

GENERAL INDEX TO DRAWINGS	
SHEET NO.	DESCRIPTION
1	TITLE SHEET AND LAYOUT PLAN
2	DETAILED INDEX
3	STANDARD PLANS SUMMARY
4 - 6	NOTES - 1 THRU 3
7	LOCATION PLAN
8 - 13	DETAILS
14 - 36	SITE & GRADING PLANS
37 - 41	TRAFFIC CONTROL PLANS

STATE OF HAWAII

DEPARTMENT OF TRANSPORTATION

HIGHWAYS DIVISION

HONOLULU, HAWAII

"AS-BUILT"

PLANS FOR


PEDESTRIAN FACILITIES & ADA COMPLIANCE,

VICINITY OF OLD WAIALAE ROAD AND SOUTH KING STREET

PROJECT NO. 7601A-01-09

DISTRICT OF HONOLULU



ISLAND OF OAHU

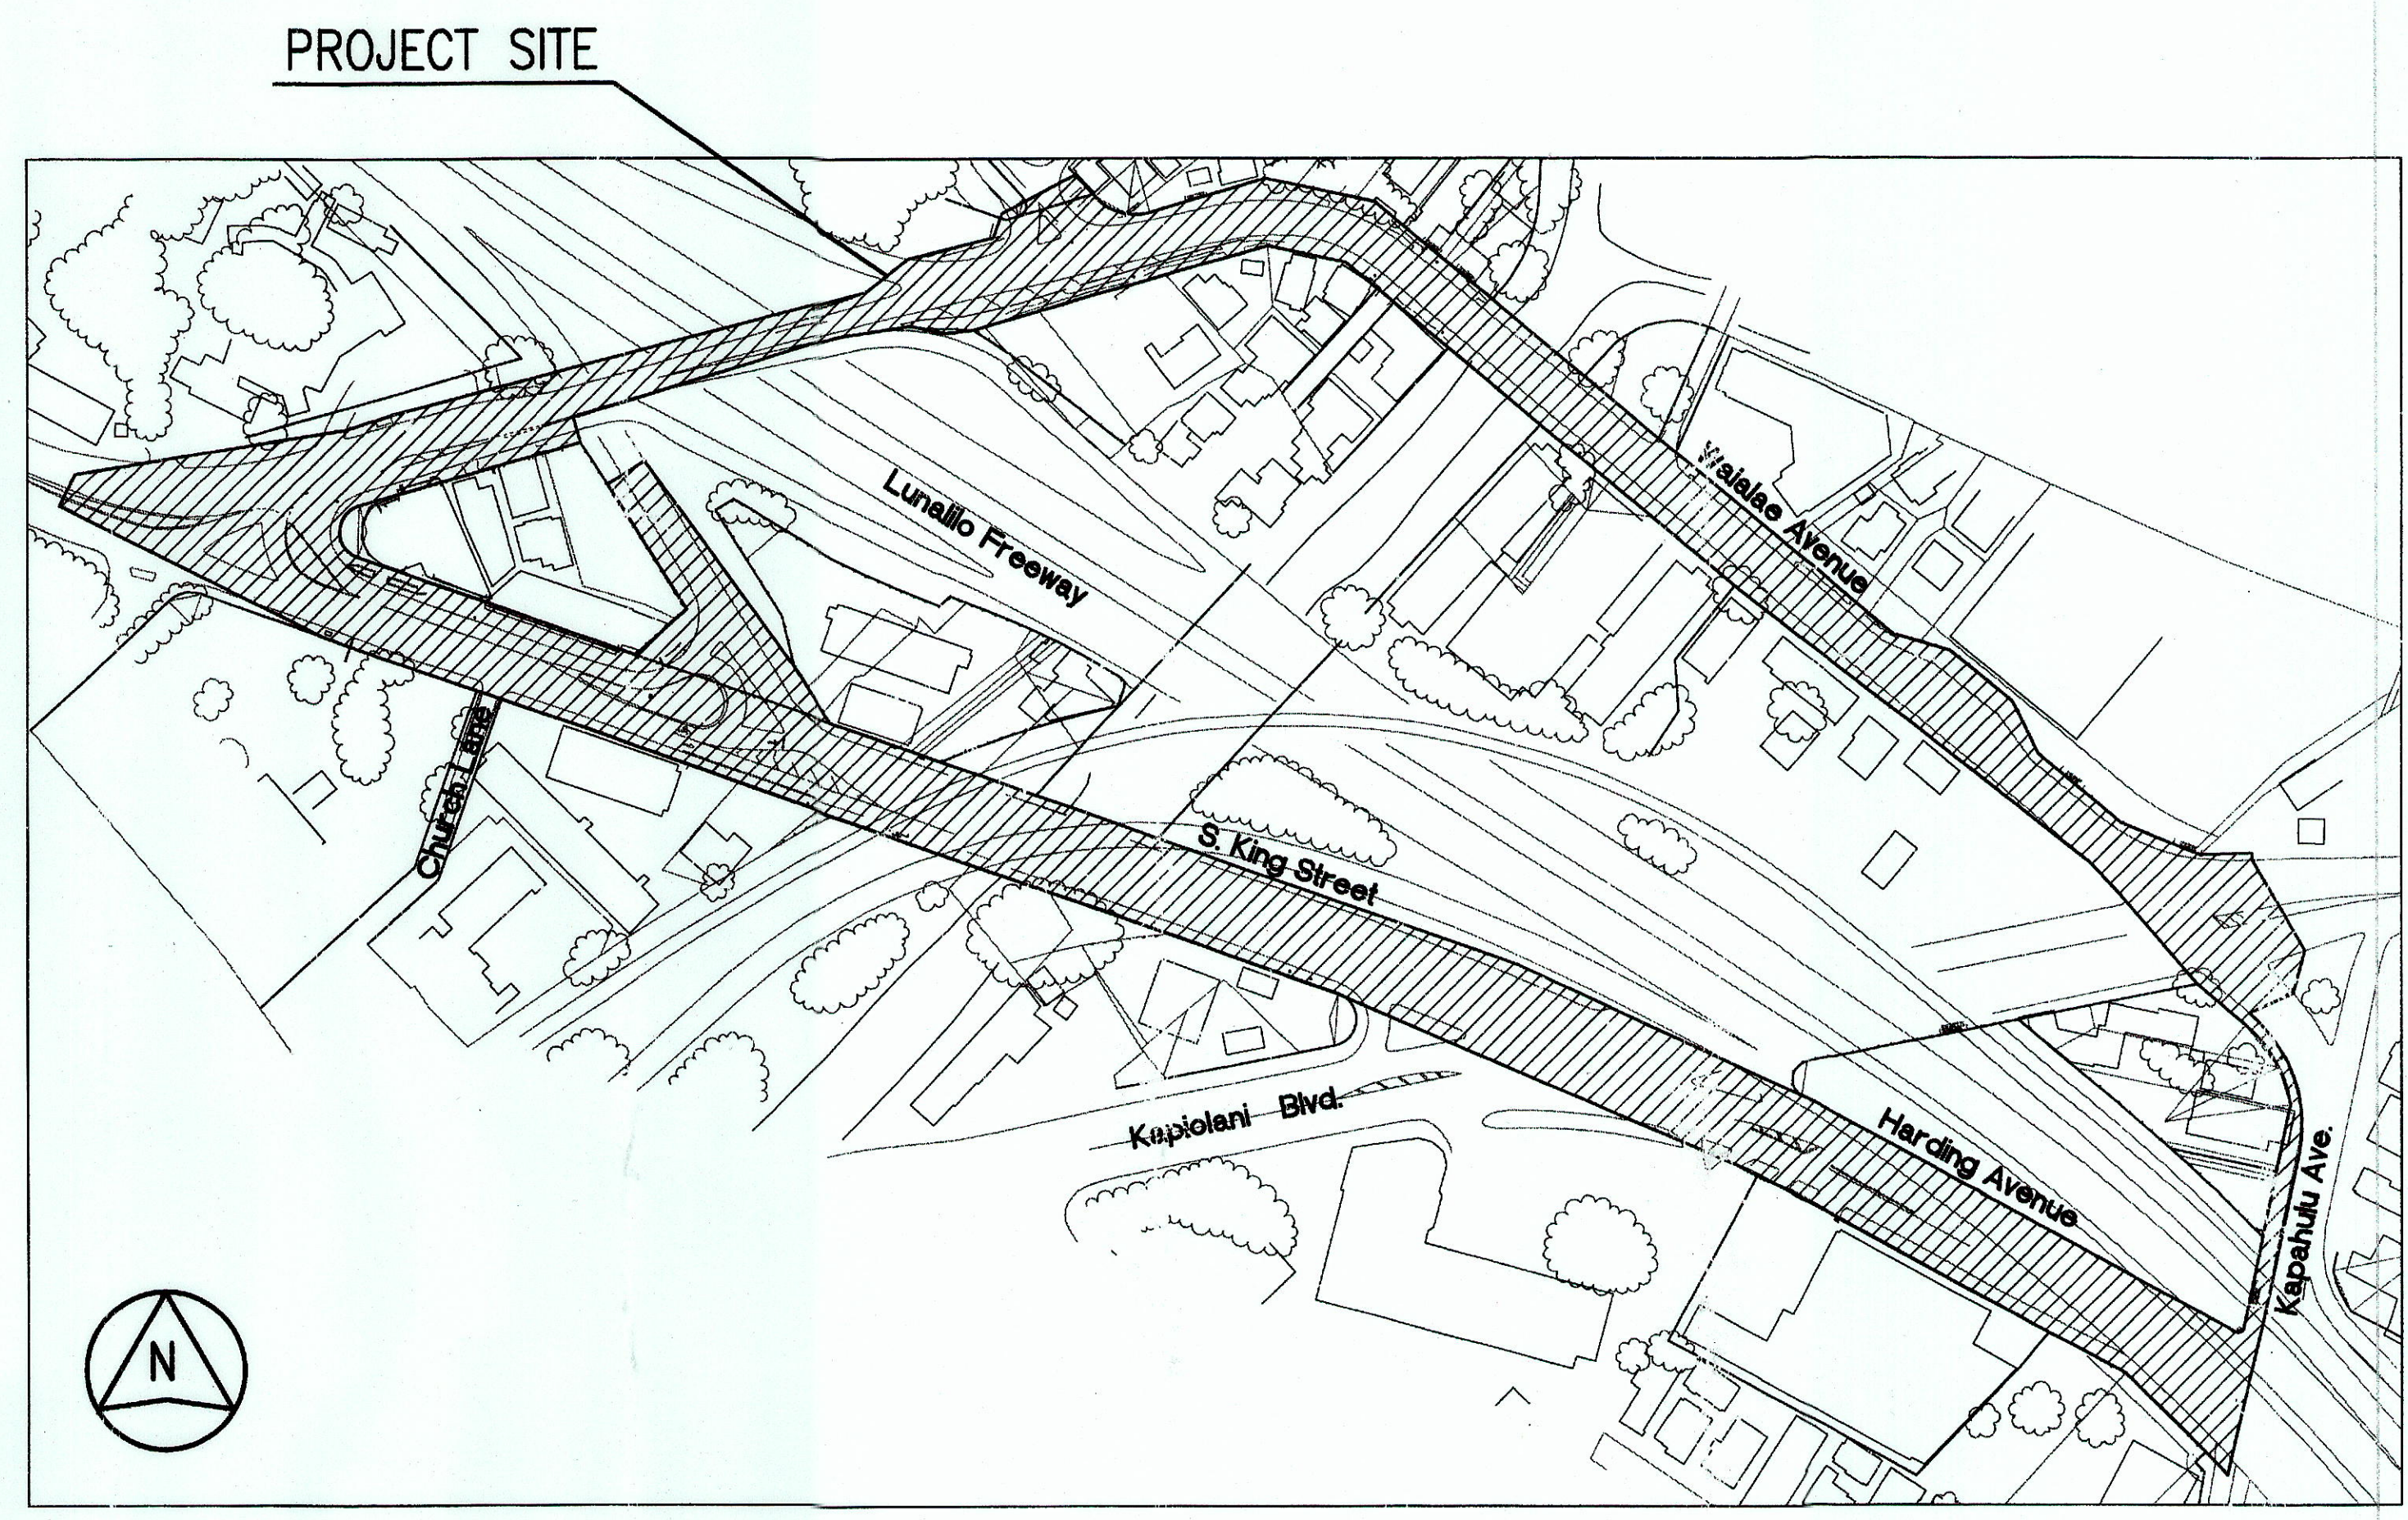

LAYOUT PLAN

Not to Scale

FED. ROAD DIST. NO.	STATE	PROJ. NO.	FISCAL YEAR	SHEET NO.	TOTAL SHEETS
HAWAII	HAW.	7301A-01-09	2010	1	41

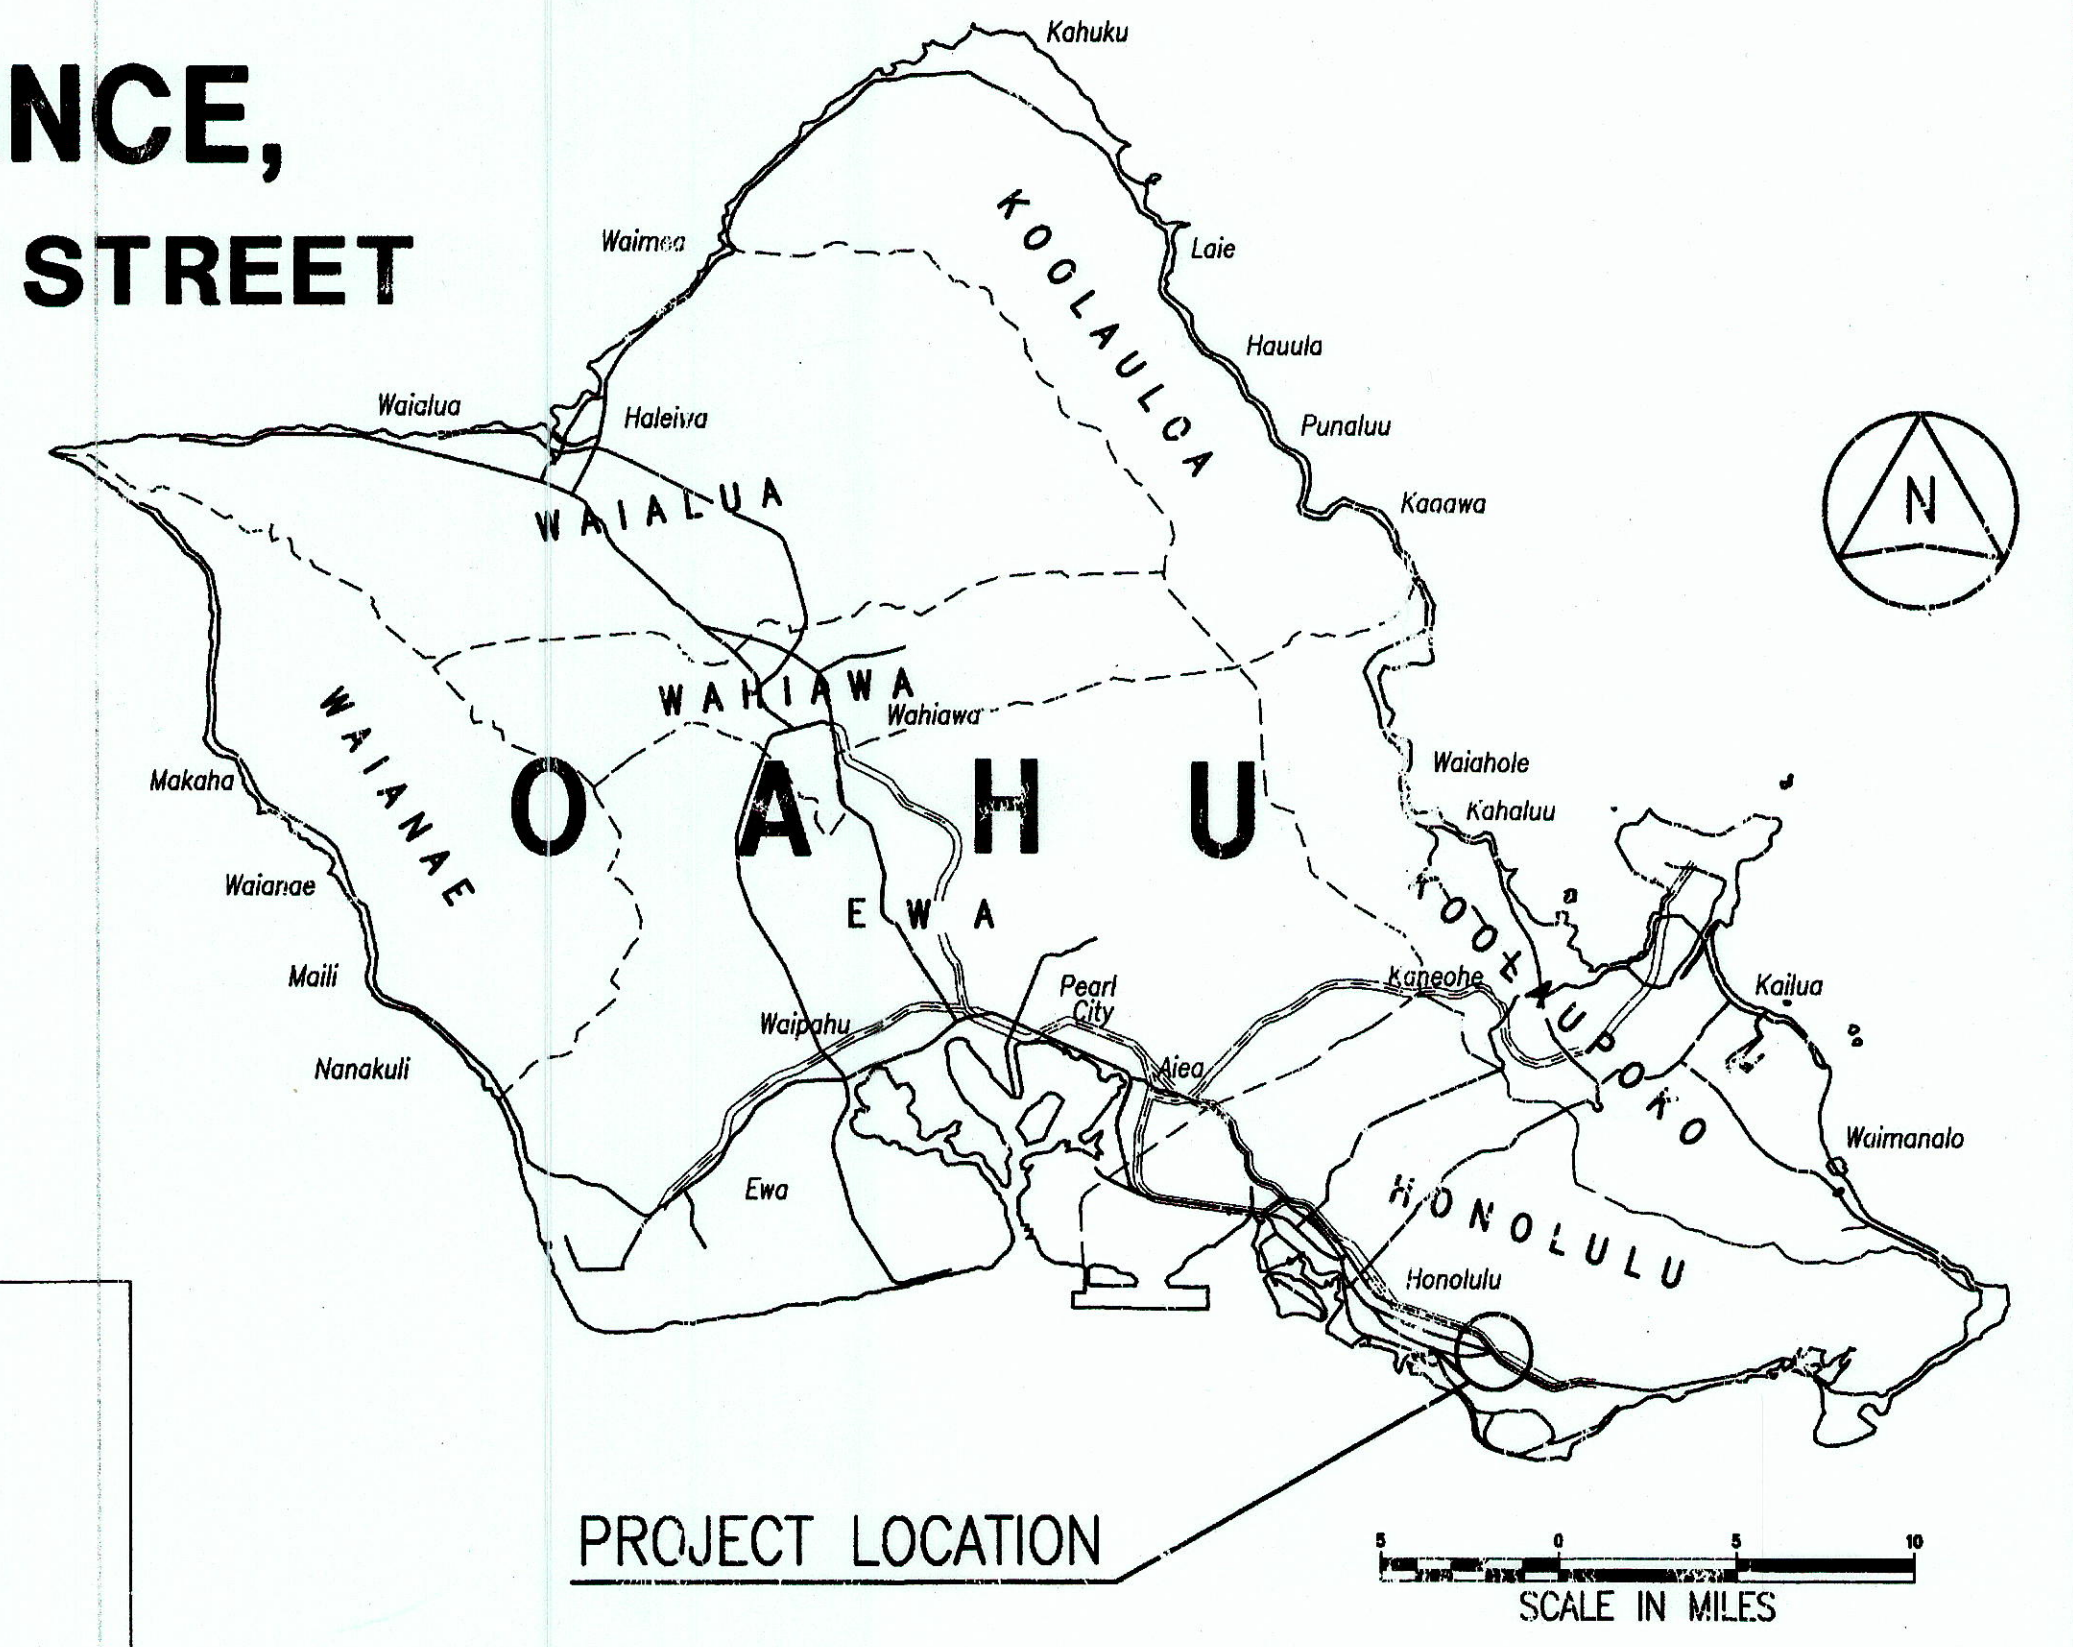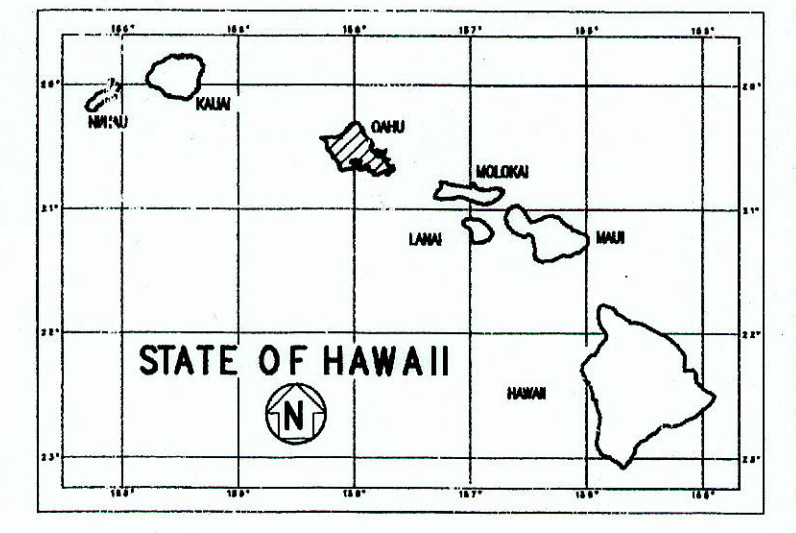

PROJECTS SITES

- 1 Old Waialae Road (Route 7601)
Mile Post 0.00 TO Mile Post 0.41
- 2 South King St., Harding Ave.
- 3 Kapahulu Ave.

CHANGES MADE DURING CONSTRUCTION HAVE BEEN INCORPORATED ON THESE PLANS EXCEPT CHANGES IN THE ORIGINAL THEORETICAL QUANTITIES. FOR ACTUAL QUANTITIES, REFER TO PROJECT LEDGER AND/OR COMPUTATION BOOK.

[Signature] 10/29/2014
RESIDENT ENGINEER DATE

DEPARTMENT OF TRANSPORTATION STATE OF HAWAII	
APPROVED:	
<i>[Signature]</i> DIR. OF TRANSPORTATION	3/22/10 DATE

DESIGNED BY	DATE
DRAWN BY	
CHECKED BY	
NOTED BY	
NO.	

R.M. TOWILL CORPORATION

DESIGNED BY

HWY-T

MANAGED BY

692-7691

PHONE

March 2010

DATE