


FED. ROAD DIST. NO.	STATE	PROJ. NO.	FISCAL YEAR	SHEET NO.	TOTAL SHEETS
HAWAII	HAW.	7801A-01-98	2000	4	14

BEGIN PROJECT @ STA. 141+00 ±

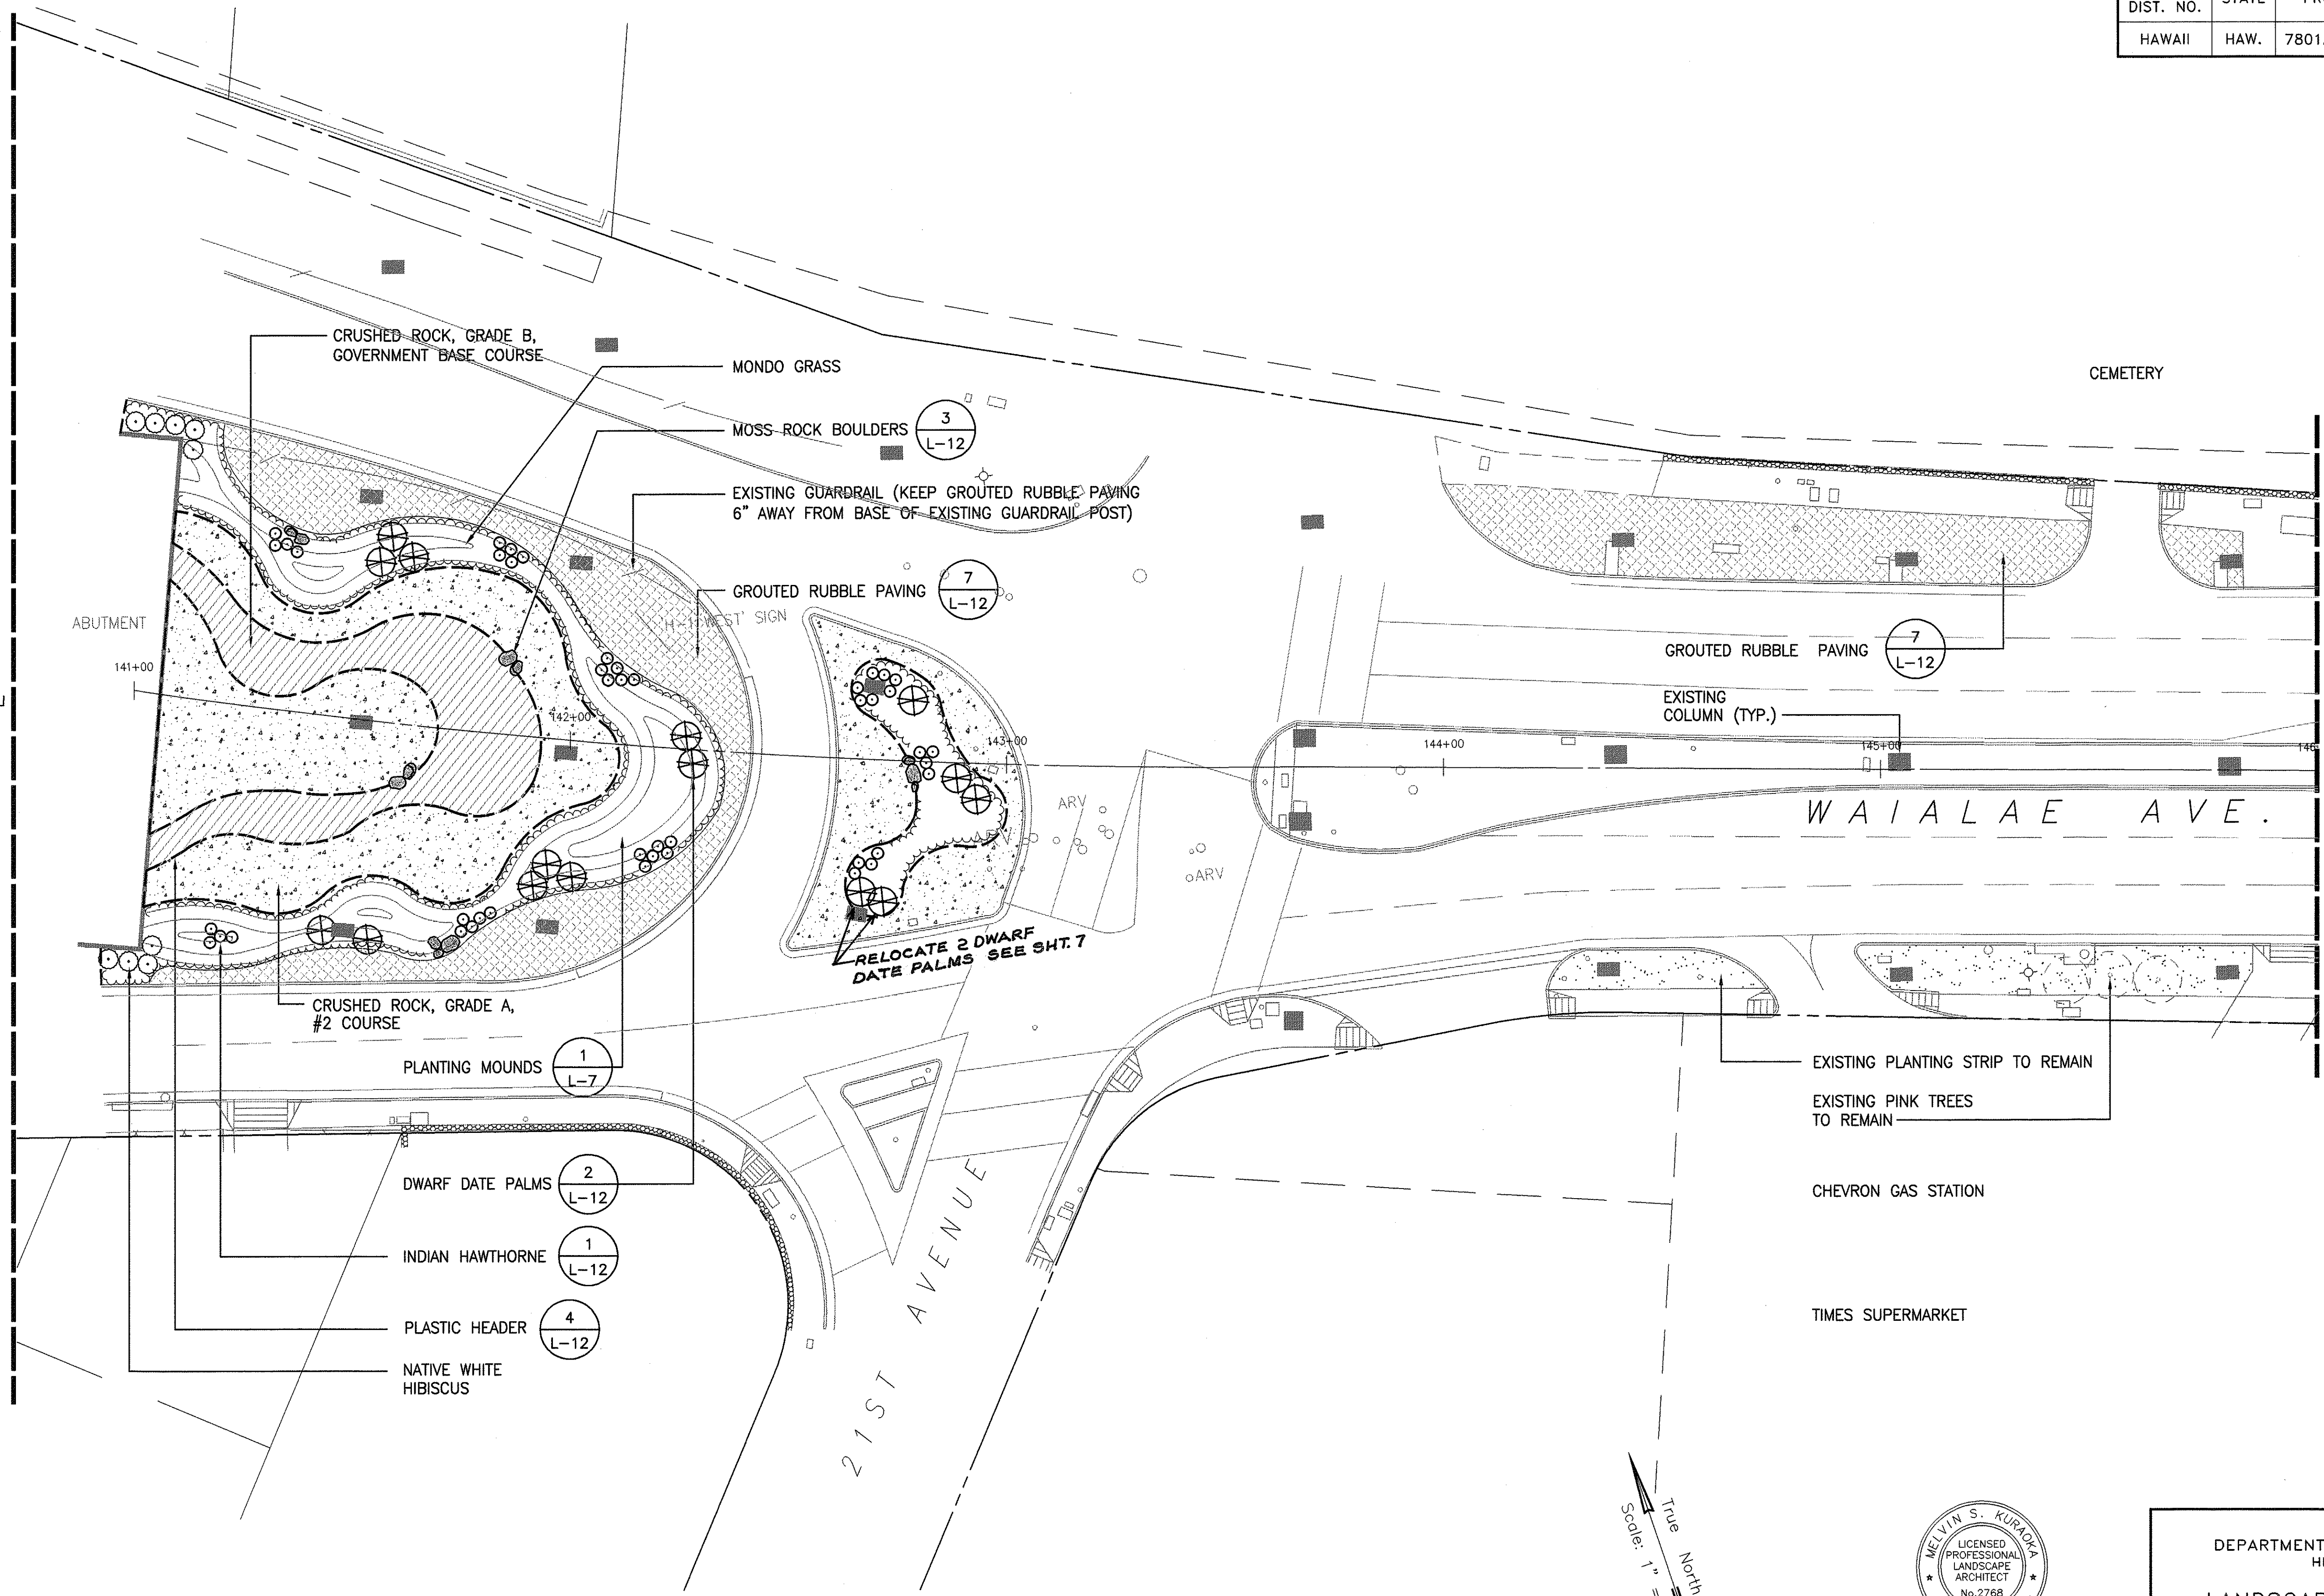

STA. 146+00 ±
MATCHLINE SEE SHEET 5

Scale: 1" = 20'

True North

SCALE IN FEET

20' 0 20' 80'

THIS WORK WAS PREPARED BY ME OF UNDER MY SUPERVISION

[Signature]

STATE OF HAWAII
DEPARTMENT OF TRANSPORTATION
HIGHWAYS DIVISION

LANDSCAPE PLANTING PLAN



WAIALAE AVENUE LANDSCAPE IMPROVEMENTS
VICINITY OF KAHALA MALL
PROJECT NO. 7801A-01-98

SCALE: 1" = 20' DATE: NOVEMBER 1999

SHEET NO. 4 OF 14 SHEETS

"AS-BUILT"

FED. ROAD DIST. NO.	STATE	PROJ. NO.	FISCAL YEAR	SHEET NO.	TOTAL SHEETS
HAWAII	HAW.	7801A-01-98	2000	5	14

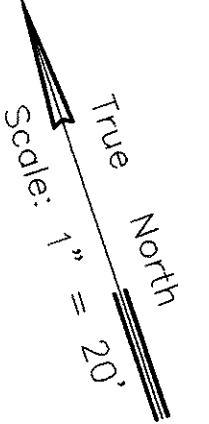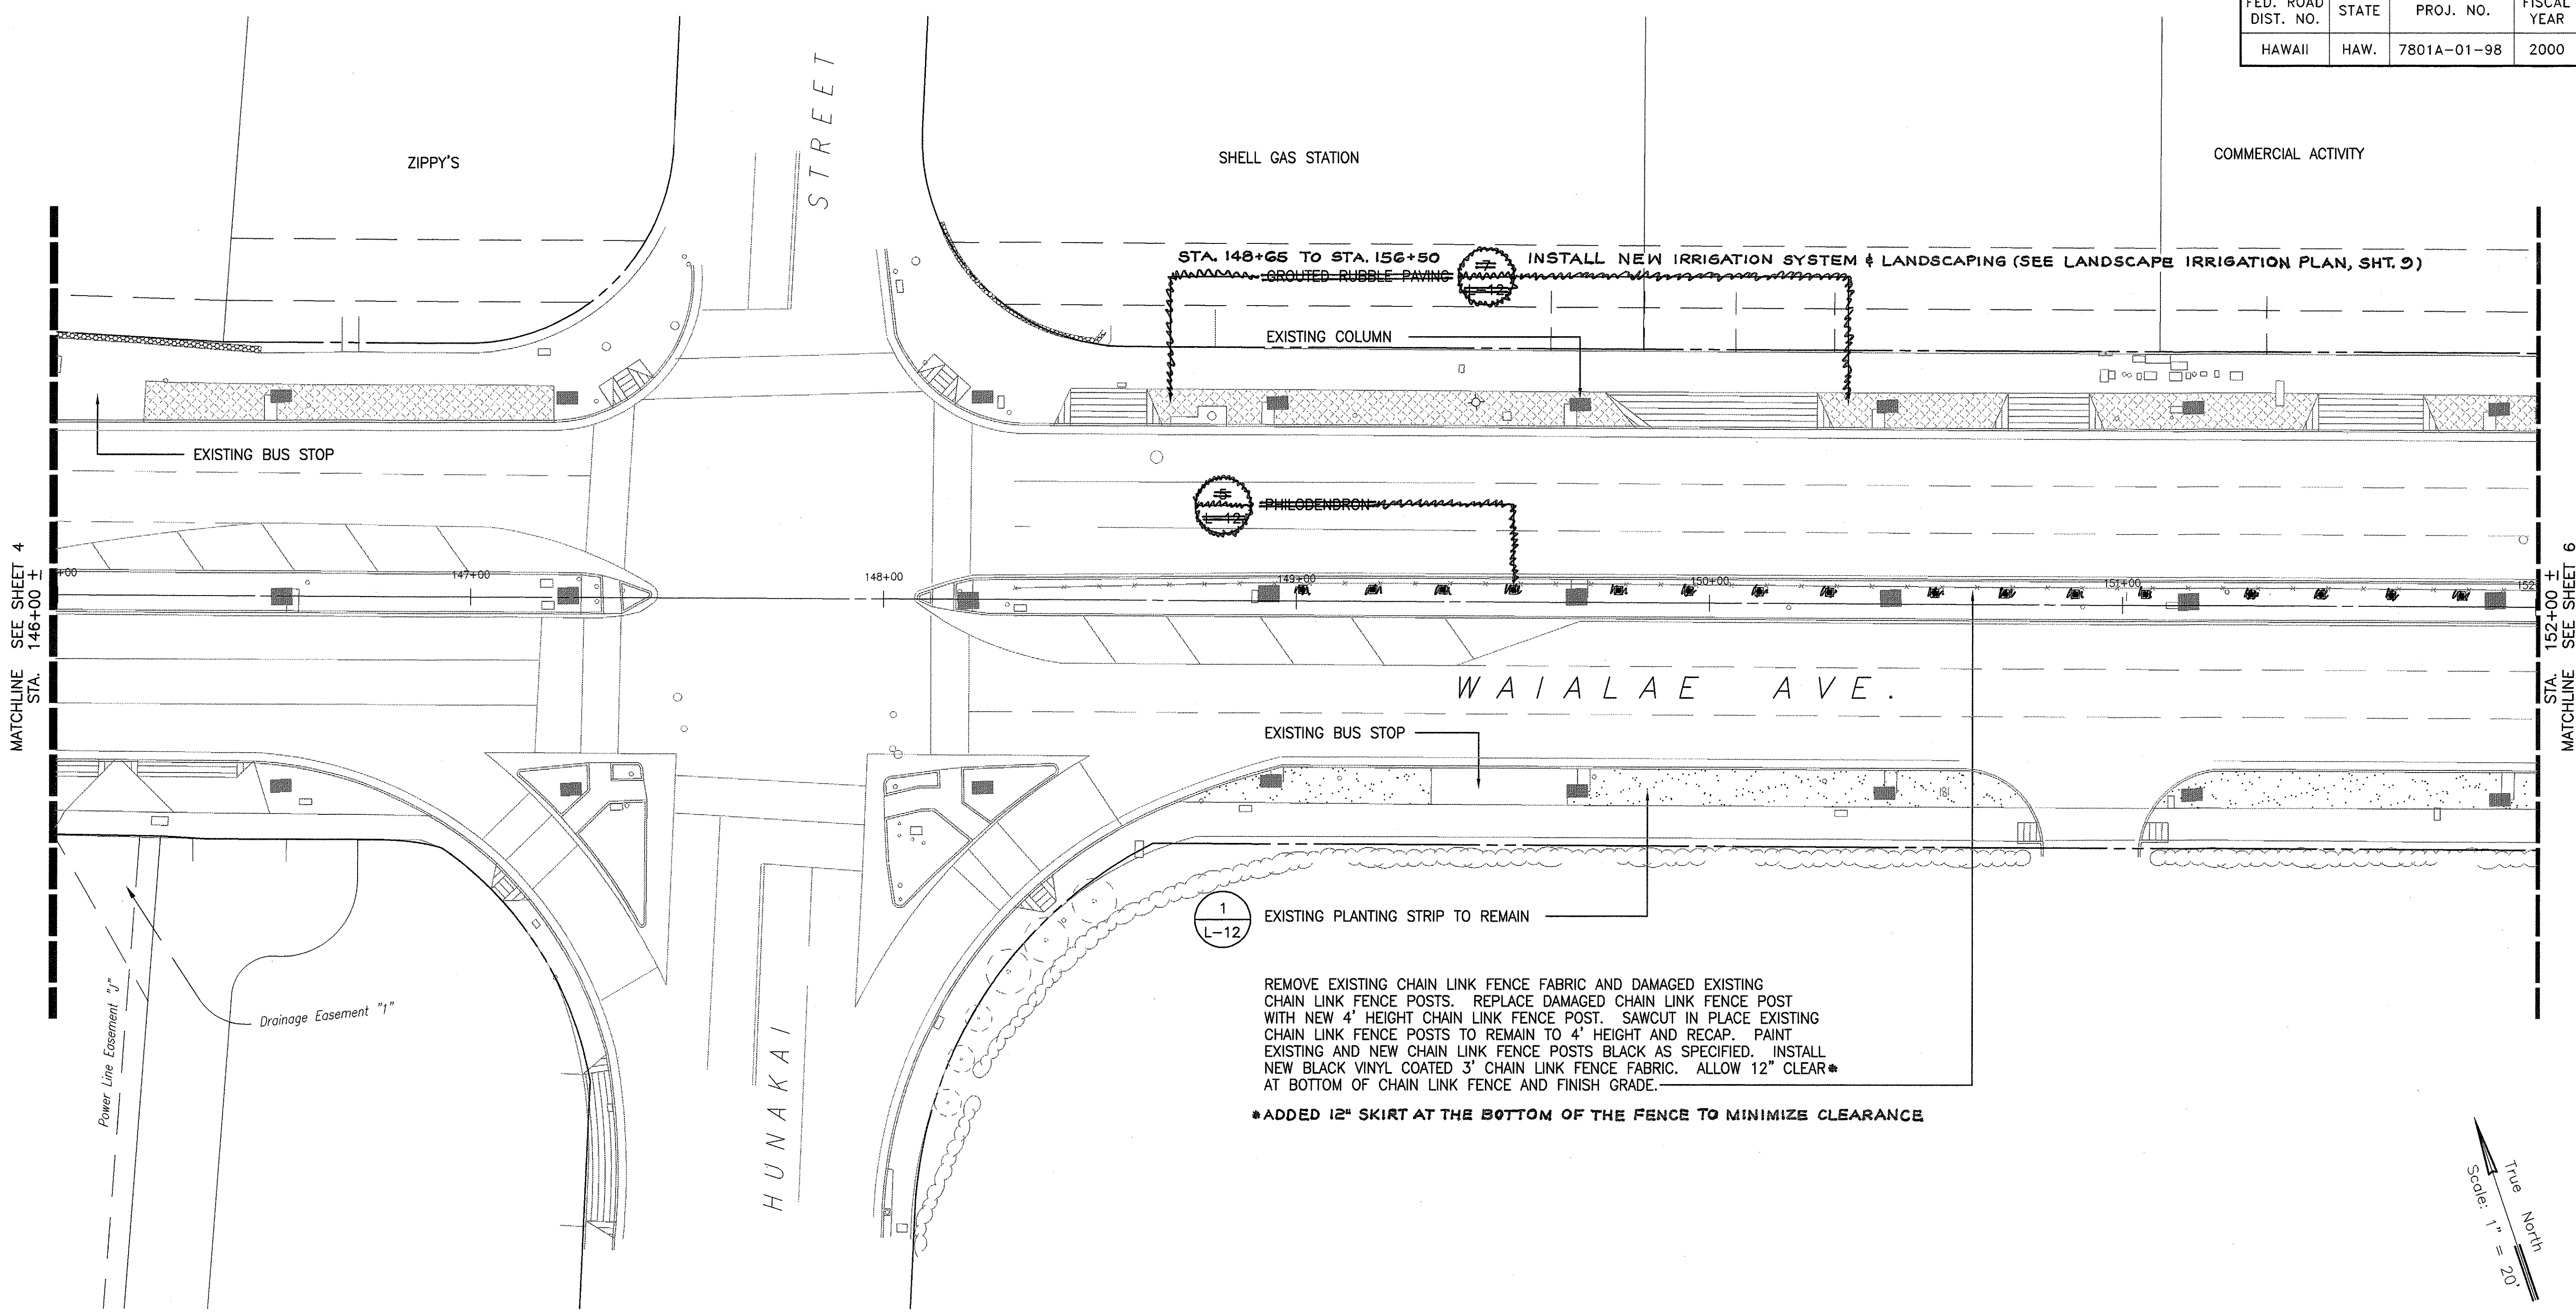

THIS WORK WAS PREPARED BY
ME OF UNDER MY SUPERVISION

[Signature]

STATE OF HAWAII
DEPARTMENT OF TRANSPORTATION
HIGHWAYS DIVISION

LANDSCAPE PLANTING PLAN

WAIALAE AVENUE LANDSCAPE IMPROVEMENTS
VICINITY OF KAHALA MALL
PROJECT NO. 7801A-01-98




SCALE: 1" = 20' DATE: NOVEMBER 1999

SHEET NO. 5 OF 14 SHEETS

"AS-BUILT"

11-8-99 / 97046 / 5 / DNL / LK

FED. ROAD DIST. NO.	STATE	PROJ. NO.	FISCAL YEAR	SHEET NO.	TOTAL SHEETS
HAWAII	HAW.	7801A-01-98	2000	6	14

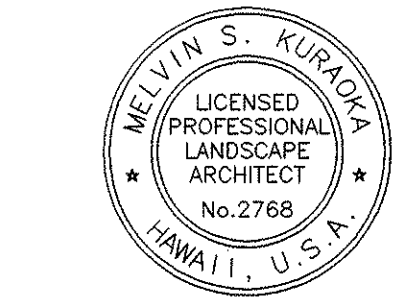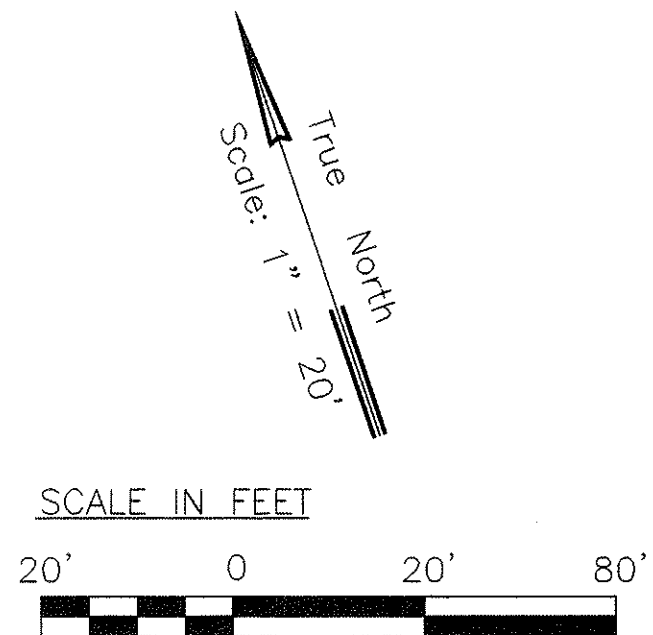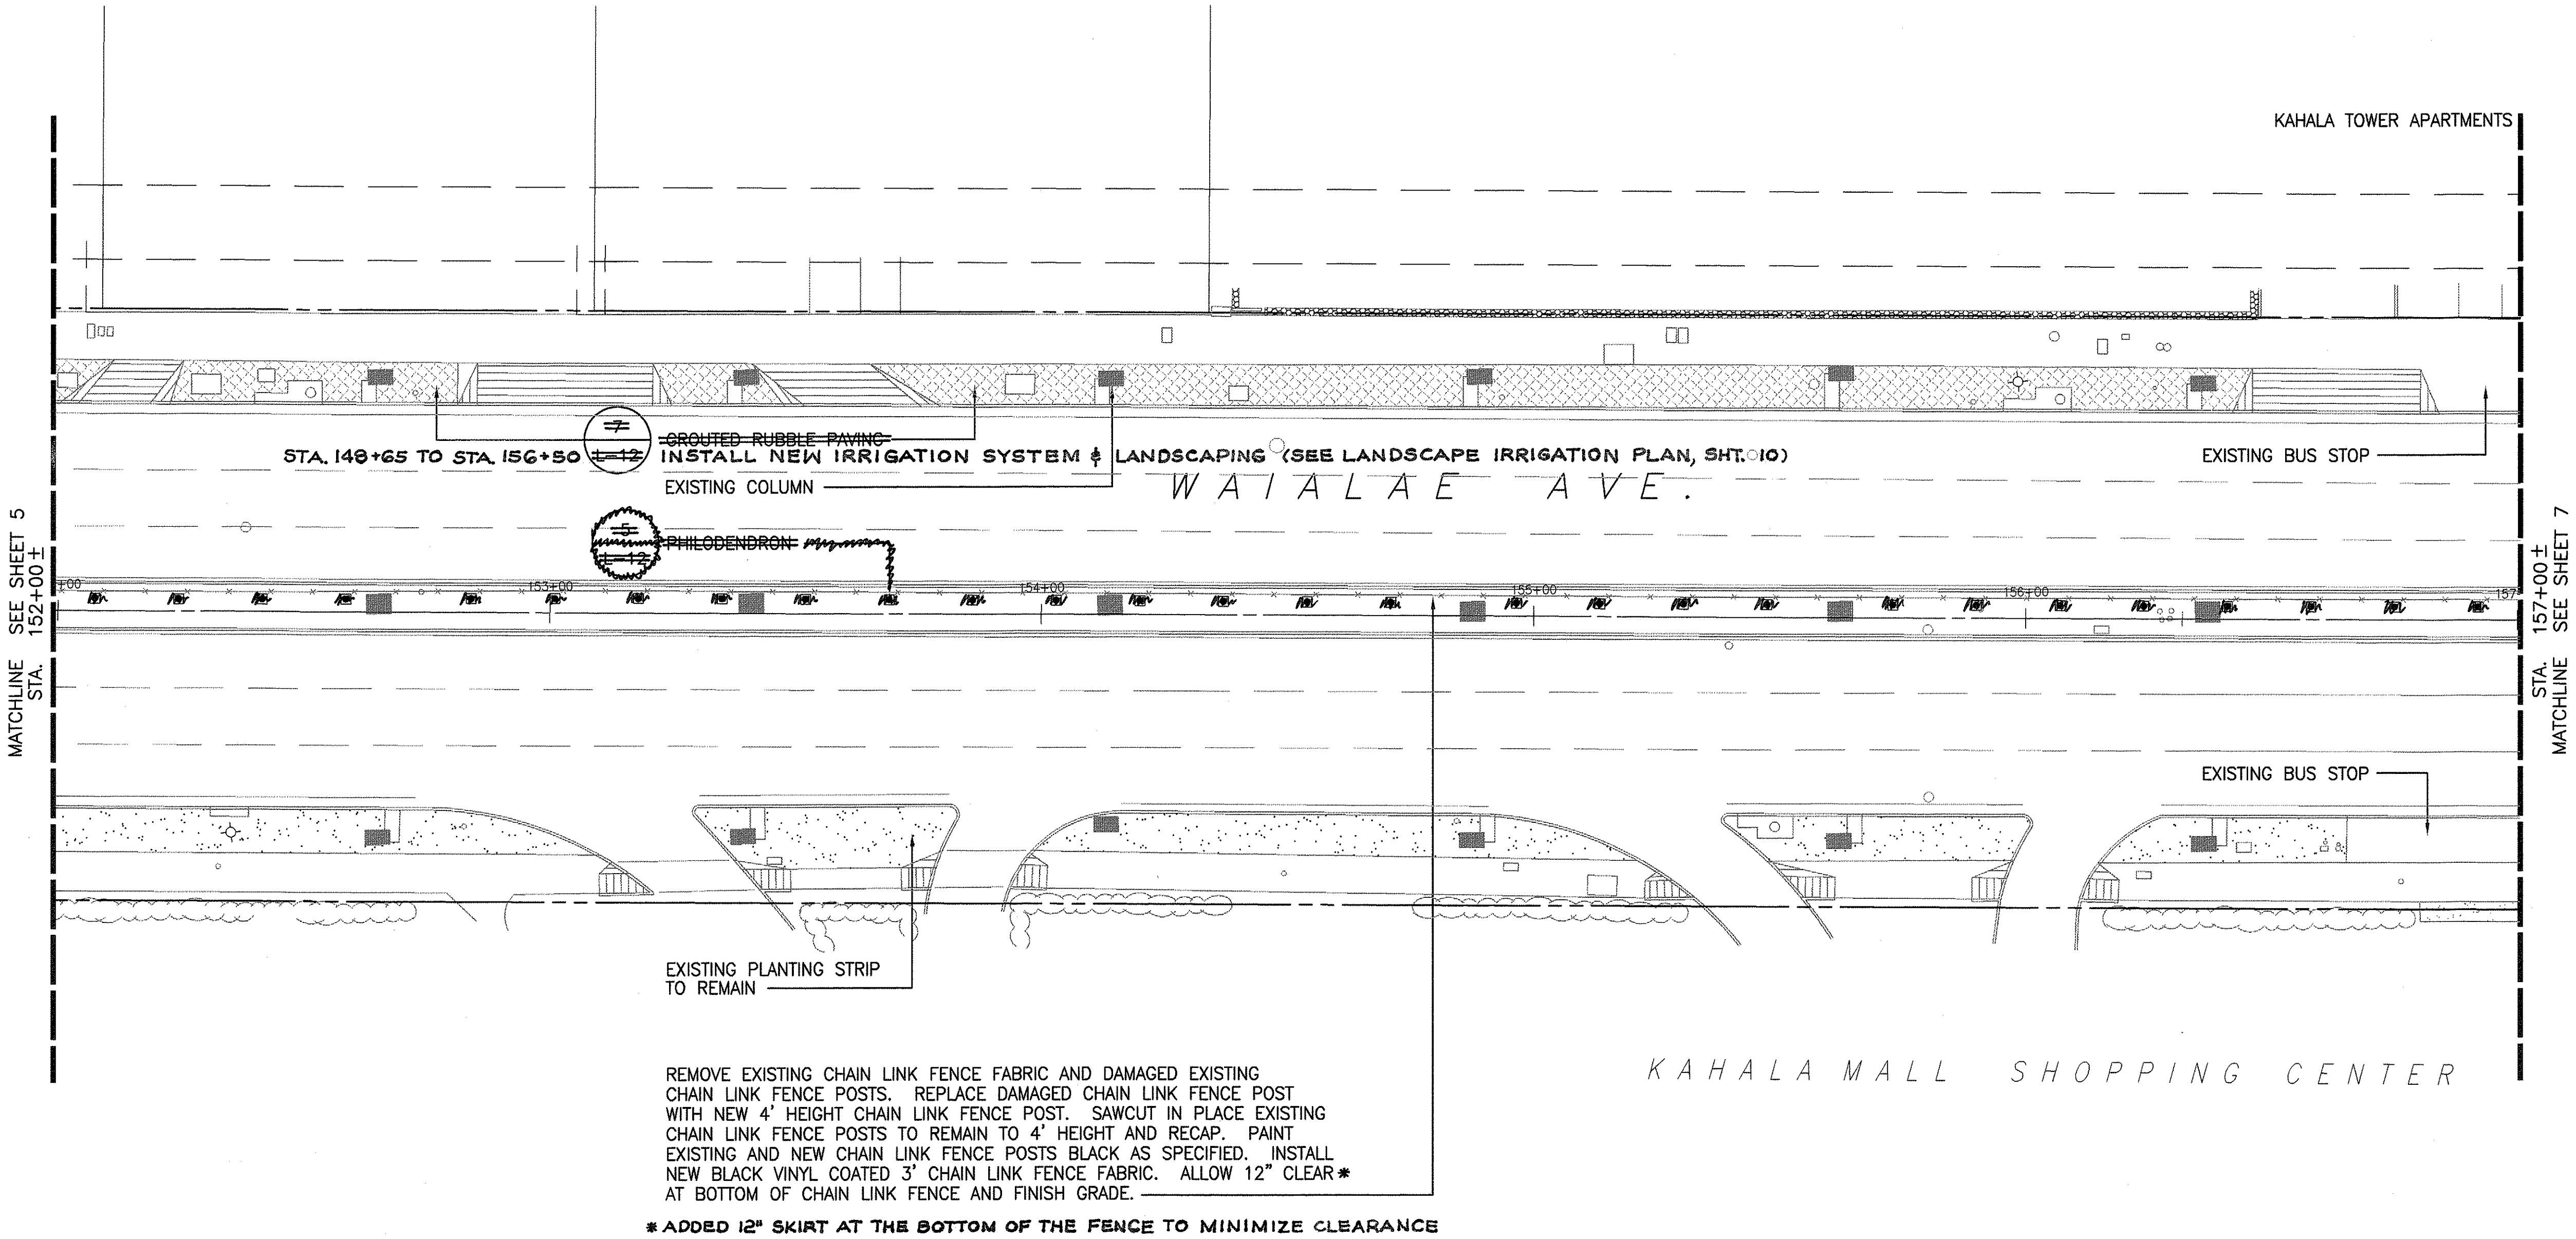

THIS WORK WAS PREPARED BY
ME OF UNDER MY SUPERVISION

[Signature]

STATE OF HAWAII
DEPARTMENT OF TRANSPORTATION
HIGHWAYS DIVISION

LANDSCAPE PLANTING PLAN

WAIALAE AVENUE LANDSCAPE IMPROVEMENTS
VICINITY OF KAHALA MALL
PROJECT NO. 7801A-01-98

SCALE: 1"= 20'

DATE: NOVEMBER 1999

