


FED. ROAD DIST. NO.	STATE	FED. AID PROJ. NO.	FISCAL YEAR	SHEET NO.	TOTAL SHEETS
HAWAII	HAW	WPMH 63	1935	9	14


FINAL SURVEY	DATE
NO.	

ORIGINAL SURVEY	DATE
NO.	

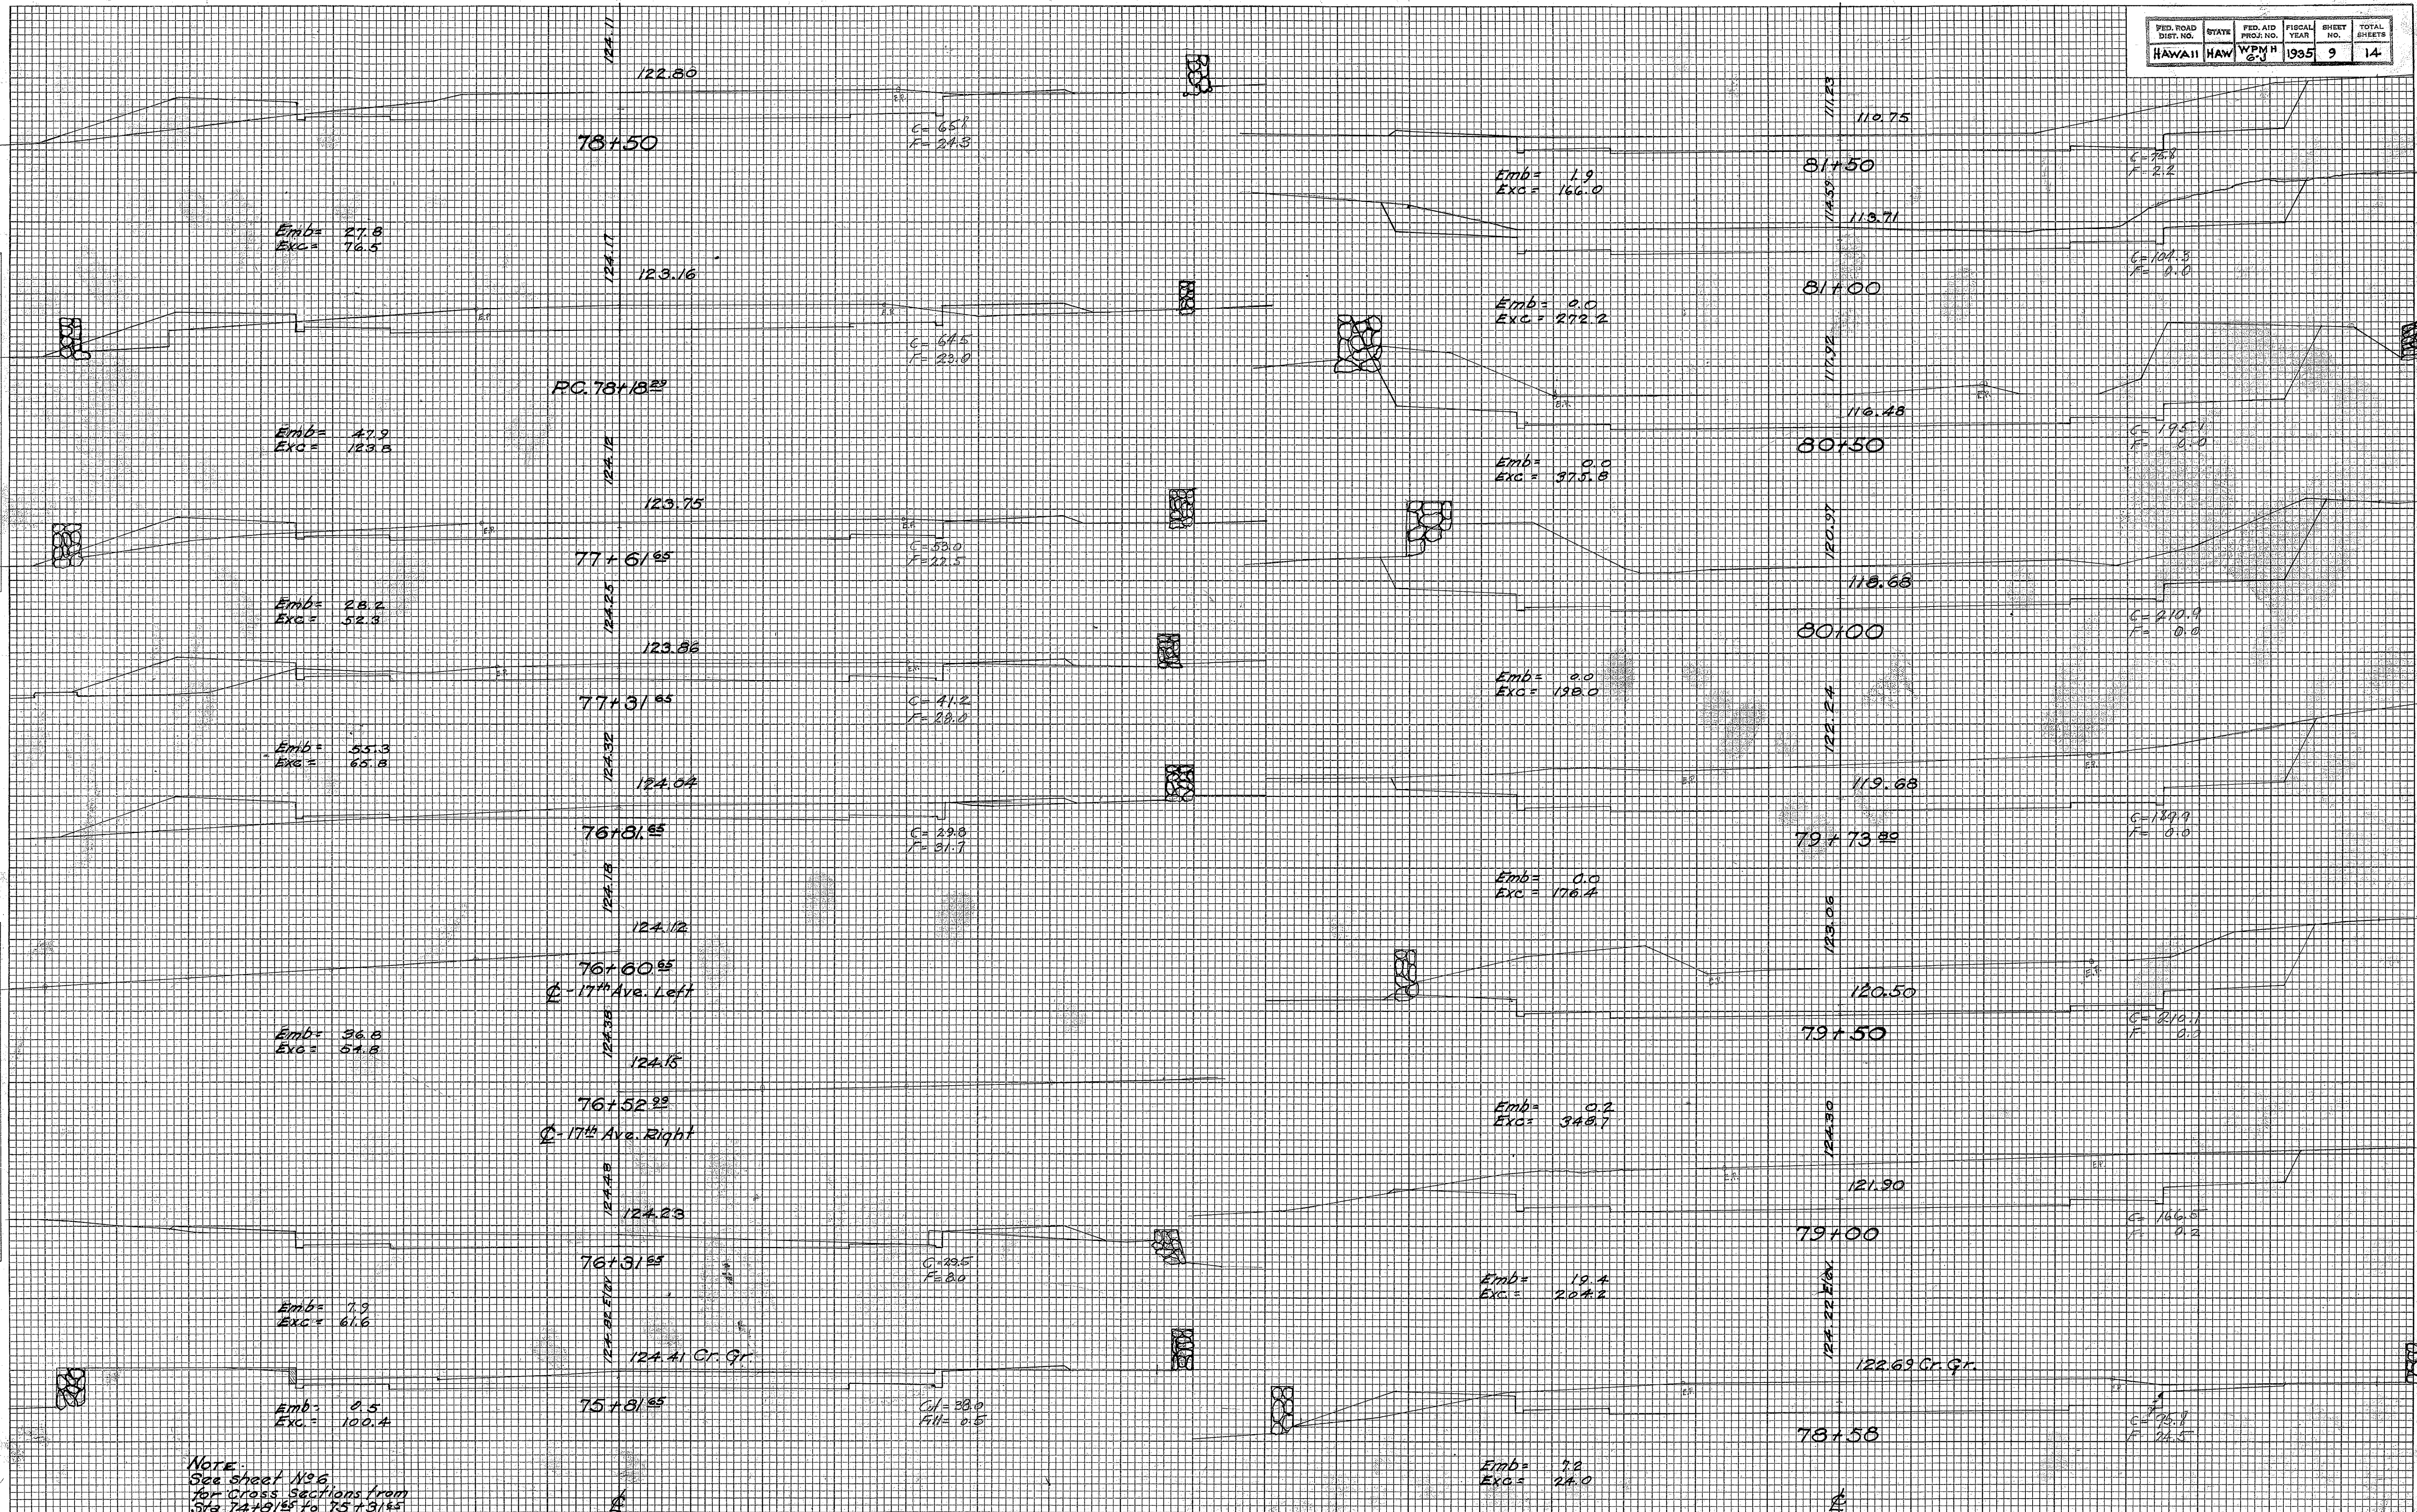

FINAL SURVEY
NO. 1
DATE
BY
SURVEYED
PLOTTER
NOTE BOOK
AREAS CHECKED

ORIGINAL SURVEY
NO. 1
DATE
BY
SURVEYED
PLOTTER
NOTE BOOK
AREAS CHECKED

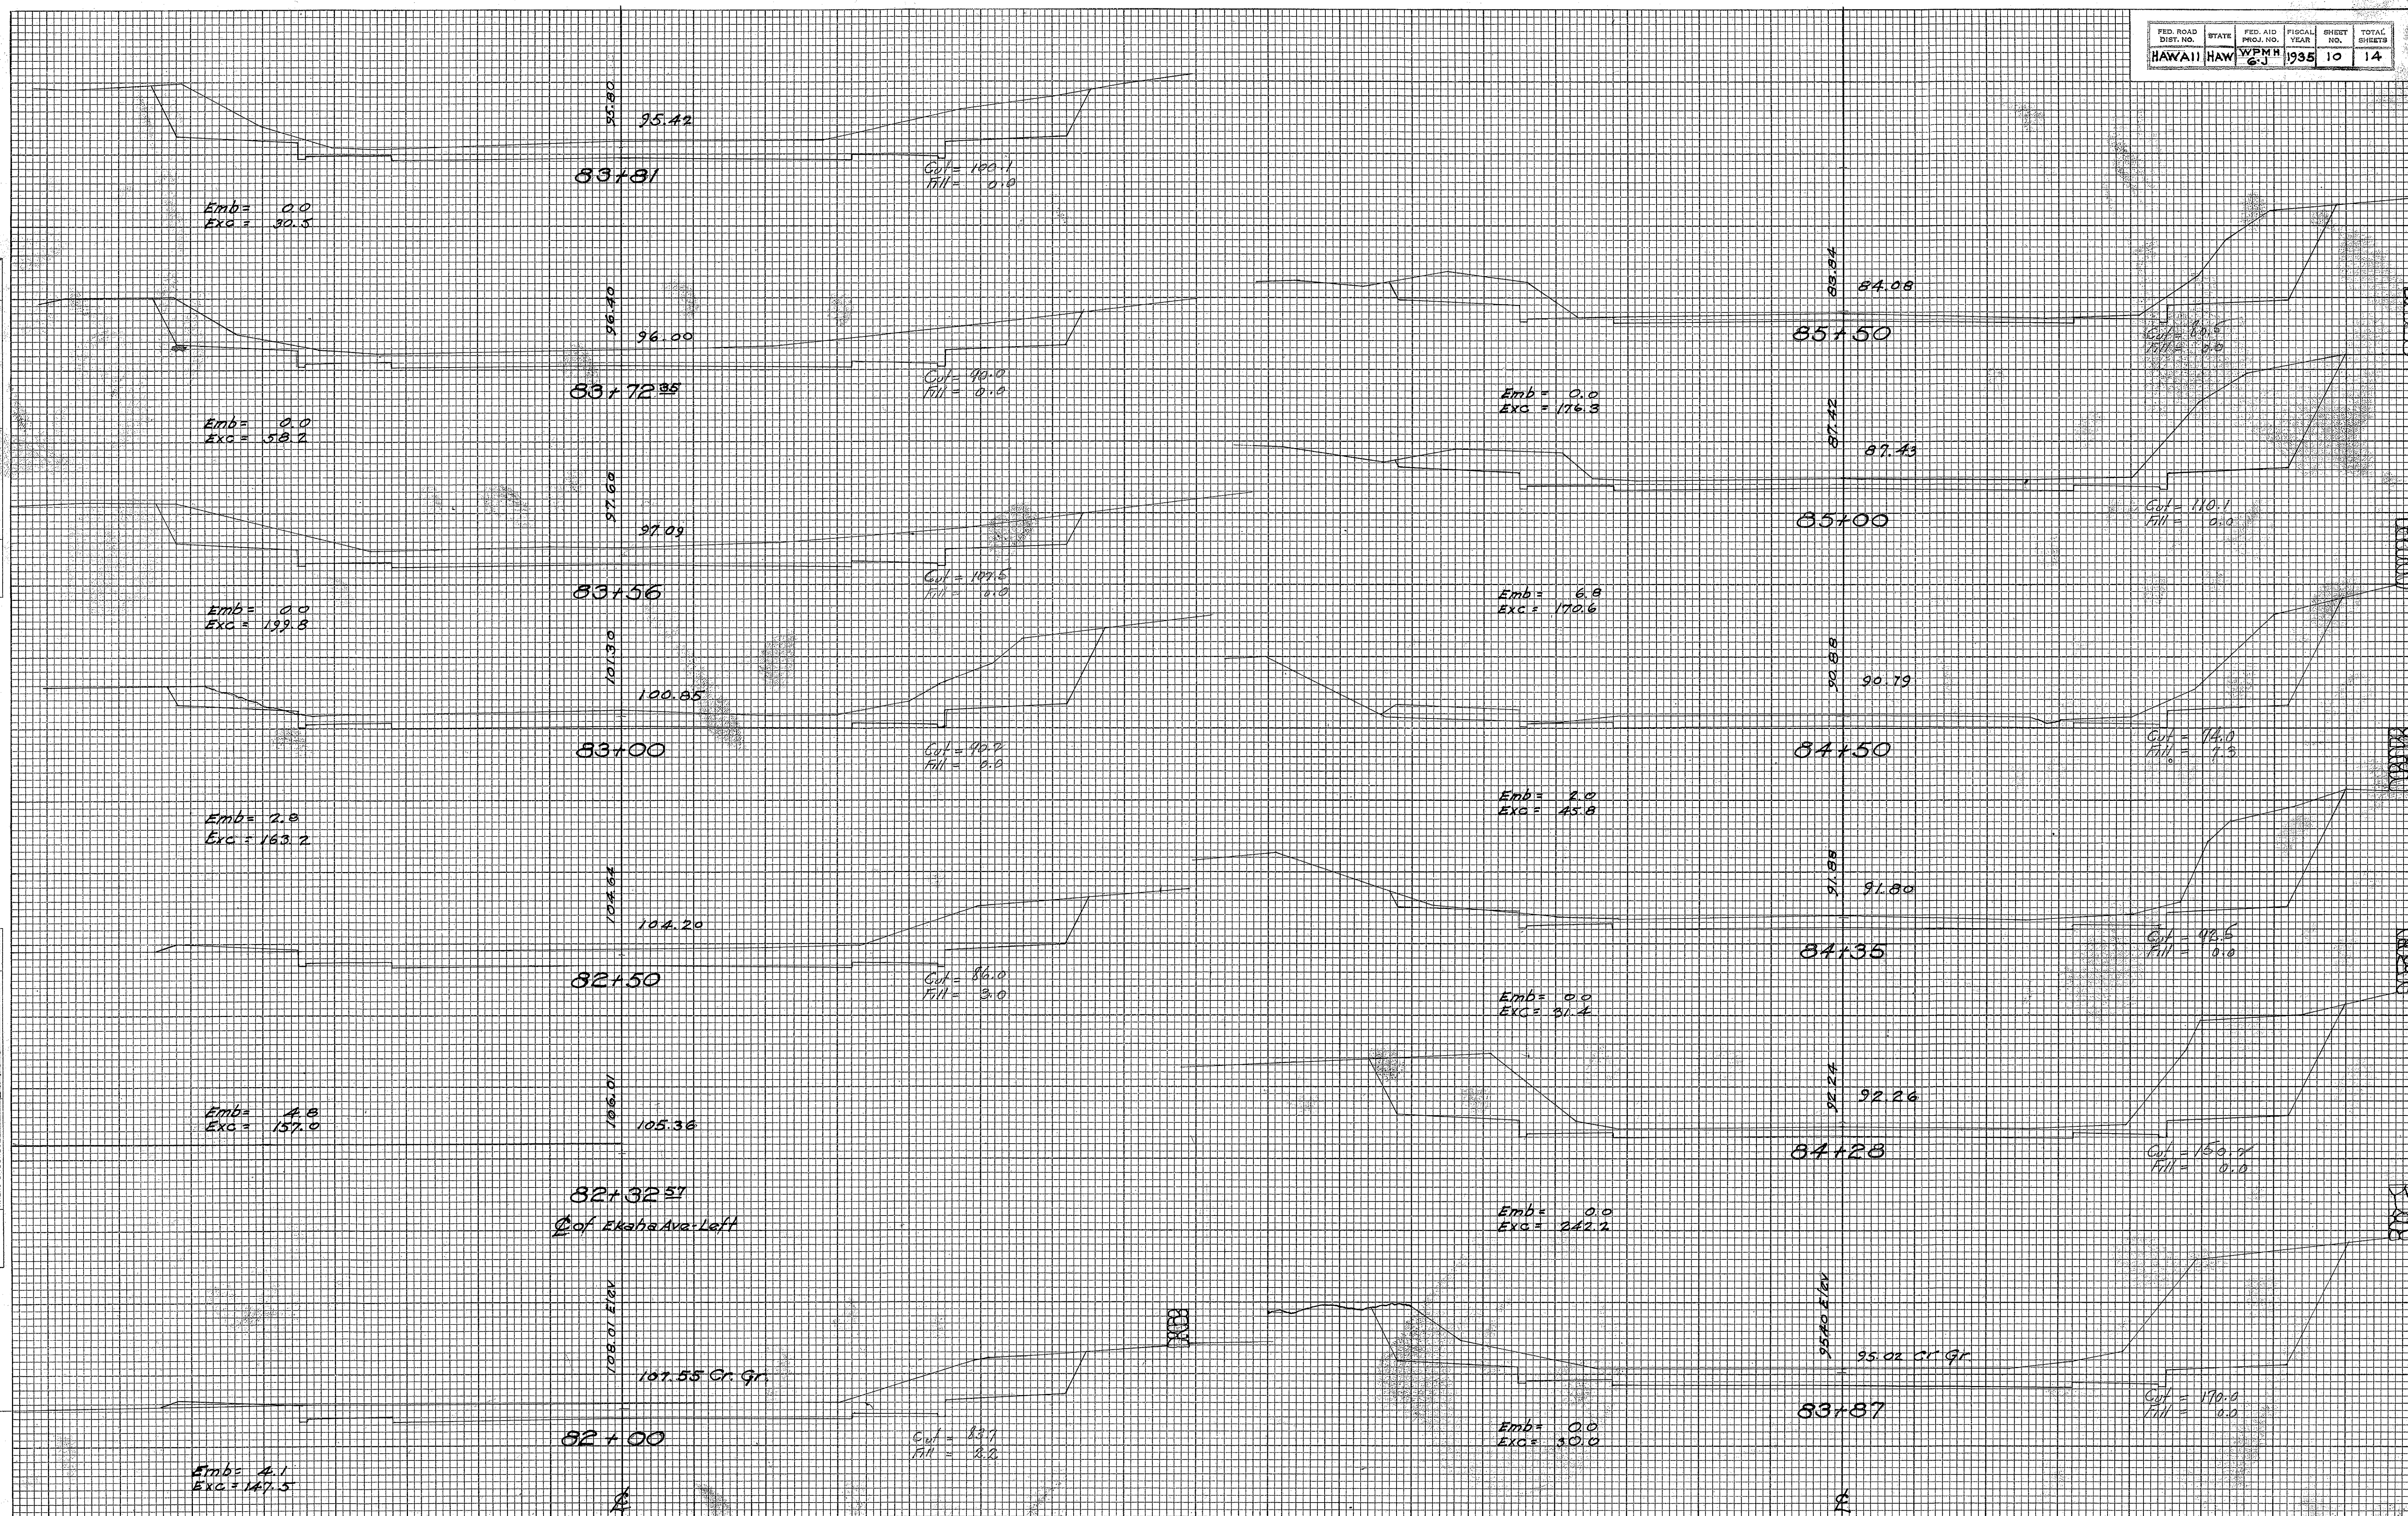

FED. ROAD DIST. NO.	STATE	FED. AID PROJ. NO.	FISCAL YEAR	SHEET NO.	TOTAL SHEETS
HAWAII	HAW	WPMH 6J	1935	11	14

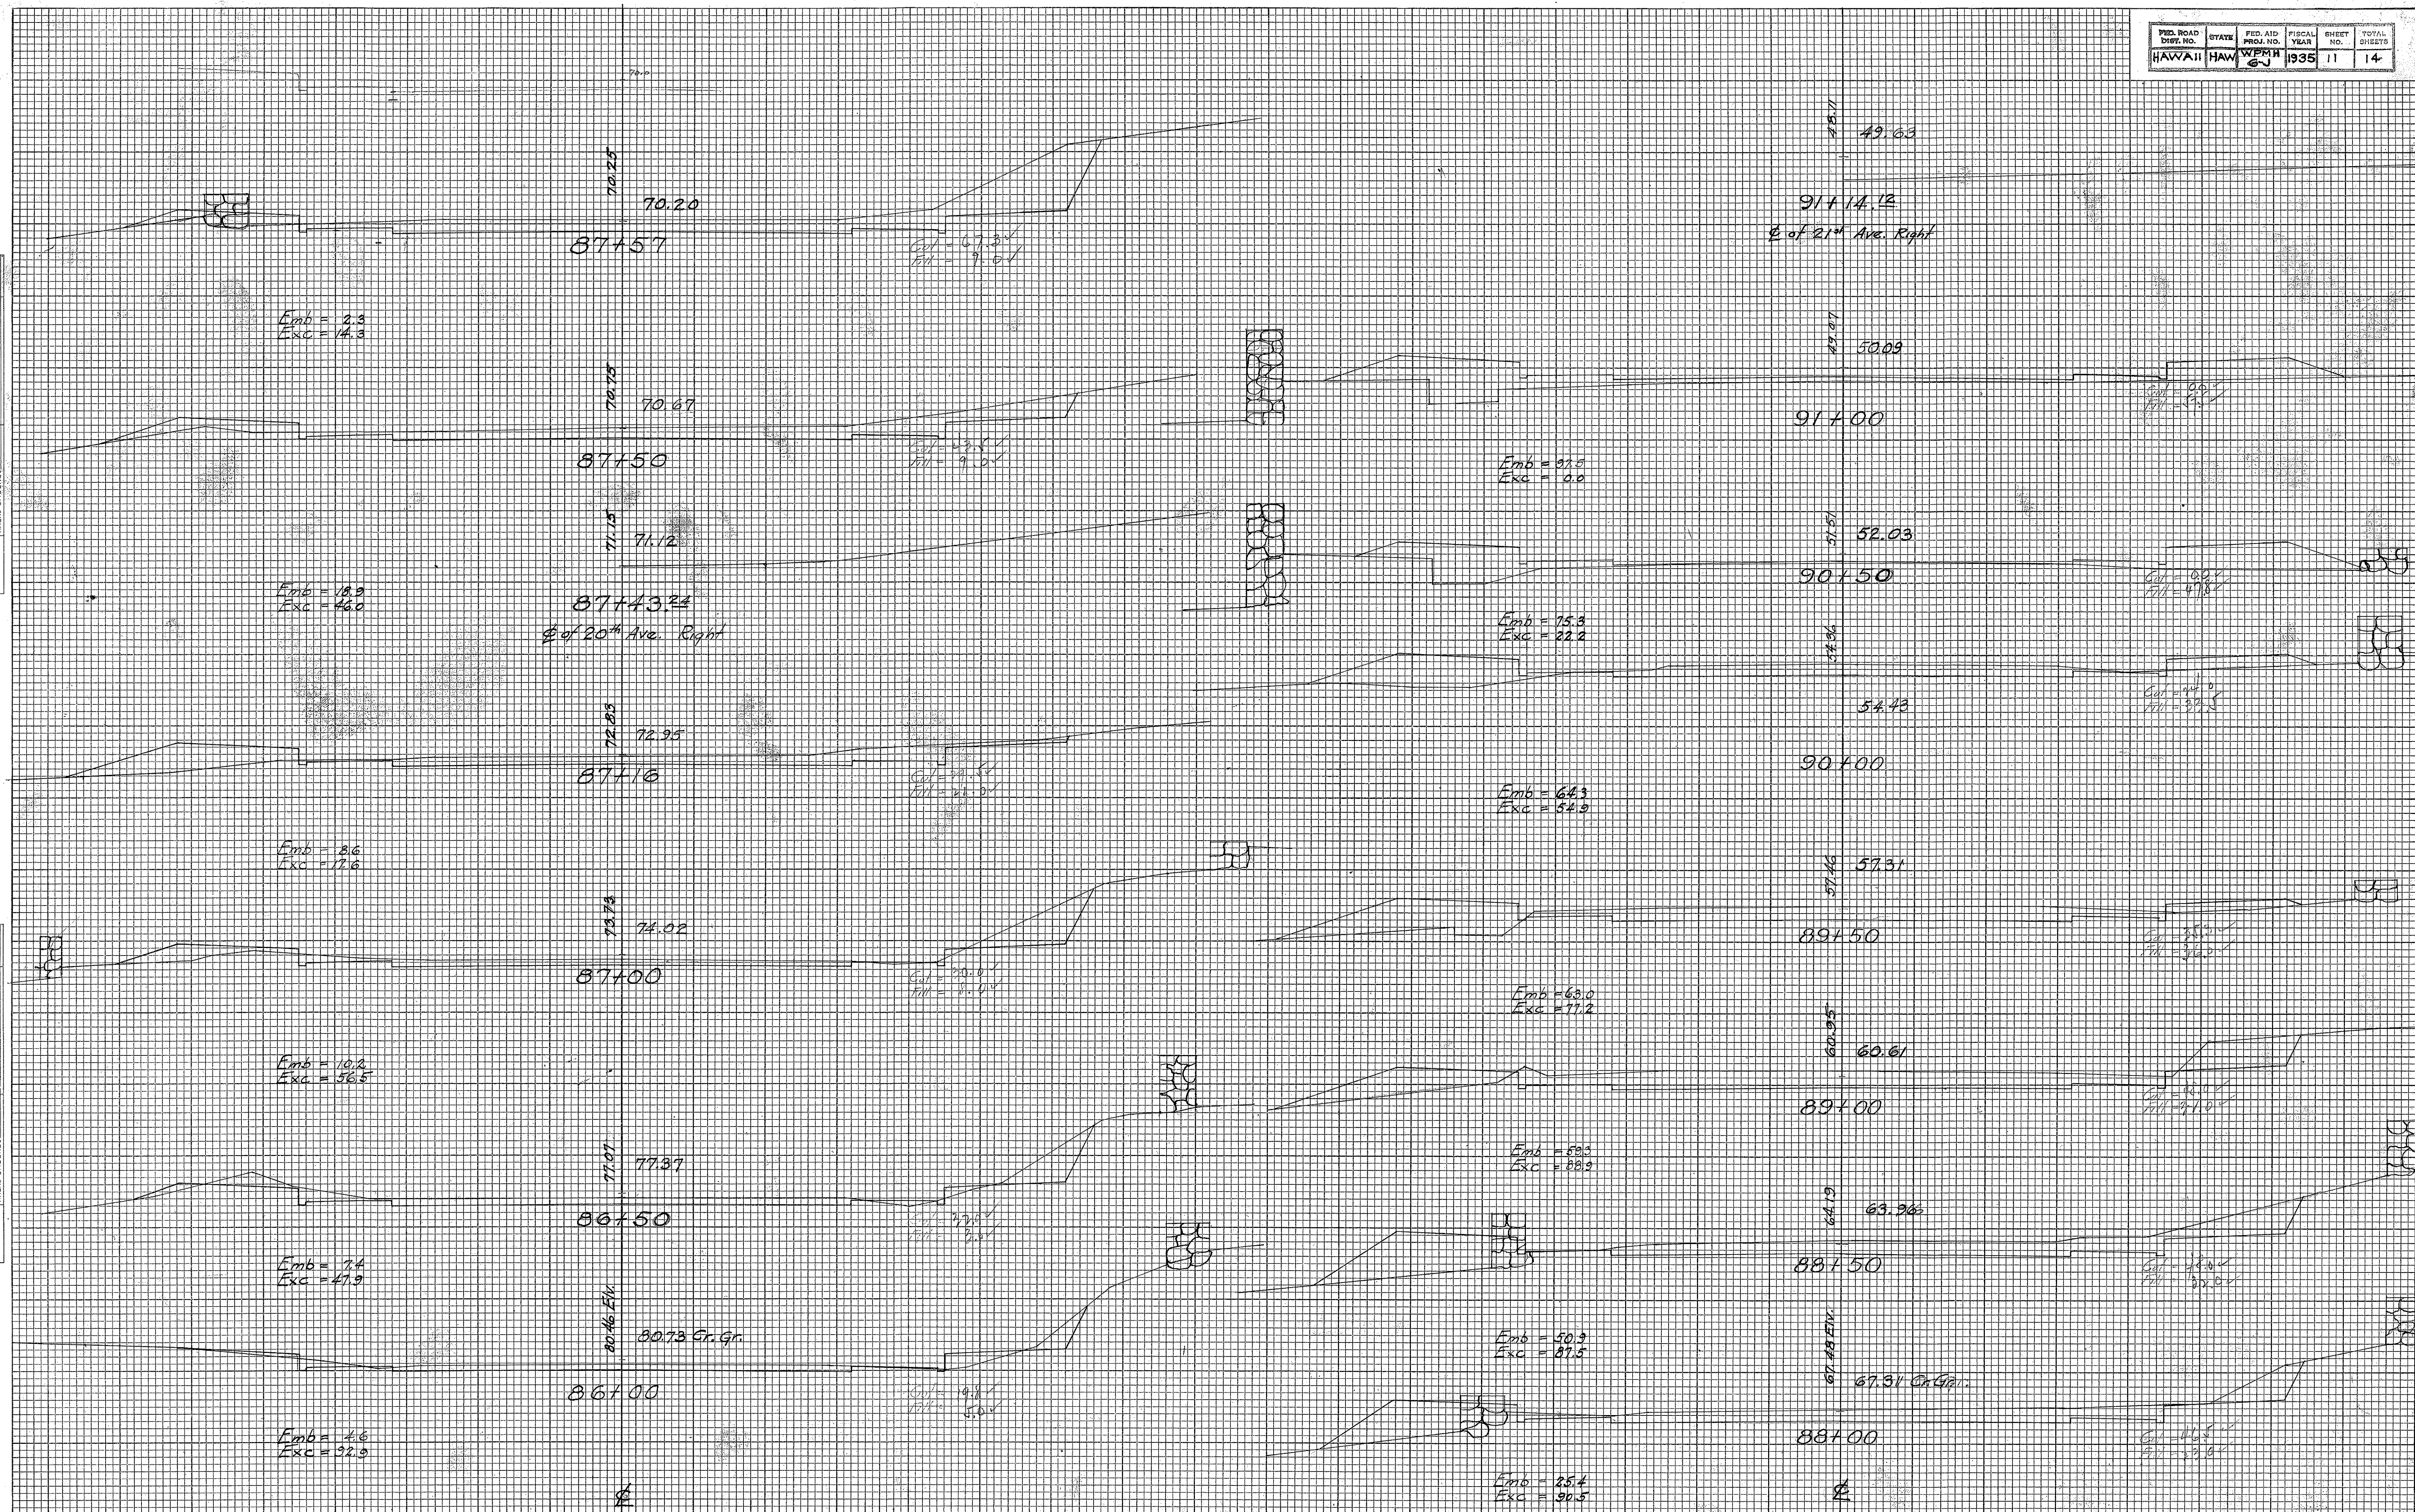
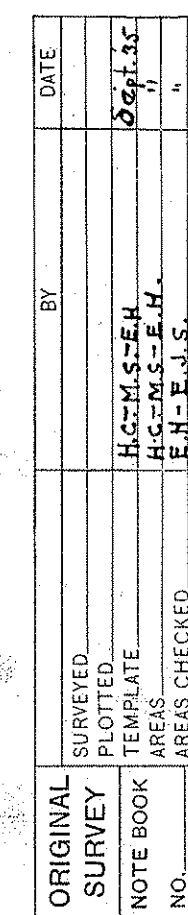
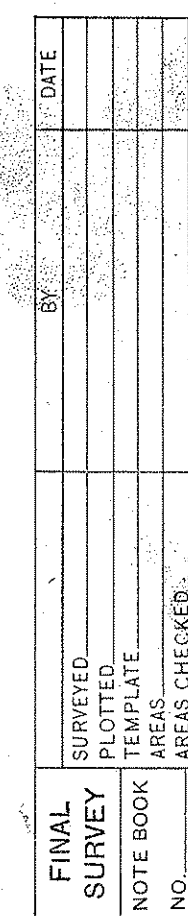


PLATE 3—CROSS SECTION O. P. R. & R. E. STANDARD
KEUFFEL & ESSER CO., NEW YORK.

4341.11

434

Show Shipped

FED. ROAD DIST. NO.	STATE	FED. AID PROJ. NO.	FISCAL YEAR	SHEET NO.	TOTAL SHEETS
HAWAII	HAWAII	W. 2711	1955	12	14

FINAL SURVEY	DATE	BY
SURVEYED		
PLOTTED		
NOTE BOOK		
AREAS CHECKED		

ORIGINAL SURVEY	DATE	BY
SURVEYED		
PLOTTED		
NOTE BOOK		
AREAS CHECKED		

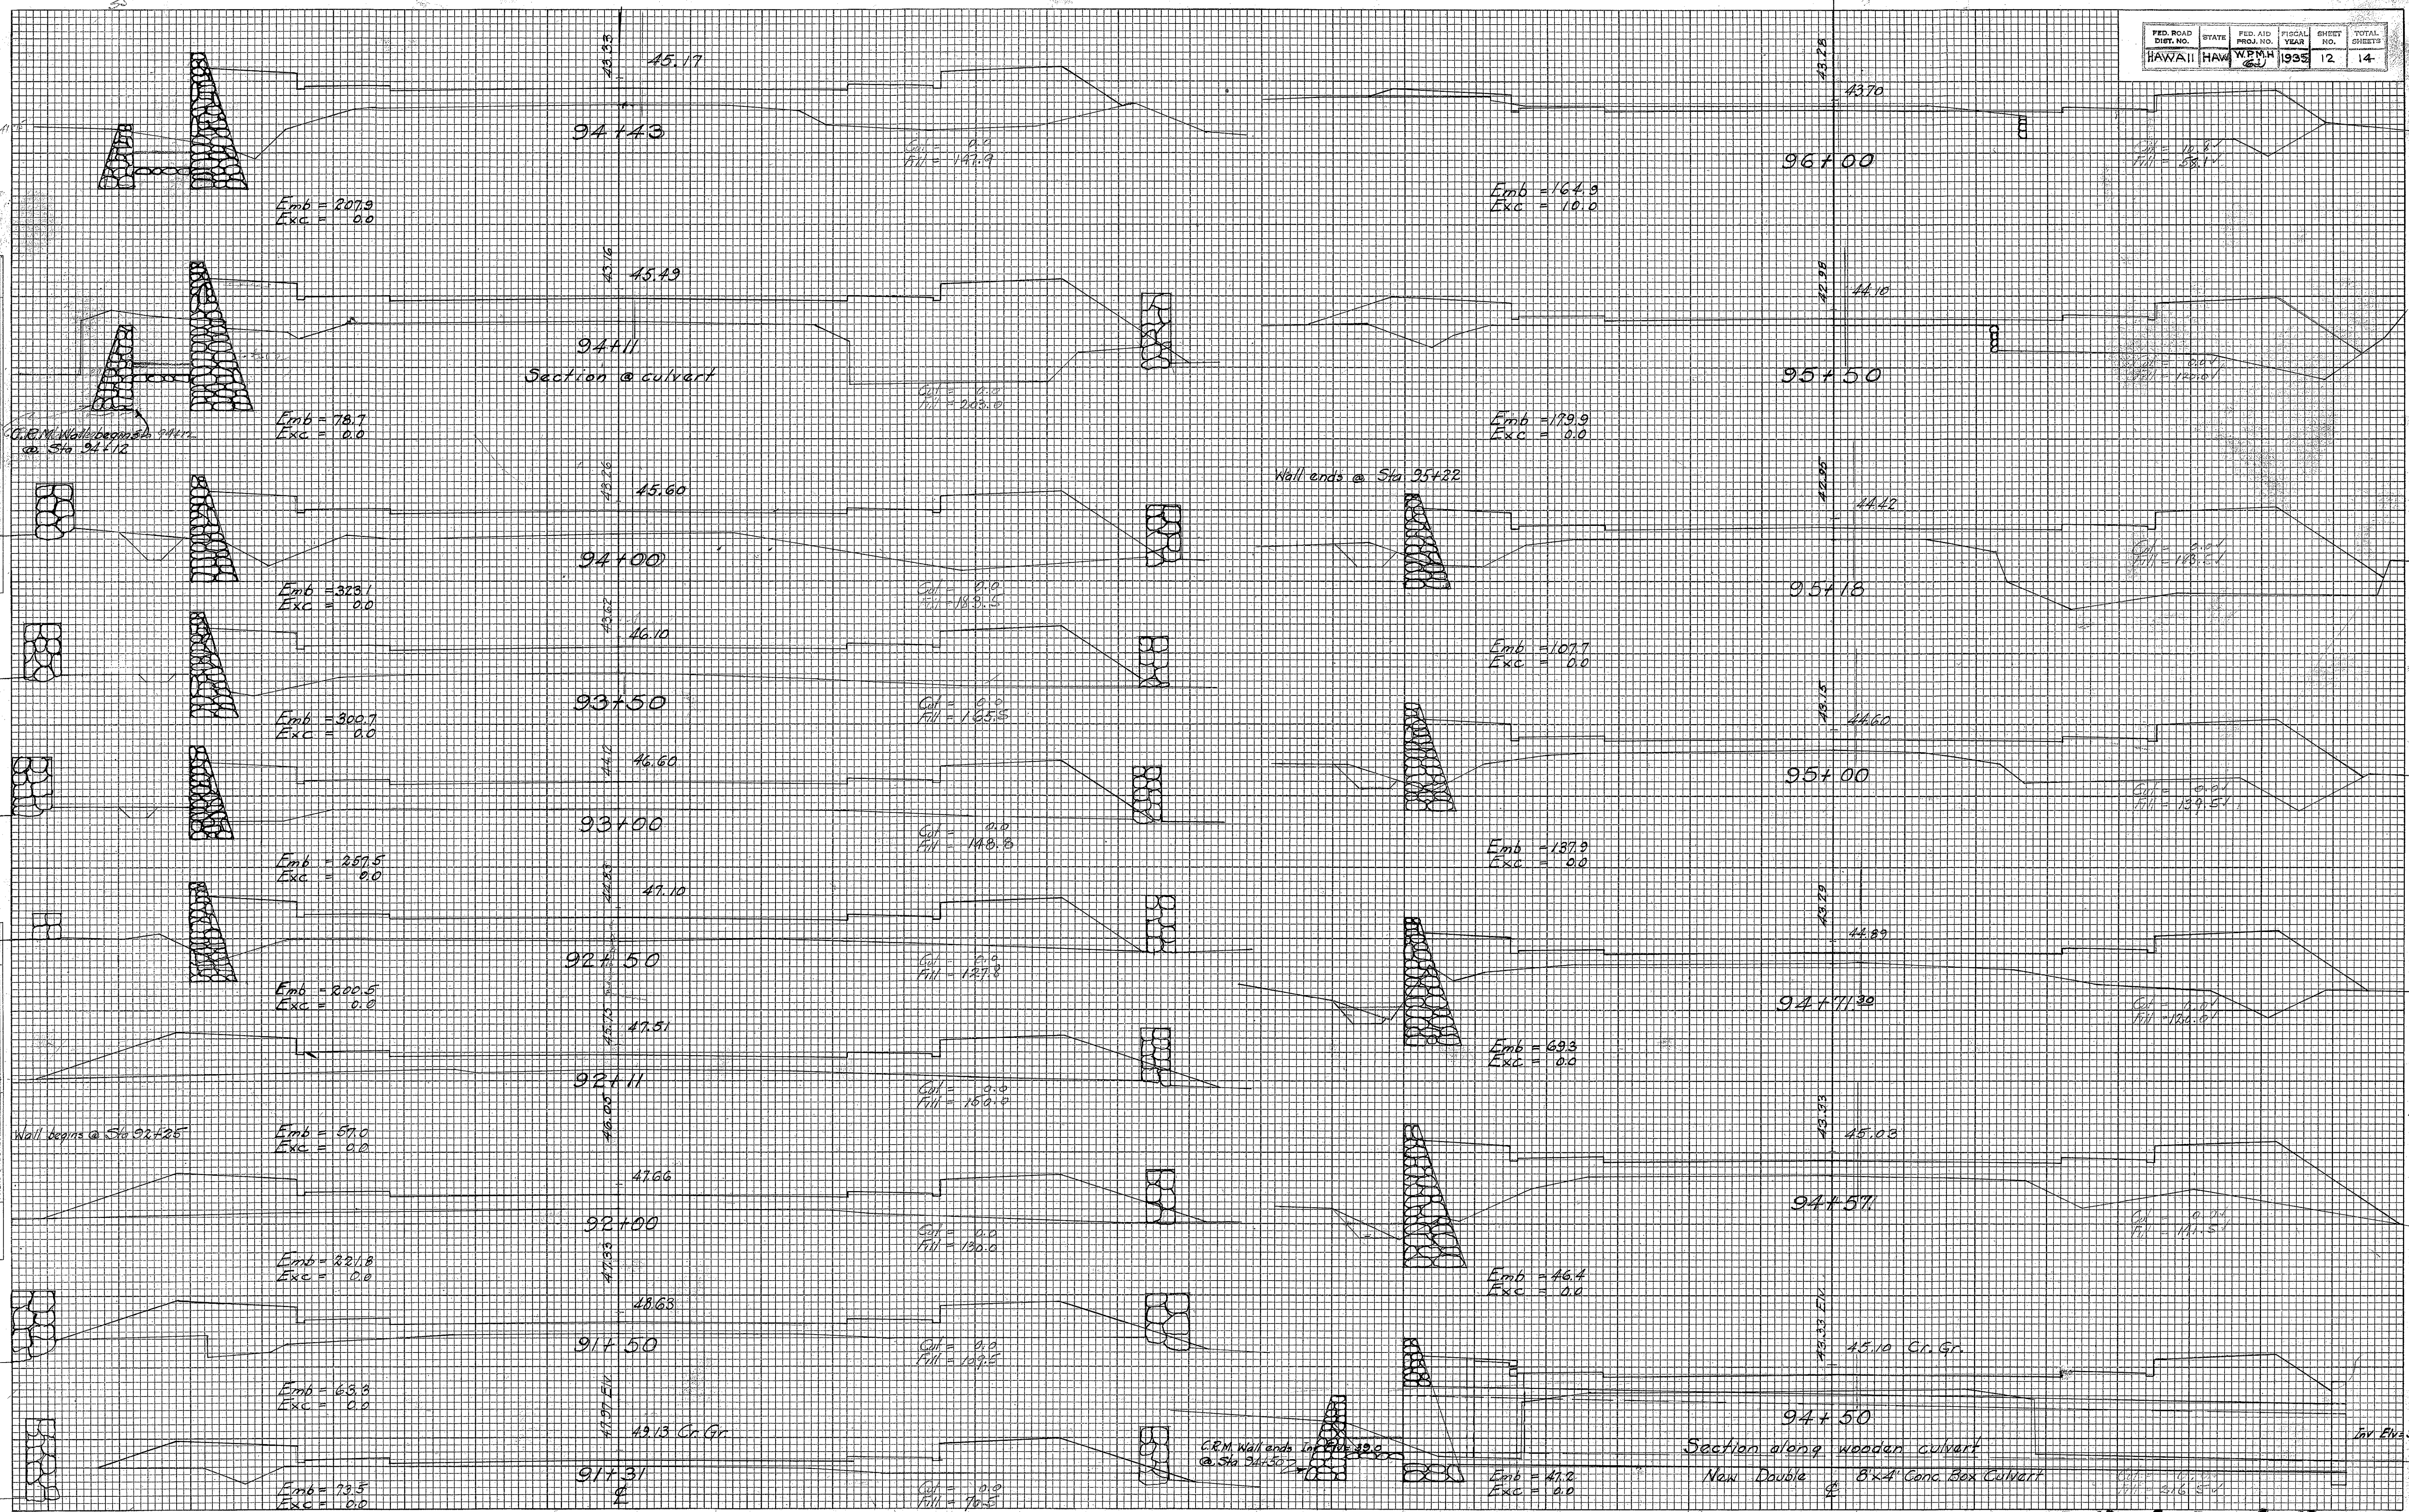



PLATE 3 - CROSS SECTION O. P. R. & R. E. STANDARD
KEUFFEL & ESSER CO. NEW YORK.

Change in 1060

4341.12

4381

ORIGINAL SURVEY	SURVEYED	BY	DATE
NOTE BOOK	PLOTTED		
	TEMPERATURE		
	AREAS		
	AREAS CHECKED		
NO. _____			

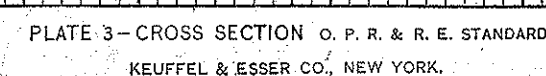

4341.13³⁰

FINAL SURVEY	DATE	BY
NOTE BOOK NO.		
AREAS CHECKED		

ORIGINAL SURVEY	DATE	BY
NOTE BOOK NO.		
AREAS CHECKED		

