



FED. ROAD DIST. NO.	STATE	FED. AID PROJ. NO.	FISCAL YEAR	SHEET NO.	TOTAL SHEETS
HAWAII	HAW.	STP-8930(1)	2004	141	144

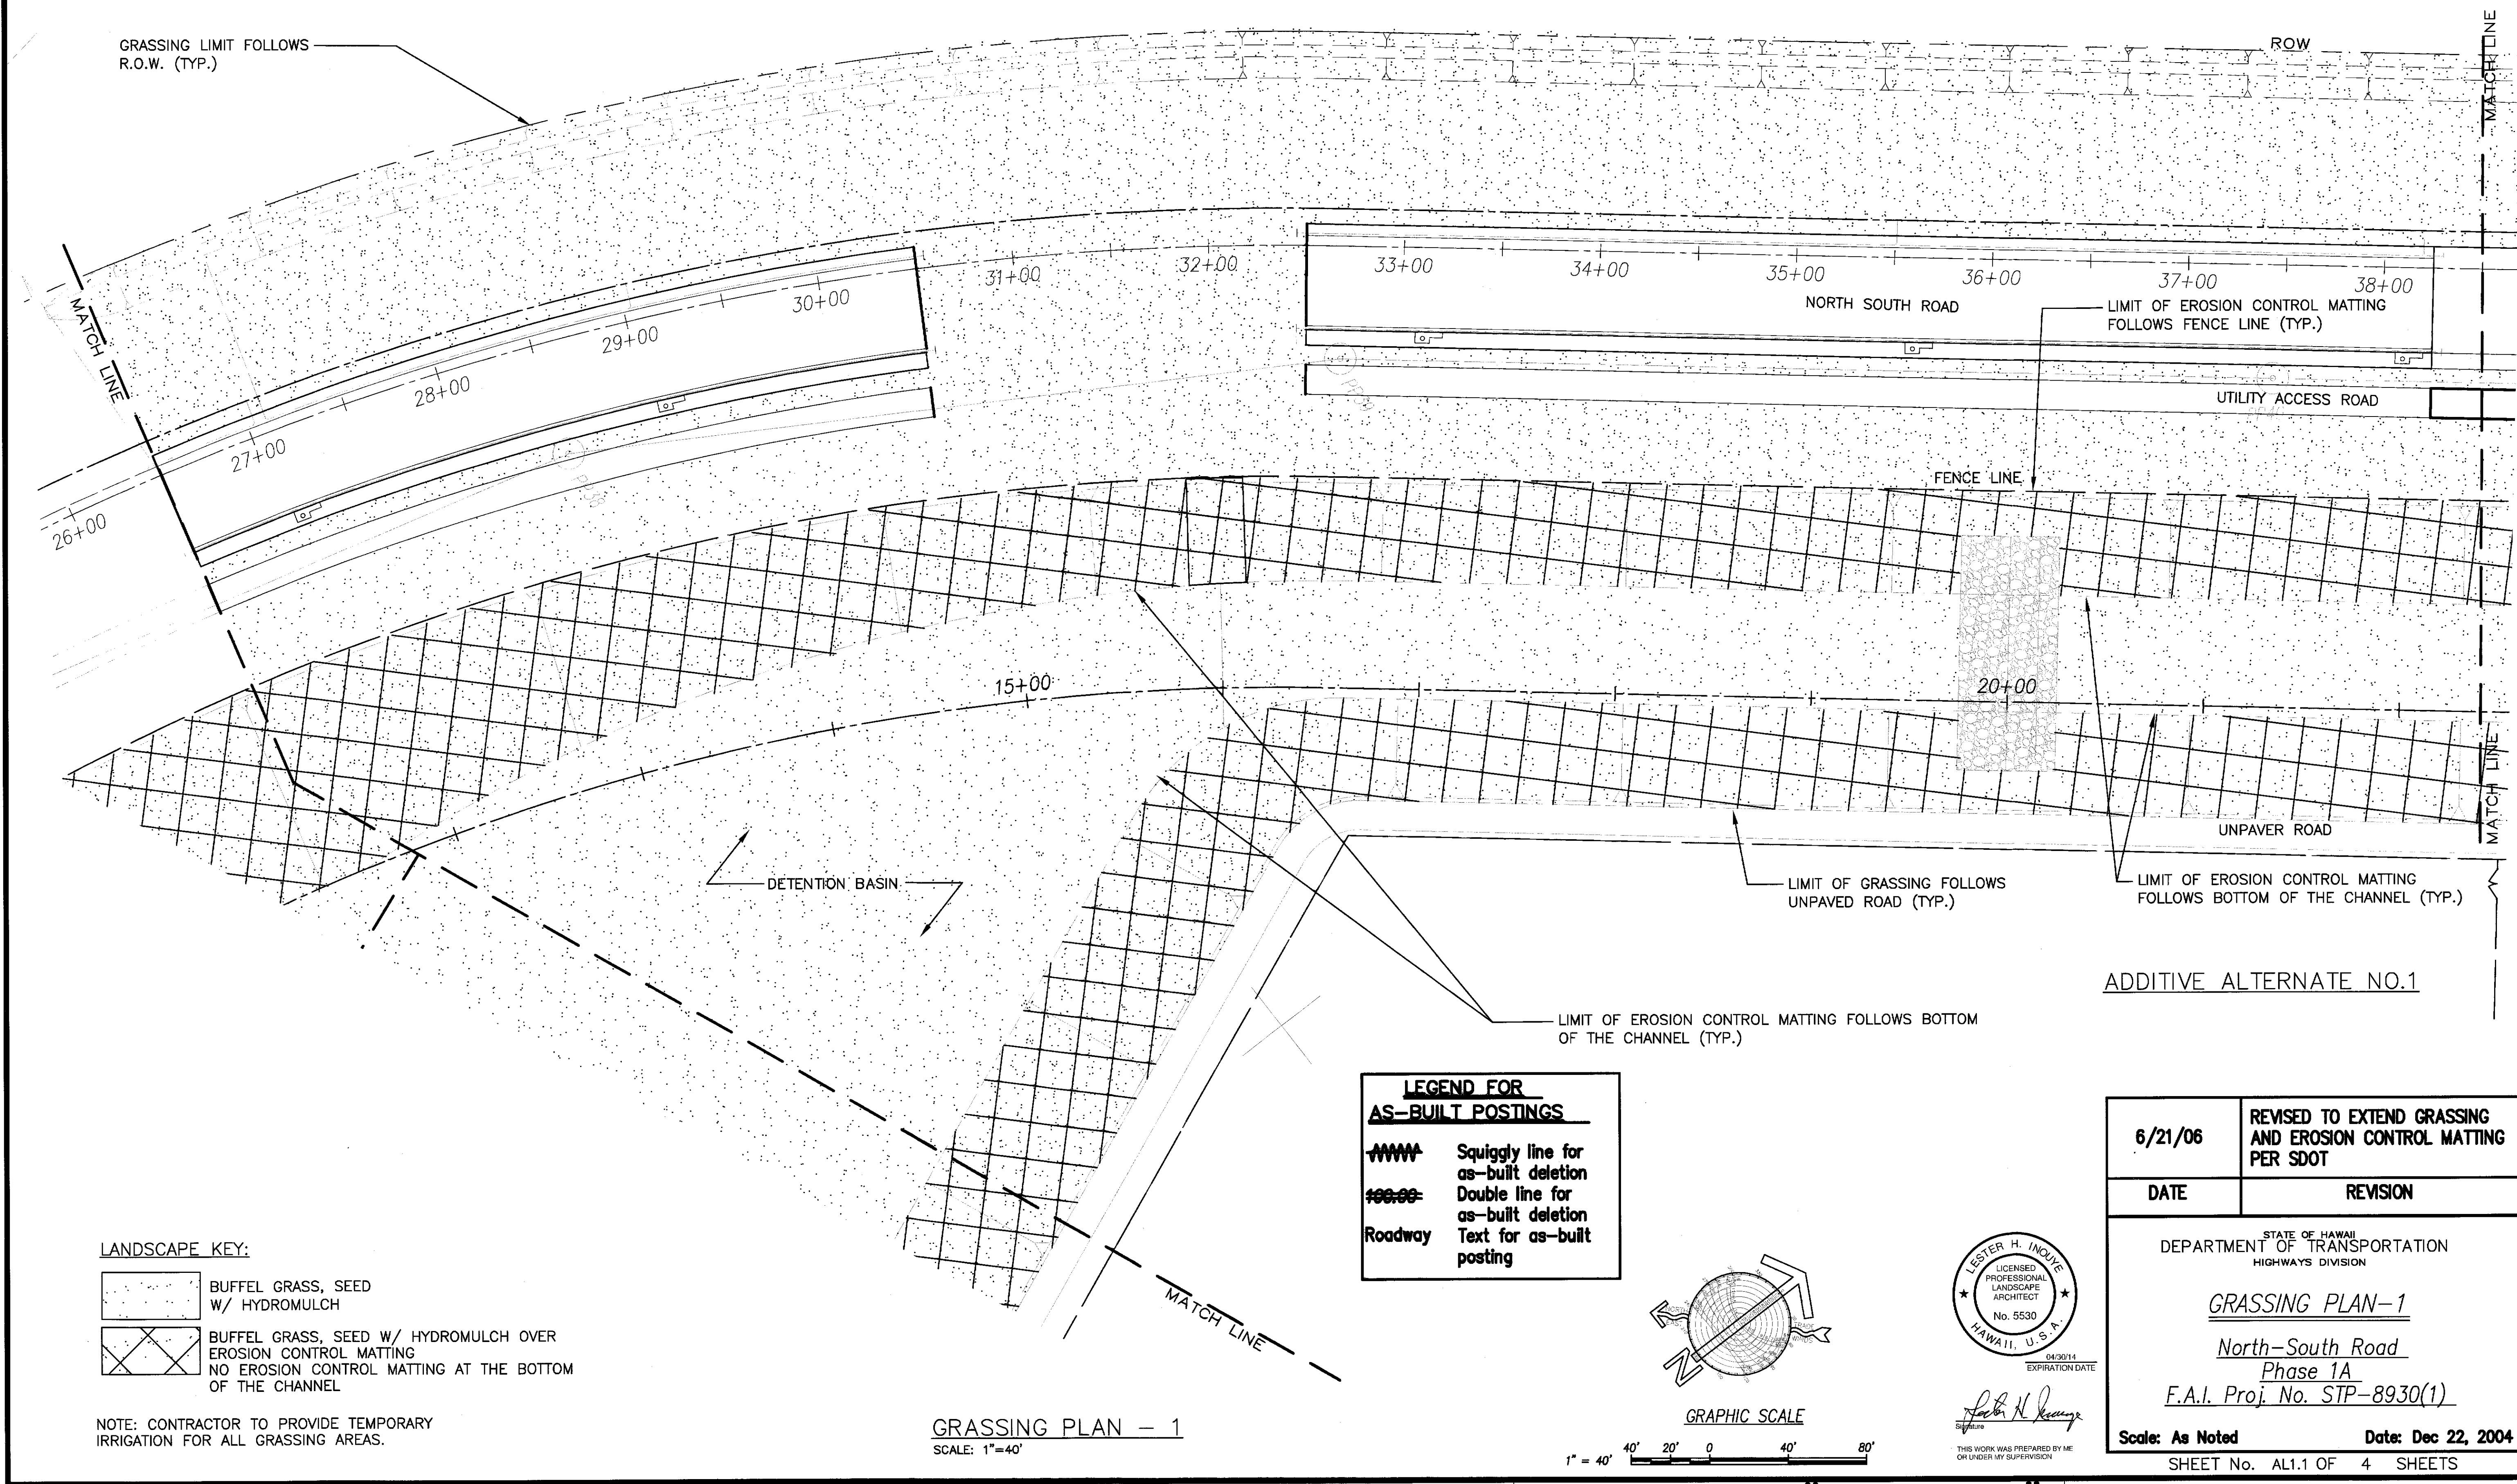

SURVEY PLOTTED BY	DATE
DRAWN BY	
TRACED BY	
NOTES BOOK	
QUANTITIES BY	
CHECKED BY	
No.	

FED. ROAD DIST. NO.	STATE	FED. AID PROJ. NO.	FISCAL YEAR	SHEET NO.	TOTAL SHEETS
HAWAII	HAW.	STP-8930(1)	2004	142	144

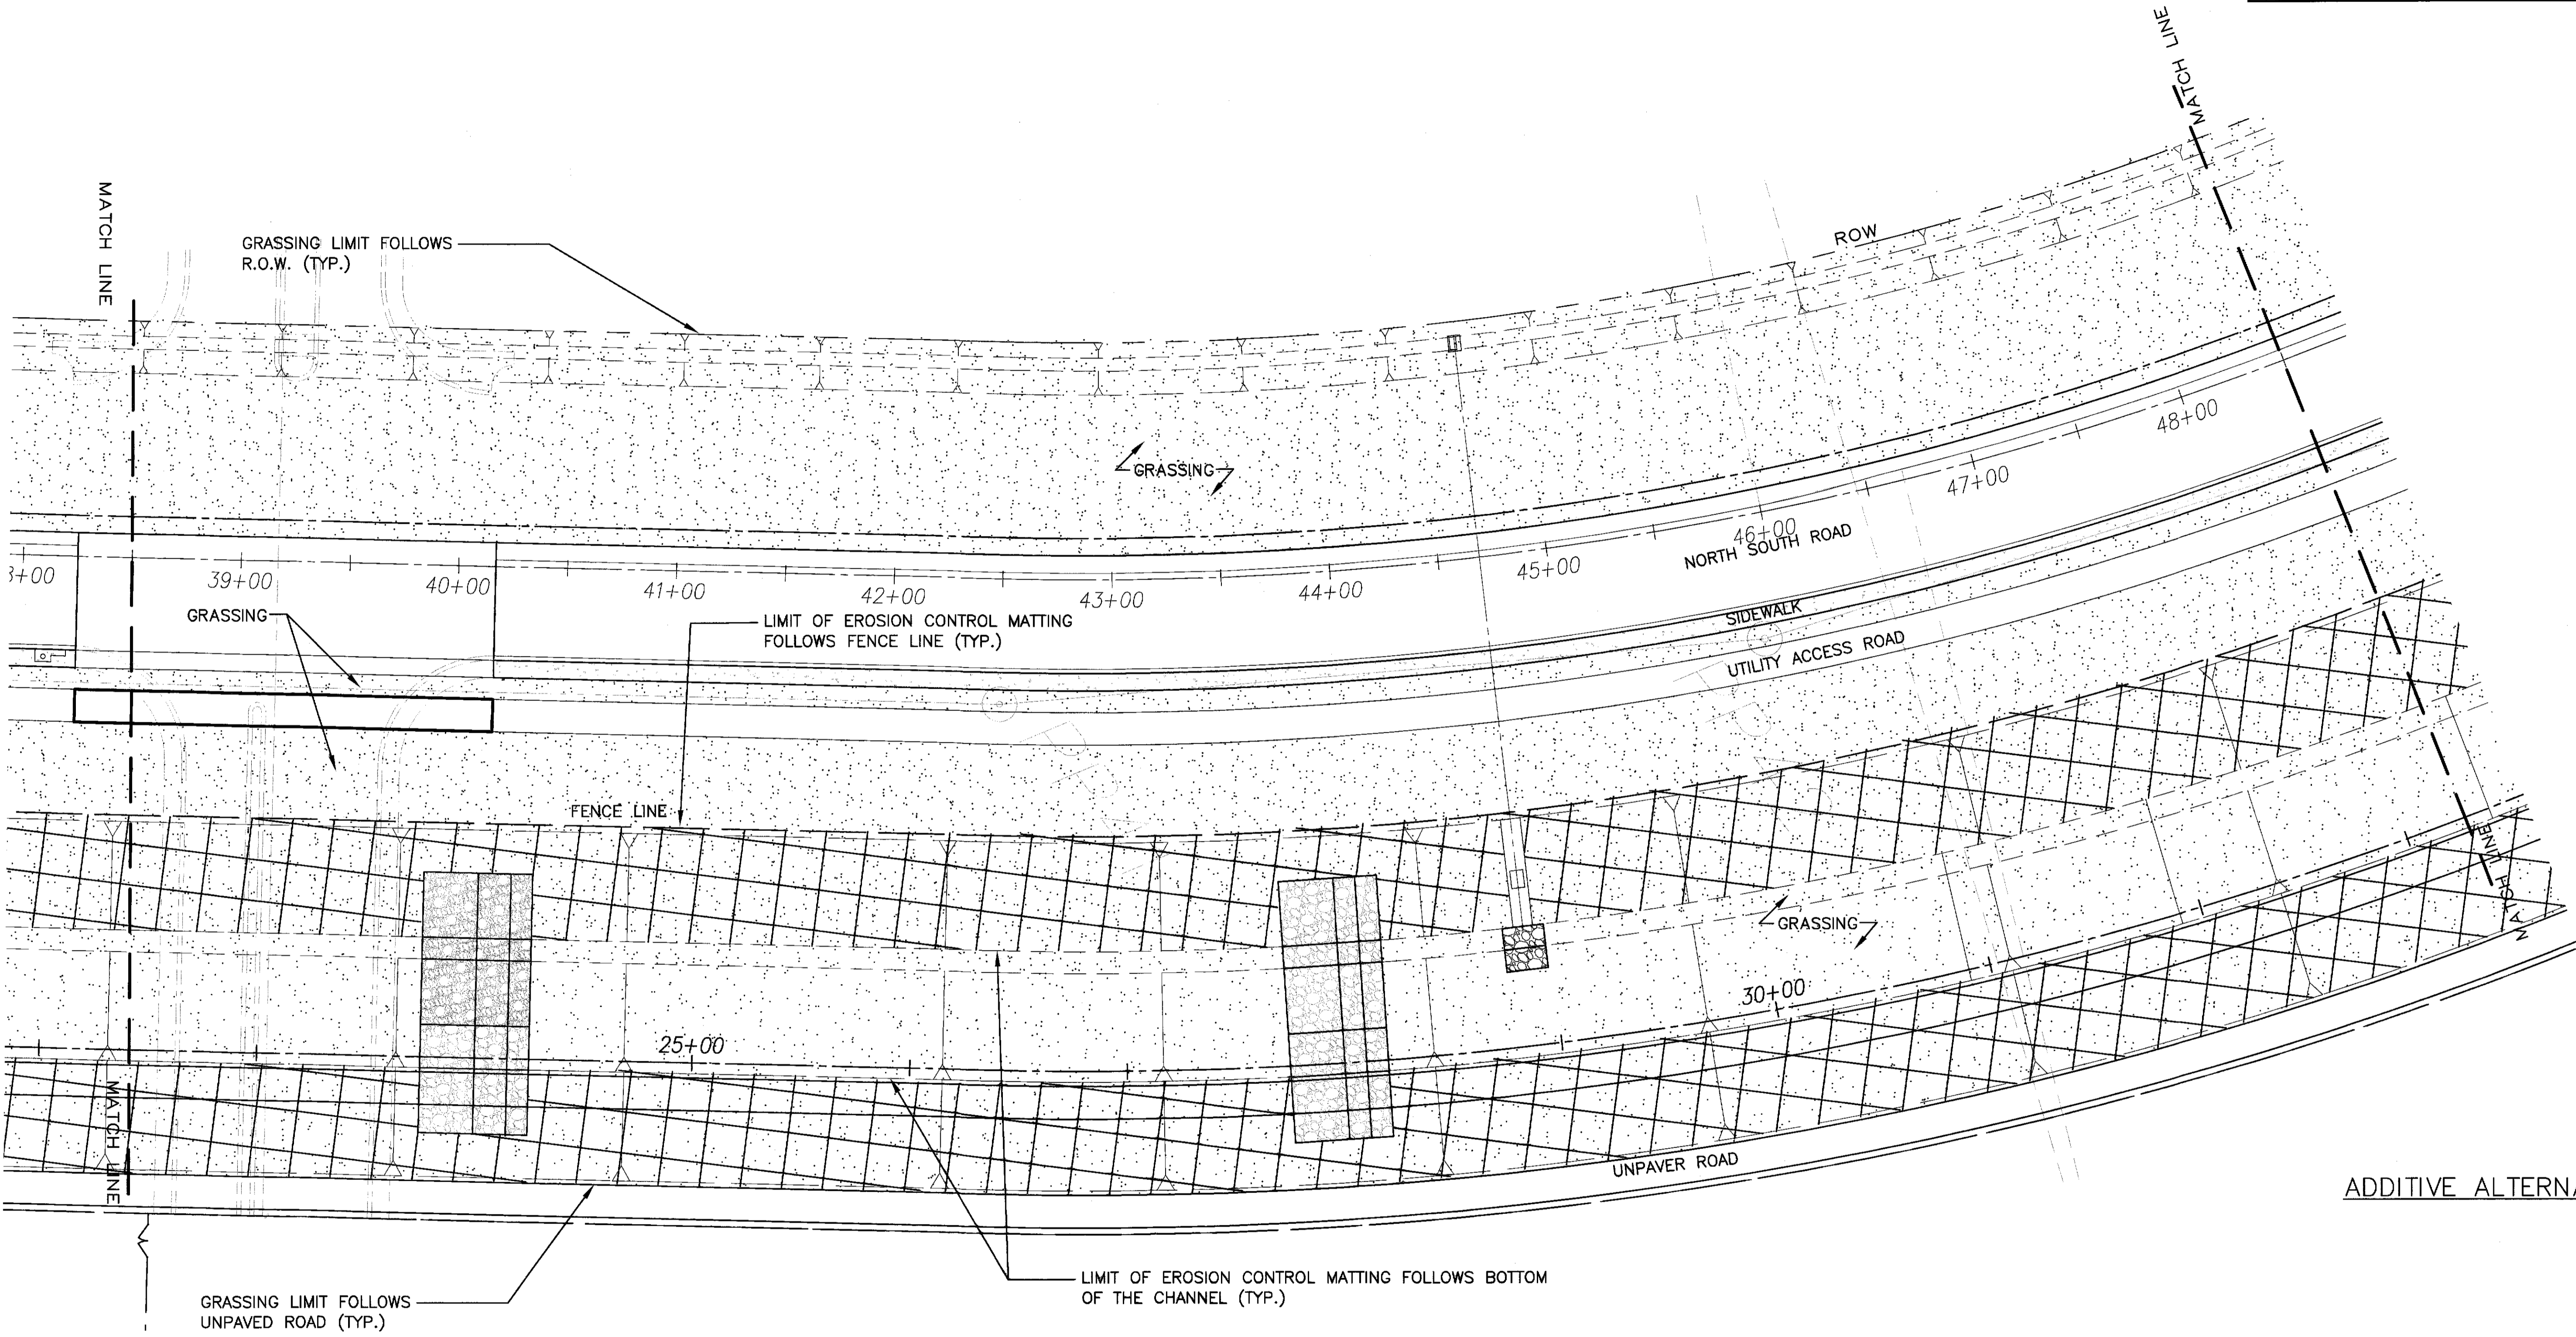

ADDITIVE ALTERNATE NO.1

SURVEY PLANNED BY	DATE
DRAWN BY	
NOTED BY	
CHECKED BY	
ORIGINAL PLAN	
NOTE BOOK	
No.	

LANDSCAPE KEY:

	BUFFEL GRASS, SEED W/ HYDROMULCH
	BUFFEL GRASS, SEED W/ HYDROMULCH OVER EROSION CONTROL MATTING
	NO EROSION CONTROL MATTING AT THE BOTTOM OF THE CHANNEL

NOTE: CONTRACTOR TO PROVIDE TEMPORARY IRRIGATION FOR ALL GRASSING AREAS.


GRASSING PLAN - 2
SCALE: 1"=40'

LEGEND FOR AS-BUILT POSTINGS

Squiggly line for as-built deletion

Double line for as-built deletion

Text for as-built posting

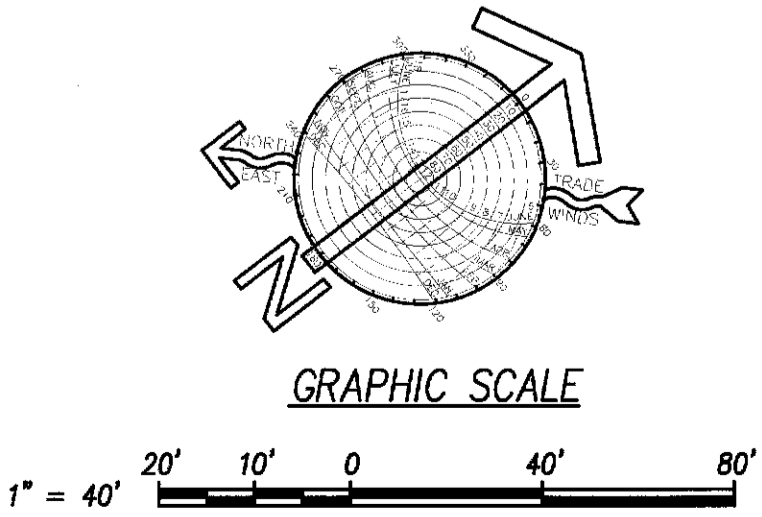

LESTER H. INOUE
LICENSED PROFESSIONAL LANDSCAPE ARCHITECT
No. 5530
HAWAII, U.S.A.
04/20/14
EXPIRATION DATE

Lester H. Inoue
Signature

THIS WORK WAS PREPARED BY ME ON UNDER MY SUPERVISION


STATE OF HAWAII
DEPARTMENT OF TRANSPORTATION
HIGHWAYS DIVISION

GRASSING PLAN-2
North-South Road
Phase 1A
F.A.I. Proj. No. STP-8930(1)

Scale: As Noted Date: Dec 22, 2004

SHEET No. AL1.2 OF 4 SHEETS

FED. ROAD DIST. NO.	STATE	FED. AID PROJ. NO.	FISCAL YEAR	SHEET NO.	TOTAL SHEETS
HAWAII	HAW.	STP-8930(1)	2004	143	144

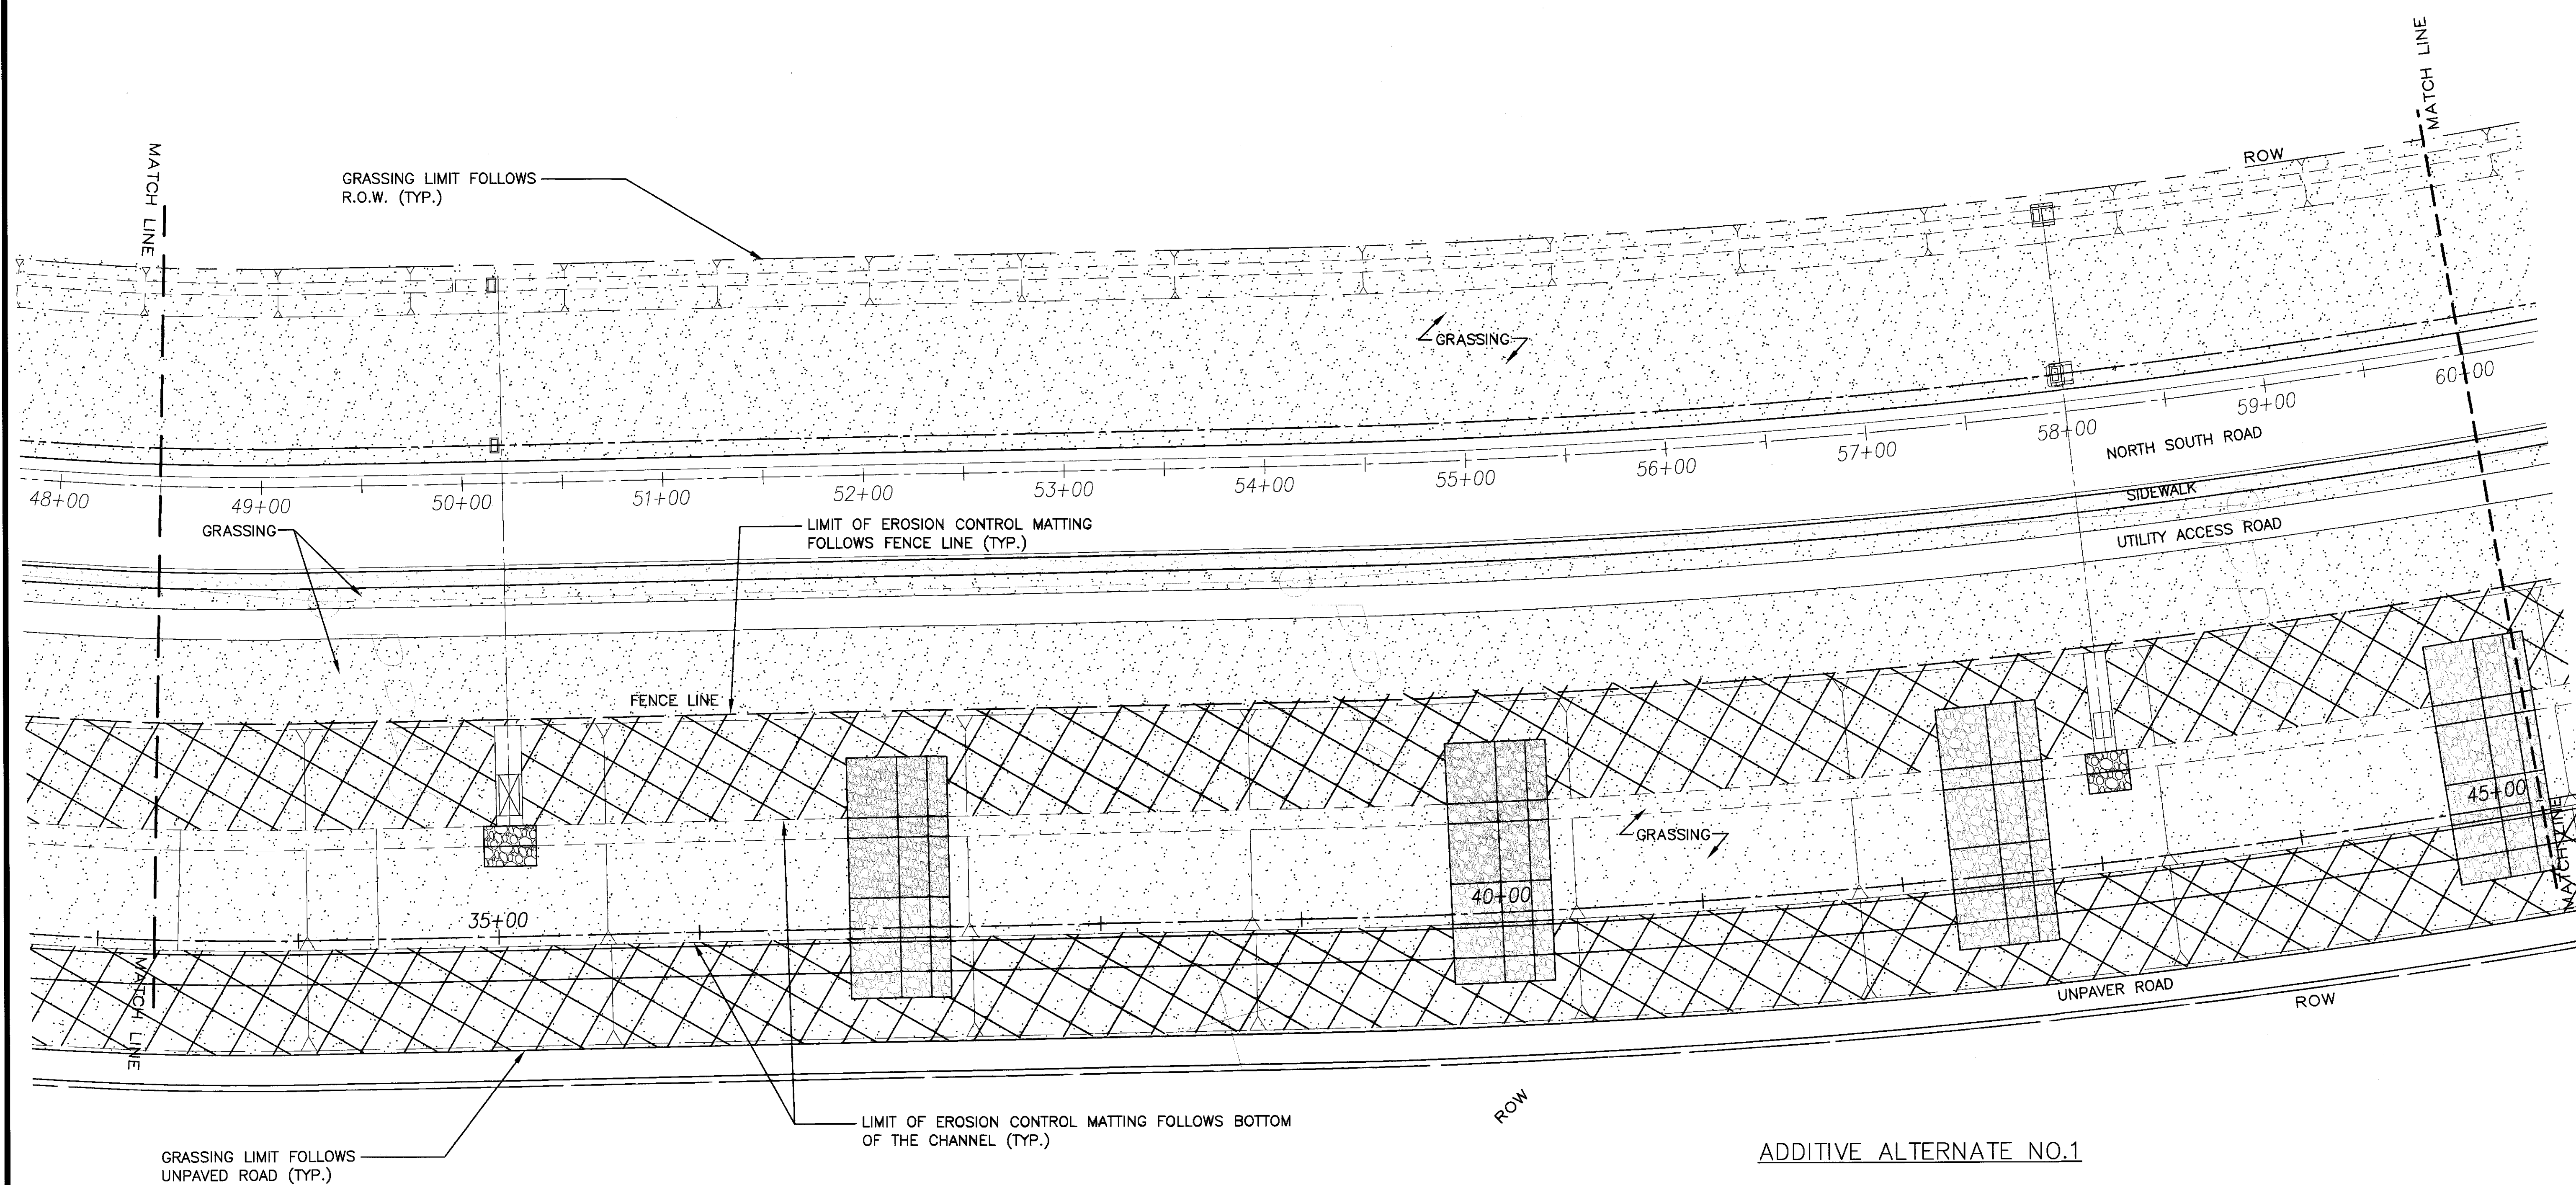

DATE	_____
SURVEY PLOTTED BY	_____
DESIGNED BY	_____
NOTED BY	_____
CHECKED BY	_____
ORIGINAL PLAN	_____
NOTE BOOK	_____
No.	_____

- LANDSCAPE KEY:
- BUFFEL GRASS, SEED W/ HYDROMULCH
 - BUFFEL GRASS, SEED W/ HYDROMULCH OVER EROSION CONTROL MATTING
 - NO EROSION CONTROL MATTING AT THE BOTTOM OF THE CHANNEL

NOTE: CONTRACTOR TO PROVIDE TEMPORARY IRRIGATION FOR ALL GRASSING AREAS.


GRASSING PLAN - 3
SCALE: 1"=40'

LEGEND FOR AS-BUILT POSTINGS

Squiggly line for as-built deletion

Double line for as-built deletion

Text for as-built posting

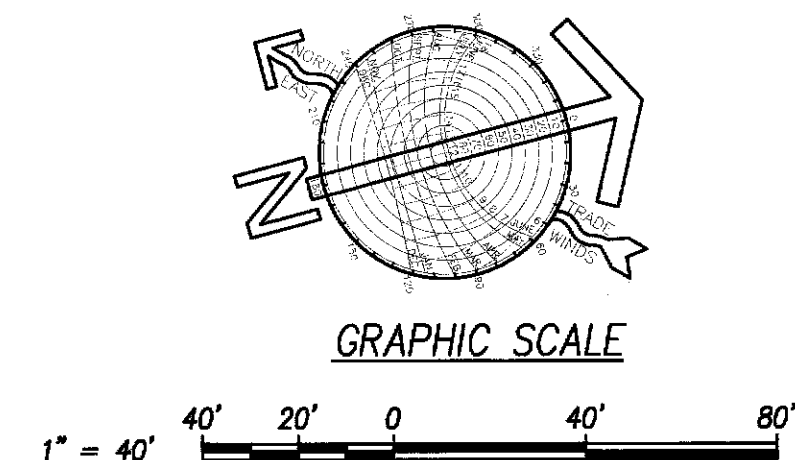

LESTER H. INOUE
LICENSED PROFESSIONAL LANDSCAPE ARCHITECT
No. 5530
HAWAII, U.S.A.
04/20/14
EXPIRATION DATE

Lester H. Inoue

THIS WORK WAS PREPARED BY ME OR UNDER MY SUPERVISION

STATE OF HAWAII
DEPARTMENT OF TRANSPORTATION
HIGHWAYS DIVISION


GRASSING PLAN-3

North-South Road
Phase 1A
F.A.I. Proj. No. STP-8930(1)

Scale: As Noted Date: Dec 22, 2004

SHEET No. AL1.3 OF 4 SHEETS

FED. ROAD DIST. NO.	STATE	FED. AID PROJ. NO.	FISCAL YEAR	SHEET NO.	TOTAL SHEETS
HAWAII	HAW.	STP-8930(1)	2004	144	144

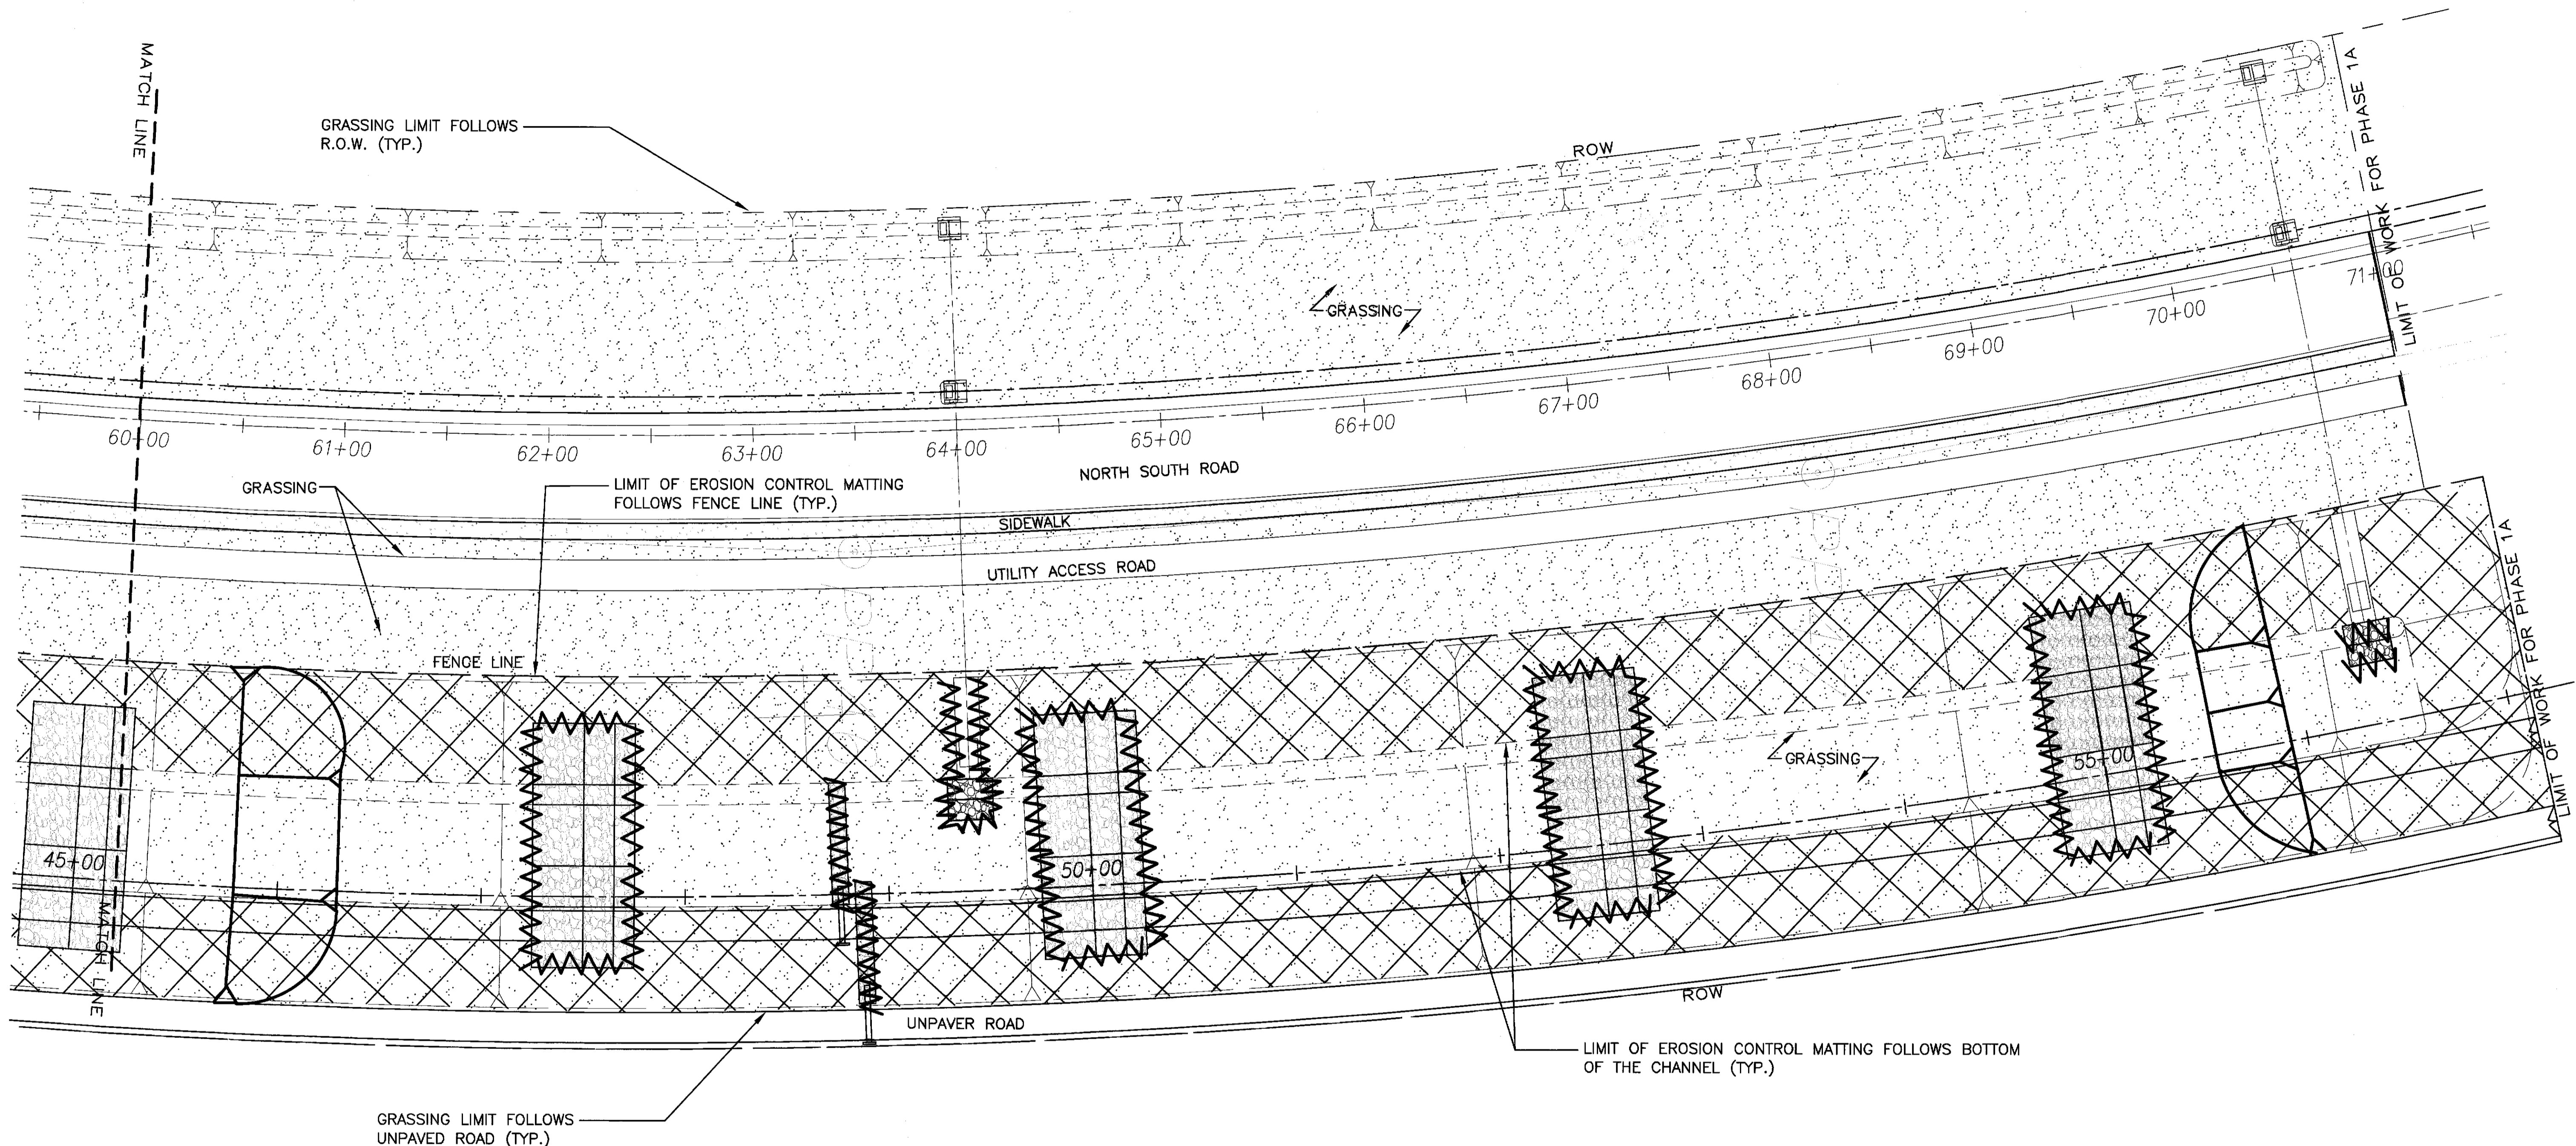

ADDITIVE ALTERNATE NO.1



LEGEND FOR AS-BUILT POSTINGS	
	Squiggly line for as-built deletion
	Double line for as-built deletion
	Text for as-built posting

EROSION CONTROL MATTING AS WELL AS DRAINAGE CHANNEL EXCAVATION, FILTER ROCK BERMS, GRP APRONS AND CULVERT F OUTLET DELETED IN THIS AREA

LANDSCAPE KEY:	
	BUFFEL GRASS, SEED W/ HYDROMULCH
	BUFFEL GRASS, SEED W/ HYDROMULCH OVER EROSION CONTROL MATTING
	NO EROSION CONTROL MATTING AT THE BOTTOM OF THE CHANNEL

NOTE: CONTRACTOR TO PROVIDE TEMPORARY IRRIGATION FOR ALL GRASSING AREAS.

GRASSING PLAN - 4
SCALE: 1"=40'

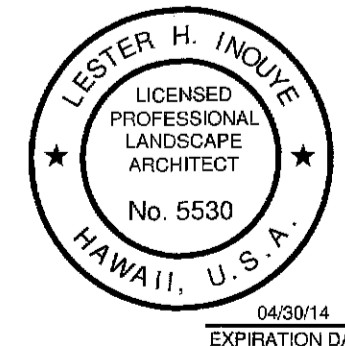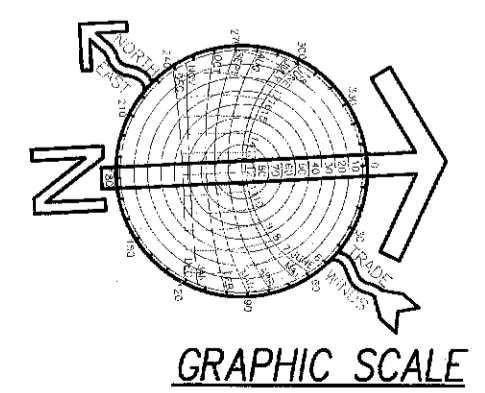

-/-	FIELD ORDER 7
DATE	REVISION
STATE OF HAWAII DEPARTMENT OF TRANSPORTATION HIGHWAYS DIVISION GRASSING PLAN-4 North-South Road Phase 1A F.A.I. Proj. No. STP-8930(1)	
Scale: As Noted	Date: Dec 22, 2004
SHEET No. L1.4 OF 4 SHEETS	

SURVEY PLATTED BY	DATE
DRAWN BY	
DESIGNED BY	
QUANTITIES BY	
CHECKED BY	
ORIGINAL PLAN	
NOTE BOOK	
No.	