


FED. ROAD DIST. NO.	STATE	FED. AID PROJ. NO.	FISCAL YEAR	SHEET NO.	TOTAL SHEETS
HAWAII	HAW.	STP-8930(1)	2005	ADD. 65	144

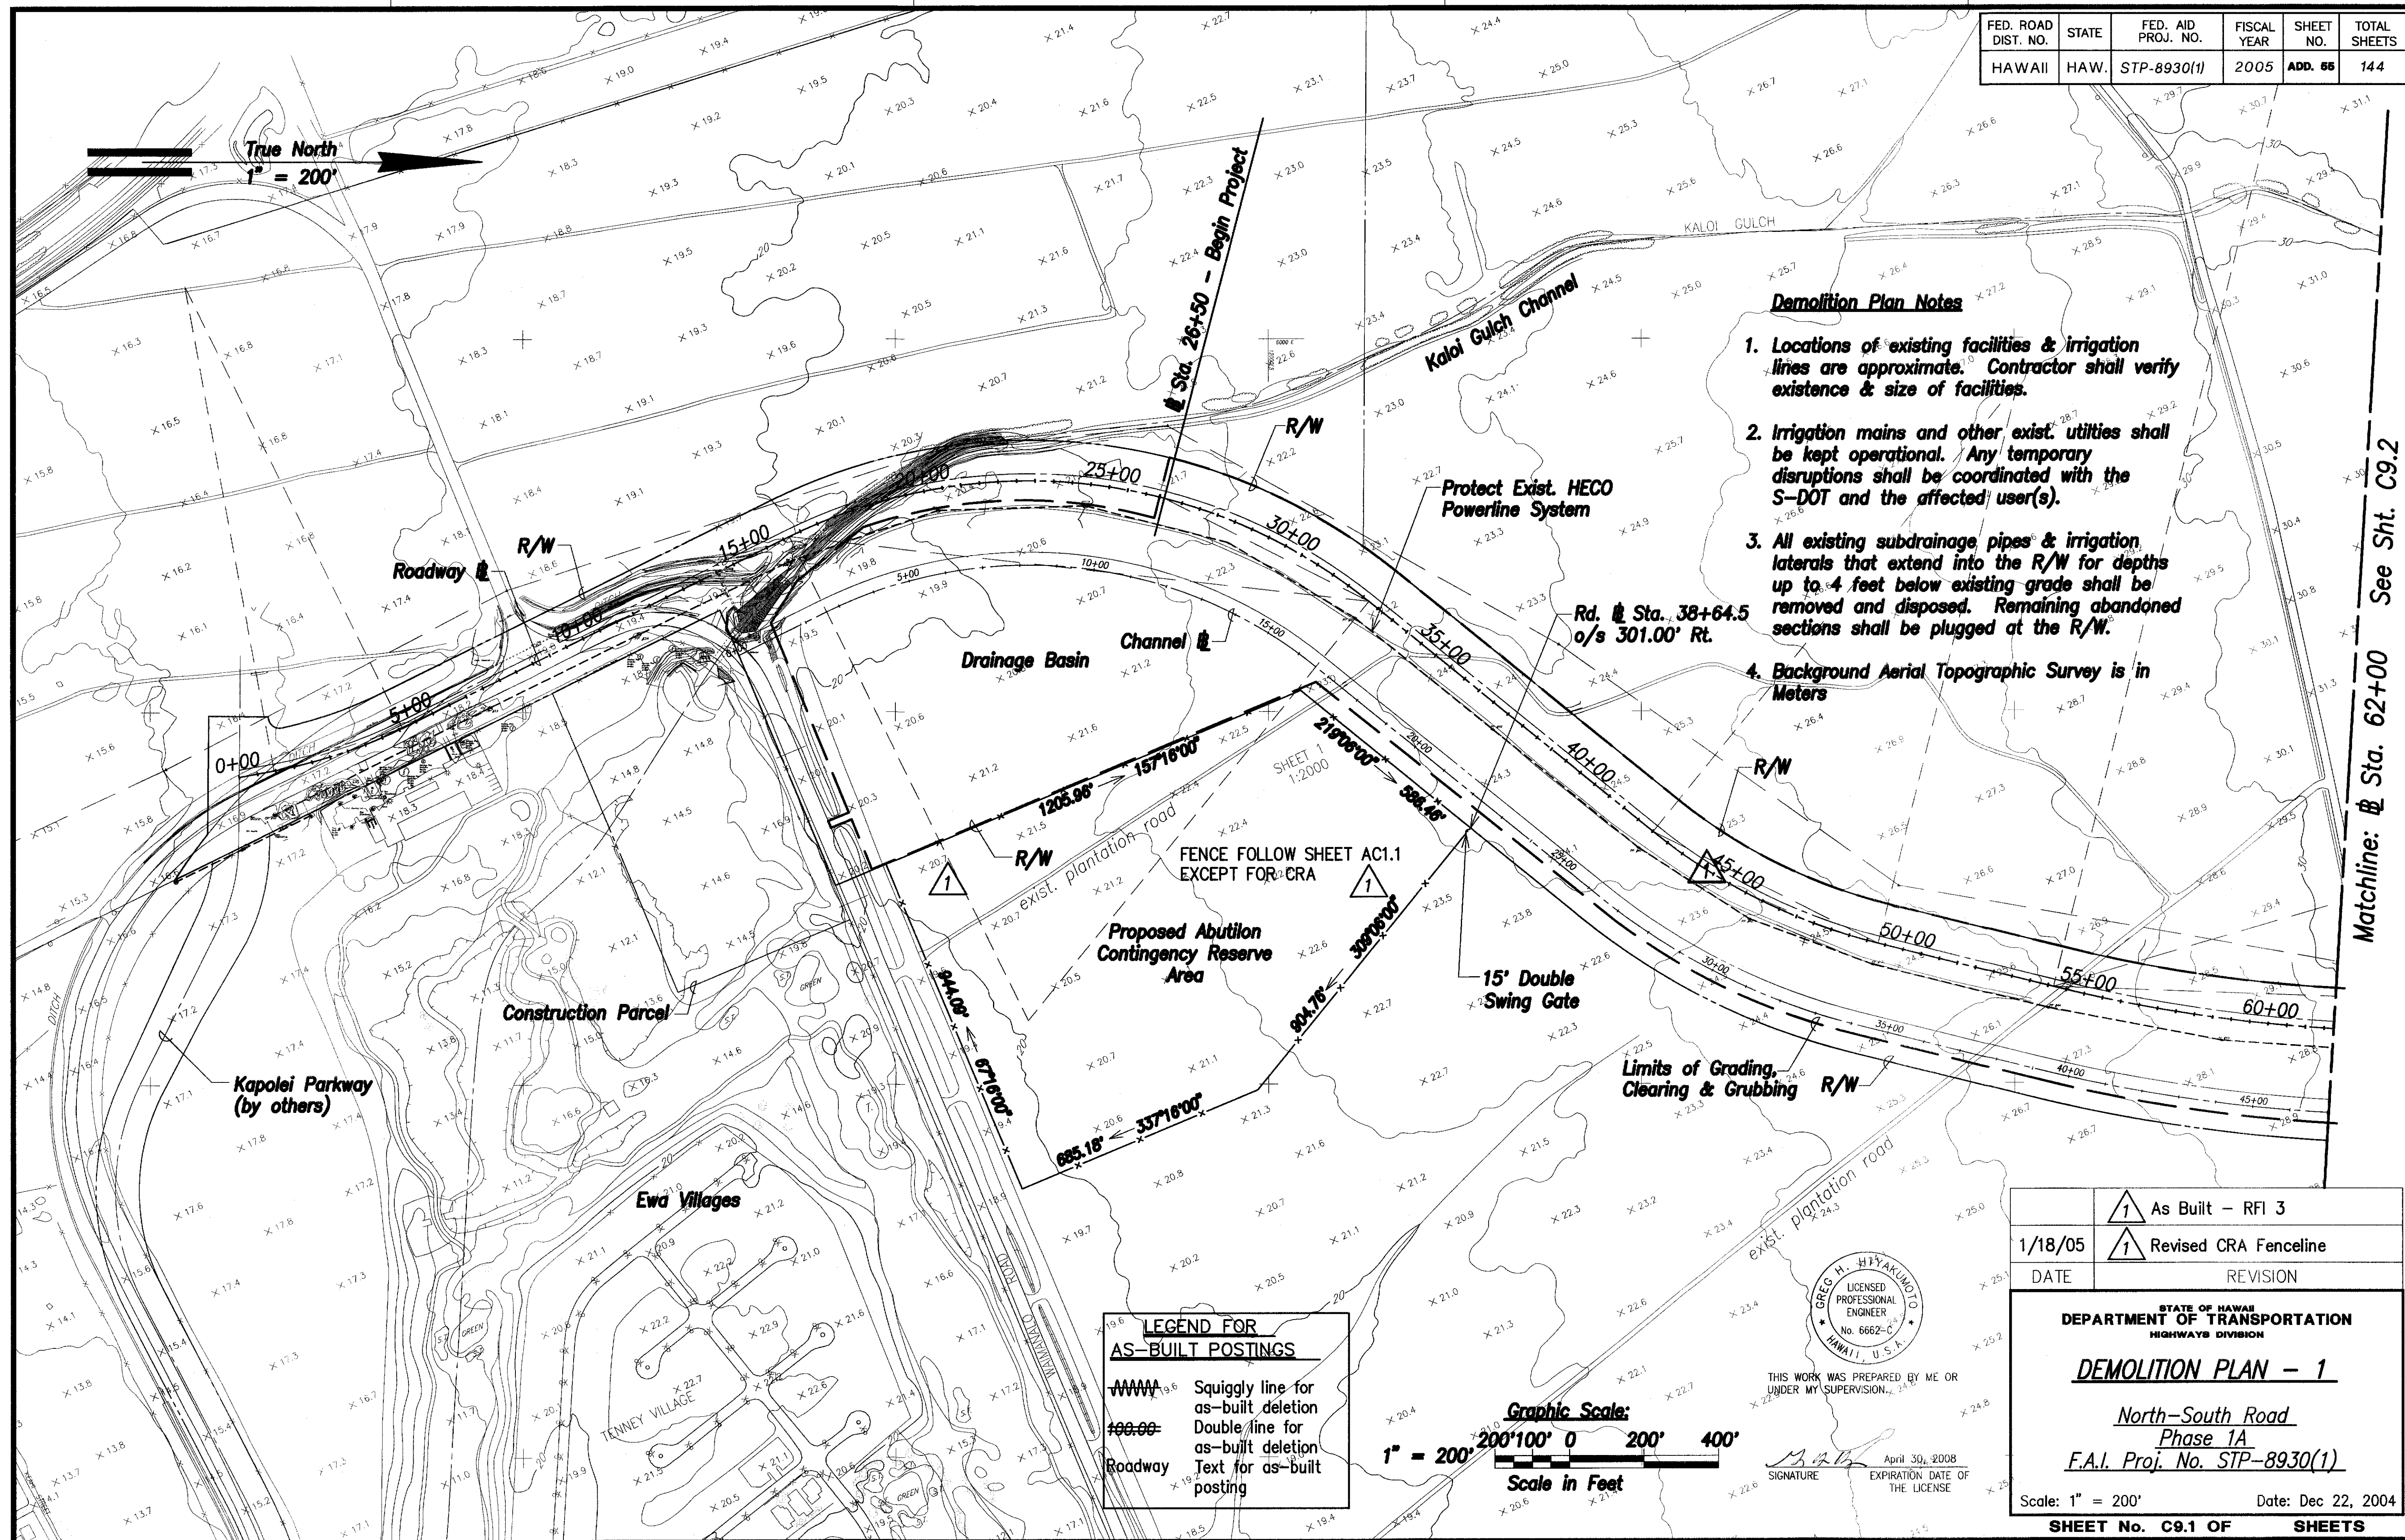

DATE	_____
SURVEY PLOTTED BY	_____
DESIGNED BY	_____
NOTED BY	_____
CHECKED BY	_____

1	As Built - RFI 3
1/18/05	1 Revised CRA Fenceline
DATE	REVISION


STATE OF HAWAII
DEPARTMENT OF TRANSPORTATION
HIGHWAYS DIVISION

DEMOLITION PLAN - 1

North-South Road
Phase 1A
F.A.I. Proj. No. STP-8930(1)

Scale: 1" = 200' Date: Dec 22, 2004

SHEET No. C9.1 OF SHEETS


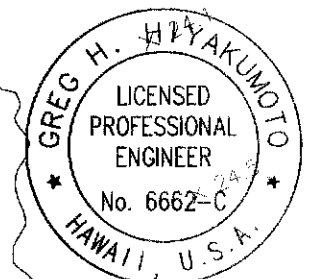


THIS WORK WAS PREPARED BY ME OR UNDER MY SUPERVISION.

SIGNATURE _____

April 30, 2008
EXPIRATION DATE OF THE LICENSE

FED. ROAD DIST. NO.	STATE	FED. AID PROJ. NO.	FISCAL YEAR	SHEET NO.	TOTAL SHEETS
HAWAII	HAW.	STP-8930(1)	2005	56	144

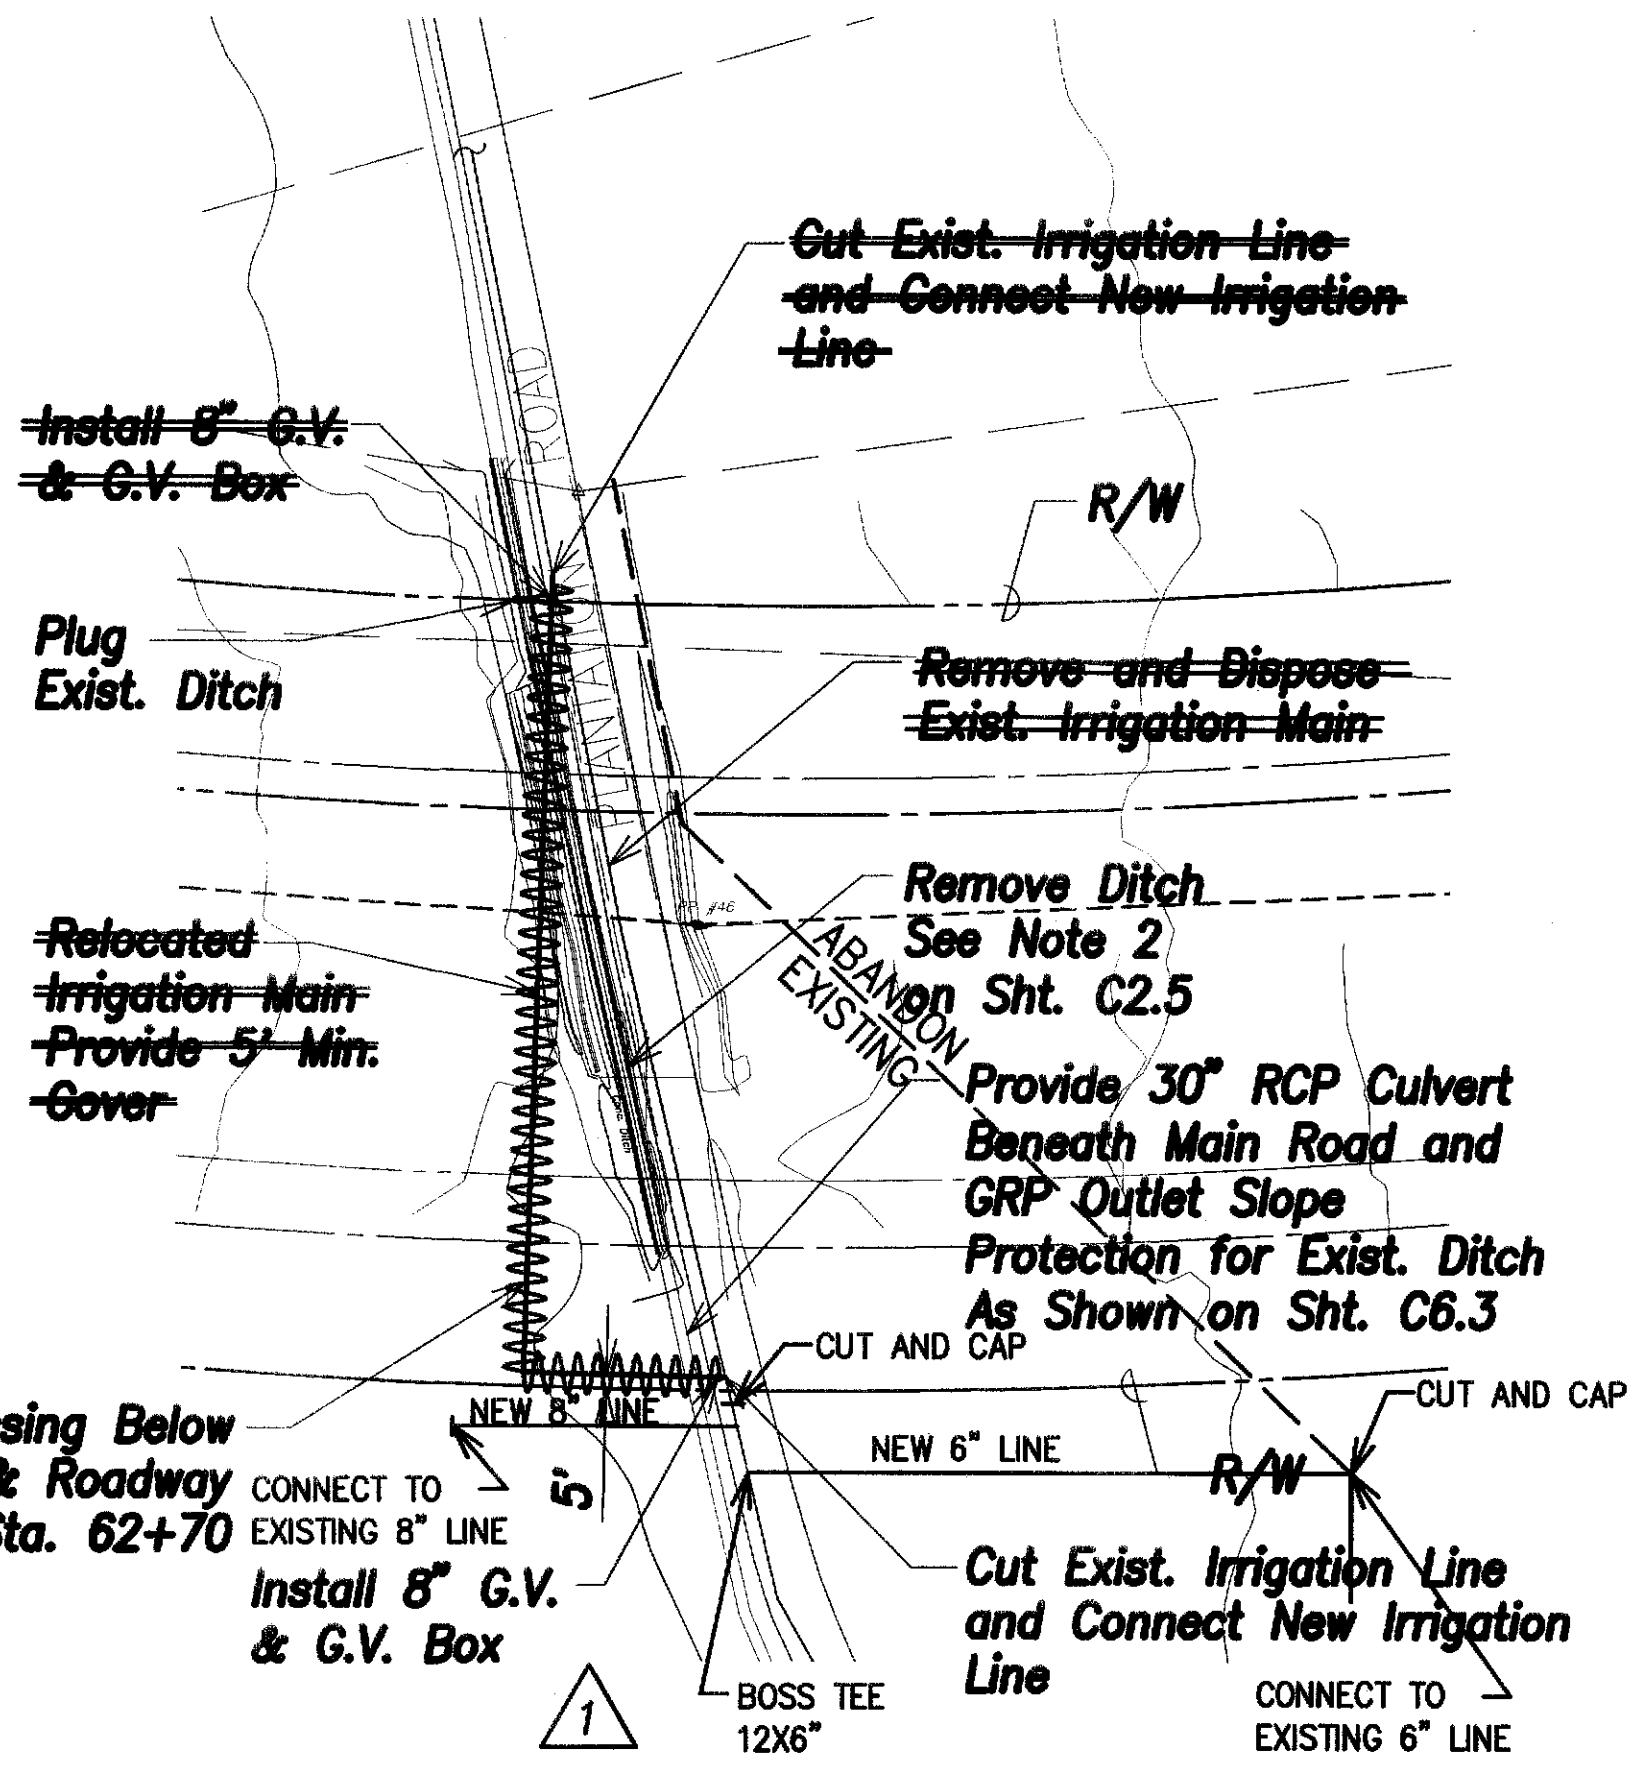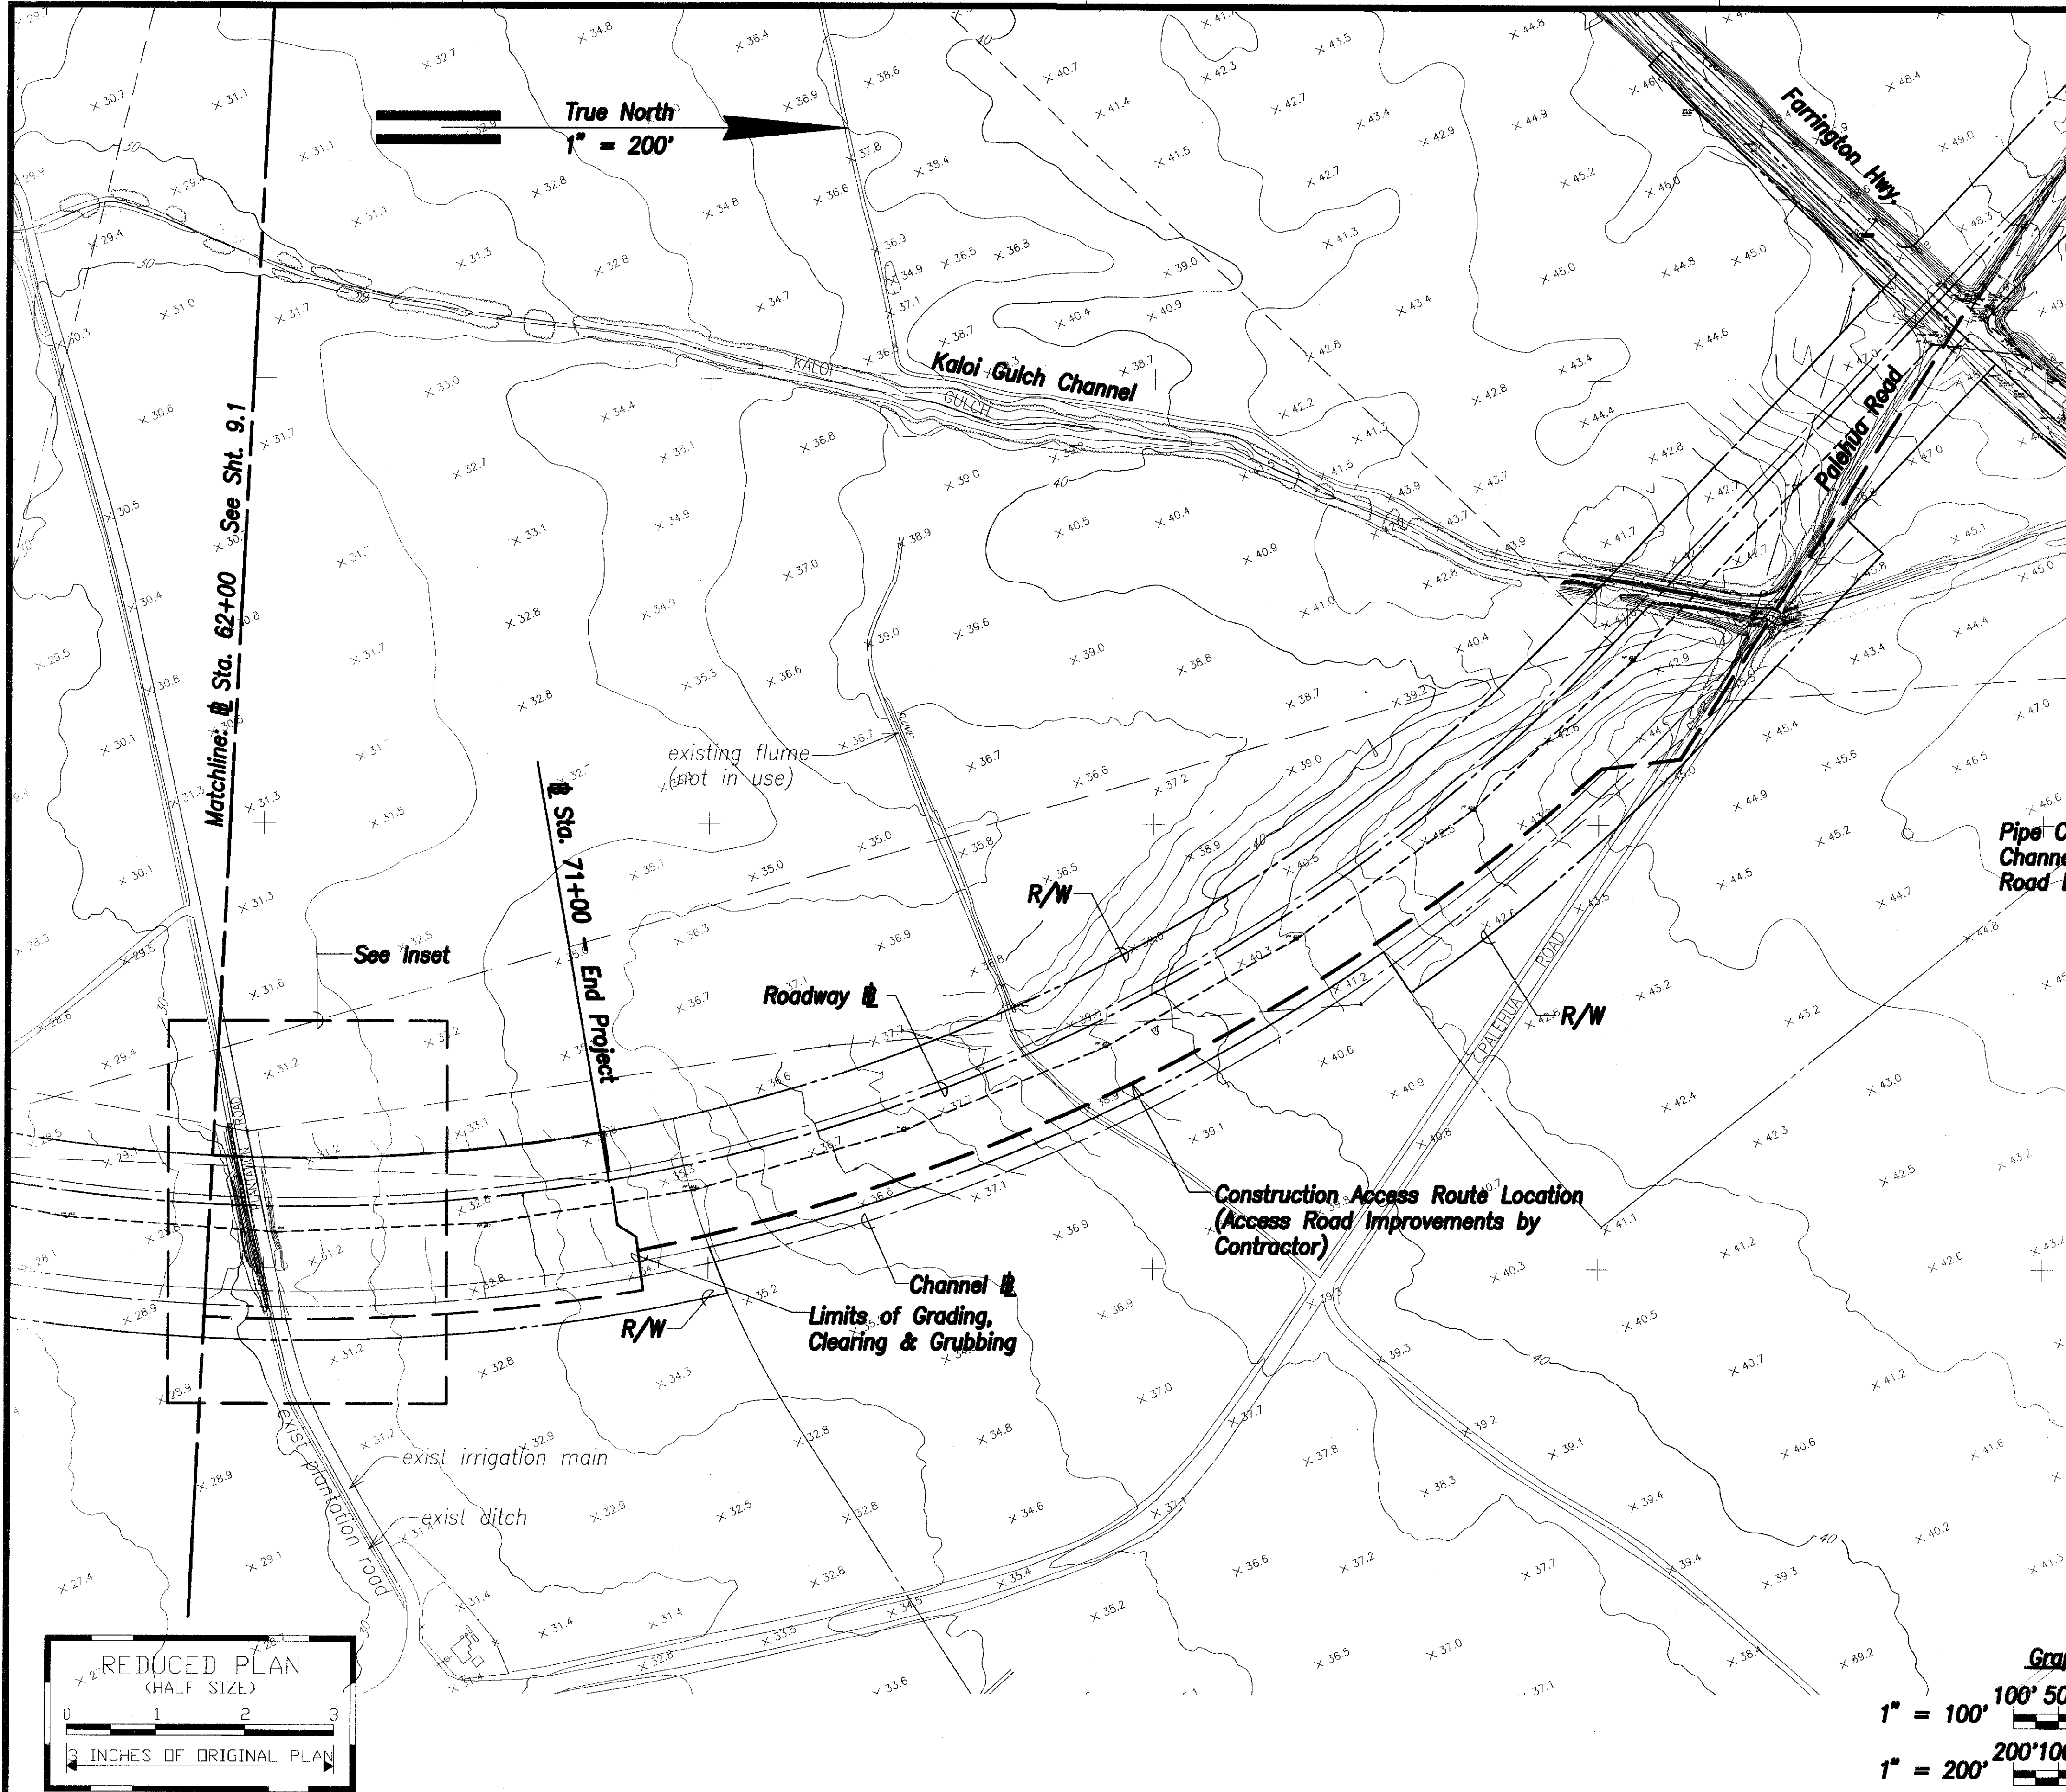


Inset Detail
Scale: 1" = 100'

LEGEND FOR AS-BUILT POSTINGS	
	Squiggly line for as-built deletion
	Double line for as-built deletion
	Text for as-built posting



THIS WORK WAS PREPARED BY ME OR UNDER MY SUPERVISION.
 Signature: *[Signature]* Date: April 30, 2008
 EXPIRATION DATE OF THE LICENSE

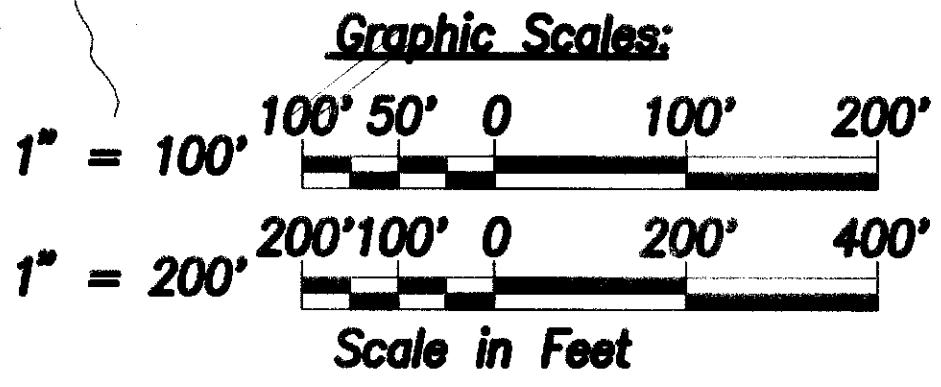

DATE	1 As Built - RFI 5
REVISION	
STATE OF HAWAII DEPARTMENT OF TRANSPORTATION HIGHWAYS DIVISION DEMOLITION PLAN - 2 North-South Road Phase 1A F.A.I. Proj. No. STP-8930(1) Scale: 1" = 200' Date: Dec 22, 2004 SHEET No. C9.2 OF SHEETS	

SURVEY PLANNED BY	DATE
DRAWN BY	
DESIGNED BY	
QUANTITIES BY	
CHECKED BY	
ORIGINAL PLAN	No.

