

	ELEUIT	RICAL SYMBO	
SYMBOL	DESCRIPTION	SYMBOL	DESCRIPTION
•—	Street Light Standard Transformer Base &	<u> </u>	Electric/Signal Ductline with Designators; Indicates Duct
	Concrete Foundation. See Detail A/E2.4		Section "A" with "2-2L" Ducts. See Sheets E2.1
•]	Street Light Standard Transformer Base &	(2-21)	& E2.2 for Duct Sections and Sheet E2.2 for Conduit
	Modified Concrete Foundation. See Detail A/E2.5		Schedules.
<u>~{</u>	Future Street Light Standard		Stub, Cap, & Mark Conduits; Provide Pullwire
o()	Existing Street Light	E	Electric Ductline
		SL	Street Light Ductline & Wiring
\boxtimes	HECo 2' X 4' Pullbox		Signal Ductline
	HECo 4' X 6' Handhole	—— TS——	Traffic Signal Ductline & Wiring
0	HECo 6' X 11' Manhole		
	HECo 6' X 14' Manhole	:	
		е	Exst Elec/Signal Ductline & Wiring
		e	Exst Elec/Signal Ductline to be Abandoned In Place
	HECo Transformer Pad Lot	sl	Exst Street Light Ductline & Wiring
	HECo Switch Equipment Pad Lot	-×-sl-×	Exst Street Light Ductline to be Abandoned In Place
	HECo PMH3 Switch Pad Lot	ts	Exst Traffic Signal Ductline
S	HTCo 2' X 4' Handhole or Pullbox	—×— ts—×—	Exst Traffic Signal Ductline to be Abandoned In Place
	HTCo 5' X 10' Manhole	-	
Q	HTCo 6' X 12' Manhole		
Name and the second sec		—— E/OH——	Elec Overhead Lines
		— Т/ОН —	Signal Overhead Lines
	Traffic Signal Pullbox, Type "A", See Sheet E2.3	— SL/OH —	Overhead Street Light Wiring, Provide Conn to Sec Elec
	Traffic Signal Pullbox, Type "B", See Sheet E2.3		
	Traffic Signal Pullbox, Type "C", See Sheet E2.3		
188323 ₁			
	Street Light Pullbox, Type "C", See Sheet E2.3	e/oh	Exst Elec Overhead Lines
	Street Light Pullbox, Type "A", See Sheet E2.3	e/oh	Exst Elec Overhead Lines to be Removed By HECo
		—— t/oh —×	Exst Signal Overhead Lines
			Exst Signal Overhead Lines to be Removed
<u> </u>	Existing HECo Manhole, Handhole or Pullbox	—	By HTCo and Catv
	Existing Telephone Handhole, Pullbox, or Manhole	— et/oh —	Exst Elec/Signal Overhead Lines
	Existing receptions transfer, runsex, or mainten		
		→ et/oh →	By HECo, HTCo and Catv
			Exst HTCo. Air Dryer and Air Pressure Assessories
			Exst Electrical Equipment
	Utility Pole Provided By Utility Co.		
<u> </u>	Exst Utility Pole		
<u> </u>	Exst Utility Pole to be Removed By Utility Co.	S	Concrete Stub-Out Marker, See Detail F/E2.4
		5	Note Symbol; See Sheet
		£ <u></u>	Exst Metering Equipment
	Guying and Guy Anchor Provided By Respective		
	Utility Co.		
	Exst Guying and Anchor		
	Exst Guying and Anchor to be Removed By		

FED. ROAD	STATE	FED. AID	FISCAL	SHEET	TOTAL
DIST. NO.		PROJ. NO.	YEAR	NO.	SHEETS
HAWAII	HAW.	STP-8930(1)	2005	112	144

<u>DESCRIPTION</u>


HECO REFERENCE SPECIFICATIONS

SPEC. NO.	<u>DESCRIPTION</u>
CS7001	Construction of Underground Facilities
CS7003	Construction of Electrical Facilities
CS7202	General Conditions for Construction of Projects
CS7401	Concrete Work
CS9401	Design and Construction of Precast Manholes and Handholes
	CS7001 CS7003 CS7202 CS7401

HECO REFERENCE DRAWINGS

DWG NO.

16688 Sht. 1 & 2	Details Handholes & Manholes, UG Standards
18844	Handhole Type 611 UG Standard
71467	Manhole Type 614 Structural Details UG Standards
11249	Material Drawing for Concrete Pad System
22–2005	Type. 3 Phase Padmounted TSF Requirements, Commercial Distribution System
30–5000	Location, Clearances and Protection Details, Pad— Mounted Equipment
30–5001	1 Phase Pad Mounted TSF Con- crete Pad URD Installation
30–5011	3 Phase Deadfront Padmount TSF — Conc. Pads, UG Ducts & Structures 75 to 300 KVA
30–5512	Concrete Pad Installation 25KV PMH—3 Switch Enclosure
30–5515	Concrete Pad Installation PMH-9 Auto. Trans. Swgr. 25KV
Note:	Reference Drawings Referred to in Description of Equip- ment Schedule.

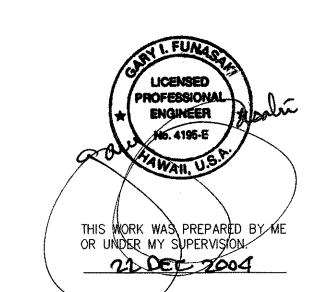

STATE OF HAWAII
DEPARTMENT OF TRANSPORTATION
HIGHWAYS DIVISION

ELECTRICAL SYMBOLS

<u>North-South Road</u> <u>Phase 1A</u> F.A.I. Proj. No. STP-8930(1)

Scale: AS NOTED

Date: DEC. 22, 2004

SHEET No. E0.2 OF 15 SHEETS

NOTES FOR CONSTRUCTION WITHIN STATE RIGHT-OF-WAY

- 1. The Contractor shall obtain a permit to perform work upon State Highways from the State Highways' District Engineer, at 727 Kakoi Street, prior to commencement of work within the State's Highway Right-of-Way.
- Construction and restoration of all existing Highway facilities within the State's Right-of-Way shall be done in accordance with all applicable Sections of the current <u>Standard Specifications</u> For Road, Bridge and Public Works Construction, and the Specifications for Installation of Miscellaneous Improvements <u>Within State Highway</u>, of the State Highways Division.
- See Contract Documents for Work Hours.
- The Contractor shall provide, install, and maintain all necessary signs, lights, flares, barricades, markers, cones and other protective facilities, and shall take all necessary precautions for the protection, convenience, and safety of public traffic. All such protective facilities and precautions to be taken shall conform with the "Administrative Rules of Hawaii Governing the Use of Traffic Control Devices at Work Sites on or Adjacent to Public Streets and Highways", adopted by the Director of Transportation, and the current U.S. Federal Highways Administration "Manual on Uniform Traffic Control Devices for Streets and Highways, Part VI -Standards and Guides for Traffic Control for Street and Highway Construction, Maintenance, Utility and Incident Management Operations". If lane closures are required during construction, a Traffic Control Plan shall be incorporated into the construction plans and must be approved by the Division prior to issuance of the permit.
- 5. The minimum pavement structure shall consist of:
 - a. Residential Driveways
 - 1) 2" Asphalt Concrete (Mix IV) and 6" Aggregate Base Course, or 2" Asphalt Concrete and 2 1/2" Asphalt Concrete Base Course or Asphalt Concrete.
 - 2) 4" Class "A" Concrete Reinforced with 6" x 6" W2.9 x W2.9 Wire Mesh on 12" Aggregate Subbase, if deemed necessary by the Engineer.
 - b. Commercial Driveways, Sideroads, and Utility Installations on Minor Highways
 - 1) 2 1/2" Asphalt Concrete (Mix IV), 8" Aggregate Base Course and 12" Subbase, or 2 1/2" Asphalt Concrete and 8" Asphalt Concrete Base Course or Asphalt Concrete.
 - 2) 6" of Class "A" Concrete Reinforced with 6" x 6" W2.9 x W2.9 Wire Mesh on 12" Aggregate Subbase, if deemed necessary by the Engineer.
- 6. No material and/or equipment shall be stockpiled or otherwise stored within the Highway right-of-way, except at locations designated in writing and approved by the District Engineer.

- Compaction tests shall be taken in accordance with the Specifications for installation of miscellaneous improvements within State Highways, as follows:
 - One (1) Compaction Test per lift per 100 lineal a. Subbase: feet of roadway.
 - b. Base Course: One (1) Compaction Test per lift per 100 lineal feet of roadway.
 - c. One (1) Compaction Test per lift per 300 lineal feet of trench.
- 8. Prior to commencing trench excavation work, the Contractor shall take a profile along the centerline of the proposed utility trench. This information shall be used in the verification of restoring the roadway to its original condition. A copy of the profile shall be submitted to the District Engineer.
- The Contractor shall provide an adequate and safe non-skid bridging material, including shoring, over trenches in pavement areas. The bridging shall be able to support all types of vehicular traffic.
- 10. Unless otherwise noted, no trench shall be opened more than 300 feet in advance of installed and tested pipeline and/or ductline.
- 11. Existing drainage systems shall be functional at all times.
- 12. The Contractor shall exercise care to minimize damages to existing Highway improvements. All damages shall be repaired by the Contractor, at his expense, to the satisfaction of the District Engineer.
- 13. All regulatory, guide, and construction signs and barricades shall have a high—intensity reflective background.
- 14. Driveways shall be kept open unless the Owners of the properties using these rights—of—way are otherwise provided for satisfactorily.
- 15. Where pedestrian walkways exist, they shall be maintained in a safe and passable condition, or other facilities for pedestrians shall be provided. Passages between walkways at intersections shall likewise be provided.
- 16. The Contractor shall reference to the satisfaction of the District Engineer, all existing traffic signs, posts, and pavement markings prior to the commencement of construction. The Contractor shall replace or repair all traffic signs, posts, and pavement markings disturbed by his activities, at his expense, unless directed otherwise by the District Engineer or his representative.
- 17. The Contractor shall exercise care when performing work in or adjacent to the State Highway Right-of-Way. Damages to existing facilities shall be immediately reported to the respective Utility Companies, and/or City or State Agencies. The repair work shall be done at the Contractor's expense.
- 18. The Contractor shall notify the State Highways' Highway Lighting and Traffic Signal Supervisor (834-4581), three (3) working days prior to commencing work.
- 19. Traffic signals shall be kept operational during construction, and if deemed necessary by the District Engineer or his representative, a temporary vehicle detection device shall be installed. All work shall be done in accordance to the require ments of the Department of Transportation Services, City and County of Honolulu, and paid for by the Contractor.

20.	The Contractor shall notify Oahu Transit Services, Inc. (OTS), Ed
	Sniffen at 848-4571, or Lowell Tom at 848-4578, two weeks prior
	to commencing any work. The Contractor shall inform OTS of
	the location and scope of work, proposed closure of any street
	or traffic lane, and the need to relocate any bus stop.

- 21. The Permit to perform work upon State Highways may be revoked because of default in any of the following, but not limited to, conditions:
 - a. Work performed before or after permitted hours.
 - b. Failure to maintain roadway surfaces in a smooth and safe condition.
 - c. Failure to clean up construction debris generated from Project work.
 - d. Failure to provide proper traffic control.
 - e. Failure to replace damaged pavement markings and signs.

TRAFFIC SIGNALS & TECHNOLOGY NOTES:

- All work shall be done in accordance with the "Standard Specifications for Public Works Construction", September, 1986, of the Department of Public Works, City and County of Honolulu, except as modified herein or in the Special Provisions.
- The Contractor shall verify with the respective Utility Companies and Government Agencies, the locations of all electric, telephone, traffic signal, street light, fire alarm, gas, water, sewer, drain, and other lines crossing the excavation path or in excavation areas.
- Locations of traffic signal conduits shall be staked out by the Contractor and approved by the Engineer prior to any excavation.
- All structures, pavements, utilities, landscaping, and other topographical features shown on the Intersection Drawings are existing and are to remain unless noted or indicated otherwise.
- The Contractor shall notify all affected Utility Companies and Government Agencies of their intent to begin construction on any intersection or street at least two (2) weeks prior to the start of such construction.
- The Contractor may close only one lane of traffic at a time for any reason. during the peak traffic periods from 6:00 to 9:00 a.m. and from 3:00 to 6:00 p.m., Monday through Friday, all lanes shall be kept open and maintained at all times.
- The Contractor shall notify the Traffic Control Branch, Department of Transportation Services, three (3) working days prior to commencing work on the traffic signal system (phone: 523-4589).
- The Contractor shall be responsible for any damages to the existing traffic signal facilities, including the Traffic Signal Interconnecting System. Any and all damages to these facilities shall be repaired by the Contractor at his cost in accordance with the requirements of the City and County of Honolulu.

LICENSED PROFESSIONAL

THIS WORK WAS PREPARED BY ME

OR UNDER MY SUPERVISION

22 000 2001

HO. 4195-E

FISCAL

YEAR

2005

FED. AID

PROJ. NO.

STP-8930(1)

SHEET TOTAL

113

SHEETS

FED. ROAD

DIST. NO.

HAWAII

HAW.

DEPARTMENT OF TRANSPORTATION STATE NOTES AND

MISCELLANEOUS DETAILS North-South Road

Phase 1A F.A.I. Proj. No. STP-8930(1)

SURVEY PLOTTE
DRAWN BY....
TRACED BY....
DESIGNED BY....
QUANTITIES BY.
CHECKED BY....

Scale: AS NOTED Date: DEC. 22, 2004 SHEET No. E0.3 OF 15 SHEETS

HAWAIIAN ELECTRIC COMPANY (HECO) NOTES

1. LOCATION OF HECO FACILITIES

The location of HECO's overhead and underground facilities shown on the plans are from existing records with varying degrees of accuracy and are not guaranteed as shown. The Contractor shall verify in the field the locations of the facilities and shall exercise proper care in excavating and working in the area. wherever connections of new utilities to existing utilities and utility crossings are shown, the Contractor shall expose the existing lines at the proposed connections and crossings to verify the depths prior to excavation for the new lines. The Contractor shall be responsible for any damages to HECO's facilities whether shown or not shown on the plans.

2. COMPLIANCE WITH HAWAII OCCUPATIONAL SAFETY AND HEALTH LAWS

The Contractor shall comply with the state of Hawaii's Occupational Safety and Health Laws and Regulations, including without limitation, those related to working on or near exposed or energized electrical lines and equipment.

EXCAVATION PERMIT

The Contractor shall obtain an excavation permit from HECO's Techinical Division (543-5654) located at 820 Ward Avenue, 4th floor, two weeks prior to starting construction. Please refer to our request number at that time.

4. CAUTION!!! ELECTRICAL HAZARD!!!

Existing HECO overhead and underground lines are energized and will remain energized during construction unless prior special arrangements have been made with HECO. Only HECO personnel are to handle these energized lines and erect temporary quards to protect these lines from damage. The Contractor shall work cautiously at all times to avoid accidents and damage to existing HECO facilities, which can result in electrocution.

OVERHEAD LINES

State law requires that a worker and the longest object he or she may contact cannot come closer than a minimum radial clearance of 10 feet when working close to or under any overhead lines rated 50kV and below. For each additional 1kV above 50kV, an additional 0.4 inch shall be added to the 10-foot clearance requirement. The preceding information on line clearance requirements is provided as a convenience and it is the Contractor's responsibility to be informed of and comply with any revisions or amendments to the law.

Should the Contractor anticipate that his work will result in the need to encroach within the minimum required clearance at any time, the Contractor shall notify HECO at least four (4) weeks prior to the planned encroachment so that, if feasible, the necessary protections (e.g. relocate, de-energize, or blanket HECO lines) can be put in place. HECO's cost of safeguarding its lines will be charged to the Contractor.

Contact HECO's Customer Installations Department at 543—7846 for assistance in identifying and safeguarding overhead power lines.

Refer to Section X of HECO's Electric Service Installation Manual for additional quidelines when working around HECO's facilities. A copy may be obtained from HECO's Customer Installations Department.

6. POLE BRACING

A minimum clearance of 10 feet must be maintained when excavating around utility poles and/or their anchor system to prevent weakening or pole support failure. Should work require excavating within 10 feet of a pole and/or its anchor system, the Contractor shall protect, support, secure, and take all other precautions to prevent damage to or leaning of these poles. The Contractor is responsible for all associated costs to brace, repair, or straighten poles. All means of structural support for the pole proposed by the Contractor shall first be reviewed by HECO before implementation. For pole bracing instructions, the Contractor shall call the HECO Construction and Maintenance Dept., Customer & System Superintendent at 543-4223 a minimum of two (2) weeks in advance.

UNDERGROUND LINES

The Contractor shall exercise extreme caution whenever construction crosses or is in close proximity of underground lines. HECO's existing electrical cables are energized and will remain energized during construction. Only HECO personnel are to break into existing HECO facilities, handle these cables, and erect temporary guards to protect these cables from damage. The cost of HECO's assistance in providing proper support and protection of its underground Tines will be charged to the Contractor. Special precautions are required when excavating near HECO's 138kV underground lines (see HECO Instructions to Consultants/Contractors on "excavation near HECO's underground 138kV lines" for detailed requirements).

For verification of underground lines, the Contractor shall call HECO's Underground Division at 543-7049 a minimum of 72 hours in advance.

For assistance in providing proper support and protection of these lines, the Contractor shall call HECO's Construction & Maintenance Dept., Customer & System Superintendent, at 543-4223, a minimum of two (2) weeks in advance.

UNDERGROUND FUEL PIPELINES

The Contractor shall exercise extreme caution whenever construction crosses or is in close proximity of HECO's underground fuel oil pipelines. Special precautions are required when excavating near HECO's underground fuel oil pipelines (see HECO Instructions to Consultants/Contractors on "excavation near HECO's underground fuel pipelines" for detailed requirements).

EXCAVATIONS

When trench excavation is adjacent to or beneath HECO's existing structures or facilities, the Contractor is responsible for:

- a) sheeting and bracing the excavation and stabilizing the existing ground to render it safe and secure and to prevent possible slides, cave—ins, and settlements.
- b) properly supporting existing structures or facilities with beams, struts, or under-pinnings to fully protect it from damage.
- c) backfilling with proper backfill material including special thermal backfill where existing (refer to Engineering Department for thermal backfill specifications).

FED. ROAD	STATE	FED. AID	FISCAL	SHEET	TOTAL
DIST. NO.		PROJ. NO.	YEAR	NO.	SHEETS
HAWAII	HAW.	STP-8930(1)	2005	114	144

10. RELOCATION OF HECO FACILITIES

Any work required to relocate or modify HECO facilities shall be done by HECO, or by the Contractor under HECO's supervision. The Contractor shall be responsible for all coordination, and shall provide necessary support for HECO's work, which may include, but not be limited to, excavation and backfill, permits and traffic control, barricading, and restoration of pavement, sidewalks, and other facilities.

All costs associated with any relocation or modification (either temporary or permanent) for the convenience of the Contractor, or to enable the Contractor to perform his work in a safe and expeditious manner in fulfilling his contract obligations shall be borne by the Contractor.


11. <u>CONFLICTS</u>

Any redesign or relocation of HECO's facilities not shown on the plans may be cause for lengthy delays. The Contractor acknowledges that HECO is not responsible for any delay or damage that may arise as a result of any conflicts discovered or identified with respect to the location or construction of HECO's electrical facilities in the field, regardless of whether the Contractor has met the requested minimum advance notices. In order to minimize any delay or impact arising from such conflicts, HECO should be notified immediately upon discovery or identification of such conflict.

12. DAMAGE TO HECO FACILITIES

The Contractor shall be responsible for the protection of all HECO surface and subsurface utilities and shall be responsible for any damages to HECO's facilities as a result of his operations. The Contractor shall immediately report such damages to HECO's Trouble Dispatcher at 548-7961. Repair work shall be done by HECO or by the Contractor under HECO's supervision costs for damages to HECO's facilities shall be borne by the Contractor.

In case of damage or suspected damage to HECO's fuel pipeline, the Contractor shall immediately notify HECO's Honolulu Power Plant Shift Supervisor at 533–2102 (a 24–hour number) so HECO personnel can secure the damaged section and report any oil spills to the proper authorities. all costs associated with the damage, repair, and oil spill cleanup shall be borne by the Contractor.

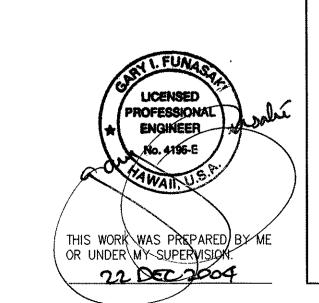

DEPARTMENT OF TRANSPORTATION HECO NOTES 1

North-South Road Phase 1A F.A.I. Proj. No. STP-8930(1)

Scale: AS NOTED

Date: DEC. 22, 2004 SHEET No. E0.4 OF 15 SHEETS

SURVEY PLOTT
DRAWN BY—
TRACED BY—
QUANTITIES B
CHECKED BY—

FED. ROAD DIST. NO. STATE FED. AID PROJ. NO. FISCAL YEAR NO. SHEETS HAWAII HAW. STP-8930(1) 2005 115 144

HAWAIIAN ELECTRIC COMPANY (HECO) NOTES CONT.

13. HECO STAND-BY PERSONNEL

The Contractor may request HECO to provide an inspector to stand—by during construction near HECO's facilities. The cost of such inspection will be charged to the Contractor.

The Contractor shall call the HECO Construction and Maintenance Dept., Customer & System Superintendent at 543-4223 a minimum of 5 working days in advance to arrange for HECO stand-by personnel.

14. CLEARANCES

The following clearances shall be maintained between HECO's ductline and all adjacent structures (charted and uncharted) in the trench:

.1
:)
(f)

- (a) The minimum horizontal clearances to water lines parallel to electrical ductlines must be increased to 60 inches if the water line is greater than 16 inches in diameter
- (b) The minimum vertical clearances to water lines crossing electrical ductlines can be reduced to 6 inches if the electrical ductline structure is concrete encased and is below the water line and the water line is less than 16 inches in diameter.
- (c) A minimum horizontal clerance of 36 inches is required between new handholes and existing sewer laterals.
- (d) The minimum vertical clearances to sewer pipes crossing electrical ductlines can be reduced to 12 inches if the sewer pipe is iacketed in concrete.
- (e) The minimum clearances shall be increased to 12 inches if the electrical ductline is direct buried.
- (f) The minimum vertical clearances to oil lines crossing electrical ductlines can be reduced to 24 inches below oil lines if the crossings are encased in 6 inches of concrete.
- (g) The Contractor shall notify the Construction Manager & HECO of any heat sources (power cable duct bank, steamline, etc.) encountered that are not properly identified on the drawing.

The following clearance shall be maintained between HECO's fuel oil pipelines and all adjacent structures: 24—inches, parallel or crossing. The minimum clearance can be reduced to 12 inchel (parallel and below only) if the structure is jacketed in concrete.

15. INDEMNITY

The Contractor shall indemnify, defend and hold harmless HECO from and against all losses, damages, claims, and actions, including but not limited to reasonable attorney's fees and costs based upon or arising out of damage to property or injuries to persons, or other tortious acts caused or contributed to by Contractor or anyone acting under its direction or control or on its behalf; provided Contractor's indemnity shall not be applicable to any liability based upon the sole negligence of HECO.

16. <u>SCHEDULE</u>

Contractor shall furnish his construction schedule 14 working days prior to starting work on HECO facilities. Contractor shall give HECO, in writing 5 working days notice to proceed with HECO's portion of work.

17. <u>AUTHORITY</u>

All construction, restoration work, and inspection shall be subject to whichever governmental agency has authority over the work.

18. <u>SPECIFICATIONS</u>

Construction of HECO's underground facilities shall be constructed in accordance with the latest revisions of HECO Specifications CS7001, CS7003, CS7202, CS9301, and CS9401 and applicable HECO Standards.

19. CONSTRUCTION

Contractor shall furnish all labor, materials, equipment, and services to properly perform and fully complete all work shown on the contract, drawings, and specifications. All materials shall be new and manufactured in the united states of america. All manhole, handhole, and ductline installations shall be inspected and approved by HECO prior to excavation and prior to placing concrete. Contractor shall notify HECO's Inspection Division at 543–4356 at least 48 hours prior to placing concrete.

Contractor to coordinate work to break into HECO's existing electrical facilities with HECO's Underground Division at 543-7871 at least 10 working days in advance.

20. STAKEOUT

The Contractor shall arrange for toneouts of all underground facilities and shall stakeout all proposed HECO facilities within the project area so as to not conflict with any utility (existing or proposed) and any proposed construction or improvement work for verification by HECO before proceeding with HECO work.

21. <u>DUCTLINES</u>


All ductline installations shall be PVC Schedule 40 encased in concrete, unless otherwise noted. all completed ductlines shall be mandrel tested by the Contractor in the presence of HECO's inspector using HECO's standard practice. The Contractor shall install a 1/8" polyolefin pull line in all completed ductlines after mandrel testing is complete.

22. <u>JOINT POLE REMOVAL</u>

The last joint pole occupant off the poles shall remove the poles.

23. <u>AS-BUILT PLANS</u>

The Contractor shall provide HECO with two sets of as—built reproducible tracings showing the offsets, stationing, and vertical elevation of the duct line(s) constructed.

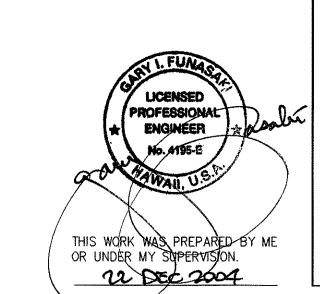

DEPARTMENT OF TRANSPORTATION HIGHWAYS DIVISION

<u>HECO NOTES II</u>


North-South Road
Phase 1A
F.A.I. Proj. No. STP-8930(1)


SHEET No. E0.5 OF 15 SHEETS


Scale: AS NOTED


Date: DEC. 22, 2004


115

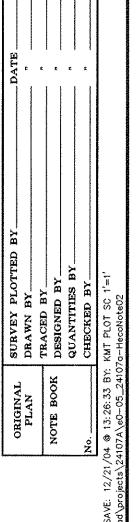


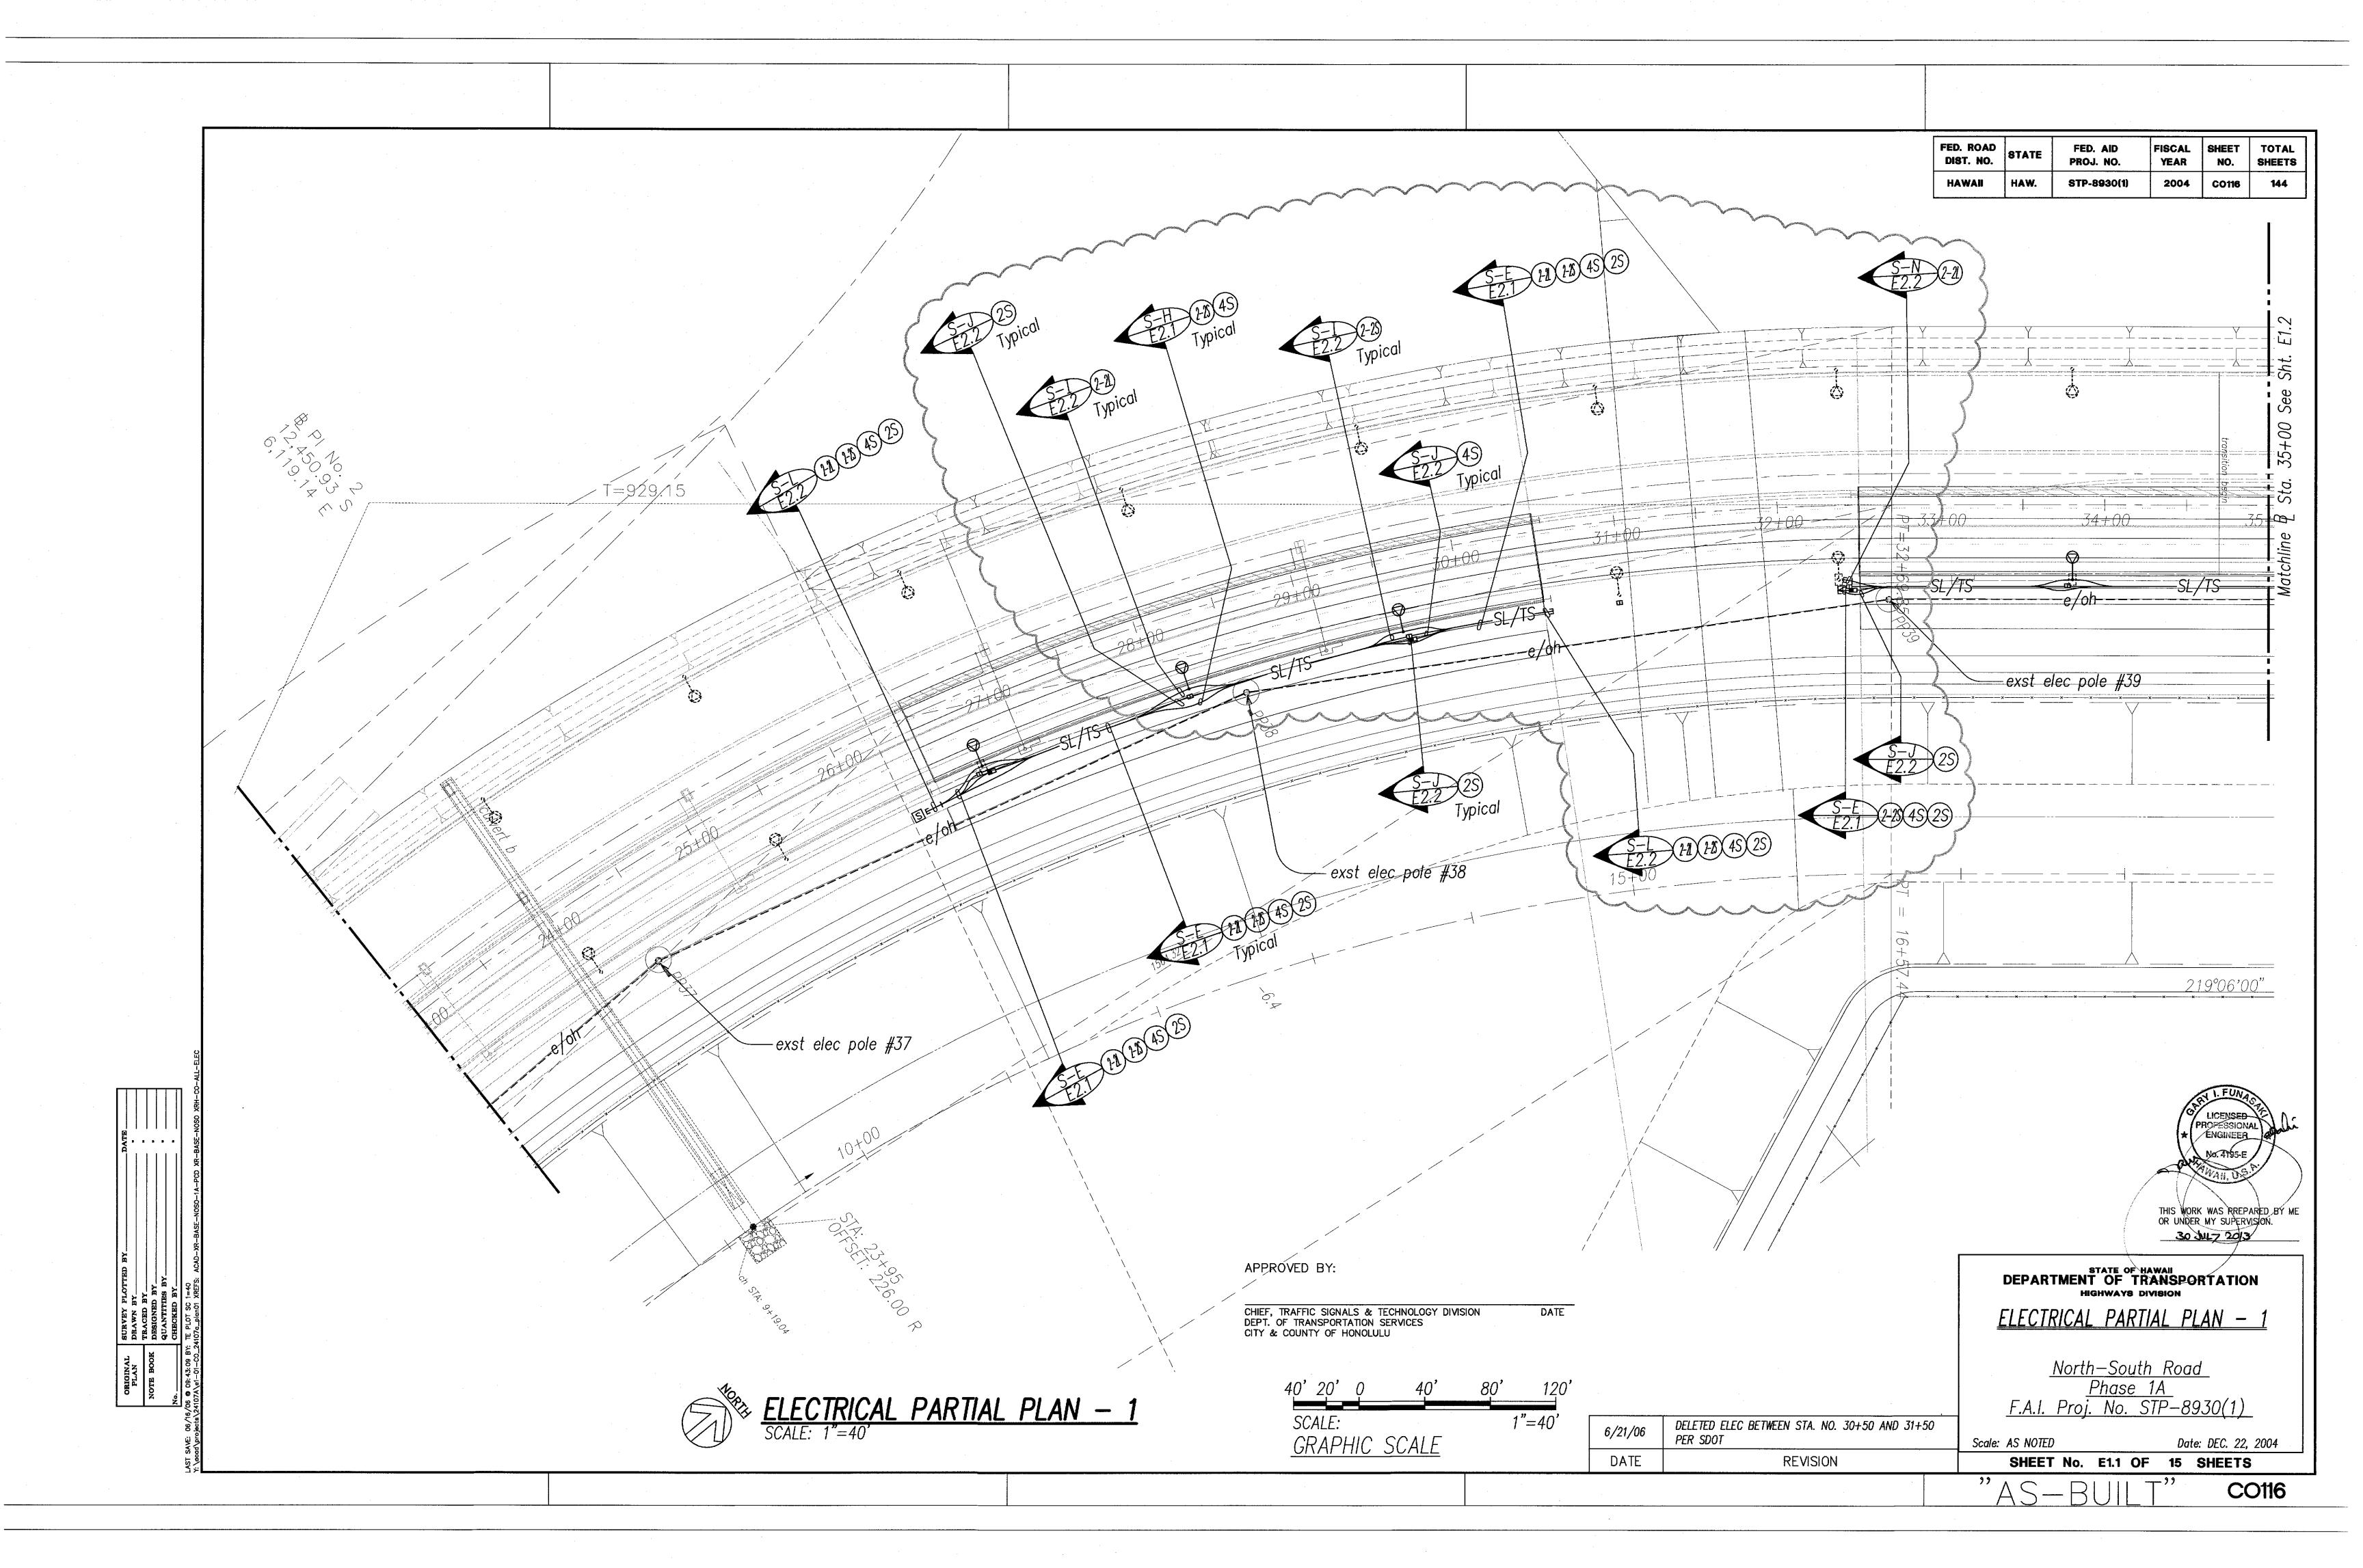


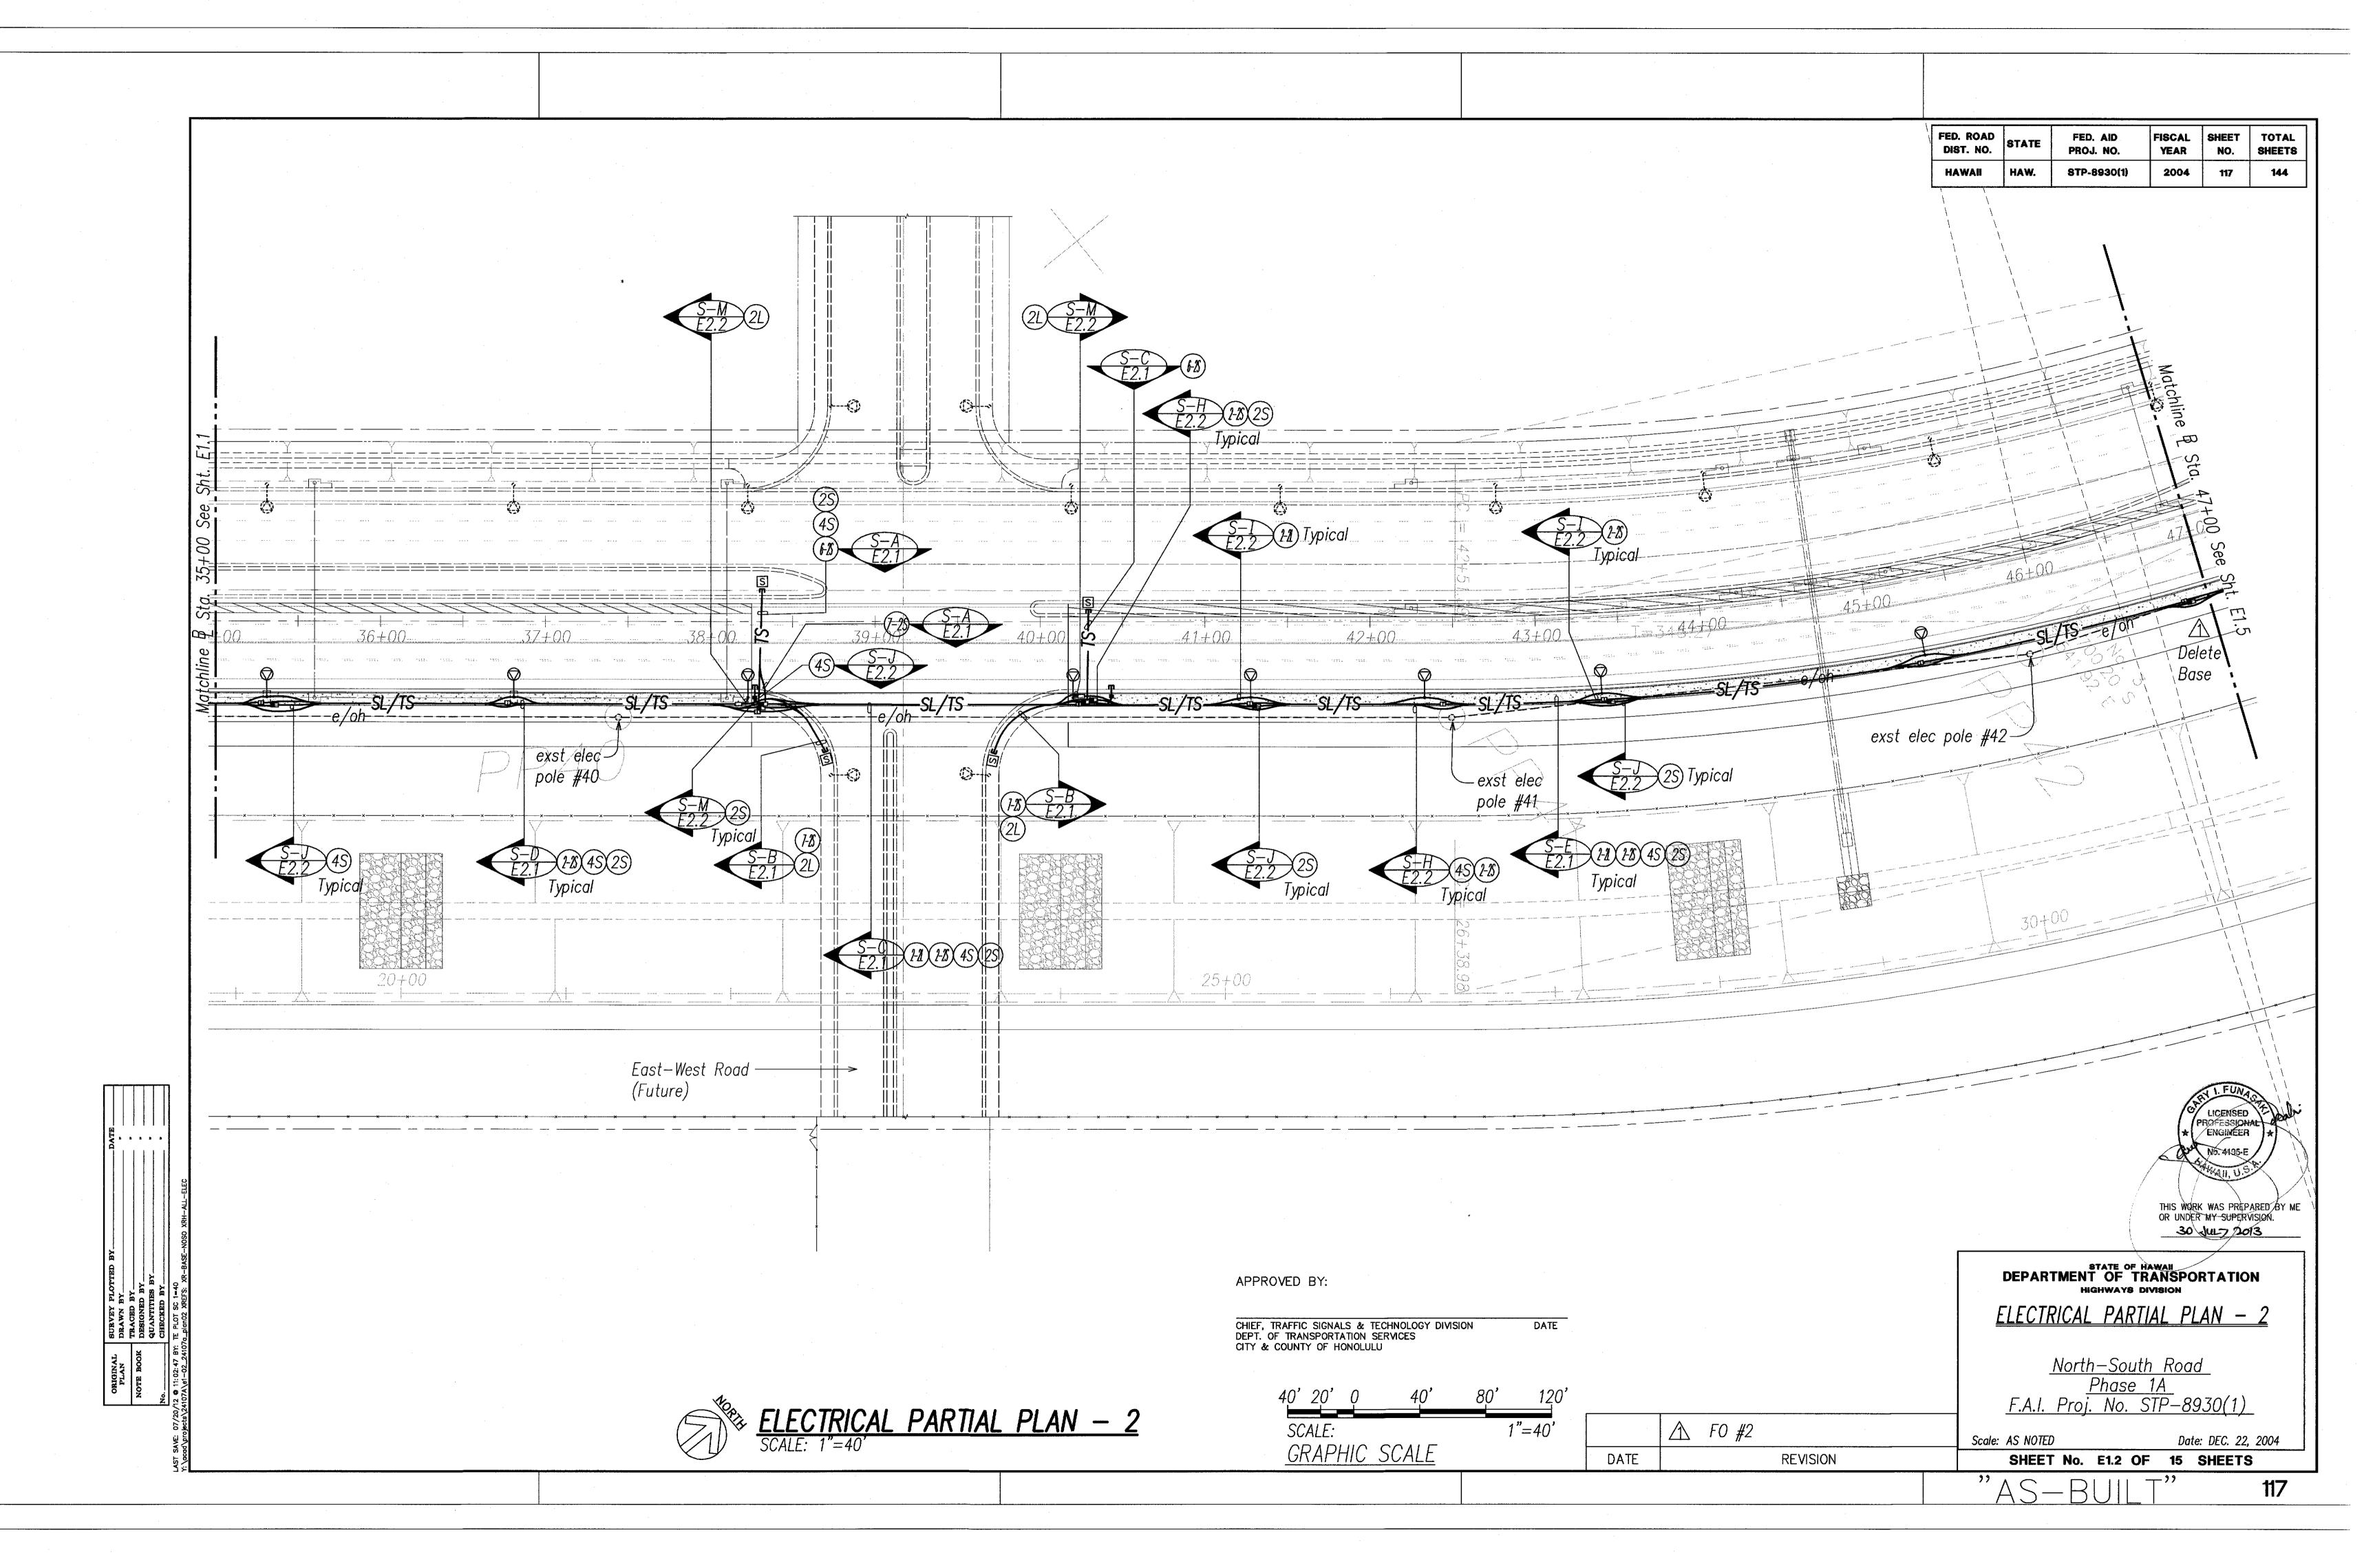


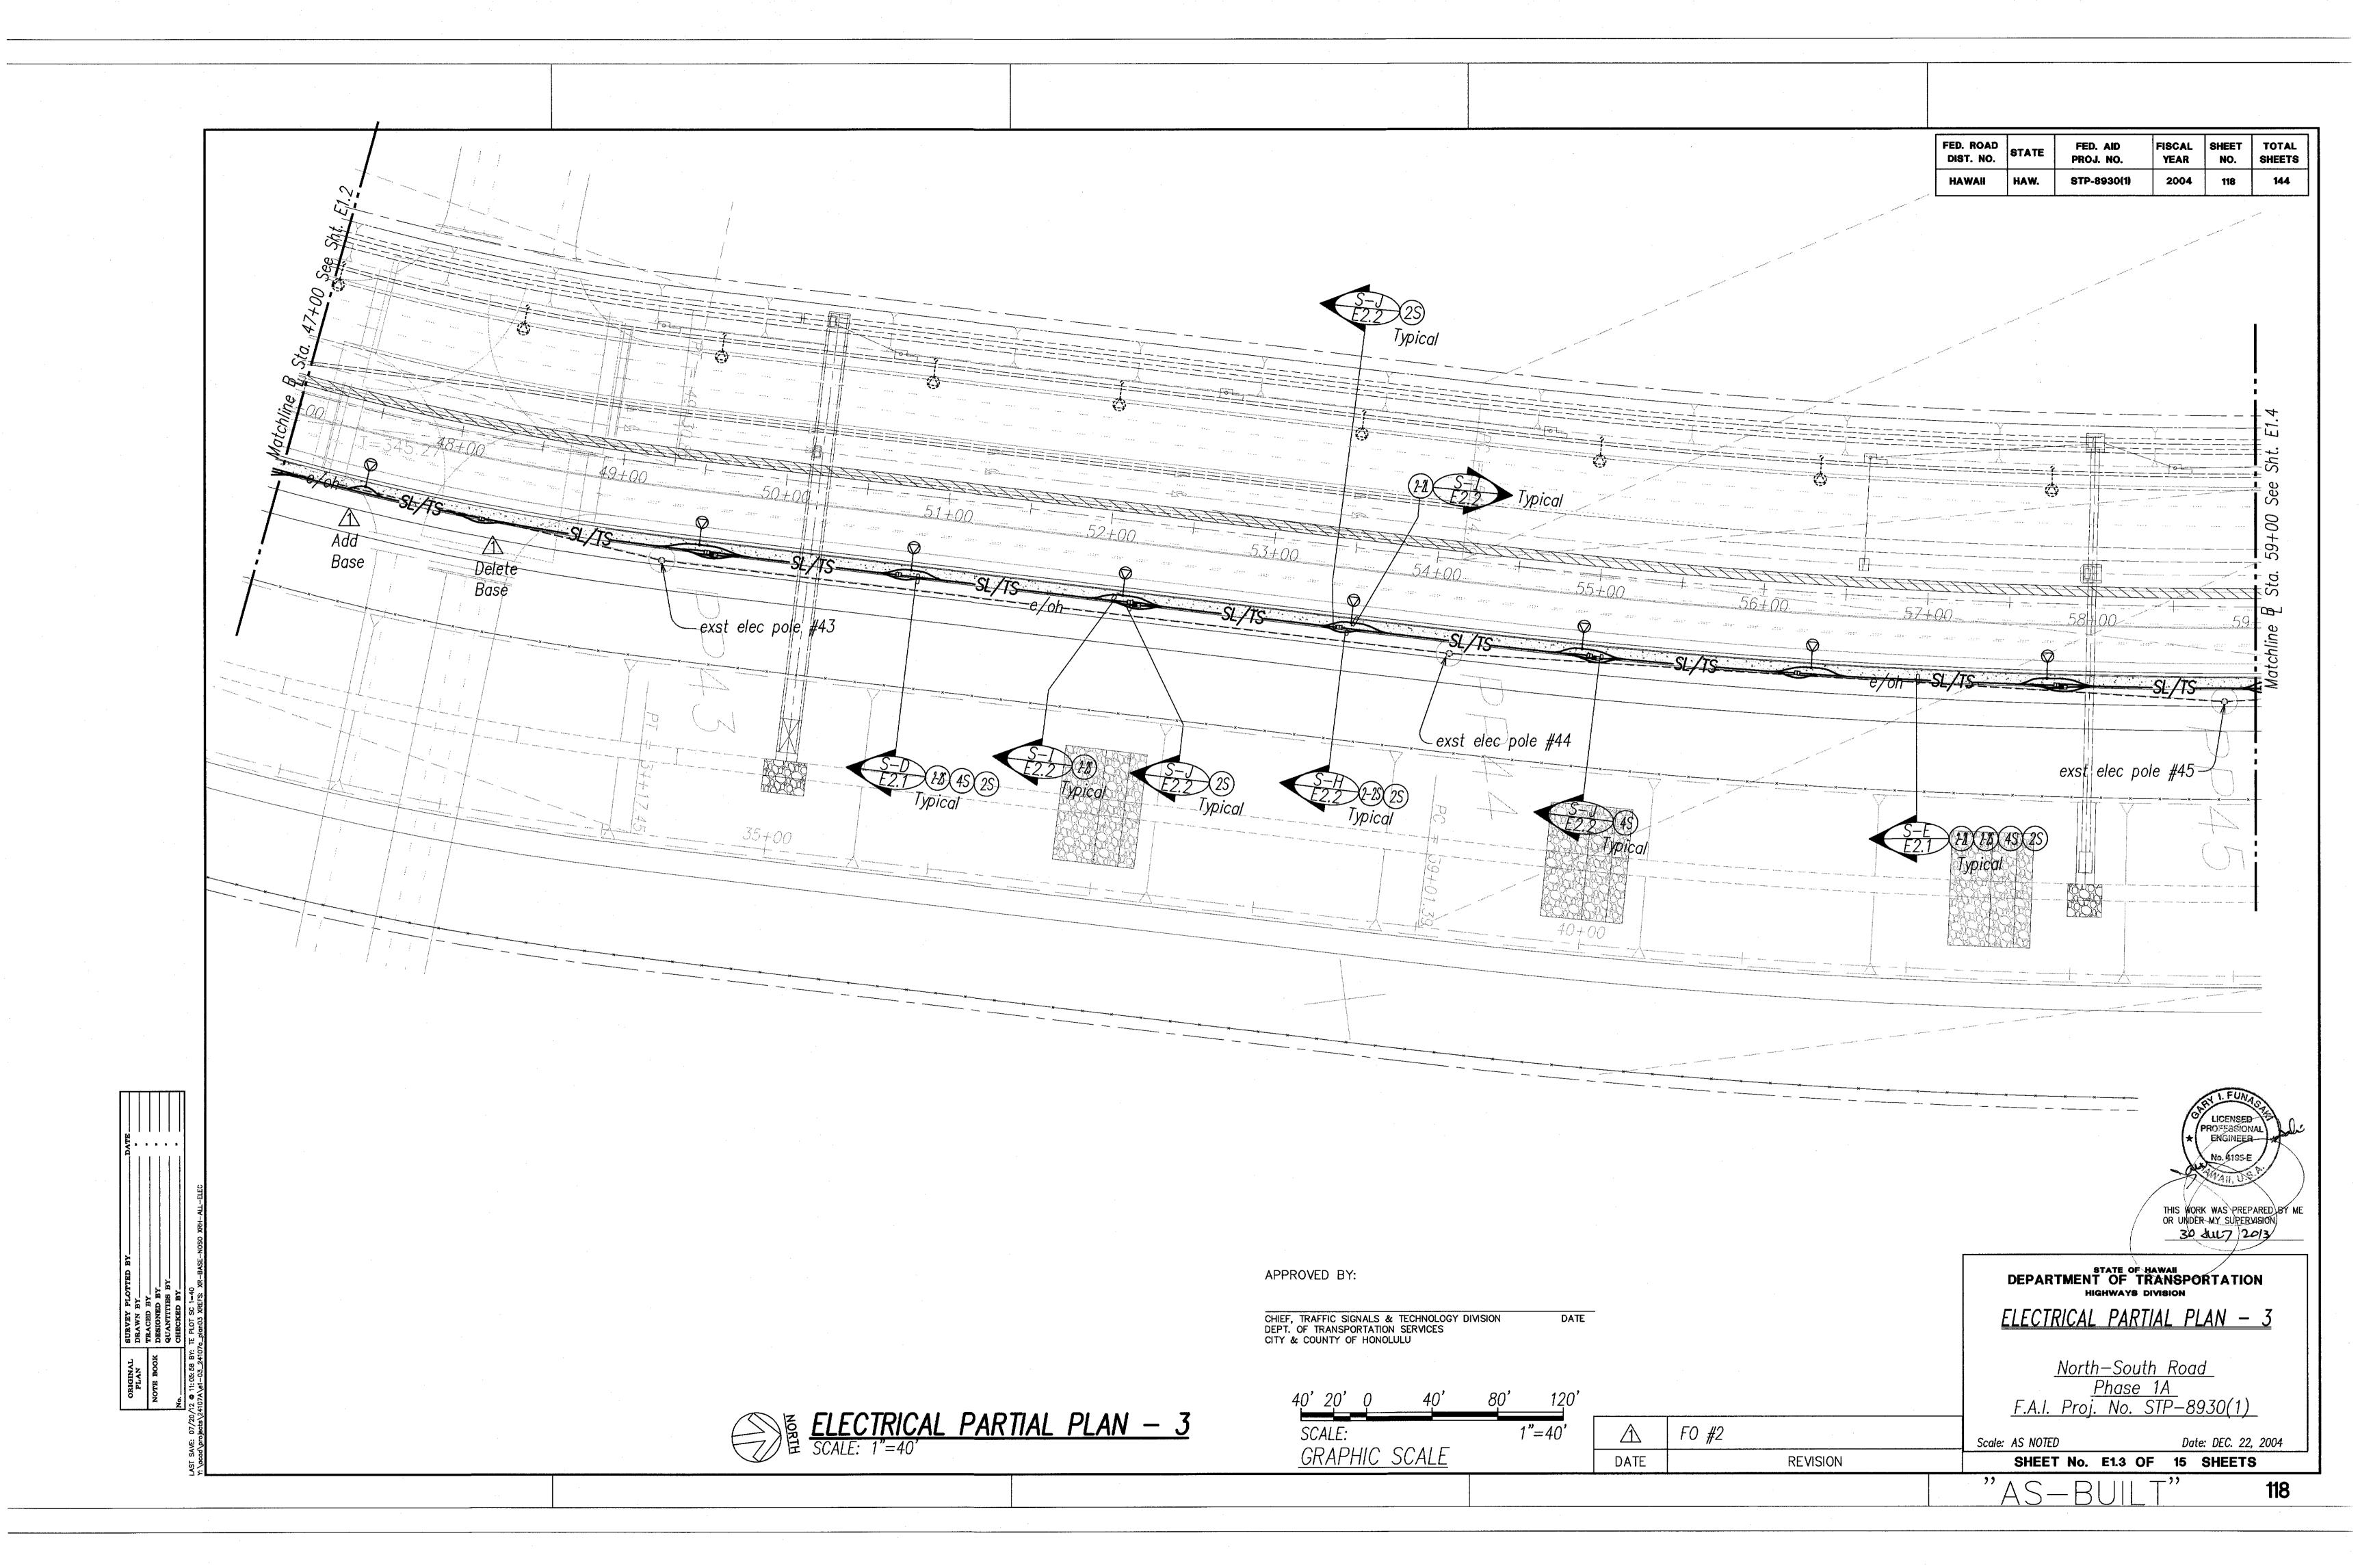

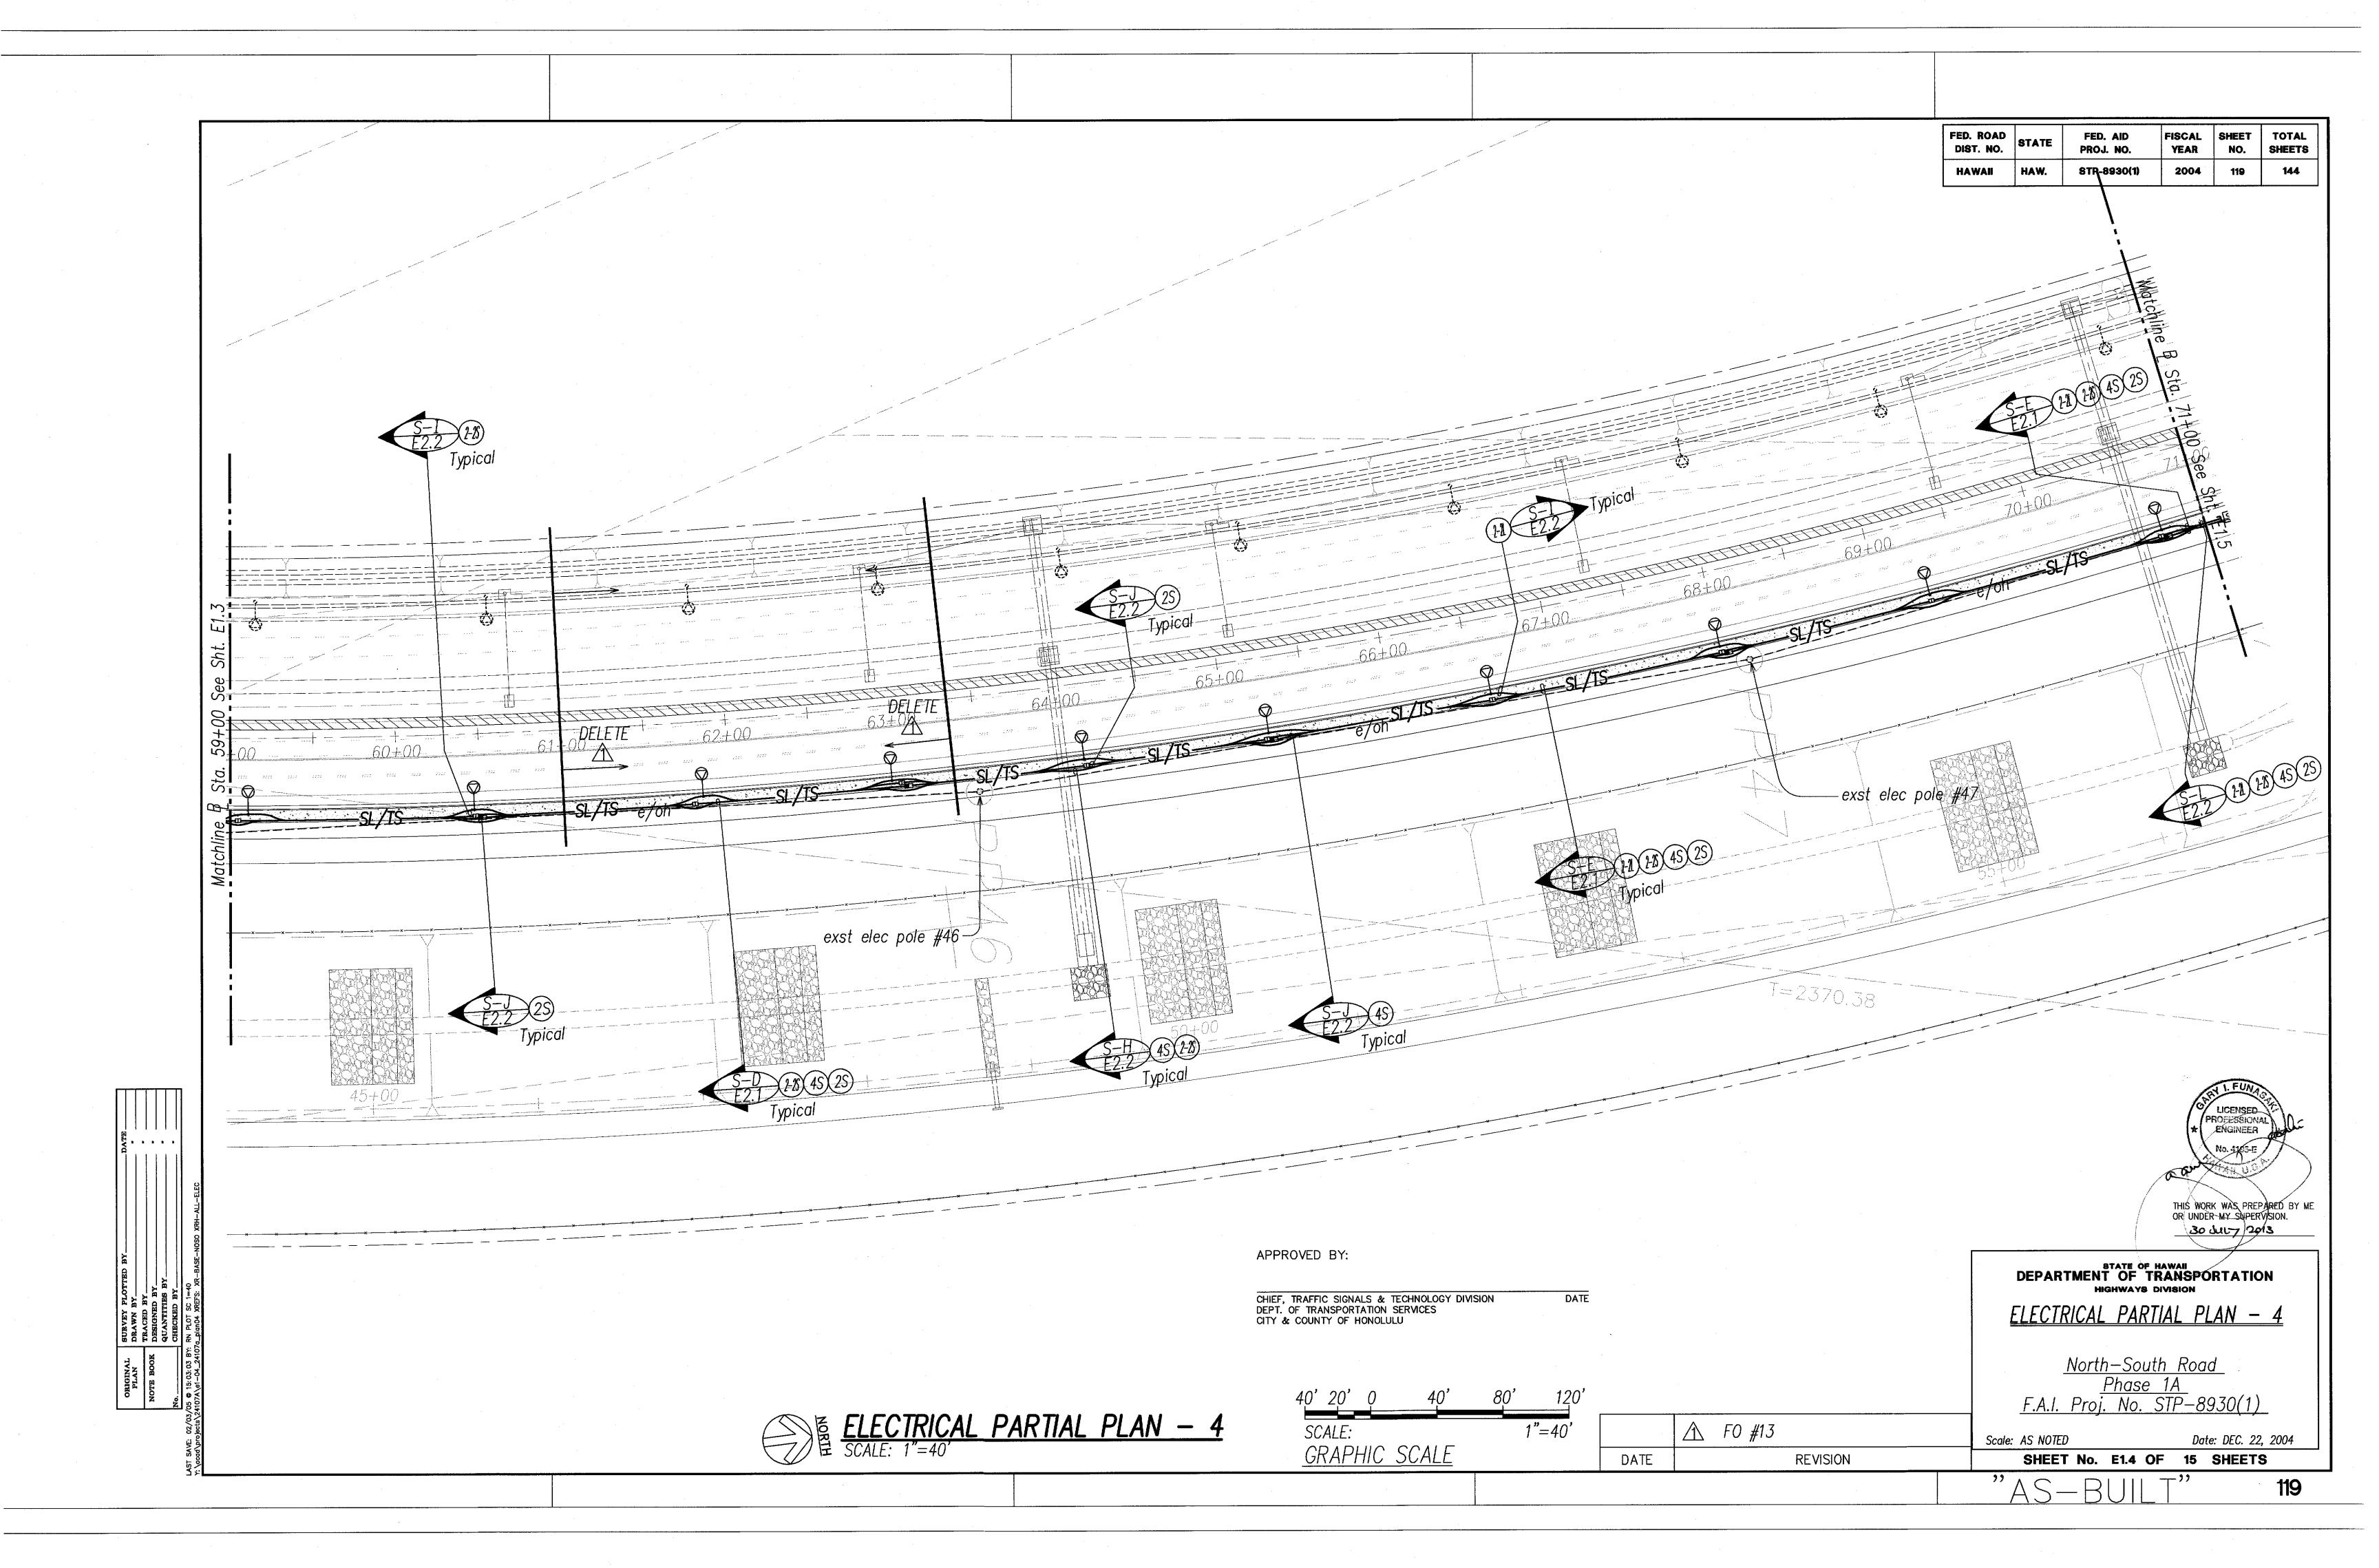

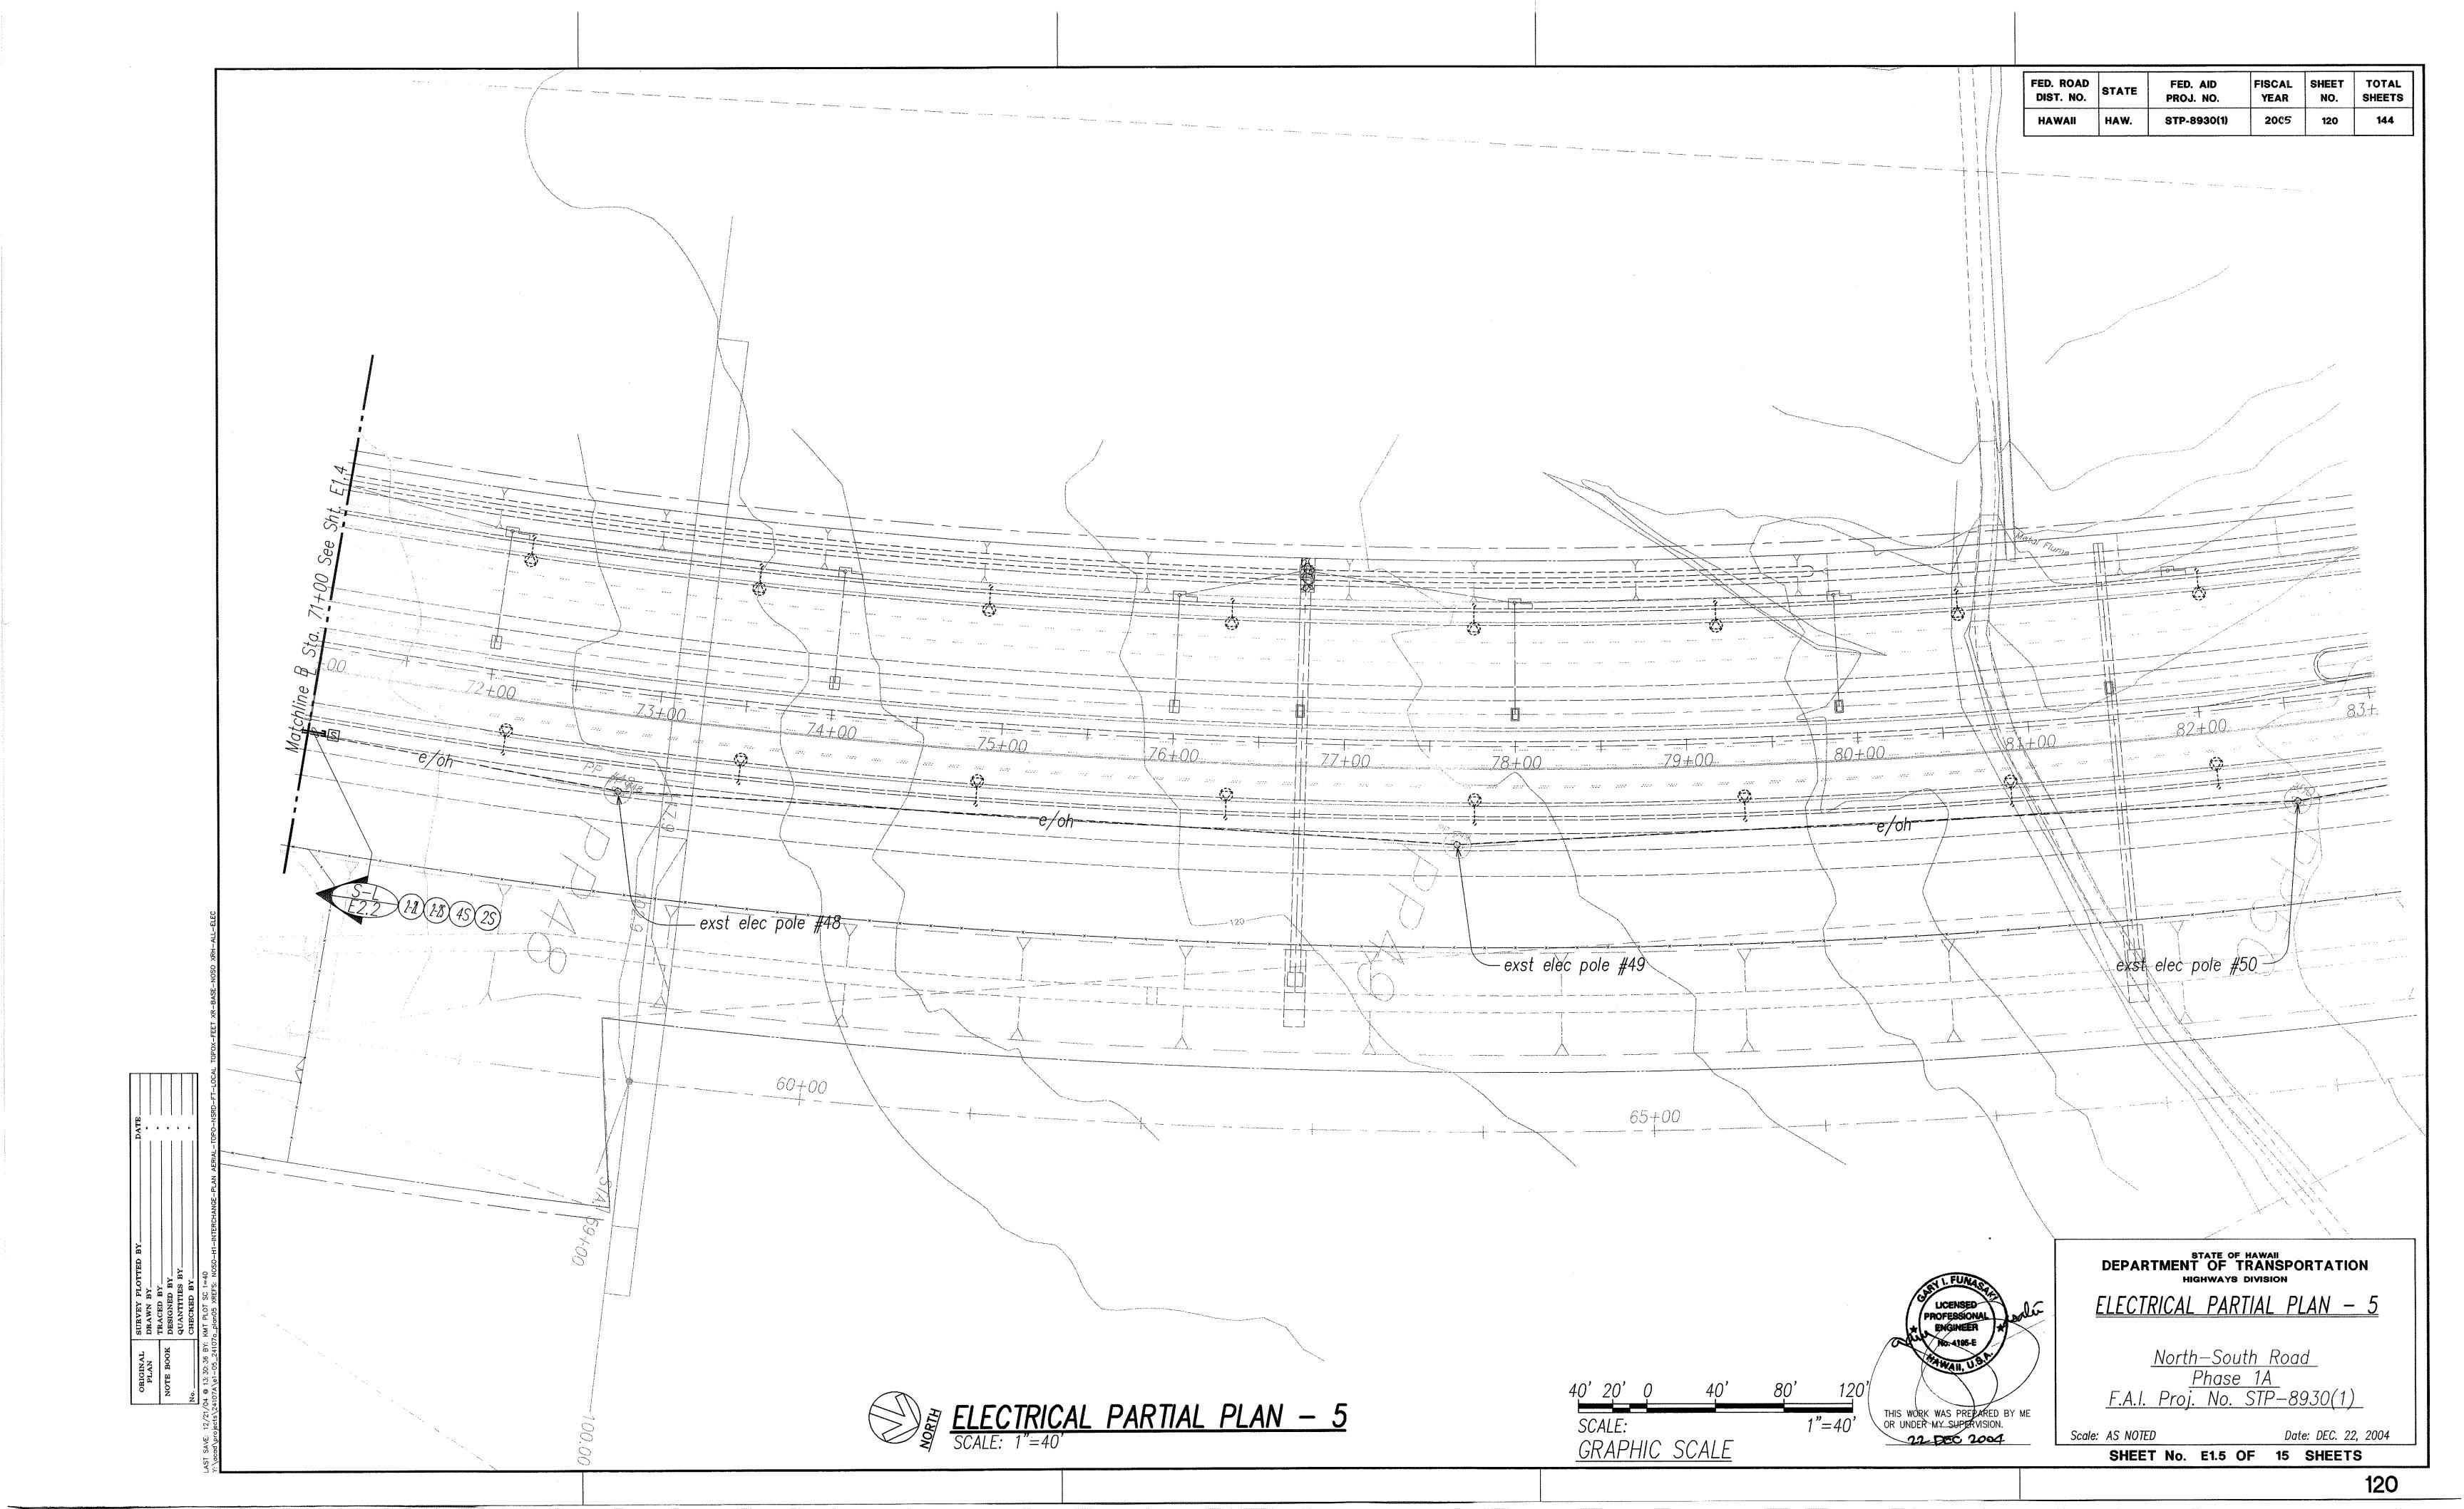

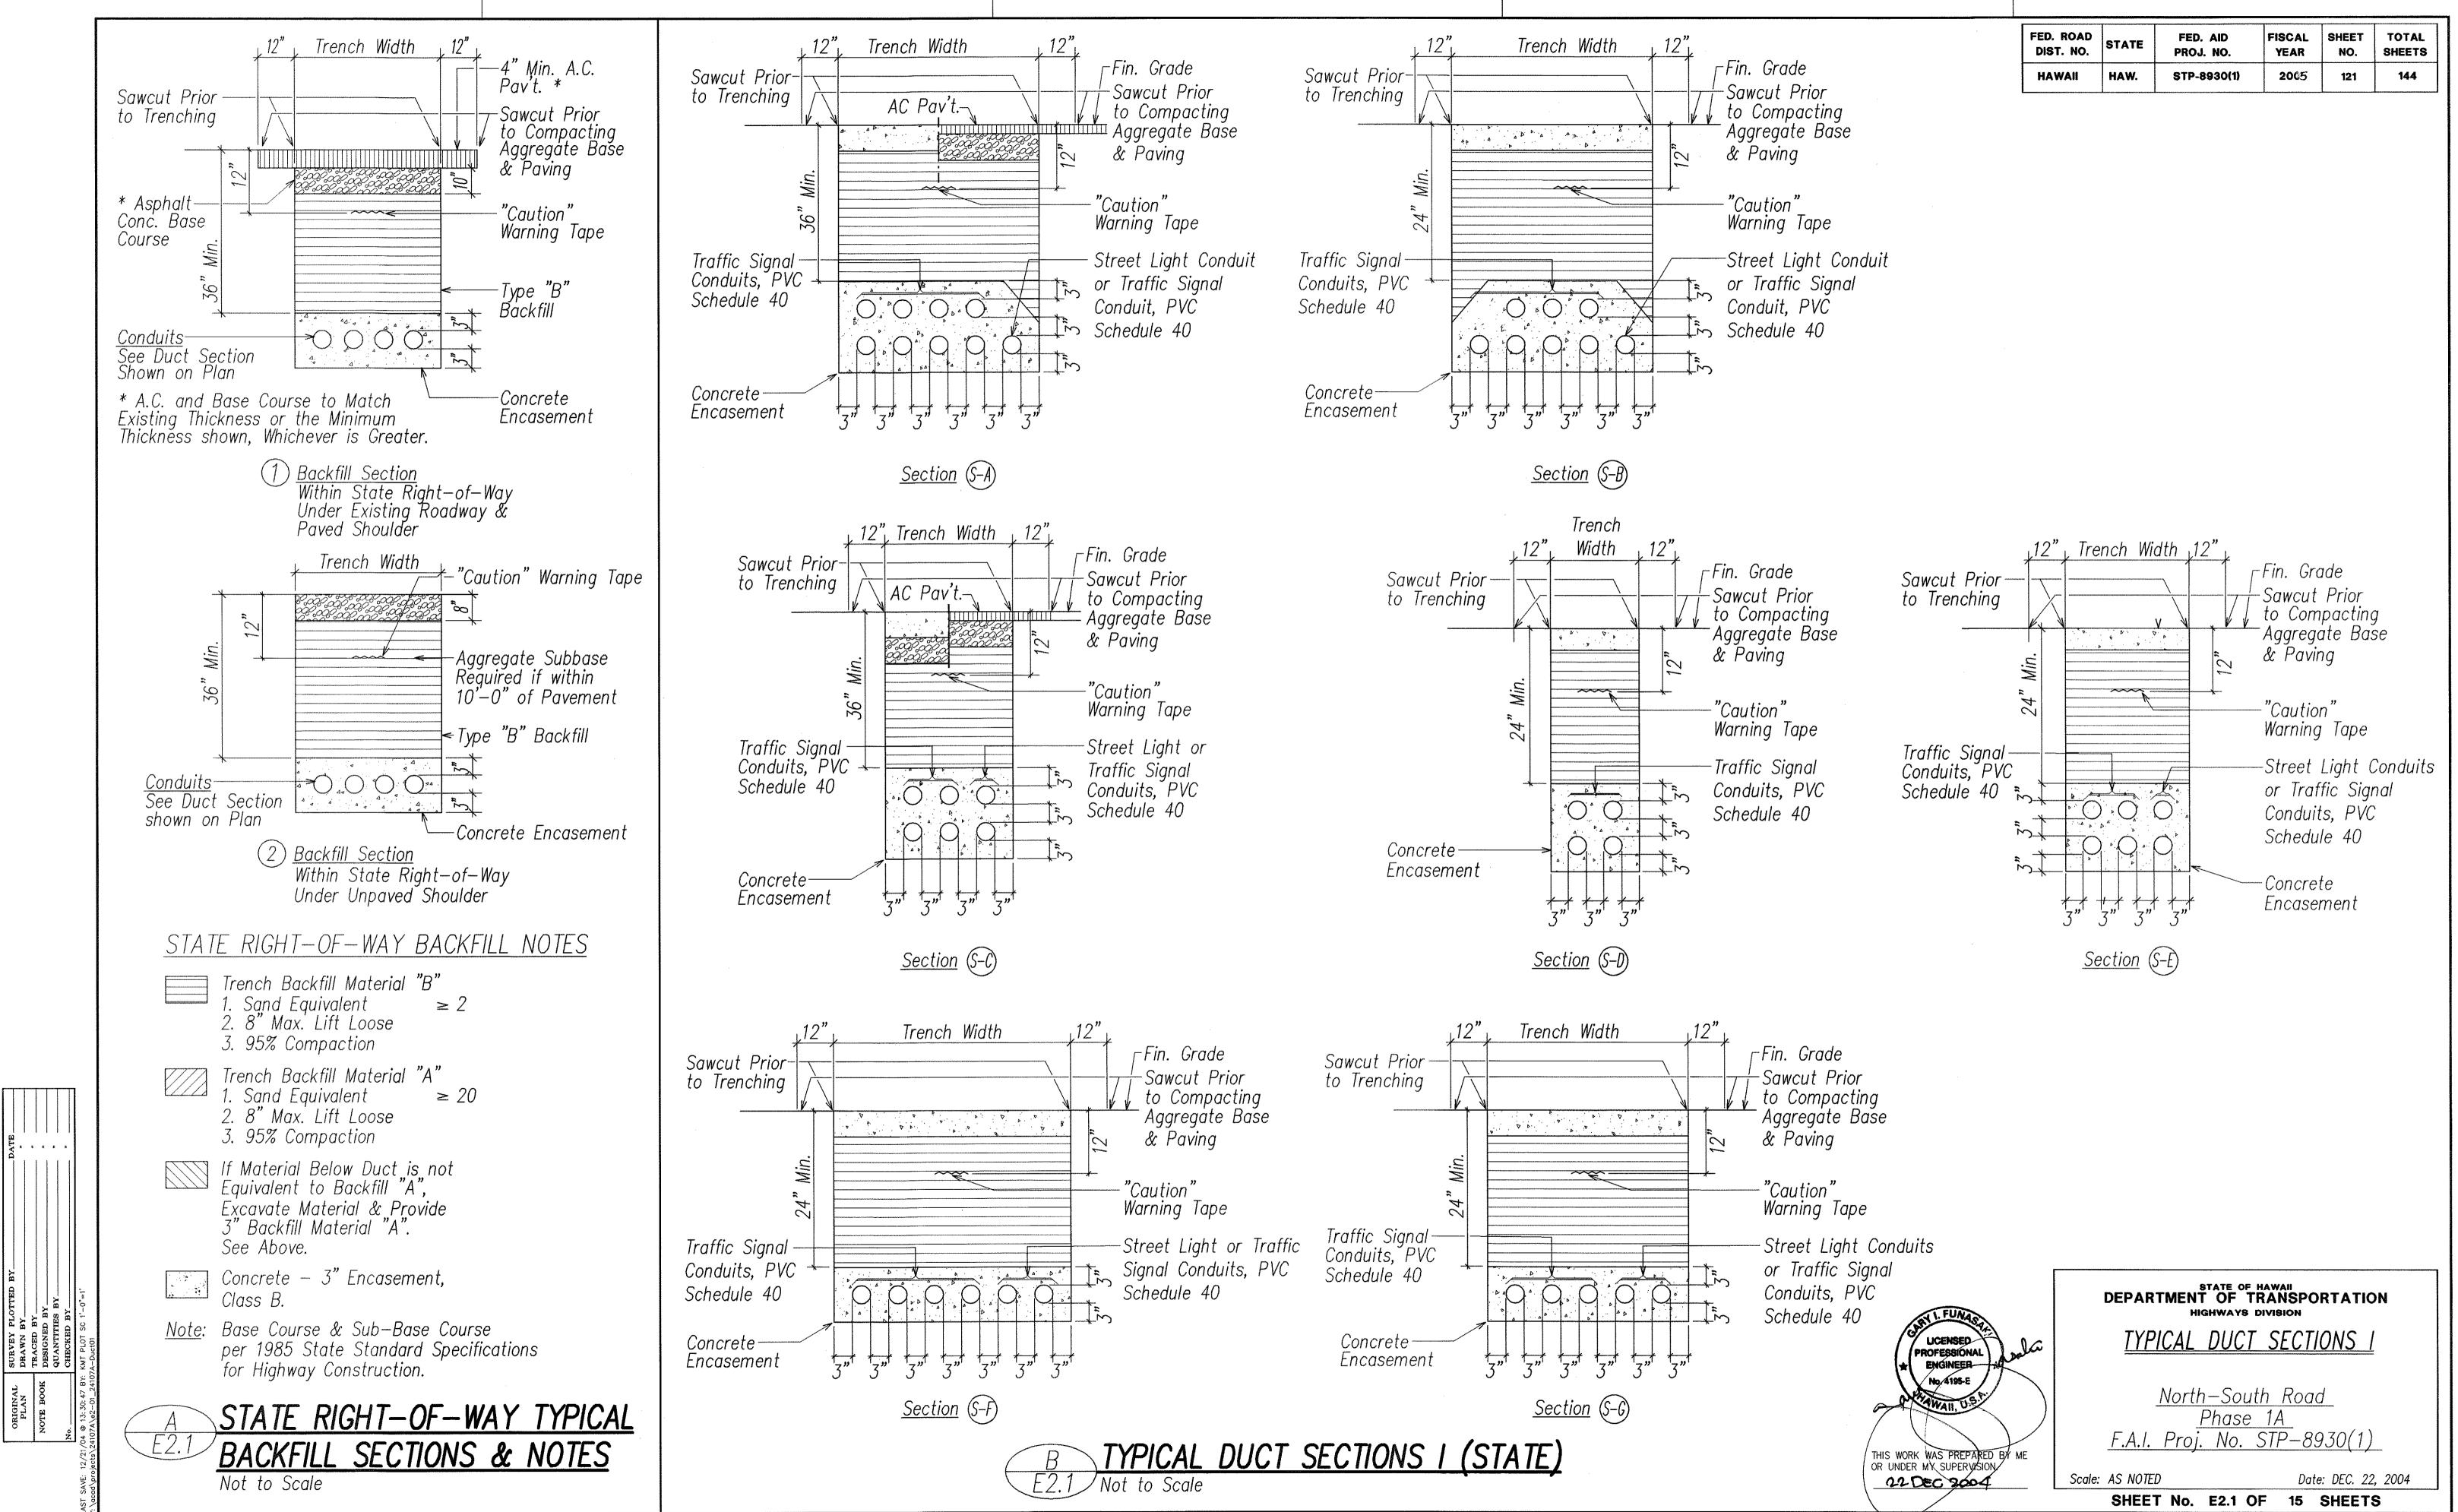


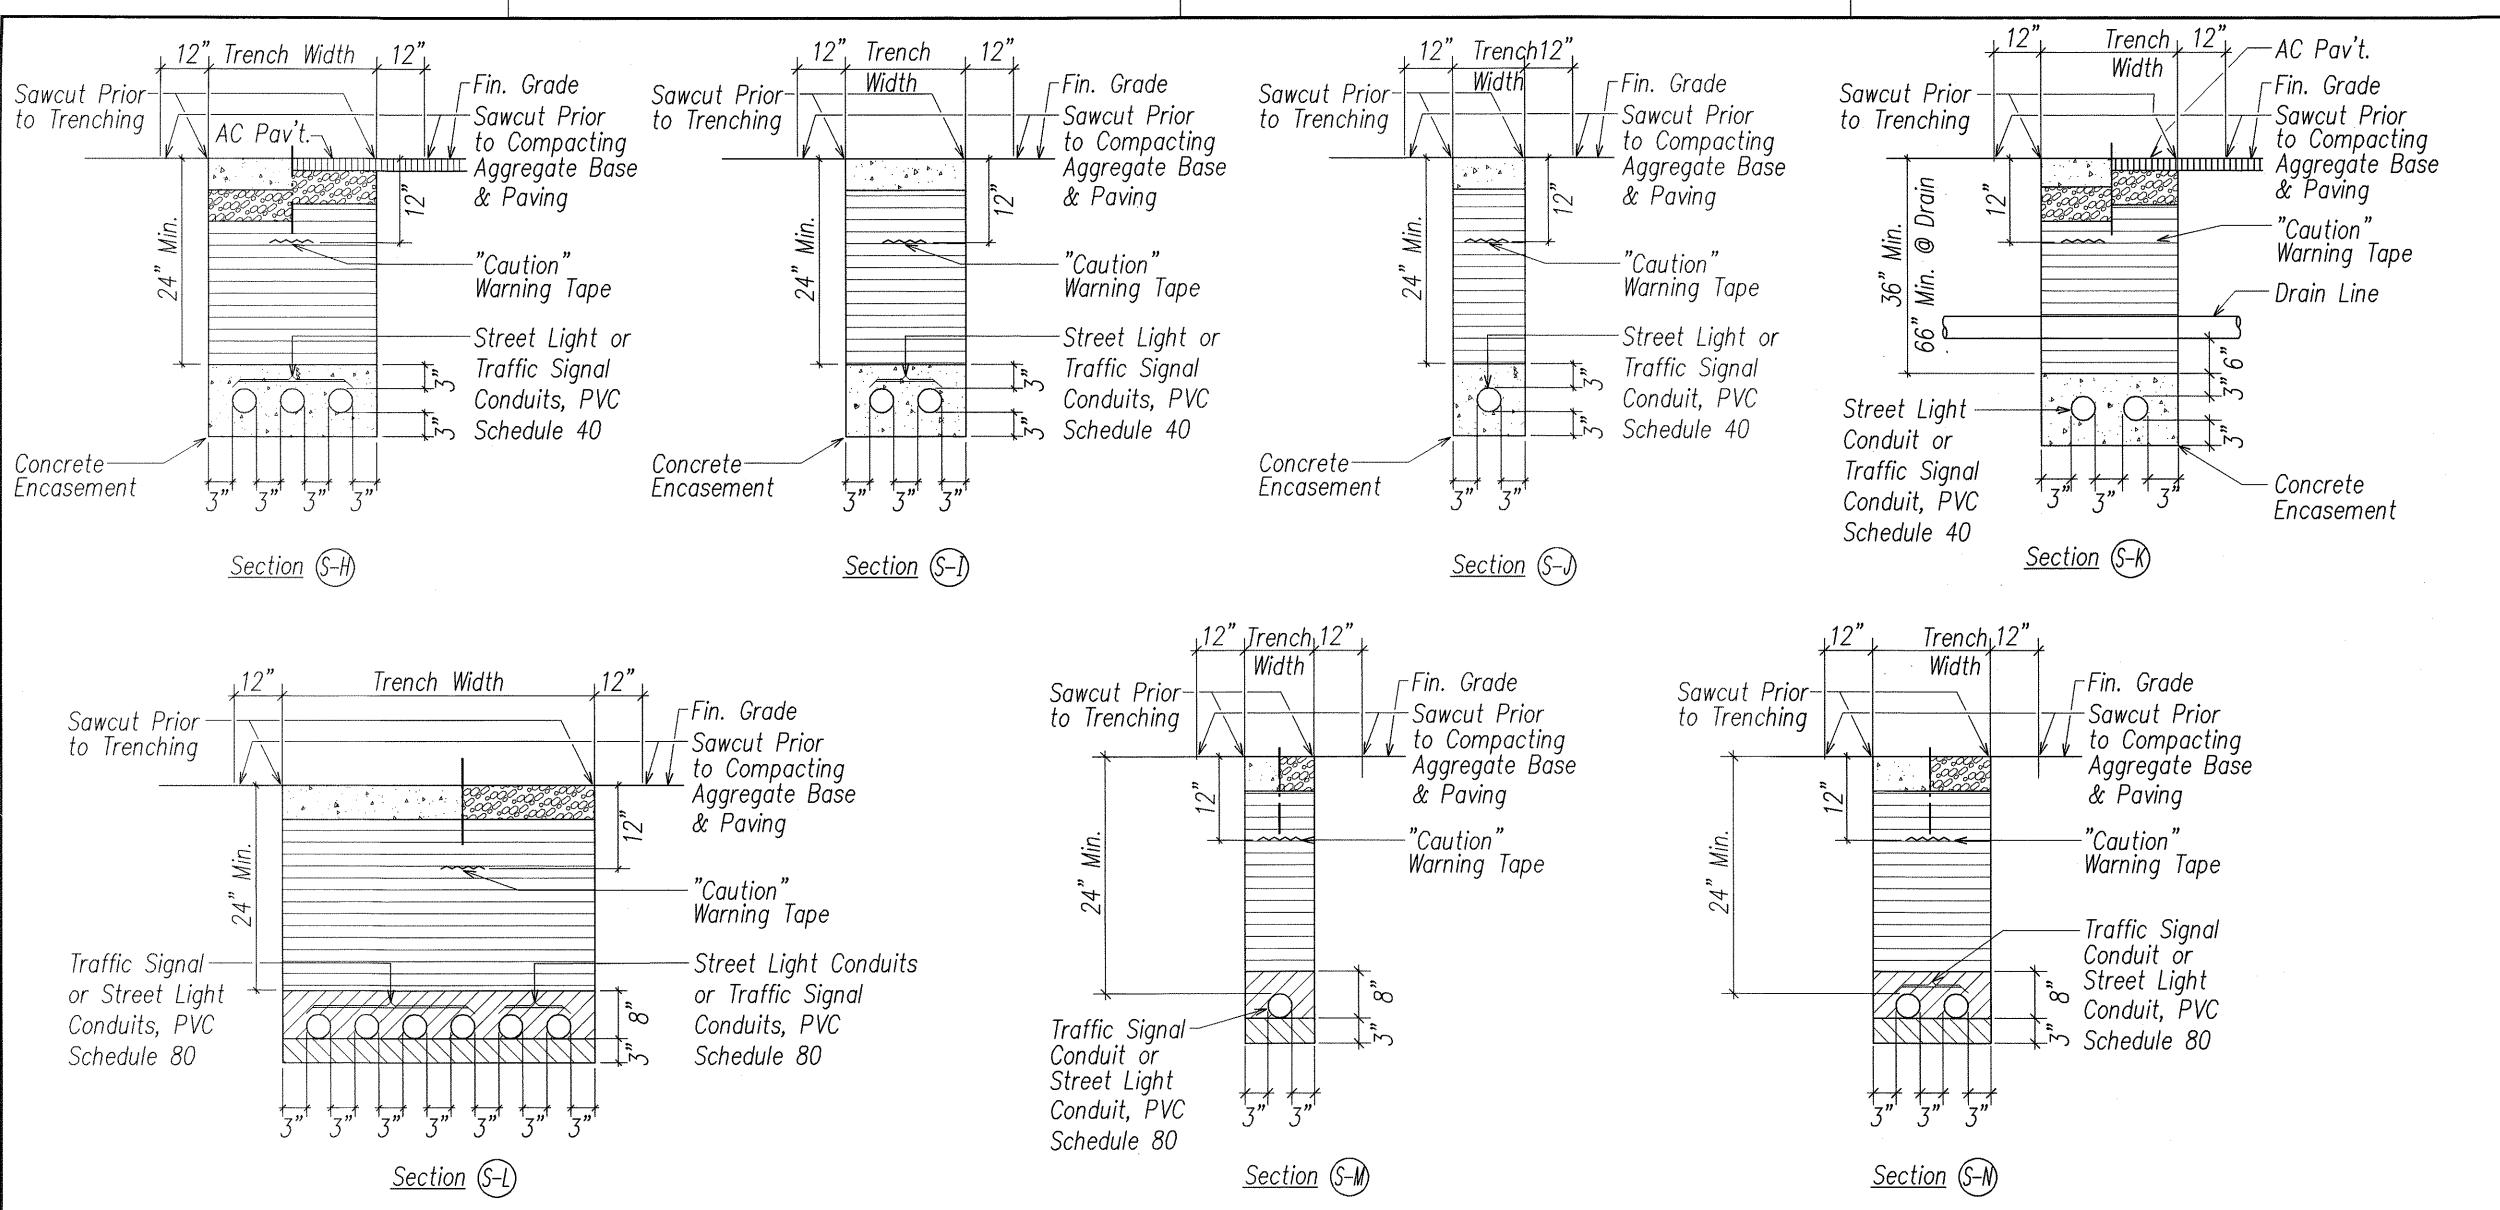



FED. ROAD DIST. NO. STATE FED. AID PROJ. NO. FISCAL SHEET TOTAL SHEETS

HAWAII HAW. STP-8930(1) 2005 122 144

	CONDUIT SCHEDULE
Item	Description
(2-2E)	HECo 2-2" Conduits (PVC Schd. 40)
(6-2E)	HECo 6-2" Conduits (PVC Schd. 40)
(3E)	HECo 3" Conduit (PVC Schd. 40)
(2-4E)	HECo 2-4" Conduits (PVC Schd. 40)
(4-4E)	HECo 4-4" Conduits (PVC Schd. 40)
(2-5 <u>f</u>)	HECo 2-5" Conduits (PVC Schd. 40)
(2-6E)	HECo 2-6" Conduits (PVC Schd. 40)
(4-6E)	HECo 4-6" Conduits (PVC Schd. 40)
(6-6E)	HECo 6-6" Conduits (PVC Schd. 40)
(47)	HTCo 4" Conduit
	HTCo 2-4" Conduits
 > <	
	HTCo 6-4" Conduits
(8-47)	HTCo 8-4" Conduits
	Street Light $1\frac{1}{4}$ " Conduit Street Light $1\frac{1}{2}$ " Conduit
	Street Light 1/2 Conduit
	Street Light 2" Conduit
(7.21)	Street Light 2-2" Conduits Street Light 3-2" Conduits
(4-21)	Street Light 4-2" Conduits
4-21)	Street Light 4-2 Conduits
(4V)	Catv 4" Conduit
(2VS)	Catv 2" Secondary Power Conduit
	The state of the s
(15)	Traffic Signal 1" Conduit
(25)	Traffic Signal 2" Conduit
(2-25)	Traffic Signal 2—2" Conduits
(3-2S)	Traffic Signal 3–2" Conduits
(4-25)	Traffic Signal 4–2" Conduits
(5-25)	Traffic Signal 5–2" Conduits
(6-2S)	Traffic Signal 6–2" Conduits
(7-25)	Traffic Signal 7—2" Conduits
(4S)	Traffic Signal 4" Conduit

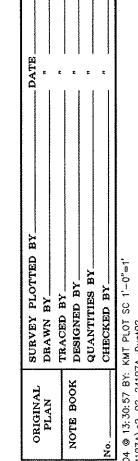

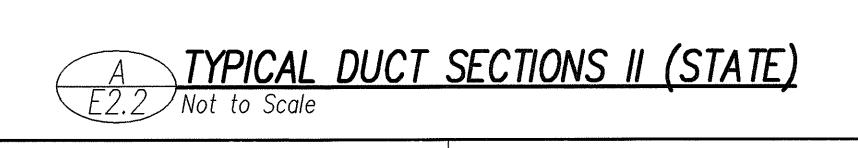

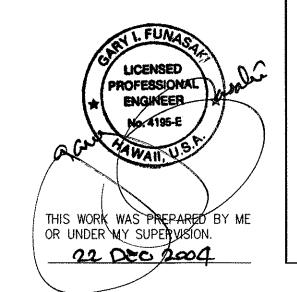


DEPARTMENT OF TRANSPORTATION
HIGHWAYS DIVISION

TYPICAL DUCT SECTIONS II

<u>North-South Road</u> <u>Phase 1A</u> F.A.I. Proj. No. STP-8930(1)

Scale: AS NOTED

Date: DEC. 22, 2004

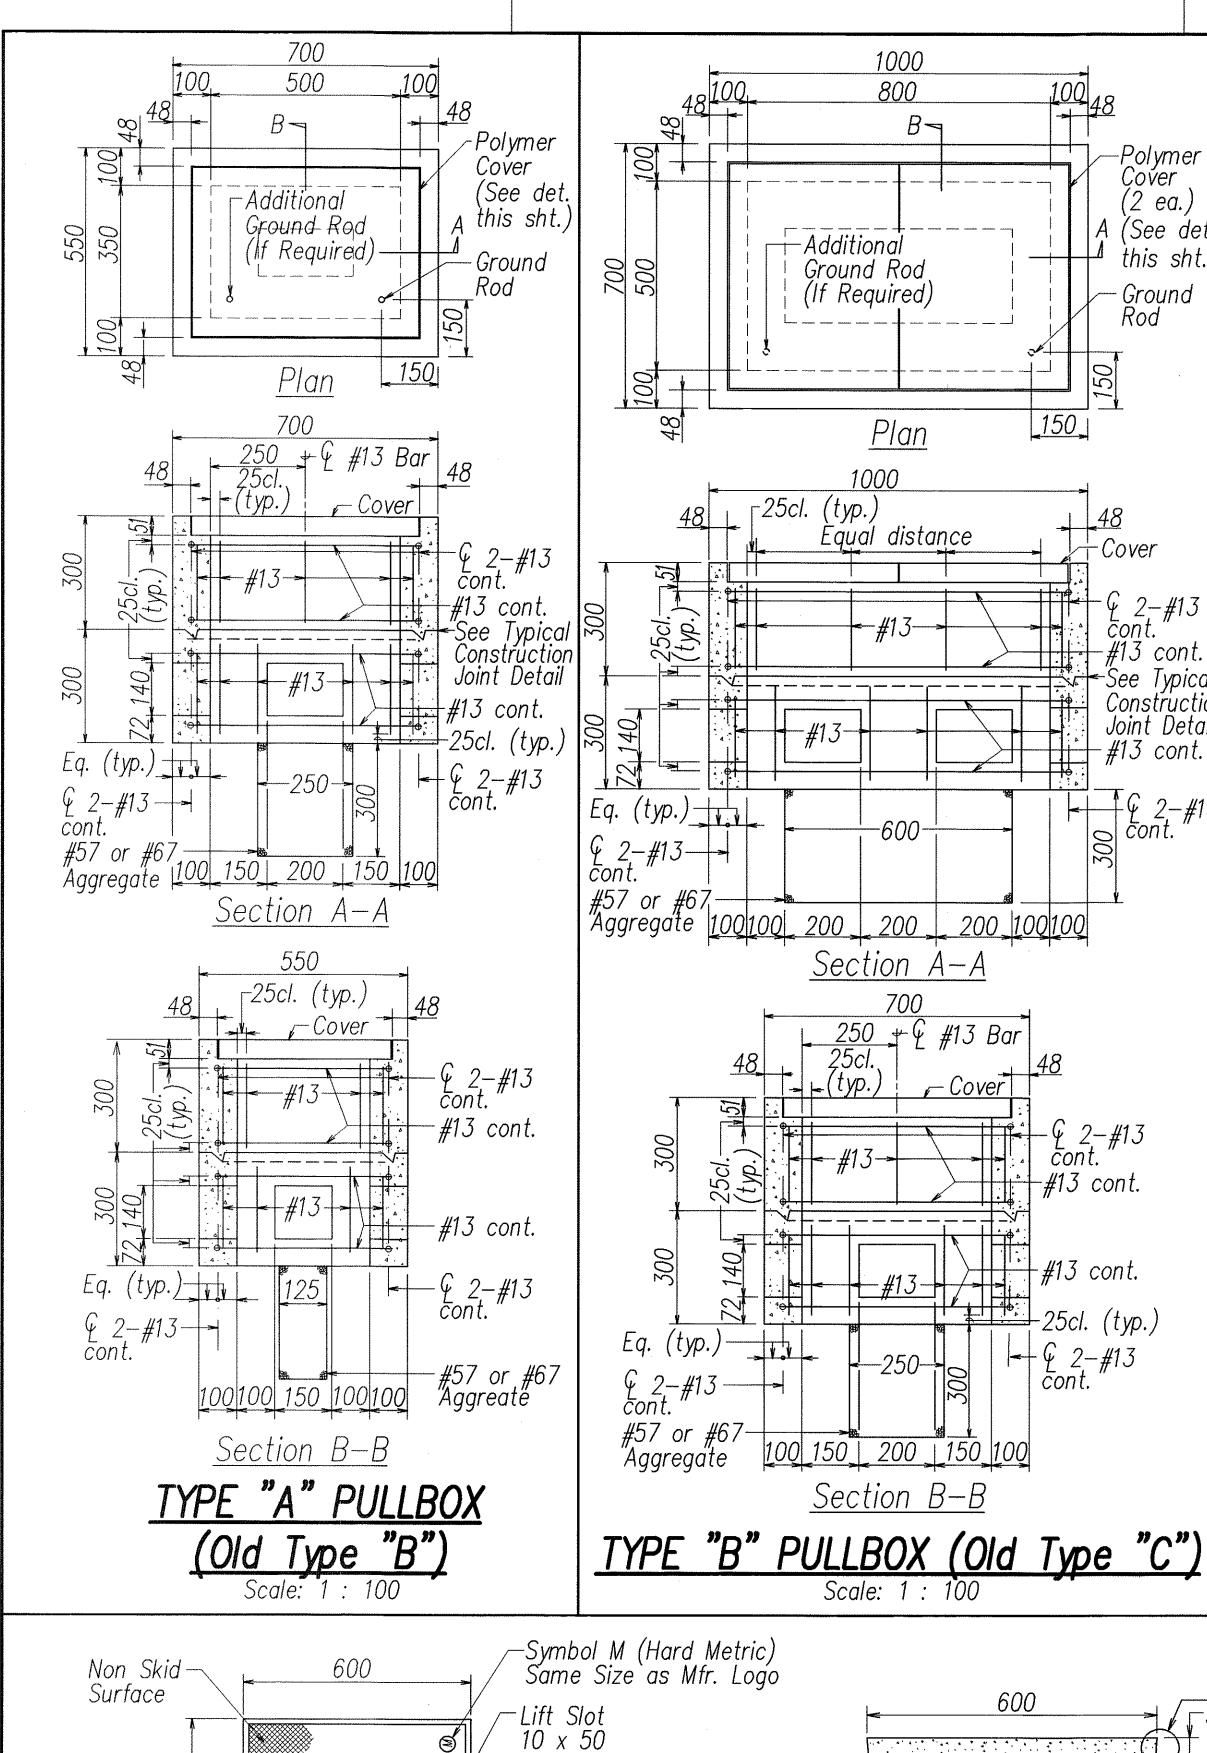

TRAFFIC SIGNAL of HWY LIGHTING SIGNAL RAFFIC SIGNAL HWY LIGHTING as specified


SURVEY PLOTITE
DRAWN BY
TRACED BY
DESIGNED BY
QUANTITIES BY.
CHECKED BY.
KMT PLOT SC 1'-0"=


450

Manufacturer's →

Plan View

Logo

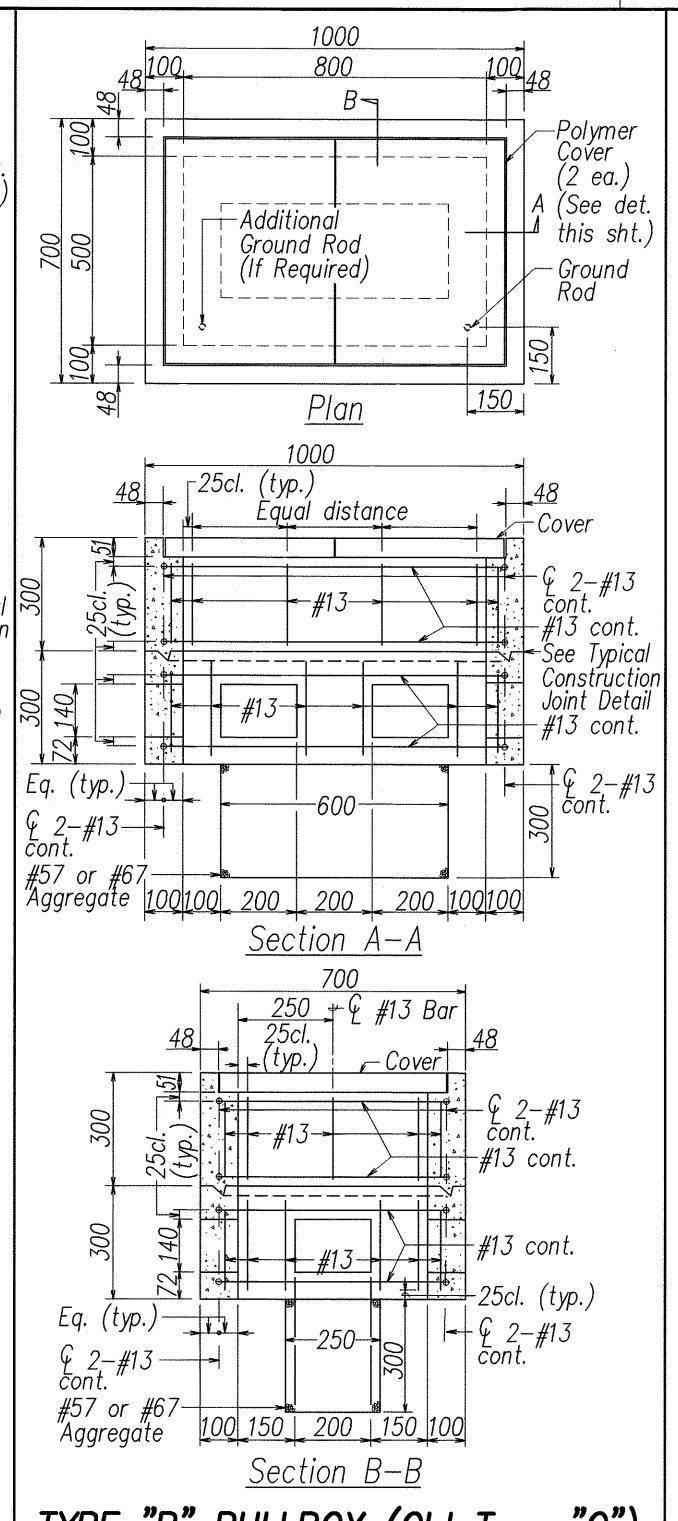


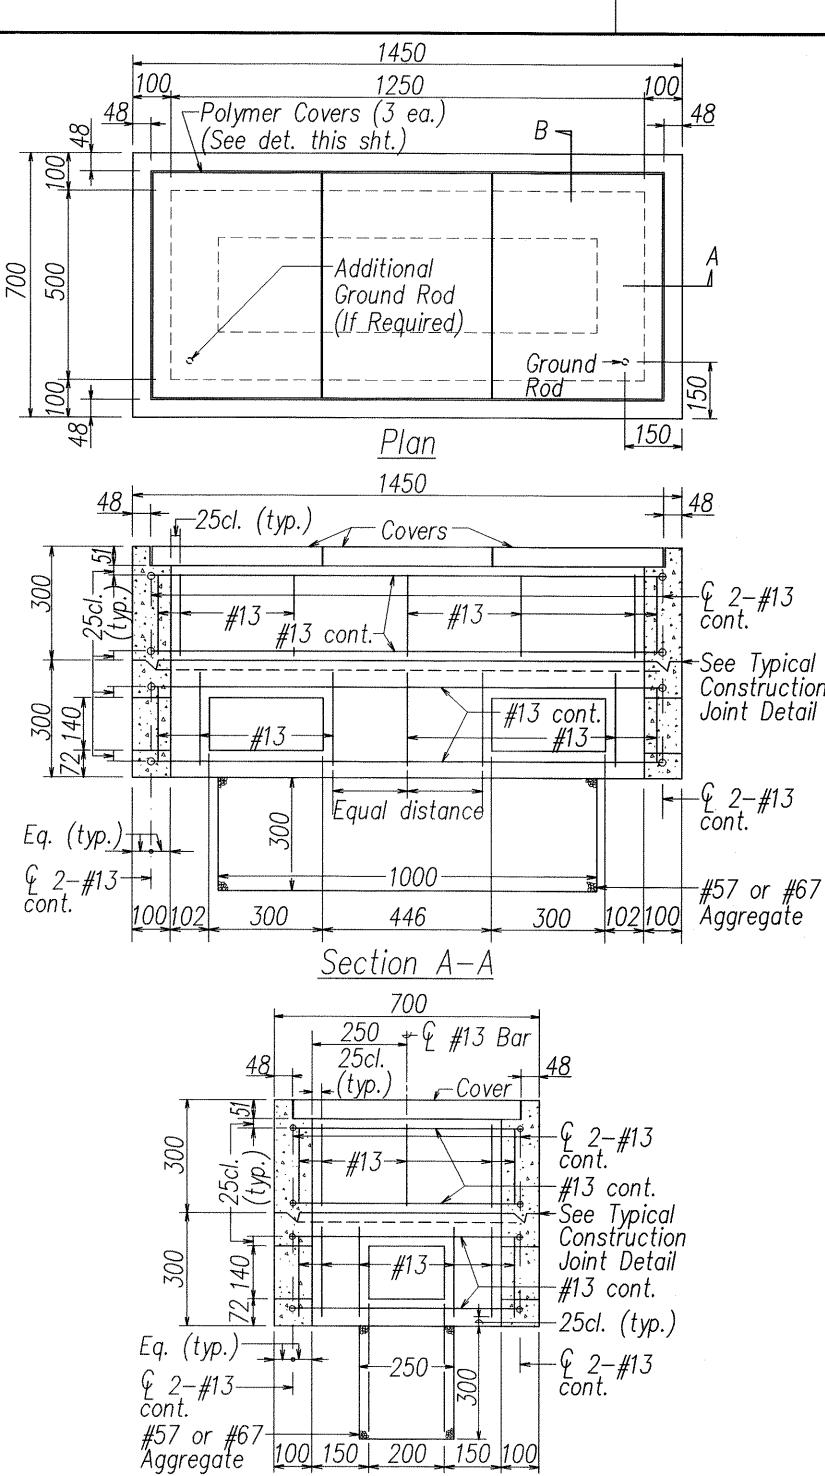


Section B-B TYPE "C" PULLBOX (Old Type "D")

600 594 **Elevation**

POLYMER CONCRETE COVER Not to Scale

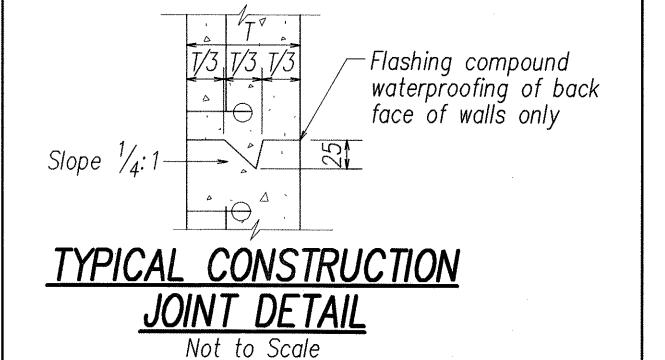

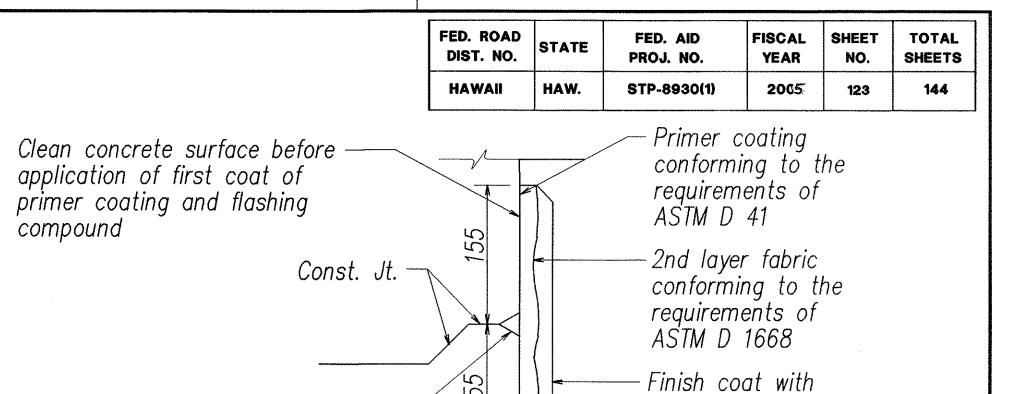

TYPICAL FLASHING COMPOUND WATERPROOFING DETAILS

Not to Scale

General Notes:

Flashing compound conforming


to the requirements of ASTM D 4586

- . Provide a minimum of one $16 \ \emptyset \ x \ 2.5 m$ Copperweld Ground Rod in each pullbox. When directed by the Traffic Signal Inspector/Engineer, install additional Ground Rods. Cost of Ground Rods shall be incidental to the pullboxes.
- 2. All pre-cast concrete pullboxes shall be manufactured in two pieces.
- 3. The pullbox with cover shall be capable of supporting an MS 18 Loading.
- 4. The maximum weight of the pullbox cover shall not exceed 27 kilograms.
- 5. The openings for the conduits on all pullboxes shall be pre-cast concrete knockouts.
- 6. After installing the conduits in the openings of the pullboxes, the Contractor shall fill the excess opening in the pre—cast knockouts with concrete mortar.
- 7. Prior to installing the pullboxes, the Contractor shall level the bottom of the trench and achieve a minimum of 95% relative compaction of the bottom of the trench.
- 8. All concrete shall be Class A (25MPa, min.)
- 9. Rebars shall be Grade 300 and all lapped splices shall be 360mm minimum.
- 10. The #57 or #67 size aggregate shall conform to latest version of AASHTO M43 (ASTM D 448).
- 11. Type "Ç" Pullbox shall be installed in a location protected from vehicular traffic (i.e. raised sidewalk, behind A.C. curbs, traffic signal standard or pipe guards).

All Dimensions are in Millimeters unless Otherwise shown.

flashing compound conforming to the

requirements of ASTM D 4586

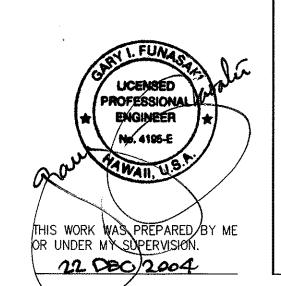

DEPARTMENT OF TRANSPORTATION


PULLBOX & COVER (STATE) DETAILS North-South Road


Phase 1A F.A.I. Proj. No. STP-8930(1)

Scale: AS NOTED


Date: DEC. 22, 2004 SHEET No. E2.3 OF 15 SHEETS

123

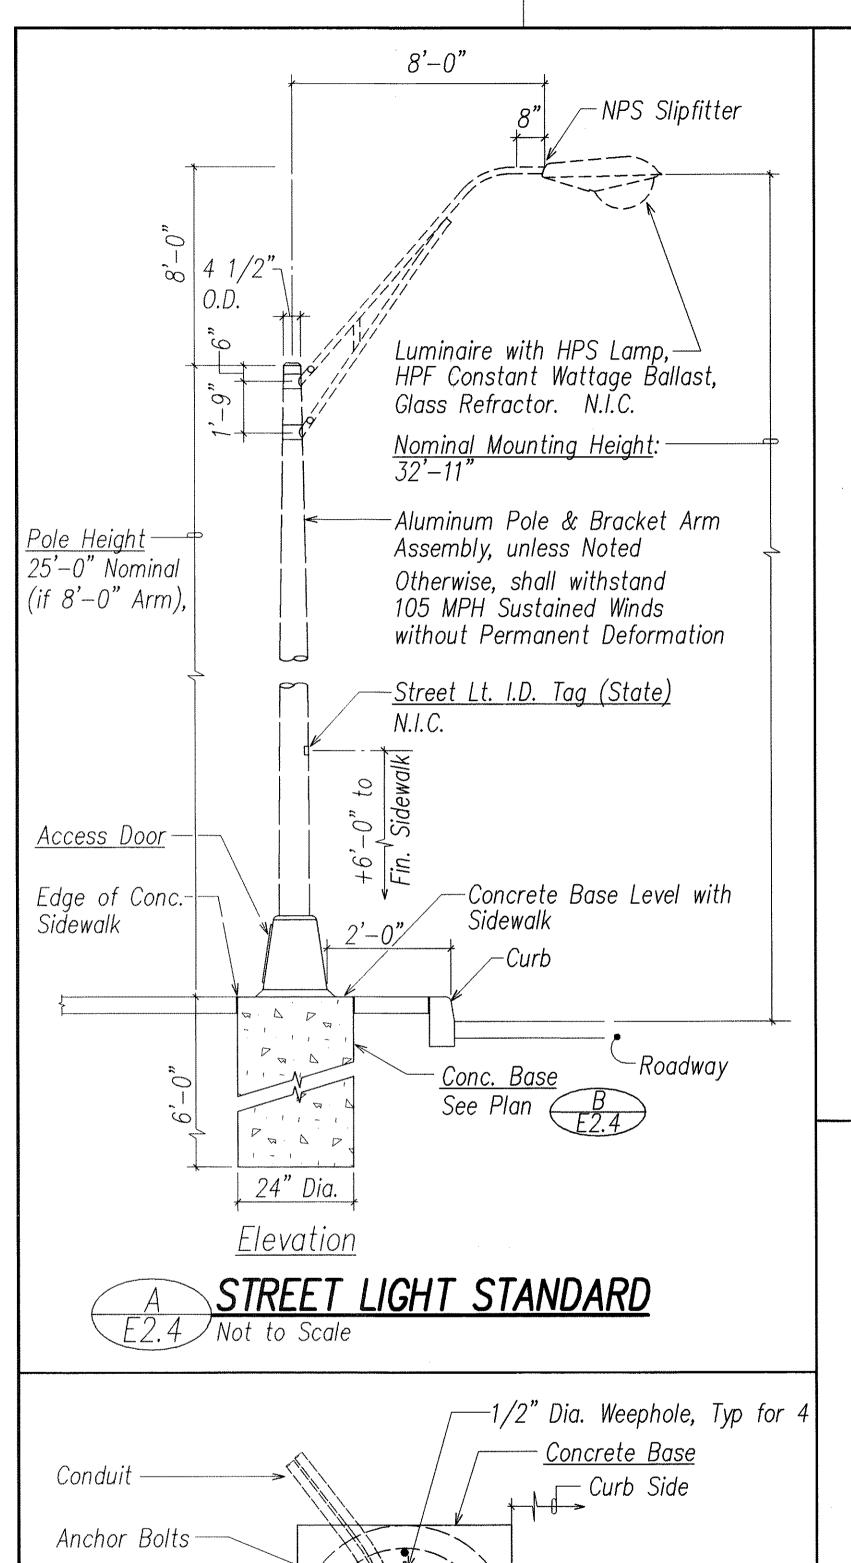

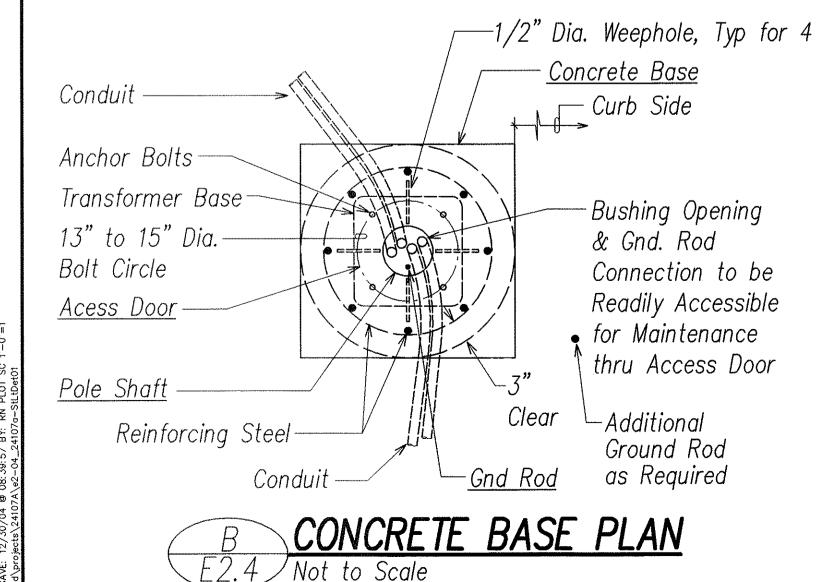


SURVEY PLOTTY
DRAWN BY____
TRACED BY___
DESIGNED BY_
QUANTITIES BY
CHECKED BY___

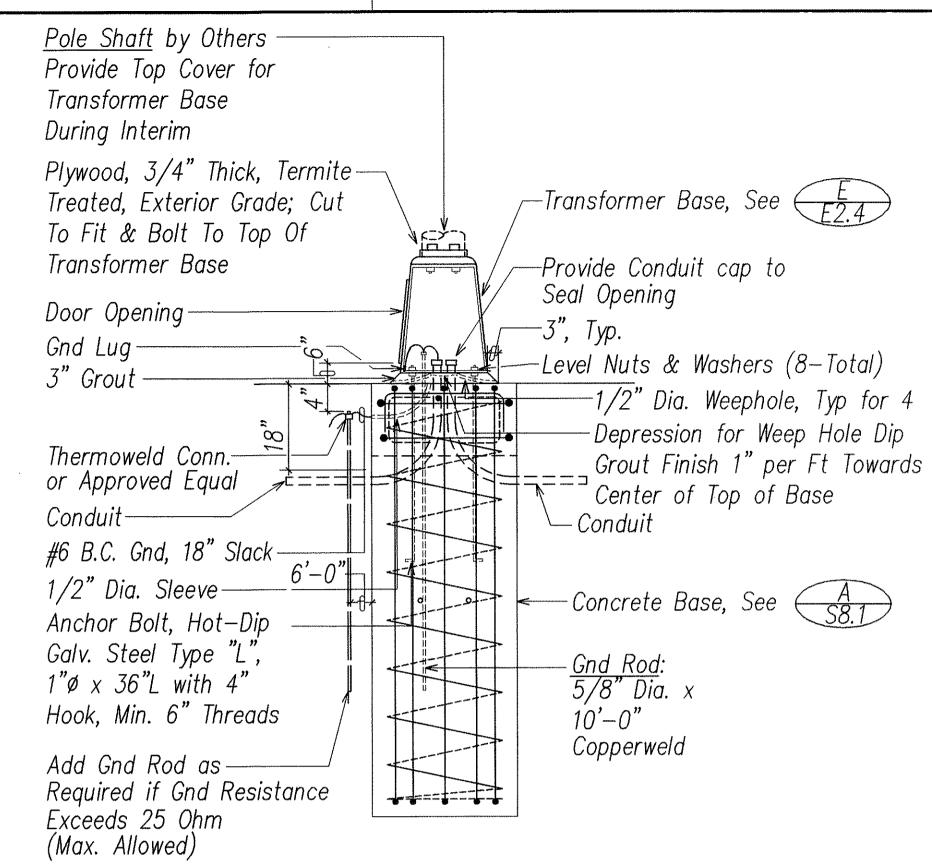

Note: See Concrete Base Plan B/E2.4 & Structural Drawings

CONCRETE BASE ELEVATION E2.4 Not to Scale

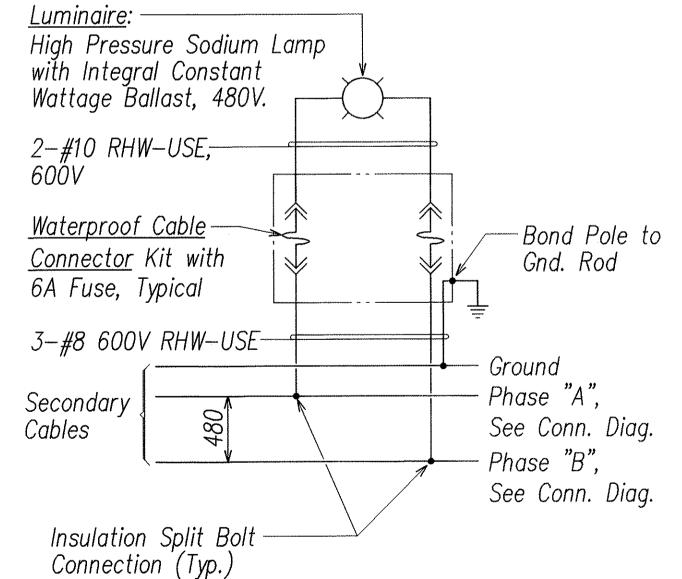

Note: All Neutral Conductors shall be identified with white insulation. Other means of identification is not acceptable.



NOT TO SCALE - Flush With Grade 2" High Letters Engraved In Marker D D "E" = Electric T" = Telephone "V" = CatvConcrete L'' = LightCONCRETE CONDUIT STUB-OUT MARKER E2.4 Not to Scale

FED. ROAD DIST. NO. FED. AID FISCAL STATE YEAR PROJ. NO. SHEETS 2005 HAWAII HAW. STP-8930(1) 124

Base Shall Be Supplied With:

- 1. Door and 1/4"-20NC S.S. screw
- 2. Eight 1" washers 1/2" thick x 2 3/4" O.D. (Washers mechanical galvanized per ASTM B454)
- 3. Four 1"-8NC \times 3 3/4" long galvanized steel hex. hd. bolts
- 4. Four 1"-8NC galvanized steel hex.
- 5. Four 1" galvanized stl. lock washers
- 6. Four 1" x 2" O.D. galvanized stl. flatwashers

1/4"-20NC Tapped Hole (Back Wall)

4043 Weld Filler (Heat Treat After Welding)

Akron Foundry TB1-AF 1315-17 I.W. OR Equal (Plus Hardware)

<u>Material: Alum. Alloy 356-T6</u>

13" to 15" Dia. Bolt Circle

BREAKAWAY TRANSFORMER BASE (ALUMINUM) DETAIL

10 1/2" to 13 1/2" Dia.

13 1/8" Sq.

9 1/4"

0

9 3/4"

15 3/8" Sq.


Bolt Circle —

Tamperproof

1/2"-13NC-

Tapped Hole

S.S. Screw

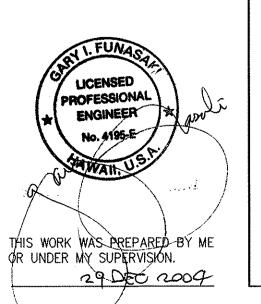


DEPARTMENT OF TRANSPORTATION

STREET LIGHT (STATE) <u>DETAILS I</u>

North-South Road Phase 1A F.A.I. Proj. No. STP-8930(1)

Scale: AS NOTED

Date: DEC. 22, 2004 SHEET No. E2.4 OF 15 SHEETS

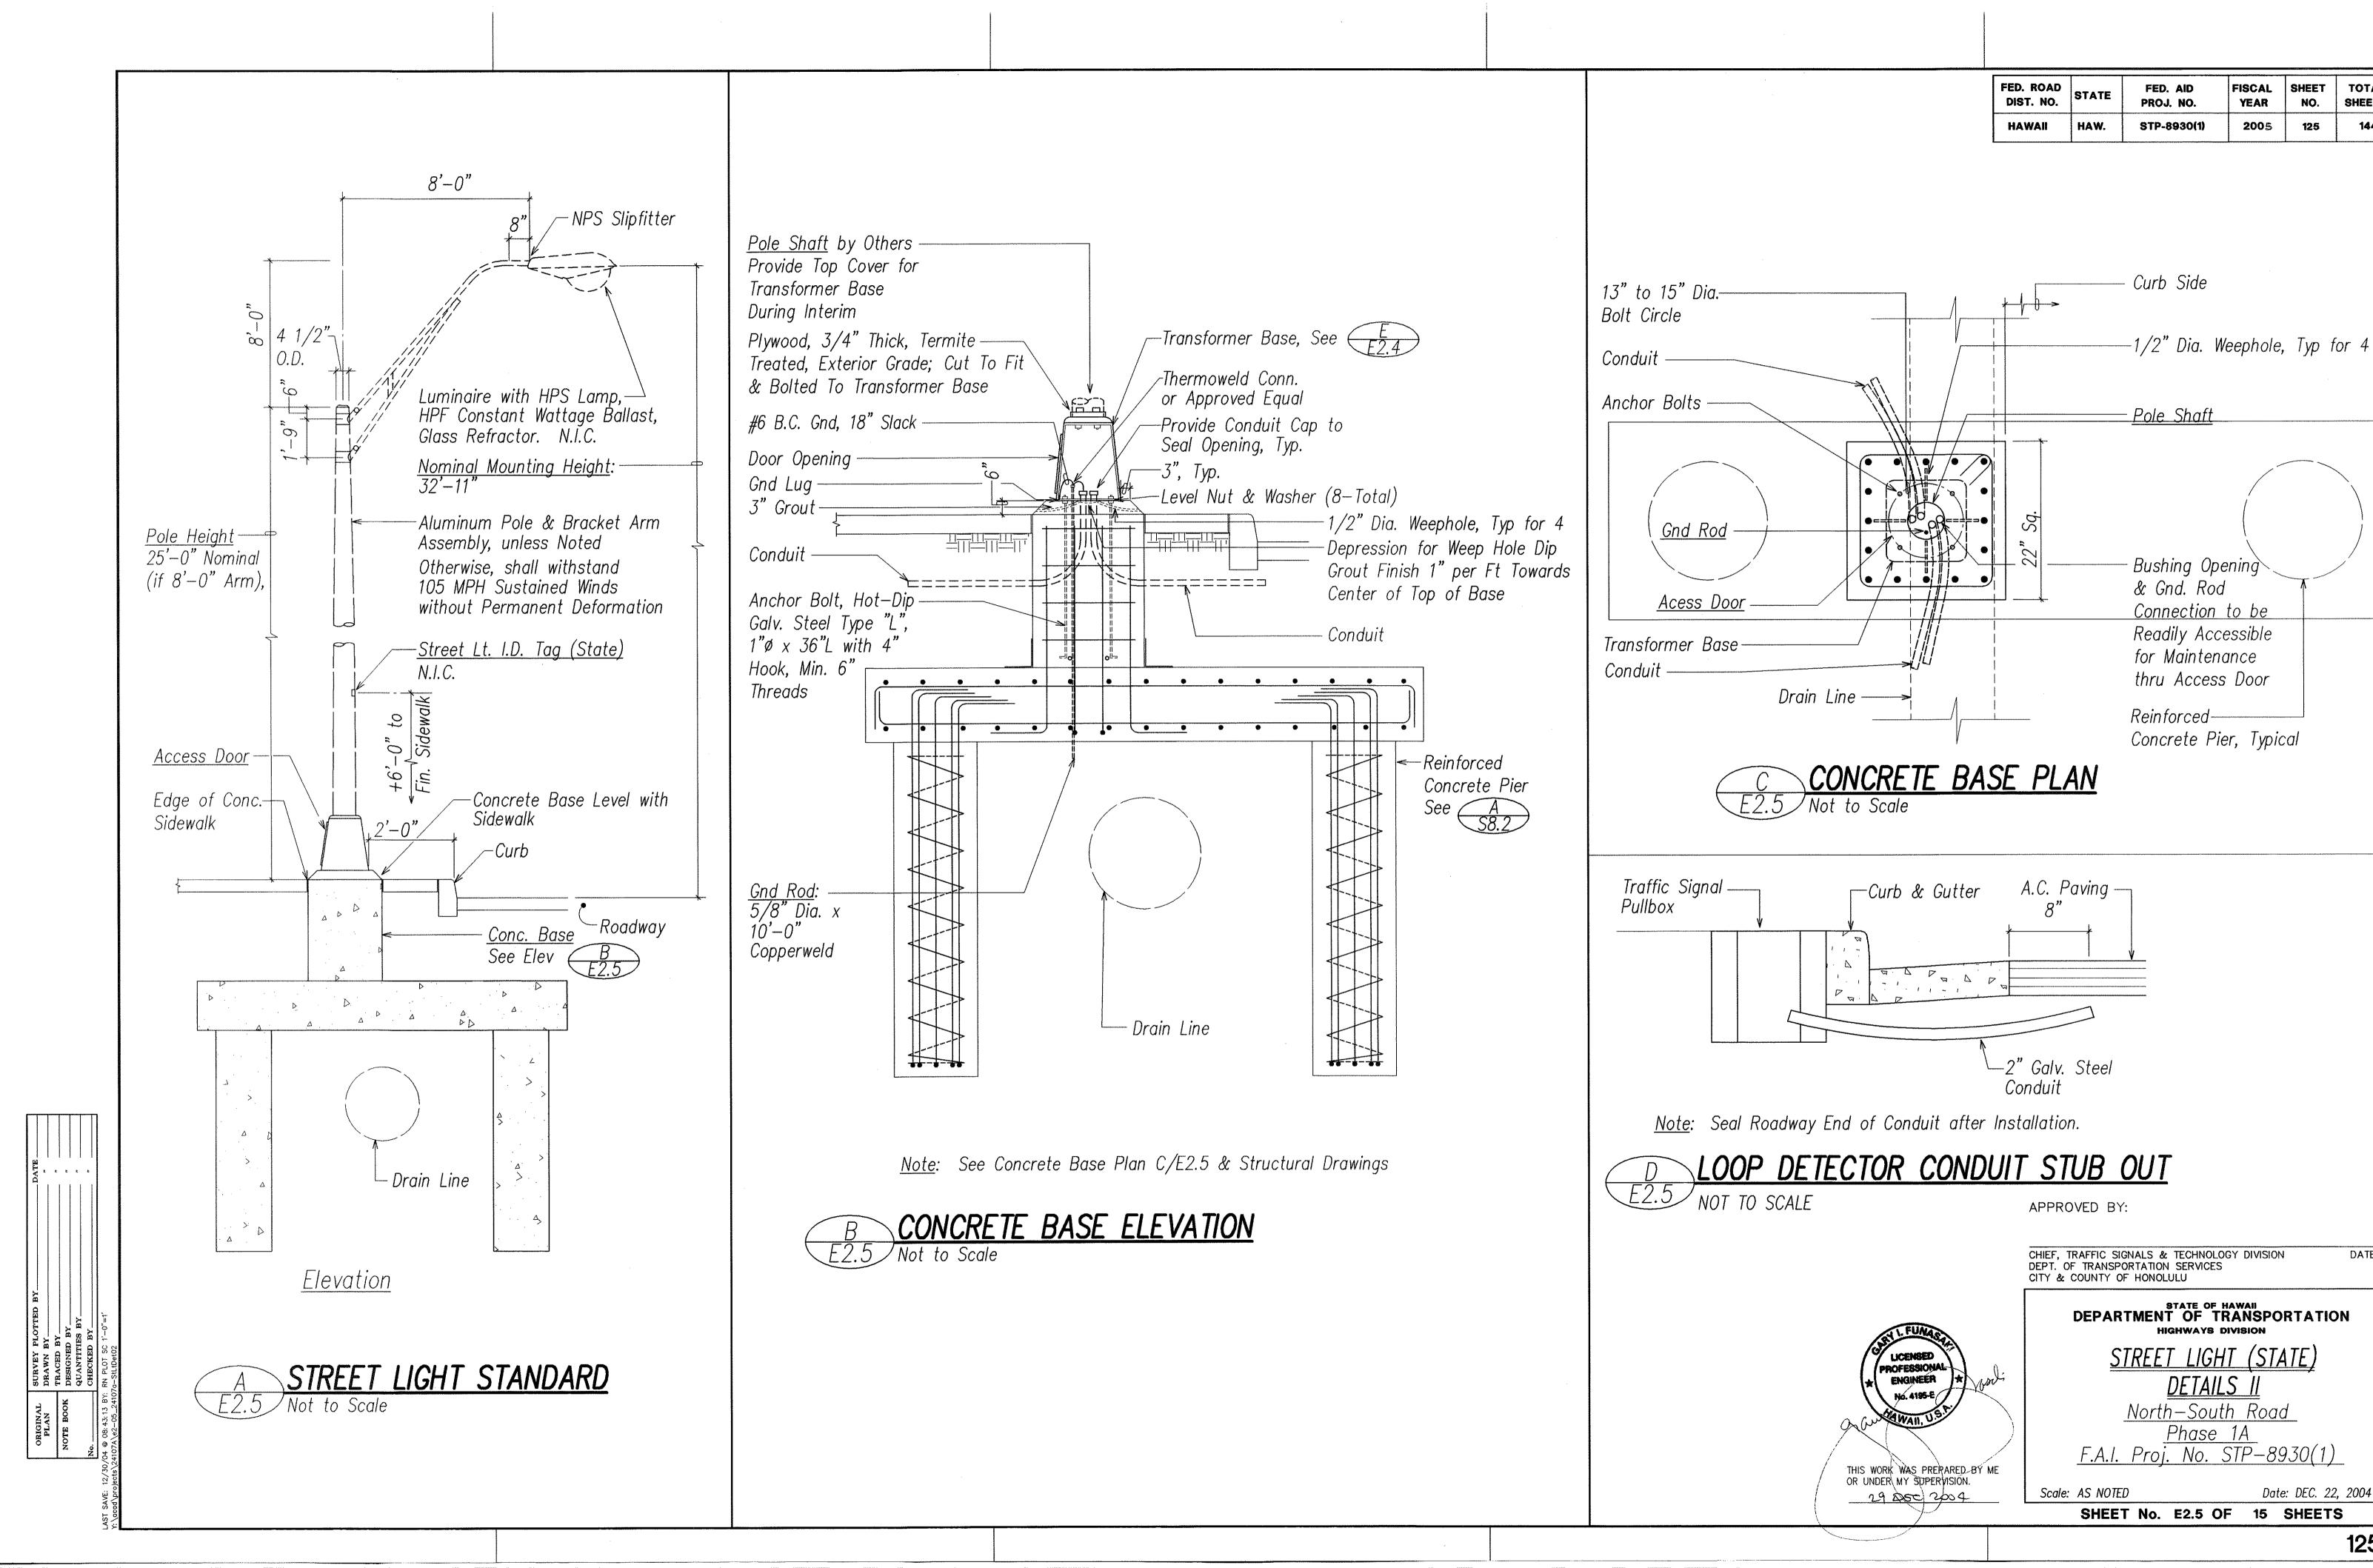

Date: DEC. 22, 2004

DATE

FISCAL YEAR

2005

125

TOTAL SHEETS