
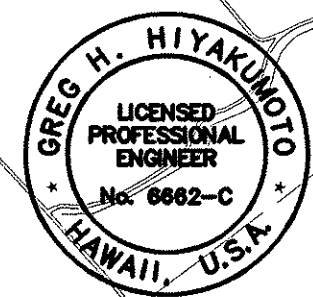
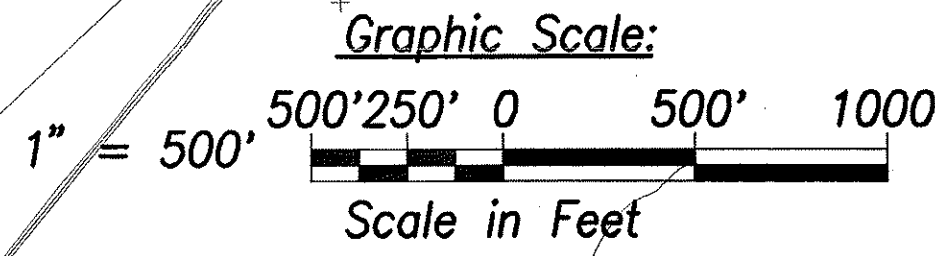


FED. ROAD DIST. NO.	STATE	FED. AID PROJ. NO.	FISCAL YEAR	SHEET NO.	TOTAL SHEETS
HAWAII	HAW.	STP-8930(1)	2005	ADD. 12	144

True North
1" = 500'

SURVEY PLOTTED BY	DATE
DRAWN BY	
DESIGNED BY	
QUANTITIES BY	
CHECKED BY	
ORIGINAL PLAN	
NOTE BOOK	
No.	

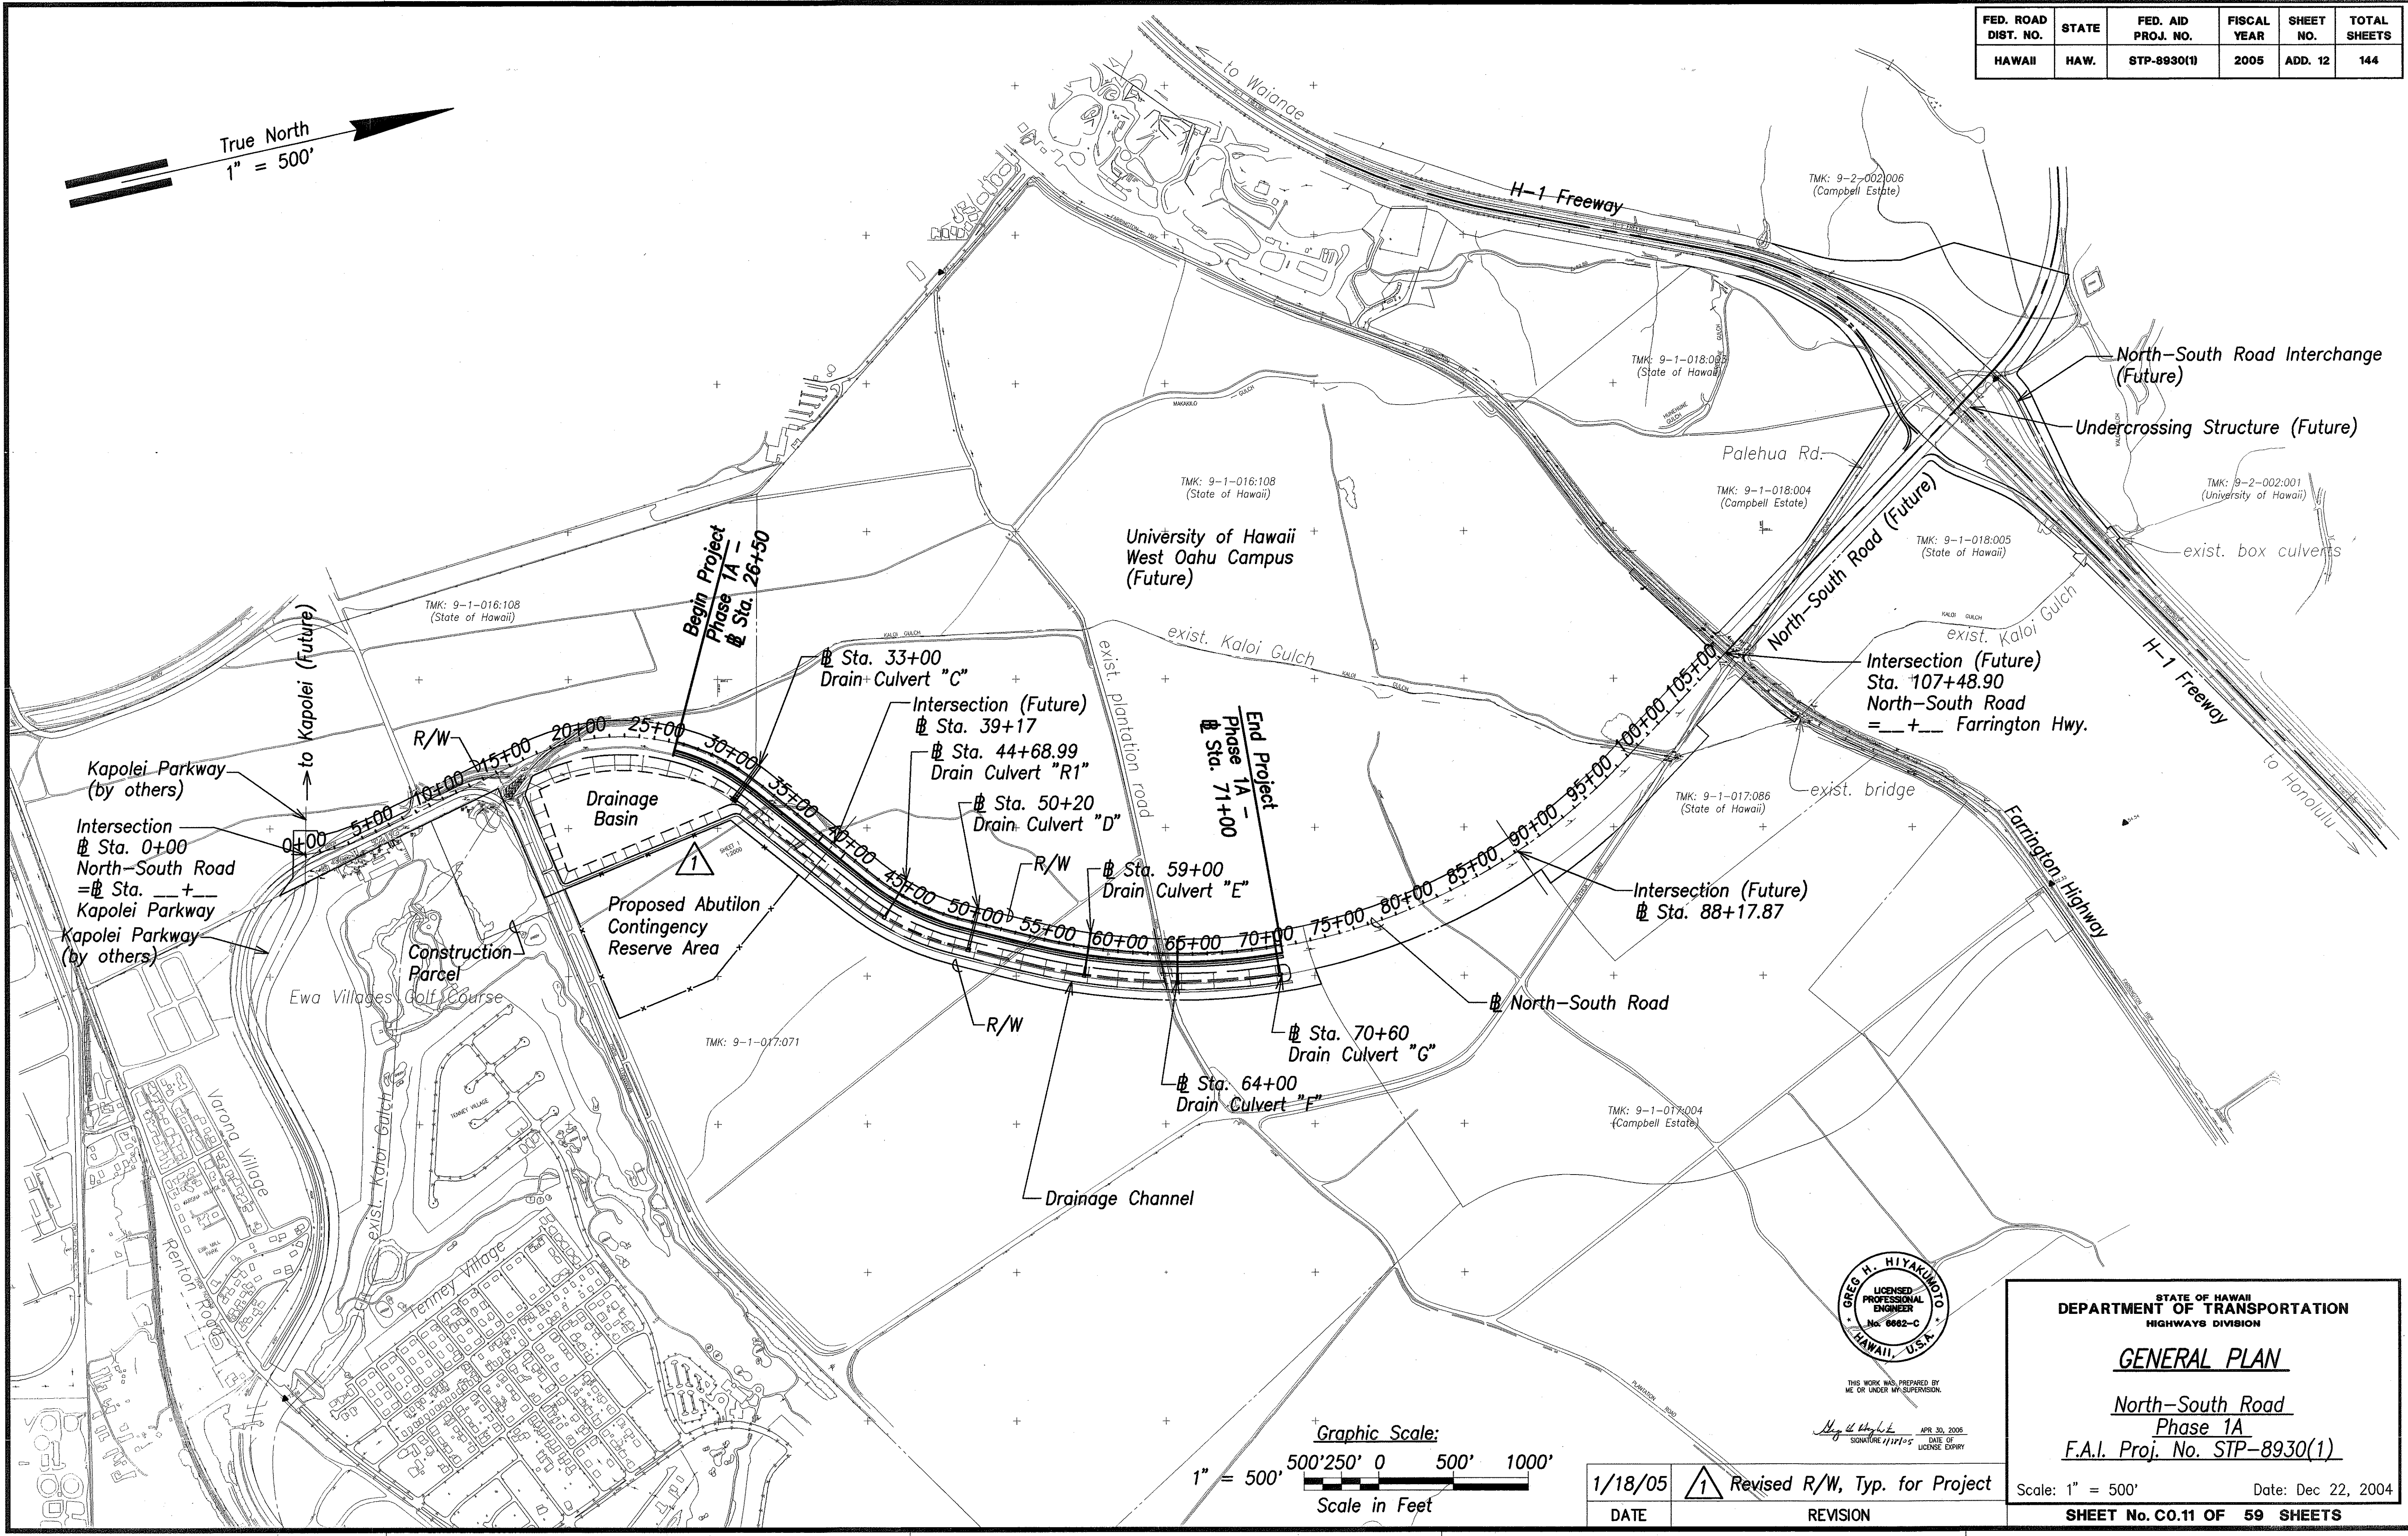

THIS WORK WAS PREPARED BY ME OR UNDER MY SUPERVISION.
DATE OF LICENSE EXPIRY: APR 30, 2006
SIGNATURE: [Signature]

1/18/05	Revised R/W, Typ. for Project
DATE	REVISION

STATE OF HAWAII
DEPARTMENT OF TRANSPORTATION
HIGHWAYS DIVISION

GENERAL PLAN

North-South Road
Phase 1A
F.A.I. Proj. No. STP-8930(1)

Scale: 1" = 500'
Date: Dec 22, 2004
SHEET No. C0.11 OF 59 SHEETS