

FED. ROAD DIST. NO.	STATE	FED. AID PROJ. NO.	FISCAL YEAR	SHEET NO.	TOTAL SHEETS
HAWAII	HAW.	STP-8930(1)	2005	2	144

ORIGINAL PLAN	SURVEY PLOTTED BY _____ DATE _____	
	DRAWN BY _____	
NOTE BOOK	TRACED BY _____	
	DESIGNED BY _____	
	QUANTITIES BY _____	
No. _____	CHECKED BY _____	
	_____	


"AS-BUILT"	2
------------	---

OVERALL INDEX

FED. ROAD DIST. NO.	STATE	FED. AID PROJ. NO.	FISCAL YEAR	SHEET NO.	TOTAL SHEETS
HAWAII	HAW.	STP-8930(1)	2005	3	144

SHEET NO.	DESCRIPTION	SHEET NO.	DESCRIPTION	SHEET NO.	DESCRIPTION
					BID ADDITIVE ALTERNATE 1
S3.1	DRAIN CULVERT TYPICAL DETAILS AND SECTIONS	E0.1	ELECTRICAL SITE PLAN	AC1.1	DRAINAGE CHANNEL PLAN - 1
S3.2	DRAIN CULVERT "C" OUTLET LAYOUT PLAN AND SECTION	E0.2	ELECTRICAL SYMBOLS	AC1.1	DRAINAGE CHANNEL PLAN - 2
S3.3	DRAIN CULVERT "D" OUTLET LAYOUT PLAN AND SECTION	E0.3	STATE NOTES AND MISCELLANEOUS DETAILS	AC1.3	DRAINAGE CHANNEL PLAN - 3
S3.4	DRAIN CULVERT "C" AND "D" OUTLET SECTIONS AND TYPICAL DETAILS	E0.4	HECO NOTES I	AC1.4	DROP STRUCTURE DETAIL
S3.5	DRAIN CULVERT "C" AND "D" OUTLET SECTION	E0.5	HECO NOTES II	AC1.5	DRAINAGE CHANNEL TYPICAL SECTIONS AND ACCESS ROAD DETAIL
S3.6	DRAIN CULVERT "C" AND "D" OUTLET SECTION			AC1.6	OUTLET DETAILS - 1
		E1.1	ELECTRICAL PARTIAL PLAN - 1	AC1.7	OUTLET DETAILS - 2
S4.1	DRAIN CULVERT "E" - LAYOUT PLAN AND SECTIONS AT DI 33	E1.2	ELECTRICAL PARTIAL PLAN - 2	AC1.8	DRAINAGE SUMMARY - 1
S4.2	DRAIN CULVERT "F" - LAYOUT PLAN AND SECTIONS AT DI 37	E1.3	ELECTRICAL PARTIAL PLAN - 3		
S4.3	DRAIN CULVERT "G" - LAYOUT PLAN AND SECTIONS AT DI 42	E1.4	ELECTRICAL PARTIAL PLAN - 4	AL1.1	GRASSING PLAN - 1
S4.4	DRAIN CULVERT "R1" - LAYOUT PLAN	E1.5	ELECTRICAL PARTIAL PLAN - 5	AL1.2	GRASSING PLAN - 2
S4.5	DRAIN CULVERT "E", "F" AND "G" - SECTIONS			AL1.3	GRASSING PLAN - 3
S4.6	DRAIN CULVERT "E", "F" AND "G" - SECTIONS	E2.1	TYPICAL DUCT SECTIONS I	AL1.4	GRASSING PLAN - 4
		E2.2	TYPICAL DUCT SECTIONS II		
S5.1	DRAIN CULVERT "E" - SECTIONS AT DI 34	E2.3	PULLBOX DETAILS		
S5.2	DRAIN CULVERT "E" - SECTIONS AT DI 34	E2.4	STREET LIGHT (STATE) DETAILS I		
S5.3	DRAIN CULVERT "F" - SECTIONS AT DI 38	E2.5	STREET LIGHT (STATE) DETAILS II		
S5.4	DRAIN CULVERT "G" - SECTIONS AT DI 43				
S5.5	DRAIN CULVERT "F" AND "G" - SECTIONS AT DI 38 AND 43	L0.1	LANDSCAPE KEY PLAN, LEGEND AND NOTES		
S5.6	DRAIN CULVERT "E", "F" AND "G" - SECTIONS				
S5.7	DRAIN CULVERT "E", "F" AND "G" - SECTION	L1.1	GRASSING PLAN - 1		
S5.8	DRAIN CULVERT "R1" - SECTIONS AND DETAIL AT DI 24	L1.2	GRASSING PLAN - 2		
S5.9	DRAIN INLET FRAME AT DI 17, 24, 26, 34, 38 AND 43	L1.3	GRASSING PLAN - 3		
		L1.4	GRASSING PLAN - 4		
S6.1	DRAIN CULVERT "E", "F", "G" AND "R1" OUTLET - LAYOUT PLAN AND SECTIONS	L1.5	GRASSING PLAN - 5		
S6.2	DRAIN CULVERT "E", "F", "G" AND "R1" OUTLET - SECTIONS	L1.6	GRASSING PLAN - 6		
S6.3	TYPICAL GRP APRON SECTIONS AND DETAIL				
S6.4	TYPICAL ADDED REINFORCING AT PIPE OPENING SECTIONS				
S7.1	BOX CULVERT OUTLET EXCAVATION AND PAY LIMITS				
S7.2	RC PIPE CULVERT OUTLET EXCAVATION AND PAY LIMITS				
S8.1	TYPICAL LIGHT POLE FOUNDATION				
S8.2	TYPICAL LIGHT POLE FOUNDATION				
S8.3	LIGHT POLE STRUCTURE EXCAVATION PAY LIMITS				

ORIGINAL PLAN	DATE
DESIGNED BY	
TRACED BY	
NOTED BY	
CHECKED BY	
DATE	

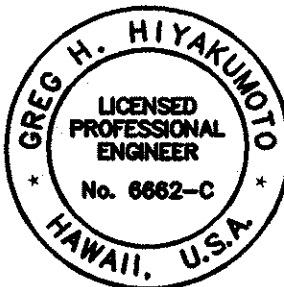

THIS WORK WAS PREPARED BY  
ME OR UNDER MY SUPERVISION.  
*Greg H. Hiyaundo* APR 30, 2006  
DATE OF SIGNATURE DATE OF LICENSE EXPIRY

STATE OF HAWAII  
DEPARTMENT OF TRANSPORTATION  
HIGHWAYS DIVISION

SHEET INDEX - 2  
North-South Road  
Phase 1A  
F.A.I. Proj. No. STP-8930(1)

Date: Dec 22, 2004

SHEET No. C0.2 OF 59 SHEETS