

FED. ROAD DIST. NO.	STATE	FED. AID PROJ. NO.	FISCAL YEAR	SHEET NO.	TOTAL SHEETS
HAWAII	HAW.	STP-8930(1)	2005	17	144

True North
1" = 300'

Benchmark
"NS-MON10"
Alum. Disk
N -14042.99
E 6673.22
Elev.=63.50

TMK: 9-1-016:108
(State of Hawaii)

Benchmark
"NS-MON8"
Alum. Disk
N -12269.27
E 6233.58
Elev.=74.03

Benchmark
"NS-MON9"
Alum. Disk
N -12888.01
E 6299.34
Elev.=72.15

Begin Project
Phase 1A -
Sta. 26+50

TMK: 9-2-002:001
(University of Hawaii)

Benchmark
"NS-MON1"
Alum. Disk
N -5430.67
E 5791.76
Elev.=154.35

TMK: 9-1-018:004
(Campbell Estate)

Benchmark
"NS-MON4"
Alum. Disk
N -7727.98
E 7500.15
Elev.=121.64




TMK: 9-1-017:086
(State of Hawaii)

Benchmark
"NS-MON3"
Alum. Disk
N -6532.15
E 7403.96
Elev.=134.82

TMK: 9-1-017:004
(Campbell Estate)

Benchmark
"NS-MON2"
Alum. Disk
N -5709.05
E 6719.49
Elev.=148.32

SURVEY PLOTTED BY	DATE
DESIGNED BY	
NOTED BY	
CHECKED BY	
DATE	

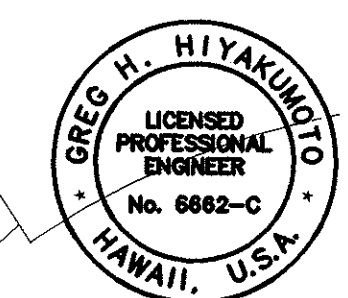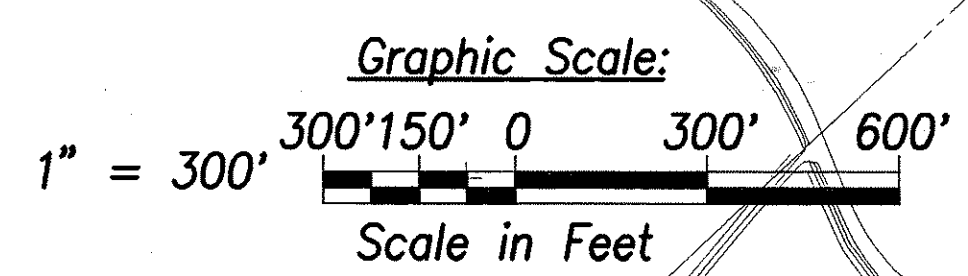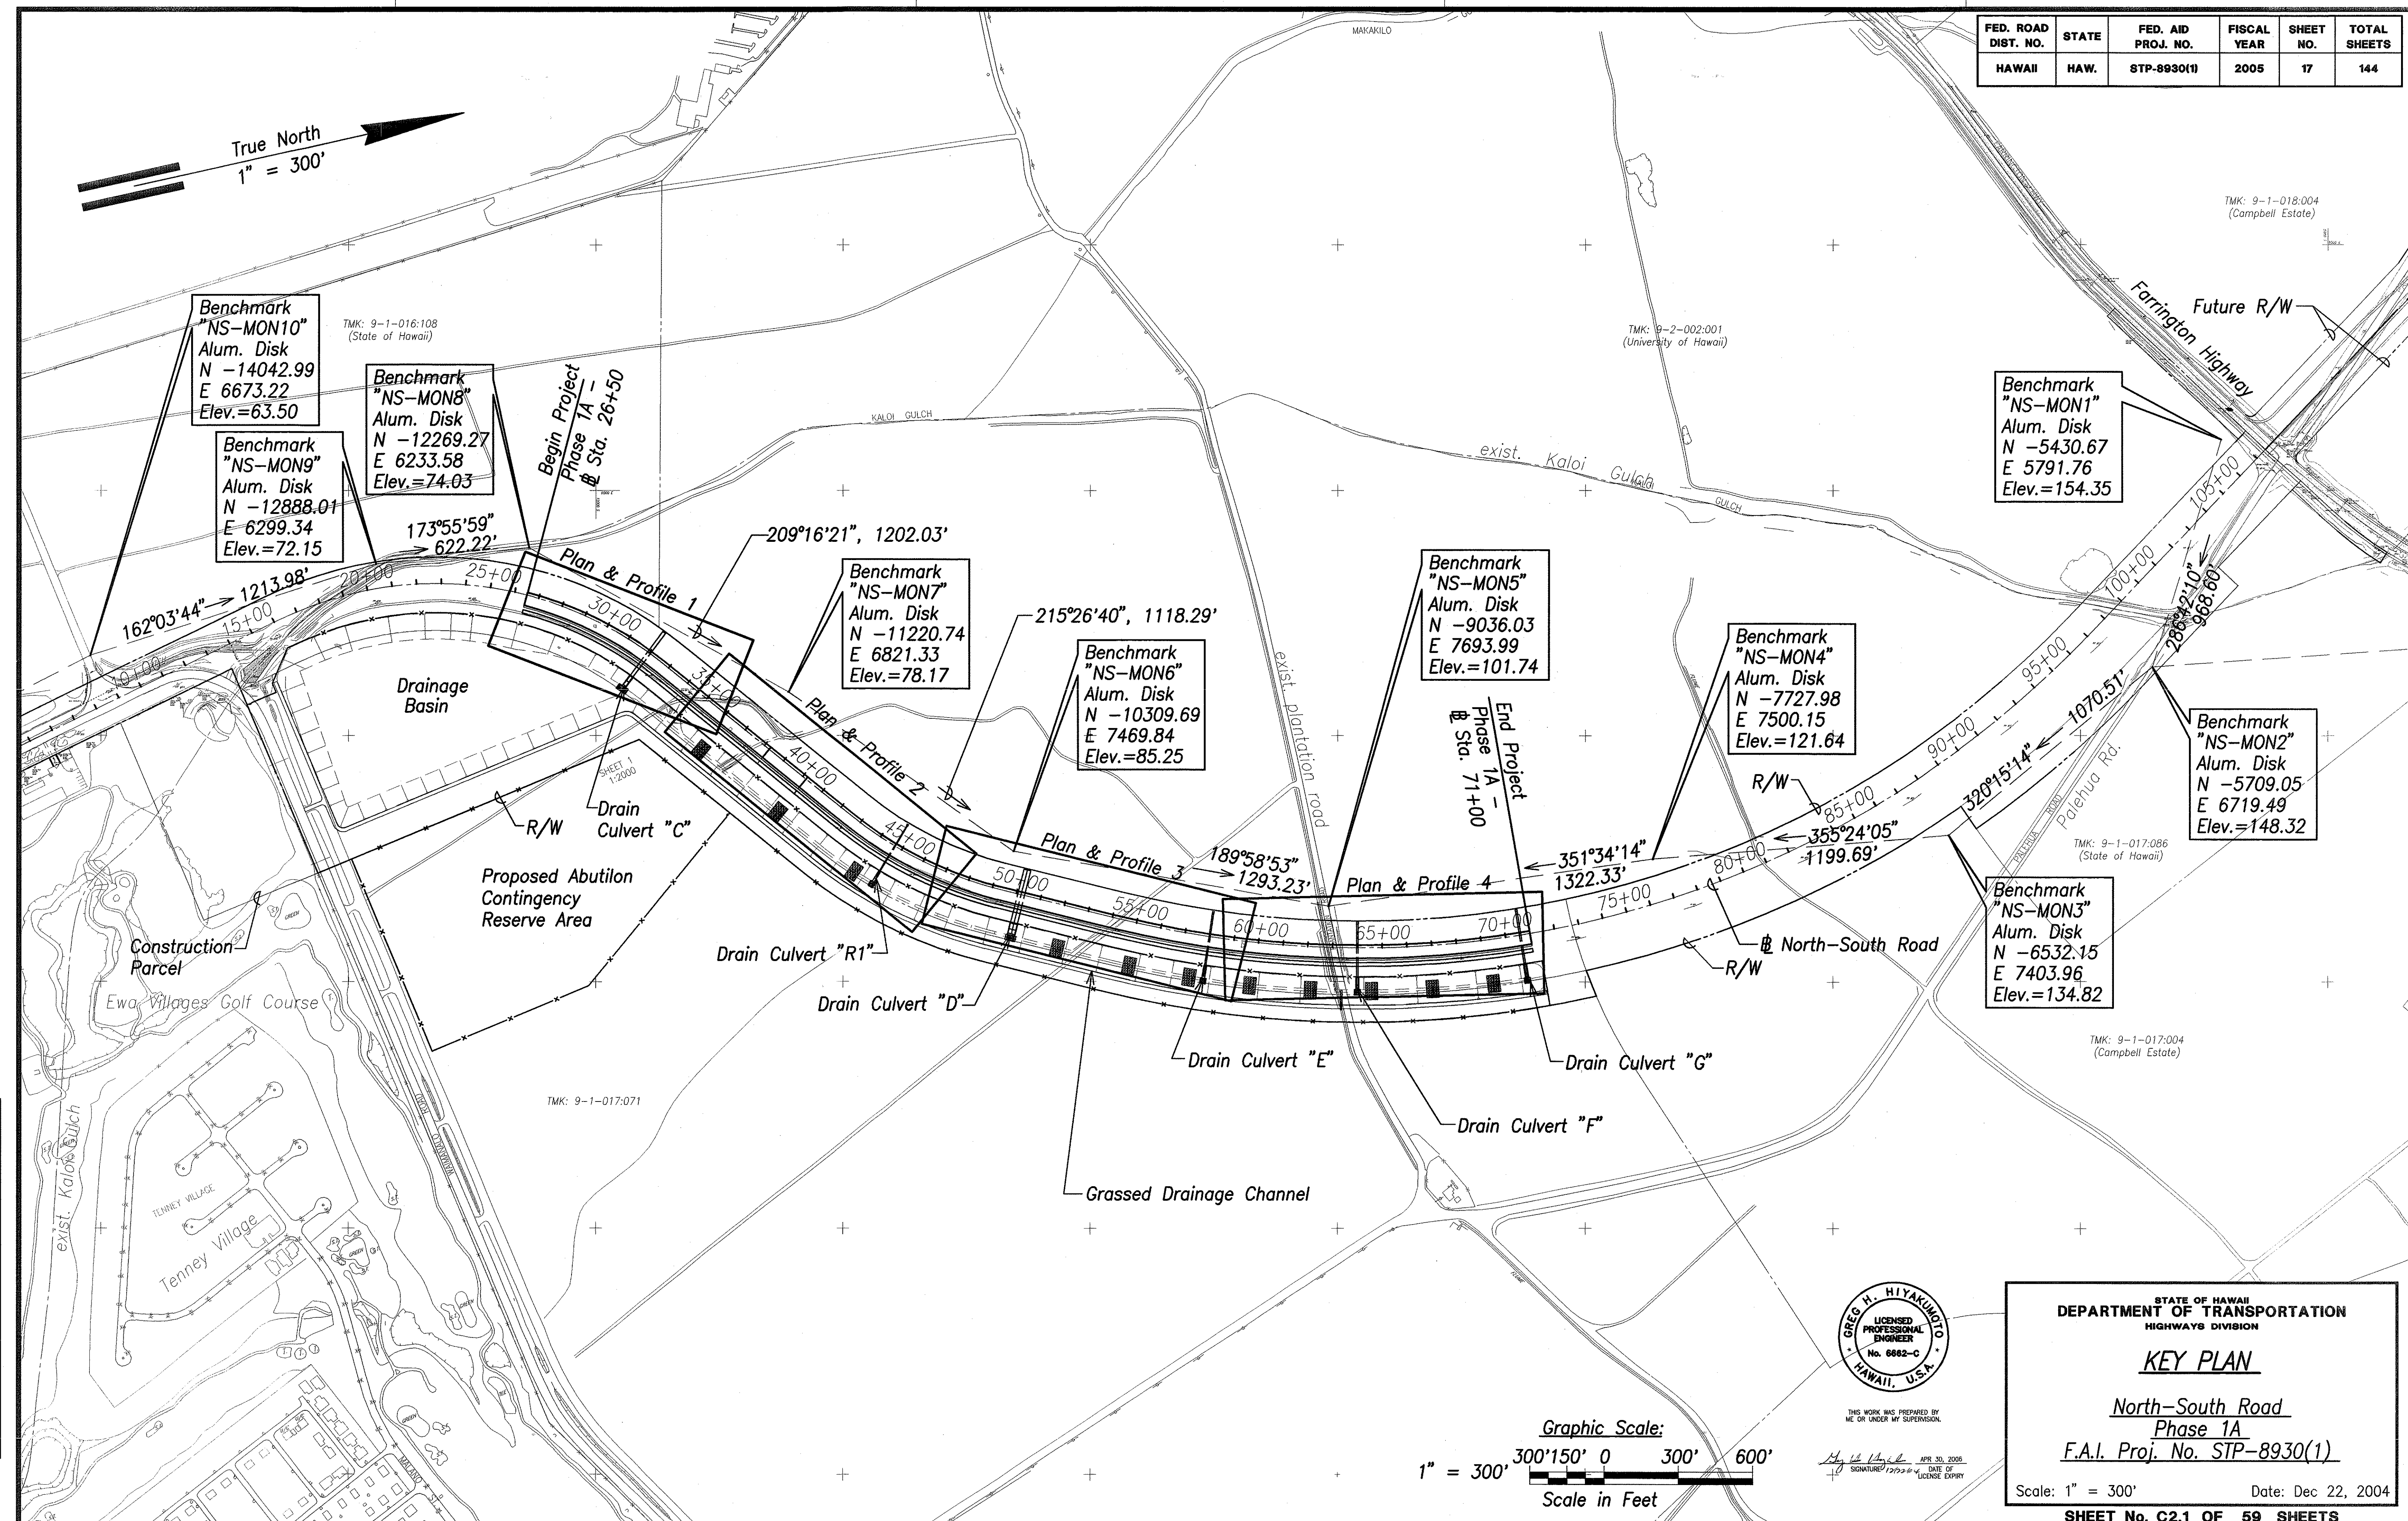

THIS WORK WAS PREPARED BY
ME OR UNDER MY SUPERVISION.
DATE OF LICENSE EXPIRY: APR 30, 2008

STATE OF HAWAII
DEPARTMENT OF TRANSPORTATION
HIGHWAYS DIVISION

KEY PLAN

North-South Road
Phase 1A
F.A.I. Proj. No. STP-8930(1)

Scale: 1" = 300' Date: Dec 22, 2004

SHEET No. C2.1 OF 59 SHEETS

FED. ROAD DIST. NO.	STATE	FED. AID PROJ. NO.	FISCAL YEAR	SHEET NO.	TOTAL SHEETS
HAWAII	HAW.	STP-8930(1)	2005		144

Daylight Ditch to Existing Ground
272°47'19", 194.01'

Tie: "NS-MON8" to Sta. 26+50

CONC. HEADER SEE C3.1

26+45 Stubout Drainline "D" for Future Conn. Inv.=63.25

Notes:



- For Special DI/DMH, See Struct. Dwg.
- Block Inlet with Removeable Plug to Prevent Water from Entering Catch Basin
- Contractor Shall Provide Shop Dwg. for Engineer Approval Prior to Construction of Cap or Plug for all 24" Drainline Stubouts.

Distance Units: US Survey Feet

Point ID	North	East	Elevation	Description
EOPCC1	-11935.189	6612.984	74.651	End of PCC
EOPCC2	-11911.980	6573.231	76.347	
EOPCC3	-11766.939	6728.077	77.343	
EOPCC4	-11738.100	6692.204	78.397	

Plan - Sta. 26+50 to 35+00

Scale: 1" = 40'

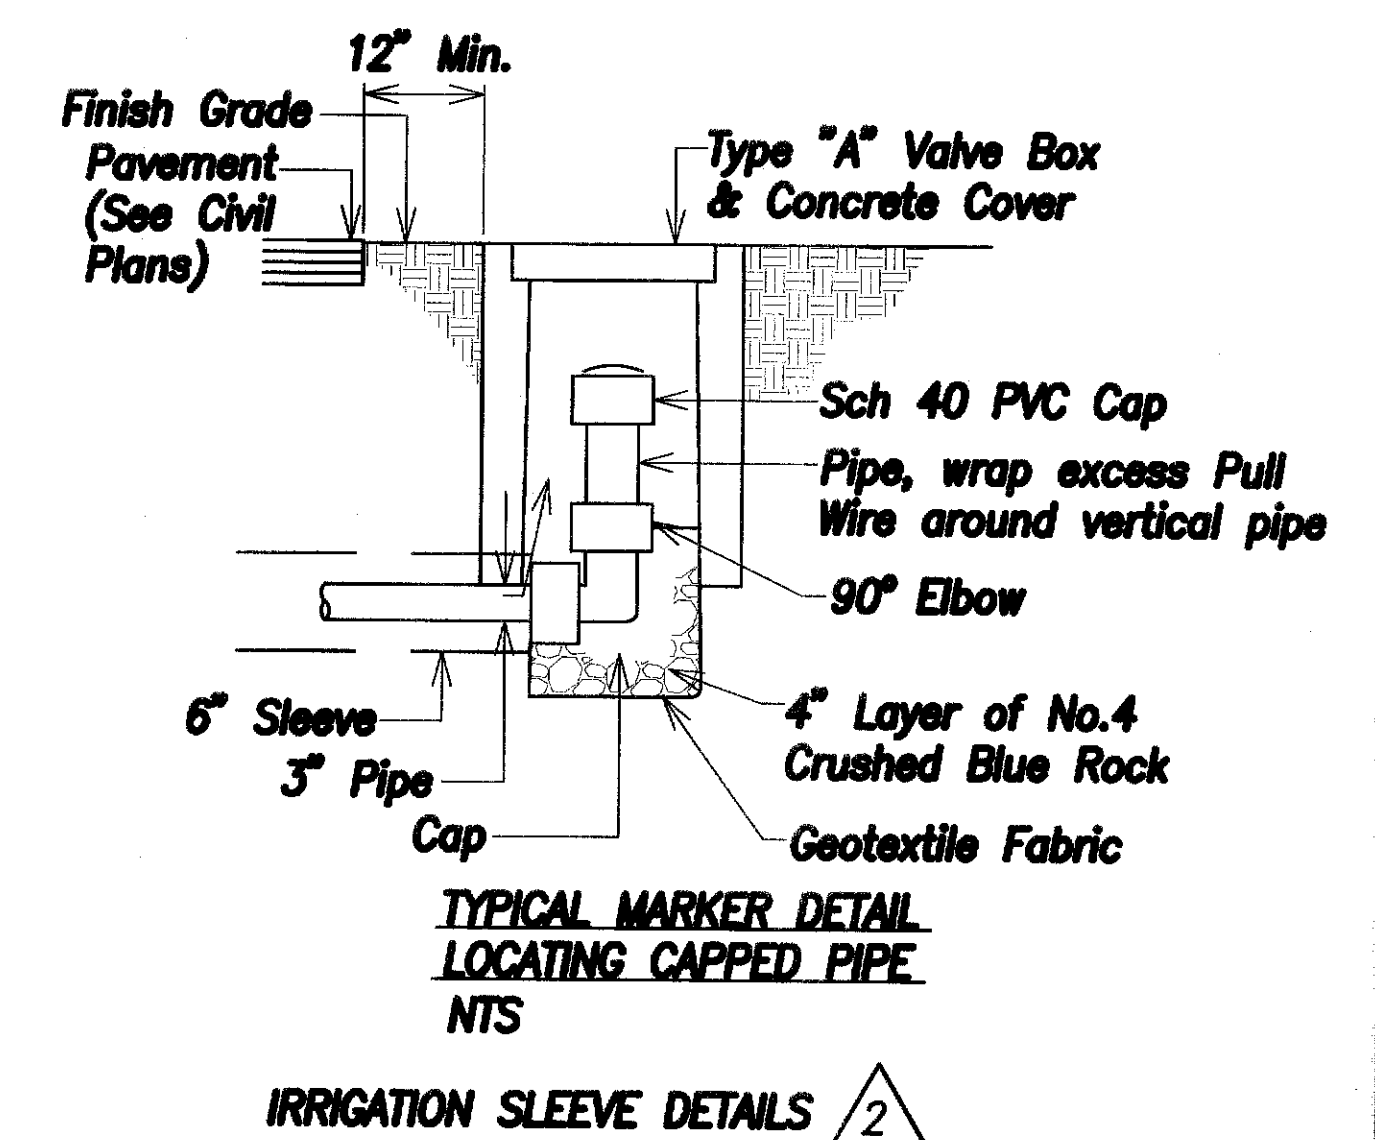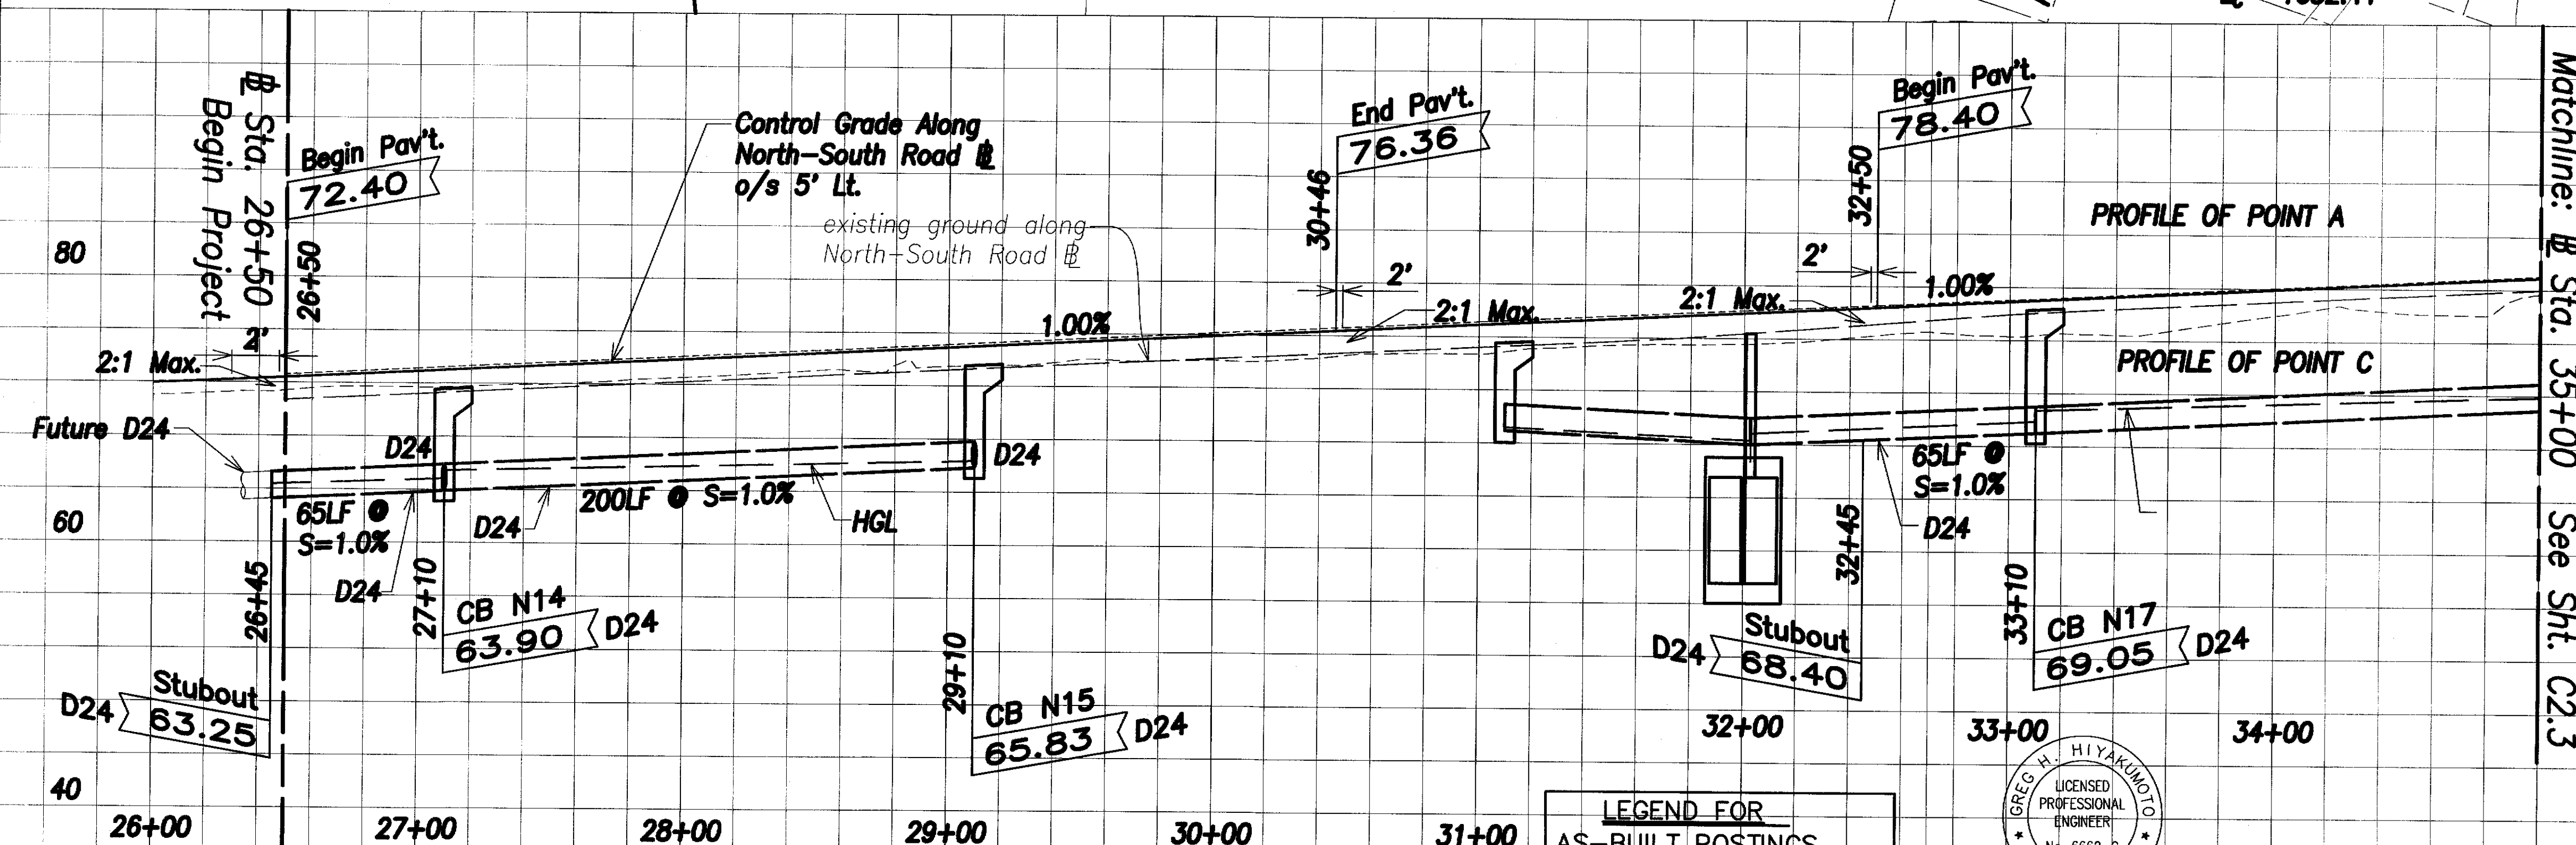

STATE OF HAWAII DEPARTMENT OF TRANSPORTATION HIGHWAYS DIVISION	
PLAN AND PROFILE - 1	
North-South Road Phase 1A F.A.I. Proj. No. STP-8930(1)	
Scale: As Shown	Date: Dec 22, 2004
SHEET No. C2.2 OF	SHEETS

LEGEND FOR AS-BUILT POSTINGS	
~~~~~	Squiggly line for as-built deletion
=====	Double line for as-built deletion
Roadway	Text for as-built posting



THIS WORK WAS PREPARED BY ME OR UNDER MY SUPERVISION.  
APRIL 30, 2008  
EXPIRATION DATE OF THE LICENSE

DATE	REVISION
3/30/06	As Built - RFI-16A
10/14/05	As Built - RFI 6
6/21/06	Deleted Culvert C, roadway from 30+46 to 32+50 (per SDOT), extended ditch

"AS-BUILT" CO 18




FED. ROAD DIST. NO.	STATE	FED. AID PROJ. NO.	FISCAL YEAR	SHEET NO.	TOTAL SHEETS
HAWAII	HAW.	STP-8930(1)	2005	19	144

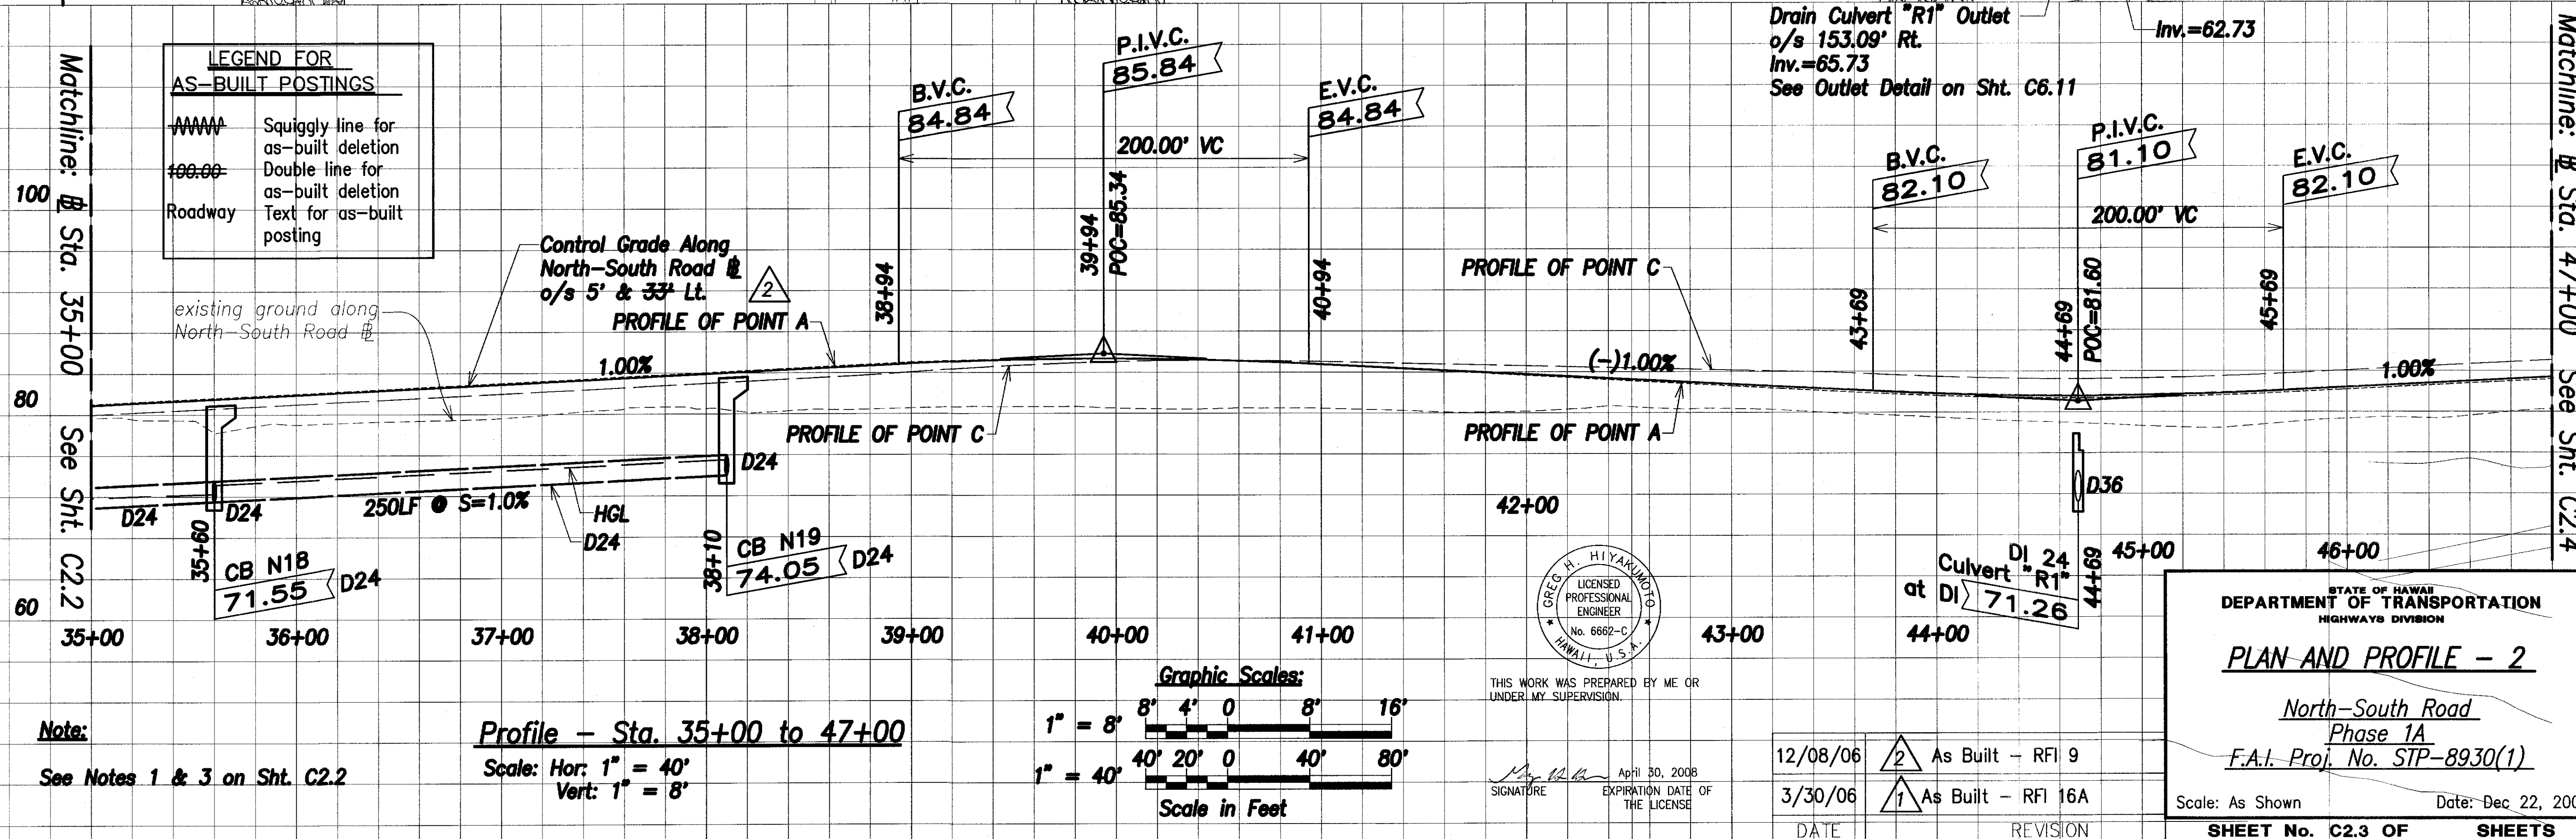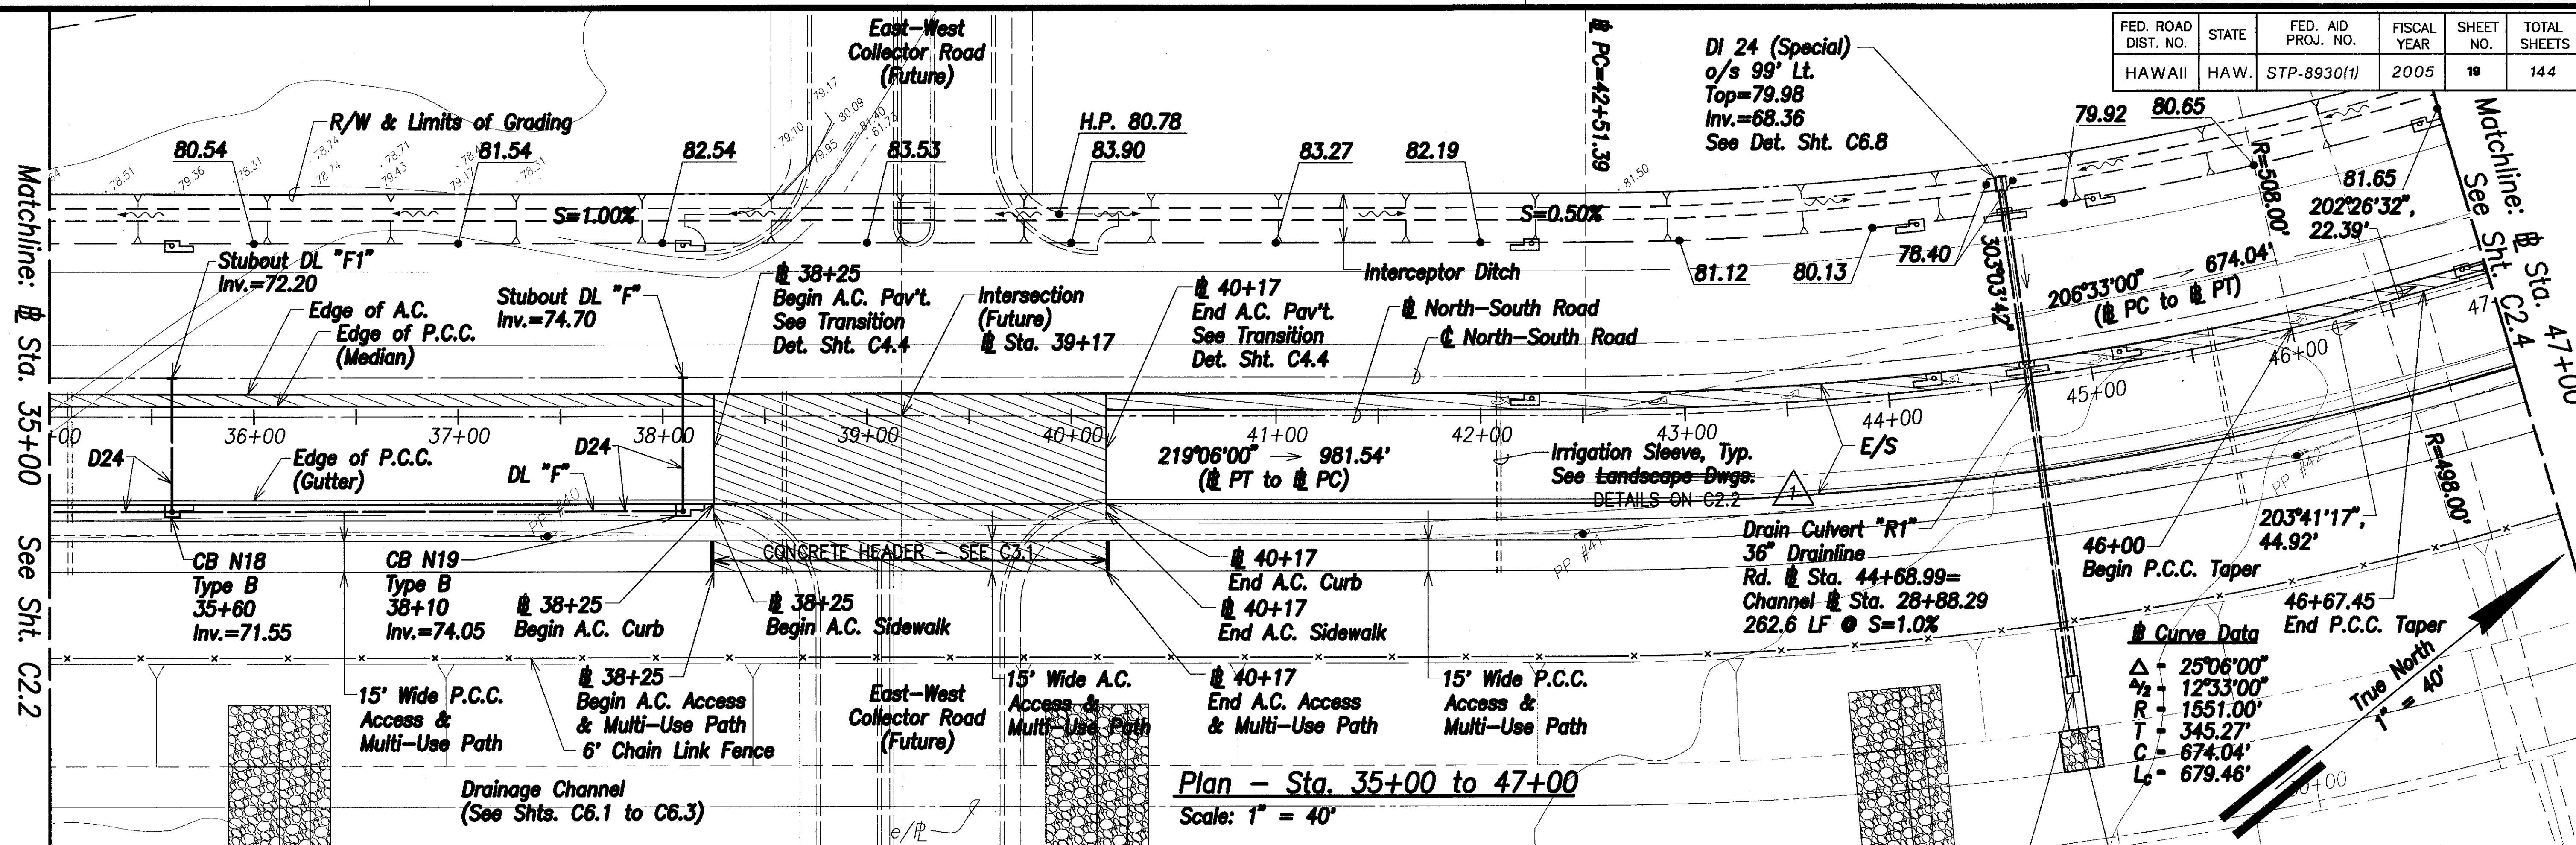

**LEGEND FOR AS-BUILT POSTINGS**

~~~~~	Squiggly line for as-built deletion
==	Double line for as-built deletion
Text	Text for as-built posting

SURVEY PLOTTED BY	DATE
DRAWN BY	
TRACED BY	
CHECKED BY	
NOTED BY	
NO.	

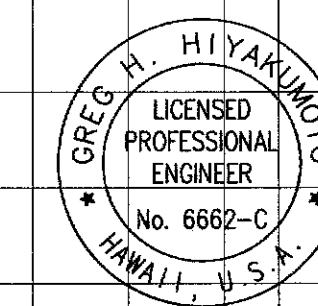

THIS WORK WAS PREPARED BY ME OR UNDER MY SUPERVISION.

SIGNATURE: *Greg H. Hiyaundo*
April 30, 2008
EXPIRATION DATE OF THE LICENSE

DATE	REVISION
12/08/06	As Built - RFI 9
3/30/06	As Built - RFI 16A

STATE OF HAWAII
DEPARTMENT OF TRANSPORTATION
HIGHWAYS DIVISION


PLAN AND PROFILE - 2

North-South Road
Phase 1A
F.A.I. Proj. No. STP-8930(1)

Scale: As Shown Date: Dec 22, 2004

SHEET No. C2.3 OF SHEETS

FED. ROAD DIST. NO.	STATE	FED. AID PROJ. NO.	FISCAL YEAR	SHEET NO.	TOTAL SHEETS
HAWAII	HAW.	STP-8930(1)	2005	60 ADD. 20	144

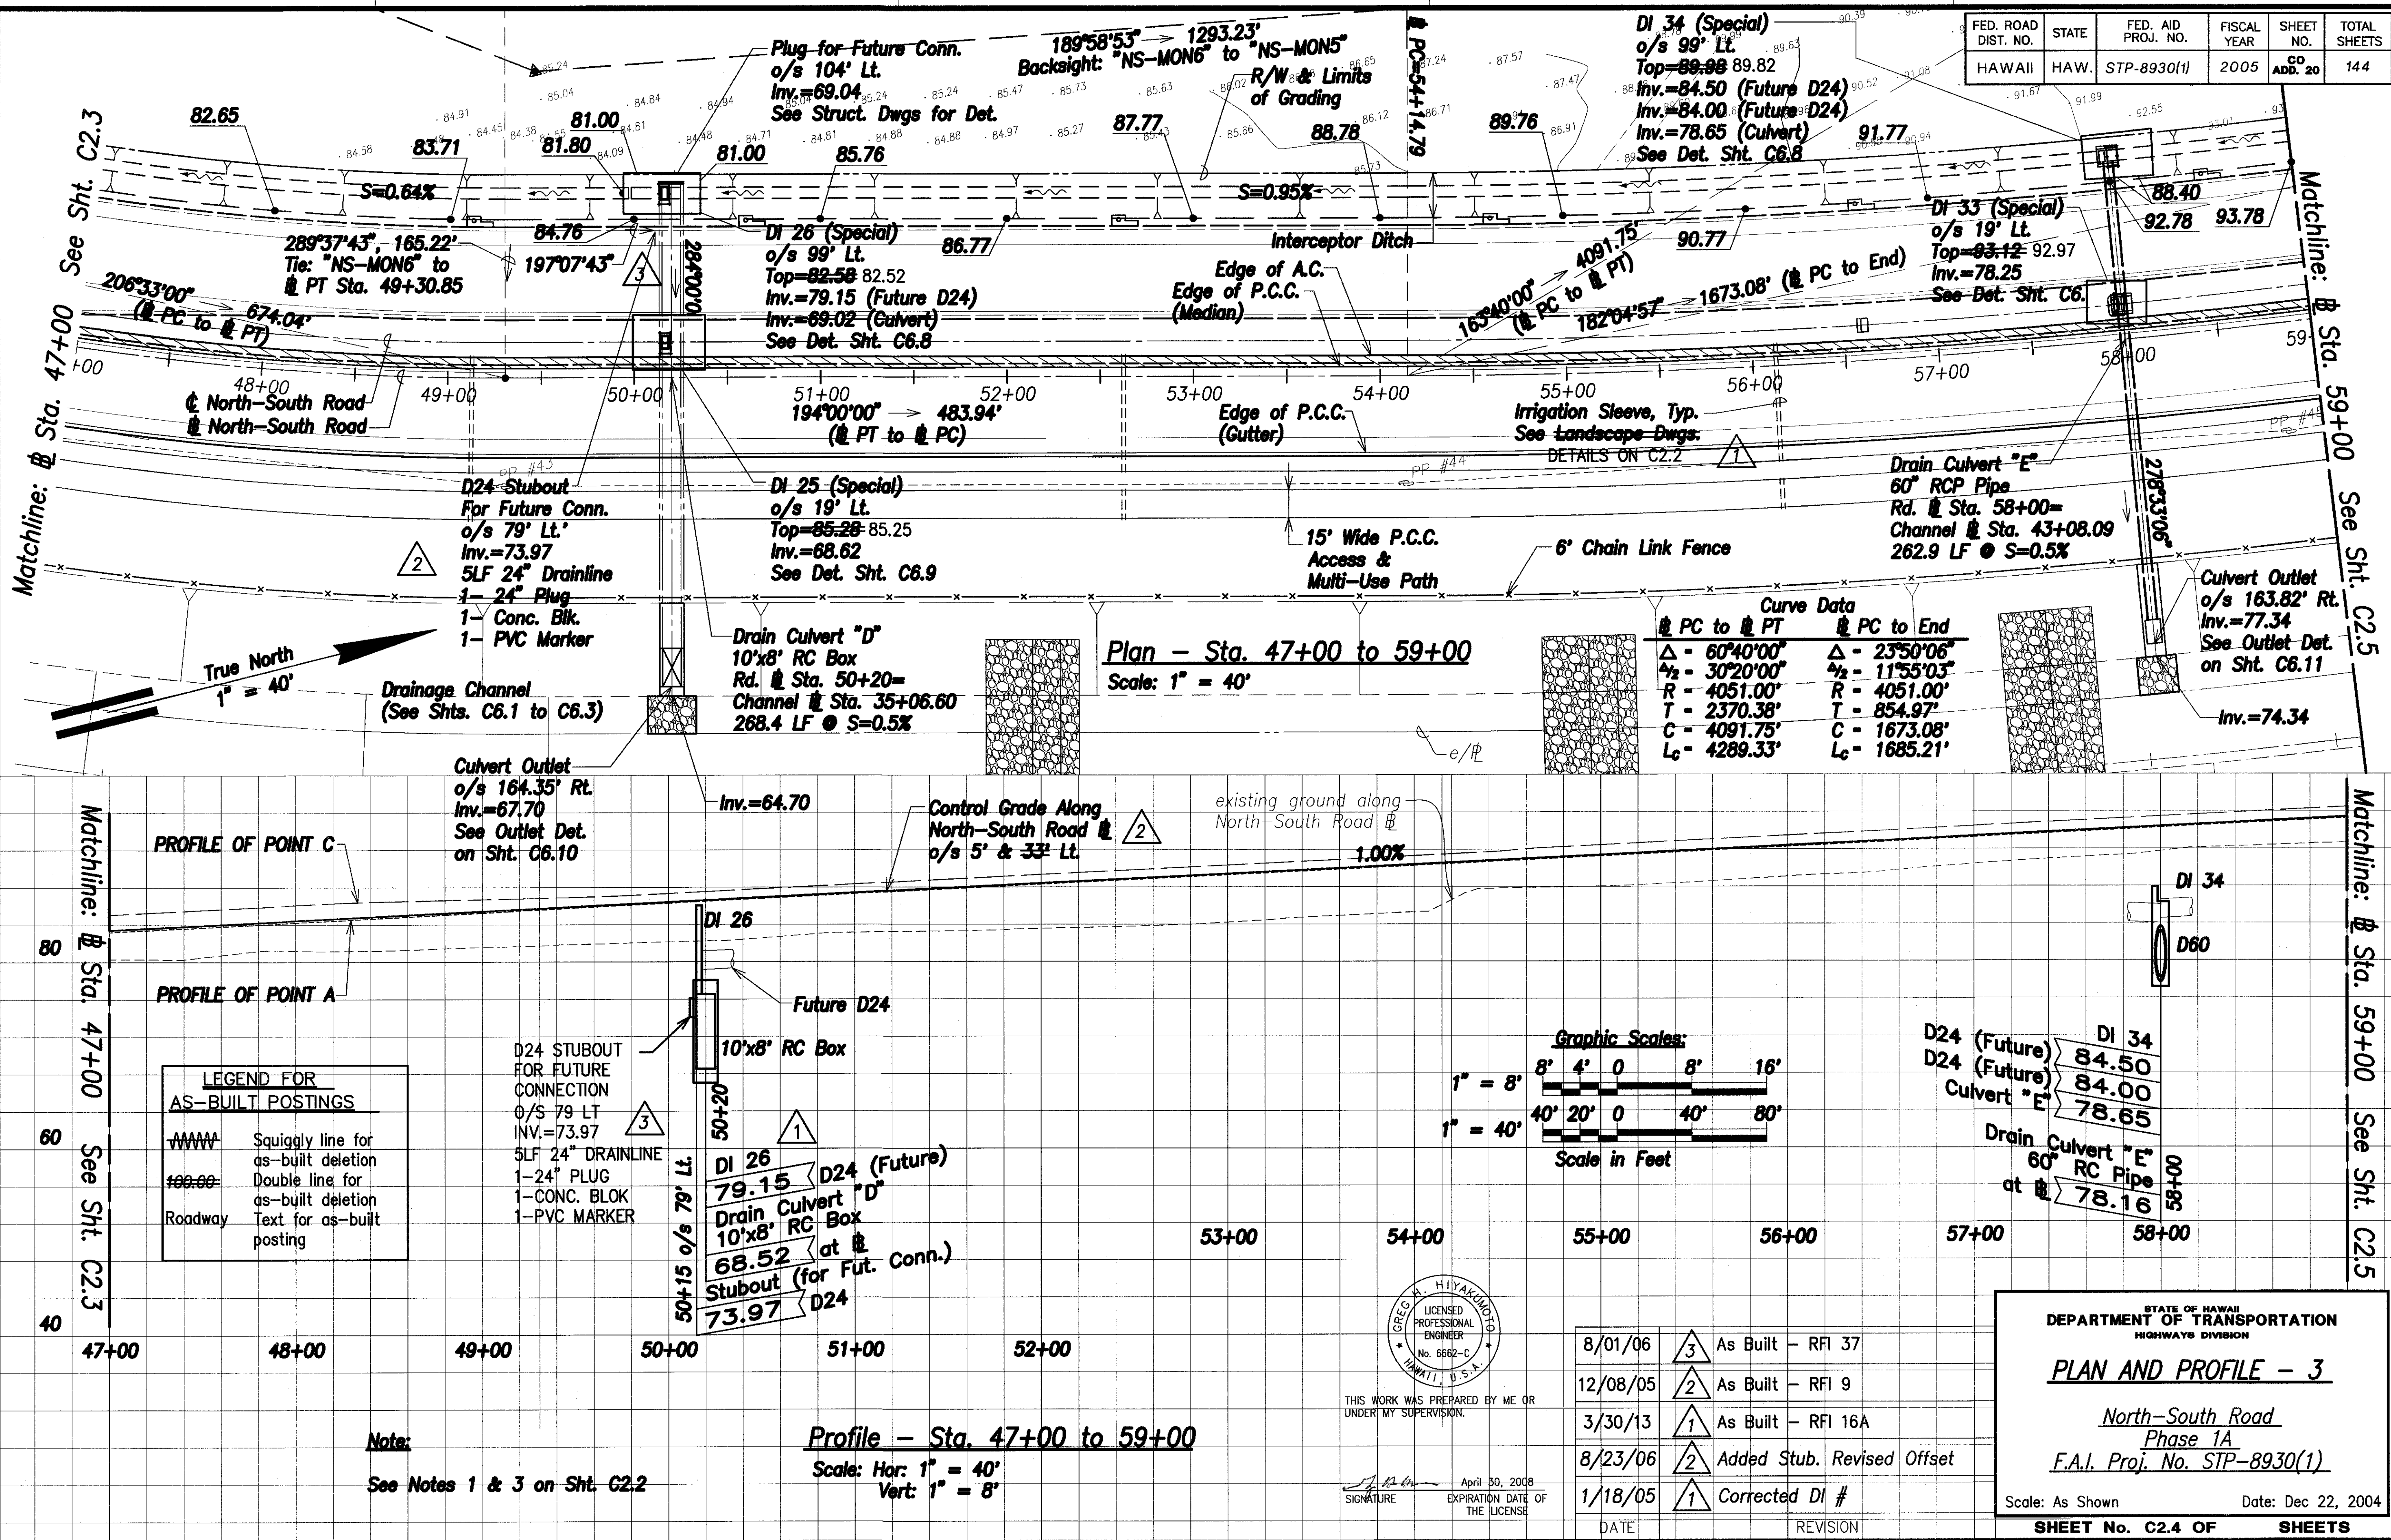

"AS-BUILT" CO ADD. 20

FED. ROAD DIST. NO.	STATE	FED. AID PROJ. NO.	FISCAL YEAR	SHEET NO.	TOTAL SHEETS
HAWAII	HAW.	STP-8930(1)	2005	21	144

