

| FED. ROAD DIST. NO. | STATE | FED. AID PROJ. NO. | FISCAL YEAR | SHEET NO. | TOTAL SHEETS |
|---------------------|-------|--------------------|-------------|-----------|--------------|
| HAWAII              | HAW.  | STP-8930(1)        | 2005        | 23        | 144          |


| Station | Edge of A.C. Elev. | Edge of P.C.C. Elev. (Median) | Edge of P.C.C. Elev. (Gutter) | Station  | Edge of A.C. Elev. | Edge of P.C.C. Elev. (Median) | Edge of P.C.C. Elev. (Gutter) | Station | Edge of A.C. Elev. | Edge of P.C.C. Elev. (Median) | Edge of P.C.C. Elev. (Gutter) | Station | Edge of A.C. Elev. | Edge of P.C.C. Elev. (Median) | Edge of P.C.C. Elev. (Gutter) |
|---------|--------------------|-------------------------------|-------------------------------|----------|--------------------|-------------------------------|-------------------------------|---------|--------------------|-------------------------------|-------------------------------|---------|--------------------|-------------------------------|-------------------------------|
| 26+50   | 72.62              | 72.40                         | 70.70                         | 39+00    | 85.040             | n/a                           | 84.8810 *                     | 51+00   | 87.249             | 87.3841                       | 88.2833                       | 63+50   | 102.56             | 102.70                        | 103.76                        |
| 26+75   | 72.87              | 72.65                         | 70.95                         | 39+25    | 85.19              | n/a                           | 84.481 *                      | 51+25   | 87.584             | 87.626                        | 88.548                        | 63+75   | 103.01             | 103.15                        | 104.21                        |
| 27+00   | 73.12              | 72.90                         | 71.20                         | 39+50    | 85.32              | n/a                           | 84.68 *                       | 51+50   | 87.759             | 87.8791                       | 88.7983                       | 64+00   | 103.46             | 103.60                        | 104.66                        |
| 27+25   | 73.37              | 73.15                         | 71.45                         | 39+75    | 85.38              | n/a                           | 84.90 *                       | 51+75   | 88.084             | 88.126                        | 89.048                        | 64+25   | 103.91             | 104.05                        | 105.11                        |
| 27+50   | 73.62              | 73.40                         | 71.70                         | 40+00    | 85.38              | n/a                           | 85.085 *                      | 52+00   | 88.259             | 88.3741                       | 89.2933                       | 64+50   | 104.36             | 104.50                        | 105.56                        |
| 27+75   | 73.87              | 73.65                         | 71.95                         | 40+17    | 85.343             | 85.30                         | 85.12                         | 52+25   | 88.584             | 88.626                        | 89.548                        | 64+75   | 104.81             | 104.95                        | 106.01                        |
| 28+00   | 74.12              | 73.90                         | 72.20                         | 40+25    | 85.31              | 85.29                         | 85.15                         | 52+50   | 88.759             | 88.8791                       | 89.7983                       | 65+00   | 105.26             | 105.40                        | 106.46                        |
| 28+25   | 74.37              | 74.15                         | 72.45                         | 40+50    | 85.19              | 85.18                         | 85.18                         | 52+75   | 89.084             | 89.126                        | 90.048                        | 65+25   | 105.71             | 105.85                        | 106.91                        |
| 28+50   | 74.62              | 74.40                         | 72.70                         | 40+75    | 85.00              | 85.02                         | 85.14                         | 53+00   | 89.259             | 89.3741                       | 90.2933                       | 65+50   | 106.16             | 106.30                        | 107.36                        |
| 28+75   | 74.87              | 74.65                         | 72.95                         | 41+00    | 84.75              | 84.79                         | 85.05                         | 53+25   | 89.584             | 89.626                        | 90.548                        | 65+75   | 106.61             | 106.75                        | 107.81                        |
| 29+00   | 75.12              | 74.90                         | 73.20                         | 41+25    | 84.48              | 84.55                         | 84.94                         | 53+50   | 89.789             | 89.8891                       | 90.883                        | 66+00   | 107.06             | 107.20                        | 108.26                        |
| 29+25   | 75.37              | 75.15                         | 73.45                         | 41+50    | 84.21              | 84.381                        | 84.83                         | 53+75   | 90.043             | 90.135                        | 91.057                        | 66+25   | 107.51             | 107.65                        | 108.71                        |
| 29+50   | 75.62              | 75.40                         | 73.70                         | 41+75    | 83.94              | 84.06                         | 84.742                        | 54+00   | 90.288             | 90.3840                       | 91.382                        | 66+50   | 107.96             | 108.10                        | 109.16                        |
| 29+75   | 75.87              | 75.65                         | 73.95                         | 42+00    | 83.678             | 83.82                         | 84.60                         | 54+25   | 90.543             | 90.635                        | 91.557                        | 66+75   | 108.41             | 108.55                        | 109.61                        |
| 30+00   | 76.12              | 75.90                         | 74.20                         | 42+25    | 83.41              | 83.578                        | 84.49                         | 54+50   | 90.788             | 90.8890                       | 91.836                        | 67+00   | 108.86             | 109.00                        | 110.06                        |
| 30+25   | 76.37              | 76.15                         | 74.45                         | 42+50    | 83.14              | 83.33                         | 84.38                         | 54+75   | 90.991.02          | 91.135                        | 92.4921                       | 67+25   | 109.31             | 109.45                        | 110.51                        |
| 30+50   | 76.62              | 76.40                         | 74.70                         | 42+75    | 82.87              | 83.089                        | 84.27                         | 55+00   | 91.247             | 91.3840                       | 92.446                        | 67+50   | 109.76             | 109.90                        | 110.96                        |
| 30+75   | 76.87              | 76.65                         | 74.95                         | 43+00    | 82.681             | 82.845                        | 84.156                        | 55+25   | 91.582             | 91.635                        | 92.6871                       | 67+75   | 110.21             | 110.35                        | 111.41                        |
| 31+00   | 77.12              | 76.90                         | 75.20                         | 43+25    | 82.334             | 82.60                         | 84.043                        | 55+50   | 91.757             | 91.8890                       | 92.946                        | 68+00   | 110.66             | 110.80                        | 111.86                        |
| 31+25   | 77.37              | 77.15                         | 75.45                         | 43+50    | 82.078             | 82.356                        | 83.9387                       | 55+75   | 92.082             | 92.145                        | 93.4921                       | 68+25   | 111.11             | 111.25                        | 112.31                        |
| 31+50   | 77.62              | 77.40                         | 75.782                        | 43+75    | 81.823             | 82.181                        | 83.688                        | 56+00   | 92.257             | 92.3840                       | 93.456                        | 68+50   | 111.56             | 111.70                        | 112.76                        |
| 31+75   | 77.876             | 77.65                         | 75.986.03                     | 44+00    | 81.642             | 81.981                        | 83.489                        | 56+25   | 92.582             | 92.645                        | 93.781                        | 68+75   | 112.01             | 112.15                        | 113.21                        |
| 32+00   | 78.10              | 77.90                         | 76.378                        | 44+25    | 81.478             | 81.767                        | 83.345                        | 56+50   | 92.757             | 92.8890                       | 93.956                        | 69+00   | 112.46             | 112.60                        | 113.66                        |
| 32+25   | 78.33              | 78.15                         | 76.76                         | 44+50    | 81.3840            | 81.679                        | 83.267                        | 56+75   | 93.082             | 93.145                        | 94.281                        | 69+25   | 112.91             | 113.05                        | 114.11                        |
| 32+50   | 78.56              | 78.40                         | 77.15                         | 44+75    | 81.389             | 81.657                        | 83.236                        | 57+00   | 93.257             | 93.3840                       | 94.456                        | 69+50   | 113.36             | 113.50                        | 114.56                        |
| 32+75   | 78.7980            | 78.65                         | 77.54                         | 45+00    | 81.483             | 81.6972                       | 83.2730                       | 57+25   | 93.51              | 93.645                        | 94.781                        | 69+75   | 113.81             | 113.95                        | 115.01                        |
| 33+00   | 79.03              | 78.90                         | 77.9489                       | 45+25    | 81.584             | 81.7883                       | 83.3741                       | 57+50   | 93.76              | 93.8890                       | 94.956                        | 70+00   | 114.26             | 114.40                        | 115.46                        |
| 33+25   | 79.27              | 79.15                         | 78.230                        | 45+50    | 81.6571            | 81.942.00                     | 83.538                        | 57+75   | 94.01              | 94.15                         | 95.281                        | 70+25   | 114.70             | 114.84                        | 115.90                        |
| 33+50   | 79.52              | 79.40                         | 78.48                         | 45+75    | 81.8794            | 82.1623                       | 83.7582                       | 58+00   | 94.26              | 94.40                         | 95.456                        | 70+50   | 115.13             | 115.26                        | 116.32                        |
| 33+75   | 79.77              | 79.65                         | 78.73                         | 46+00    | 82.139             | 82.418                        | 84.087                        | 58+25   | 94.51              | 94.65                         | 95.71                         | 70+75   | 115.53             | 115.67                        | 116.72                        |
| 34+00   | 80.02              | 79.90                         | 78.98                         | 46+25    | 82.3844            | 82.6572                       | 84.2532                       | 58+50   | 94.76              | 94.90                         | 95.96                         | 71+00   | 115.91             | 116.05                        | 117.11                        |
| 34+25   | 80.27              | 80.15                         | 79.23                         | 46+50    | 82.639             | 82.8892                       | 84.587                        | 58+75   | 95.01              | 95.15                         | 96.21                         |         |                    |                               |                               |
| 34+50   | 80.52              | 80.40                         | 79.48                         | 46+67.45 | 82.7986            | 83.018                        | 84.6774                       | 59+00   | 95.26              | 95.40                         | 96.46                         |         |                    |                               |                               |
| 34+75   | 80.77              | 80.65                         | 79.73                         | 46+75    | 82.8894            | 83.8916                       | 84.7581                       | 59+25   | 95.53              | 95.66                         | 96.72                         |         |                    |                               |                               |
| 35+00   | 81.02              | 80.90                         | 79.98                         | 47+00    | 83.139             | 83.3541                       | 85.086                        | 59+50   | 95.81              | 95.95                         | 97.01                         |         |                    |                               |                               |
| 35+25   | 81.27              | 81.15                         | 80.23                         | 47+25    | 83.3844            | 83.686                        | 85.2531                       | 59+75   | 96.13              | 96.26                         | 97.32                         |         |                    |                               |                               |
| 35+50   | 81.52              | 81.40                         | 80.48                         | 47+50    | 83.639             | 83.8591                       | 85.586                        | 60+00   | 96.46              | 96.60                         | 97.66                         |         |                    |                               |                               |
| 35+75   | 81.77              | 81.65                         | 80.73                         | 47+75    | 83.8894            | 84.186                        | 85.7881                       | 60+25   | 96.83              | 96.96                         | 98.02                         |         |                    |                               |                               |
| 36+00   | 82.02              | 81.90                         | 80.98                         | 48+00    | 84.139             | 84.3541                       | 86.045                        | 60+50   | 97.21              | 97.35                         | 98.41                         |         |                    |                               |                               |
| 36+25   | 82.27              | 82.15                         | 81.23                         | 48+25    | 84.3945            | 84.686                        | 86.26                         | 60+75   | 97.63              | 97.76                         | 98.82                         |         |                    |                               |                               |
| 36+50   | 82.52              | 82.40                         | 81.48                         | 48+50    | 84.6571            | 84.8591                       | 86.483                        | 61+00   | 98.06              | 98.20                         | 99.26                         |         |                    |                               |                               |
| 36+75   | 82.77              | 82.65                         | 81.73                         | 48+75    | 84.927             | 85.186                        | 86.527                        | 61+25   | 98.51              | 98.65                         | 99.71                         |         |                    |                               |                               |
| 37+00   | 83.02              | 82.90                         | 81.98                         | 49+00    | 85.1924            | 85.3841                       | 86.638                        | 61+50   | 98.96              | 99.10                         | 100.16                        |         |                    |                               |                               |
| 37+25   | 83.27              | 83.15                         | 82.23                         | 49+25    | 85.4651            | 85.616                        | 86.7480                       | 61+75   | 99.41              | 99.55                         | 100.61                        |         |                    |                               |                               |
| 37+50   | 83.52              | 83.40                         | 82.48                         | 49+50    | 85.737             | 85.8891                       | 86.8894                       | 62+00   | 99.86              | 100.00                        | 101.06                        |         |                    |                               |                               |
| 37+75   | 83.77              | 83.65                         | 82.73                         | 49+75    | 85.996.03          | 86.146                        | 87.0312                       | 62+25   | 100.31             | 100.45                        | 101.51                        |         |                    |                               |                               |
| 38+00   | 84.02              | 83.90                         | 82.98                         | 50+00    | 86.249             | 86.3841                       | 87.2833                       | 62+50   | 100.76             | 100.90                        | 101.96                        |         |                    |                               |                               |
| 38+25   | 84.27              | 84.15                         | 83.23                         | 50+25    | 86.4954            | 86.616                        | 87.538                        | 62+75   | 101.21             | 101.35                        | 102.41                        |         |                    |                               |                               |
| 38+50   | 84.52              | n/a                           | 83.489 *                      | 50+50    | 86.749             | 86.8891                       | 87.7883                       | 63+00   | 101.66             | 101.80                        | 102.86                        |         |                    |                               |                               |
| 38+75   | 84.776             | n/a                           | 83.737 *                      | 50+75    | 86.997.04          | 87.146                        | 88.038                        | 63+25   | 102.11             | 102.25                        | 103.31                        |         |                    |                               |                               |

1 GRADE REVISIONS

\*Grade Shown is for Edge of A.C. Pavement

# LEGEND FOR AS-BUILT POSTINGS

~~~~~ Squiggly line for as-built deletion  
 #00.00- Double line for as-built deletion  
 Roadway Text for as-built posting

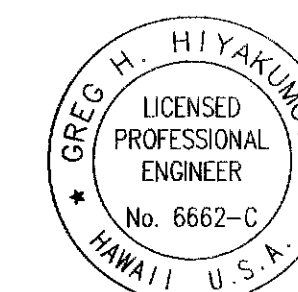

THIS WORK WAS PREPARED BY ME OR UNDER MY SUPERVISION.

SIGNATURE April 30, 2008  
 EXPIRATION DATE OF THE LICENSE

|         |                     |
|---------|---------------------|
| 4/17/06 | 1 As Built - RFI 9B |
| DATE    | REVISION            |

STATE OF HAWAII  
DEPARTMENT OF TRANSPORTATION  
HIGHWAYS DIVISION

ROADWAY GRADING SCHEDULE

North-South Road  
Phase 1A  
F.A.I. Proj. No. STP-8930(1)

Date: Dec 22, 2004

SHEET No. C2.7 OF SHEETS