


INDEX TO STRUCTURAL DRAWINGS

FED. ROAD DIST. NO.	STATE	FED. AID PROJ. NO.	FISCAL YEAR	SHEET NO.	TOTAL SHEETS
HAWAII	HAW.	STP-8930(1)	2005	C.O. 68	144

SHEET NO.	DESCRIPTION
S0.1	INDEX TO STRUCTURAL DRAWINGS
S0.2	ESTIMATED QUANTITIES
S0.3	STRUCTURAL GENERAL NOTES
S0.4	SYMBOLS AND ABBREVIATIONS
S1.1	DRAIN CULVERT "C" - LAYOUT PLAN AND SECTION
S1.2	DRAIN CULVERT "C" - TOP SLAB PLAN AT DI 17 AND SECTION
S1.3	DRAIN CULVERT "C" - TOP SLAB PLAN AT DI 16 AND SECTION
S1.4	DRAIN CULVERT "C" - SECTIONS
S1.5	DRAIN CULVERT "C" - TOP SLAB PLAN AT DMH 18 AND SECTION
S1.6	DRAIN CULVERT "C" - TOP SLAB PLAN AT DMH 18 AND SECTIONS
S2.1	DRAIN CULVERT "D" - LAYOUT PLAN, TOP SLAB PLAN AT DI 26 SECTION AND DETAIL
S2.2	DRAIN CULVERT "D" - TOP SLAB PLAN AT DI 25, SECTION AND DETAIL
S2.3	DRAIN CULVERT "D" - SECTIONS
S3.1	DRAIN CULVERT TYPICAL DETAILS AND SECTIONS
S3.2	DRAIN CULVERT "C" OUTLET LAYOUT PLAN AND SECTION
S3.3	DRAIN CULVERT "D" OUTLET LAYOUT PLAN AND SECTION
S3.4	DRAIN CULVERT "D" OUTLET SECTIONS AND TYPICAL DETAILS
S3.5	DRAIN CULVERT "D" OUTLET SECTION
S3.6	DRAIN CULVERT "D" OUTLET SECTION
S4.1	DRAIN CULVERT "E" - LAYOUT PLAN AND SECTIONS AT DI 33
S4.2	DRAIN CULVERT "F" - LAYOUT PLAN AND SECTIONS AT DI 37
S4.3	DRAIN CULVERT "G" - LAYOUT PLAN AND SECTIONS AT DI 42
S4.4	DRAIN CULVERT "RI" - LAYOUT PLAN
S4.5	DRAIN CULVERT "E", "F" AND "G" - SECTIONS
S4.6	DRAIN CULVERT "E", "F" AND "G" - SECTIONS
S5.1	DRAIN CULVERT "E" - SECTIONS AT DI 34
S5.2	DRAIN CULVERT "E" - SECTIONS AT DI 34
S5.3	DRAIN CULVERT "F" - SECTIONS AT DI 38
S5.4	DRAIN CULVERT "G" - SECTIONS AT DI 43
S5.5	DRAIN CULVERT "F" AND "G" - SECTIONS AT DI 38 AND 43
S5.6	DRAIN CULVERT "E", "F" AND "G" - SECTIONS
S5.7	DRAIN CULVERT "E", "F" AND "G" - SECTION

SHEET NO.	DESCRIPTION
S5.8	DRAIN CULVERT "RI" - SECTIONS AND DETAIL AT DI 24
S5.9	DRAIN INLET FRAME AT 24, 26, 34, 38 AND 43
S6.1	DRAIN CULVERT "E", "F", "G" AND "RI" OUTLET - LAYOUT PLAN AND SECTIONS
S6.2	DRAIN CULVERT "E", "F", "G" AND "RI" OUTLET - SECTIONS
S6.3	TYPICAL GRP APRON SECTIONS AND DETAIL
S6.4	TYPICAL ADDED REINFORCING AT PIPE OPENING SECTIONS
S7.1	BOX CULVERT OUTLET EXCAVATION AND PAY LIMITS
S7.2	RC PIPE CULVERT OUTLET EXCAVATION AND PAY LIMITS
S8.1	TYPICAL LIGHT POLE FOUNDATION
S8.2	TYPICAL LIGHT POLE FOUNDATION
S8.3	LIGHT POLE STRUCTURE EXCAVATION PAY LIMITS
S9.1	STRUCTURAL GENERAL NOTES AND TYPICAL DETAILS
S9.2	NEW MAINTENANCE MANHOLE TYPICAL PLANS AND SECTIONS
S9.3	MAINTENANCE MANHOLE EXTENSION SECTIONS
S9.4	MAINTENANCE MANHOLE WALL ELEVATION

DATE	
SURVEY PLOTTED BY	
PLAN	
DESIGNED BY	
TRACED BY	
NOTE BOOK	
QUANTITIES BY	
CHECKED BY	
ORIGINAL	
PLAN	
NOTE BOOK	
No.	

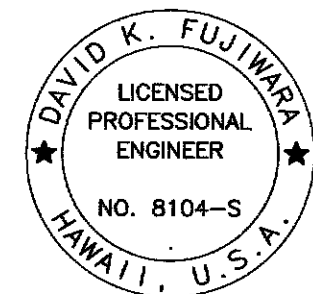

THIS WORK WAS PREPARED BY
ME OR UNDER MY SUPERVISION.

David K. Fujiwara
SIGNATURE EXPIRATION DATE OF THE LICENSE 4-30-08

STATE OF HAWAII DEPARTMENT OF TRANSPORTATION HIGHWAYS DIVISION	
INDEX TO STRUCTURAL DRAWINGS	
North-South Road Phase 1A F.A.I. Proj. No. STP-8930(1)	
Scale: As Noted	Date: Dec. 22, 2004
SHEET No. S0.1 OF 43 SHEETS	


6/21/06	Remove and Revise Description per SDOT
DATE	REVISION

FED. ROAD DIST. NO.	STATE	FED. AID PROJ. NO.	FISCAL YEAR	SHEET NO.	TOTAL SHEETS
HAWAII	HAW.	STP-8930(1)	2005	C.O.ADD. 69	144

ESTIMATED QUANTITIES

ITEM NO.	ITEM	QUANTITY	UNIT
1 206.3000	Structure Excavation for Drain Culvert "C"	3,950	CY
1 206.3001	Structure Excavation for Drain Culvert "D"	3,020	CY
1 206.4000	Structure Excavation for Drain Culvert "C" Outlet Structure	150	CY
1 206.4001	Structure Excavation for Drain Culvert "D" Outlet Structure	90	CY
1 206.4002	Structure Excavation for Drain Culvert "E" Outlet Structure	55	CY
1 206.4003	Structure Excavation for Drain Culvert "F" Outlet Structure	60	CY
1 206.4004	Structure Excavation for Drain Culvert "G" Outlet Structure	60	CY
1 206.5000	Structure Excavation for Drain Culvert "RI" Outlet Structure	50	CY
1 206.5001	Structure Excavation for Light Pole Pile Cap and Pedestal	80	CY
1 503.1080	Concrete for Drain Culvert "C"	LS	LS
1 503.1081	Concrete for Drain Culvert "D"	LS	LS
1 503.1082	Concrete for Drain Culvert "C" Outlet Structure	LS	LS
1 503.1083	Concrete for Drain Culvert "D" Outlet Structure	LS	LS
1 503.1084	Concrete for Drain Culvert "E" Outlet Structure	LS	LS
1 503.1085	Concrete for Drain Culvert "F" Outlet Structure	LS	LS
1 503.1086	Concrete for Drain Culvert "G" Outlet Structure	LS	LS
1 503.1087	Concrete for Drain Culvert "RI" Outlet Structure	LS	LS
1 503.1088	Concrete for Light Pole Pile Cap and Pedestal	LS	LS
1 602.0090	Reinforcing Steel for Drain Culvert "C"	LS	LS
1 602.0091	Reinforcing Steel for Drain Culvert "D"	LS	LS
1 602.0092	Reinforcing Steel for Drain Culvert "C" Outlet Structure	LS	LS
1 602.0093	Reinforcing Steel for Drain Culvert "D" Outlet Structure	LS	LS
1 602.0094	Reinforcing Steel for Drain Culvert "E" Outlet Structure	LS	LS
1 602.0095	Reinforcing Steel for Drain Culvert "F" Outlet Structure	LS	LS
1 602.0096	Reinforcing Steel for Drain Culvert "G" Outlet Structure	LS	LS
1 602.0097	Reinforcing Steel for Drain Culvert "RI" Outlet Structure	LS	LS
1 602.0098	Reinforcing Steel for Light Pole Cap and Pedestal	LS	LS
1 603.2000	Bed Course Material for Drain Culvert "D"	160	CY
1 603.2001	Bed Course Material for Drain Culvert "D" Outlet Structures	40	CY
1 603.2002	Bed Course Material for Drain Culvert "E", Drain Culvert "F", Drain Culvert "G" and Drain Culvert "RI" Outlet Structures	50	CY

SURVEY PLOTTED BY	DATE
DRAWN BY	
DESIGNED BY	
QUANTITIES BY	
CHECKED BY	
ORIGINAL PLAN	
NOTE BOOK	
No.	

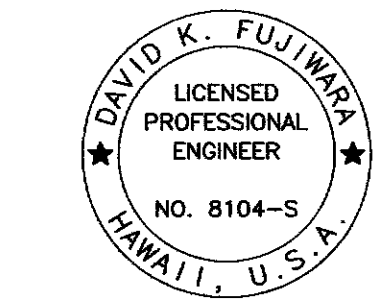

THIS WORK WAS PREPARED BY ME OR UNDER MY SUPERVISION.

Signature: David K. Fujiwara
EXPIRATION DATE OF THE LICENSE: 12-30-06

6/21/06	Remove & Revise Items per SDOT
1/18/05	1 Clarification
DATE	REVISION

STATE OF HAWAII DEPARTMENT OF TRANSPORTATION HIGHWAYS DIVISION
ESTIMATED QUANTITIES
North-South Road Phase 1A F.A.I. Proj. No. STP-8930(1)
Scale: As Noted Date: Dec. 22, 2004
SHEET No. S0.2 OF 43 SHEETS

STRUCTURAL GENERAL NOTES

FED. ROAD DIST. NO.	STATE	FED. AID PROJ. NO.	FISCAL YEAR	SHEET NO.	TOTAL SHEETS
HAWAII	HAW.	STP-8930(1)	2005	ADD. 70	144

1. General Specifications: Hawaii Department of Transportation, Standard Specifications for Road and Bridge and Public Works Construction, 1994, together with Special Provisions prepared for this contract. 1

2. Design Specifications: AASHTO 1998 LRFD Bridge Design Specifications (Second Edition) and its subsequent interim specifications with interim supplements and modifications by the Highways Division, Department of Transportation, State of Hawaii.

3. Loads:

(A) Dead Load: An allowance of 25 PSF for future wearing surface of asphalt concrete has been provided for in the design.

(B) Live Load: AASHTO HL-93 Truck Loading

(C) Seismic Loads: Acceleration coefficient - 0.16
Seismic Performance Zone - 2
Importance Category - Critical
Soil Profile - Type II

(D) Wind Load: 105 mph. Value is a 3 second gust speed at 32.8 ft above ground for Exposure C category and is associated with an annual probability of 0.02 (50 year mean recurrence interval).

4. Materials:

(A) All concrete strengths shall be as noted below:

Item No.	Structural Parts	Classes of Concrete	Specified Compressive Strength, f'c (28 Days)
(1)	Box Culverts	-	4000 PSI
(2)	Culvert Outlets	-	4000 PSI
(3)	Wing Walls	-	4000 PSI
(4)	Light pole foundation	-	4000 PSI
(5)	Except as noted otherwise, all others	A	3000 PSI

All concrete with a 28 day compressive strength of 4000 psi or greater shall have a maximum W/C Ratio of 0.45. The W/C Ratio for Class concrete shall follow the Standard Specifications.

(B) All reinforcing steel shall be ASTM A615 Grade 60 unless otherwise noted.

(C) Reinforcing steel shall be ASTM A706 where welded connections are required.

(D) All structural steel shall be ASTM A36 hot dip galvanized after fabrication, unless otherwise noted.

(E) All anchor bolts, washers and nuts shall be ASTM A325 hot dip galvanized after fabrication, unless otherwise specified.

5. Reinforcement:

(A) The minimum covering measured from the surface of the concrete to the face of any reinforcing bars shall be as follows, except as otherwise shown:

(1) Concrete cast against and permanently exposed to earth = 3"

(2) All others unless otherwise noted = 2".

(B) Reinforcing bars shall be detailed in accordance with the latest edition of the design specification in note 2 unless otherwise noted.

(C) Minimum clear spacing between parallel bars shall be 1 1/2 times the diameter of bars (for non bundled bars). In no case shall the clear distance between the bars be less than 1 1/2 times the maximum size of the coarse aggregate or 1 1/2".

5. Reinforcement: (Cont.)

(D) All dimensions relating to reinforcing bars are to centers of bars unless otherwise noted.

(E) Reinforcing bars shall be securely tied at all intersections and lap splices except where the spacing of intersections is less than one foot in each direction, in which case alternate intersections shall be tied.

6. Stainless Steel Reinforcing Steel

(A) Stainless steel bars for concrete reinforcement shall be deformed stainless steel bars Type 316L (UNS S31603) corrosion resistant anneal, Grade 60 conforming to ASTM A955.

(B) Stainless steel reinforcing shall not be in contact with any material other than concrete or plastic.

7. Construction Notes:

(A) See Standard Specifications and Special Provisions.

(B) Except as otherwise noted, all vertical dimensions are measured plumb.

(C) The Contractor shall verify all site conditions and not rely upon these plans for stream location, etc. Conditions may differ from those shown.

(D) The Contractor shall verify the location of all utility lines and notify the respective owners before commencing with excavation, and any temporary piling or sheeting.

(E) For concrete finish see Standard Specifications and Special Provisions.

(F) Construction joints may be relocated or additional ones added subject to the approval of the Engineer.

(G) Unless otherwise noted, all exposed concrete edges shall be chamfered 3/4"x3/4".

(H) Contractor shall verify elevations before fabricating wall reinforcing.

8. General:

(A) Standard detail drawings refer to all structures in general, except for modifications as may be required for special conditions. For such modifications refer to the corresponding detailed drawings.

9. Foundation:

(A) Active pressure = 40 pcf

(B) At-rest pressure = 90 pcf

(C) Earthquake load (active condition) = $6.5H^2$ (lb./ft.)

(D) Earthquake load (at-rest condition) = $10.6H^2$ (lb./ft.) 1


(E) Bearing Pressure at bottom culvert

(A) Extreme event limit state = 18 ksf

(B) Strength limit state = 9 ksf

(C) Service limit state = 6 ksf

1 For additional information, see soils report dated September 10, 2004 by Geolabs, Inc.

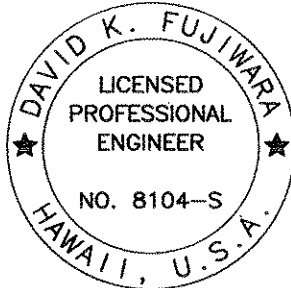

THIS WORK WAS PREPARED BY ME OR UNDER MY SUPERVISION.

David K. Fujiwara

SIGNATURE

4-30-06
EXPIRATION DATE OF THE LICENSE

ORIGINAL PLAN	SURVEY PLOTTED BY	DATE
NOTE BOOK	DRAWN BY	
	DESIGNED BY	
	QUANTITIES BY	
	CHECKED BY	
	No.	

1/18/05

1 Clarification

DATE

REVISION

STATE OF HAWAII
DEPARTMENT OF TRANSPORTATION
HIGHWAYS DIVISION

STRUCTURAL GENERAL NOTES

North-South Road
Phase 1A
F.A.I. Proj. No. STP-8930(1)

Scale: None

Date: Dec. 22, 2004

SHEET No. S0.3 OF 43 SHEETS

ADD. 70

C:\K5105\01-17-05 A231\NS-504 ADD. 400' dwg. 1/17/2005 11:22:50 AM, K51mcs03, 1-1

SYMBOLS AND ABBREVIATIONS

FED. ROAD DIST. NO.	STATE	FED. AID PROJ. NO.	FISCAL YEAR	SHEET NO.	TOTAL SHEETS
HAWAII	HAW.	STP-8930(1)	2005	ADD. 71	144

& And
@ At
ø Diameter
≥ Greater Than or Equal to
≤ Less Than or Equal to
Number

Abut. Abutment
Abbr. Abbreviation
Add. Additional
Alt. Alternate
AB Anchor Bolt
AC Asphaltic Concrete
Approx. Approximate
Az. Azimuth

Bk. Back
Bal. Balance
B Baseline
Bm. Beam
Brg., Brgs. Bearing, Bearings
BVC Beginning of Vertical Curve
Bet. Between
BF Both Faces
BW Both Ways
BFE Bottom of Footing Elevation
Bot., Bott., B Bottom
Br. Bridge
Blt. Bolt

Cant. Cantilever
CIP Cast Iron Pipe
CL Center line
CG Center of Gravity
cc Center to Center
Cl. Class
Clr. Clearance
CO Clean Out
Col. Column
Conc. Concrete
CBW Concrete Barrier Wall
CMU Concrete Masonry Unit
Conn. Connection
Const. Construction
CJ Construction Joint
Cntl. Jt. Control Joint
CLSM Controlled Low Strength
Material

Cont. Continuous
CSL Cross Hole Sonic Loggin
CF Cubic Feet
CY, Cu. Yd. Cubic Yard

Det. Detail
Dia. Diameter
Diaph. Diaphragm
Dim. Dimension
Dist. Distance
DO Ditto
Dwls. Dowels
Dn. Down
Dbl. Double
DI Drain Inlet, Ductile Iron
DMH Drain Manhole
Dwg., Dwgs. Drawing, Drawings
DS Drilled Shaft



E East
EA, Ea., ea. Each
EF Each Face
EFH Each Face Horizontal
EFV Each Face Vertical
EW Each Way
EPE Existing Edge of Pavement
EPS Expanded Polystyrene
ES Edge of Shoulder
Elec. Electrical
EMH Electrical Manhole
El., Elev. Elevation
Emb. Embankment
EVC End of Vertical Curve
Eq. Equal
Est. Estimated
Exc. Excavation
Excl. Excluding
Exist., Ex. Existing
Exp., (E) Expansion
EJ Expansion Joint
Ext. Exterior

FF Far Face, Front Face
f'c Specified Compressive Strength
of Concrete at 28 days
f'ci Specified Compressive Strength of
Concrete at Time of Initial Prestress
Ft. Feet, Foot
Fig. Figure
Fin. Gr. Finish Grade
(F) Flxed
FB Flat Bar
Ftg. Footing
FA Force account

Ga. Gage, Gauge
Galv. Galvanized

G, Gir. Girder
GDI Grated Drain Inlet
GFRP Glass Fiber Reinforced Polymer
Gr. Grade
Grd. Ground
GRP Grouted Rubble Pavement
Ht. Height
(H) Hinge
Horiz., H Horizontal
HDOT State of Hawaii Department
of Transportation
HDPE High Density Polyethylene
HS High strength
HECO Hawaiian Electric Company

IB Inbound
In. Inch
ID Inside Diameter
IF Inside Face
Int. Interior
Inv. Invert

Jt. Joint

K Kips
KF Kip Foot
KSF Kips Per Square Foot
KSI Kips Per Square Inch
KLF Kips Per Linear Foot

L Length
lb., lbs., LBS. Pound, Pounds
Ltg. Std. Lighting Standard
LF, Lin. Ft. Linear Feet/Foot
LS Lump Sum
Longit. Longitudinal

M Modified
MH Manhole
Max. Maximum
Mech. Mechanical
Min. Minimum
Misc. Miscellaneous
MPH Miles Per Hour

NF Near Face
N North

NIC Not in Contract
No. Number
NTS Not to Scale
O/S Offset
oc On Center
Opn'g Opening
OB Outbound
OD Outside Diameter
OG Outside Girder, Outbound Girder

Perf. Perforated
PL Plate
PCC Portland Cement Concrete
PC Point of Curvature
PCF Pounds per Cubic Foot
PPM Parts Per Million
PSF Pounds per Square Foot
PSI Pounds per Square Inch
PLF Pounds per Linear Foot
PI Point of Intersection
of Tangents
PIVC Point of Intersection of
Vertical Curve
PT Point of Tangency
Pt., Pts. Point, Points
PRC Point of Reverse Curvature
PVC Polyvinyl Chloride
Prestr. Prestressed
P/S Prestressed Strands
PB Pull Box


Rad., R Radius
RF Rear Face
RC Reinforced Concrete
RCP Reinforced Concrete Pipe
Rebar Reinforcing Bar
Ref. Reference
Reinf. Reinforced, Reinforcing,
Reinforcement
Req'd. Required
Ret. Retaining
ROW Right of Way
Rdwy. Roadway



Sect. Section
SRW Segmental Retaining Wall
Sht. Sheet
Sim. Similar
Sl. Slope
S South

Spc., Spg. Spaces, Spacing
Sprd. Spread
Spec. Specification
SF Square Feet
SY Square Yard
SS Stainless Steel
Std. Standard
Sta. Station
Stiff. Stiffener
Stirr. Stirrup
Stl. Steel
Str. Straight
Struct. Structure
SE Super Elevation
Symm. Symmetrical
Tan. Tangent
Temp. Temporary
Thk. Thick
T Top
T&B Top and Bottom
TCE Top of Column (and Bent Cap Soffit) Elevation
TOD Top of Deck
TFE Top of Footing Elevation
Tot. Total
Transv. Transverse
TS Structural Tubing
Typ. Typical
Undergrd. Underground
Var. Varies
Vert., V Vertical
VC Vertical Curve

W/C Water/Cement
w/ With
W West
WWF Welded Wire Fabric
WW Wingwall
WP Work Point, Working Point
WS Water Surface
Yr. Year

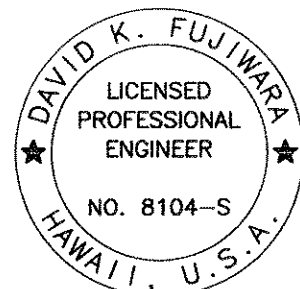

THIS WORK WAS PREPARED BY
ME OR UNDER MY SUPERVISION.

SIGNATURE: *David K. Fujiwara* 4-30-06
EXPIRATION DATE OF THE LICENSE

STATE OF HAWAII
DEPARTMENT OF TRANSPORTATION
HIGHWAYS DIVISION

SYMBOLS AND ABBREVIATIONS

North-South Road
Phase 1A
F.A.I. Proj. No. STP-8930(1)


Scale: None Date: Dec. 22, 2004

SHEET No. S0.4 OF 43 SHEETS

ADD. 71

ORIGINAL PLAN	SURVEY PLOTTED BY	DATE
NOTE BOOK	DRAWN BY	
No.	DESIGNED BY	
	QUANTITIES BY	
	CHECKED BY	


FED. ROAD DIST. NO.	STATE	FED. AID PROJ. NO.	FISCAL YEAR	SHEET NO.	TOTAL SHEETS
HAWAII	HAW.	STP-8930(1)	2005	C.O.ADD-72	144

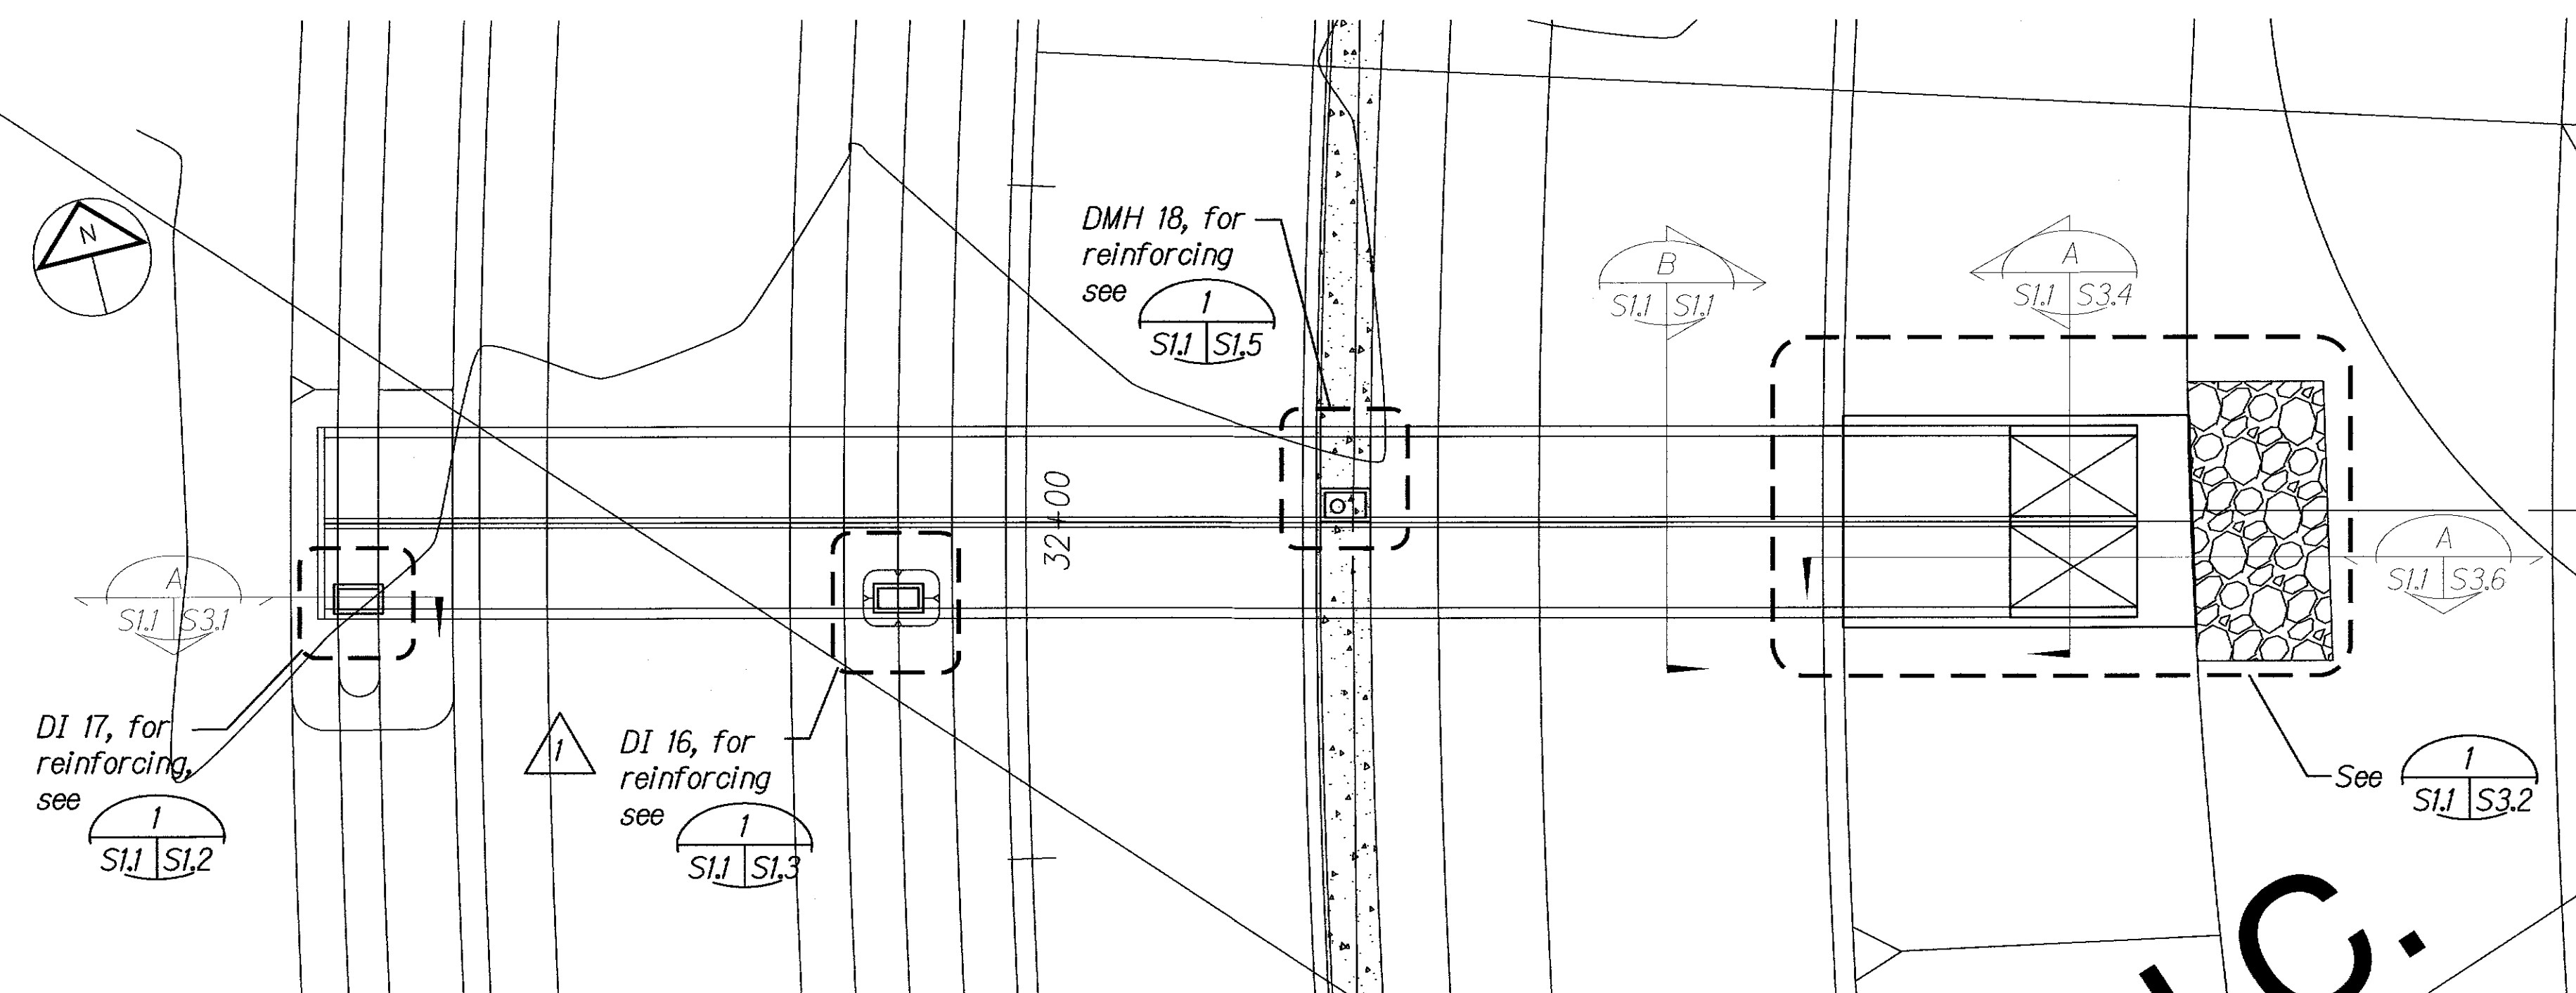

- Notes:**
1. Construction joints shall be spaced at a maximum of 60'-0" and control joints shall be spaced at a maximum of 20'-0".
 2. Refer to sheet S3.1 for construction and control joint details.
 3. Refer to civil drawings for Culvert, DI, DMH and Outlet profile dimensions and elevations.


DRAIN CULVERT "C" - LAYOUT PLAN
SCALE: 1" = 20'

N.I.C.

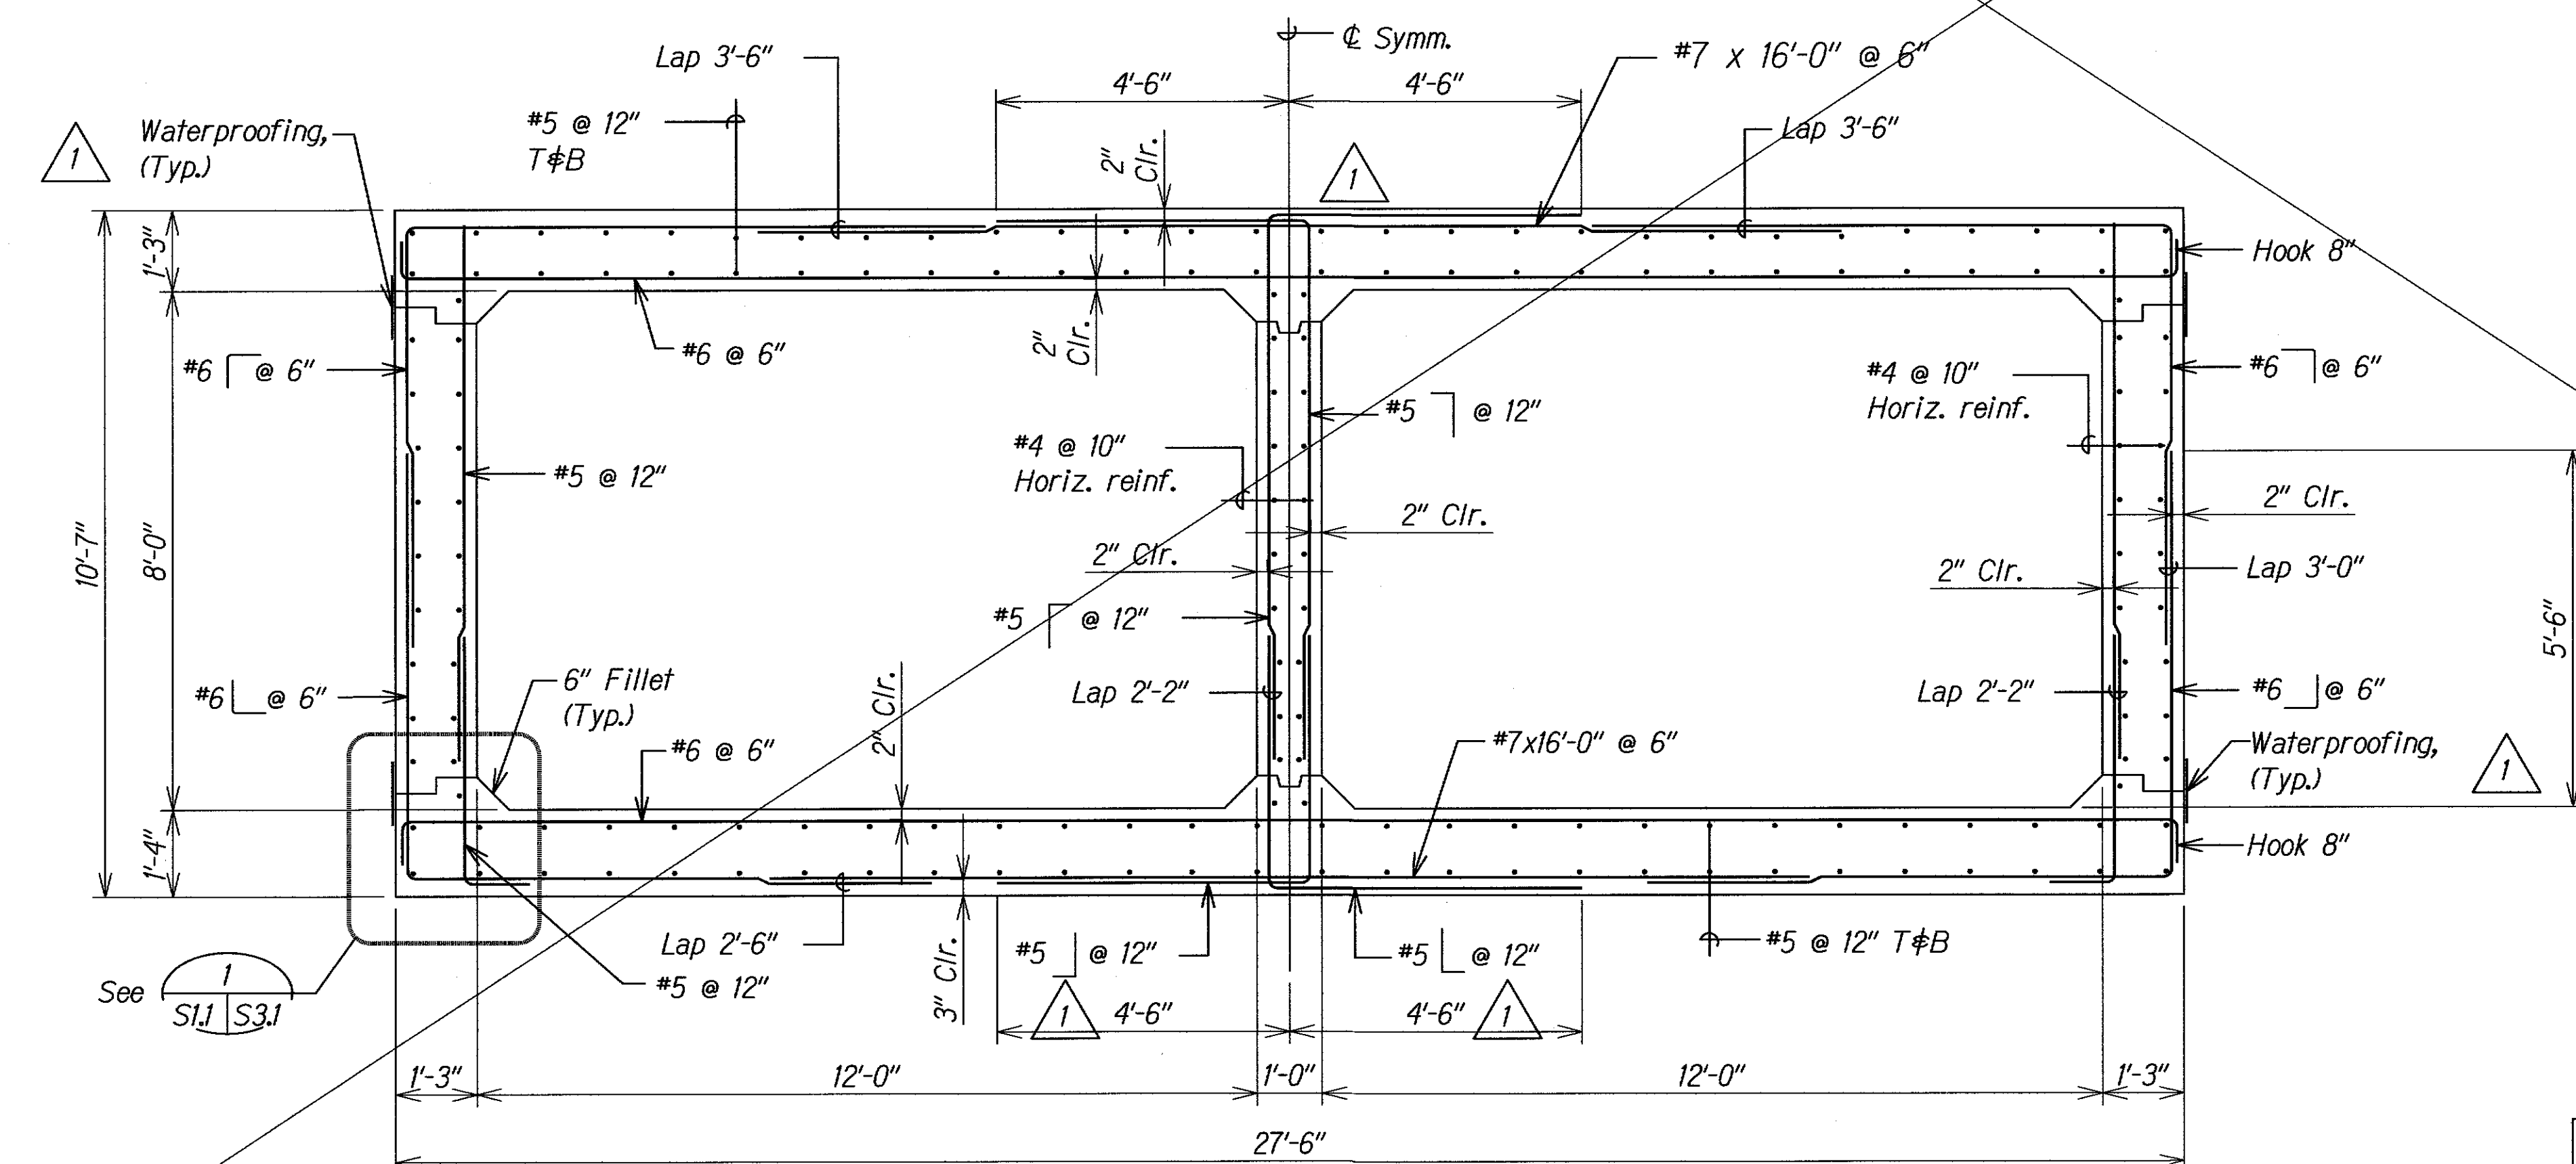

DRAIN CULVERT "C" - TYPICAL SECTION
SCALE: 1/2" = 1'-0"

DESIGNED BY	DATE
CHECKED BY	
NOTED BY	
QUANTITIES BY	
TRACED BY	
DRAWN BY	
SURVEY PLATTED BY	
ORIGINAL PLAN	No.

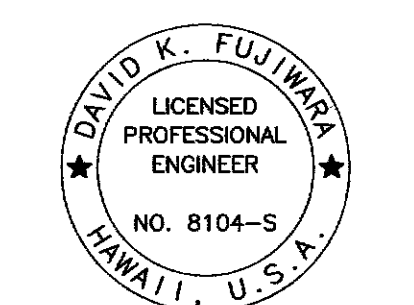

THIS WORK WAS PREPARED BY ME OR UNDER MY SUPERVISION.
Signature: David K. Fujiwara
EXPIRATION DATE OF THE LICENSE: 4-30-08

DATE	REVISION
6/21/06	Delete Sheet per SDOT
1/18/05	Clarification of Notes and Added Dimensions

STATE OF HAWAII
DEPARTMENT OF TRANSPORTATION
HIGHWAYS DIVISION


DRAIN CULVERT "C" - LAYOUT PLAN AND SECTION

North-South Road
Phase 1A
F.A.I. Proj. No. STP-8930(1)


Scale: As Noted Date: Dec. 22, 2004

SHEET No. S1.1 OF 43 SHEETS

FED. ROAD DIST. NO.	STATE	FED. AID PROJ. NO.	FISCAL YEAR	SHEET NO.	TOTAL SHEETS
HAWAII	HAW.	STP-8930(1)	2005	C.O. ADD. 73	144

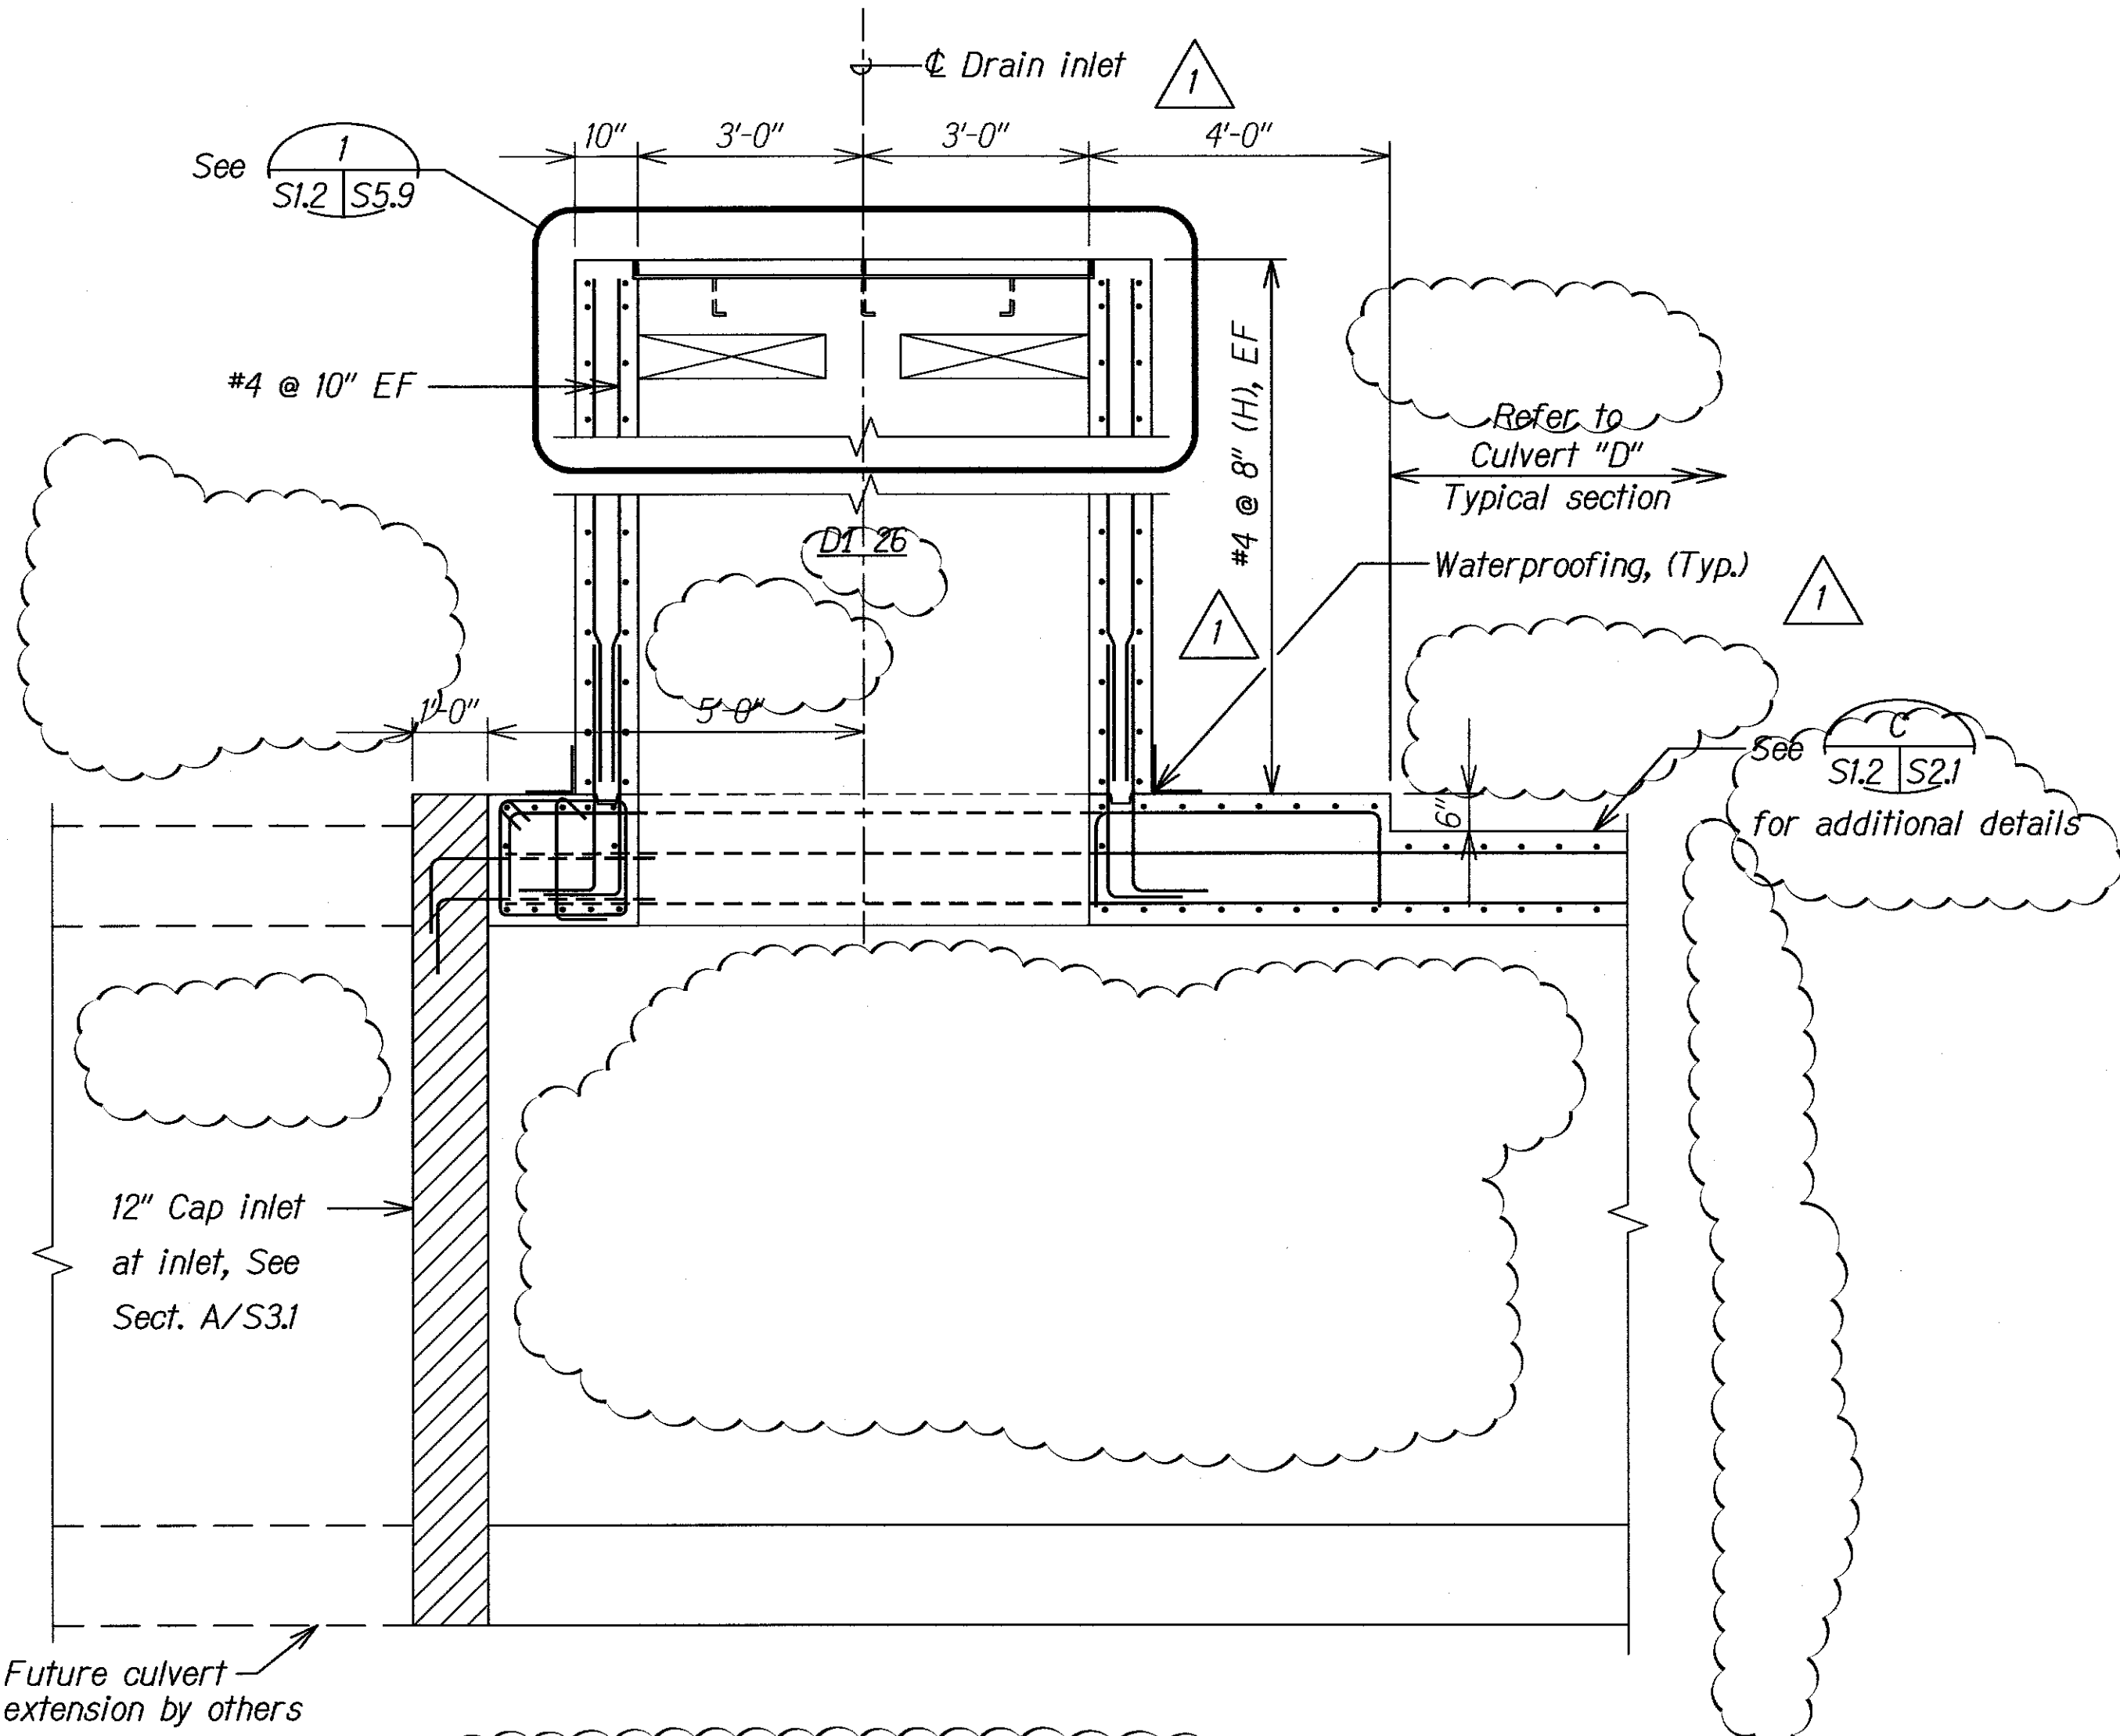

DRAIN CULVERT "D" - SECTION A
SCALE: 1/2" = 1'-0"

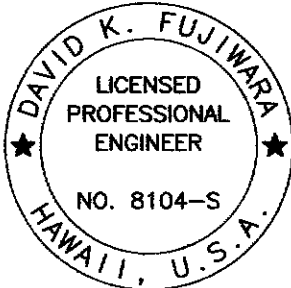

THIS WORK WAS PREPARED BY ME OR UNDER MY SUPERVISION.

Signature: David K. Fujiwara
EXPIRATION DATE OF THE LICENSE: 6-30-08

ORIGINAL PLAN	DATE
SURVEY PLOTTED BY	
DESIGNED BY	
TRACED BY	
NOTE BOOK	
DESIGNED BY	
QUANTITIES BY	
CHECKED BY	
No.	


6/21/06	Remove & Revise Detail per SDOT
1/18/05	1 Clarification of Notes
DATE	REVISION

STATE OF HAWAII
DEPARTMENT OF TRANSPORTATION
HIGHWAYS DIVISION

DRAIN CULVERT "D" - SECTION AT DI 26
North-South Road
Phase 1A
F.A.I. Proj. No. STP-8930(1)

Scale: As Noted Date: Dec. 22, 2004
SHEET No. S1.2 OF 43 SHEETS


FED. ROAD DIST. NO.	STATE	FED. AID PROJ. NO.	FISCAL YEAR	SHEET NO.	TOTAL SHEETS
HAWAII	HAW.	STP-8930(1)	2005	ADD. 74	144

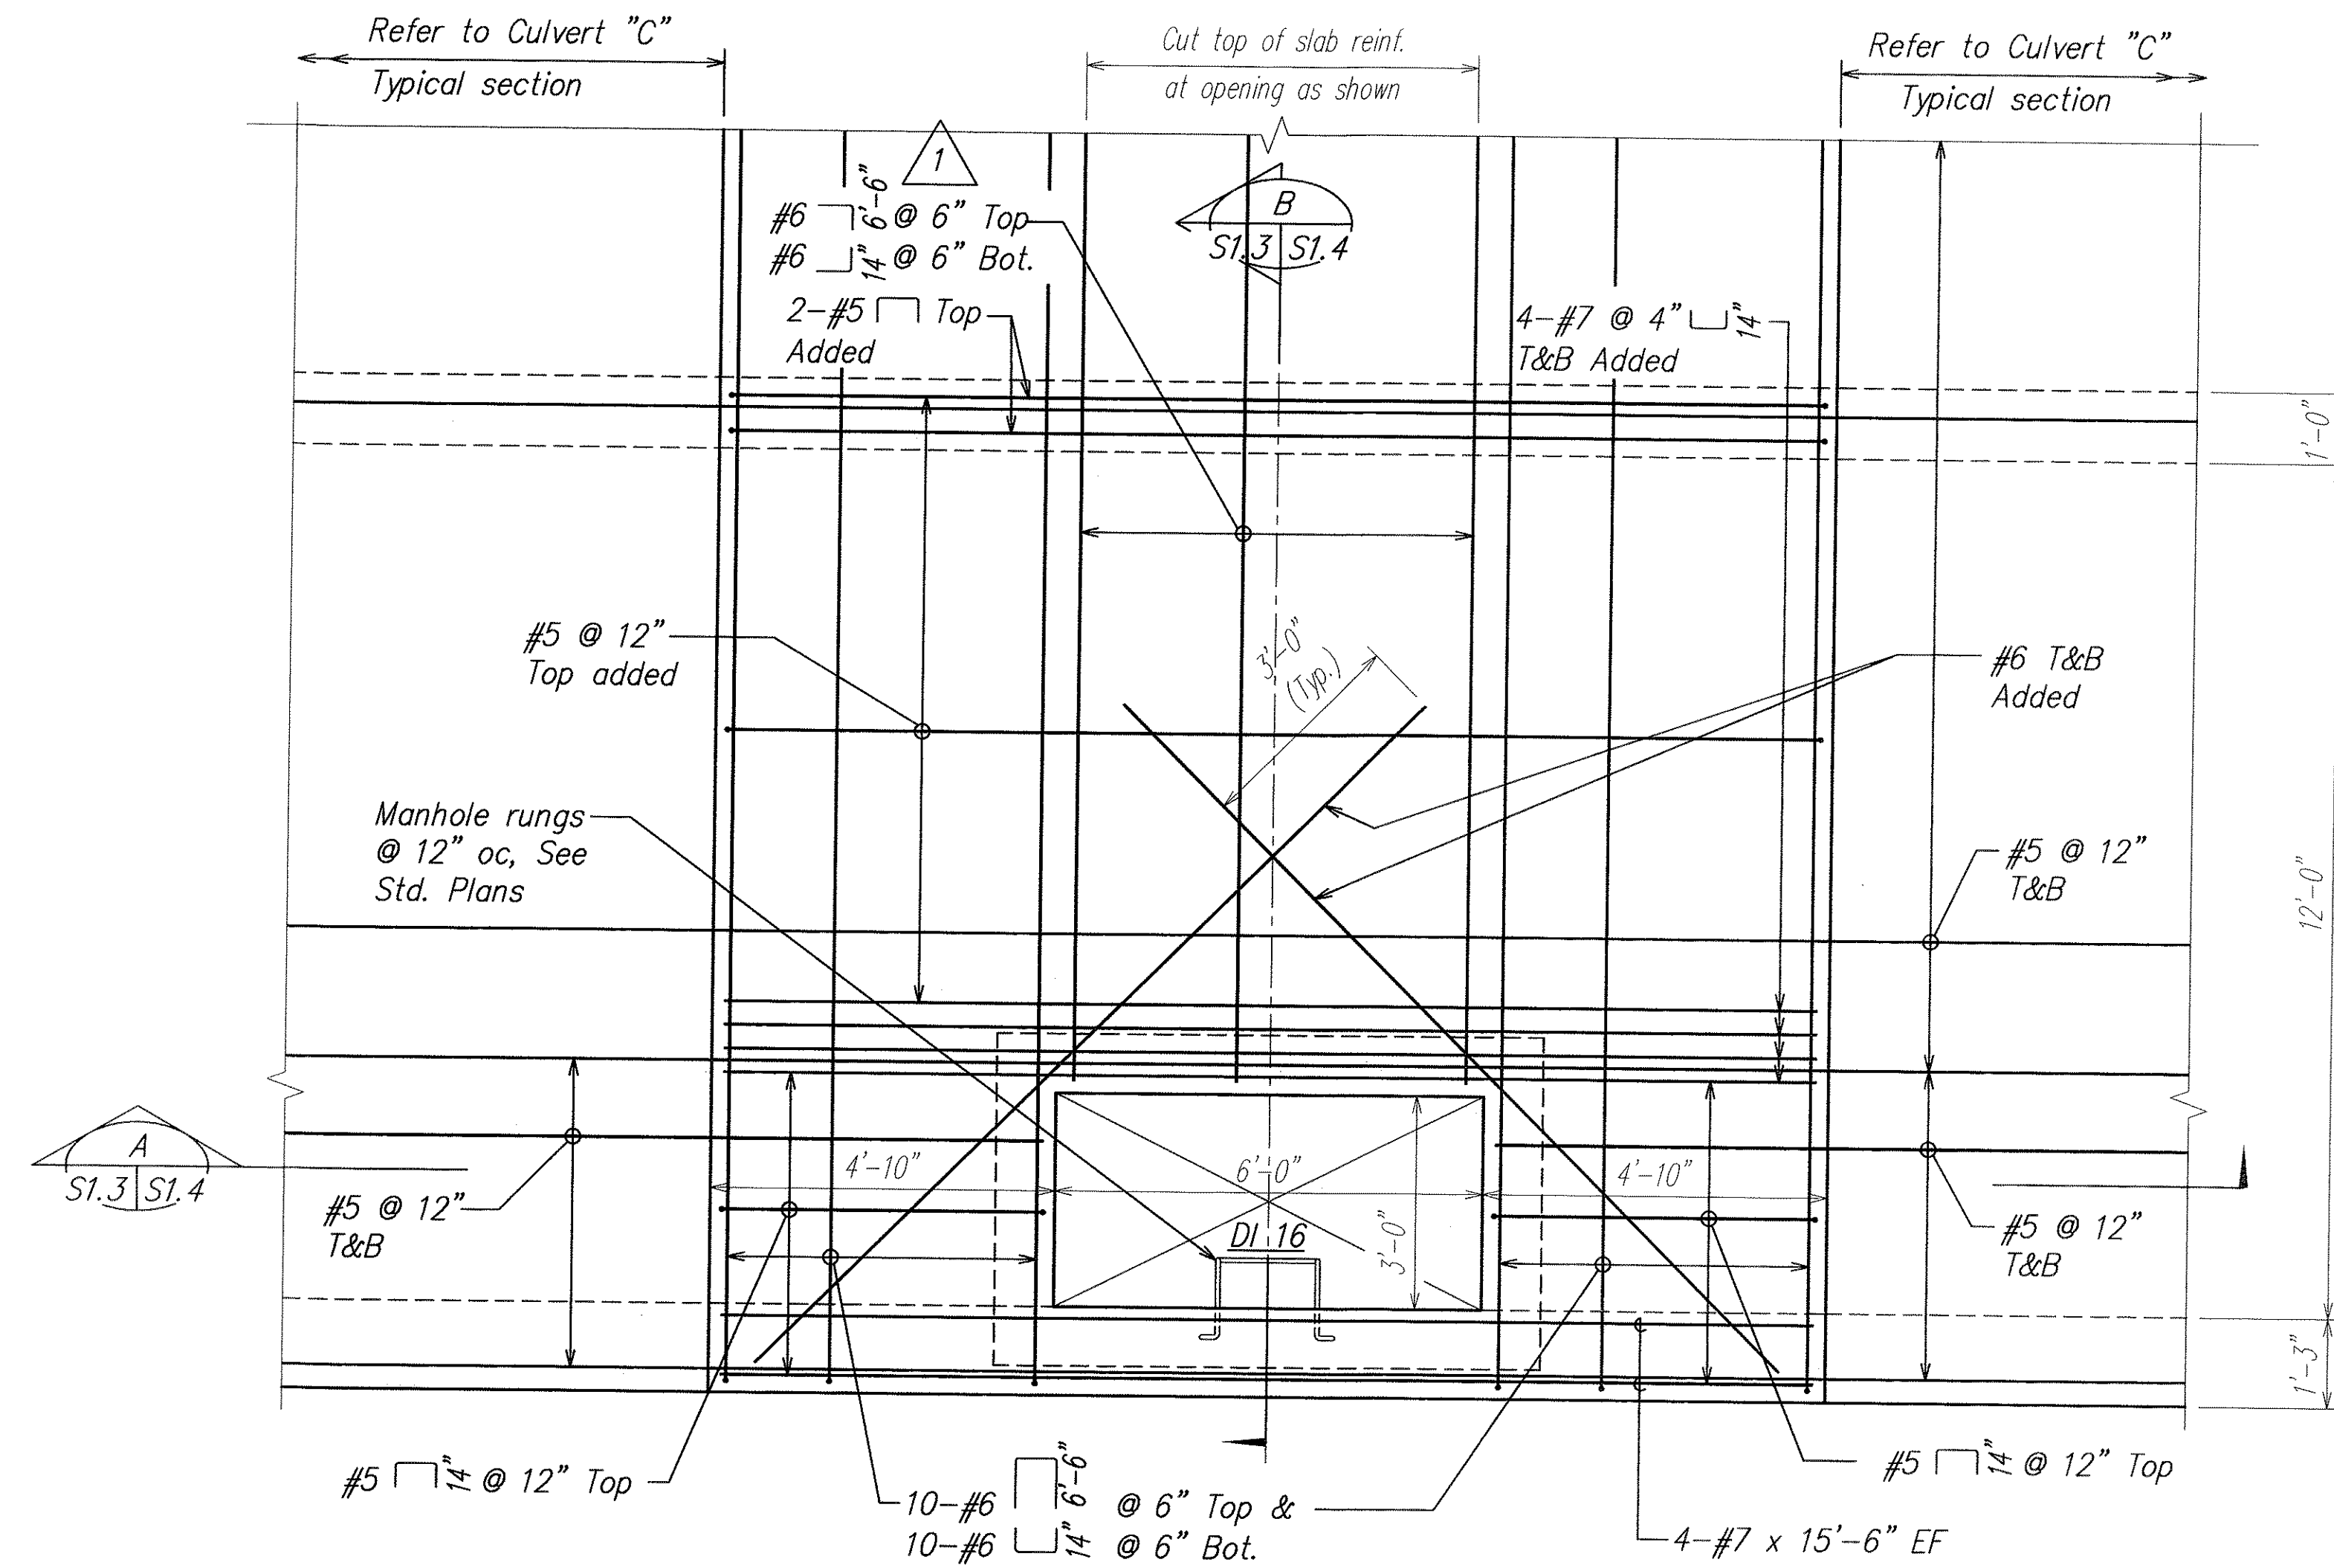

DRAIN CULVERT "C" - TOP SLAB PLAN AT DI 16

SCALE: 1/2" = 1'-0"


1
S1.1 S1.3

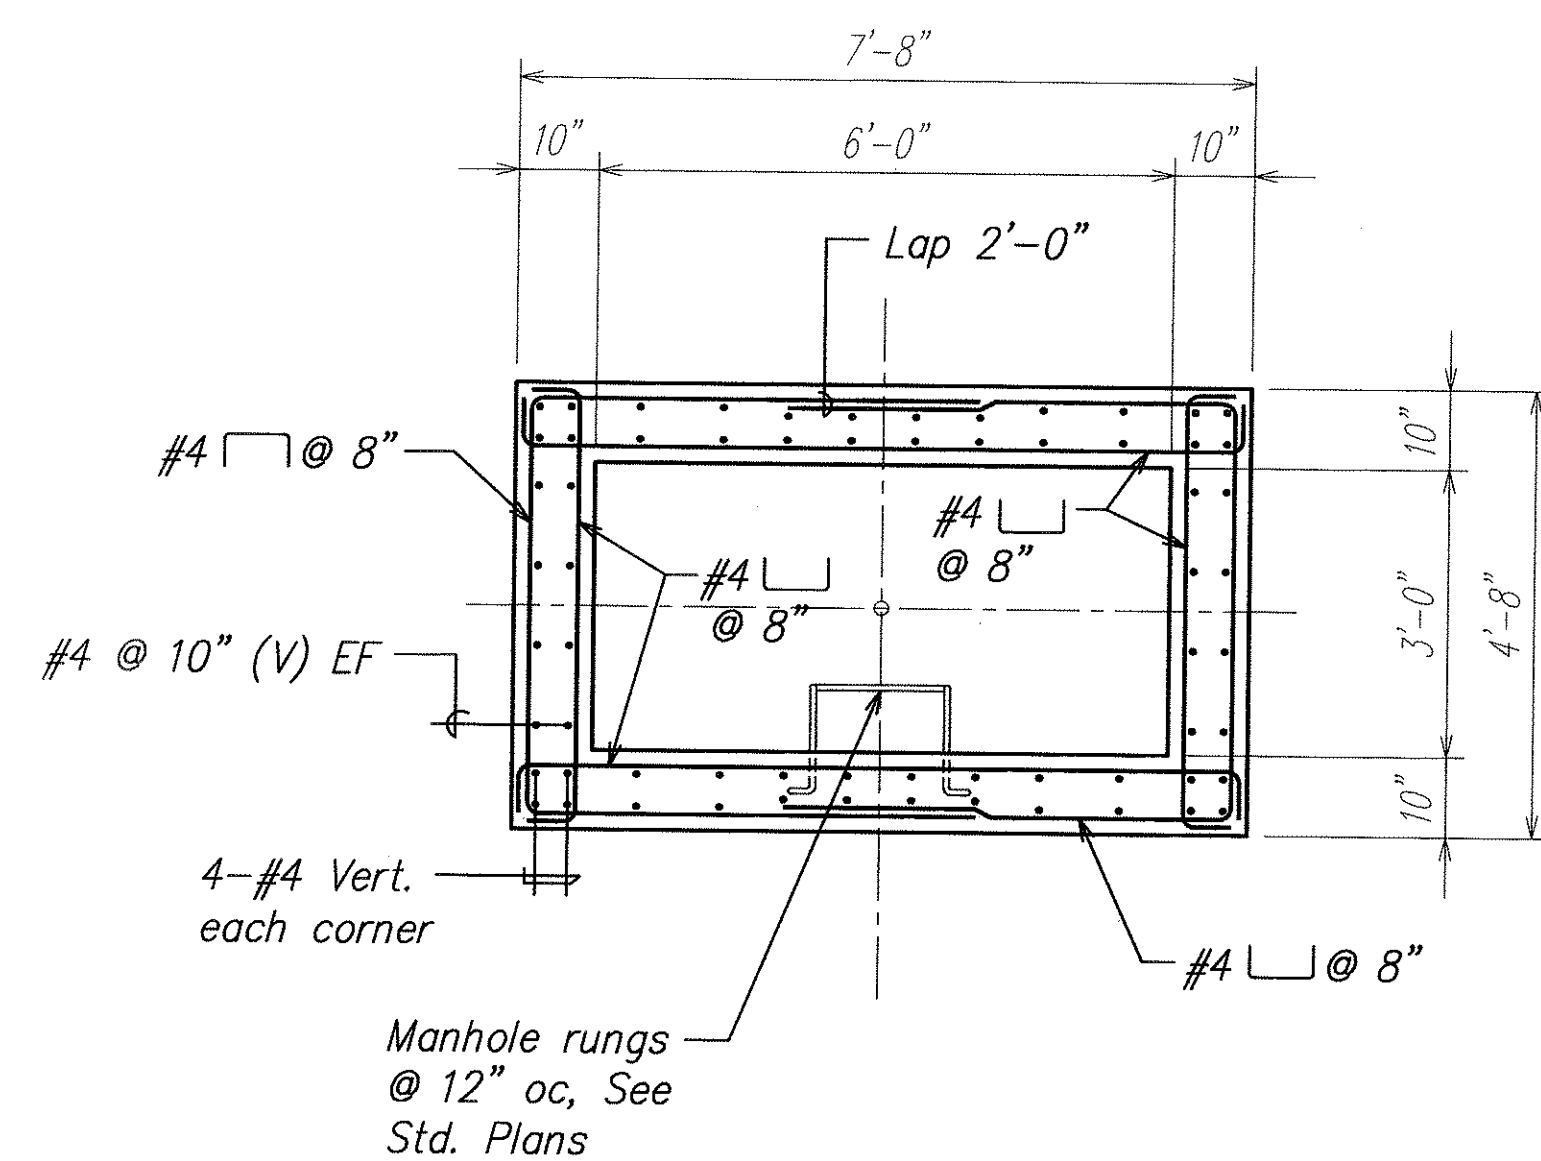

SECTION

SCALE: $1/2" = 1'-0"$

S1.2 S1.4 S1.3

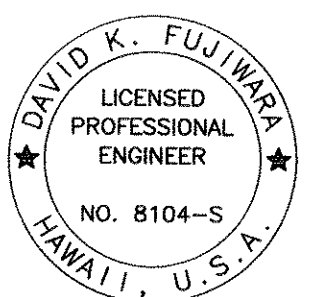

THIS WORK WAS PREPARED BY
ME OR UNDER MY SUPERVISION.

David K. Ferguson
4-30-06
SIGNATURE EXPIRATION DATE OF THE LICENSE

STATE OF HAWAII
DEPARTMENT OF TRANSPORTATION
HIGHWAYS DIVISION

DRAIN CULVERT "C" - TOP SLAB PLAN
AT DI 16, AND SECTION

North-South Road

Phase 1A
F.A.I. Proj. No. STP-8930(1)

Scale: As Noted Date: Dec. 22, 2004

SHEET No. S1.3 OF 43 SHEETS



ADD. 74

1/18/05	 Clarification of Notes
DATE	REVISION

ORIGINAL PLAN	SURVEY PLOTTED BY _____ DATE _____
NOTE BOOK	DRAWN BY _____
	TRACED BY _____
	DESIGNED BY _____
	QUANTITIES BY _____
No. _____	CHECKED BY _____

NS-S103.DWG
PLOT 1 = 1


FED. ROAD DIST. NO.	STATE	FED. AID PROJ. NO.	FISCAL YEAR	SHEET NO.	TOTAL SHEETS
HAWAII	HAW.	STP-8930(1)	2005	C.O.ADD. 76	144

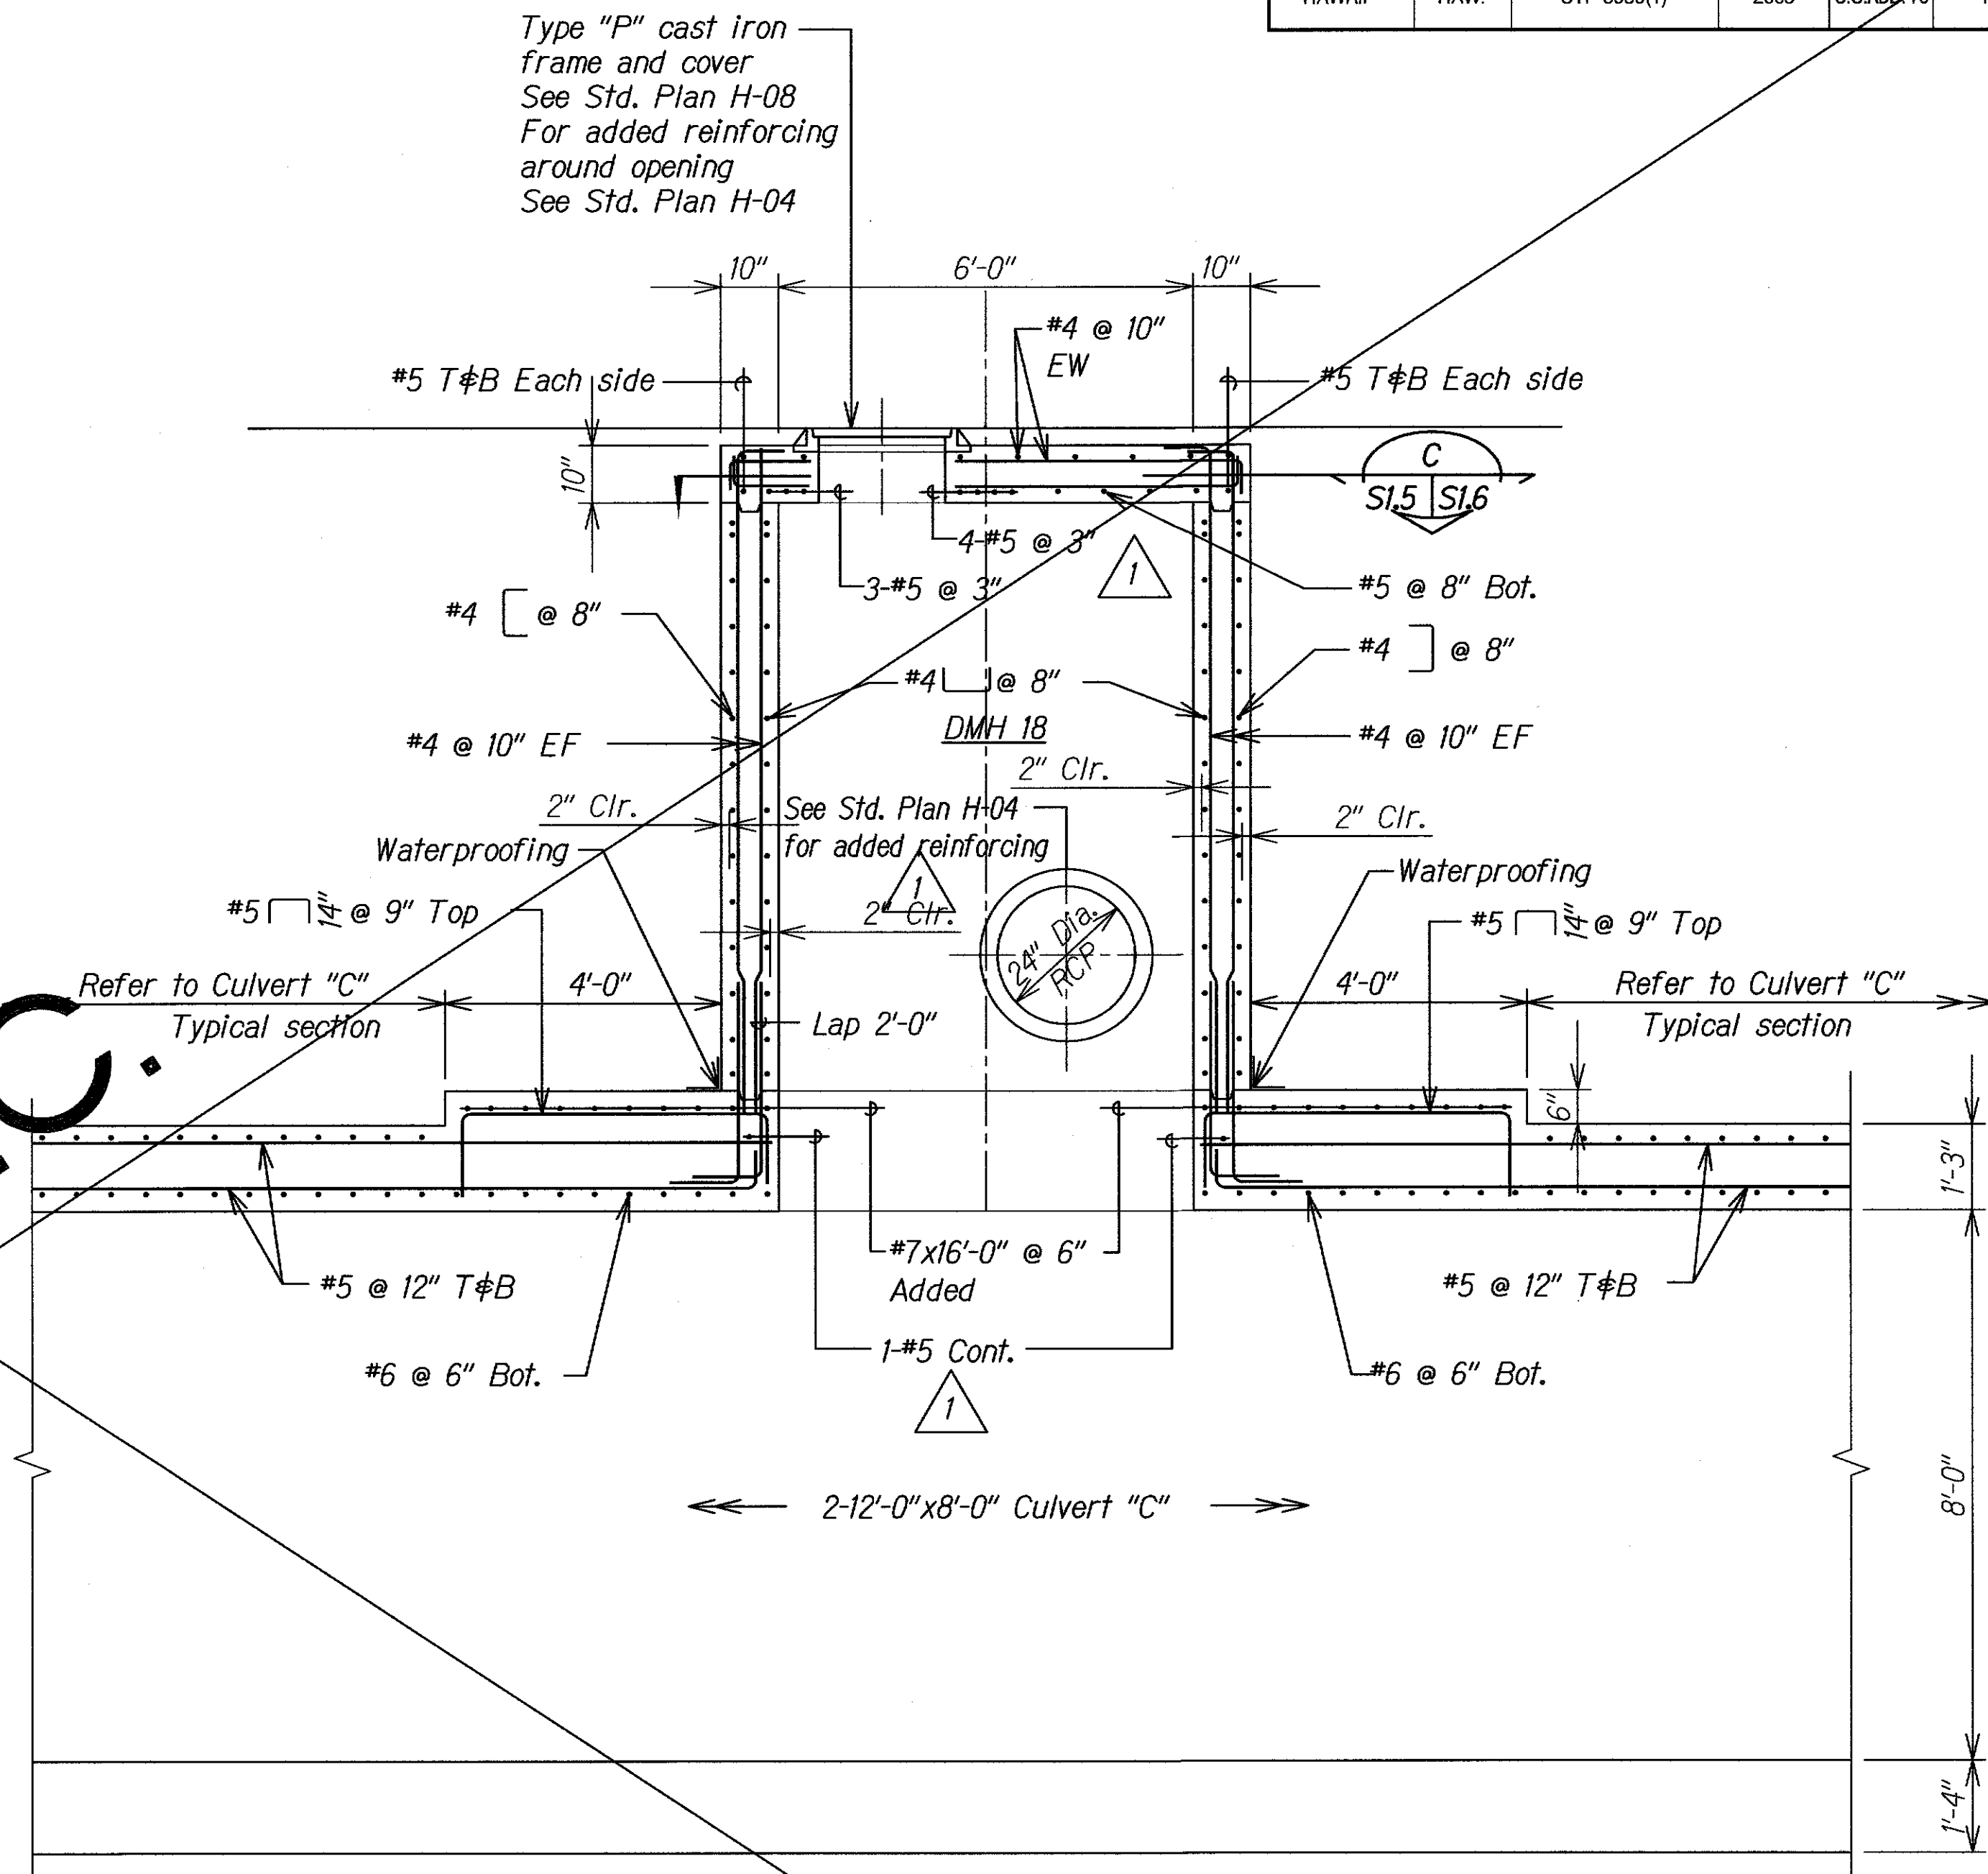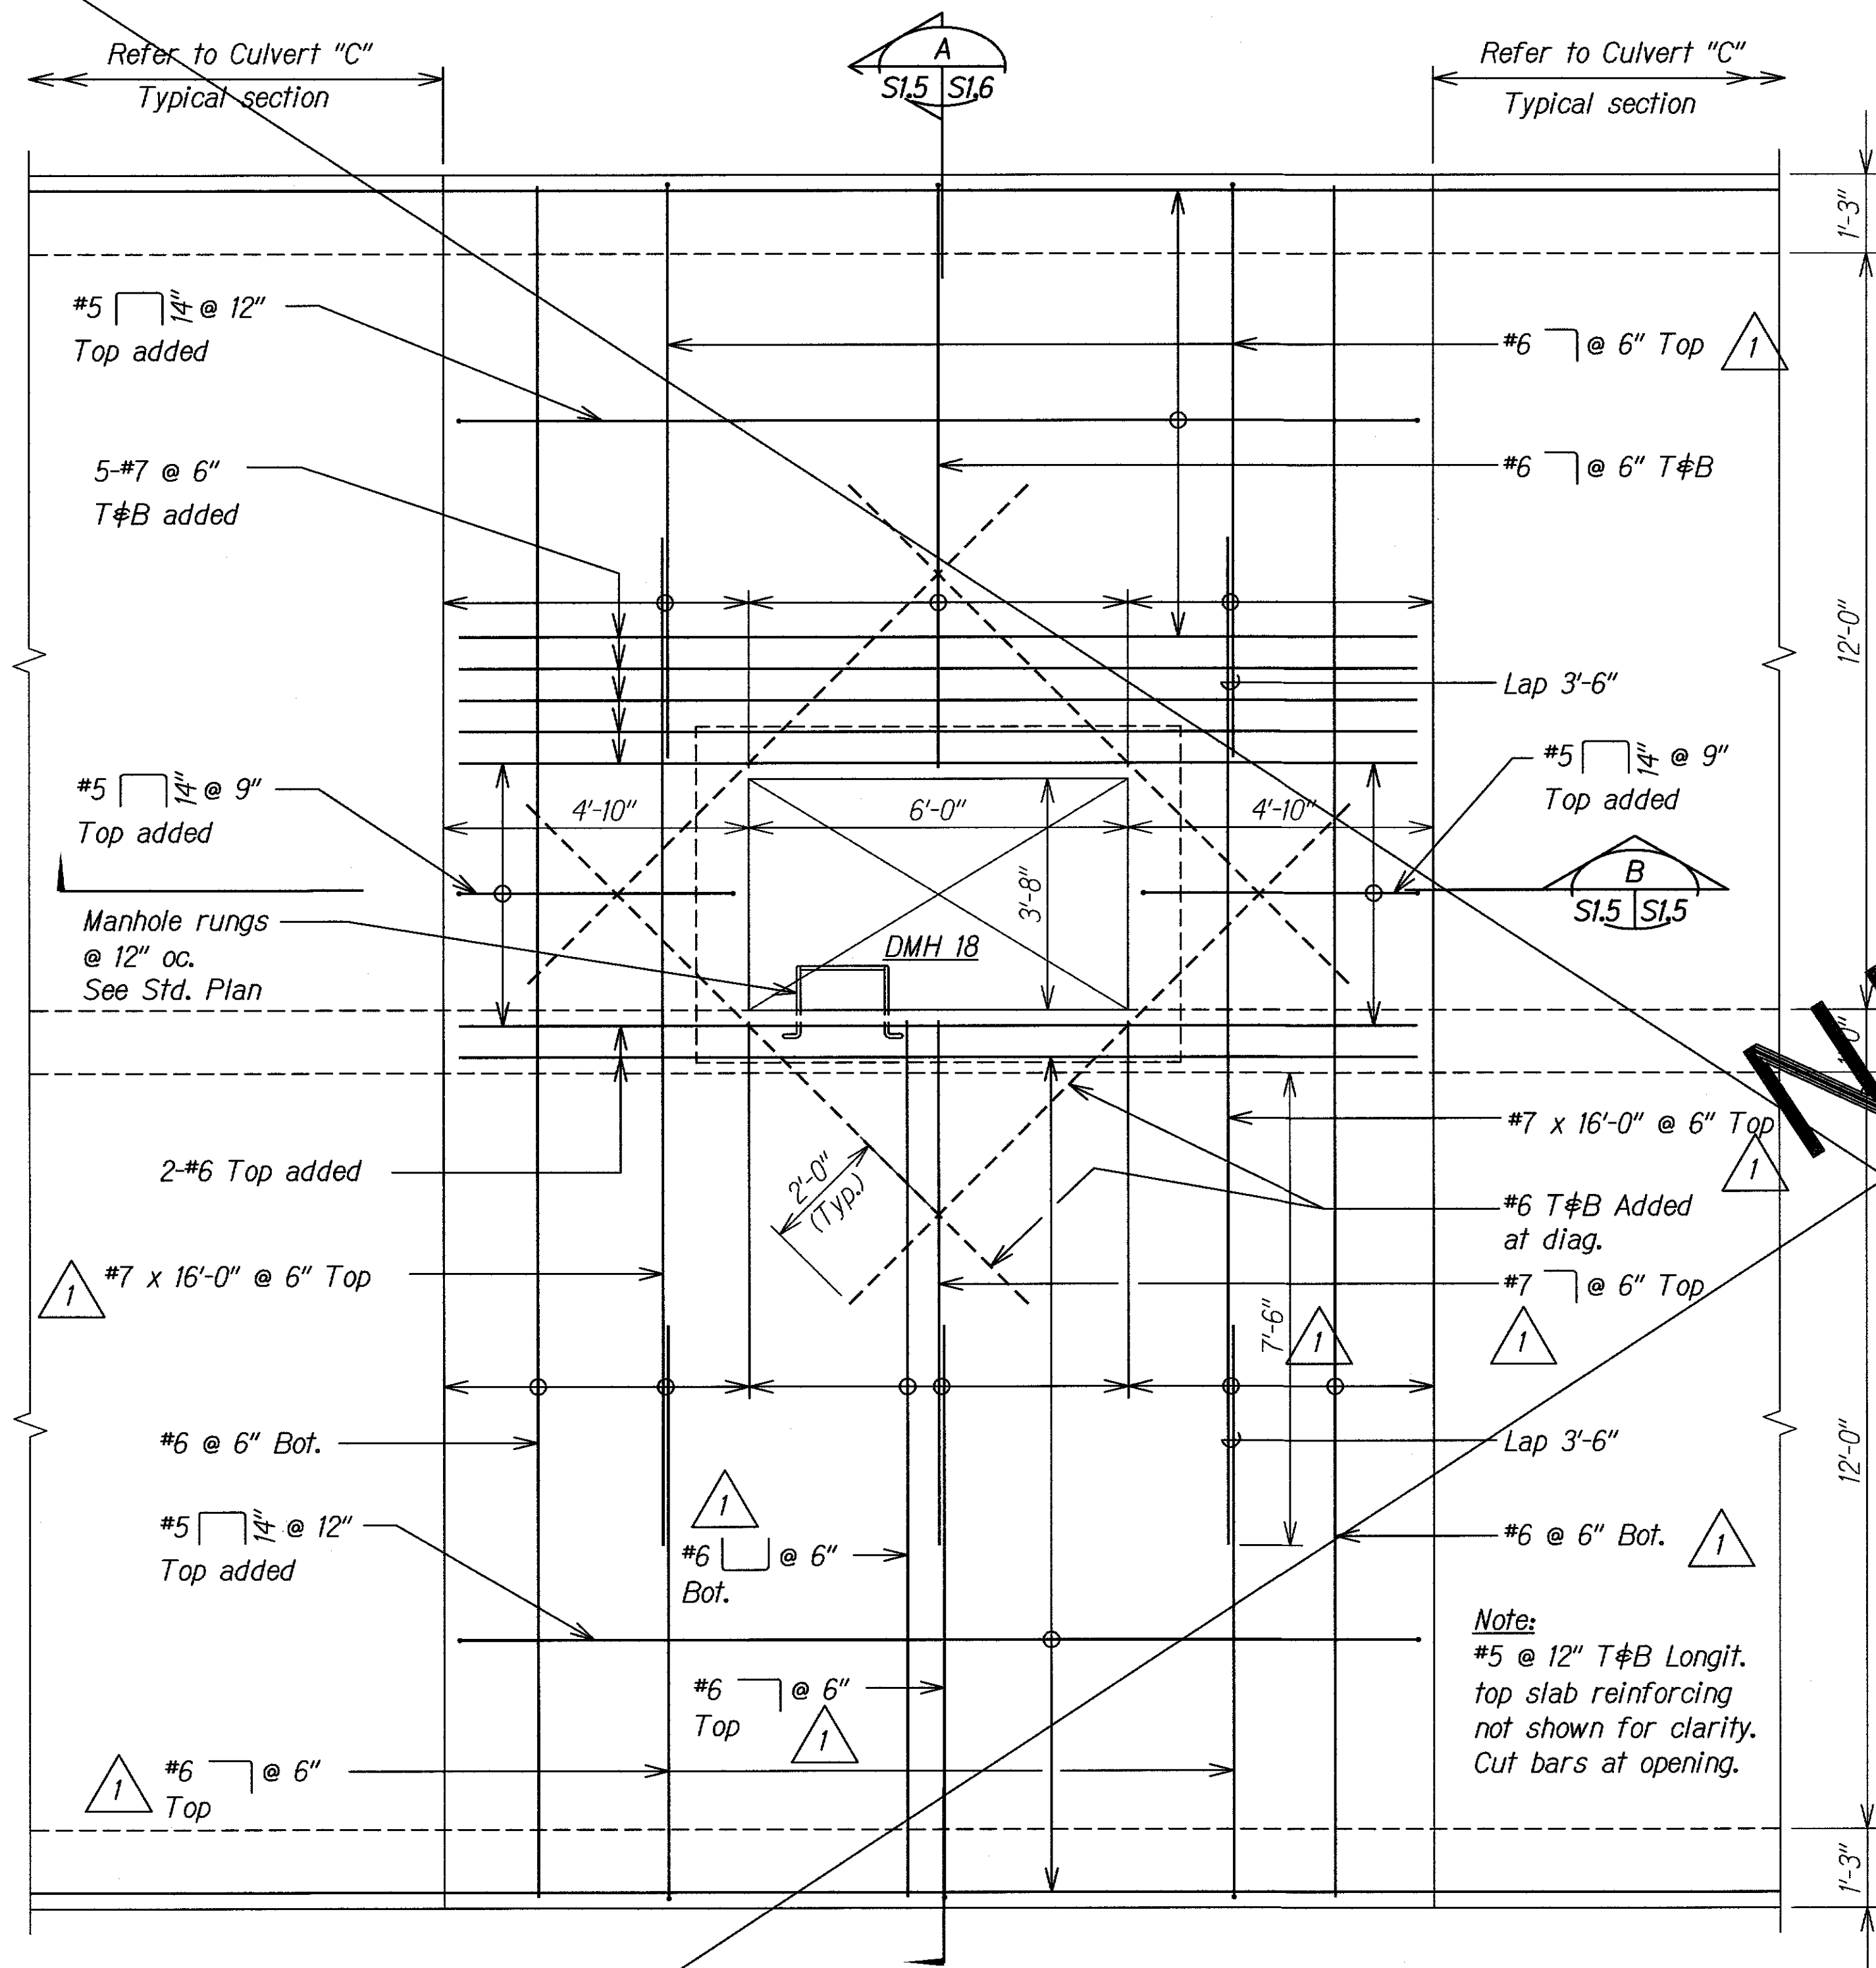

DRAIN CULVERT "C" TOP SLAB PLAN AT DMH 18
 SCALE: 1/2" = 1'-0"
 1
 S1.5 S1.6

SECTION B
 SCALE: 1/2" = 1'-0"
 S1.5 S1.6 S1.5

DATE	_____
SURVEY PLOTTED BY	_____
DRAWN BY	_____
TRACED BY	_____
NOTED BY	_____
CHECKED BY	_____
NO.	_____

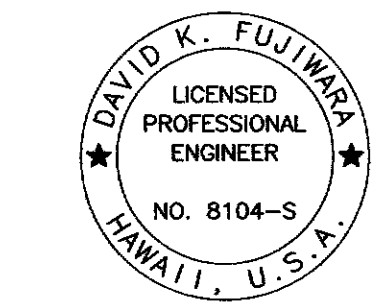

THIS WORK WAS PREPARED BY
 ME OR UNDER MY SUPERVISION.
 David K. Fujimura
 SIGNATURE EXPIRATION DATE OF THE LICENSE 4-30-08

6/21/06	Delete Sheet per SDOT
1/18/05	1 Clarification of Notes
DATE	REVISION


STATE OF HAWAII
 DEPARTMENT OF TRANSPORTATION
 HIGHWAYS DIVISION

**DRAIN CULVERT "C" - TOP SLAB PLAN
 AT DMH 18 AND SECTION**

North-South Road
 Phase 1A
 F.A.I. Proj. No. STP-8930(1)


Scale: As Noted Date: Dec. 22, 2004
 SHEET No. S1.5 OF 43 SHEETS

FED. ROAD DIST. NO.	STATE	FED. AID PROJ. NO.	FISCAL YEAR	SHEET NO.	TOTAL SHEETS
HAWAII	HAW.	STP-8930(1)	2005	C.O.ADD. 77	144

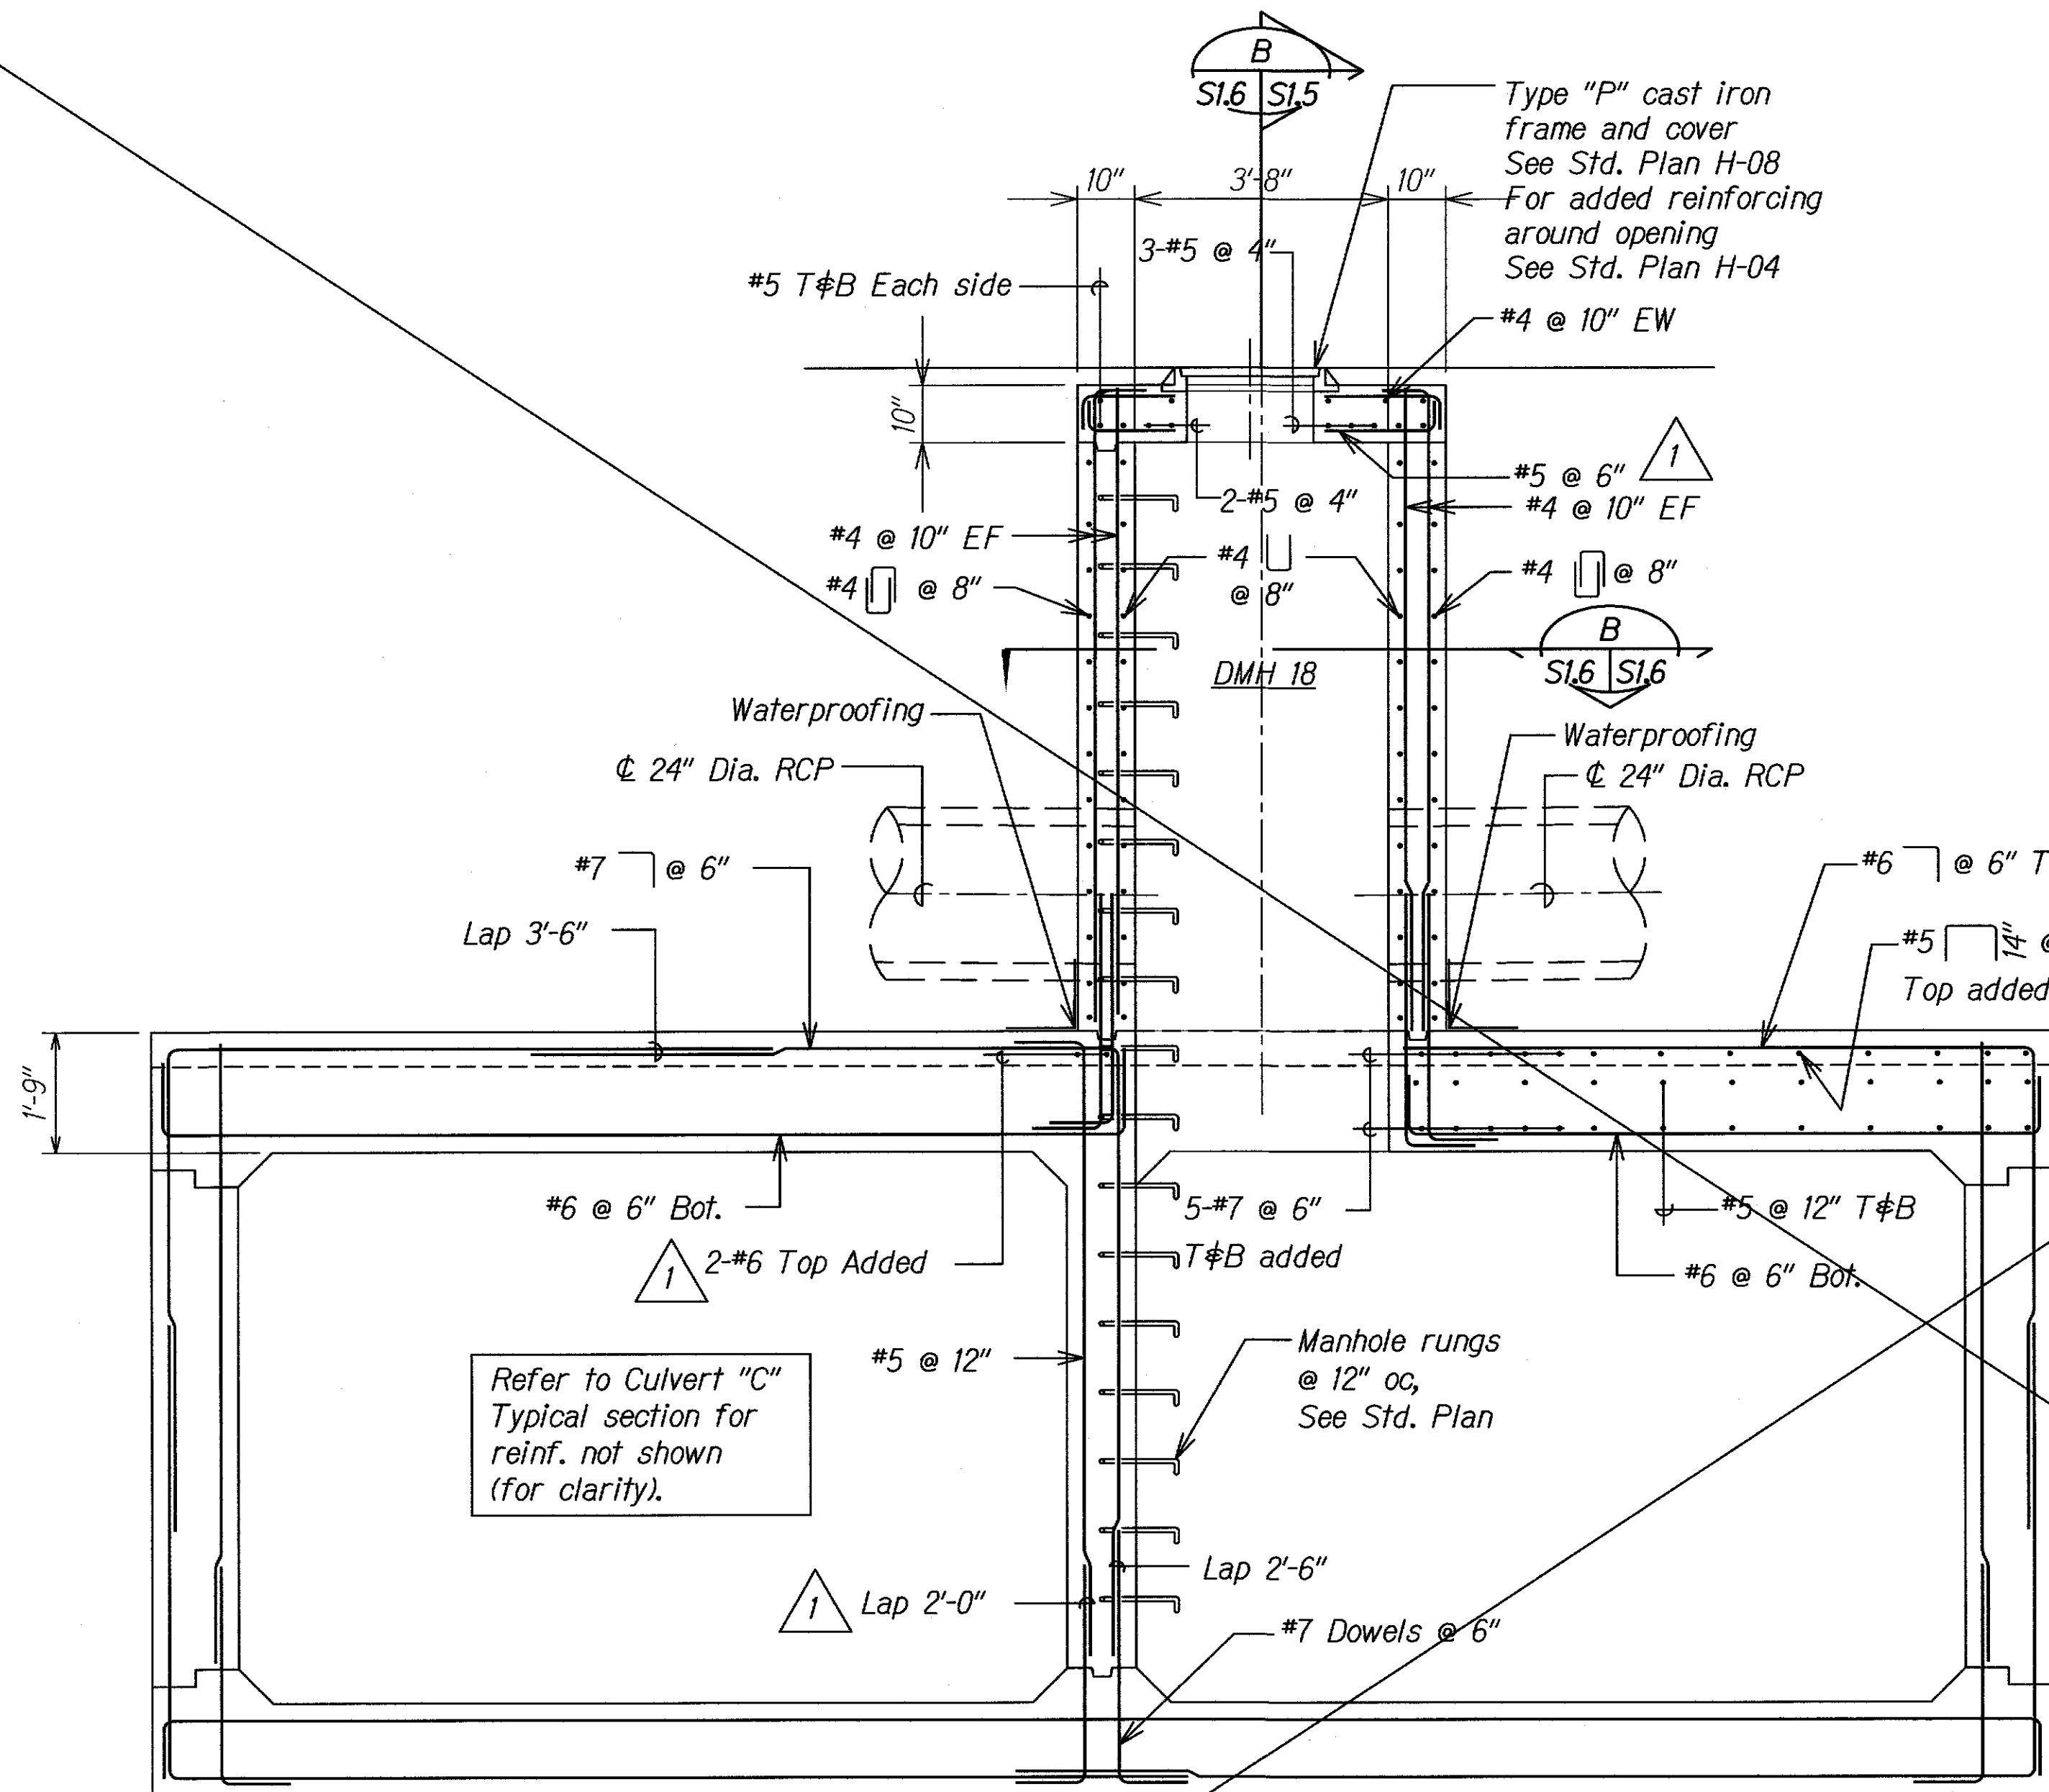


Refer to Culvert "C"
Typical section for
reinf. not shown
(for clarity).

SECTION A
SCALE: 1/2" = 1'-0"

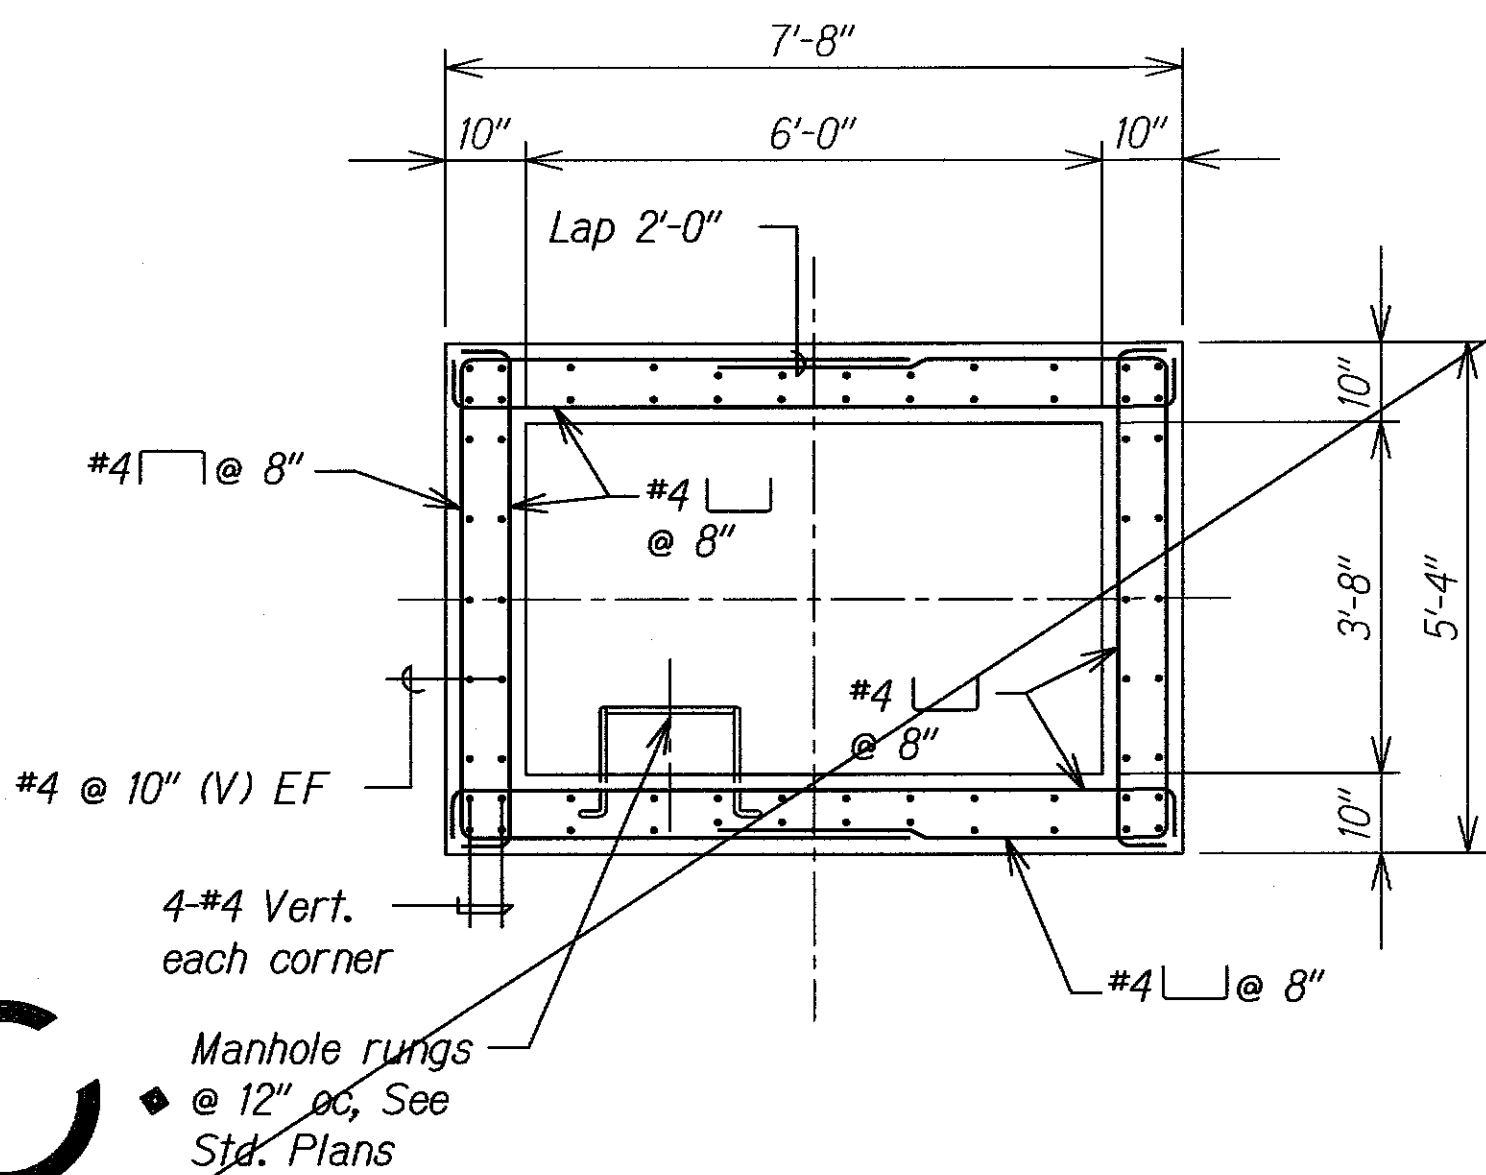


SECTION B
SCALE: 1/2" = 1'-0"

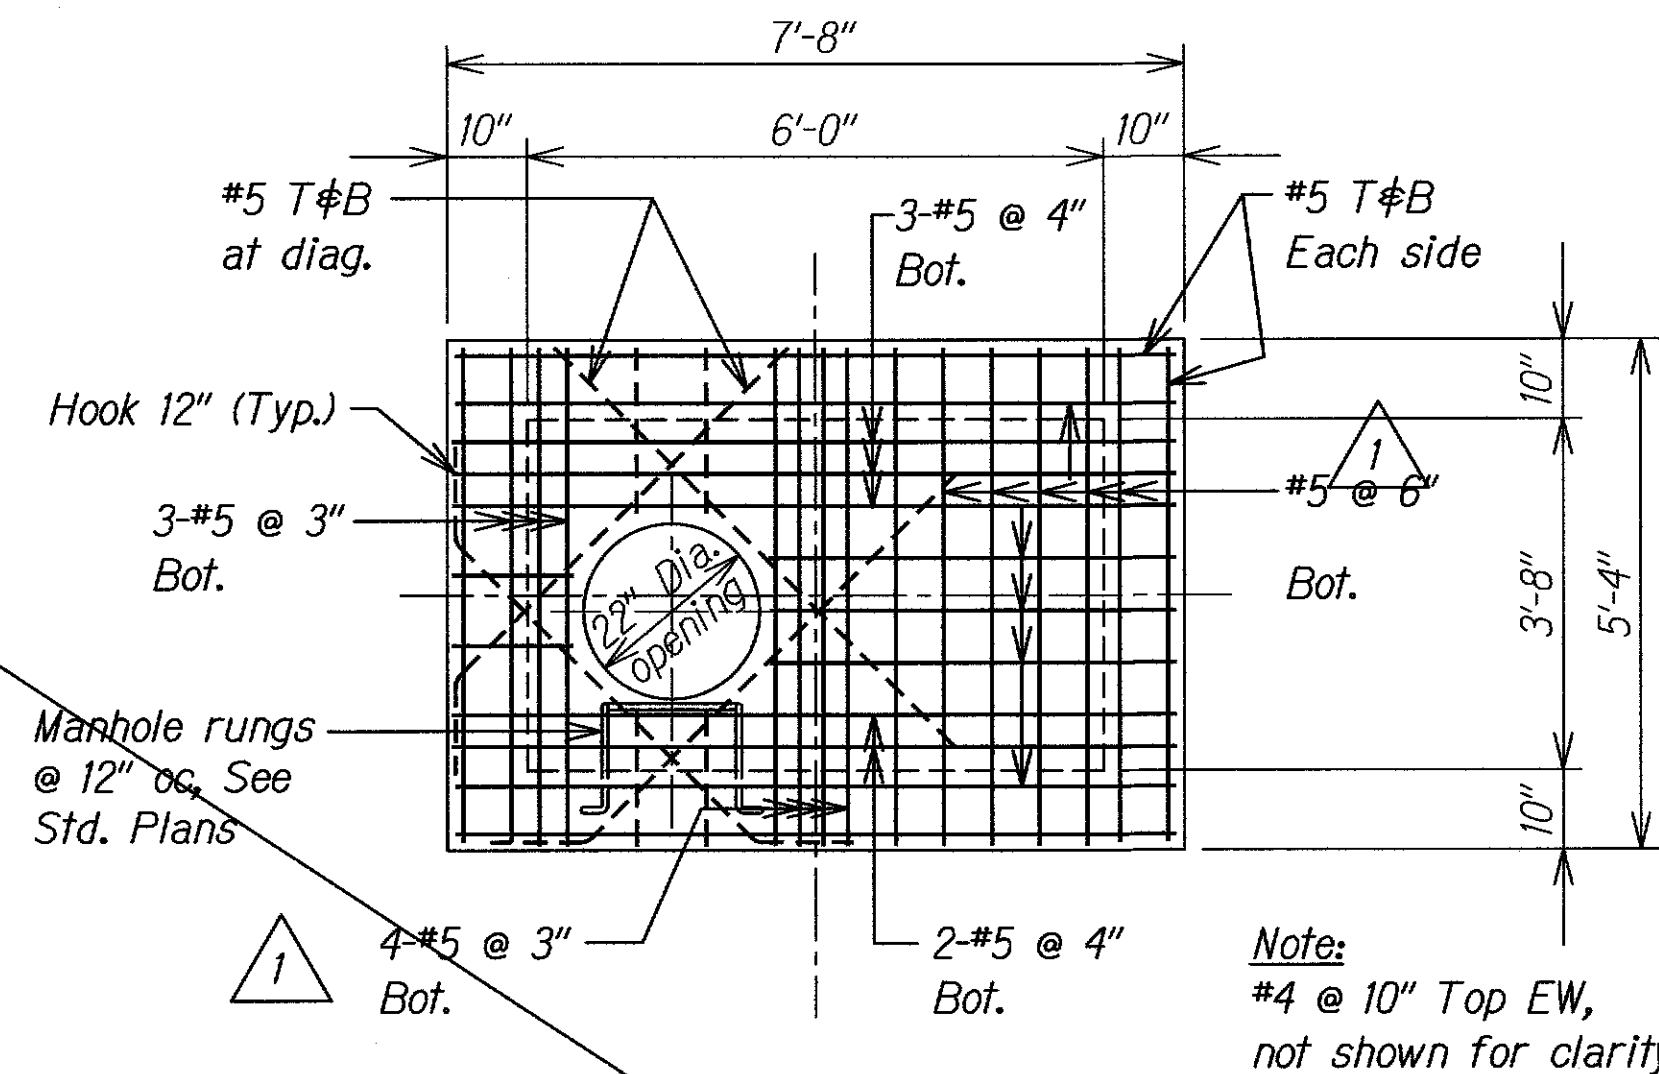

DMH 18 - TOP SLAB PLAN C
SCALE: 1/2" = 1'-0"

DATE	_____
SURVEY PLOTTED BY	_____
DRAWN BY	_____
TRACED BY	_____
DESIGNED BY	_____
QUANTITIES BY	_____
CHECKED BY	_____
ORIGINAL PLAN	_____
NOTE BOOK	_____
No.	_____

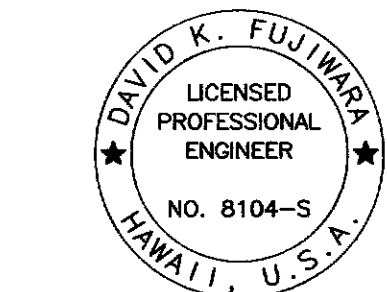


THIS WORK WAS PREPARED BY
ME OR UNDER MY SUPERVISION.
David K. Fujiwara
SIGNATURE EXPIRATION DATE OF THE LICENSE 4-30-08

6/21/06	Delete Sheet per SDOT
1/18/05	1 Clarification of Notes
DATE	REVISION

STATE OF HAWAII DEPARTMENT OF TRANSPORTATION HIGHWAYS DIVISION	
DRAIN CULVERT "C" - TOP SLAB PLAN AT DMH 18 AND SECTIONS	
North-South Road Phase 1A F.A.I. Proj. No. STP-8930(1)	
Scale: As Noted	Date: Dec. 22, 2004
SHEET No. S1.6 OF 43 SHEETS	


C.O.ADD. 77

FED. ROAD DIST. NO.	STATE	FED. AID PROJ. NO.	FISCAL YEAR	SHEET NO.	TOTAL SHEETS
HAWAII	HAW.	STP-8930(1)	2005	ADD. 78	144

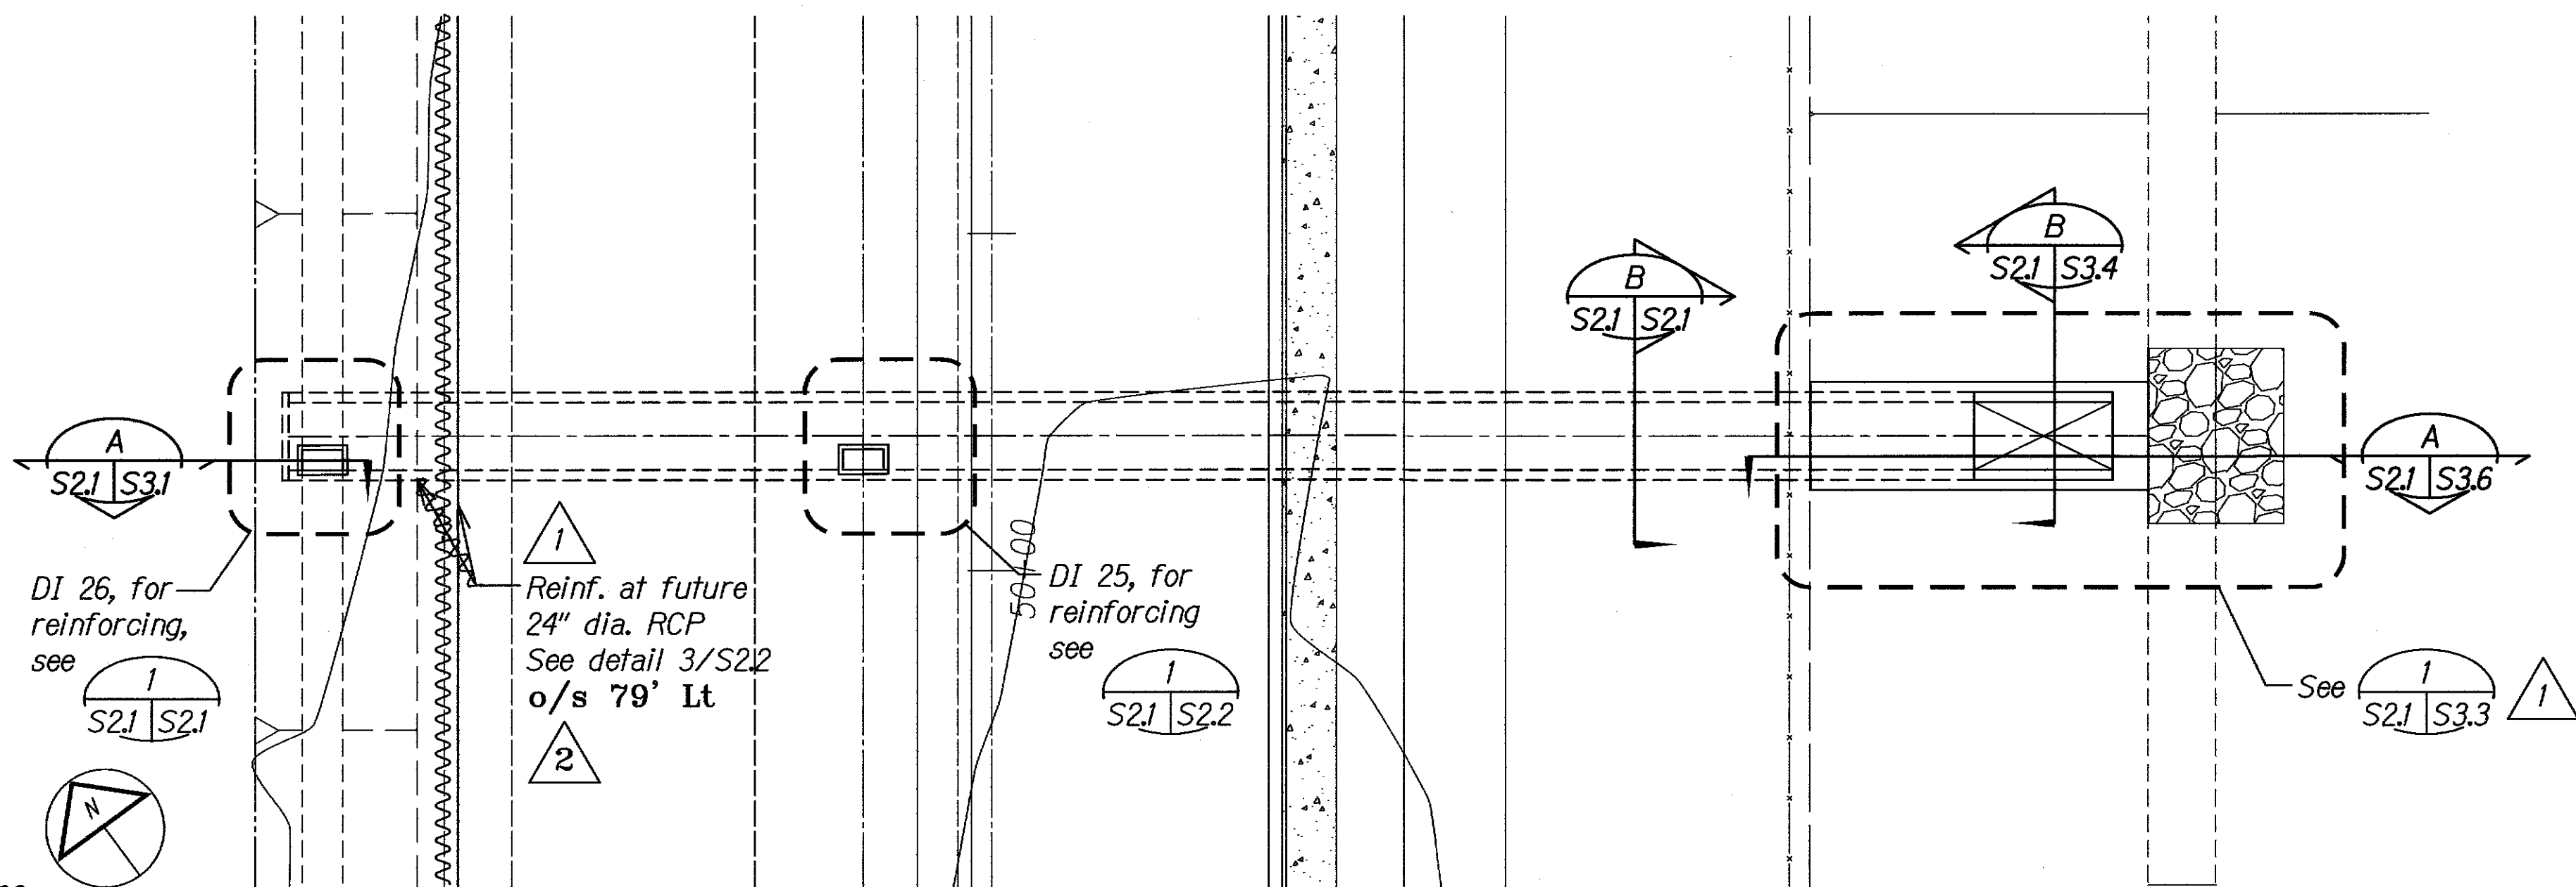


- Notes:
- Construction joints shall be spaced at a maximum of 60'-0" and control joints shall be spaced at a maximum of 20'-0".
 - Refer to sheet S3.1 for construction and control joint details.
 - Refer to civil drawings for Culvert, DI, and Outlet profile dimensions and elevations.

DRain Culvert "D" - LAYOUT PLAN
SCALE: 1" = 20'

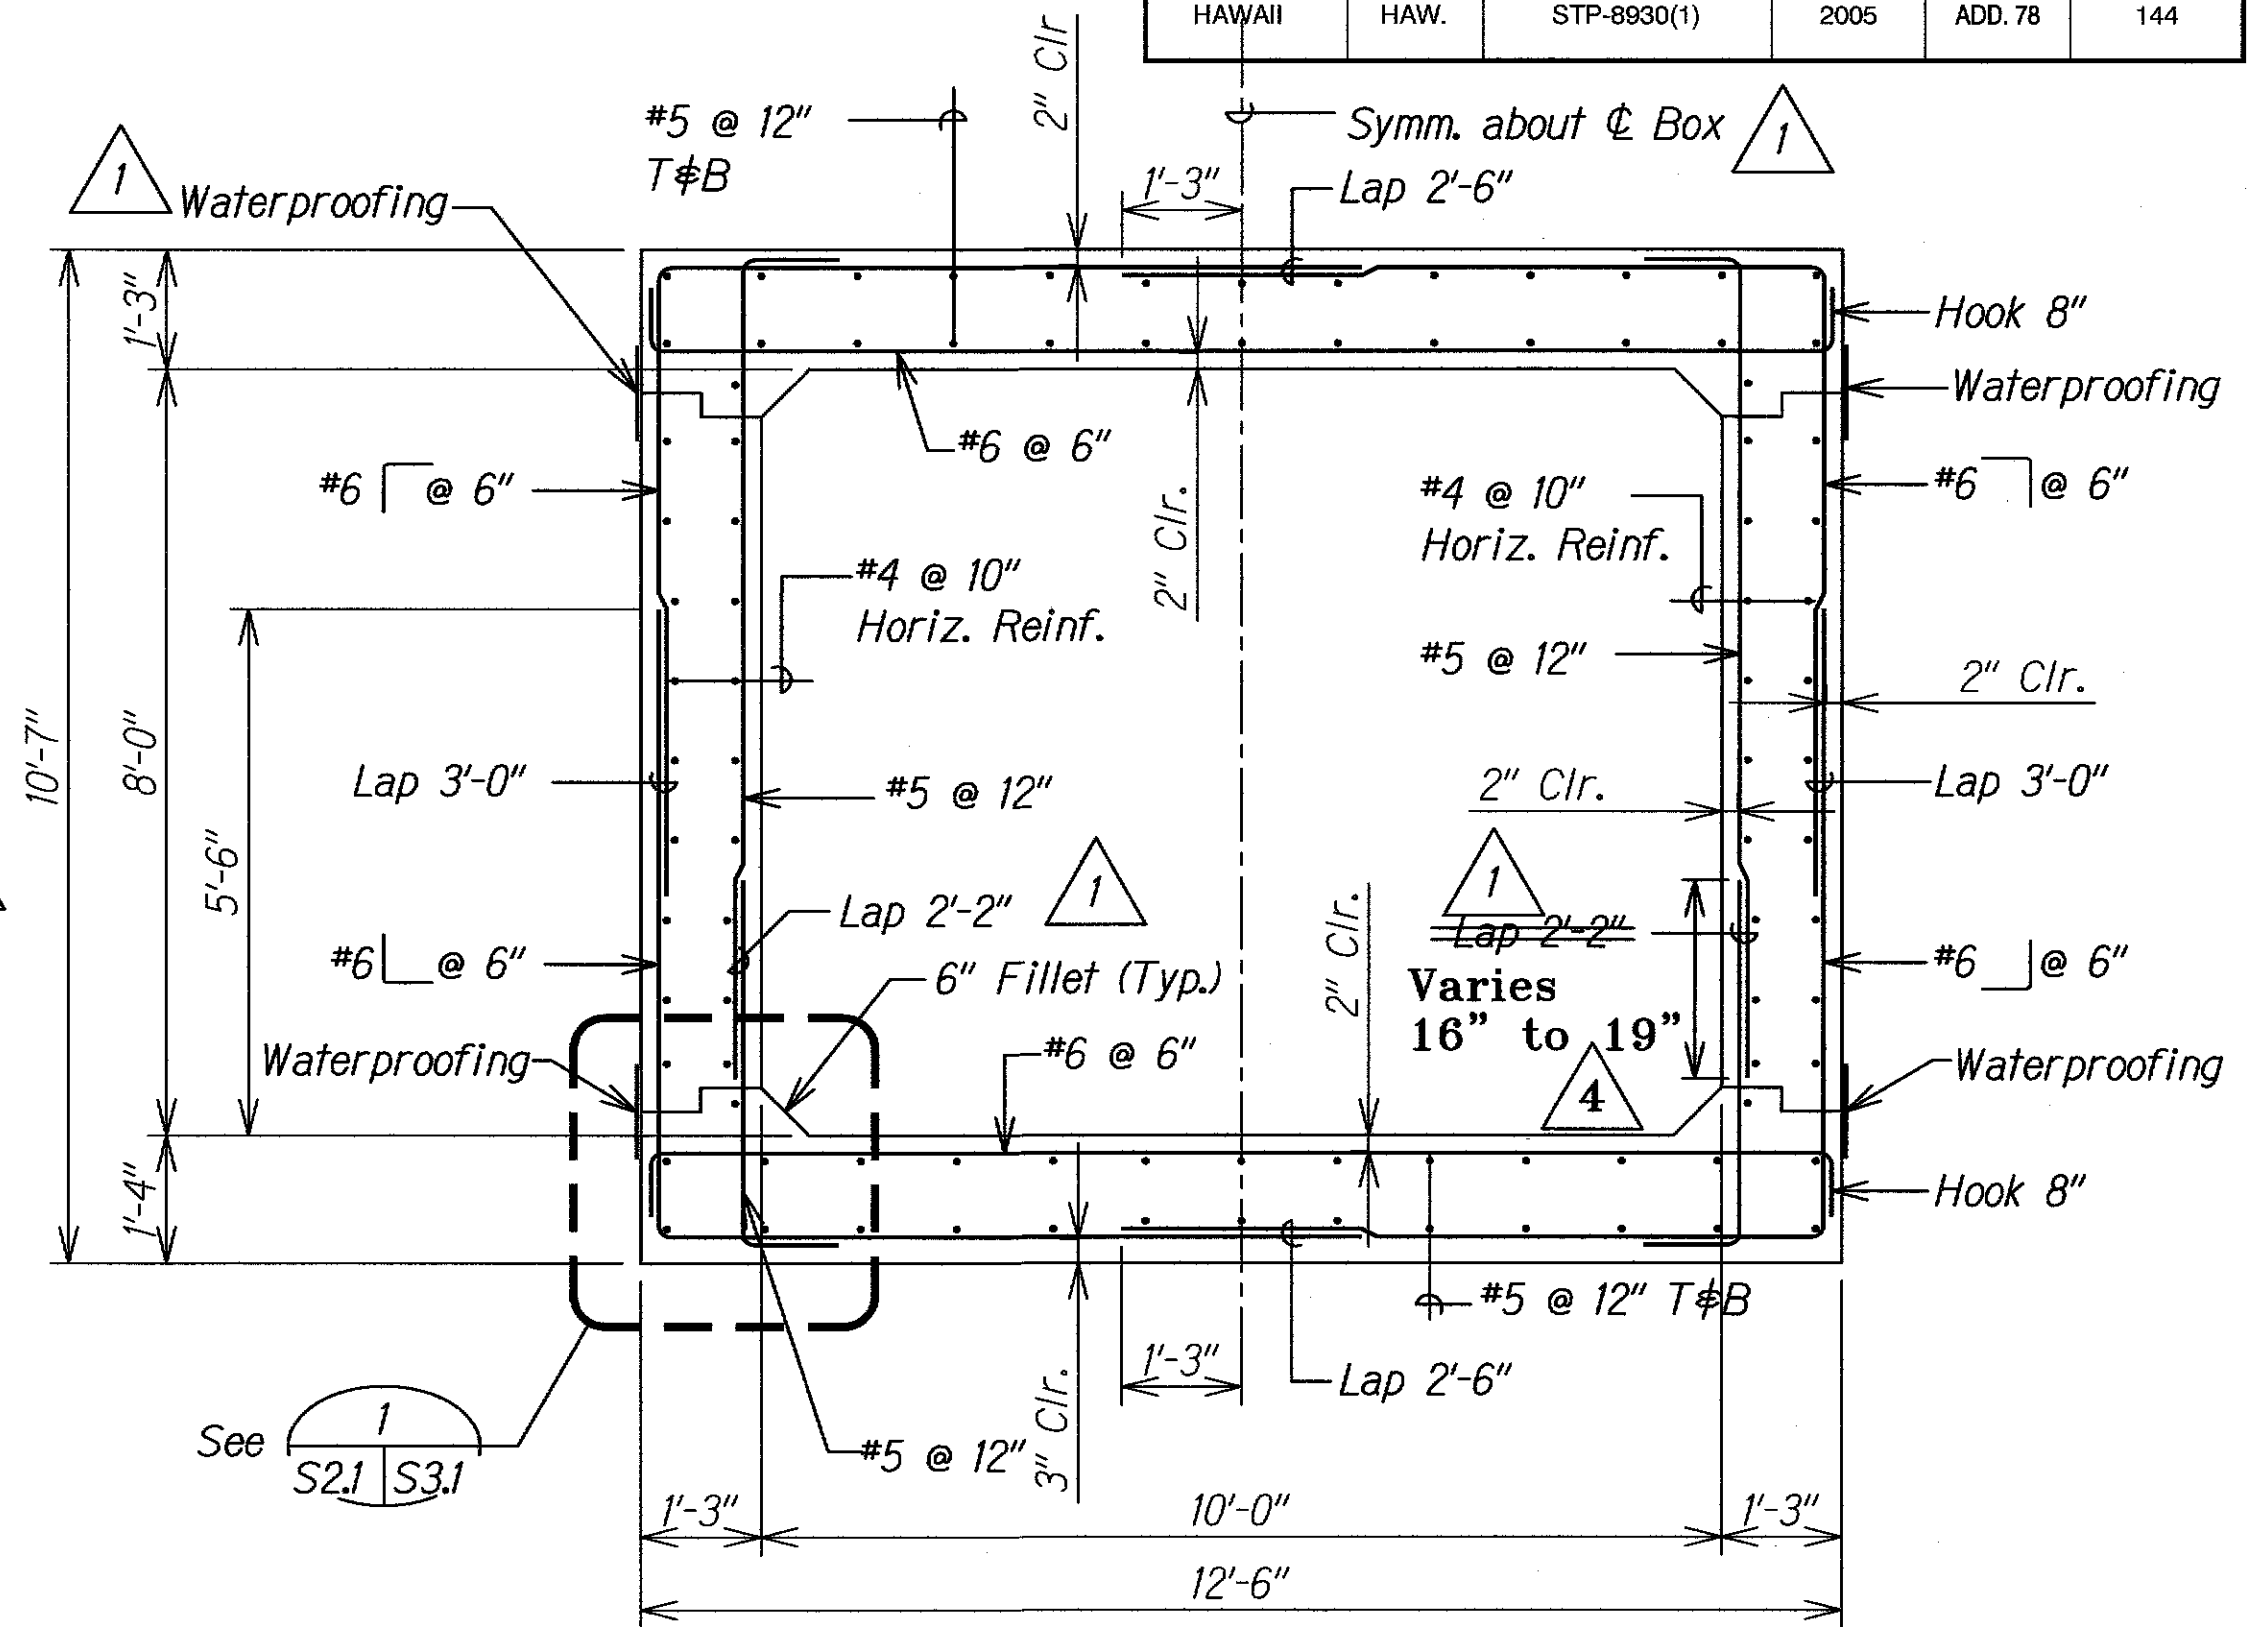


DRain Culvert "D" - TYPICAL SECTION
SCALE: 1/2" = 1'-0"

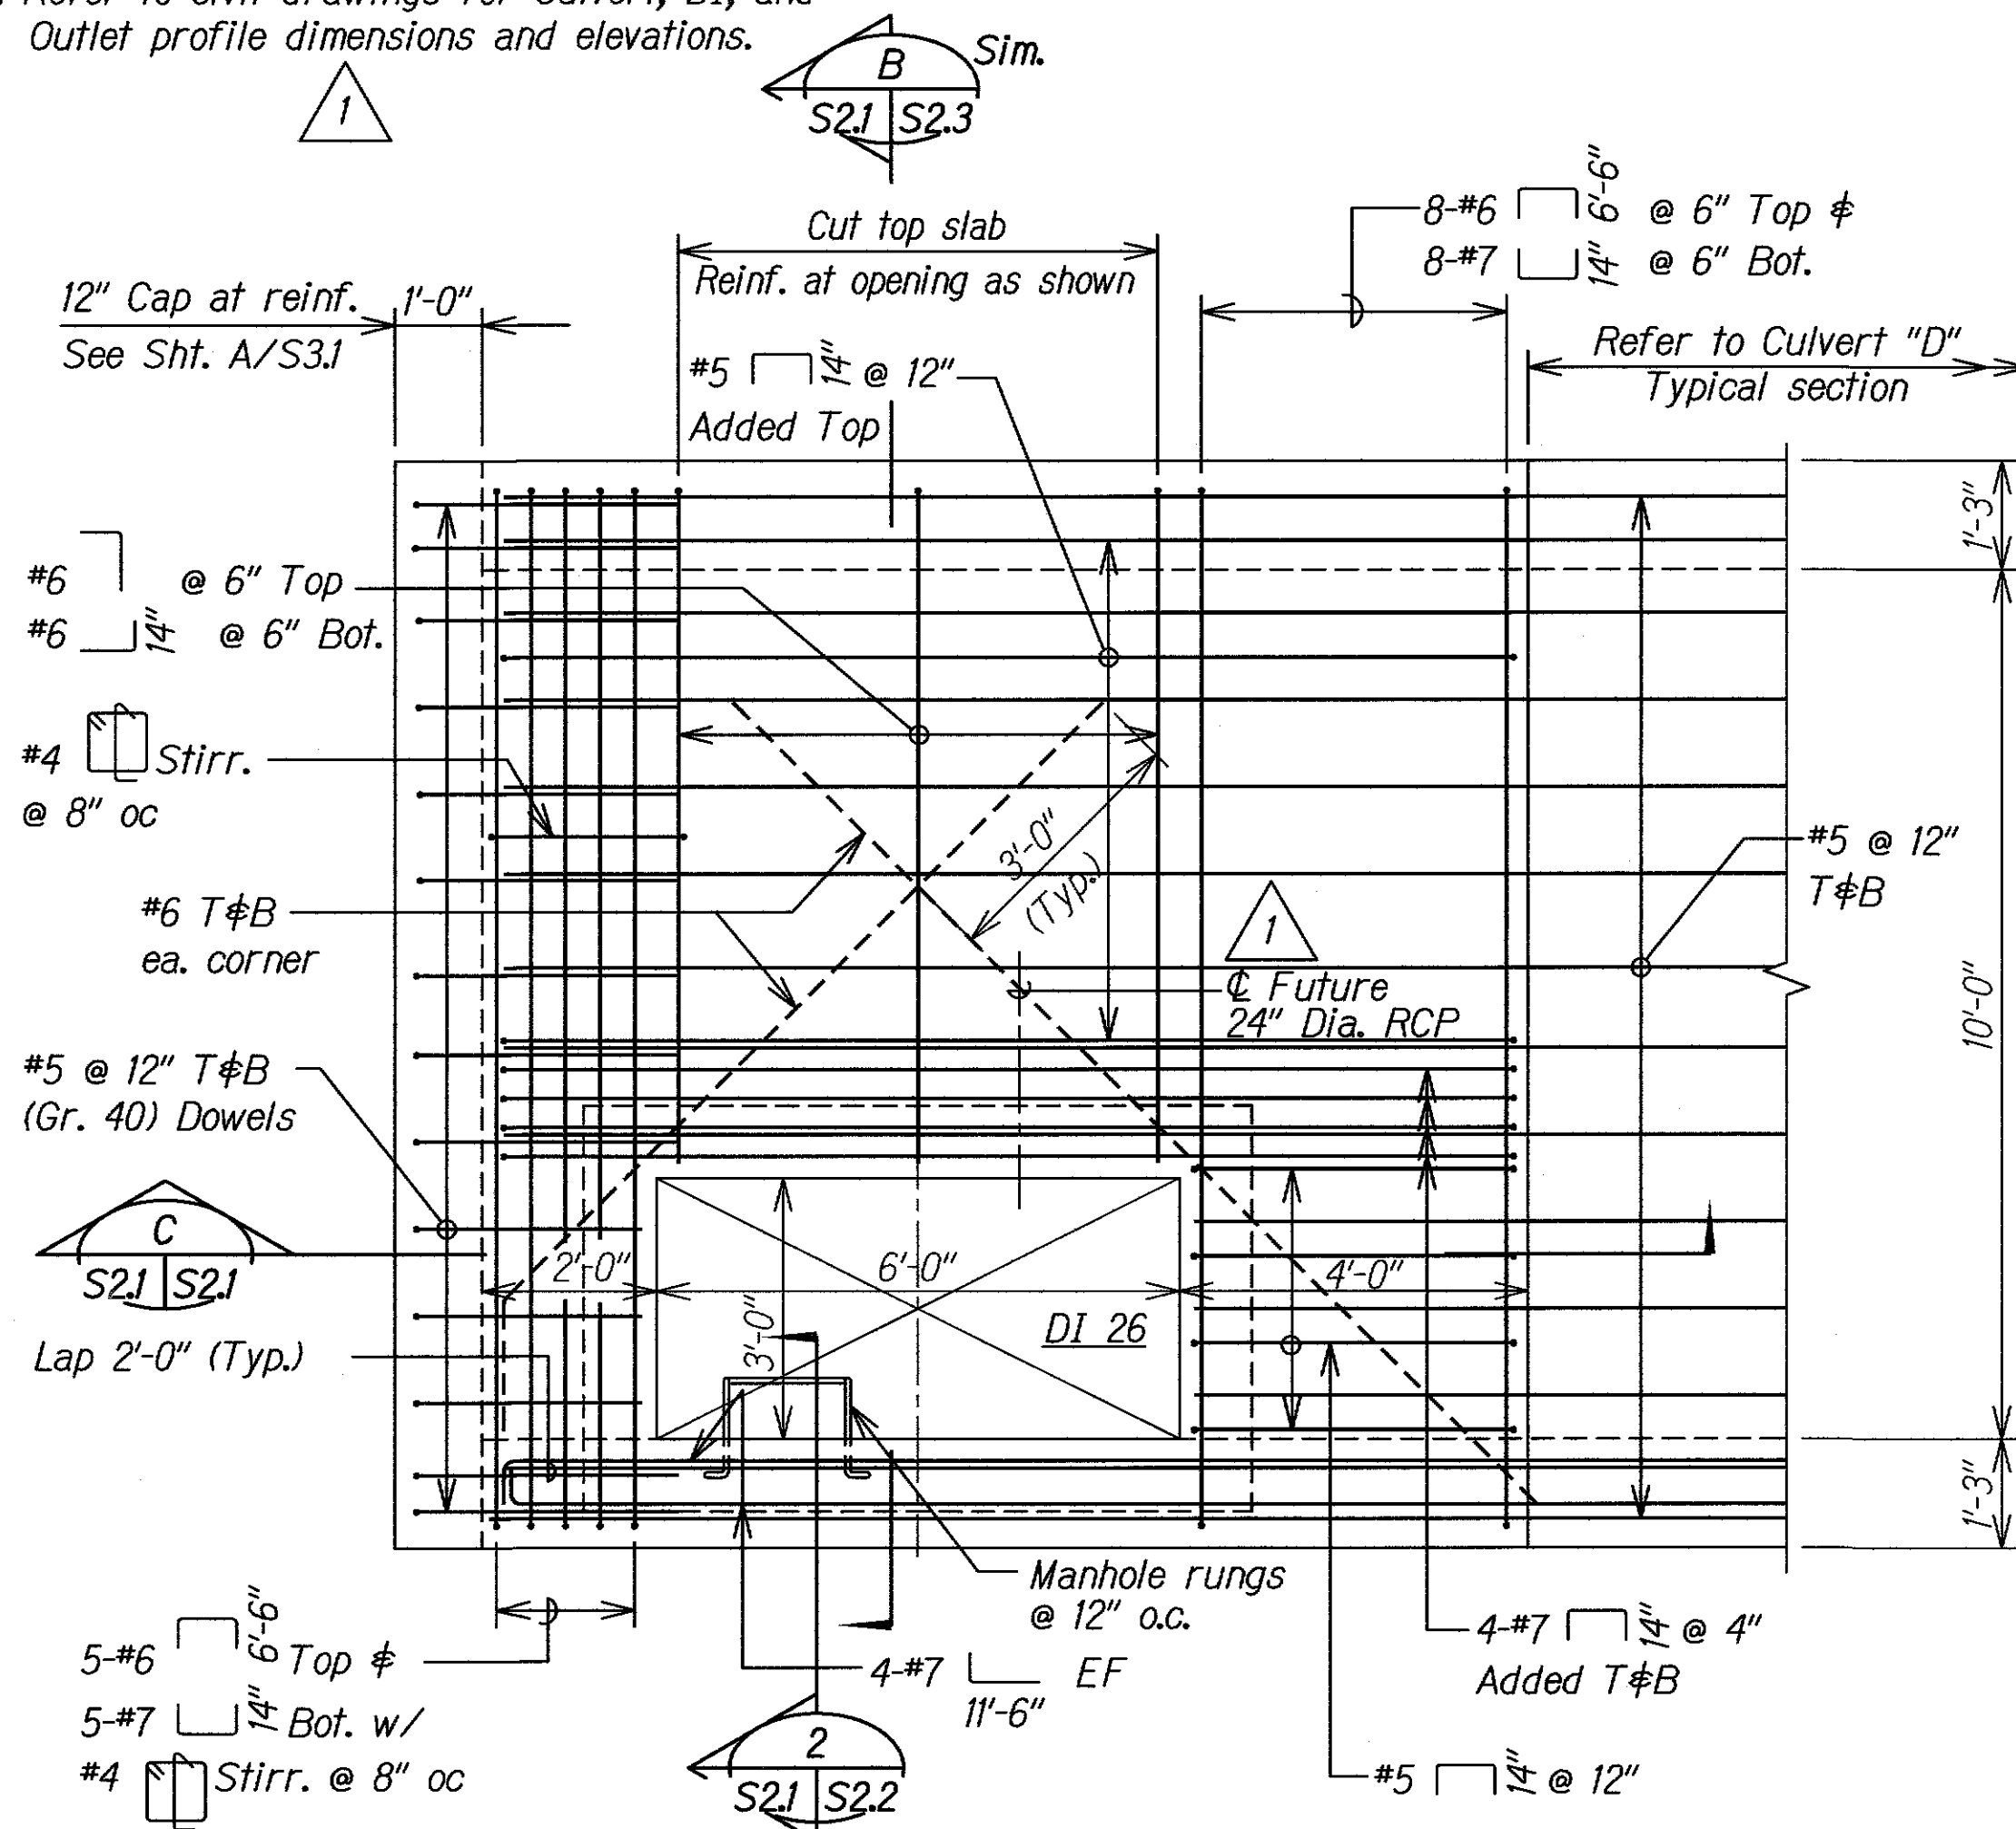

DRain Culvert "D" - TOP SLAB PLAN AT DI 26
SCALE: 1/2" = 1'-0"


- Note:
- Refer to Section A/SI.2 For Top Portion of DI 26.

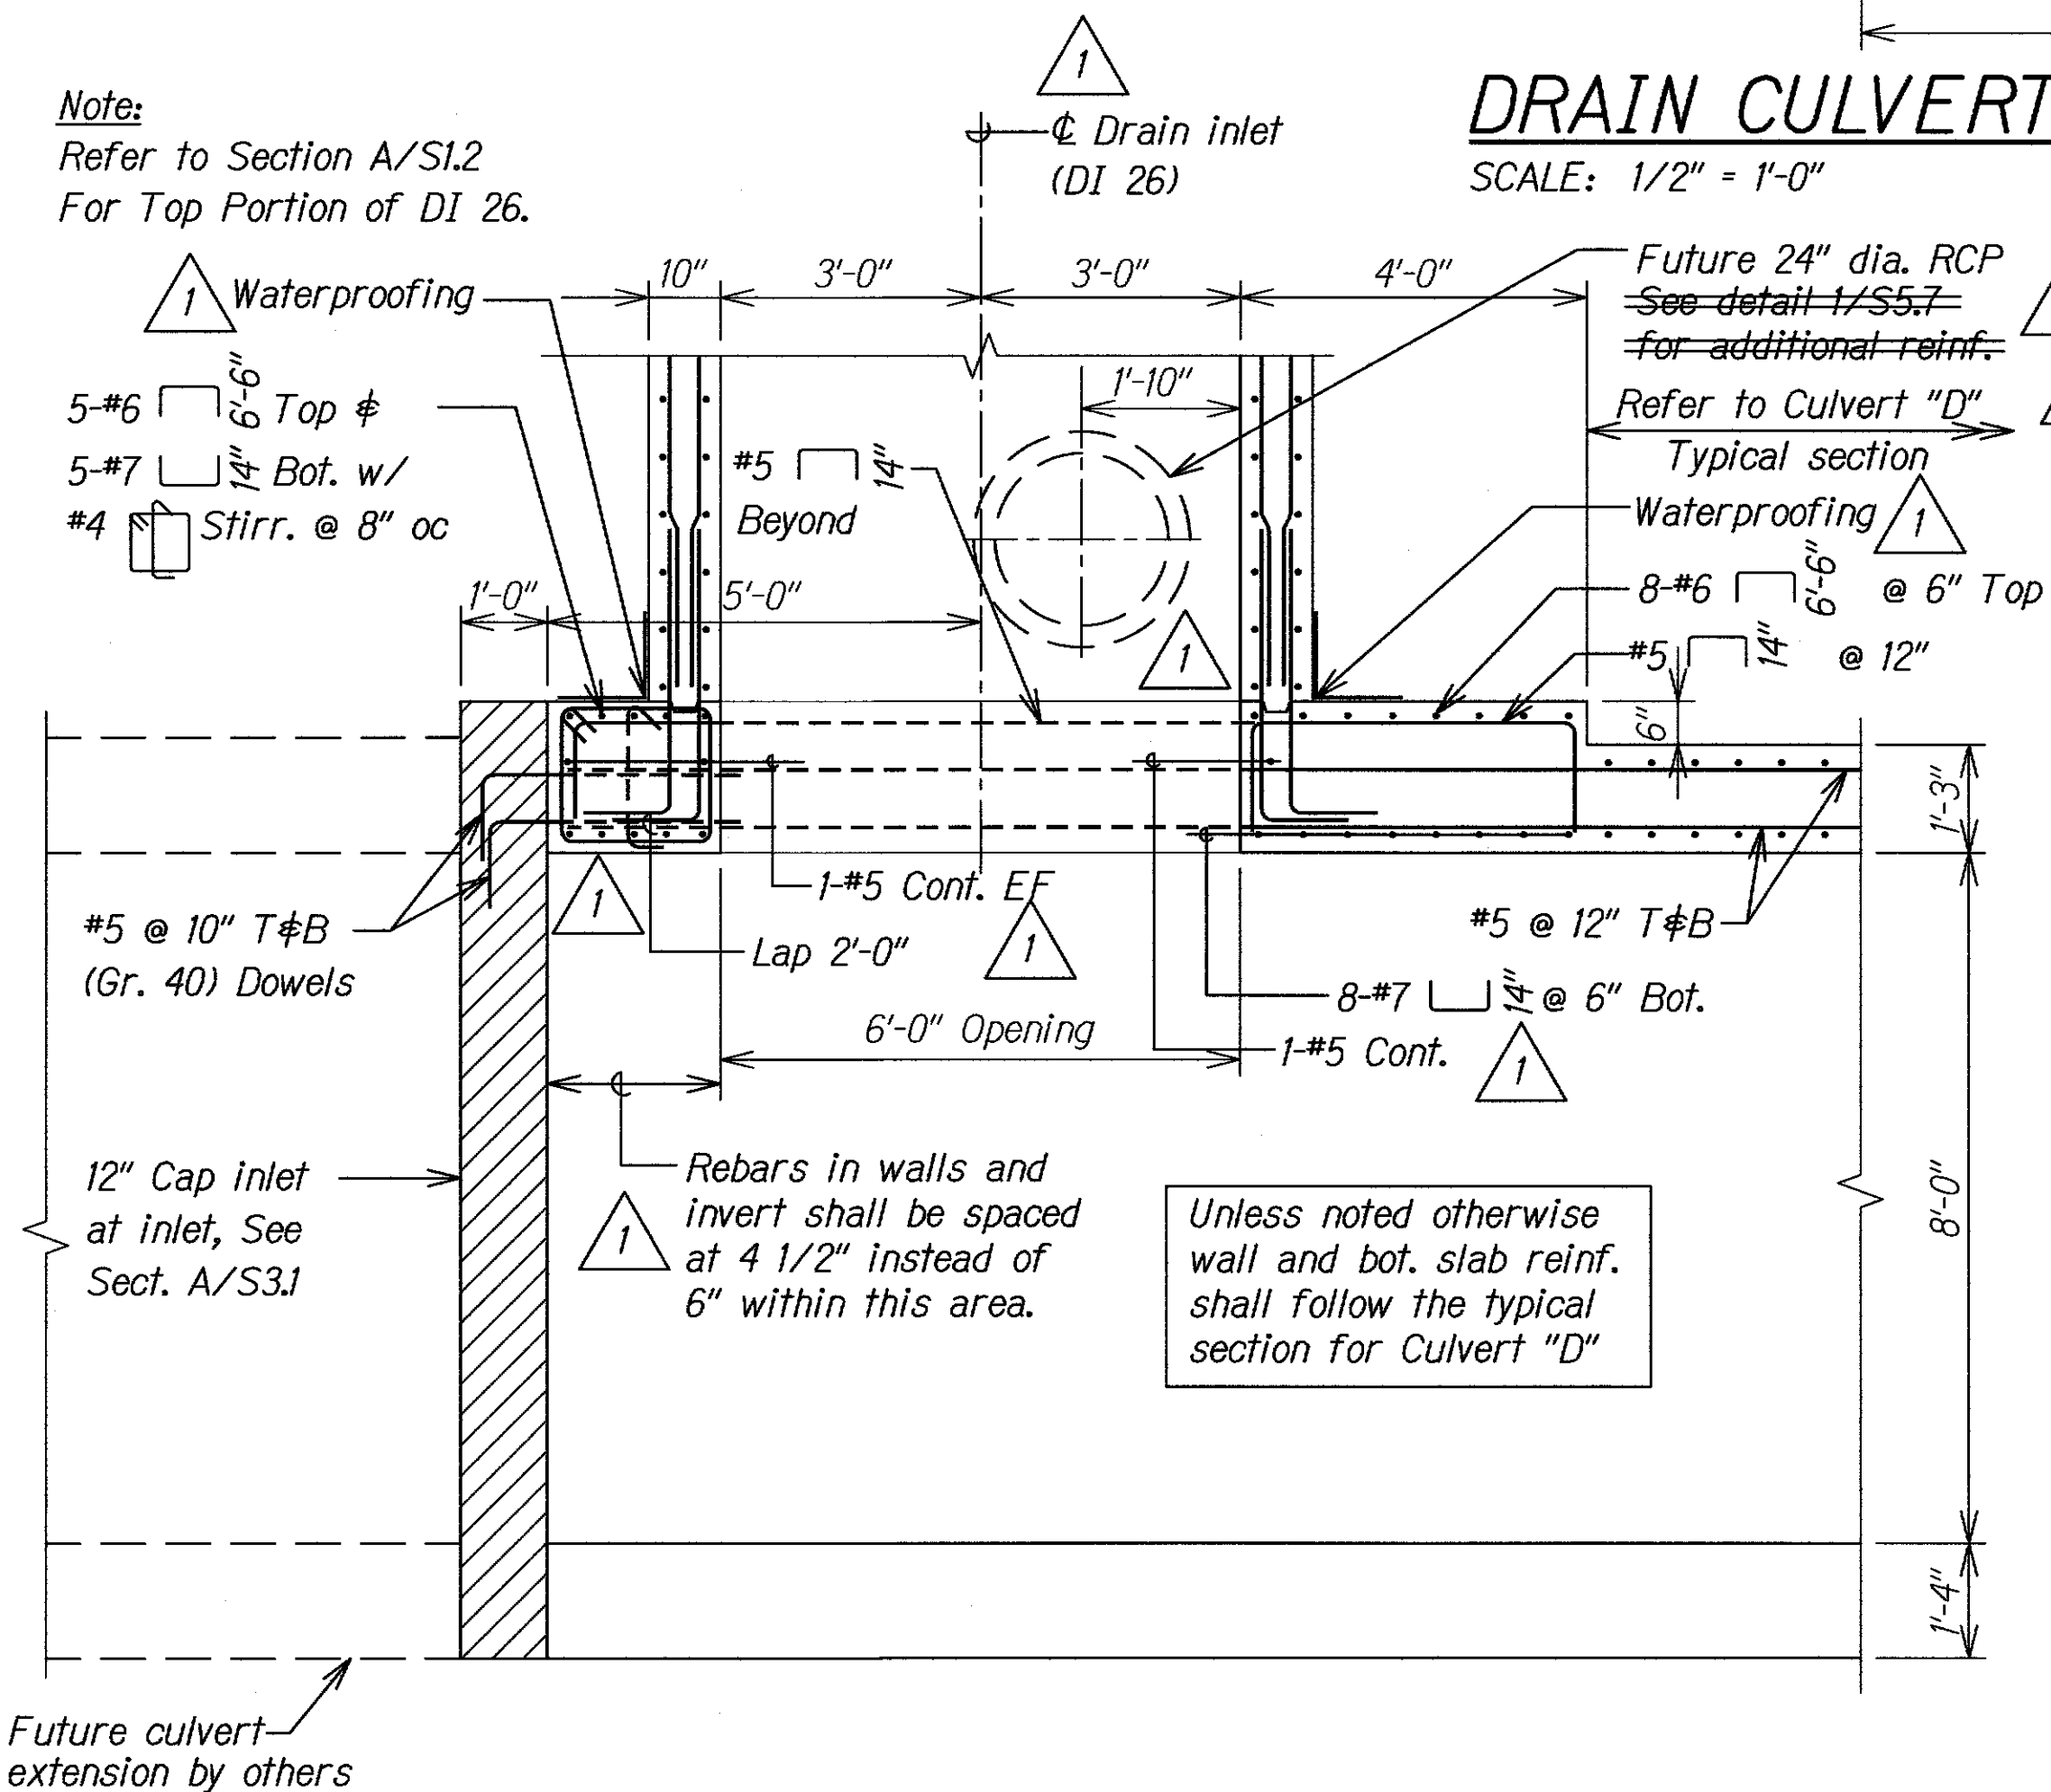

DRain Culvert "D" - SECTION
SCALE: 1/2" = 1'-0"

Additional Reinf.
Deleted Due to
Conflict

LEGEND FOR AS-BUILT POSTINGS	
	Squiggly line for as-built deletion
	Double line for as-built deletion
	Text for as-built posting

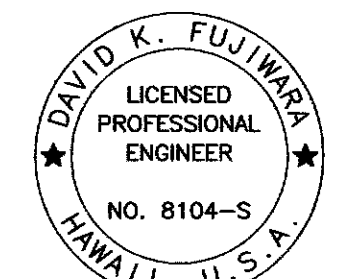

THIS WORK WAS PREPARED BY ME OR UNDER MY SUPERVISION.

Signature: David K. Fujiwara
EXPIRATION DATE OF THE LICENSE: 4-30-08

DATE	REVISION
1/18/05	1 Clarification of Notes
	2 As Built - RFI 37
	3 As Built - RFI 47
	4 As Built - RFI 41

STATE OF HAWAII DEPARTMENT OF TRANSPORTATION HIGHWAYS DIVISION	
DRain Culvert "D" - LAYOUT PLAN, TOP SLAB PLAN AT DI 26, SECTION AND DETAIL	
North-South Road Phase 1A F.A.I. Proj. No. STP-8930(1)	
Scale: As Noted	Date: Dec. 22, 2004
SHEET No. S2.1 OF 43 SHEETS	


"AS-BUILT"

ADD. 78

[illegible]


C.O.ADD. 79

FED. ROAD DIST. NO.	STATE	FED. AID PROJ. NO.	FISCAL YEAR	SHEET NO.	TOTAL SHEETS
HAWAII	HAW.	STP-8930(1)	2005	C.O. ADD. 81	144

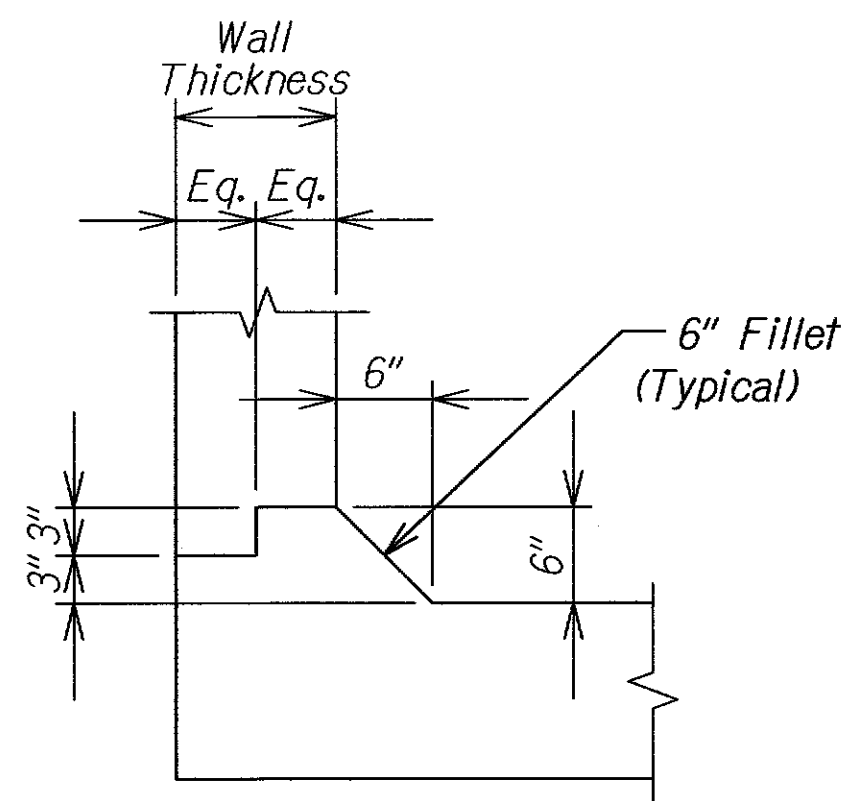


TYP. FILLET - KEY DETAIL

SCALE: 1" = 1'-0"

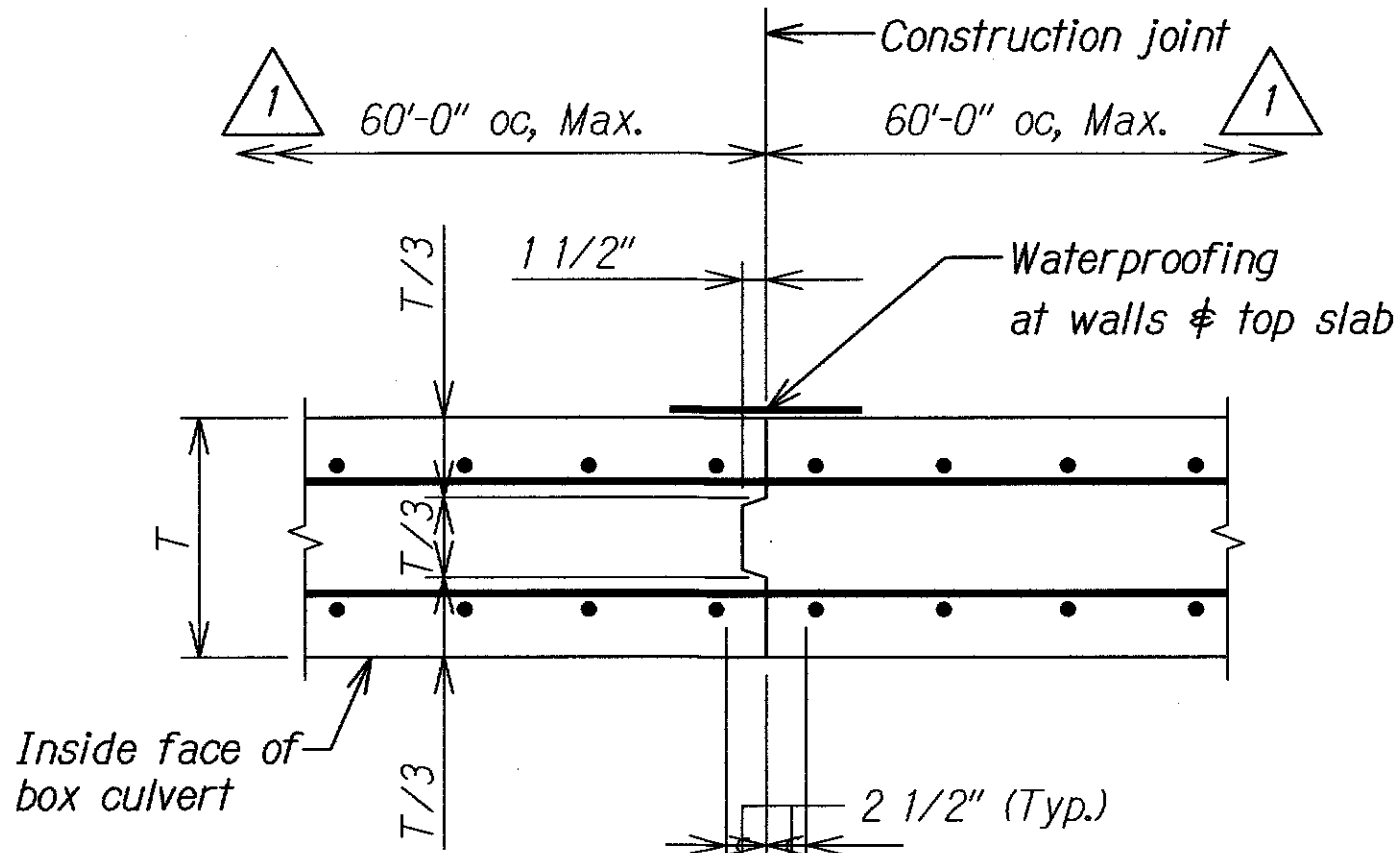


CONSTRUCTION JOINT DETAIL

SCALE: 1" = 1'-0"

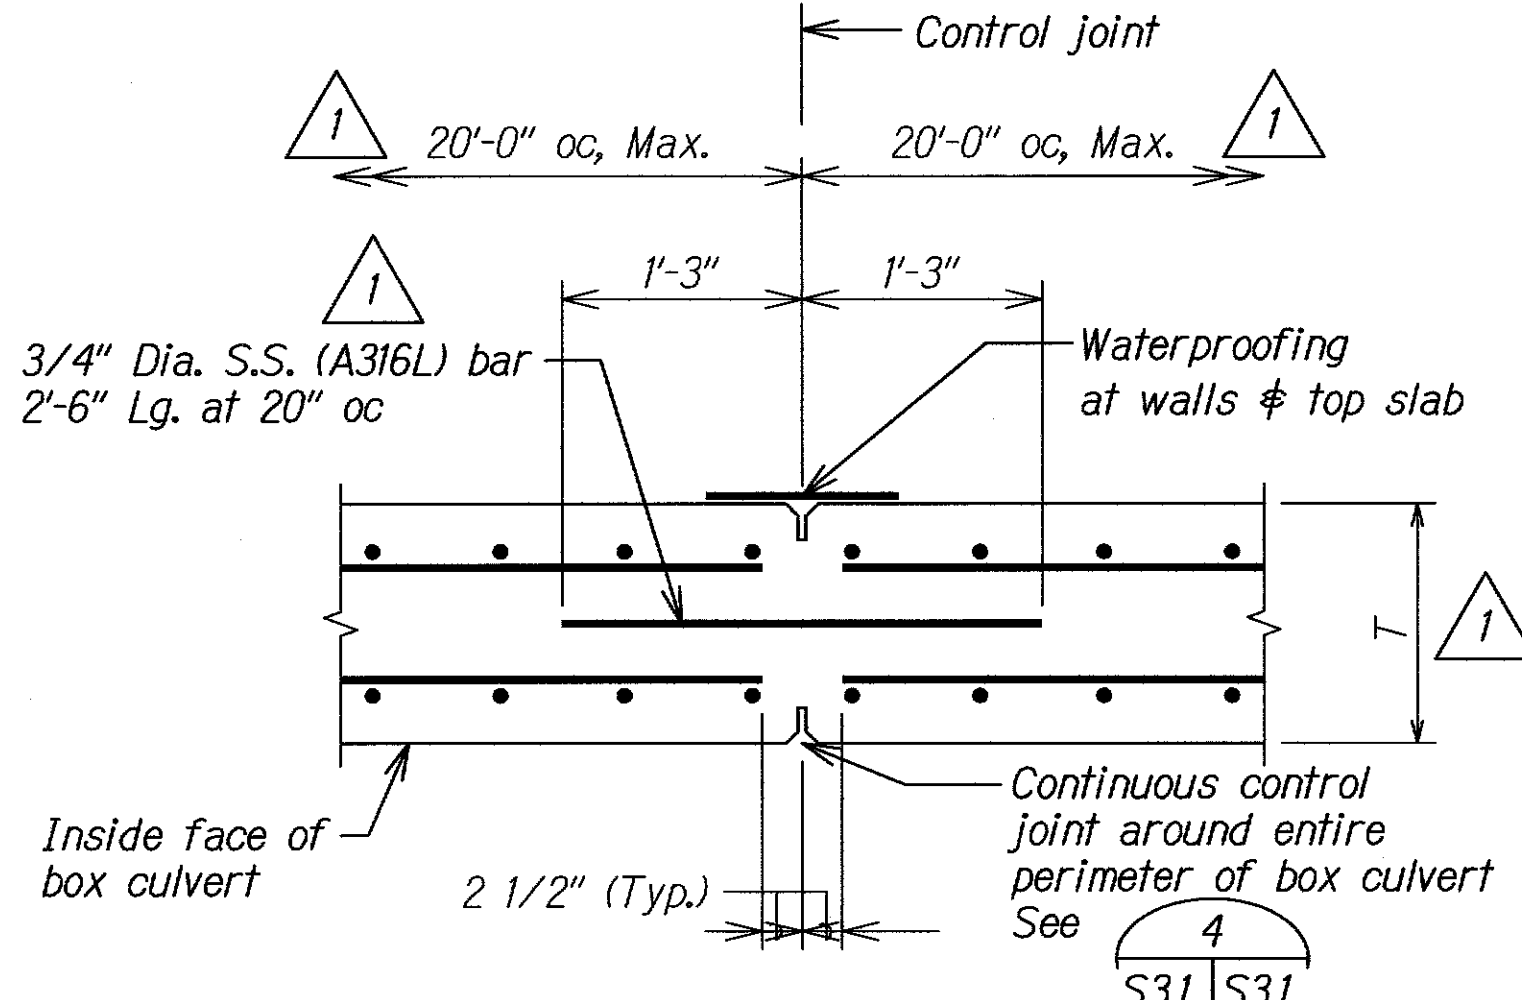


ALTERNATE CONTROL JOINT DETAIL

SCALE: 1" = 1'-0"

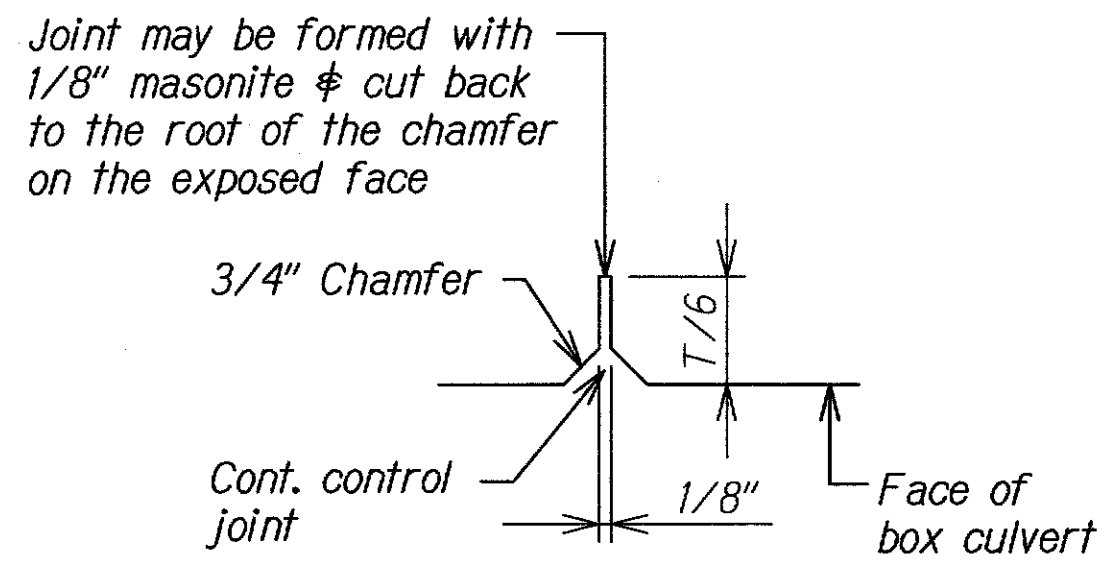


CONTROL JOINT DETAIL

SCALE: 3" = 1'-0"

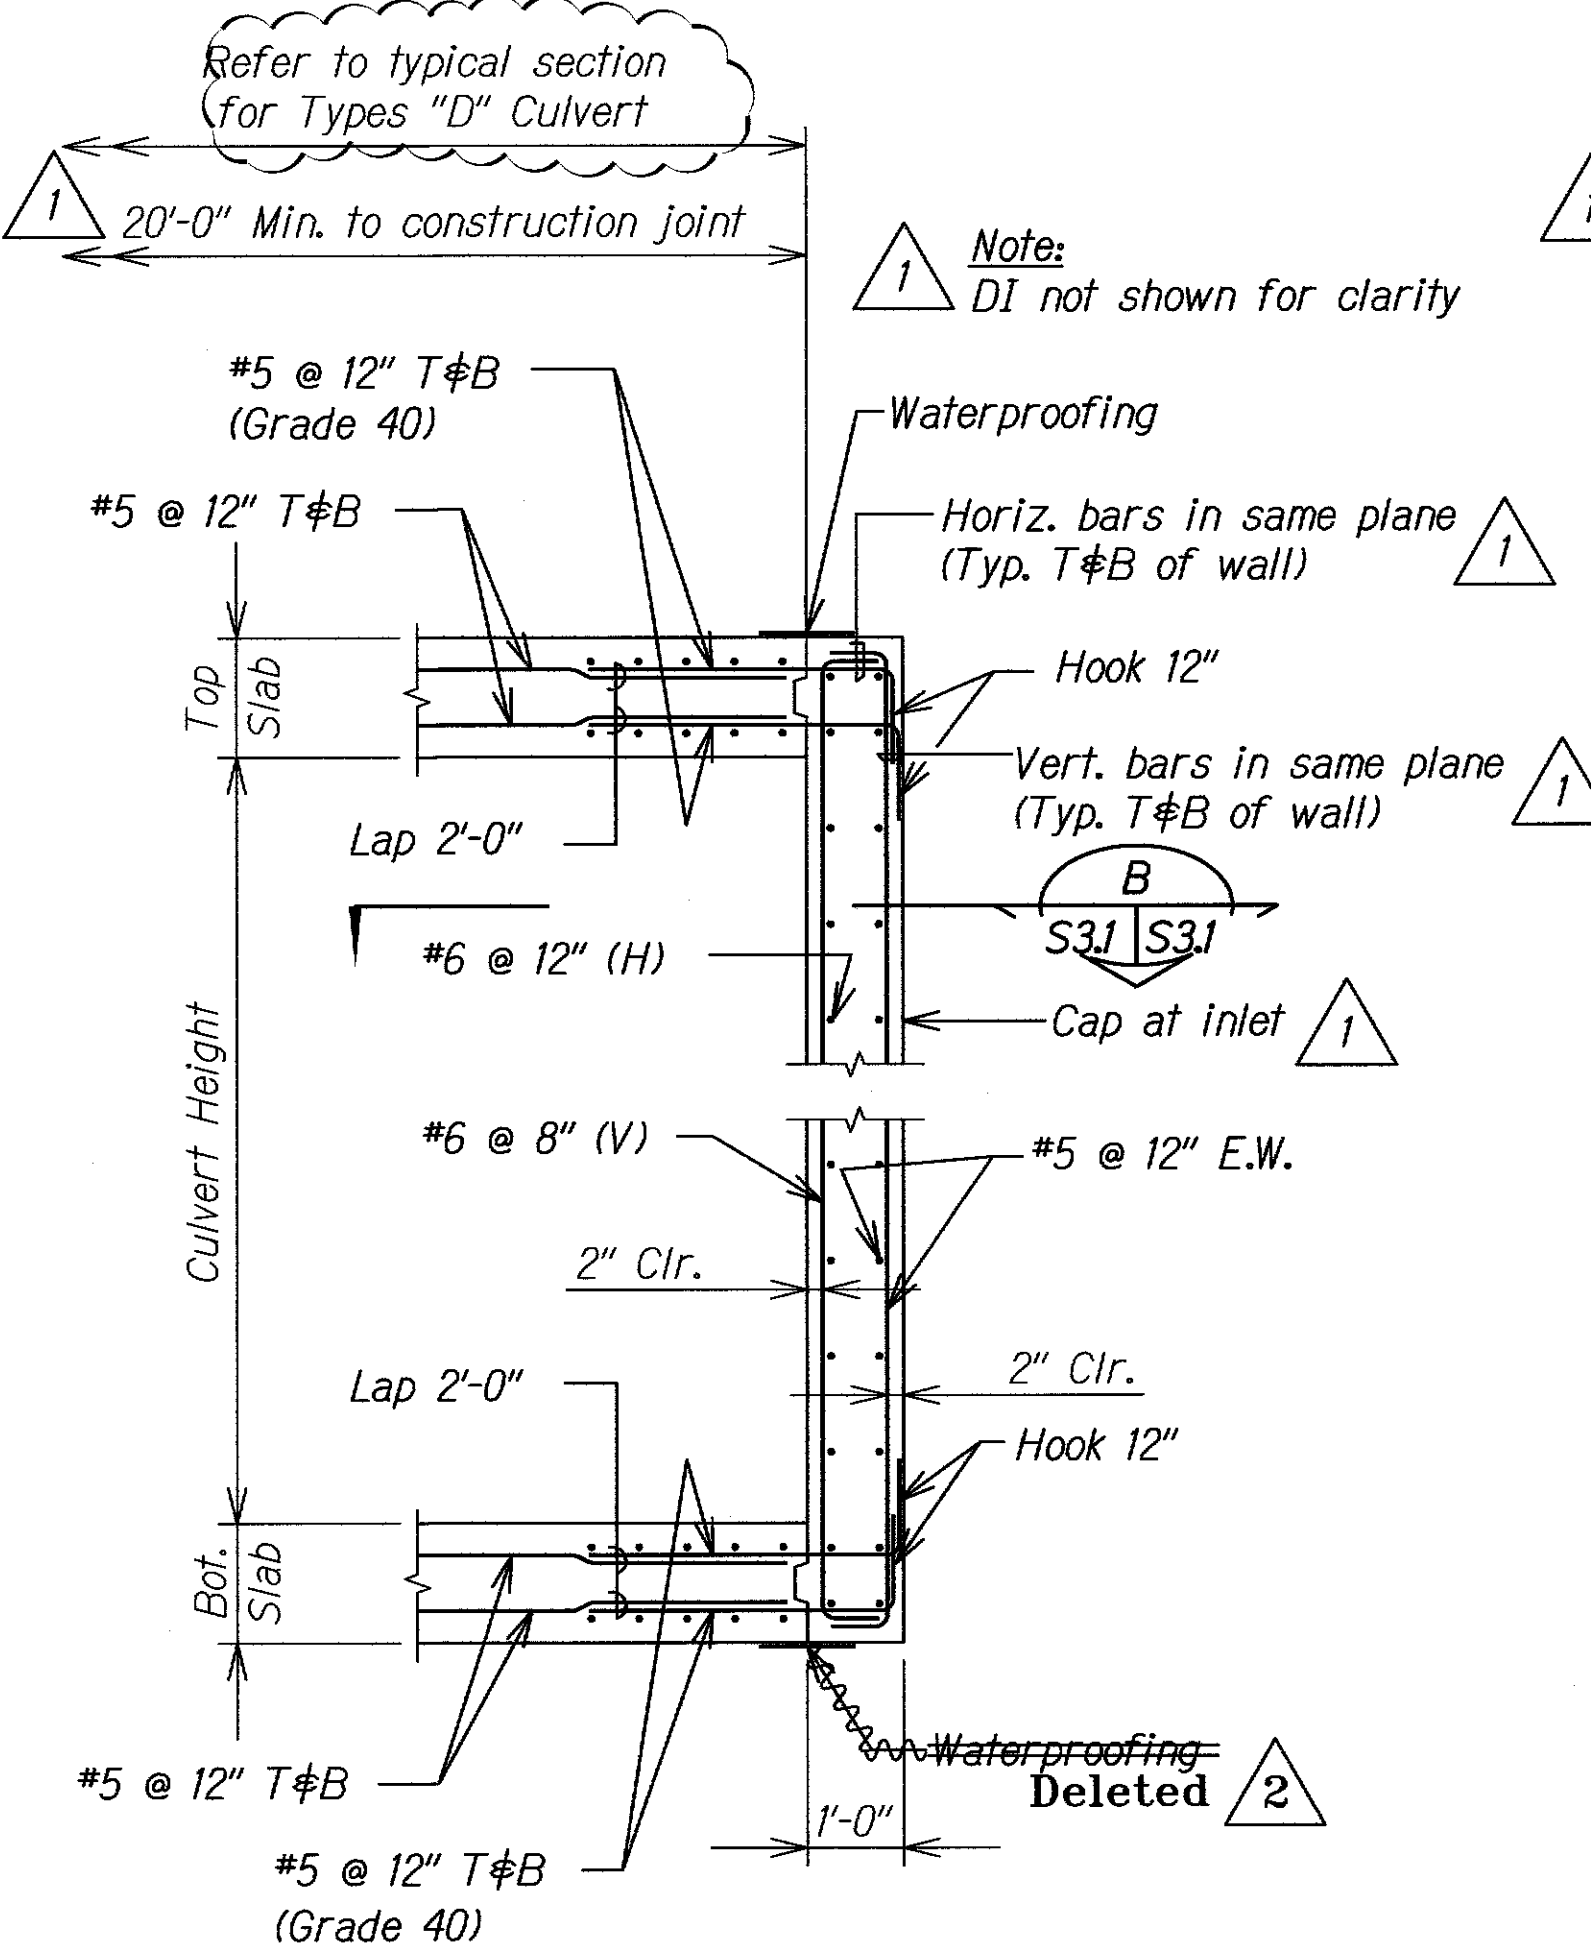


SECTION A

SCALE: 1/2" = 1'-0"

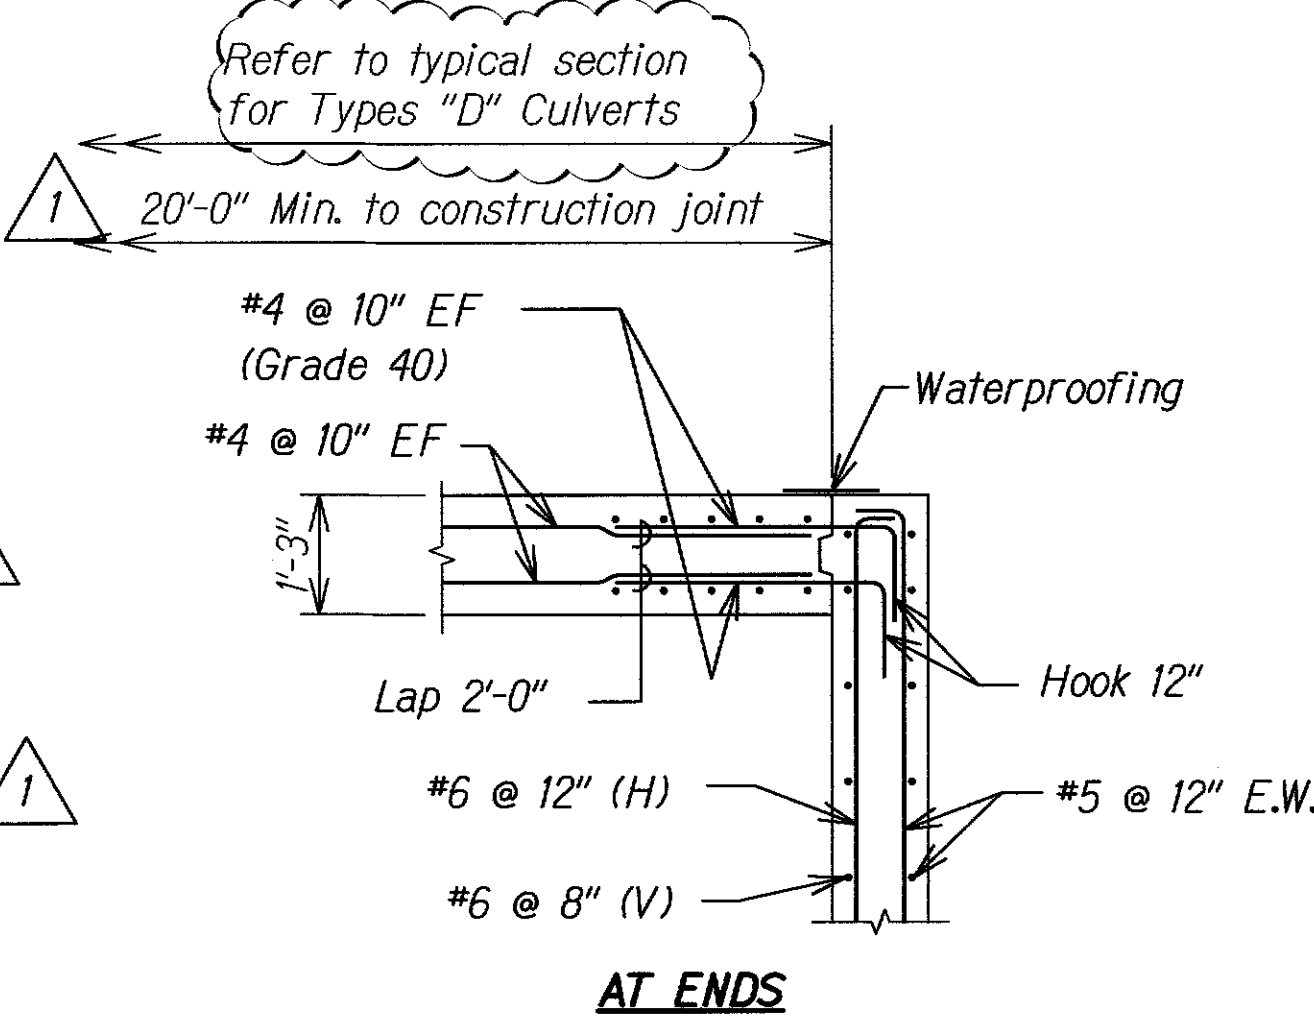

SECTION B


SCALE: 1/2" = 1'-0"

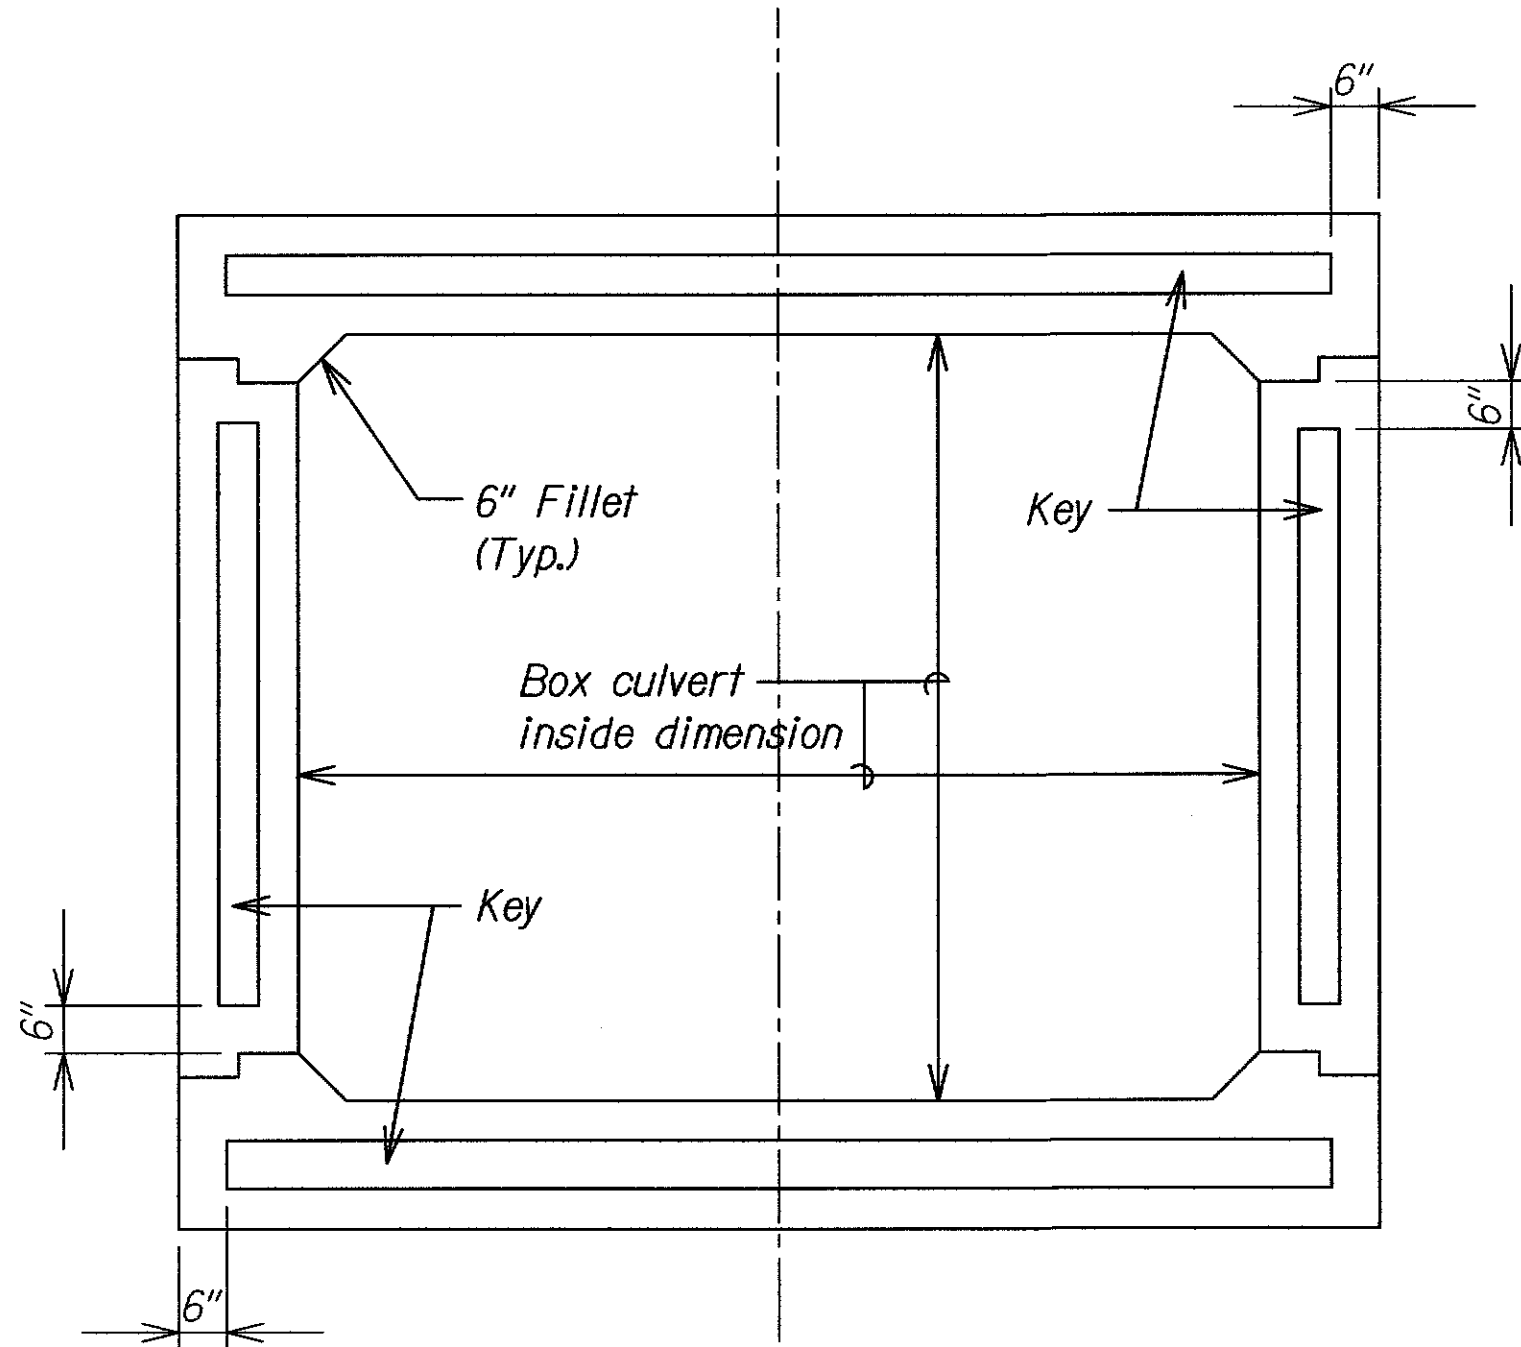

CONSTRUCTION JOINT KEY SCHEMATIC

SCALE: 1/2" = 1'-0"

LEGEND FOR AS-BUILT POSTINGS	
	Squiggly line for as-built deletion
	Double line for as-built deletion
	Text for as-built posting

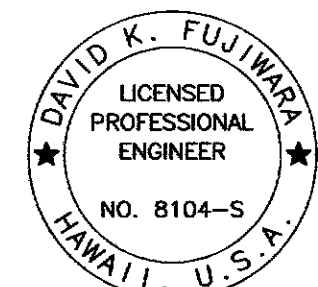

THIS WORK WAS PREPARED BY ME OR UNDER MY SUPERVISION.

SIGNATURE: David K. Fujiwara
EXPIRATION DATE OF THE LICENSE: 4-30-08


DATE	REVISION
6/21/06	2 As Built - RFI 12C Remove & Revise Detail per SDOT
1/18/05	1 Clarification of Notes

STATE OF HAWAII DEPARTMENT OF TRANSPORTATION HIGHWAYS DIVISION	
DRAIN CULVERT TYPICAL DETAILS AND SECTIONS	
North-South Road Phase 1A F.A.I. Proj. No. STP-8930(1)	
Scale: As Noted	Date: Dec. 22, 2004
SHEET No. S3.1 OF 43 SHEETS	

AS-BUILT



C.O. ADD. 81

FED. ROAD DIST. NO.	STATE	FED. AID PROJ. NO.	FISCAL YEAR	SHEET NO.	TOTAL SHEETS
HAWAII	HAW.	STP-8930(1)	2005	C.O.ADD. 82	144

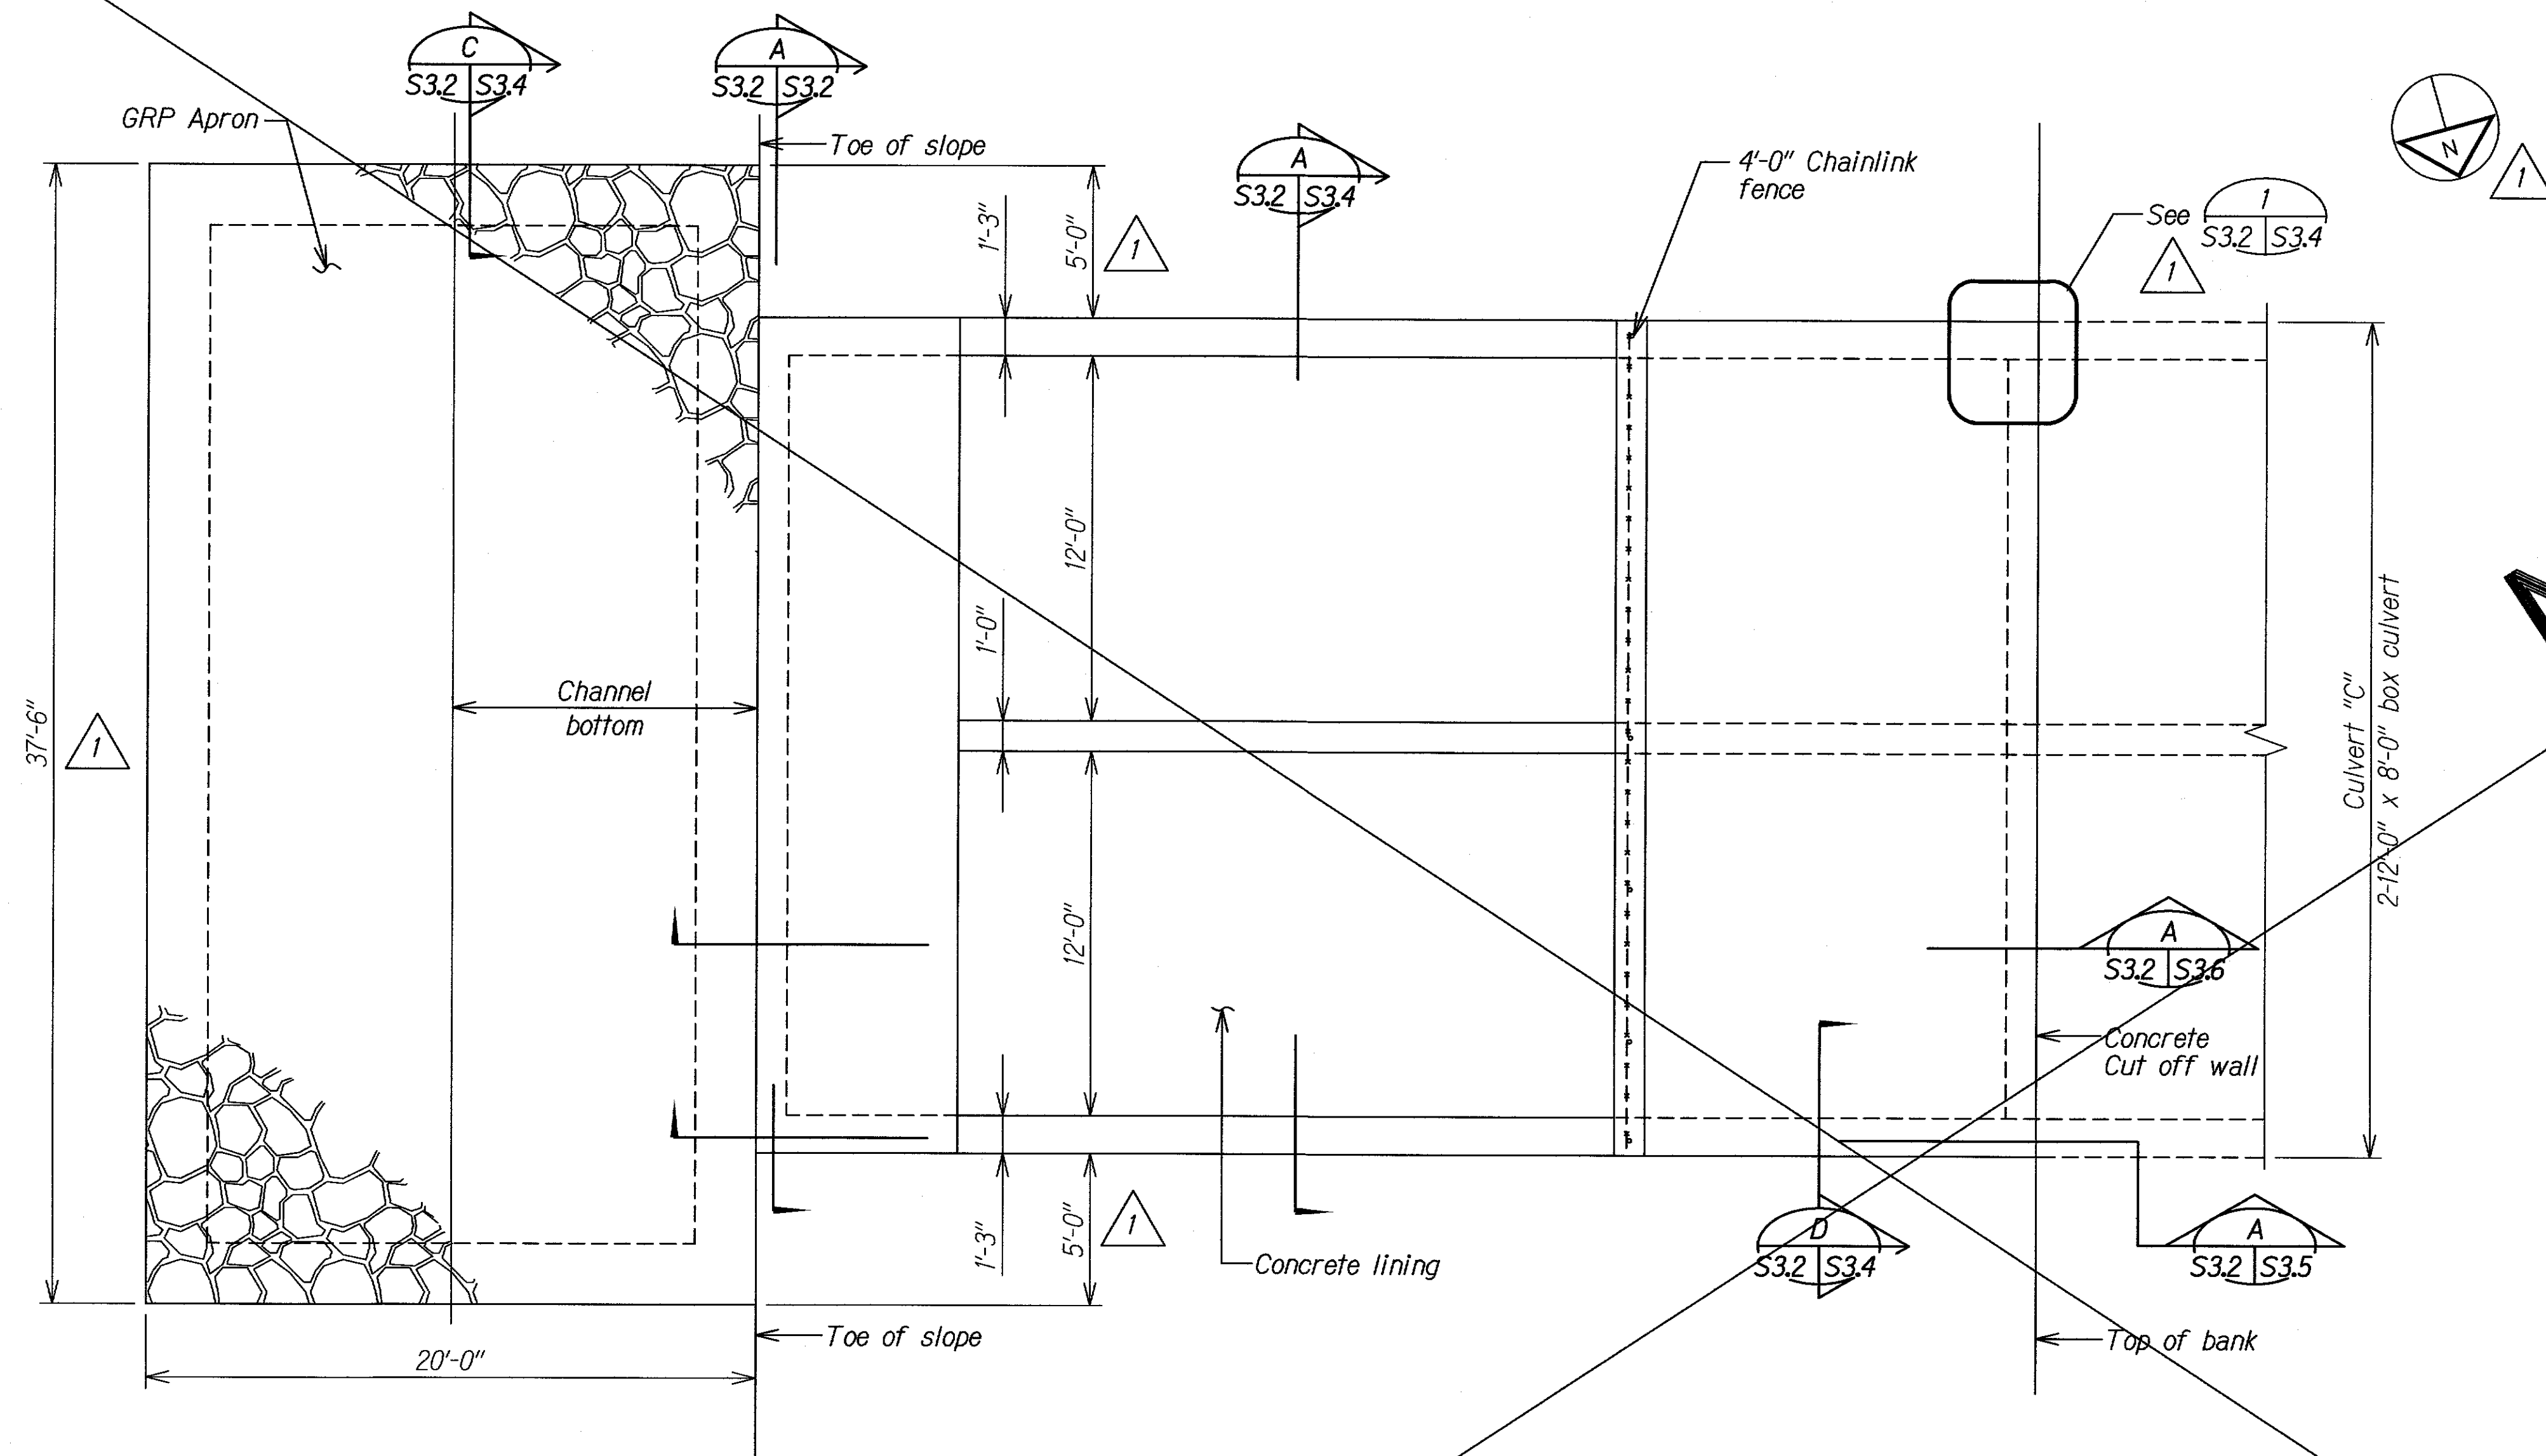

DRAIN CULVERT "C" - OUTLET LAYOUT PLAN

SCALE: 1/4" = 1'-0"

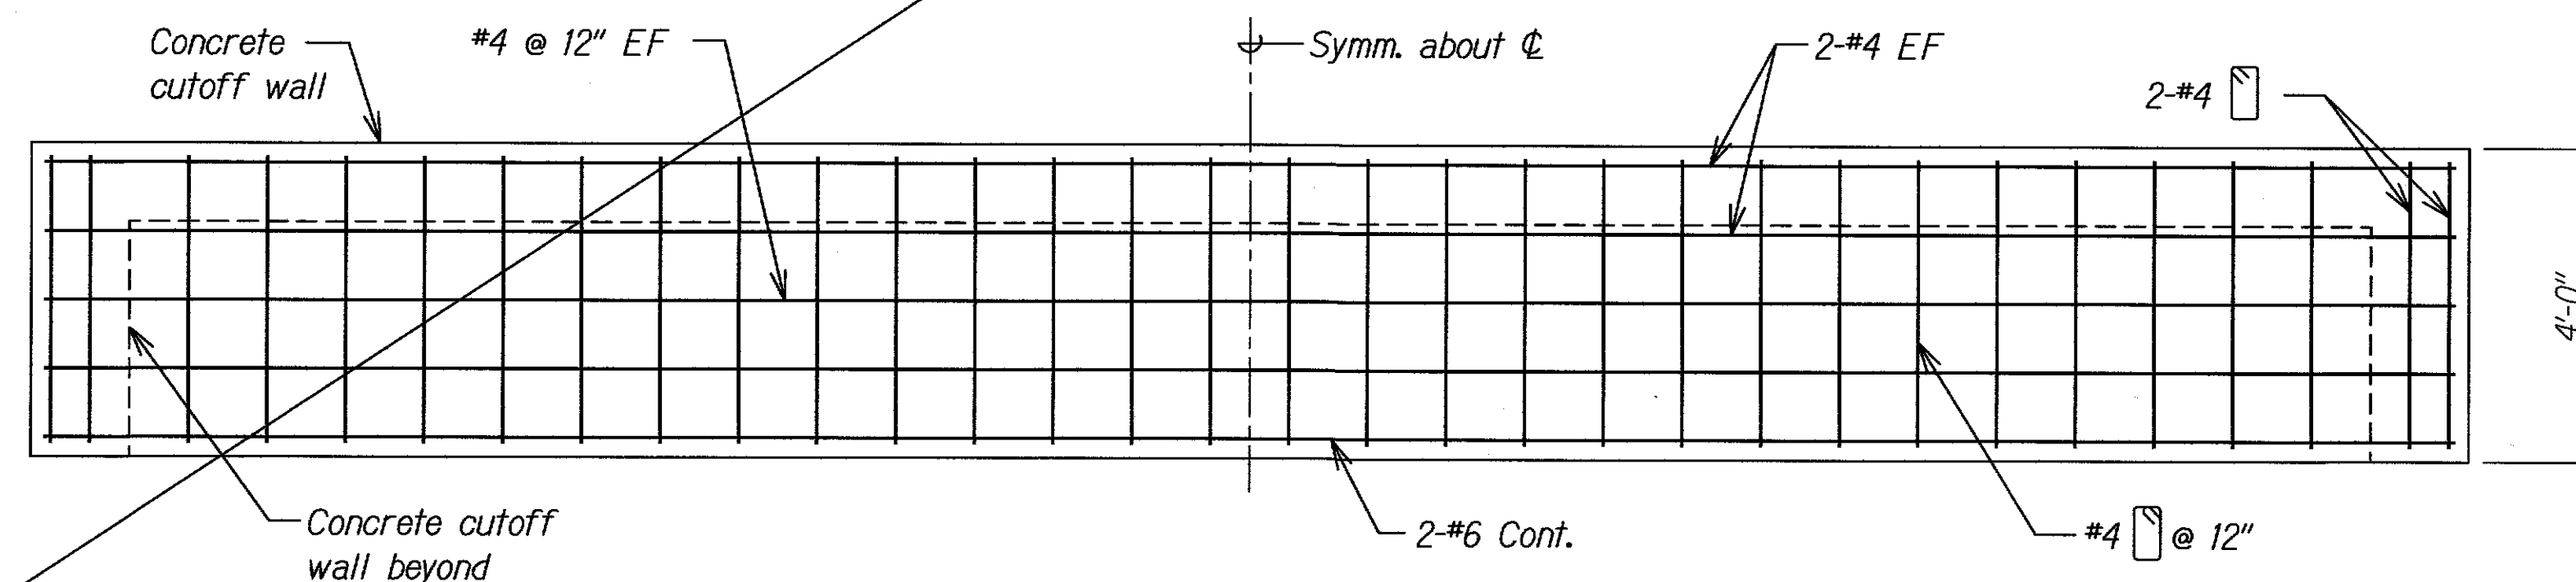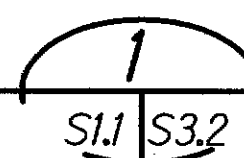

SECTION

SCALE: 1/2" = 1'-0"

S3.2, S3.5, S3.6 S3.2




6/21/06	Delete sheet per SDOT
1/18/05	Clarification of Note and Revised Dimensions
DATE	REVISION

STATE OF HAWAII
DEPARTMENT OF TRANSPORTATION
HIGHWAYS DIVISION

DRAIN CULVERT "C"
OUTLET LAYOUT PLAN AND SECTION
North-South Road
Phase 1A
F.A.I. Proj. No. STP-8930(1)

Scale: As Noted Date: Dec. 22, 2004

SHEET No. S3.2 OF 43 SHEETS

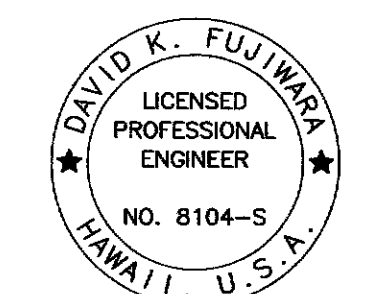


THIS WORK WAS PREPARED BY
ME OR UNDER MY SUPERVISION.


David K. Fujimura
SIGNATURE EXPIRATION DATE OF THE LICENSE 4-30-08

ORIGINAL PLAN	DATE
NO. _____	_____
SURVEY PLOTTED BY	_____
DRAWN BY	_____
TRACED BY	_____
CHECKED BY	_____
QUANTITIES BY	_____
NO. _____	_____


FED. ROAD DIST. NO.	STATE	FED. AID PROJ. NO.	FISCAL YEAR	SHEET NO.	TOTAL SHEETS
HAWAII	HAW.	STP-8930(1)	2005	ADD. 83	144

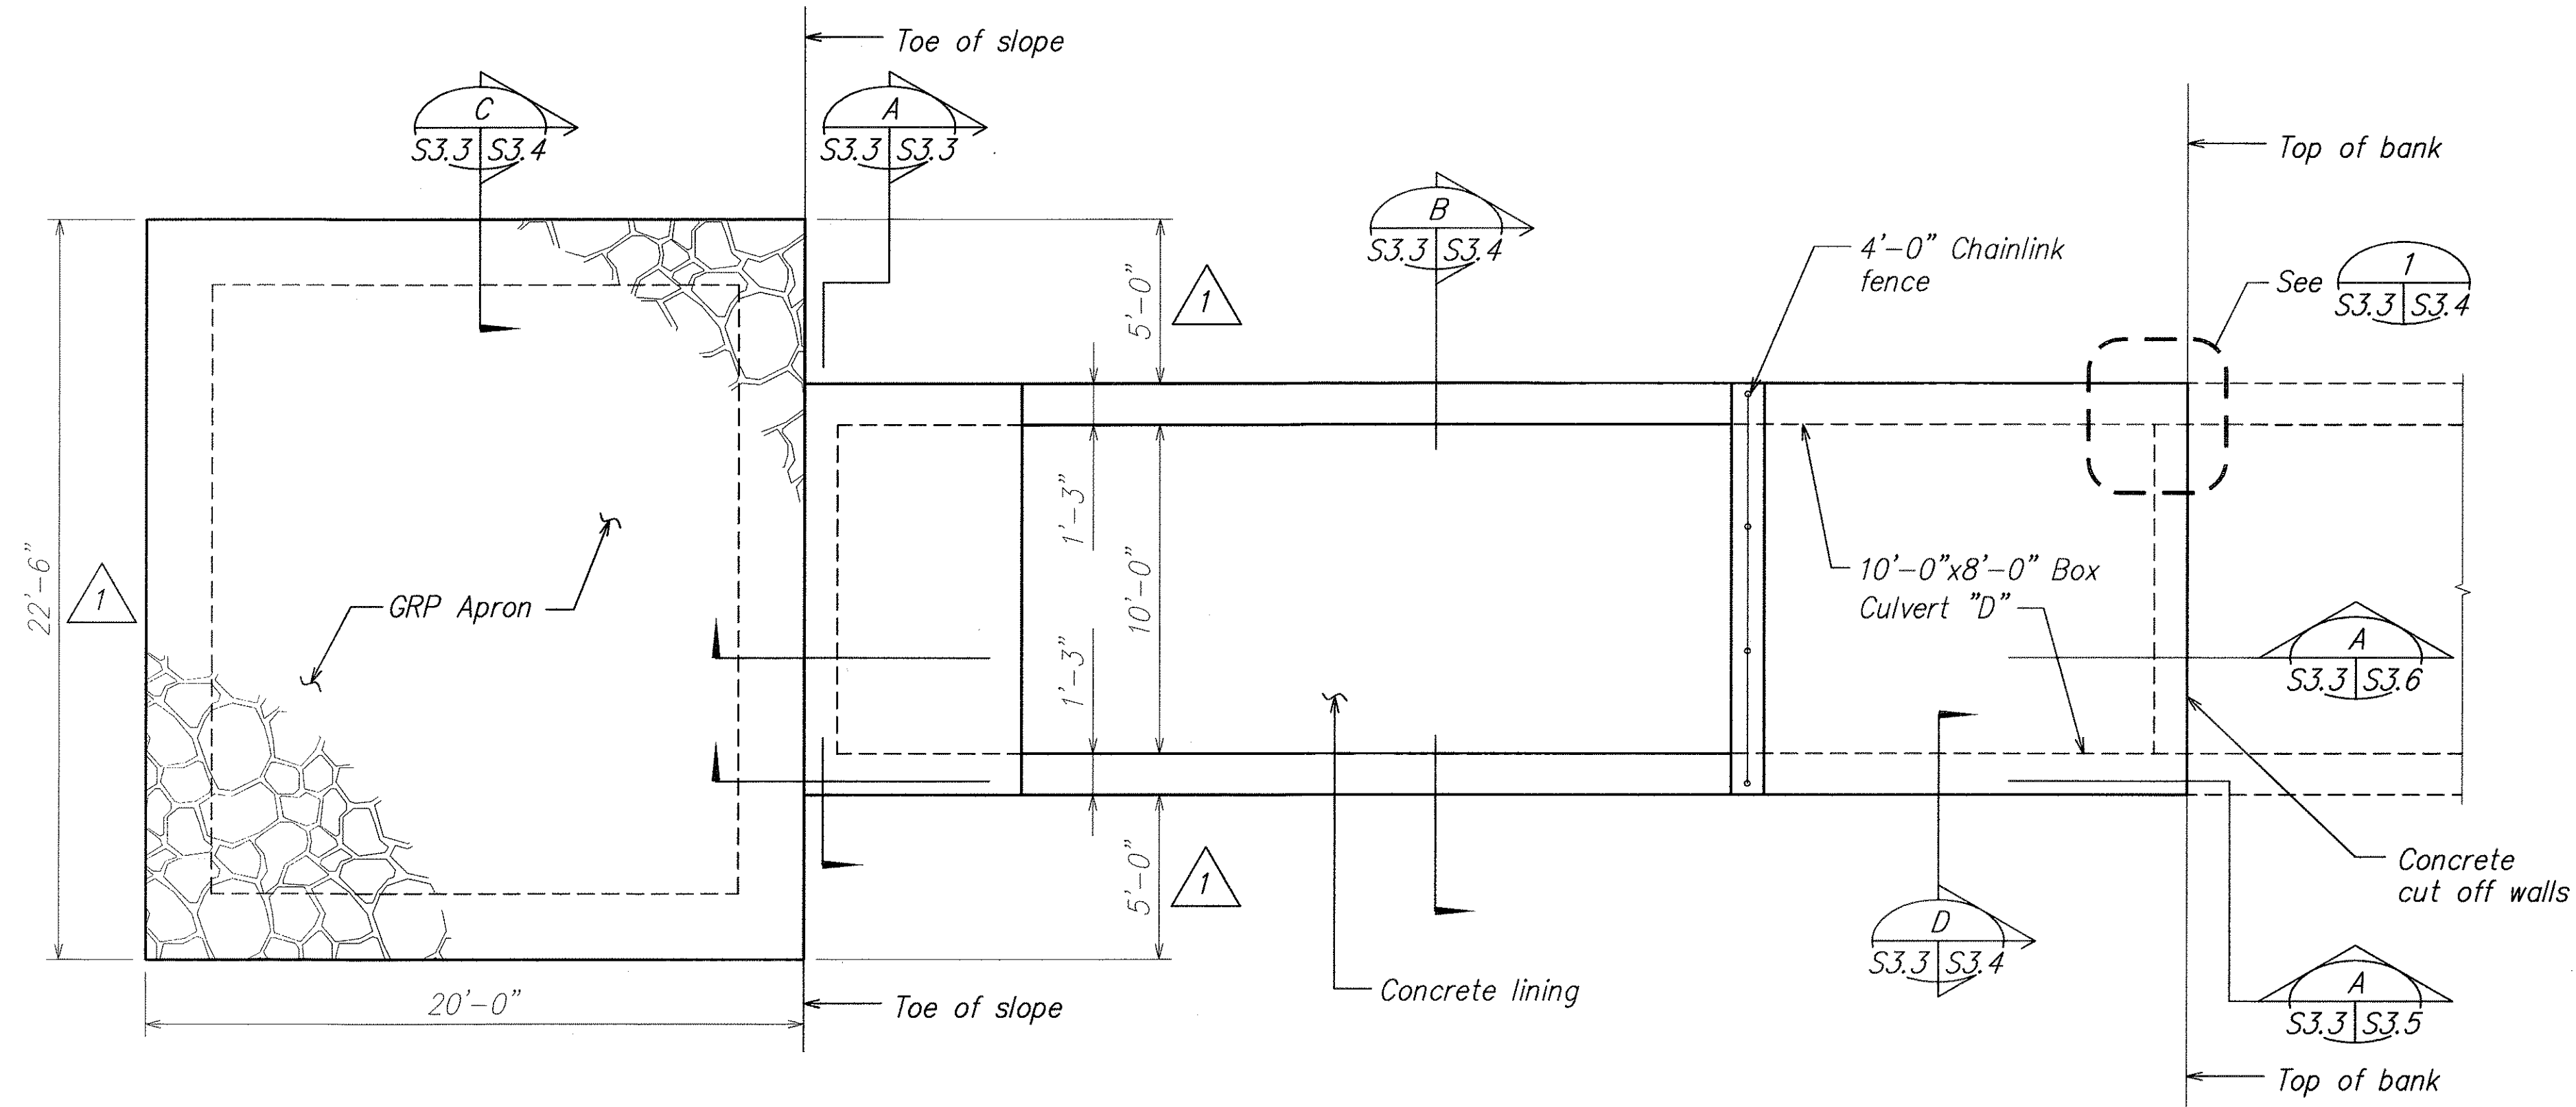

DRAIN CULVERT "D" - OUTLET LAYOUT PLAN
SCALE: 1/4" = 1'-0"
S2.1/S3.3

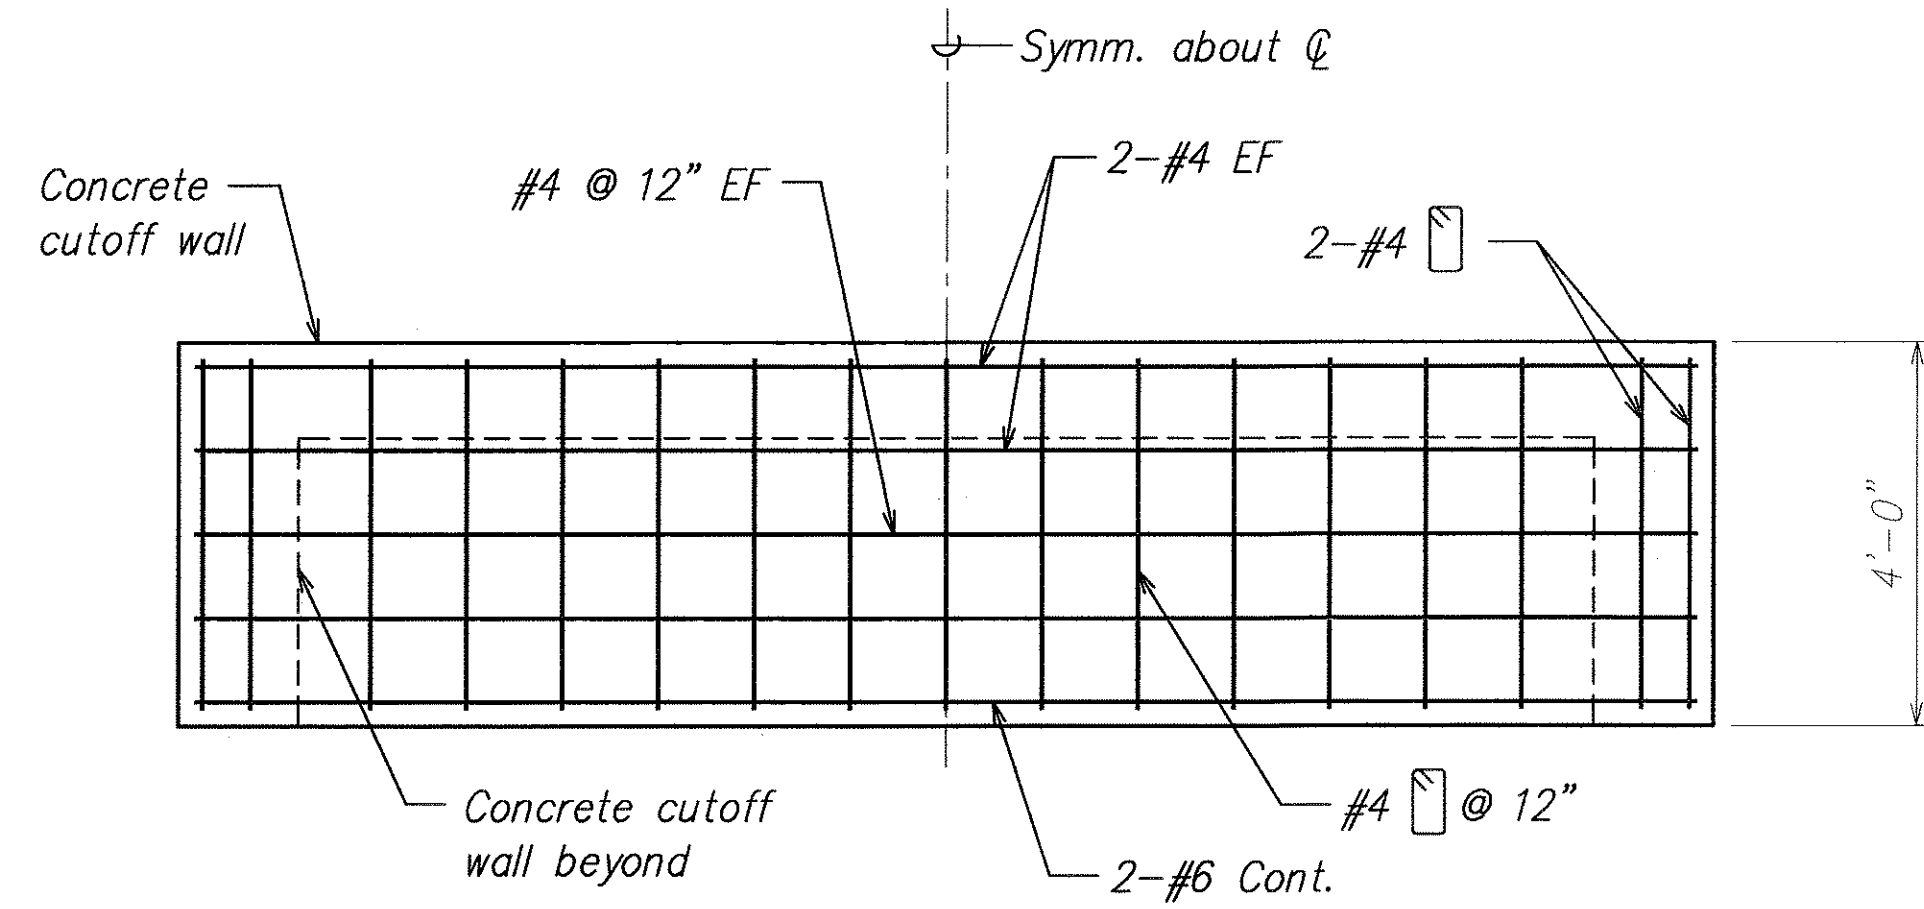

SECTION A
SCALE: 1/2" = 1'-0"
S3.3, S3.5, S3.6/S3.3

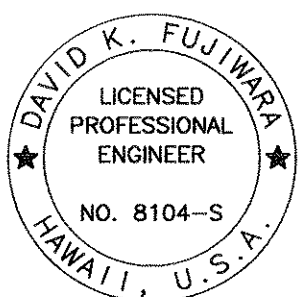

THIS WORK WAS PREPARED BY ME OR UNDER MY SUPERVISION.

Signature: David K. Fujinaka
Expiration Date of License: 4-30-06

STATE OF HAWAII
DEPARTMENT OF TRANSPORTATION
HIGHWAYS DIVISION






DRAIN CULVERT "D"
OUTLET LAYOUT PLAN AND SECTION
North-South Road
Phase 1A
F.A.I. Proj. No. STP-8930(1)

Scale: As Noted Date: Dec. 22, 2004

SHEET No. S3.3 OF 43 SHEETS

1/18/05	1	Revised Dimension
DATE	REVISION	

FED. ROAD DIST. NO.	STATE	FED. AID PROJ. NO.	FISCAL YEAR	SHEET NO.	TOTAL SHEETS
HAWAII	HAW.	STP-8930(1)	2005	C.O.ADD. 84	144

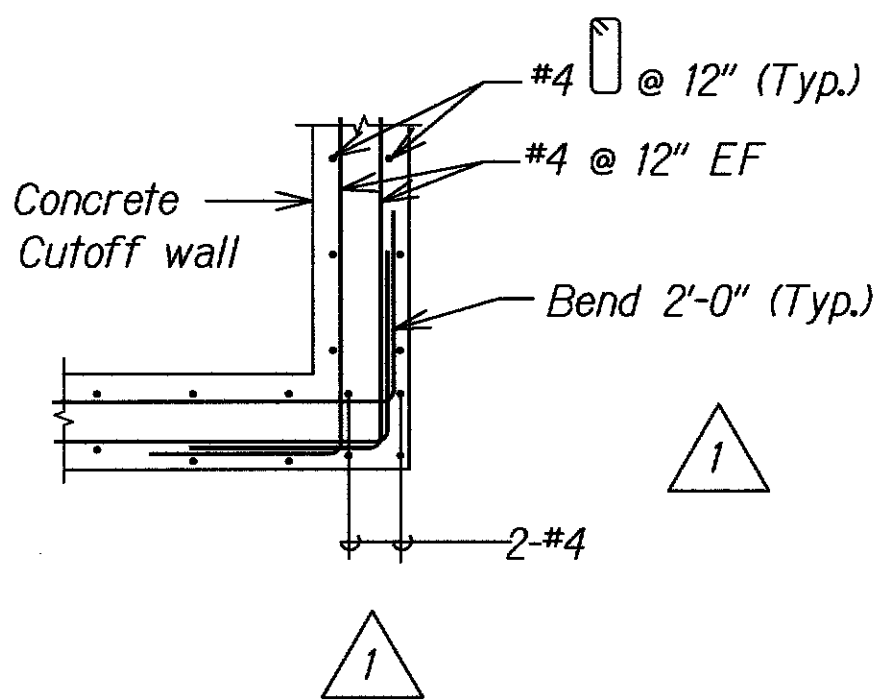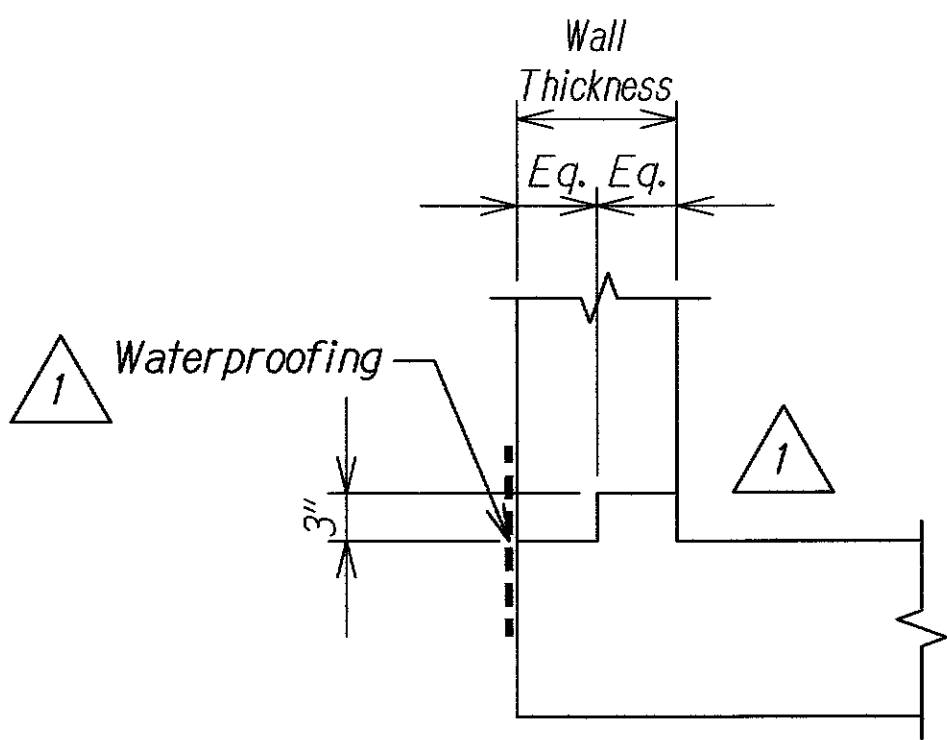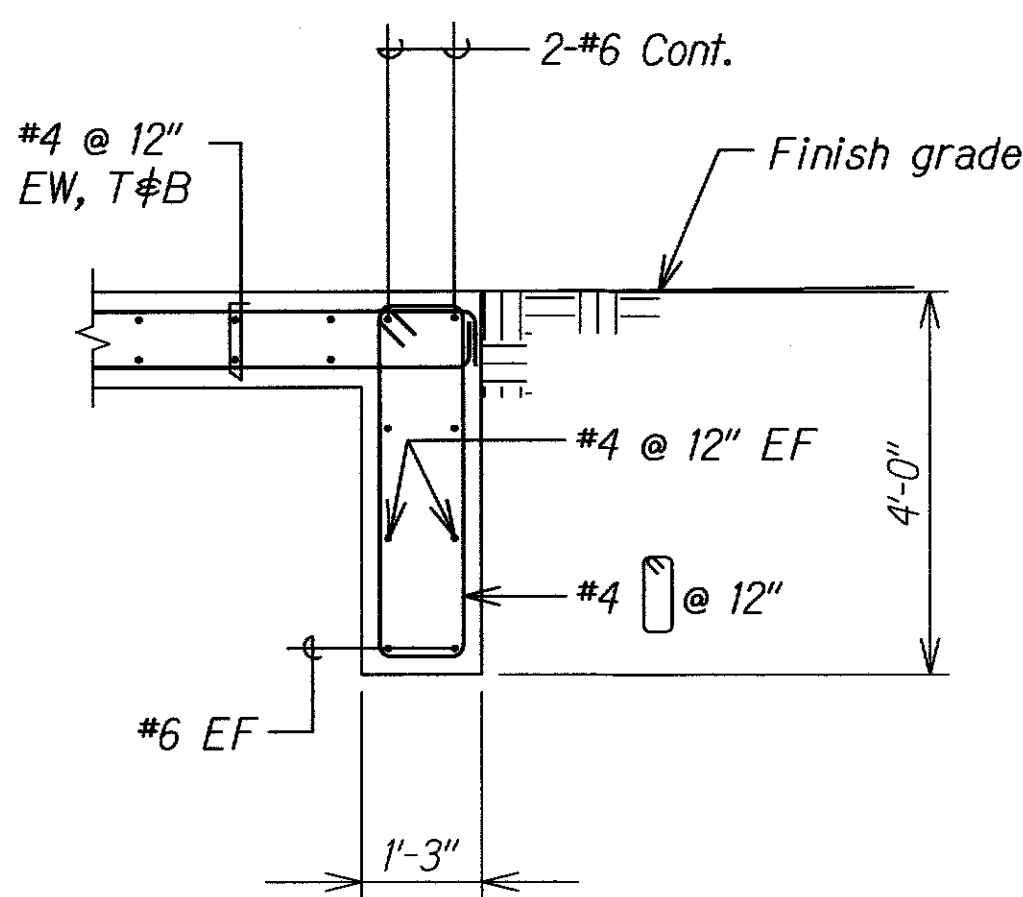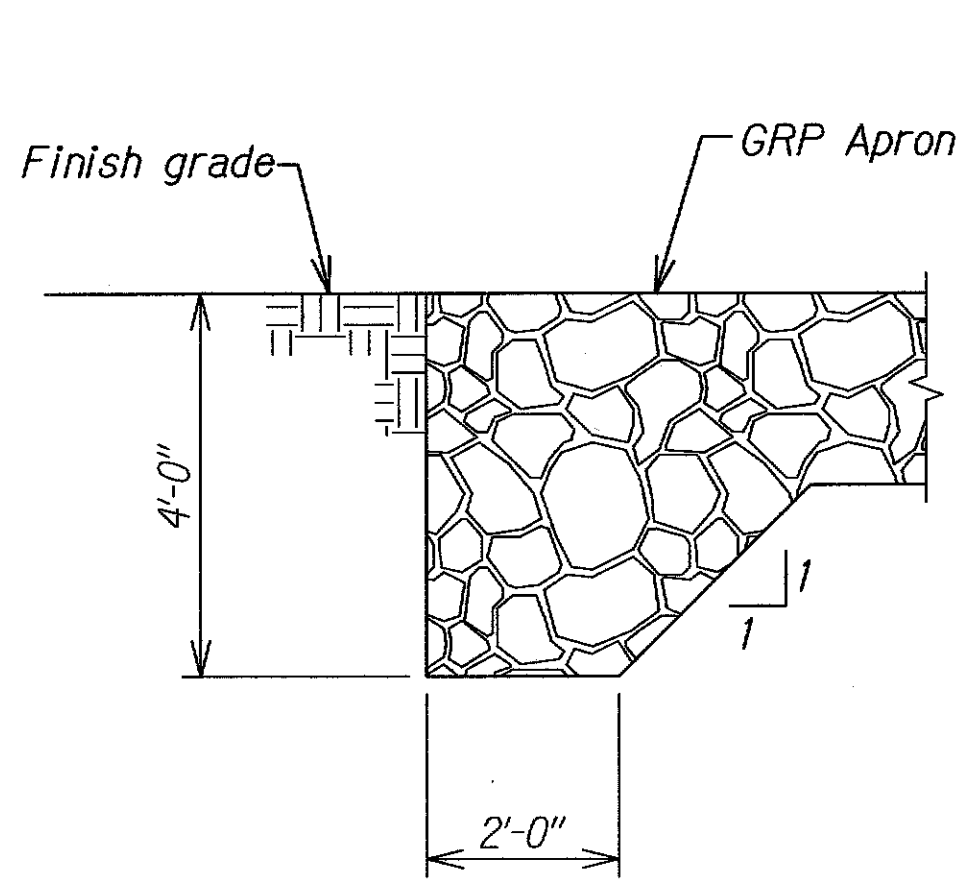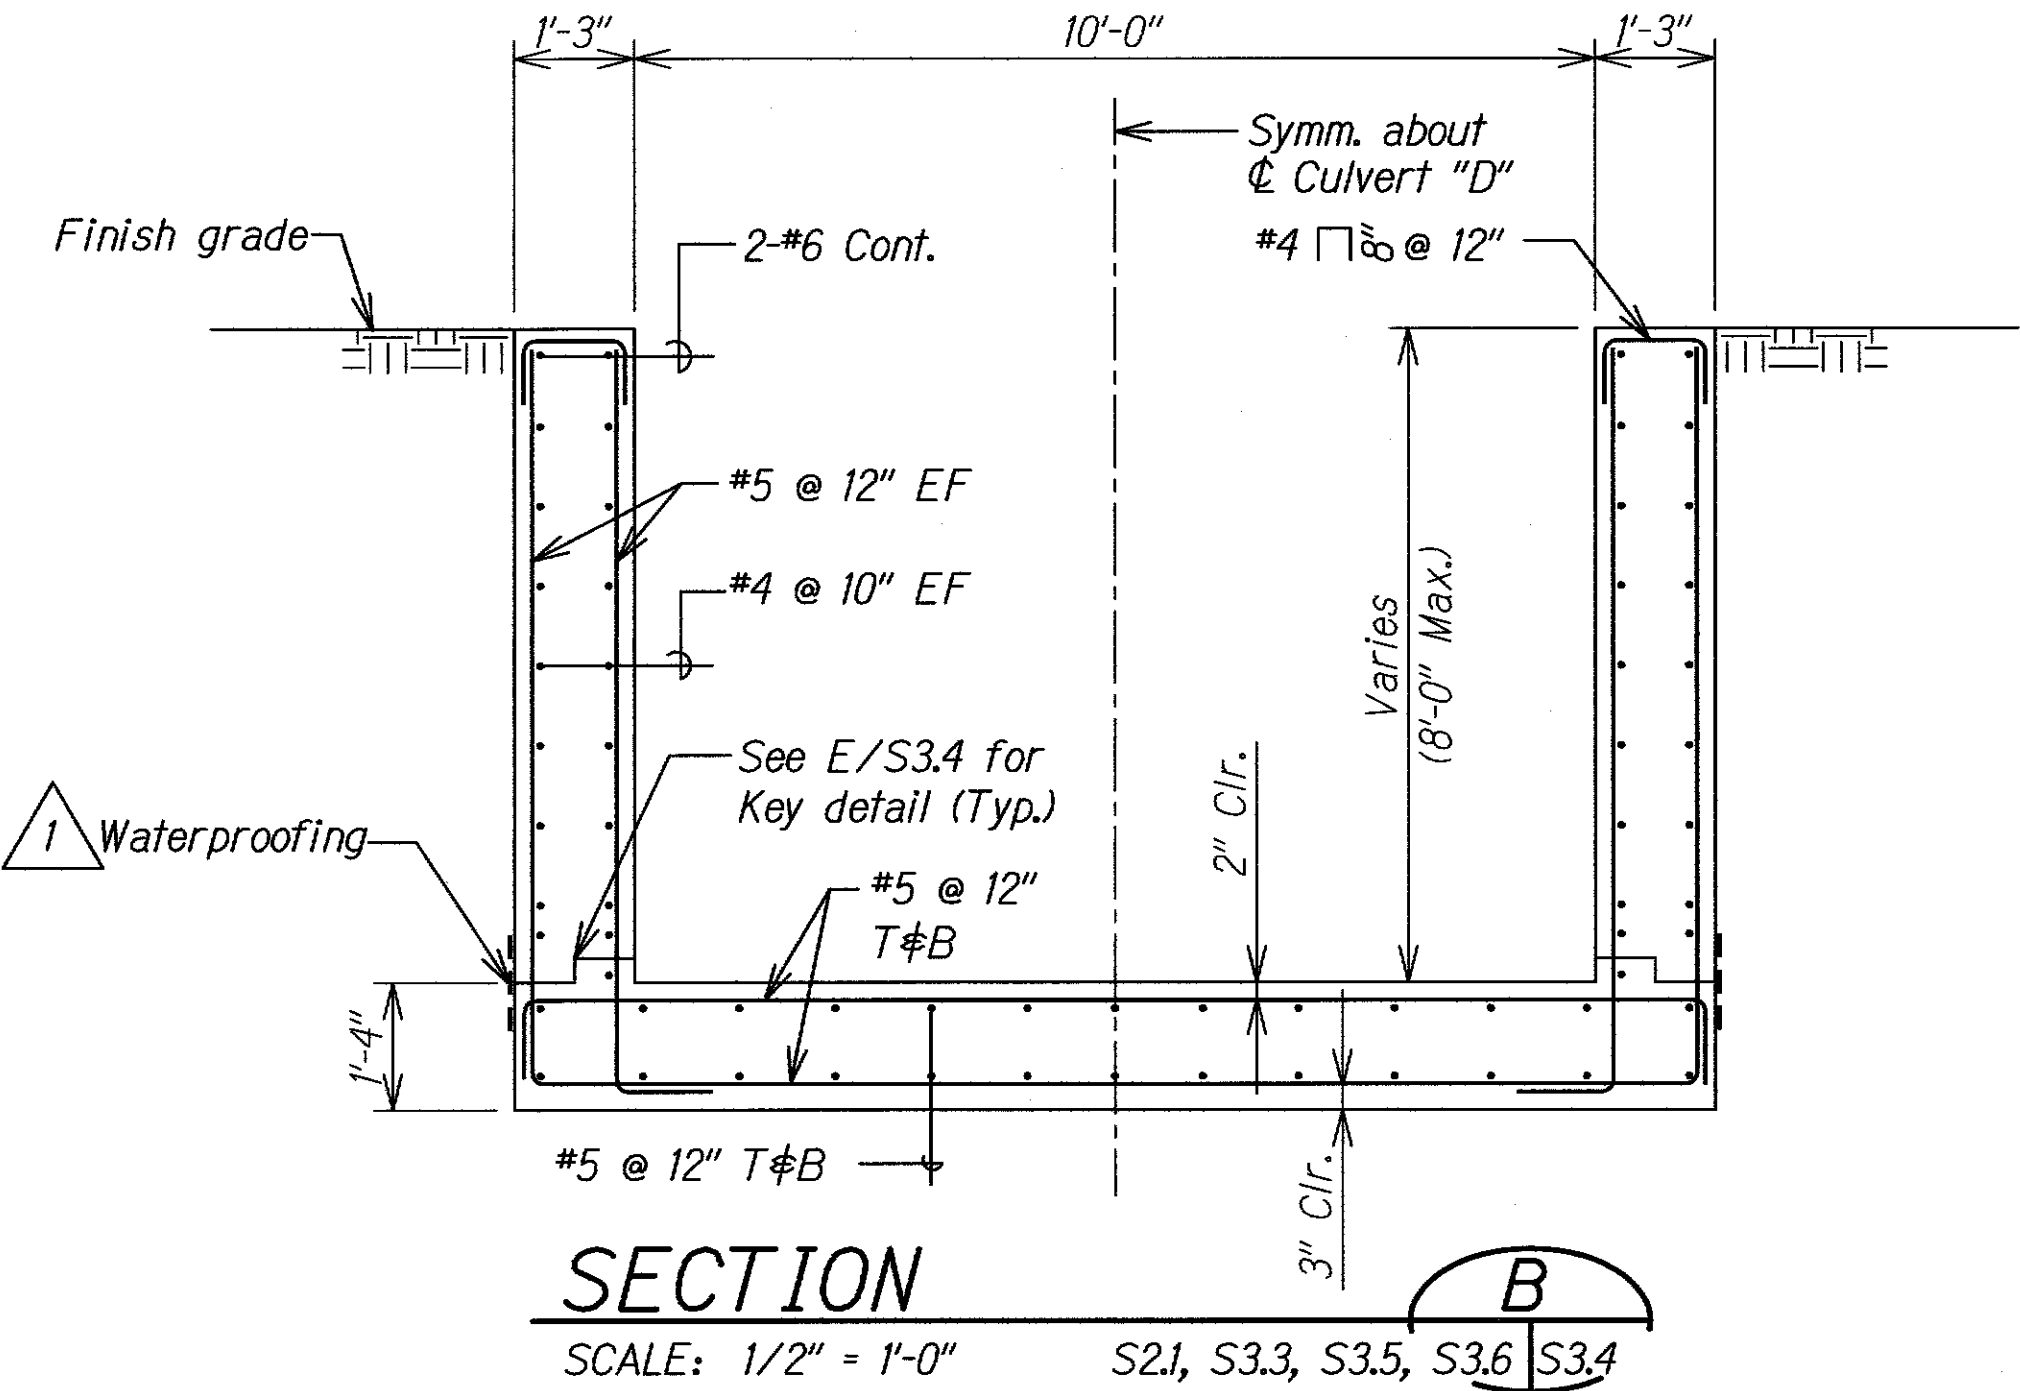


DATE	_____
SURVEY PLOTTED BY	_____
DRAWN BY	_____
DESIGNED BY	_____
CHECKED BY	_____
ORIGINAL PLAN	_____
NOTE BOOK	_____
No.	_____

SECTION C
SCALE: 1/2" = 1'-0"

SECTION D
SCALE: 1/2" = 1'-0"

TYPICAL KEY DETAIL E
SCALE: 1" = 1'-0"

TYPICAL CORNER DETAIL I
SCALE: 1/2" = 1'-0"

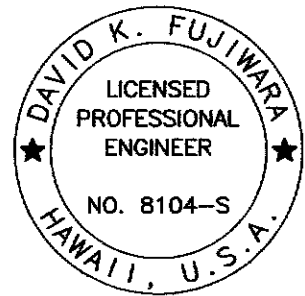

THIS WORK WAS PREPARED BY ME OR UNDER MY SUPERVISION.
Signature: *David K. Fujiwara* 4-30-08
EXPIRATION DATE OF THE LICENSE

STATE OF HAWAII
DEPARTMENT OF TRANSPORTATION
HIGHWAYS DIVISION


DRAIN CULVERT "D" OUTLET
SECTIONS AND TYPICAL DETAILS
North-South Road
Phase 1A
F.A.I. Proj. No. STP-8930(1)

Scale: As Noted
SHEET No. S3.4 OF 43 SHEETS

Date: Dec. 22, 2004

6/21/06	Remove # Revise Detail per SDOT
1/18/05	Added Note and Removed Dimensions
DATE	REVISION

FED. ROAD DIST. NO.	STATE	FED. AID PROJ. NO.	FISCAL YEAR	SHEET NO.	TOTAL SHEETS
HAWAII	HAW.	STP-8930(1)	2005	C.O.ADD. 85	144

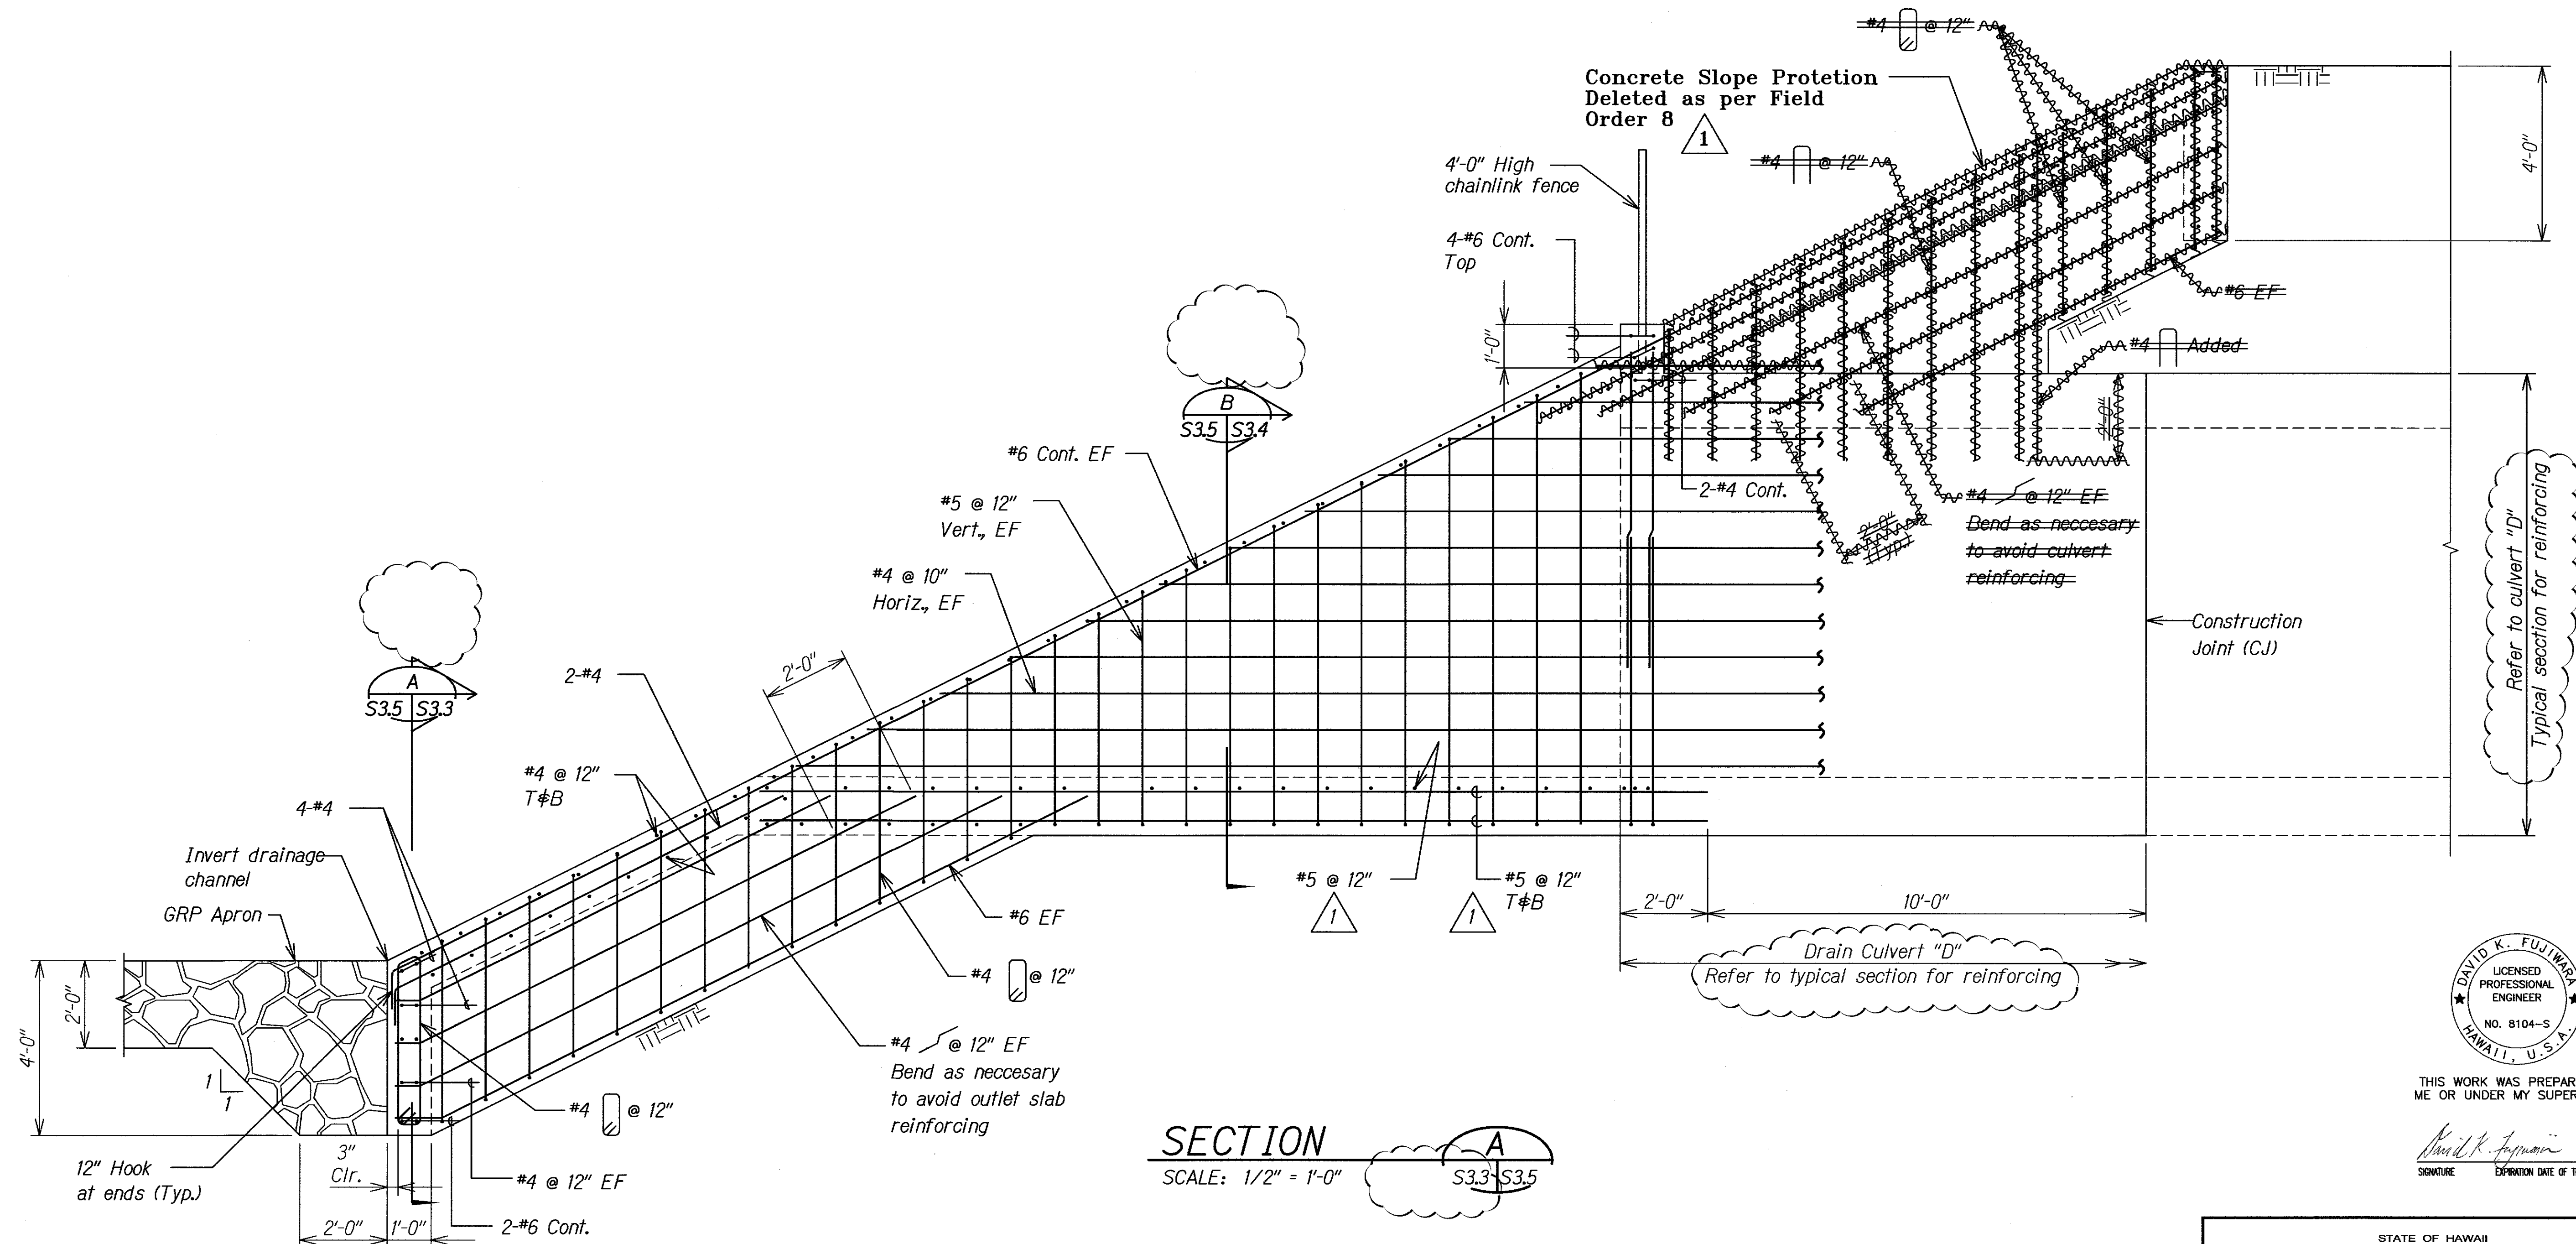

ORIGINAL PLAN	DATE
DESIGNED BY	DATE
CHECKED BY	DATE
NO.	


LEGEND FOR AS-BUILT POSTINGS	
	Squiggly line for as-built deletion
	Double line for as-built deletion
Roadway	Text for as-built posting

-	1 As Built - Field Order 8
6/21/06	Revise Detail per SDOT
1/18/05	1 Clarification of Note
DATE	REVISION

STATE OF HAWAII
DEPARTMENT OF TRANSPORTATION
HIGHWAYS DIVISION

Drain Culvert "D" Outlet Section
North-South Road
Phase 1A
F.A.I. Proj. No. STP-8930(1)



Scale: As Noted
Date: Dec. 22, 2004
SHEET No. S3.5 OF 43 SHEETS

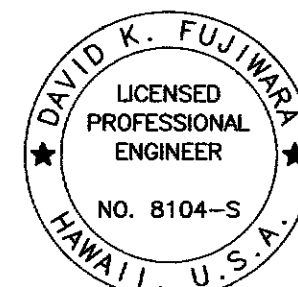

THIS WORK WAS PREPARED BY ME OR UNDER MY SUPERVISION.

David K. Fujiwara
SIGNATURE
4-30-08
EXPIRATION DATE OF THE LICENSE


FED. ROAD DIST. NO.	STATE	FED. AID PROJ. NO.	FISCAL YEAR	SHEET NO.	TOTAL SHEETS
HAWAII	HAW.	STP-8930(1)	2005	ADD. 87	144

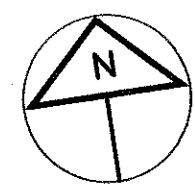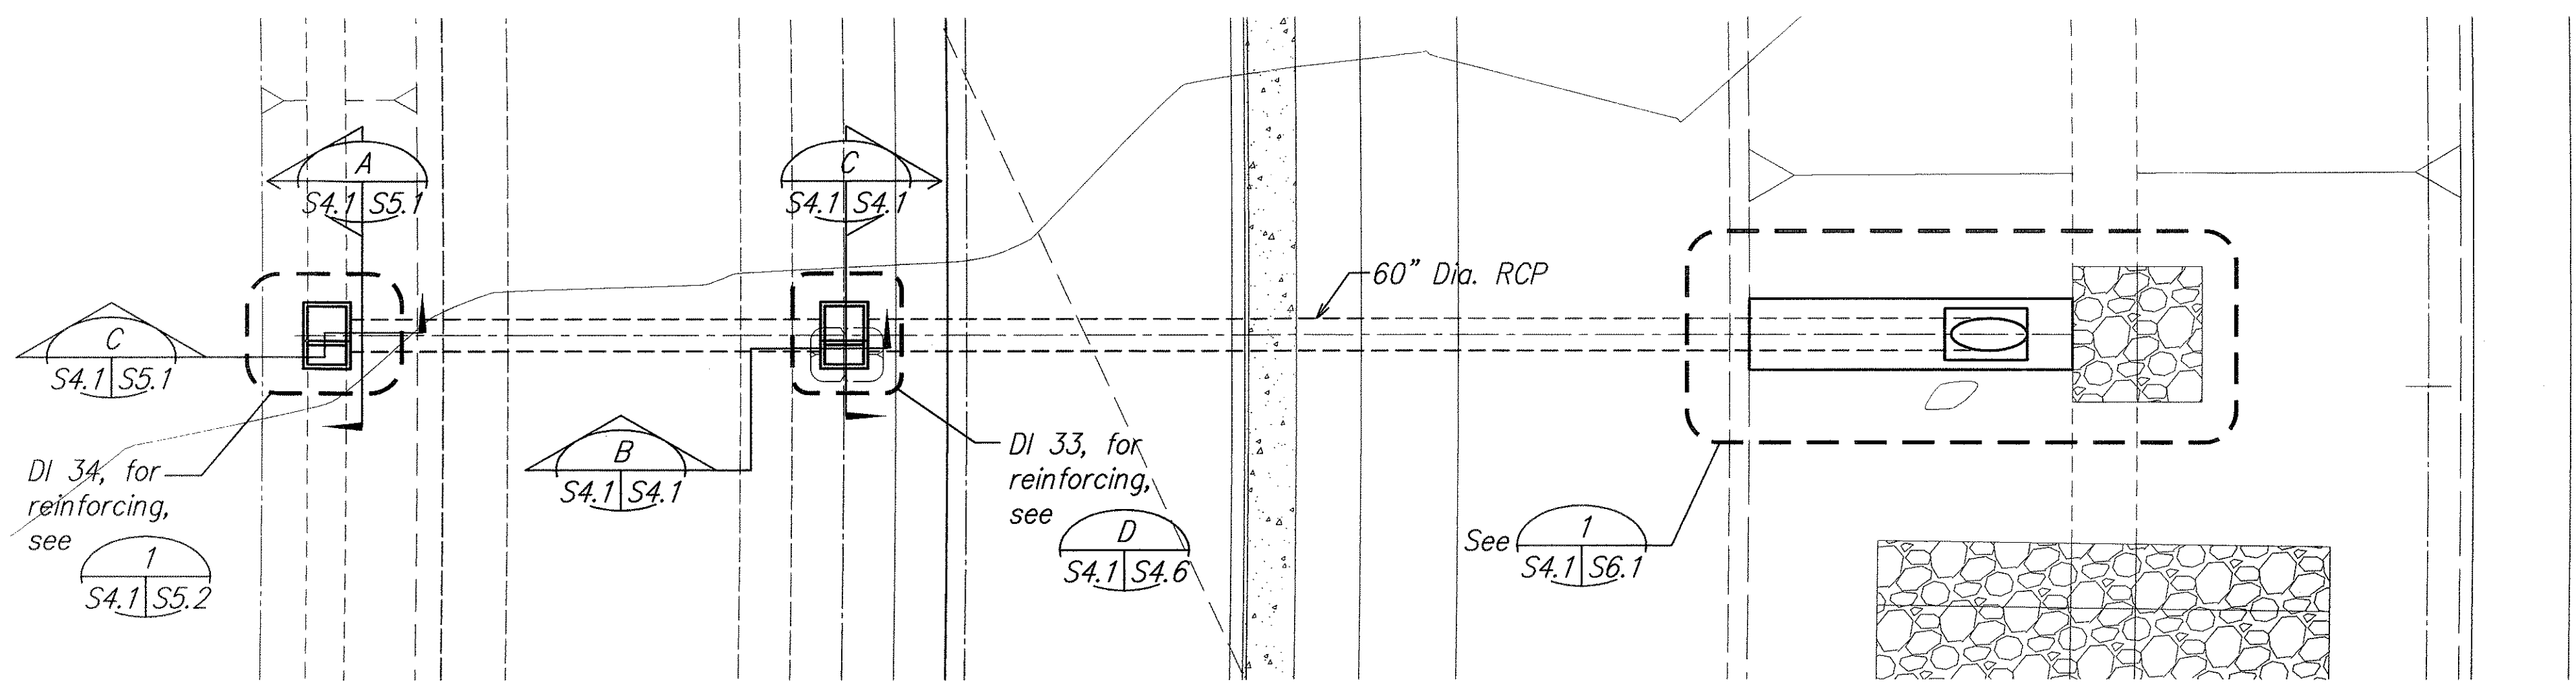

DRAIN CULVERT "E" - LAYOUT PLAN

SCALE: 1" = 20'

A
S4.1/S4.1

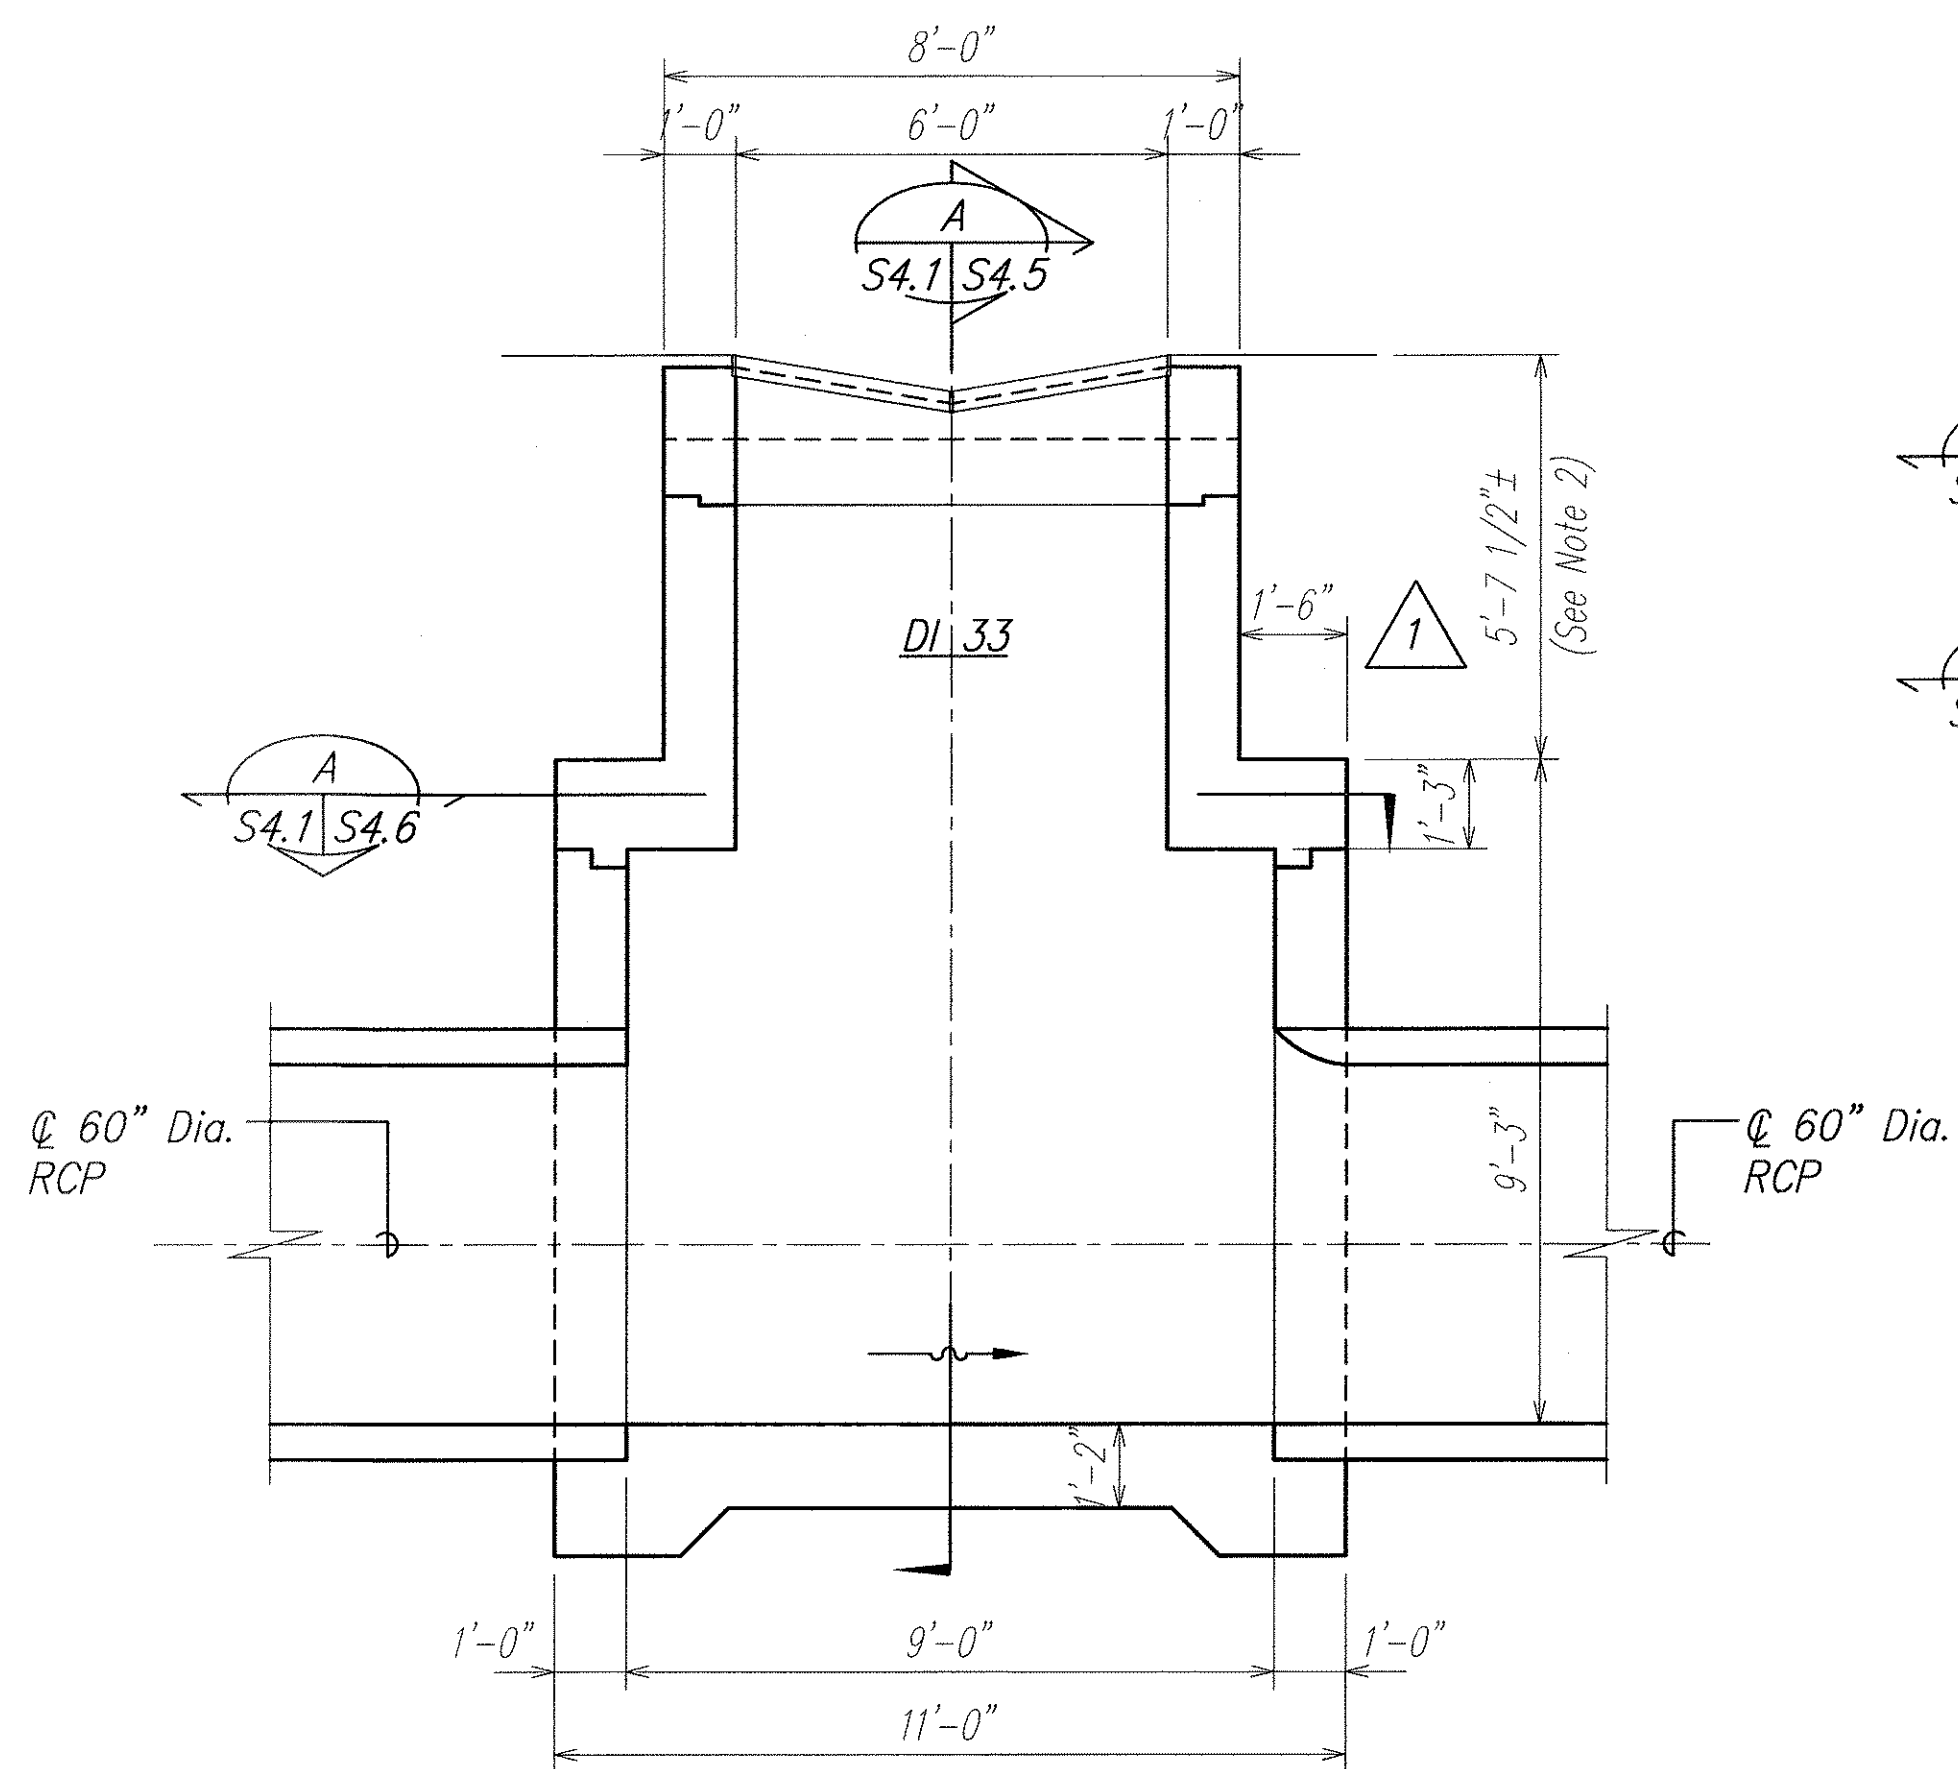


SECTION B

SCALE: 3/8" = 1'-0"

B
S4.1/S4.1

DRAIN CULVERT "E" - SECTIONS AT DI 33

1
S4.1/S4.1

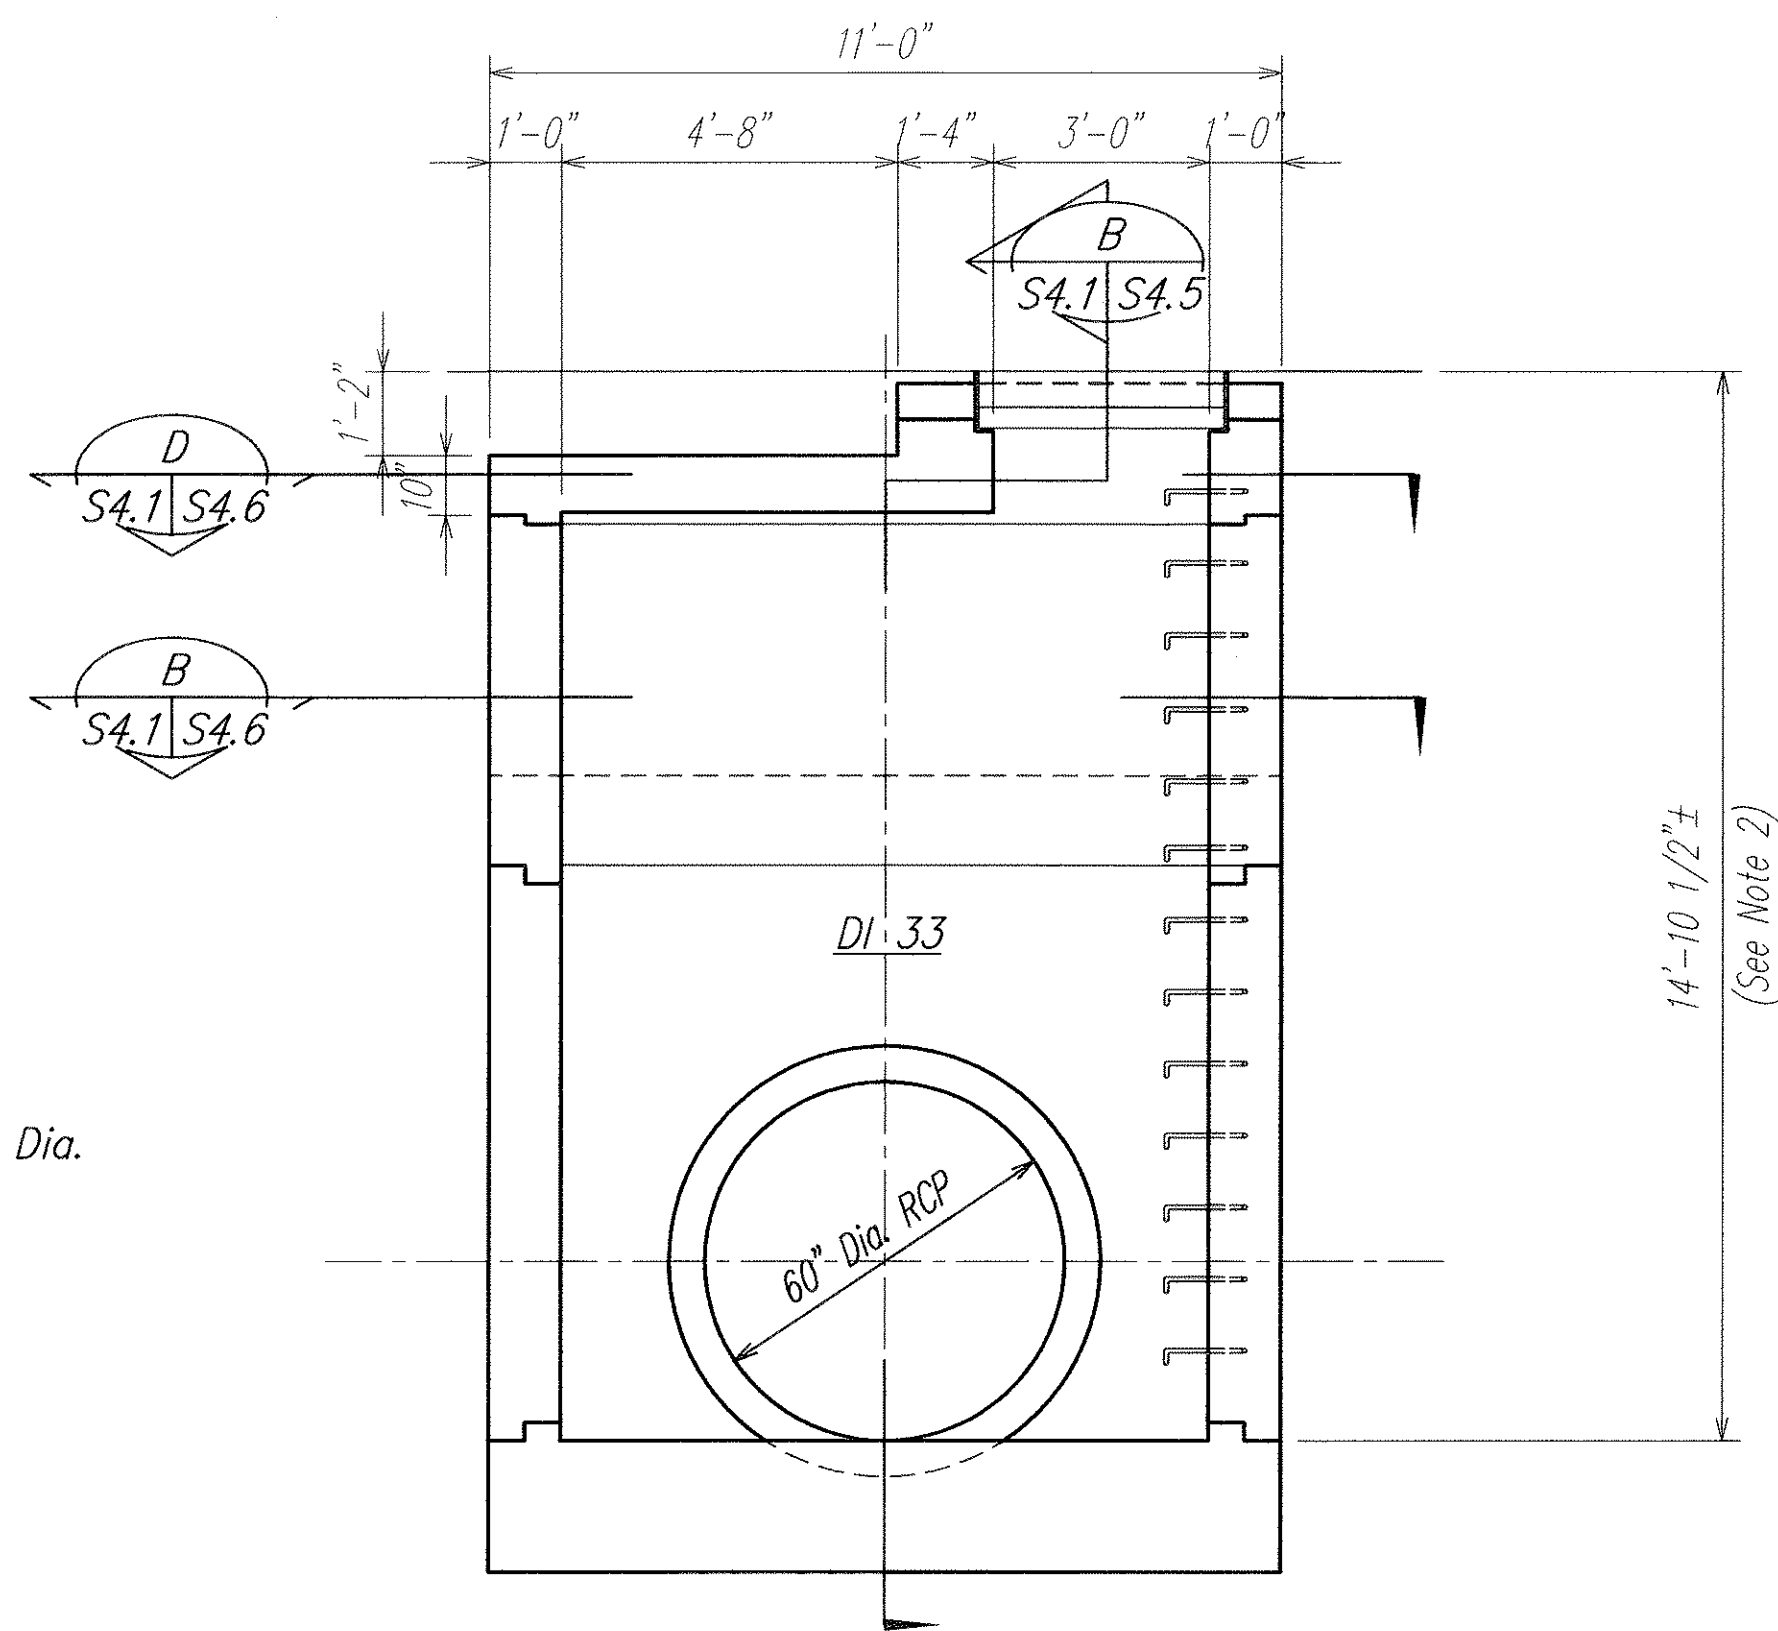

SECTION C


SCALE: 3/8" = 1'-0"

C
S4.1/S4.1

Note:

1. Refer to sheets S4.5 and S4.6 for reinforcing.
2. Refer to civil drawings for DI elevations and verify dimension

1/18/05	Added Dimension and Clarification
DATE	REVISION

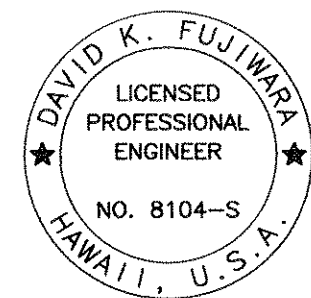

THIS WORK WAS PREPARED BY ME OR UNDER MY SUPERVISION.

David K. Fujiwara
SIGNATURE
4-30-05
EXPIRATION DATE OF THE LICENSE

STATE OF HAWAII
DEPARTMENT OF TRANSPORTATION
HIGHWAYS DIVISION


**DRAIN CULVERT "E" - LAYOUT PLAN
AND SECTIONS AT DI 33**

**North-South Road
Phase 1A
F.A.I. Proj. No. STP-8930(1)**


Scale: As Noted Date: Dec. 22, 2004

SHEET No. S4.1 OF 43 SHEETS

FED. ROAD DIST. NO.	STATE	FED. AID PROJ. NO.	FISCAL YEAR	SHEET NO.	TOTAL SHEETS
HAWAII	HAW.	STP-8930(1)	2005	ADD. 89	144

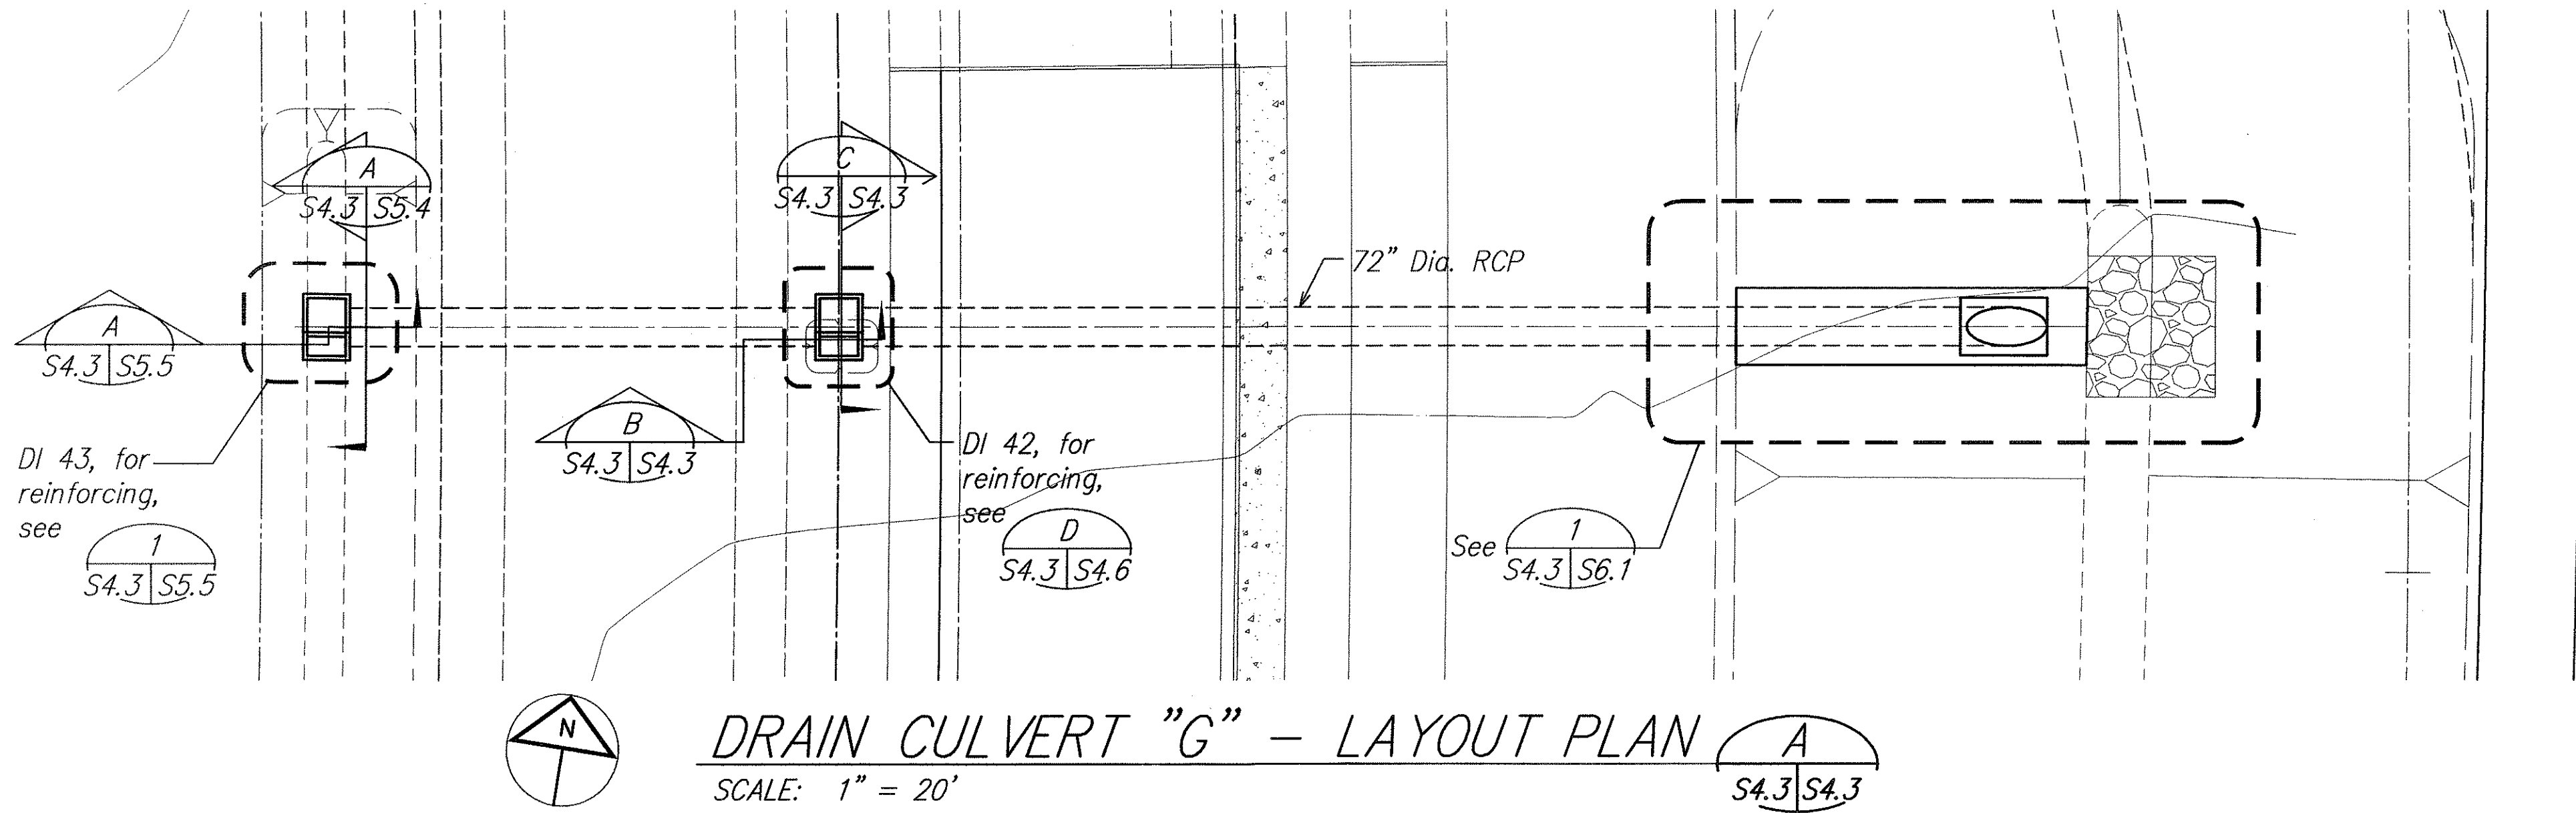

DRAIN CULVERT "G" - LAYOUT PLAN
SCALE: 1" = 20'

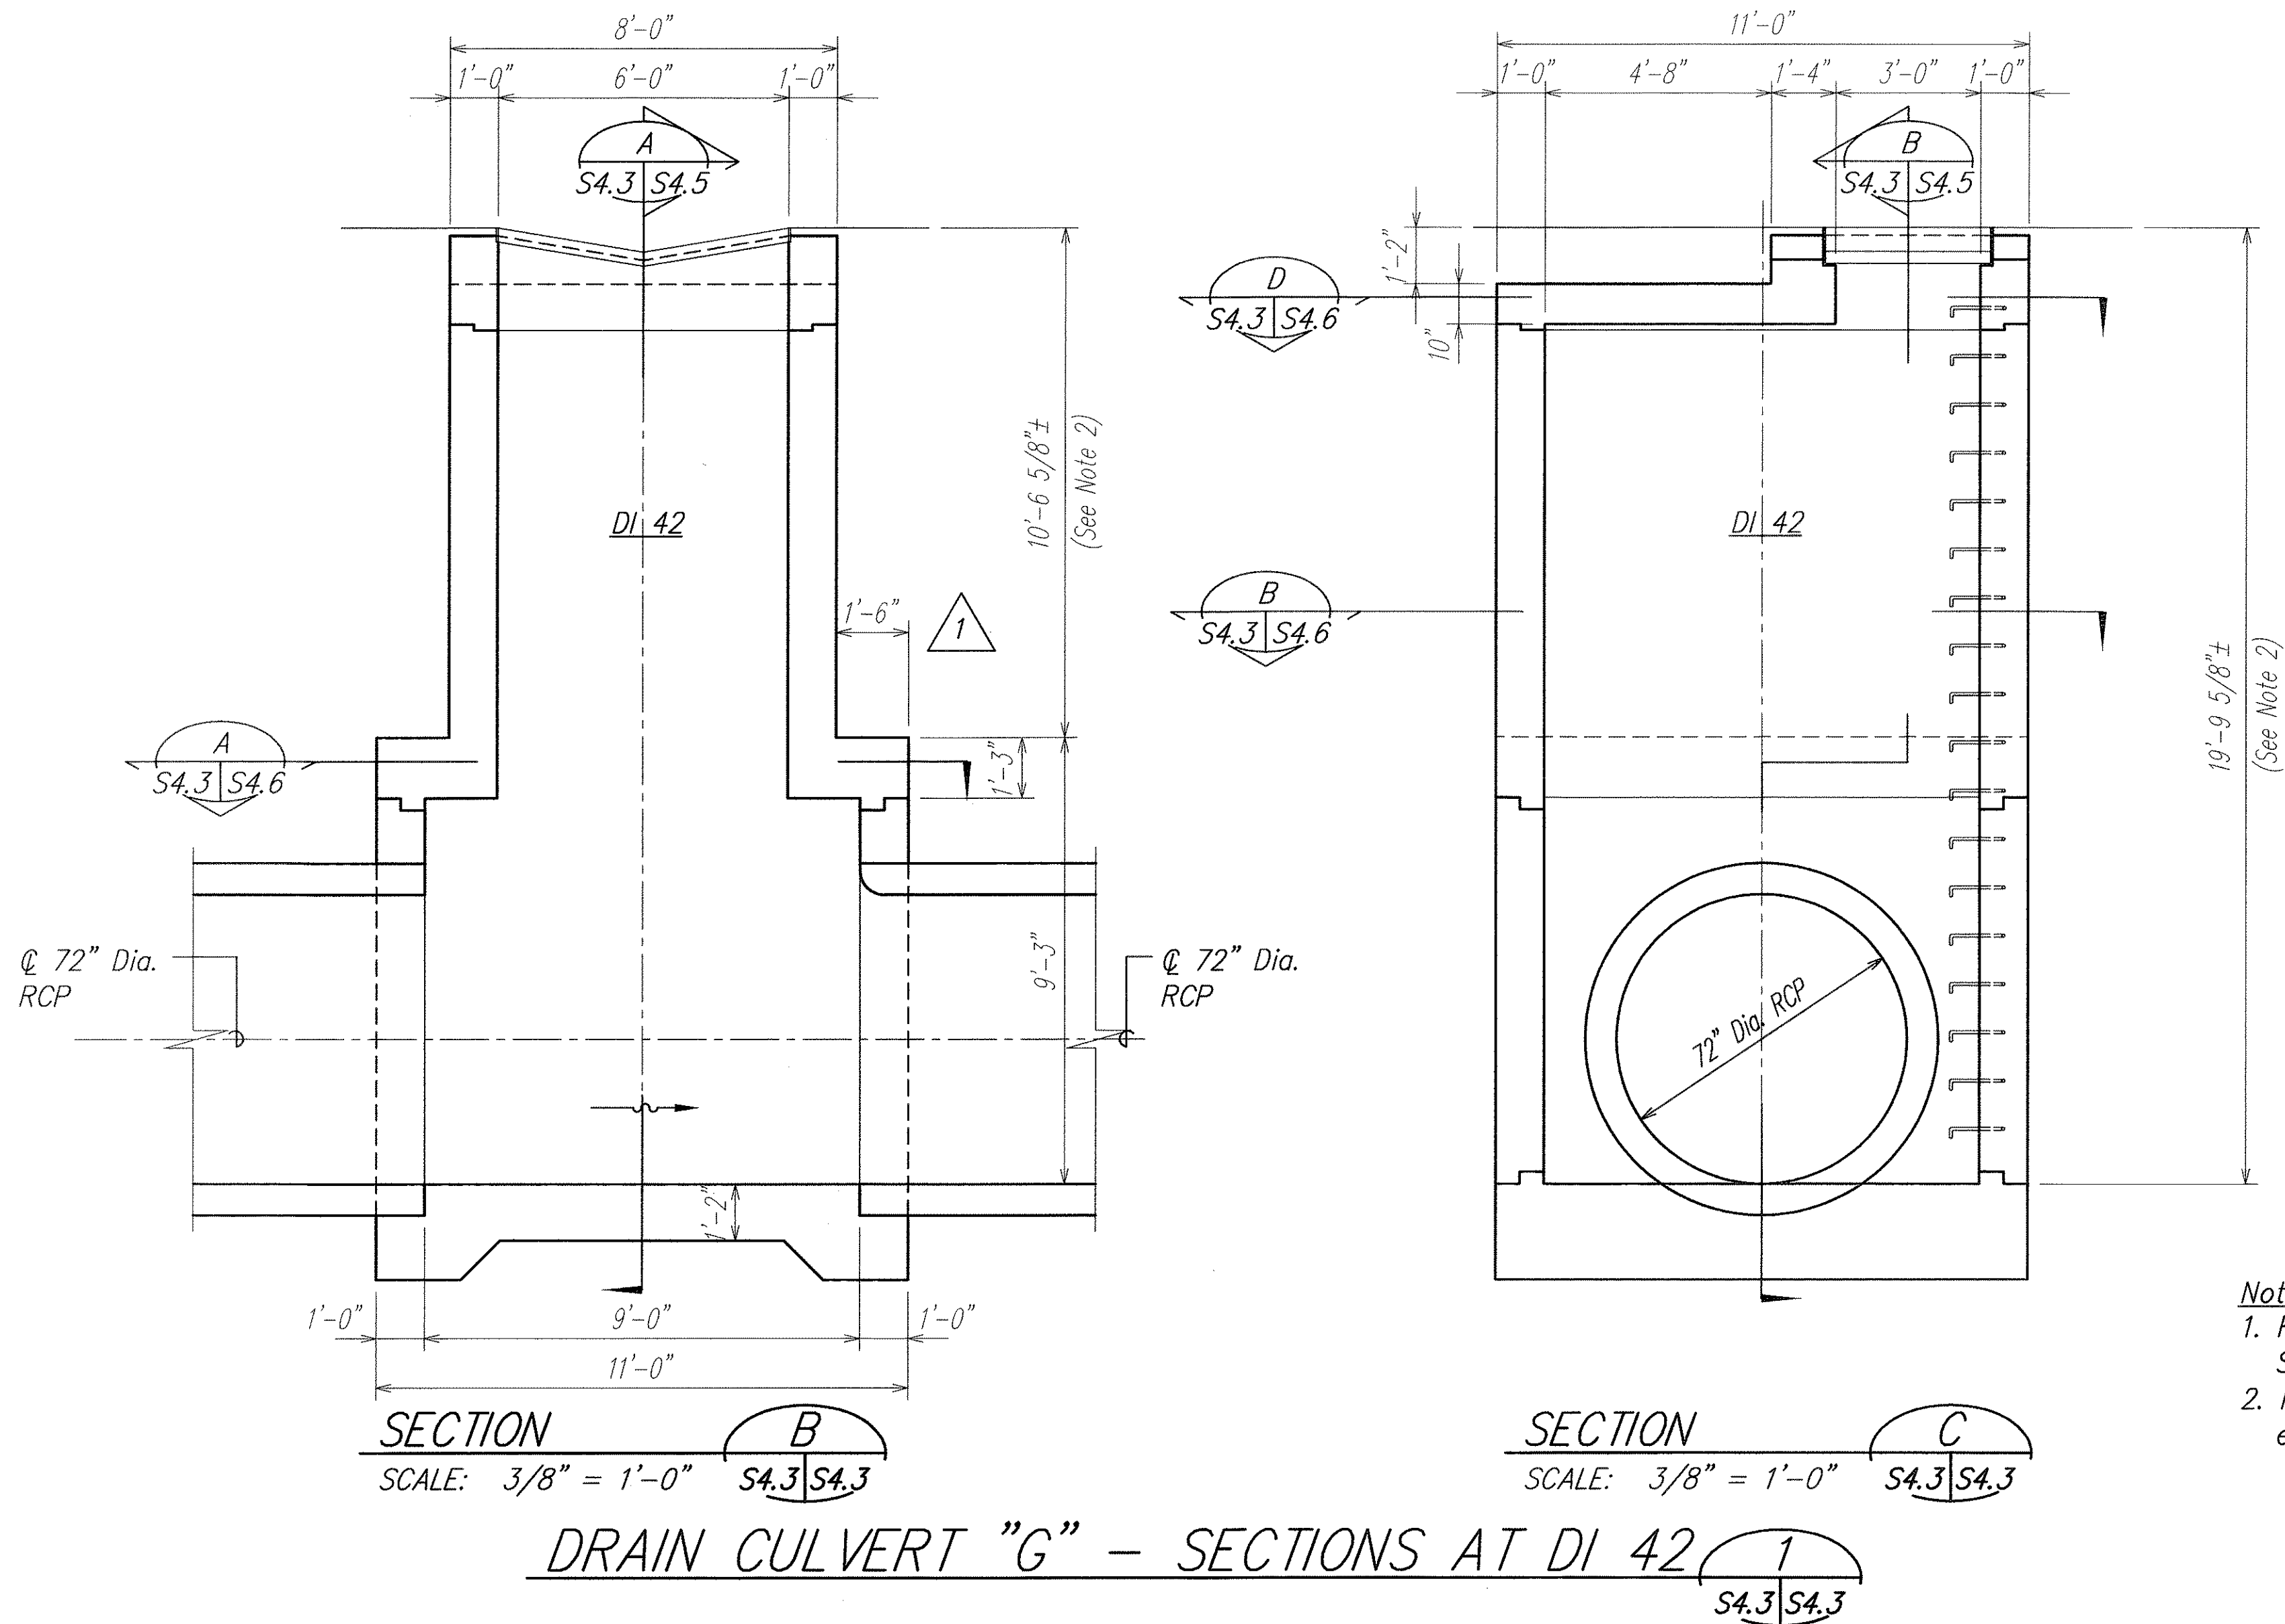


SECTION B
SCALE: 3/8" = 1'-0"

SECTION C
SCALE: 3/8" = 1'-0"

DRAIN CULVERT "G" - SECTIONS AT DI 42

- Note:
1. Refer to sheets S4.5 and S4.6 for reinforcing.
 2. Refer to civil drawings for DI elevations and verify dimensions.

1/18/05	Added Dimension and Clarification
DATE	REVISION

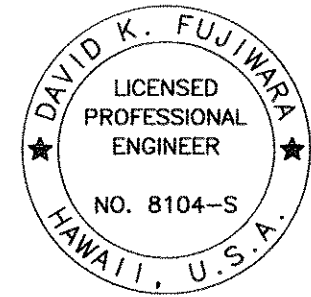

THIS WORK WAS PREPARED BY ME OR UNDER MY SUPERVISION.

Signature: David K. Fujiwara
Expiration Date of License: 4-30-06

STATE OF HAWAII
DEPARTMENT OF TRANSPORTATION
HIGHWAYS DIVISION


DRAIN CULVERT "G" - LAYOUT PLAN AND SECTIONS AT DI 42

North-South Road
Phase 1A
F.A.I. Proj. No. STP-8930(1)

Scale: As Noted Date: Dec. 22, 2004


SHEET No. S4.3 OF 43 SHEETS

FED. ROAD DIST. NO.	STATE	FED. AID PROJ. NO.	FISCAL YEAR	SHEET NO.	TOTAL SHEETS
HAWAII	HAW.	STP-8930(1)	2005	90	144

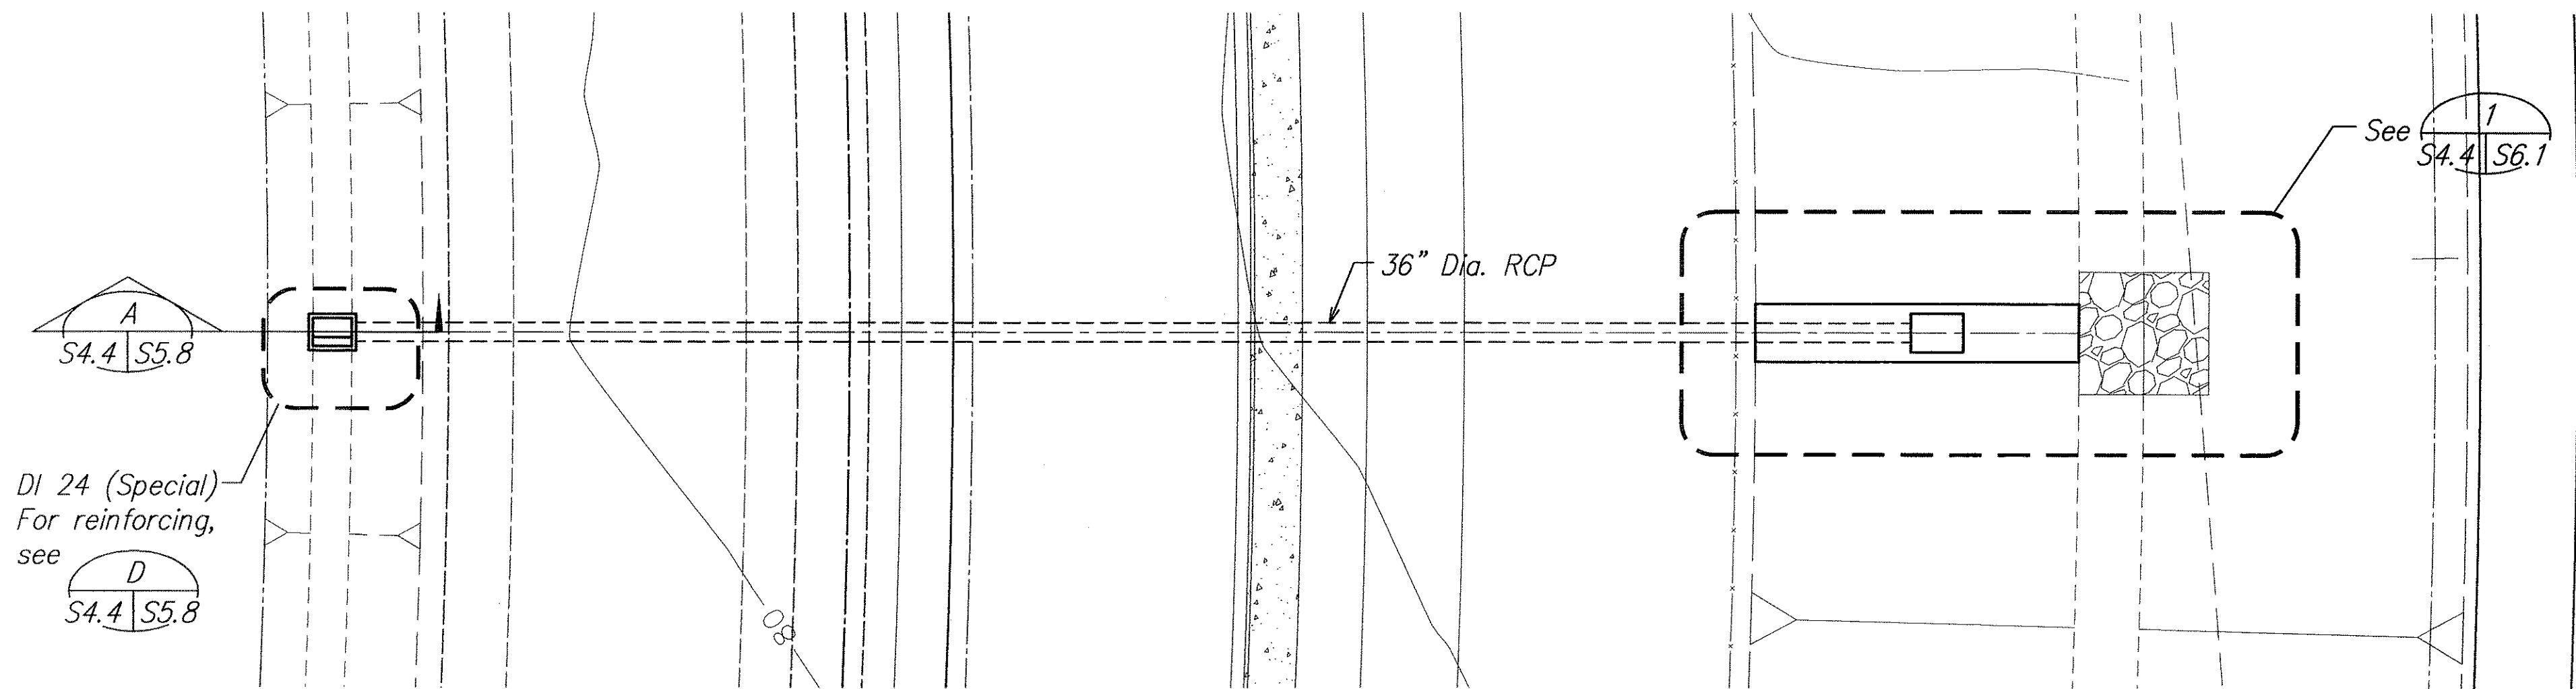

DRAIN CULVERT "R1" - LAYOUT PLAN
SCALE: 1" = 20'

ORIGINAL PLAN	SURVEY PLOTTED BY	DATE
NOTE BOOK	DRAWN BY	"
No.	DESIGNED BY	"
	QUANTITIES BY	"
	CHECKED BY	"

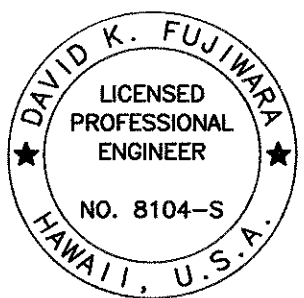

THIS WORK WAS PREPARED BY
ME OR UNDER MY SUPERVISION.

David K. Fujimura
SIGNATURE EXPIRATION DATE OF THE LICENSE 4-30-06

STATE OF HAWAII
DEPARTMENT OF TRANSPORTATION
HIGHWAYS DIVISION


DRAIN CULVERT "R1"
LAYOUT PLAN

North-South Road
Phase 1A
F.A.I. Proj. No. STP-8930(1)


Scale: As Noted Date: Dec. 22, 2004

SHEET No. S4.4 OF 43 SHEETS


FED. ROAD DIST. NO.	STATE	FED. AID PROJ. NO.	FISCAL YEAR	SHEET NO.	TOTAL SHEETS
HAWAII	HAW.	STP-8930(1)	2005	ADD. 91	144

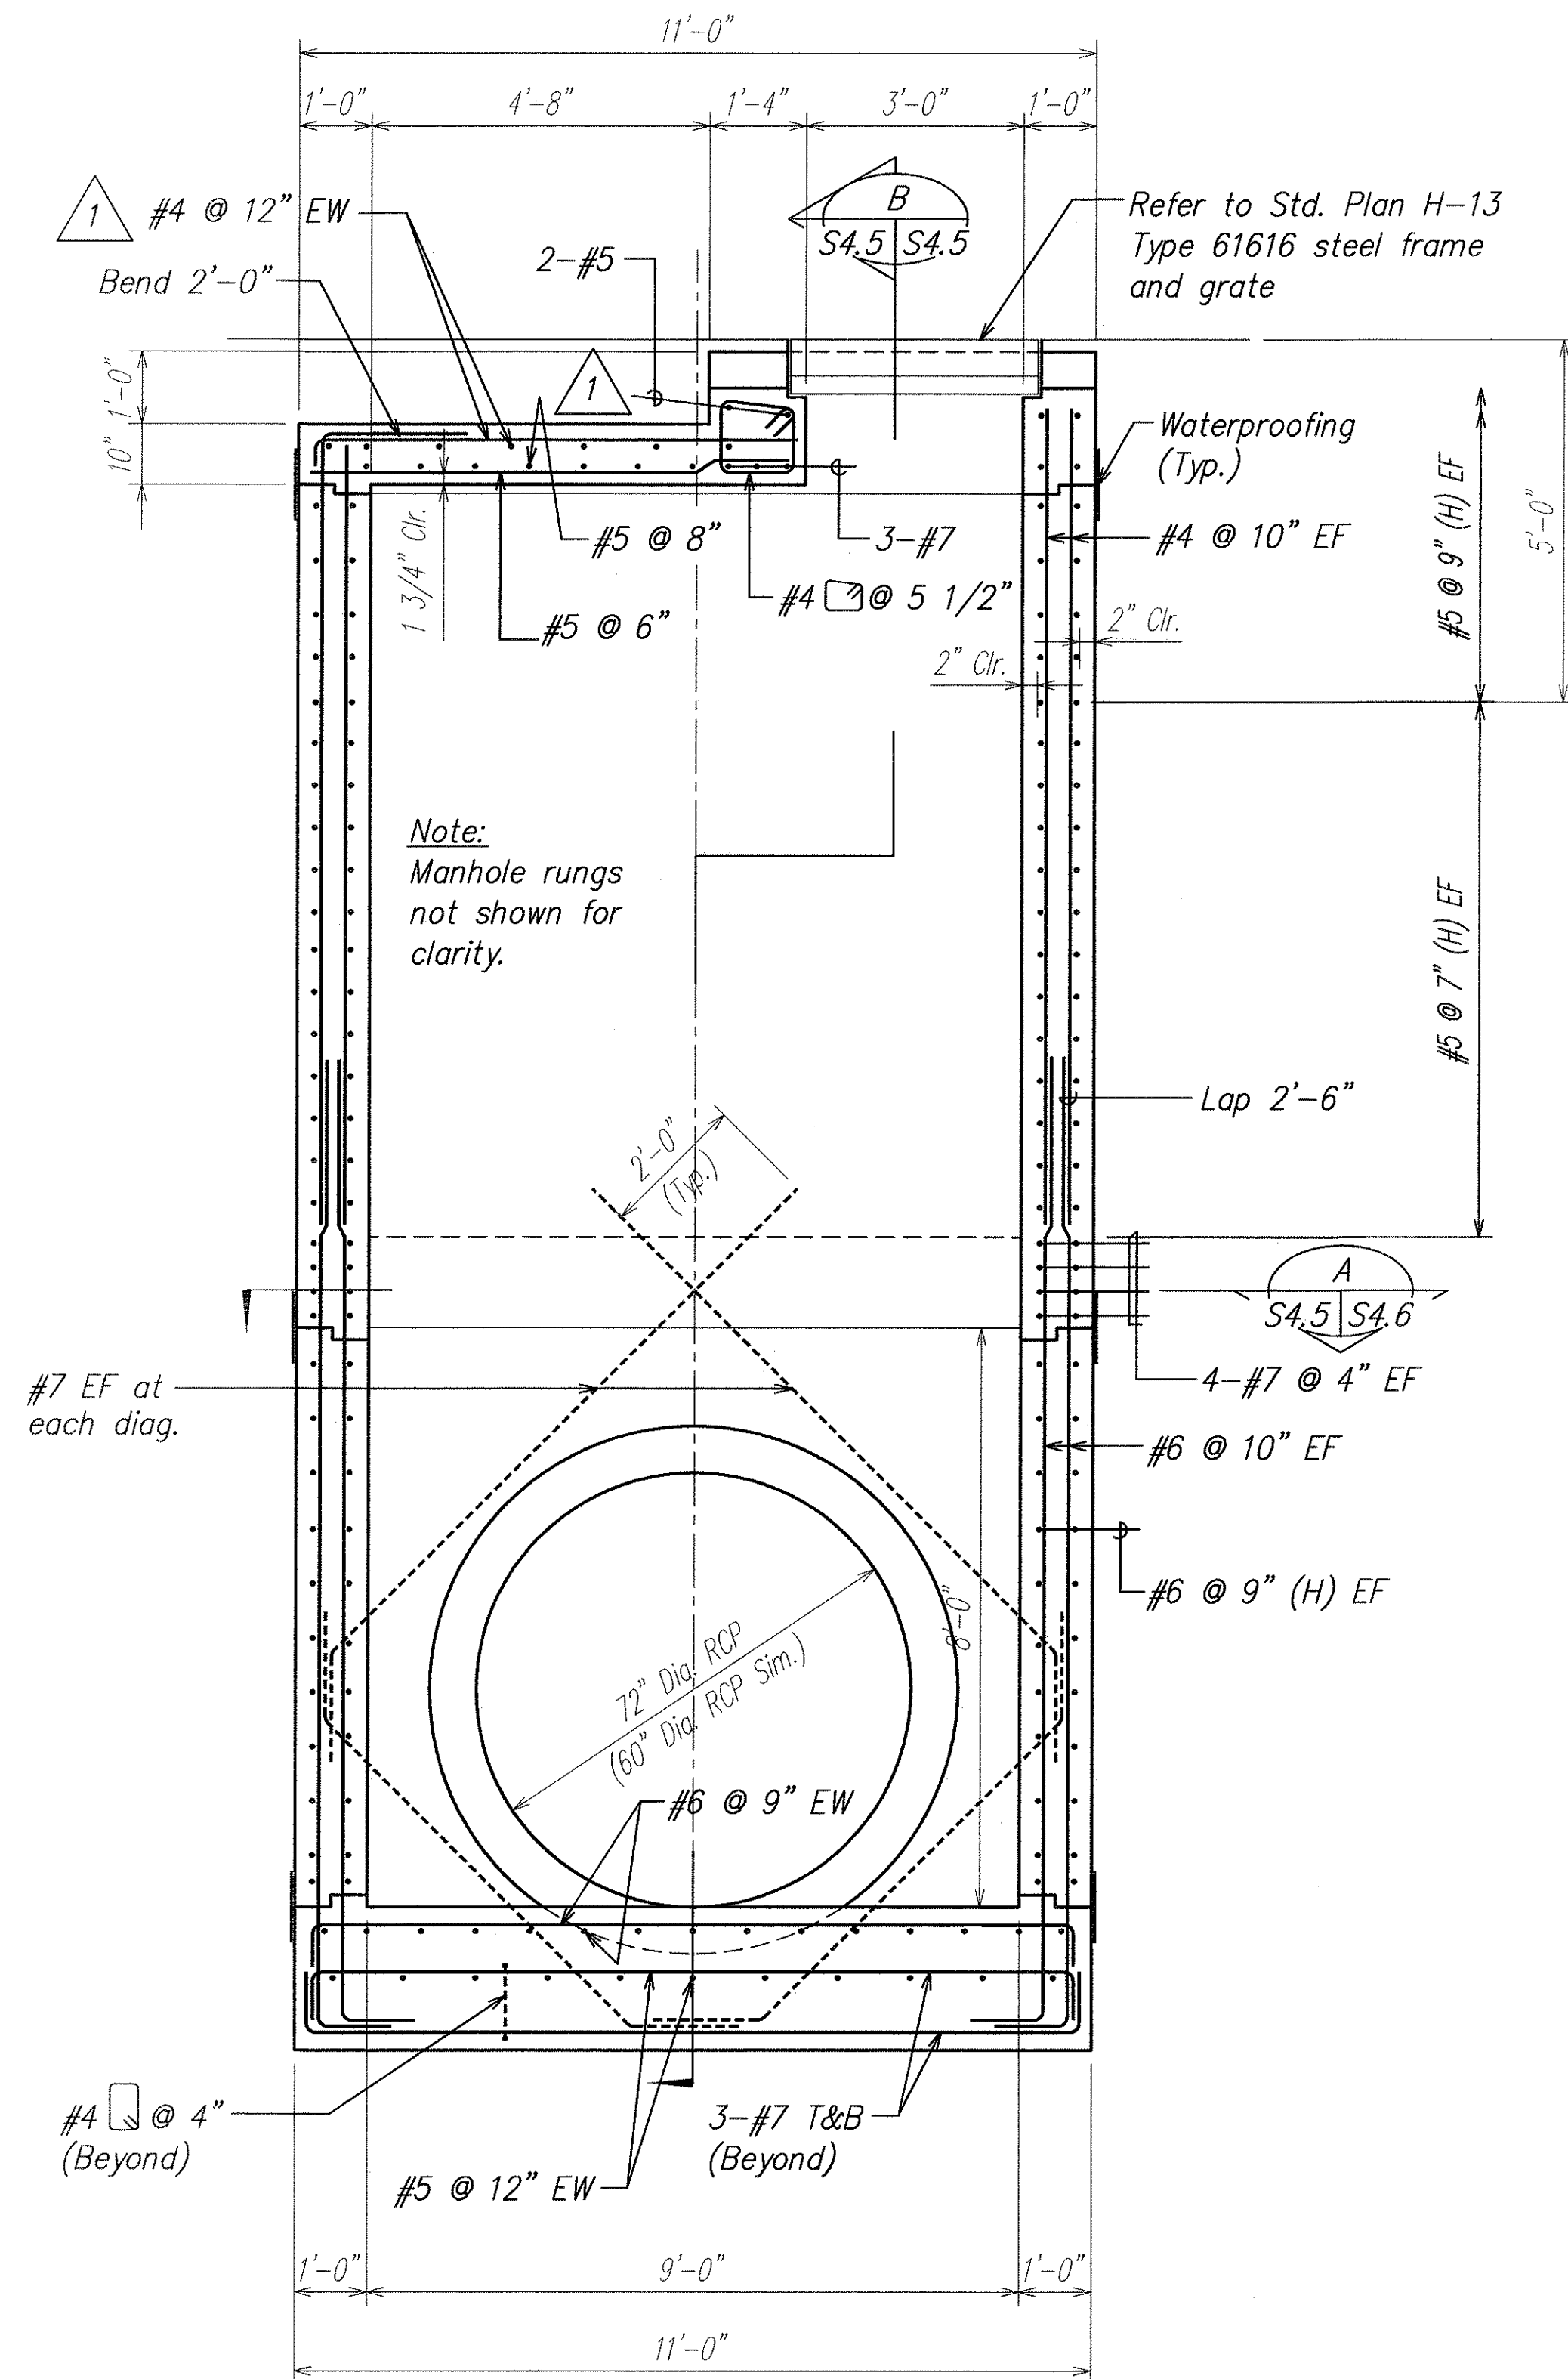

DRAIN CULVERT "G" - REINF. SECTION
(DRAIN CULVERT "E" AND "F" SIMILAR) A
SCALE: 1/2" = 1'-0" S4.1, S4.2, S4.3, S4.5 S4.5

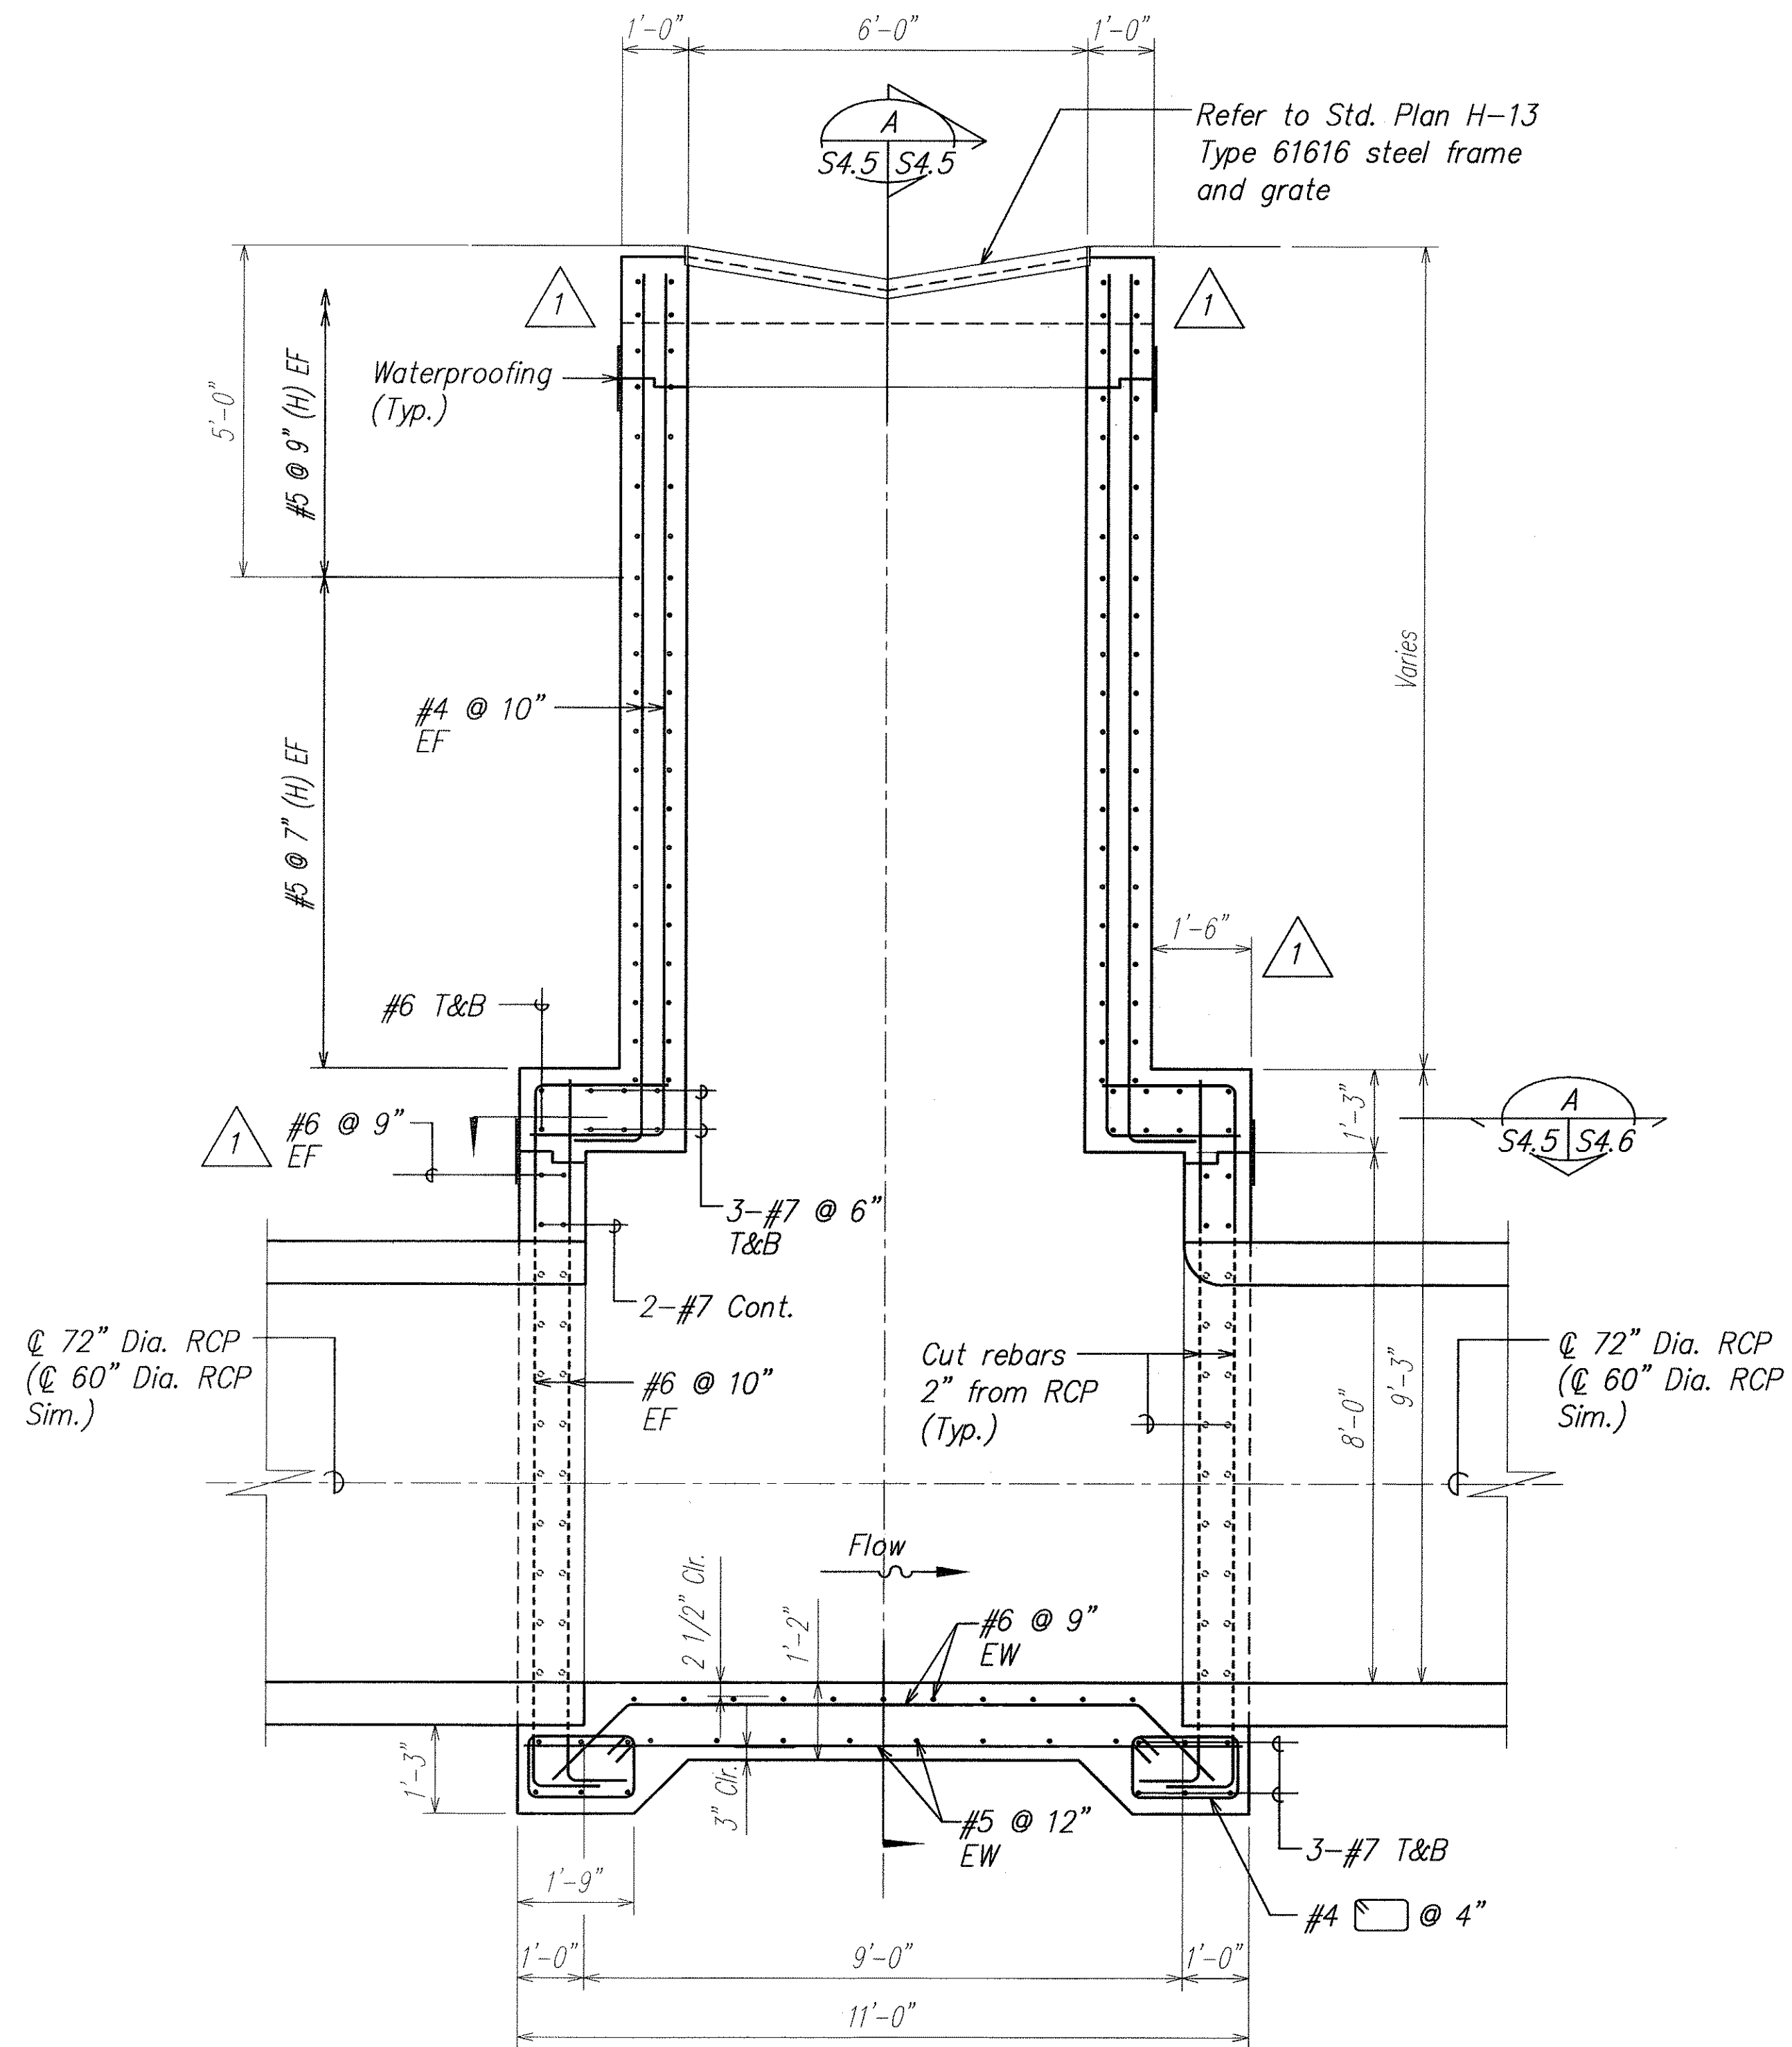

DRAIN CULVERT "G" - REINF. SECTION
(DRAIN CULVERT "E" AND "F" SIMILAR) B
SCALE: 1/2" = 1'-0" S4.1, S4.2, S4.3, S4.5 S4.5

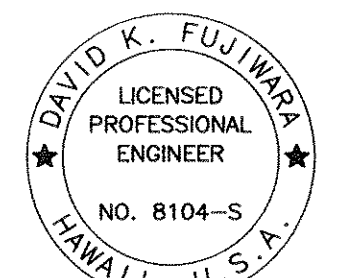

THIS WORK WAS PREPARED BY
ME OR UNDER MY SUPERVISION.

Signature: David K. Fujiwara
EXPIRATION DATE OF THE LICENSE: 4-30-06

STATE OF HAWAII
DEPARTMENT OF TRANSPORTATION
HIGHWAYS DIVISION

DRAIN CULVERT "E", "F" AND "G"
SECTIONS


North-South Road
Phase 1A
F.A.I. Proj. No. STP-8930(1)

Scale: As Noted Date: Dec. 22, 2004


SHEET No. S4.5 OF 43 SHEETS

1/18/05	Added Dimension, Added Reinforcing and Clarification
DATE	REVISION


FED. ROAD DIST. NO.	STATE	FED. AID PROJ. NO.	FISCAL YEAR	SHEET NO.	TOTAL SHEETS
HAWAII	HAW.	STP-8930(1)	2005	ADD. 92	144

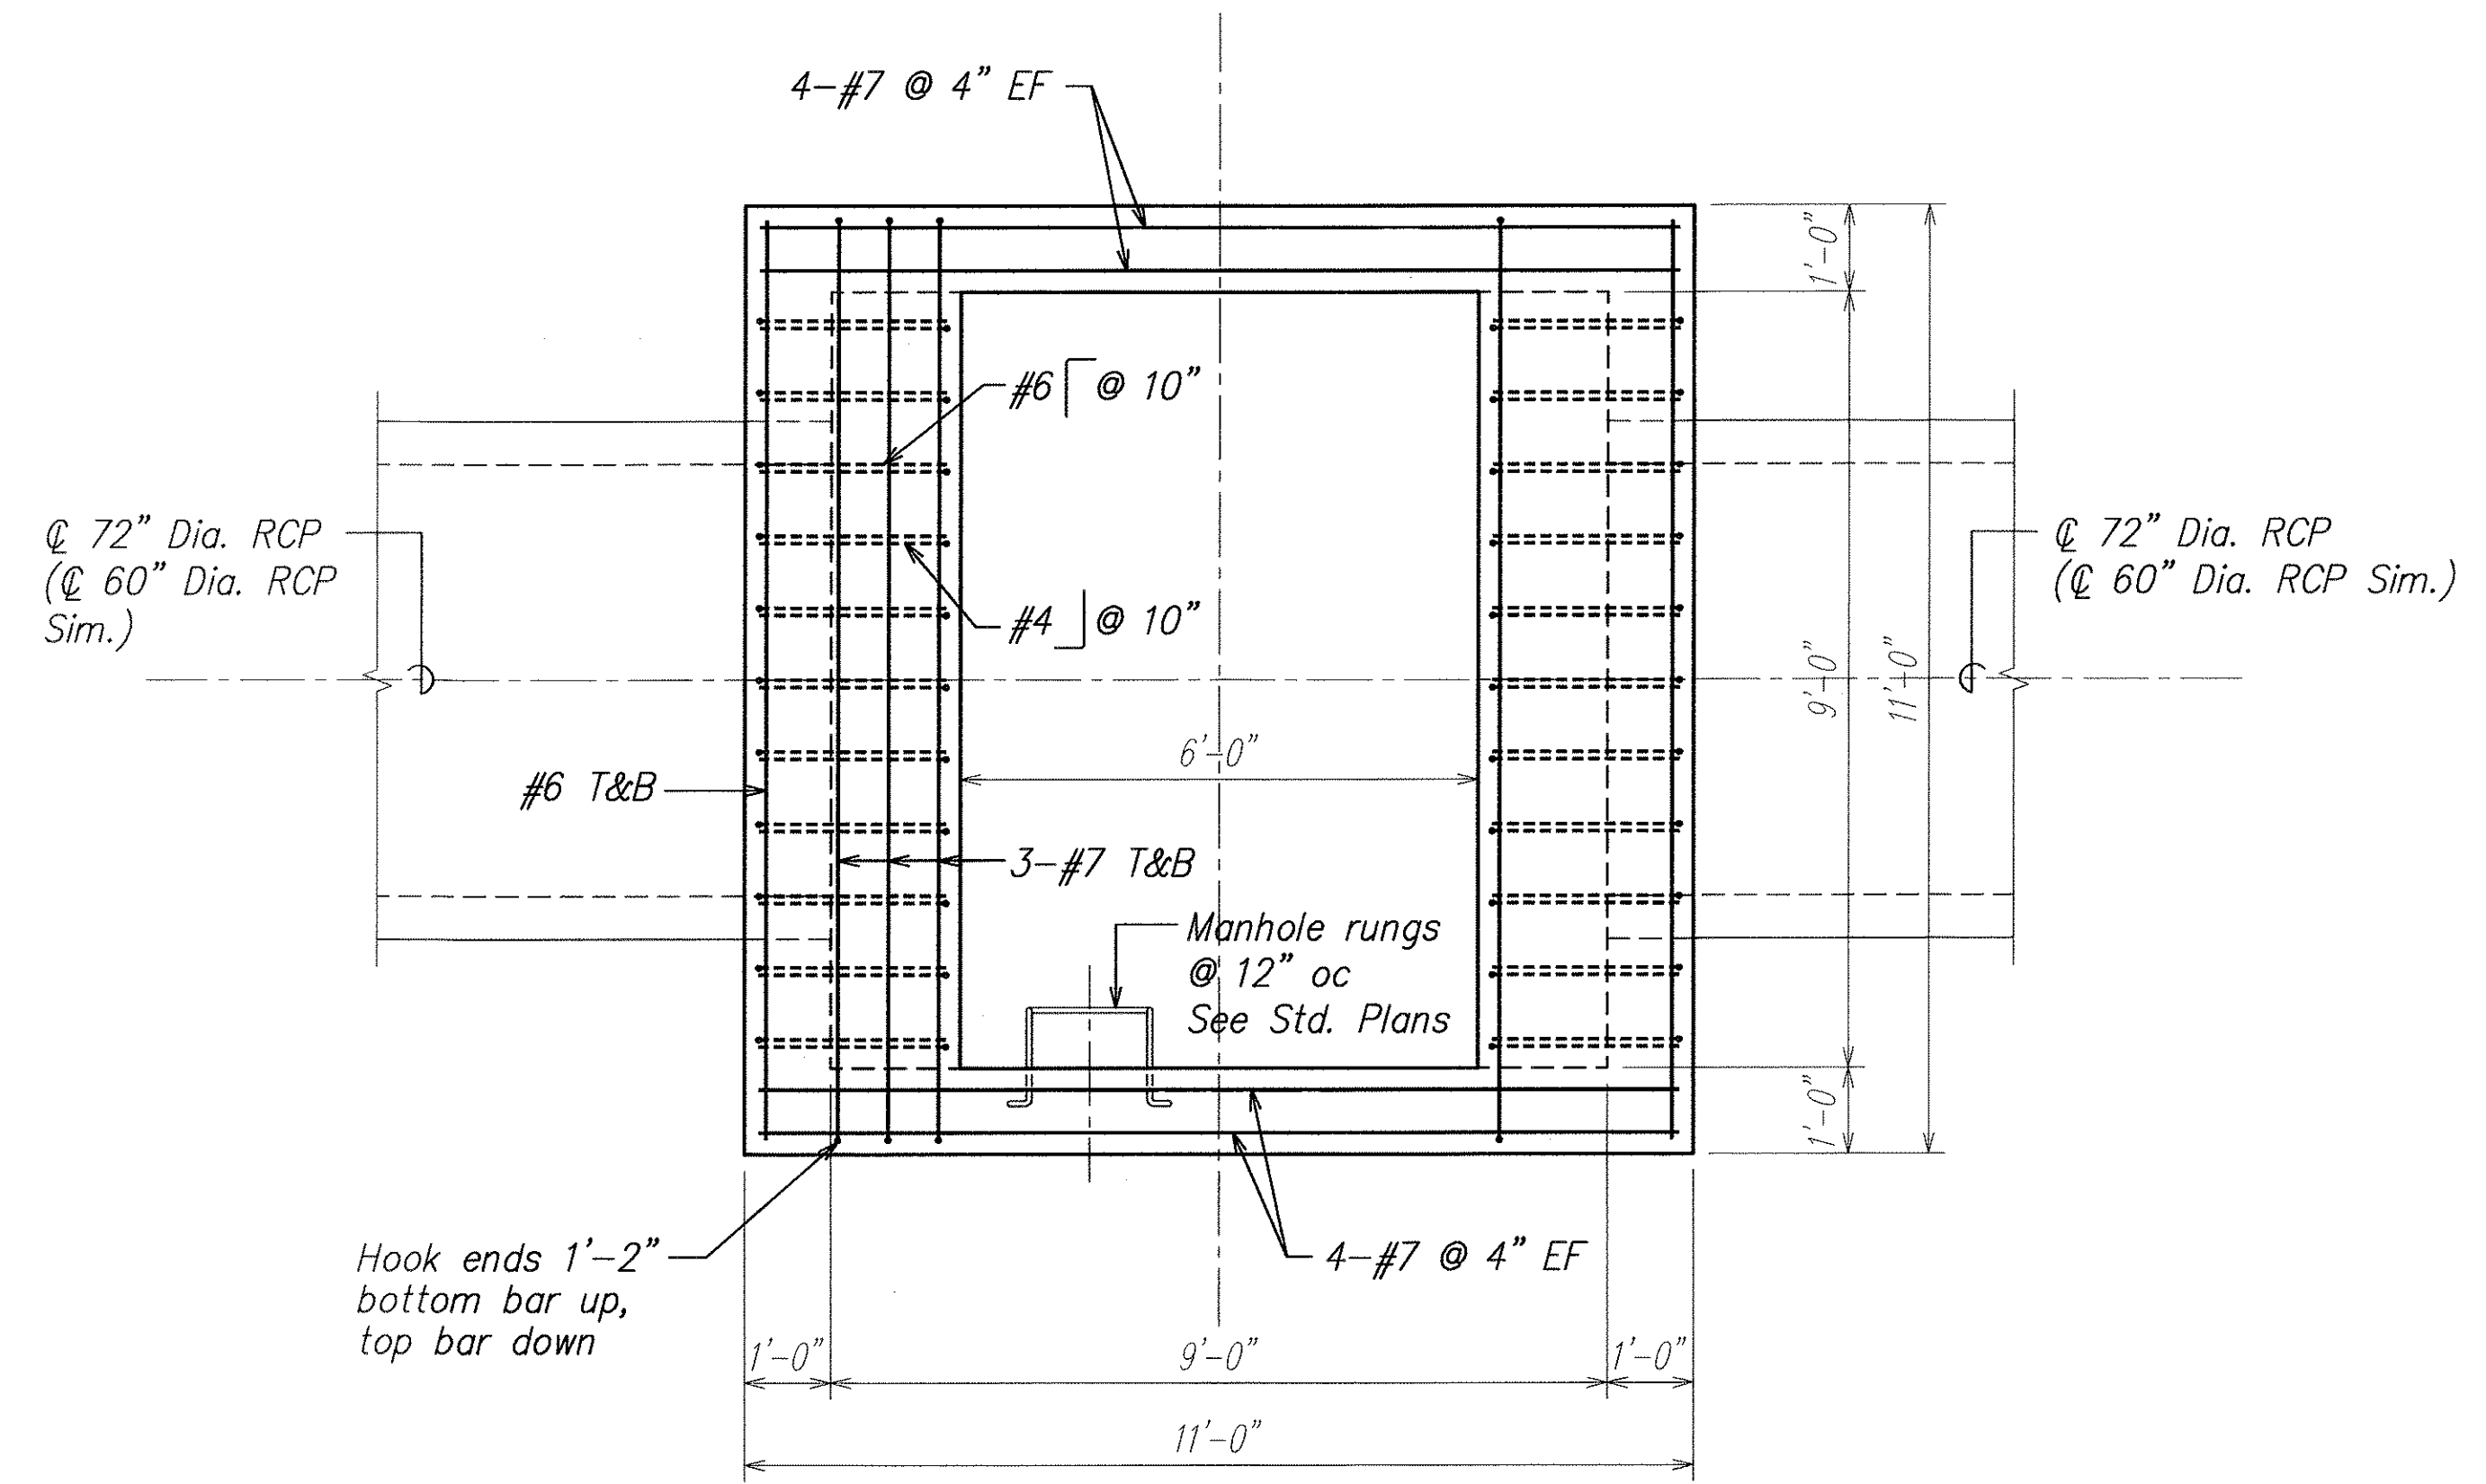


SECTION A
SCALE: 1/2" = 1'-0" S4.1, S4.2, S4.3, S4.5, S4.6

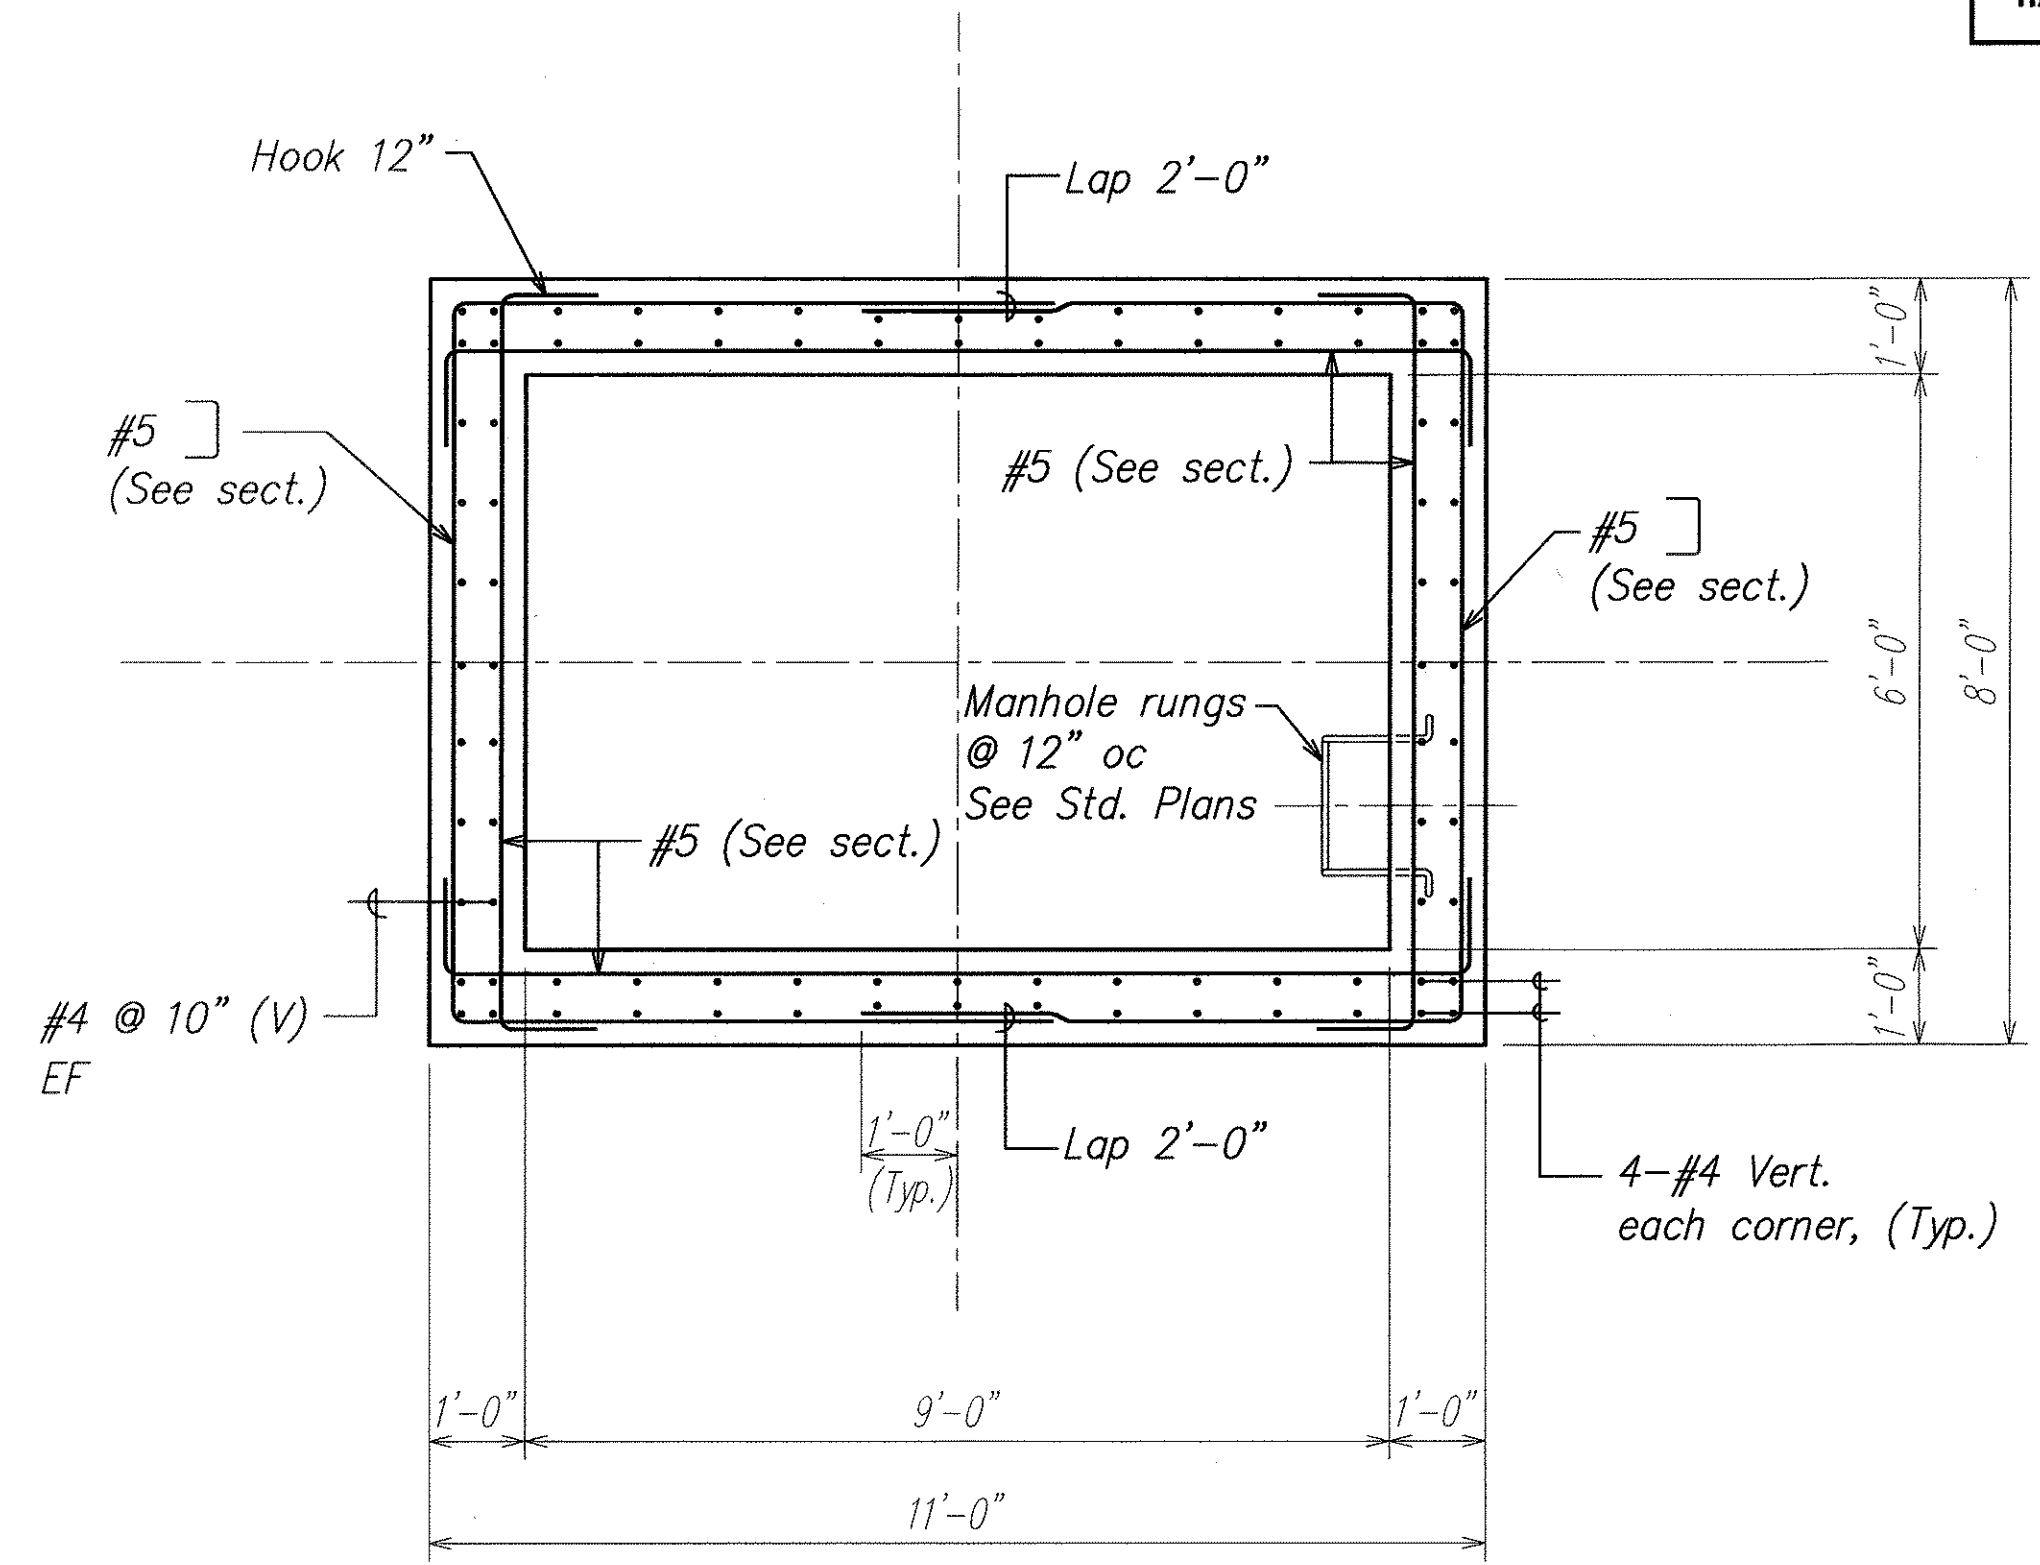

SECTION B
SCALE: 1/2" = 1'-0" S4.1, S4.2, S4.3, S4.6

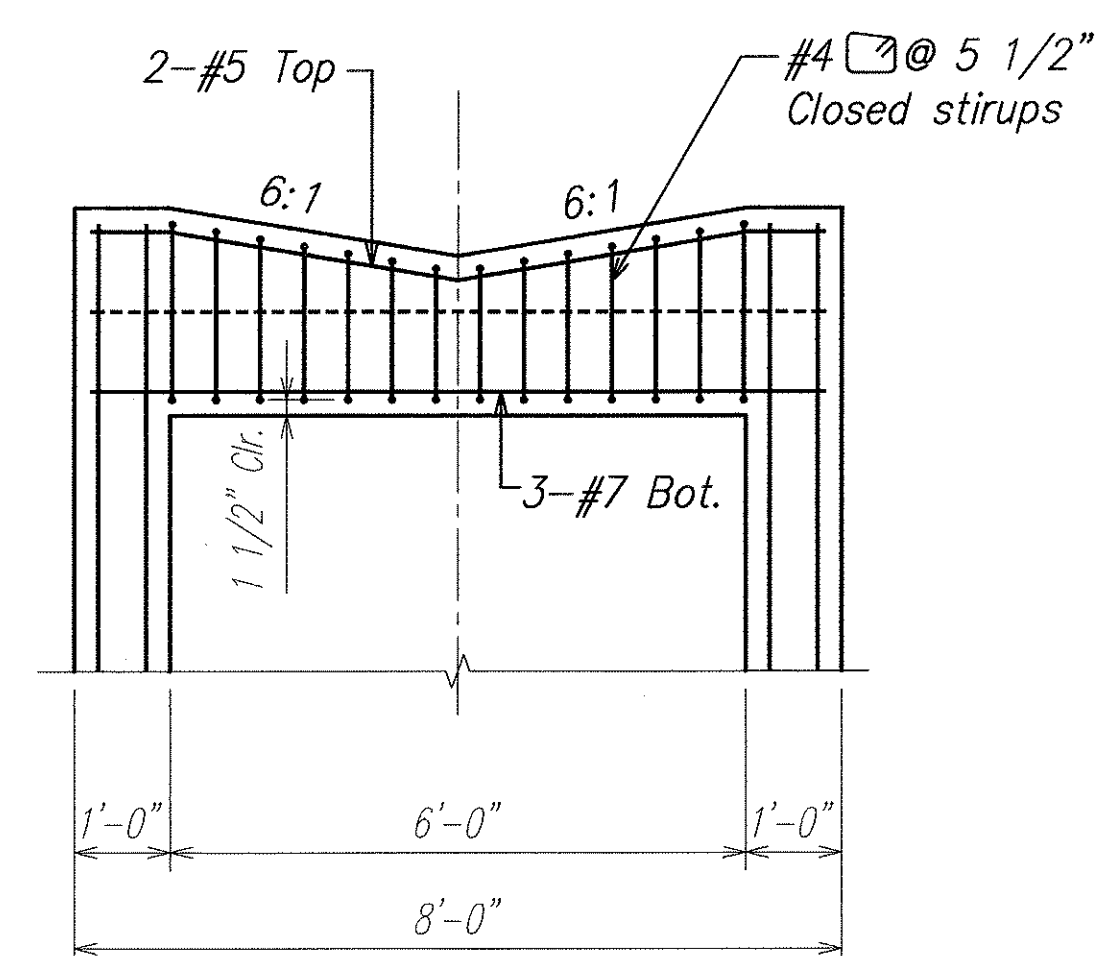


SECTION AT BEAM REINF. C
SCALE: 1/2" = 1'-0" S4.6, S4.6

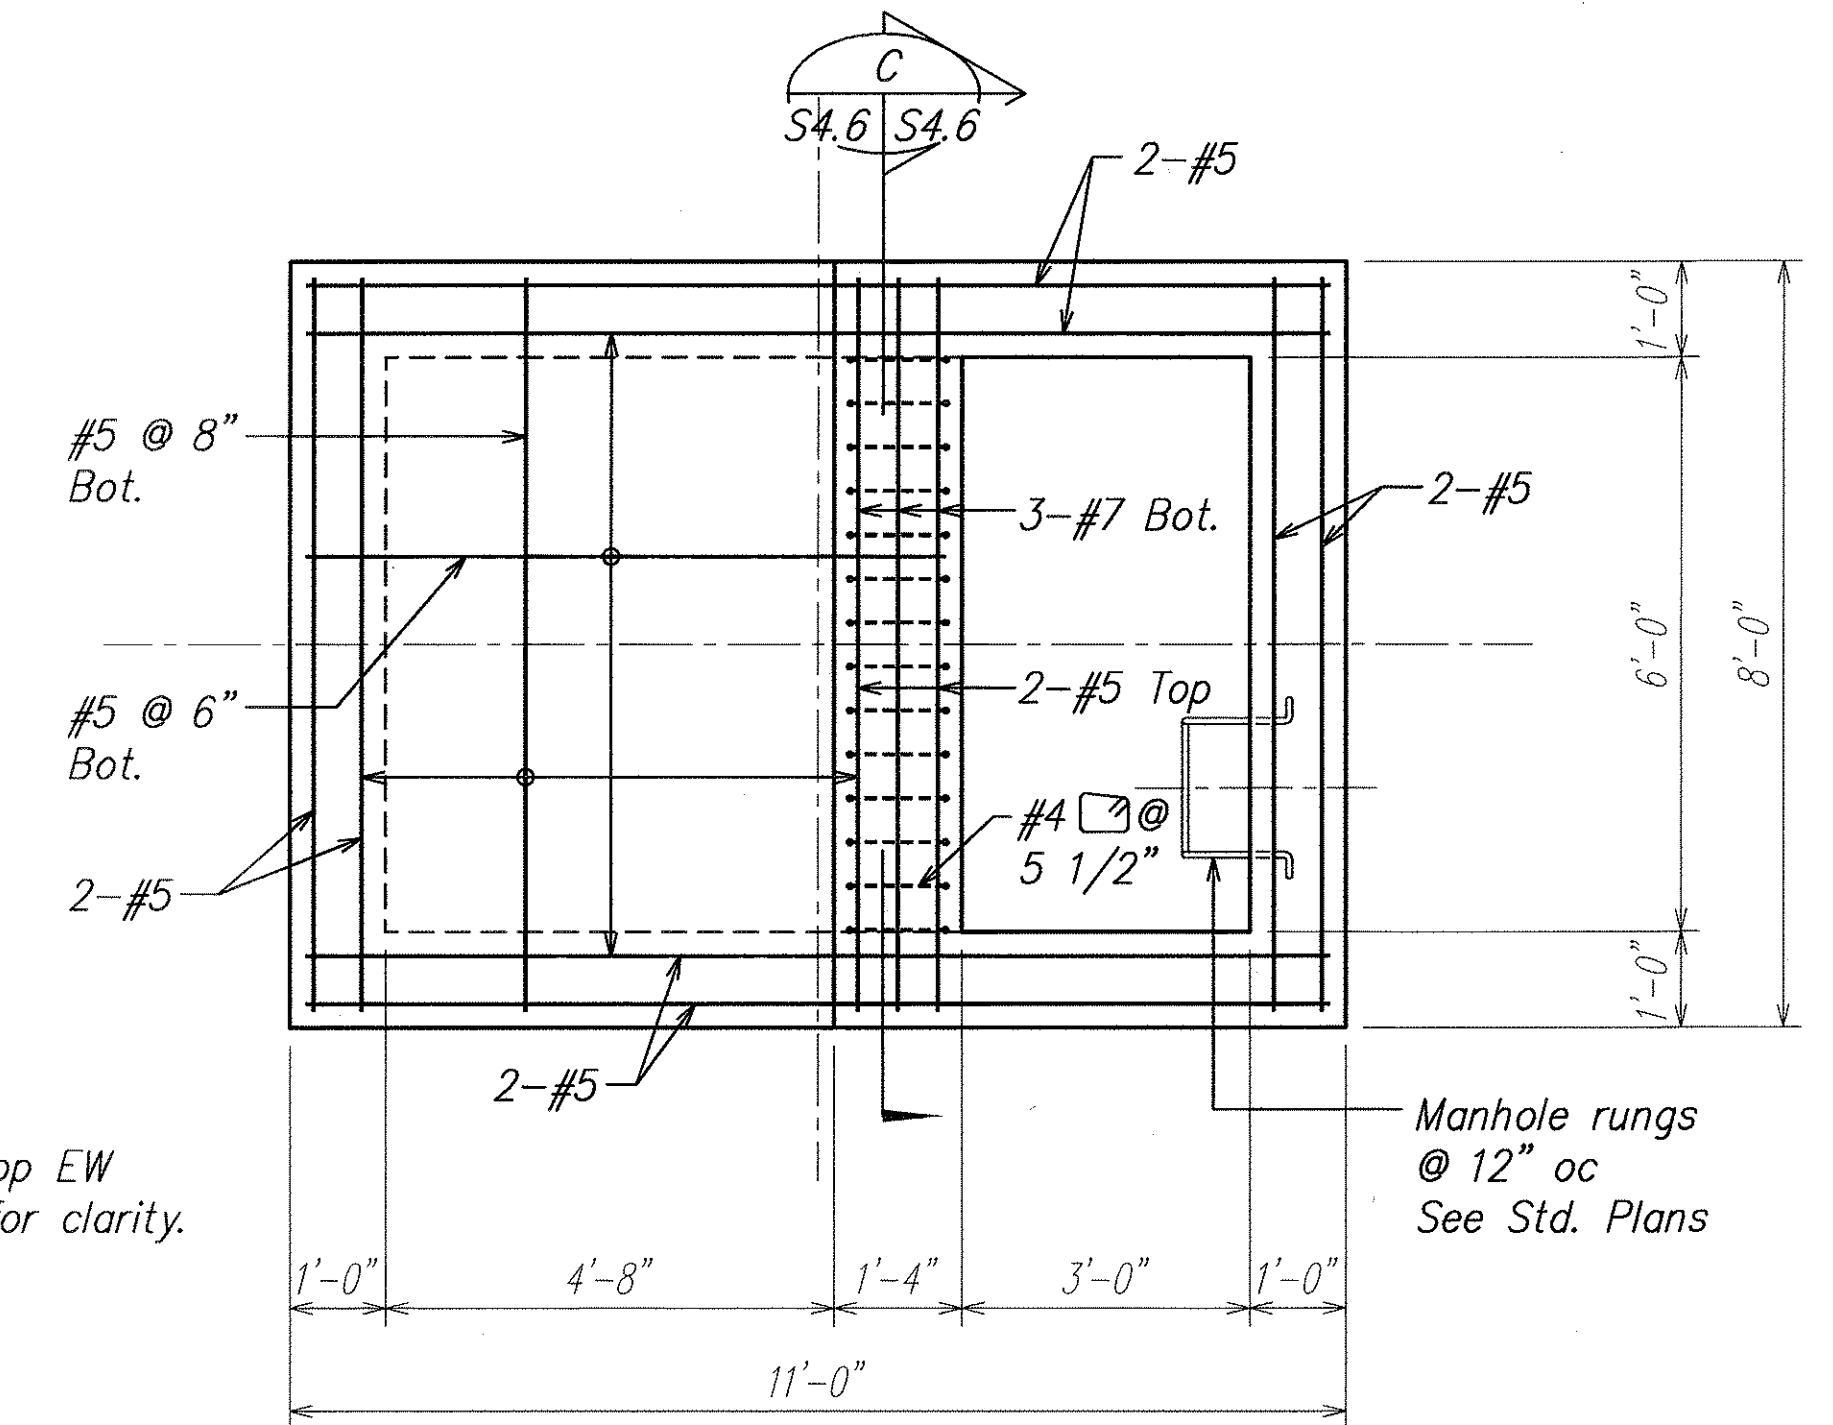

SECTION D
SCALE: 1/2" = 1'-0" S4.1, S4.2, S4.3, S4.6

Note:
#4 @ 12" Top EW
not shown for clarity.

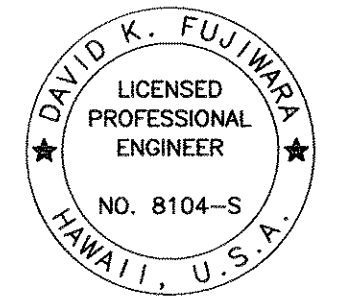

THIS WORK WAS PREPARED BY ME OR UNDER MY SUPERVISION.
Signature: David K. Fujiwara
4-30-06
EXPIRATION DATE OF THE LICENSE

DATE	REVISION
1/18/05	1 Added Note

STATE OF HAWAII
DEPARTMENT OF TRANSPORTATION
HIGHWAYS DIVISION

DRAIN CULVERT "E", "F" AND "G"
SECTIONS

North-South Road
Phase 1A
F.A.I. Proj. No. STP-8930(1)


Scale: As Noted Date: Dec. 22, 2004

SHEET No. S4.6 OF 43 SHEETS


ORIGINAL PLAN	SURVEY PLOTTED BY	DATE
NOTE BOOK	DRAWN BY	
No.	DESIGNED BY	
	QUANTITIES BY	
	CHECKED BY	

C:\S-05\01-17-05 A301\NS-S406 ADD.dwg, 1/17/2005 1:04:19 PM, KSFrcp3, 1:1

FED. ROAD DIST. NO.	STATE	FED. AID PROJ. NO.	FISCAL YEAR	SHEET NO.	TOTAL SHEETS
HAWAII	HAW.	STP-8930(1)	2005	ADD. 93	144

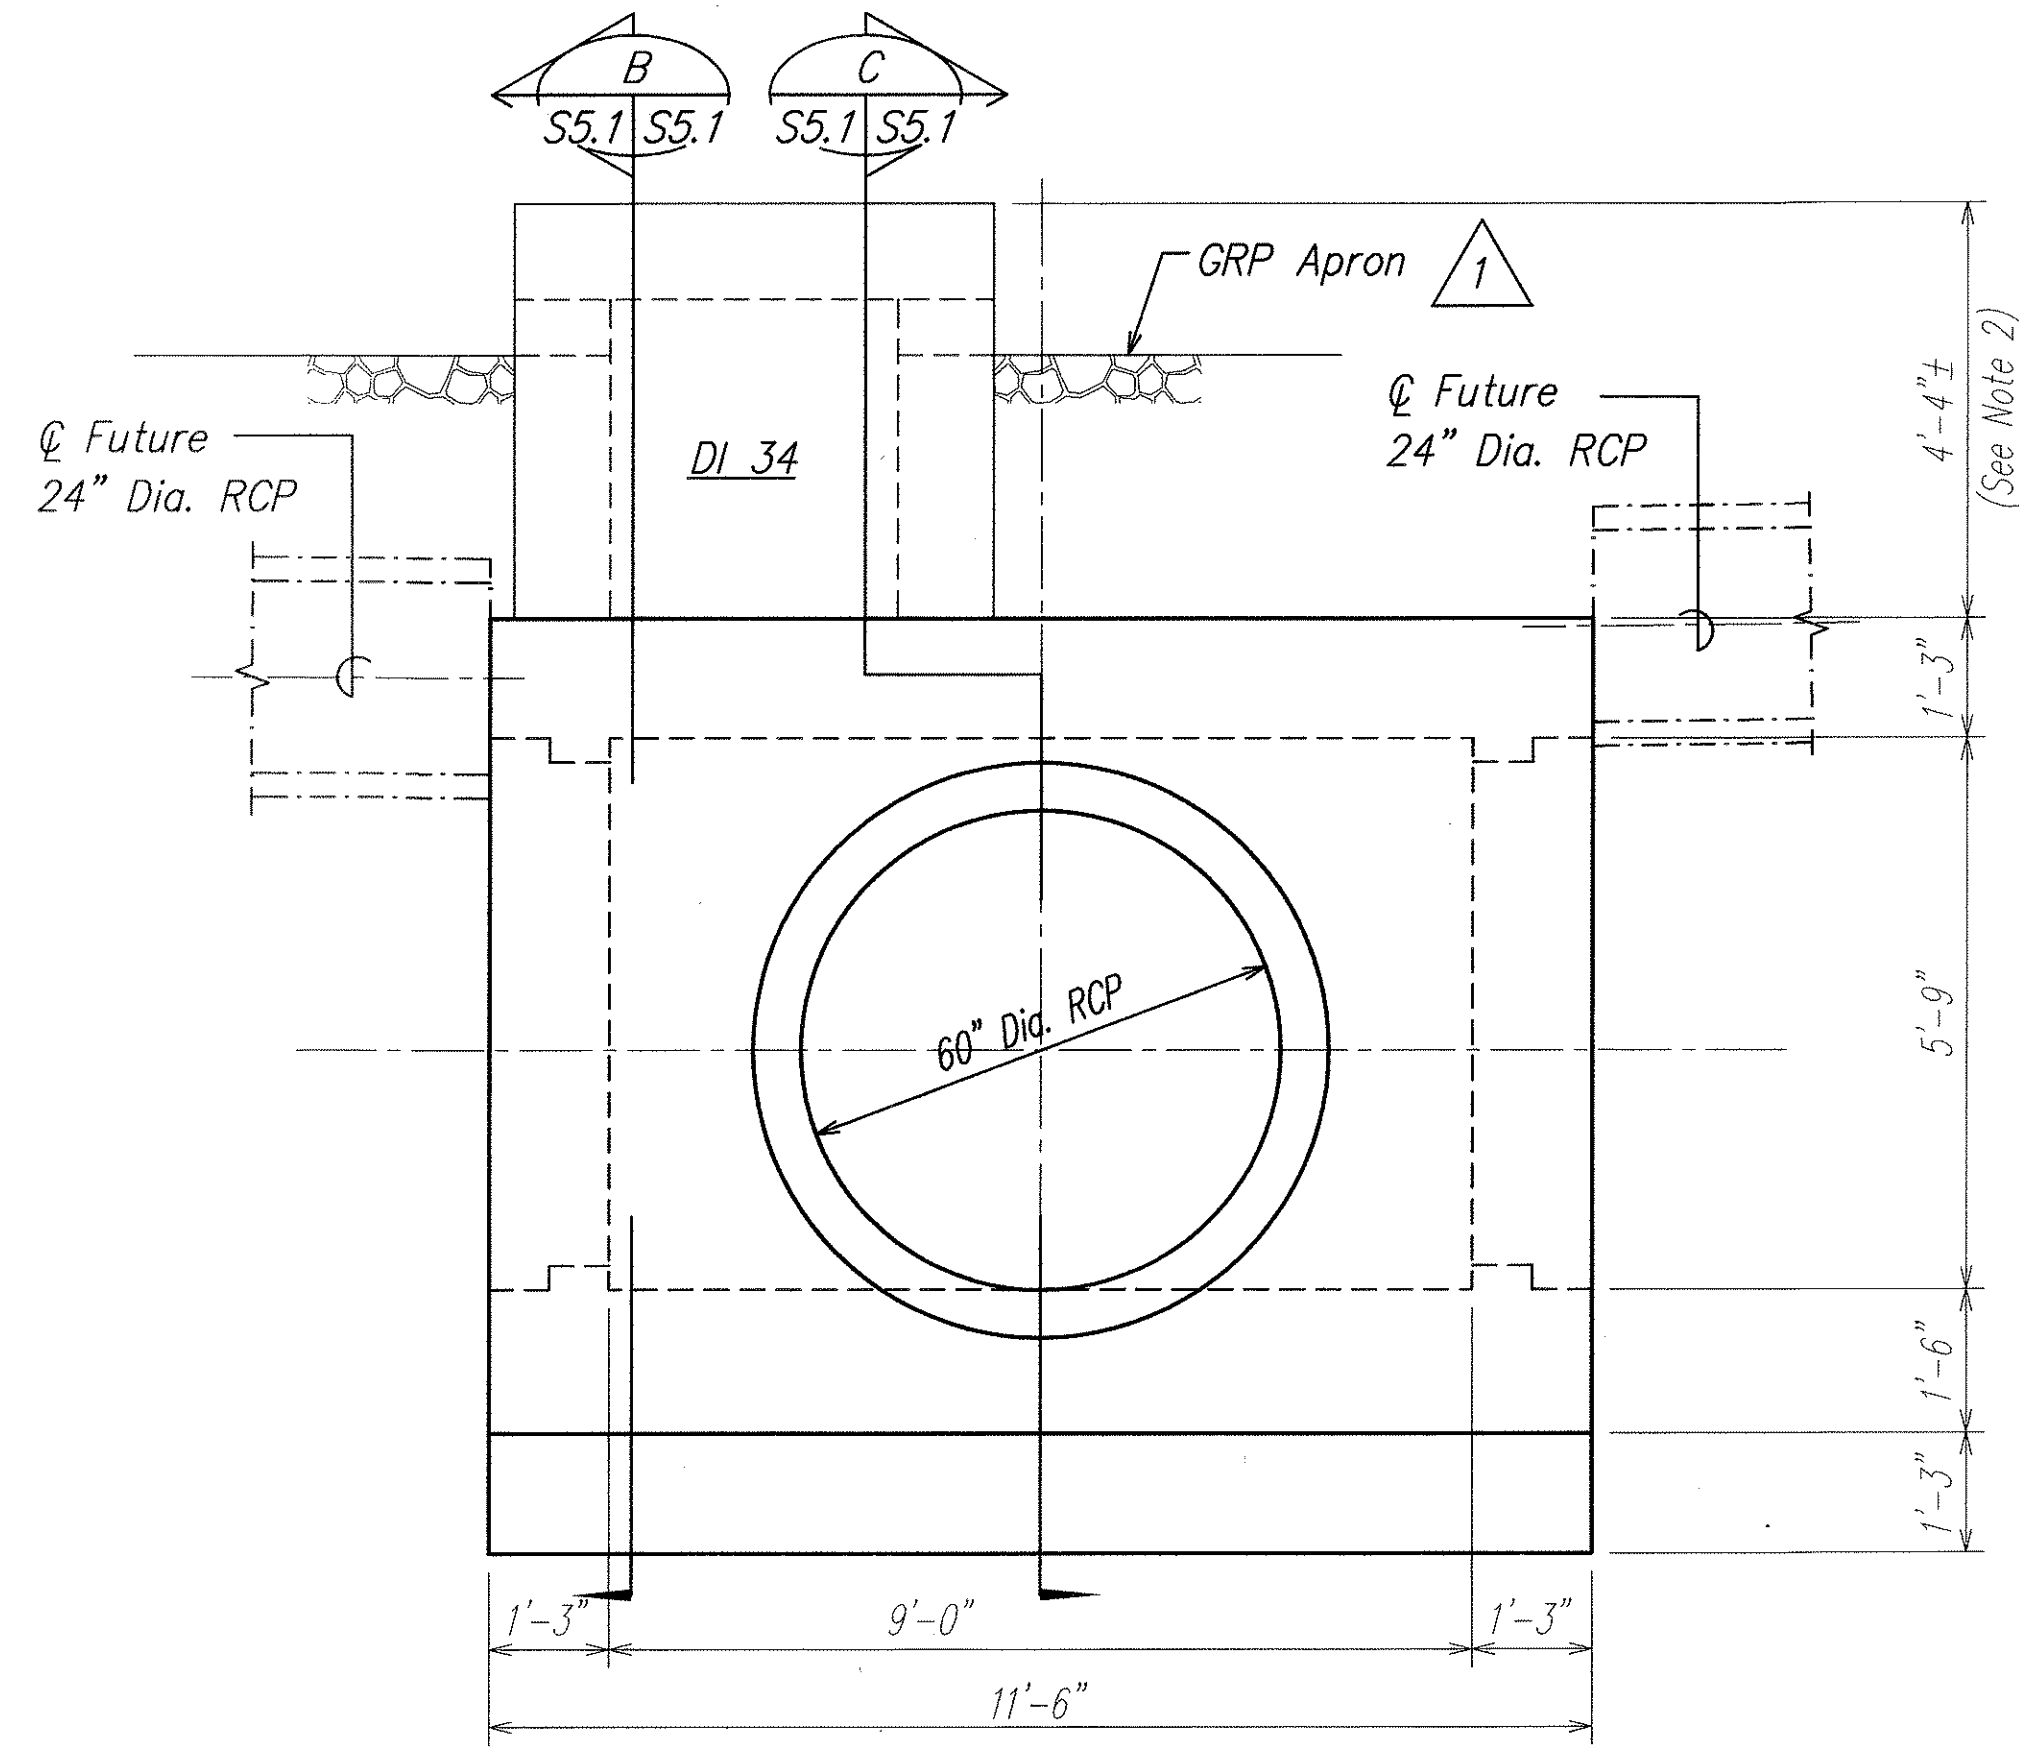


SECTION A
SCALE: 1/2" = 1'-0" S4.1 S5.1

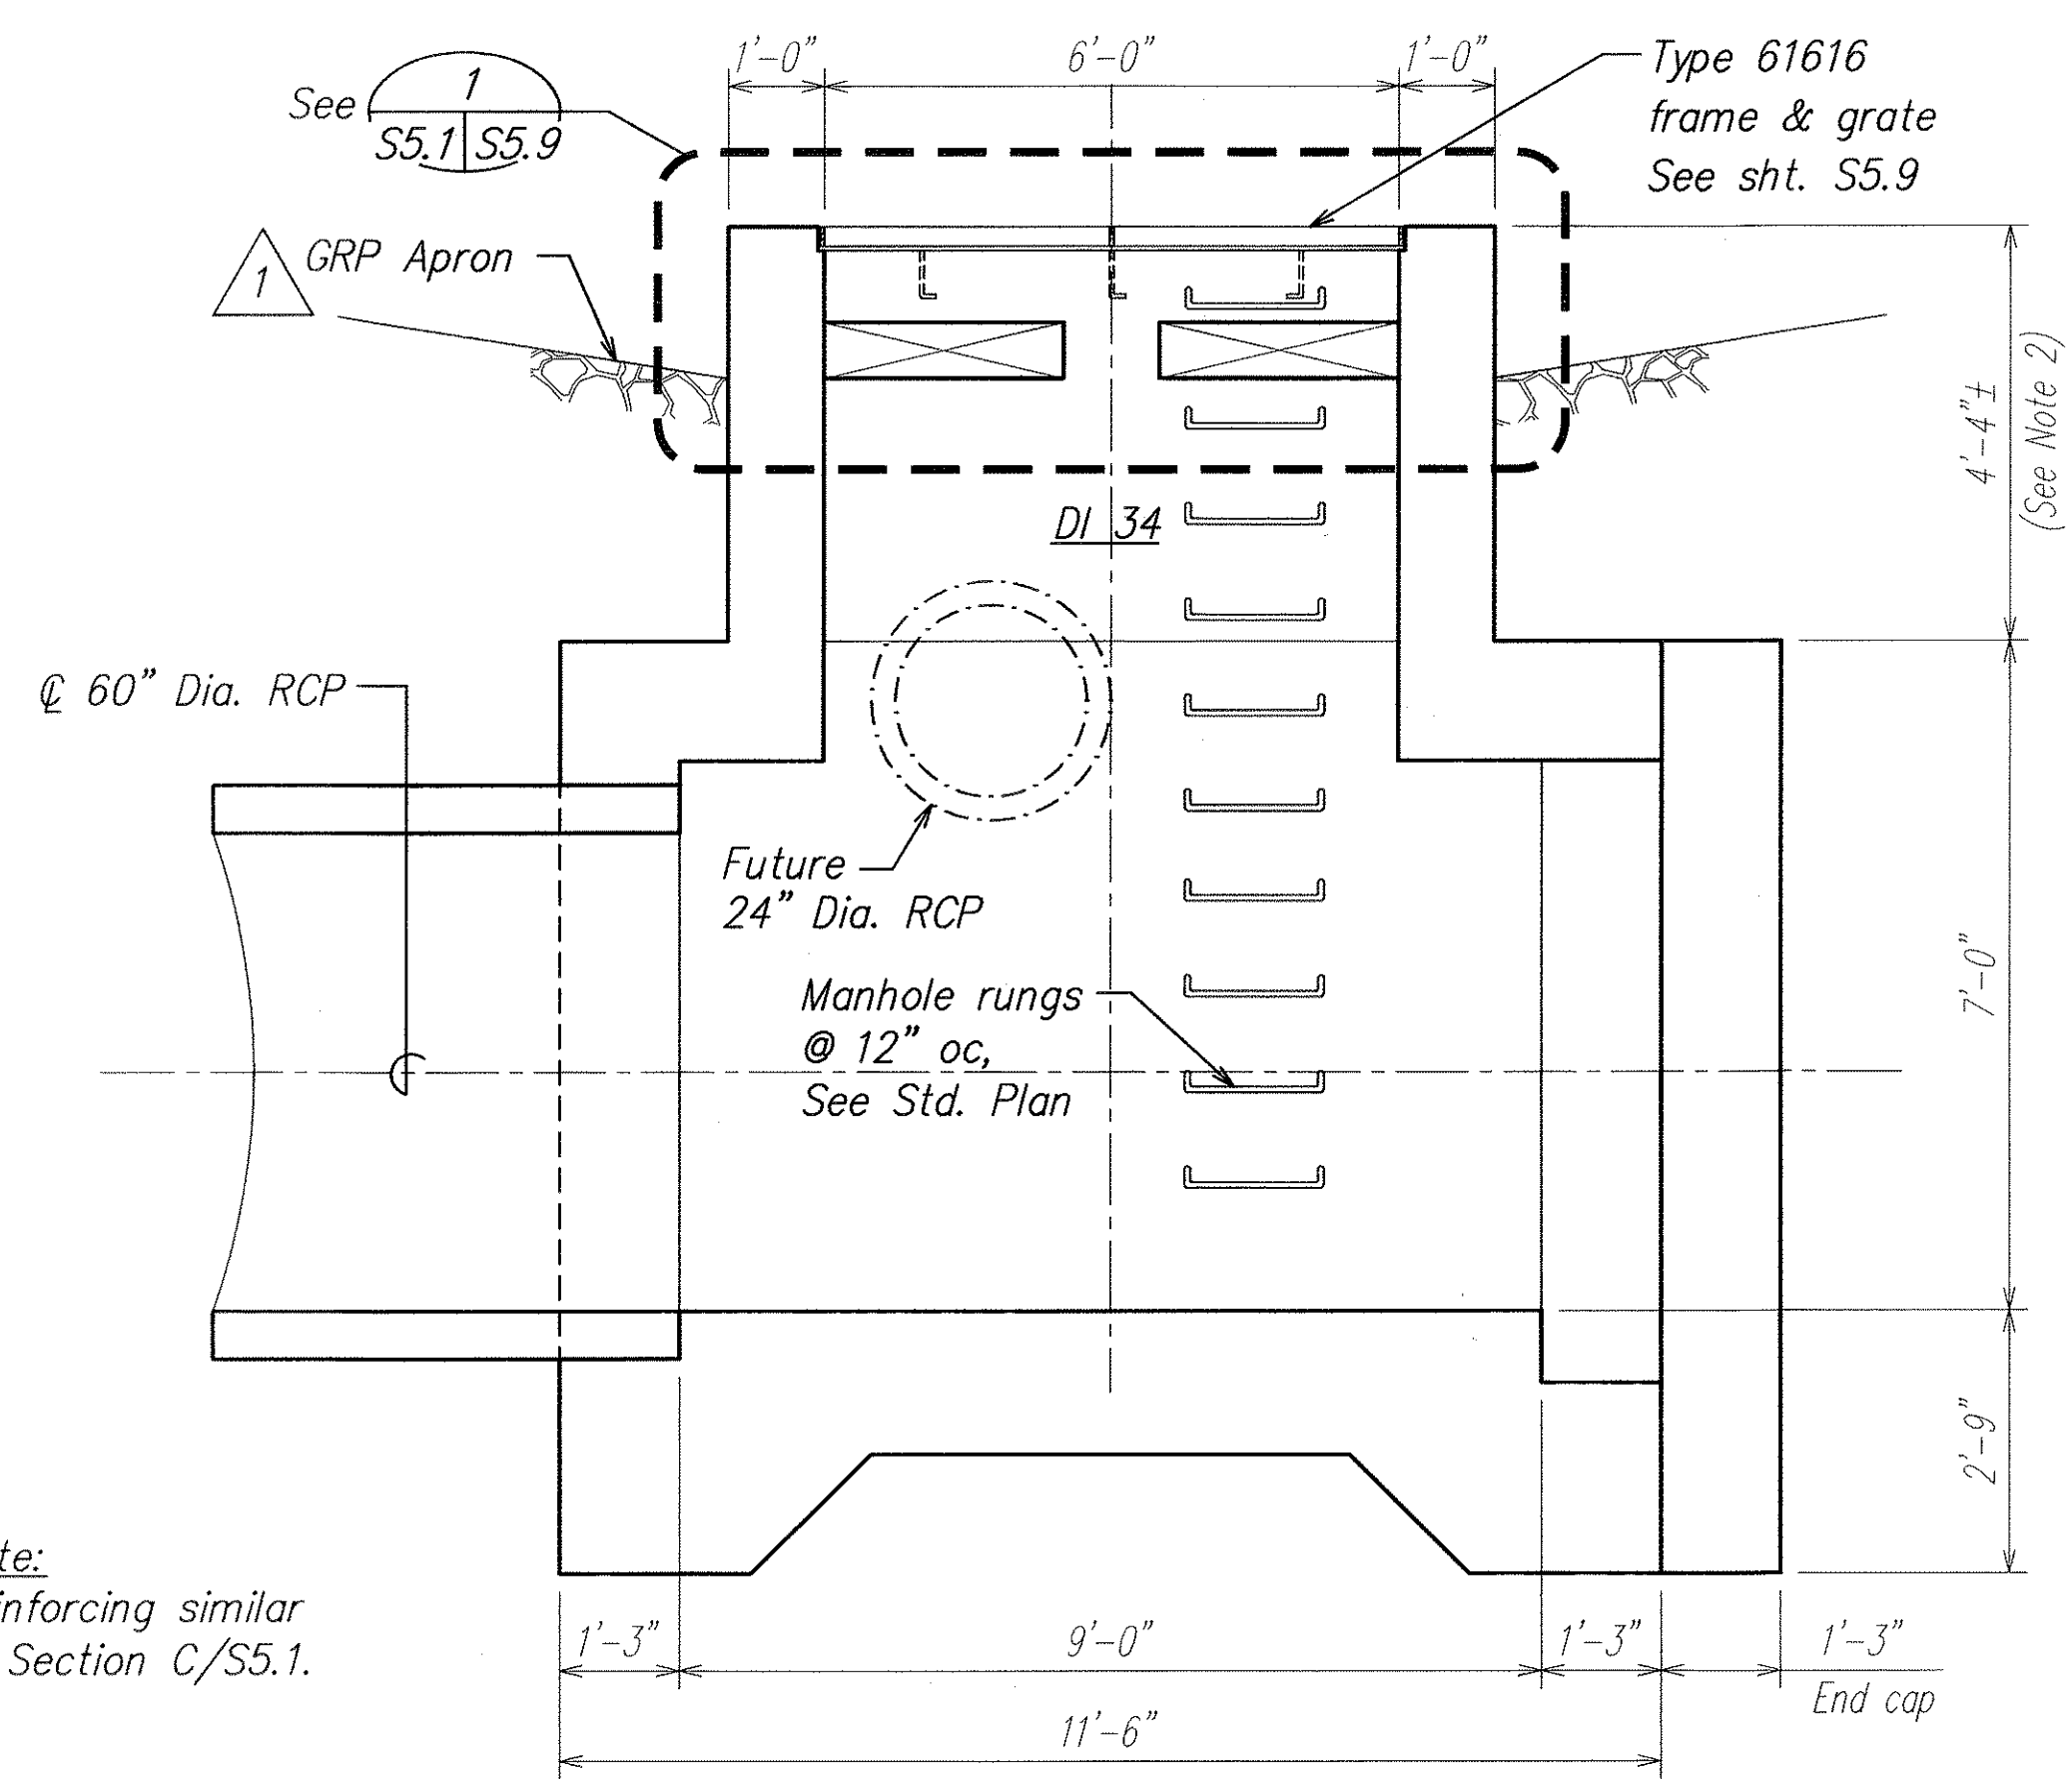


Note:
Reinforcing similar
to Section C/S5.1.

SECTION B
SCALE: 1/2" = 1'-0" S5.1 S5.1

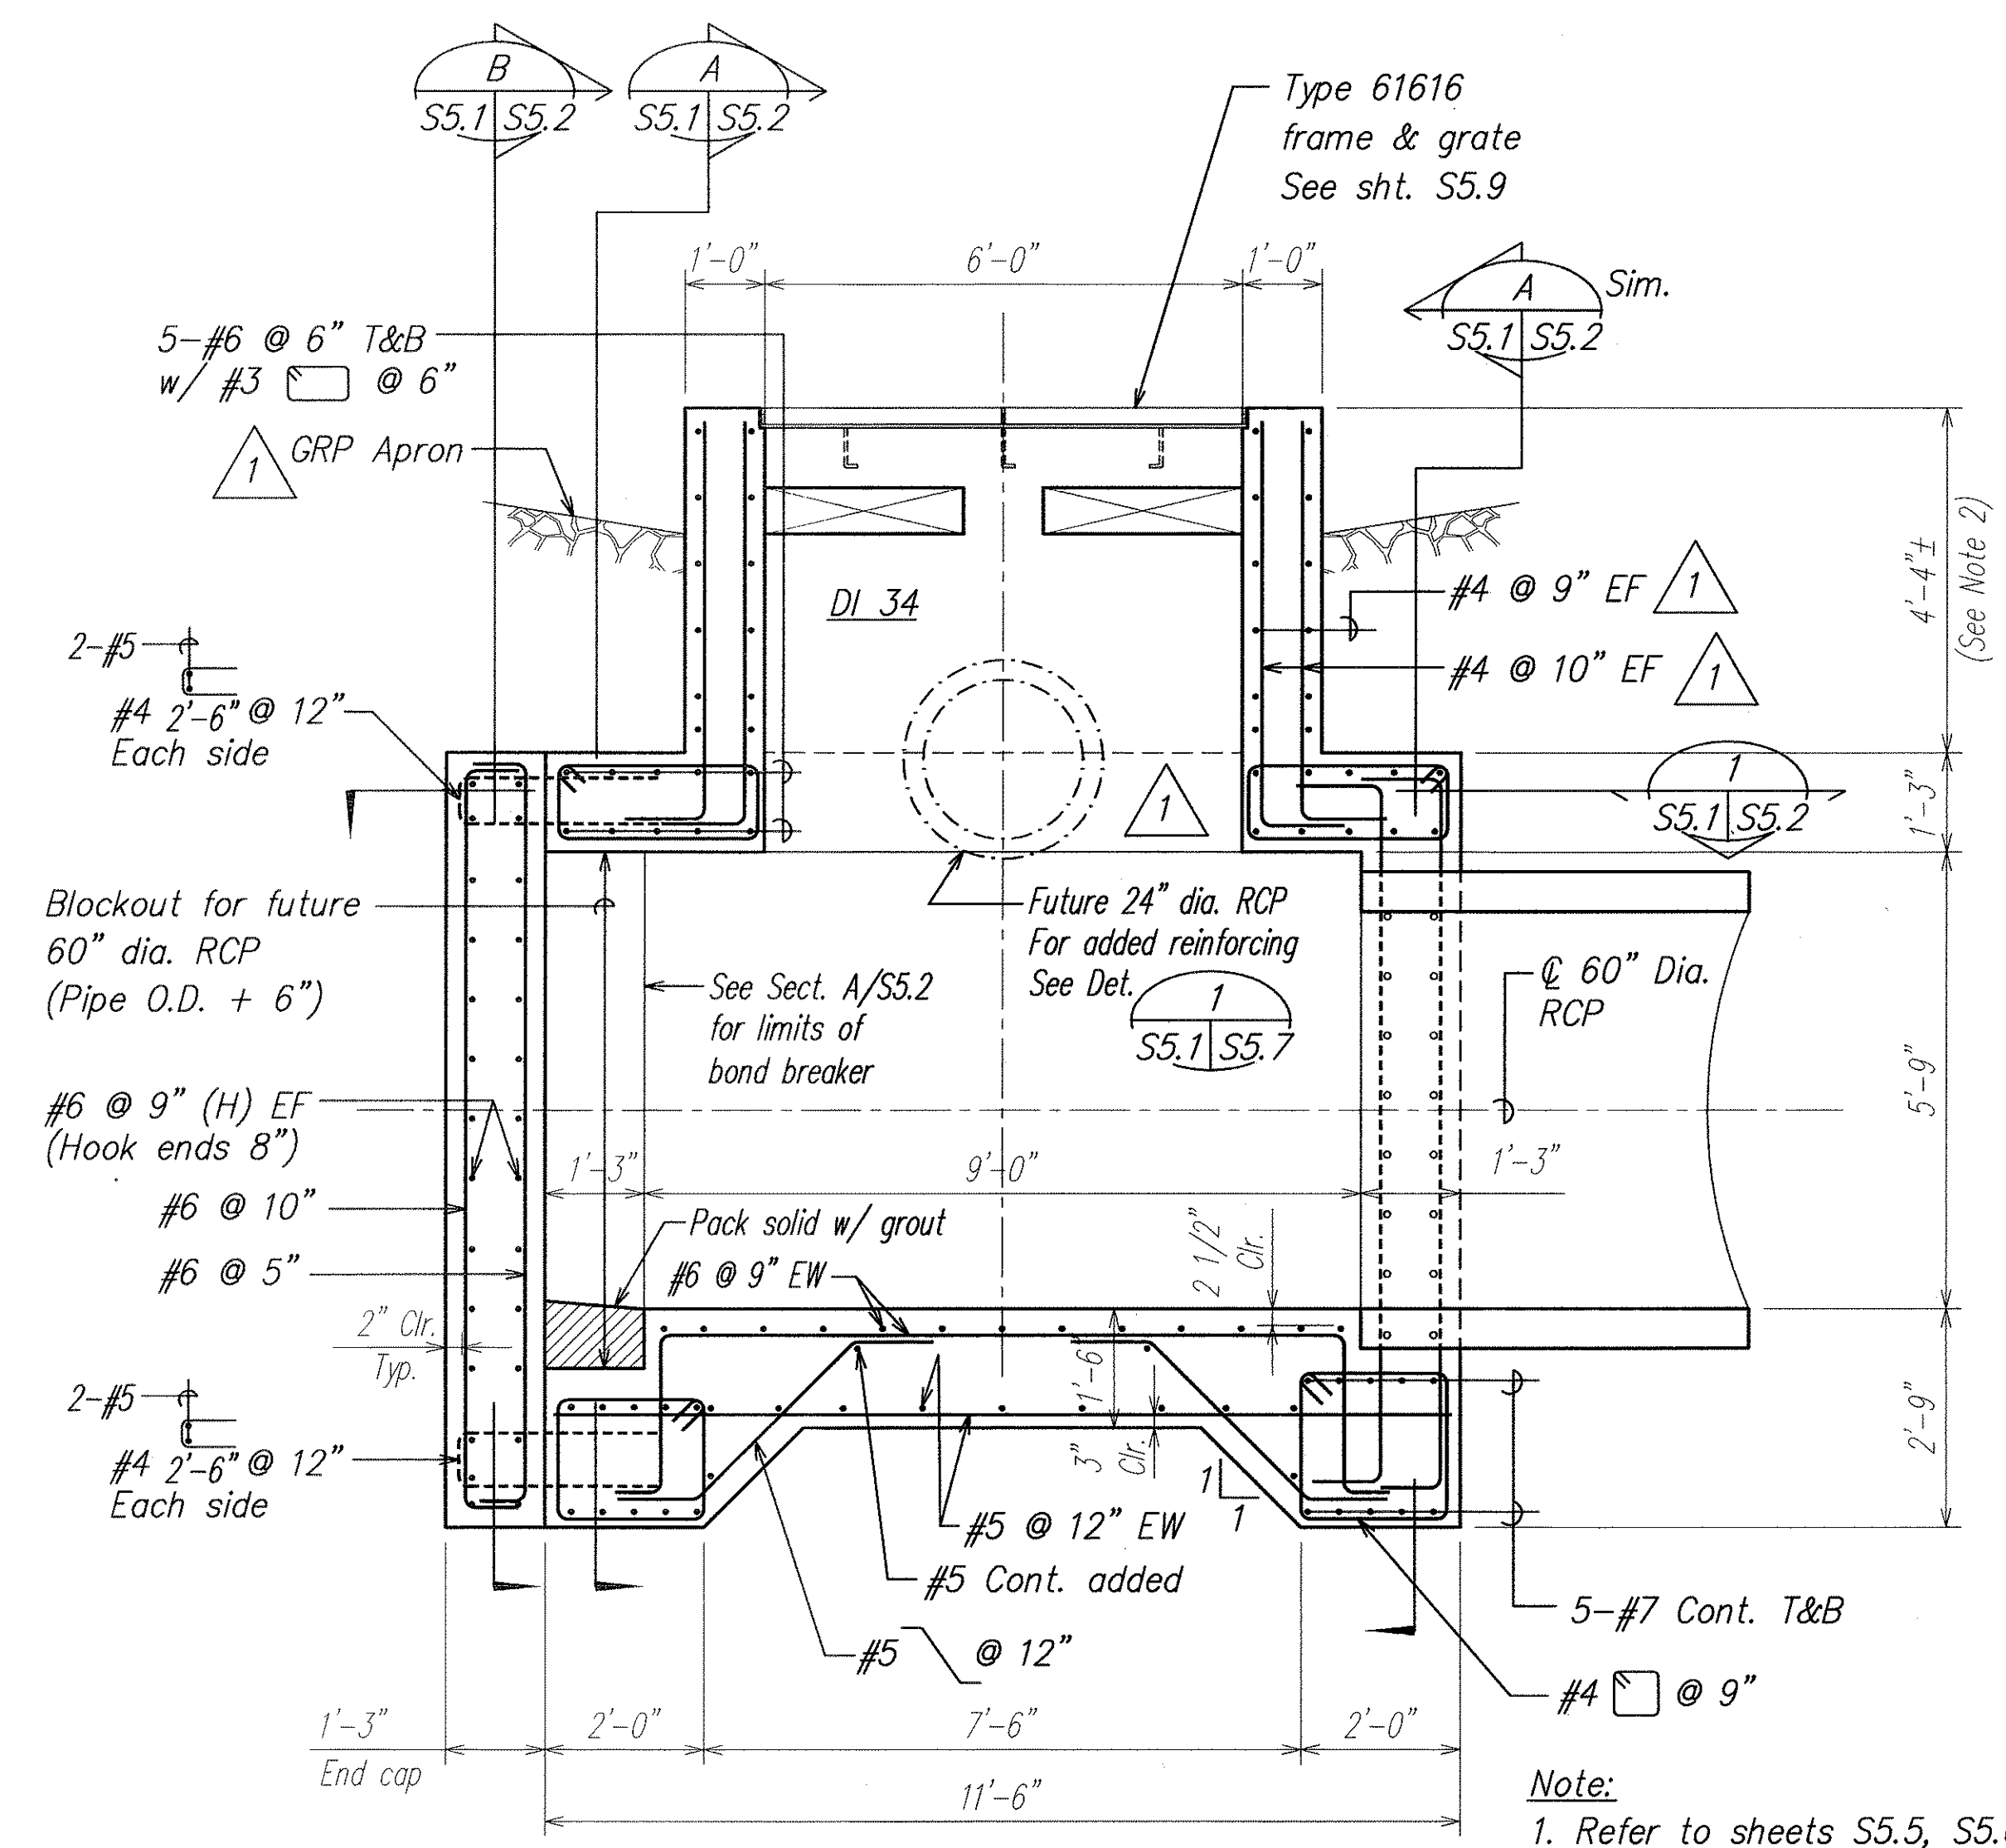

SECTION C
SCALE: 1/2" = 1'-0" S4.1, S5.1, S5.2 S5.1

Note:
1. Refer to sheets S5.5, S5.6
and S5.7 for reinforcing.
2. Refer to civil drawings for DI
elevations and verify dimensions.

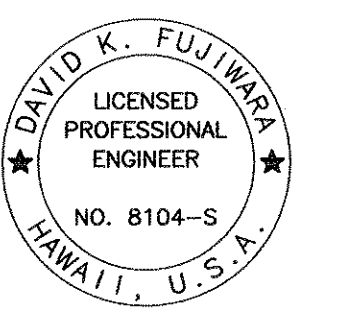

THIS WORK WAS PREPARED BY
ME OR UNDER MY SUPERVISION.

Signature: David K. Fujiwara
Expiration Date of the License: 4-30-06

1/18/05	1	Clarification of Notes
DATE		REVISION


STATE OF HAWAII
DEPARTMENT OF TRANSPORTATION
HIGHWAYS DIVISION

DRAIN CULVERT "E"
SECTIONS AT DI 34
North-South Road
Phase 1A
F.A.I. Proj. No. STP-8930(1)


Scale: As Noted Date: Dec. 22, 2004

SHEET No. S5.1 OF 43 SHEETS


FED. ROAD DIST. NO.	STATE	FED. AID PROJ. NO.	FISCAL YEAR	SHEET NO.	TOTAL SHEETS
HAWAII	HAW.	STP-8930(1)	2005	ADD. 94	144

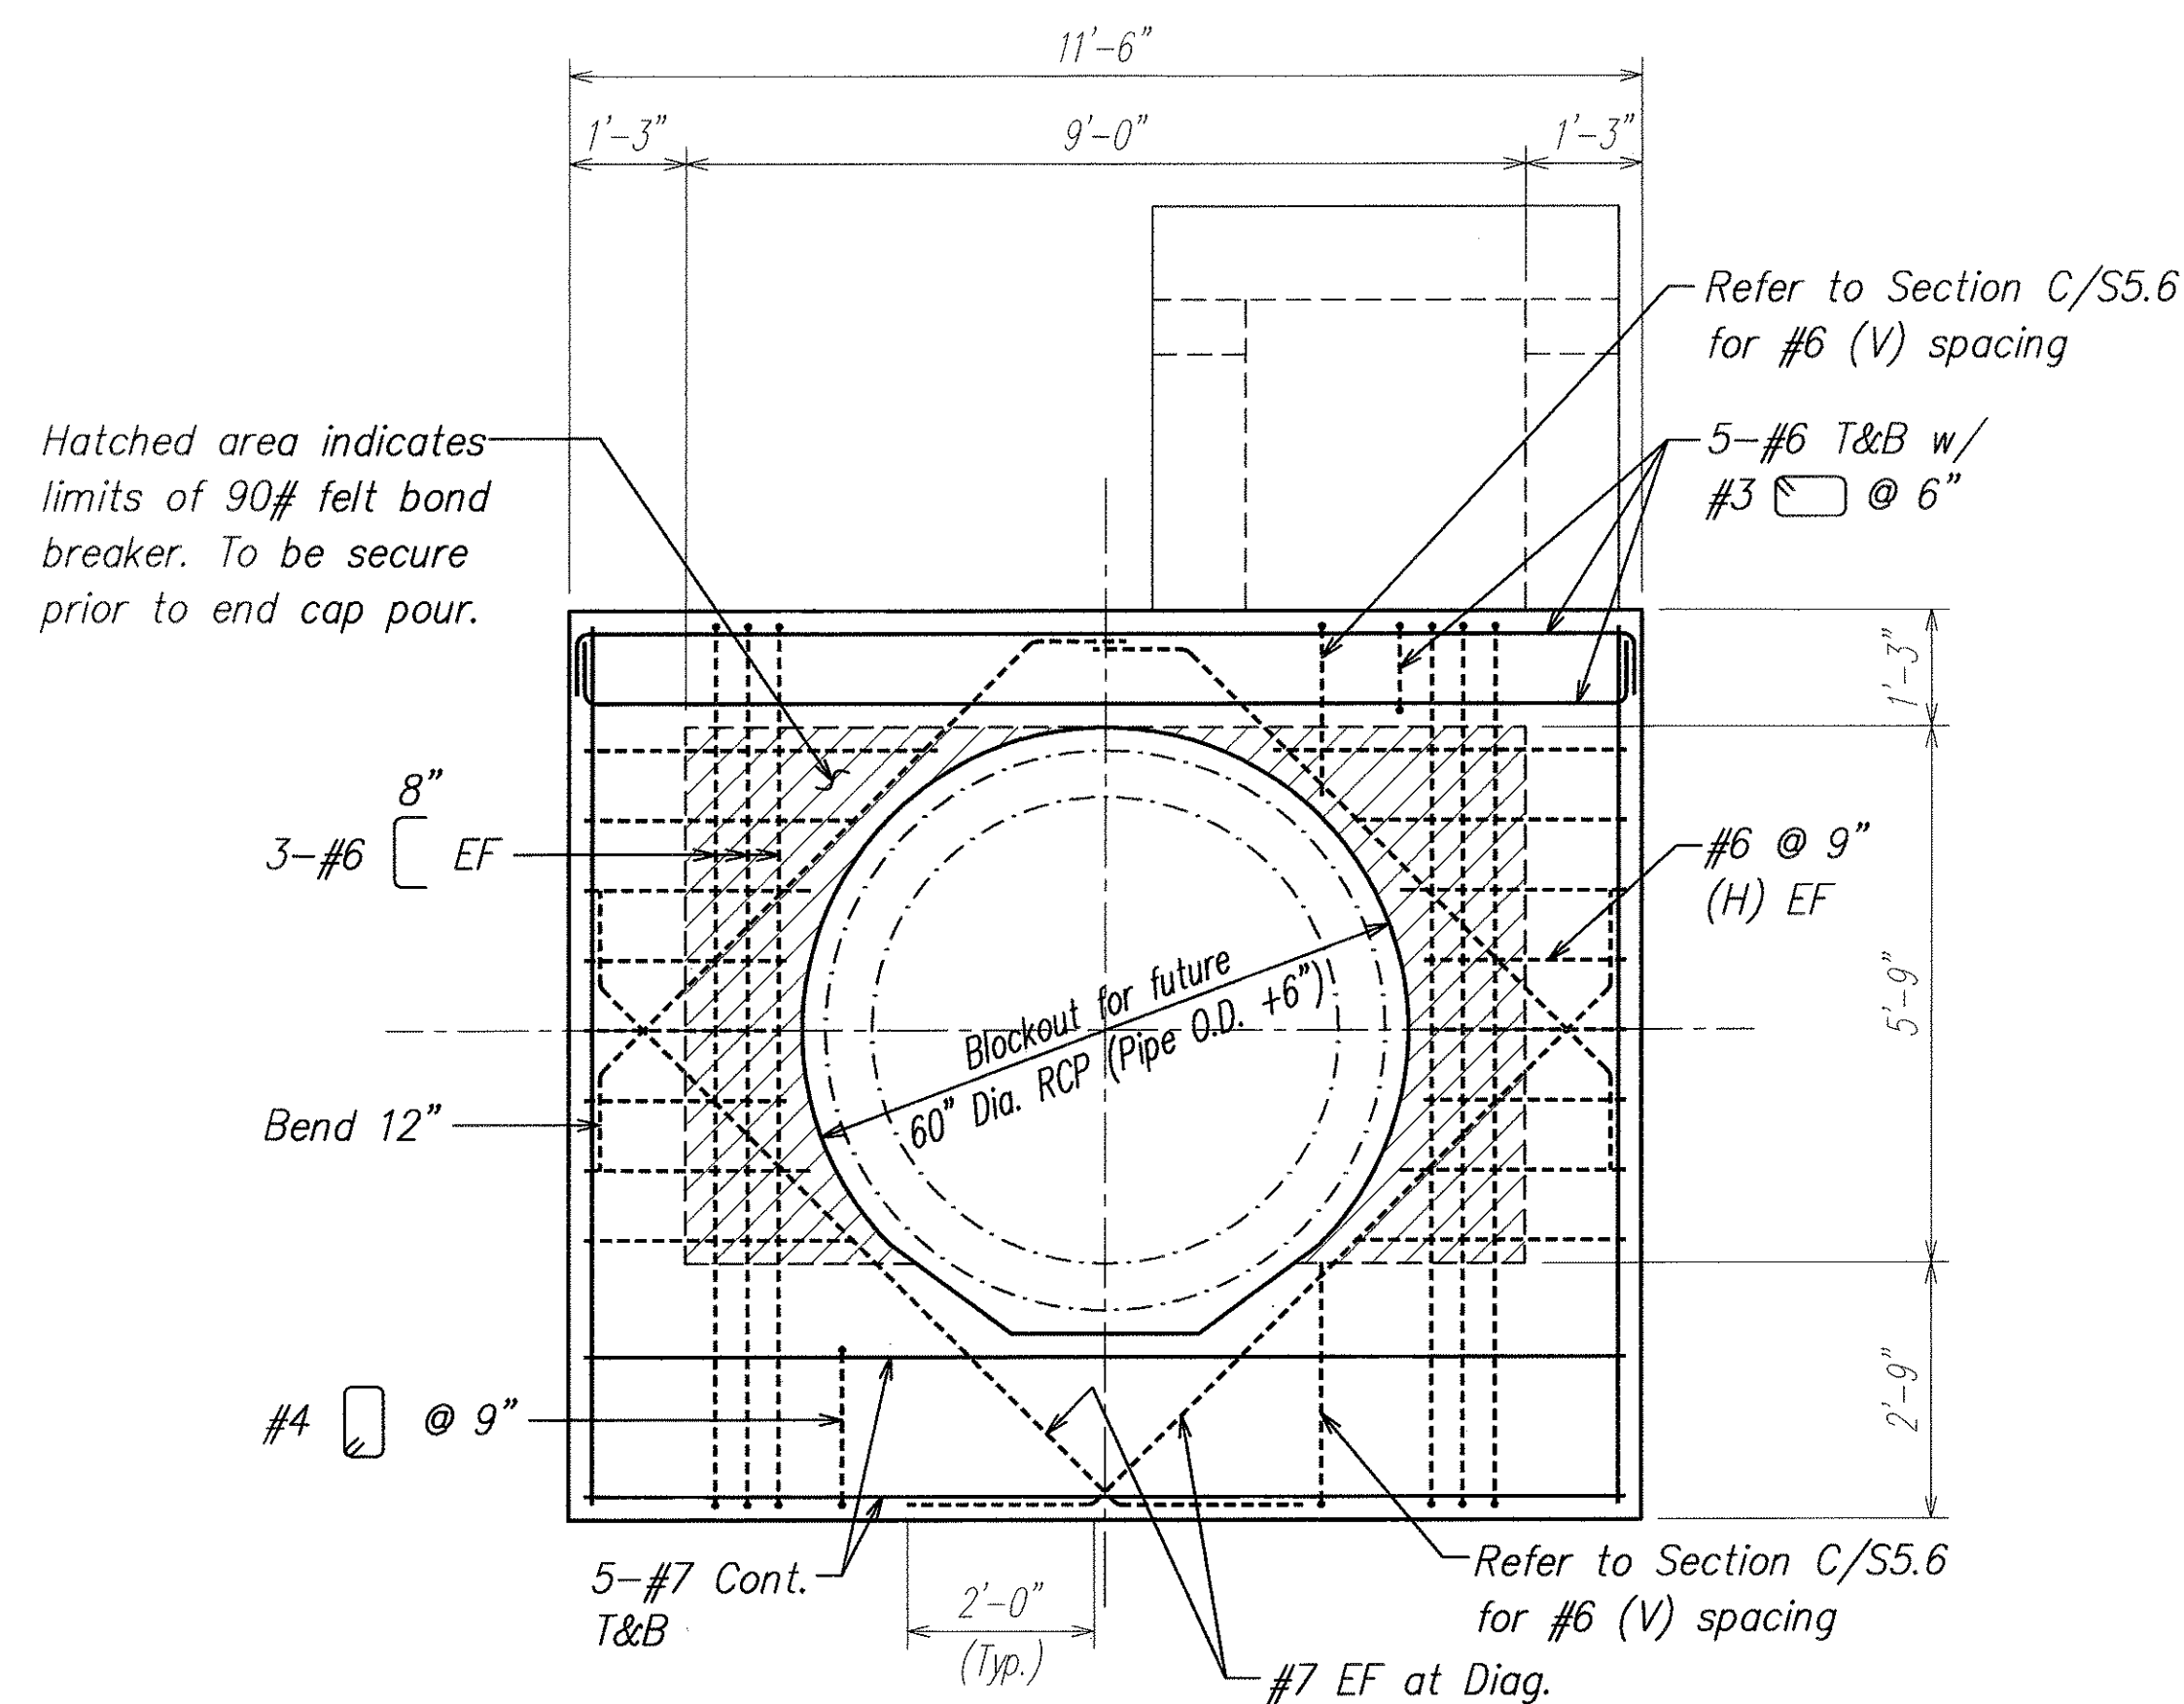

SECTION A
SCALE: 1/2" = 1'-0" S5.1 S5.2

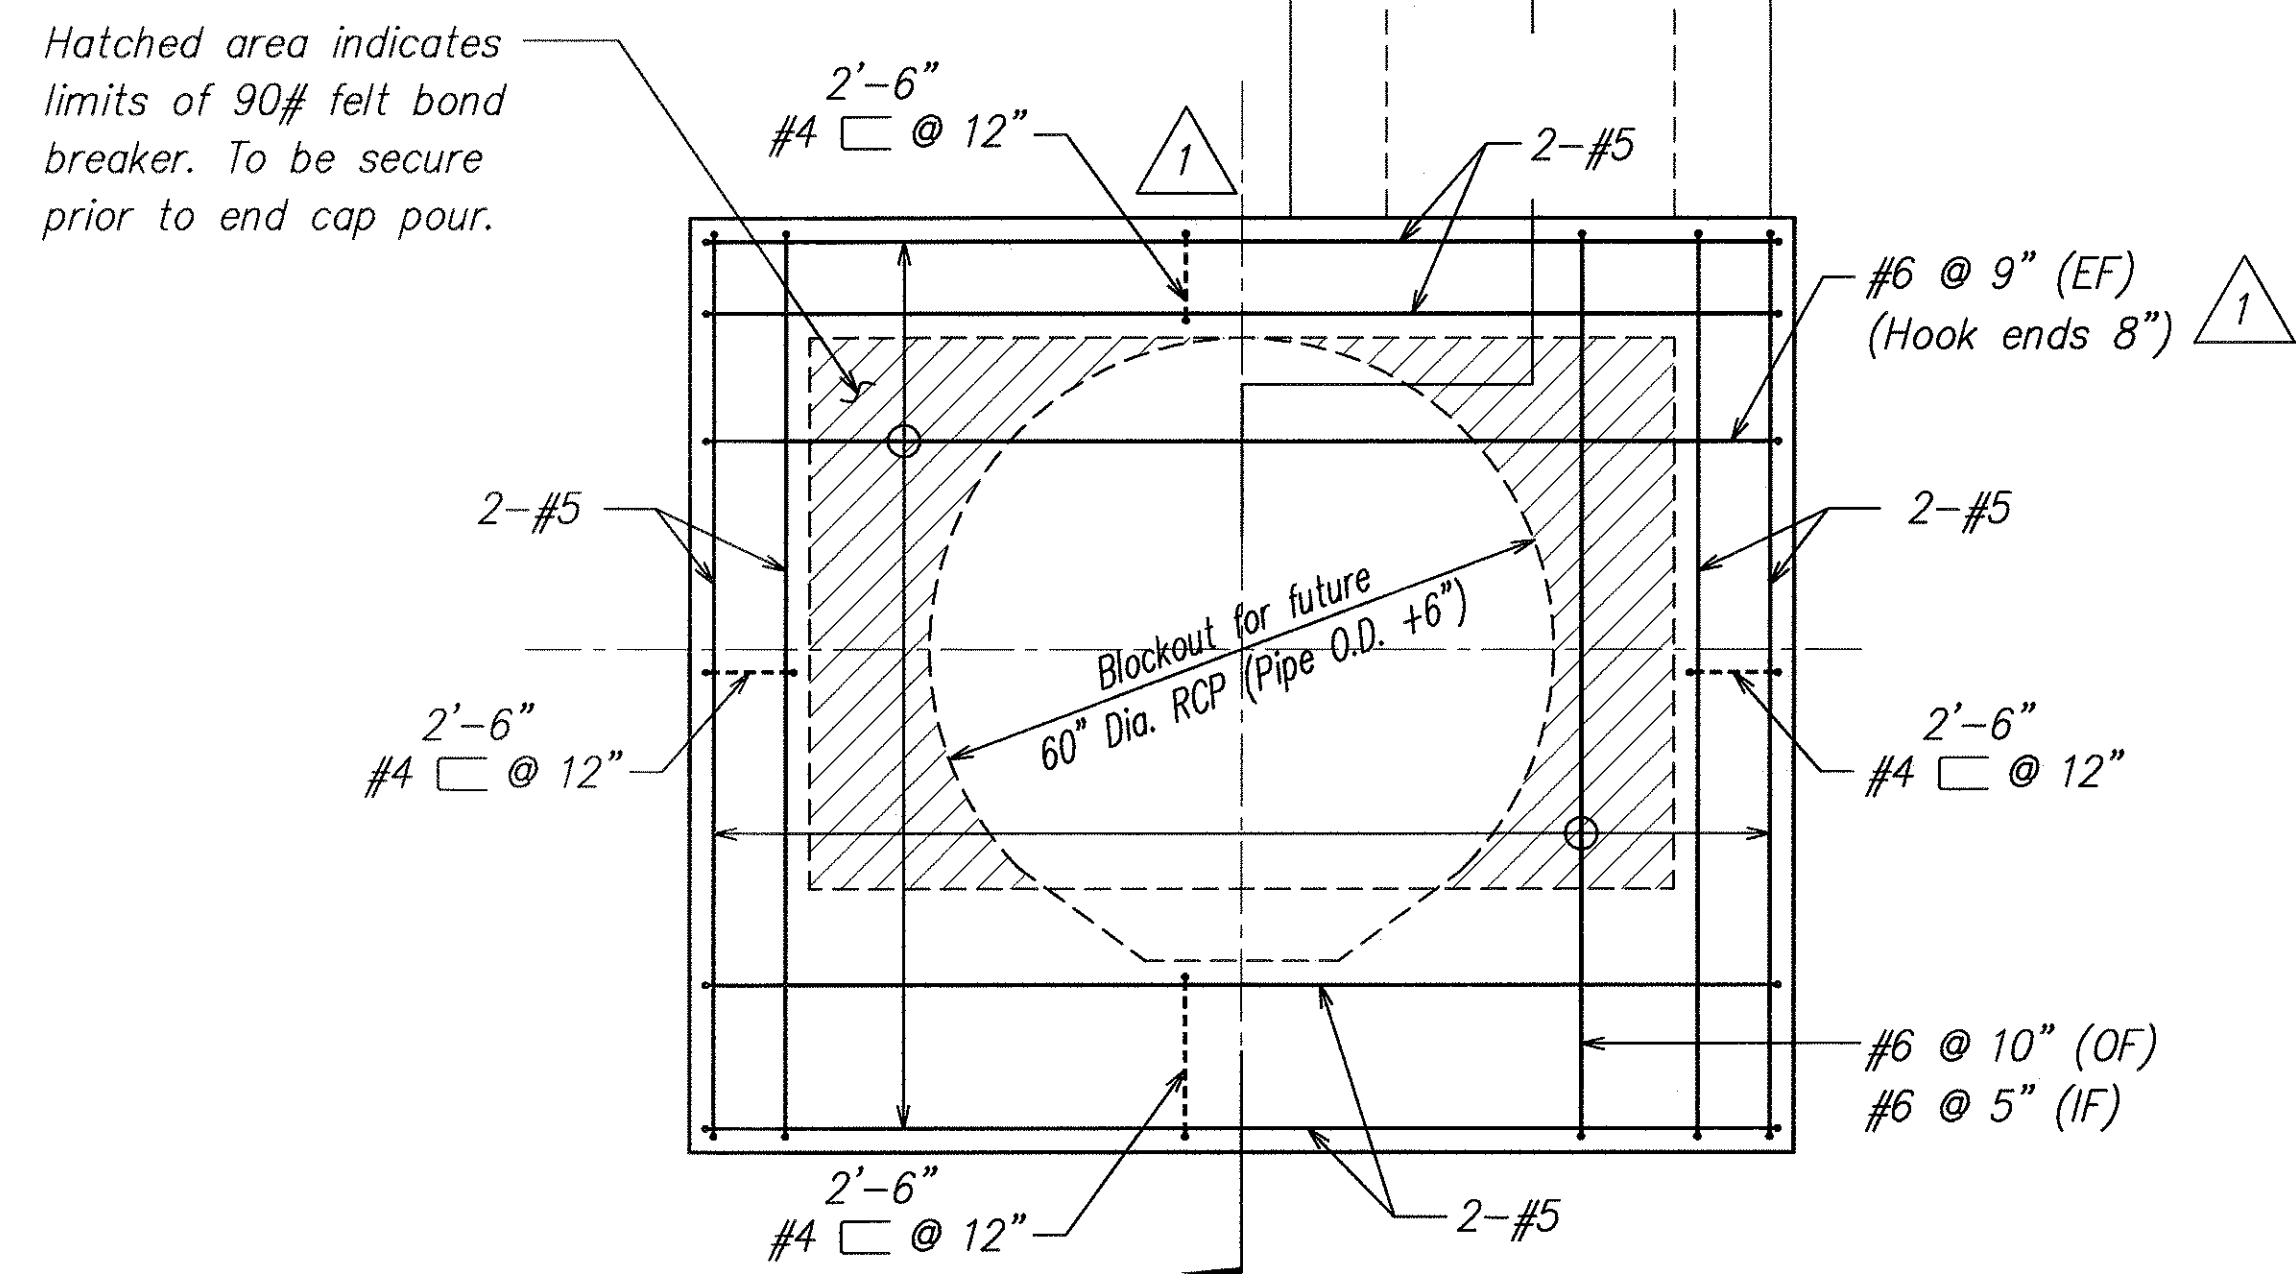


SECTION B
SCALE: 1/2" = 1'-0" S5.1 S5.2

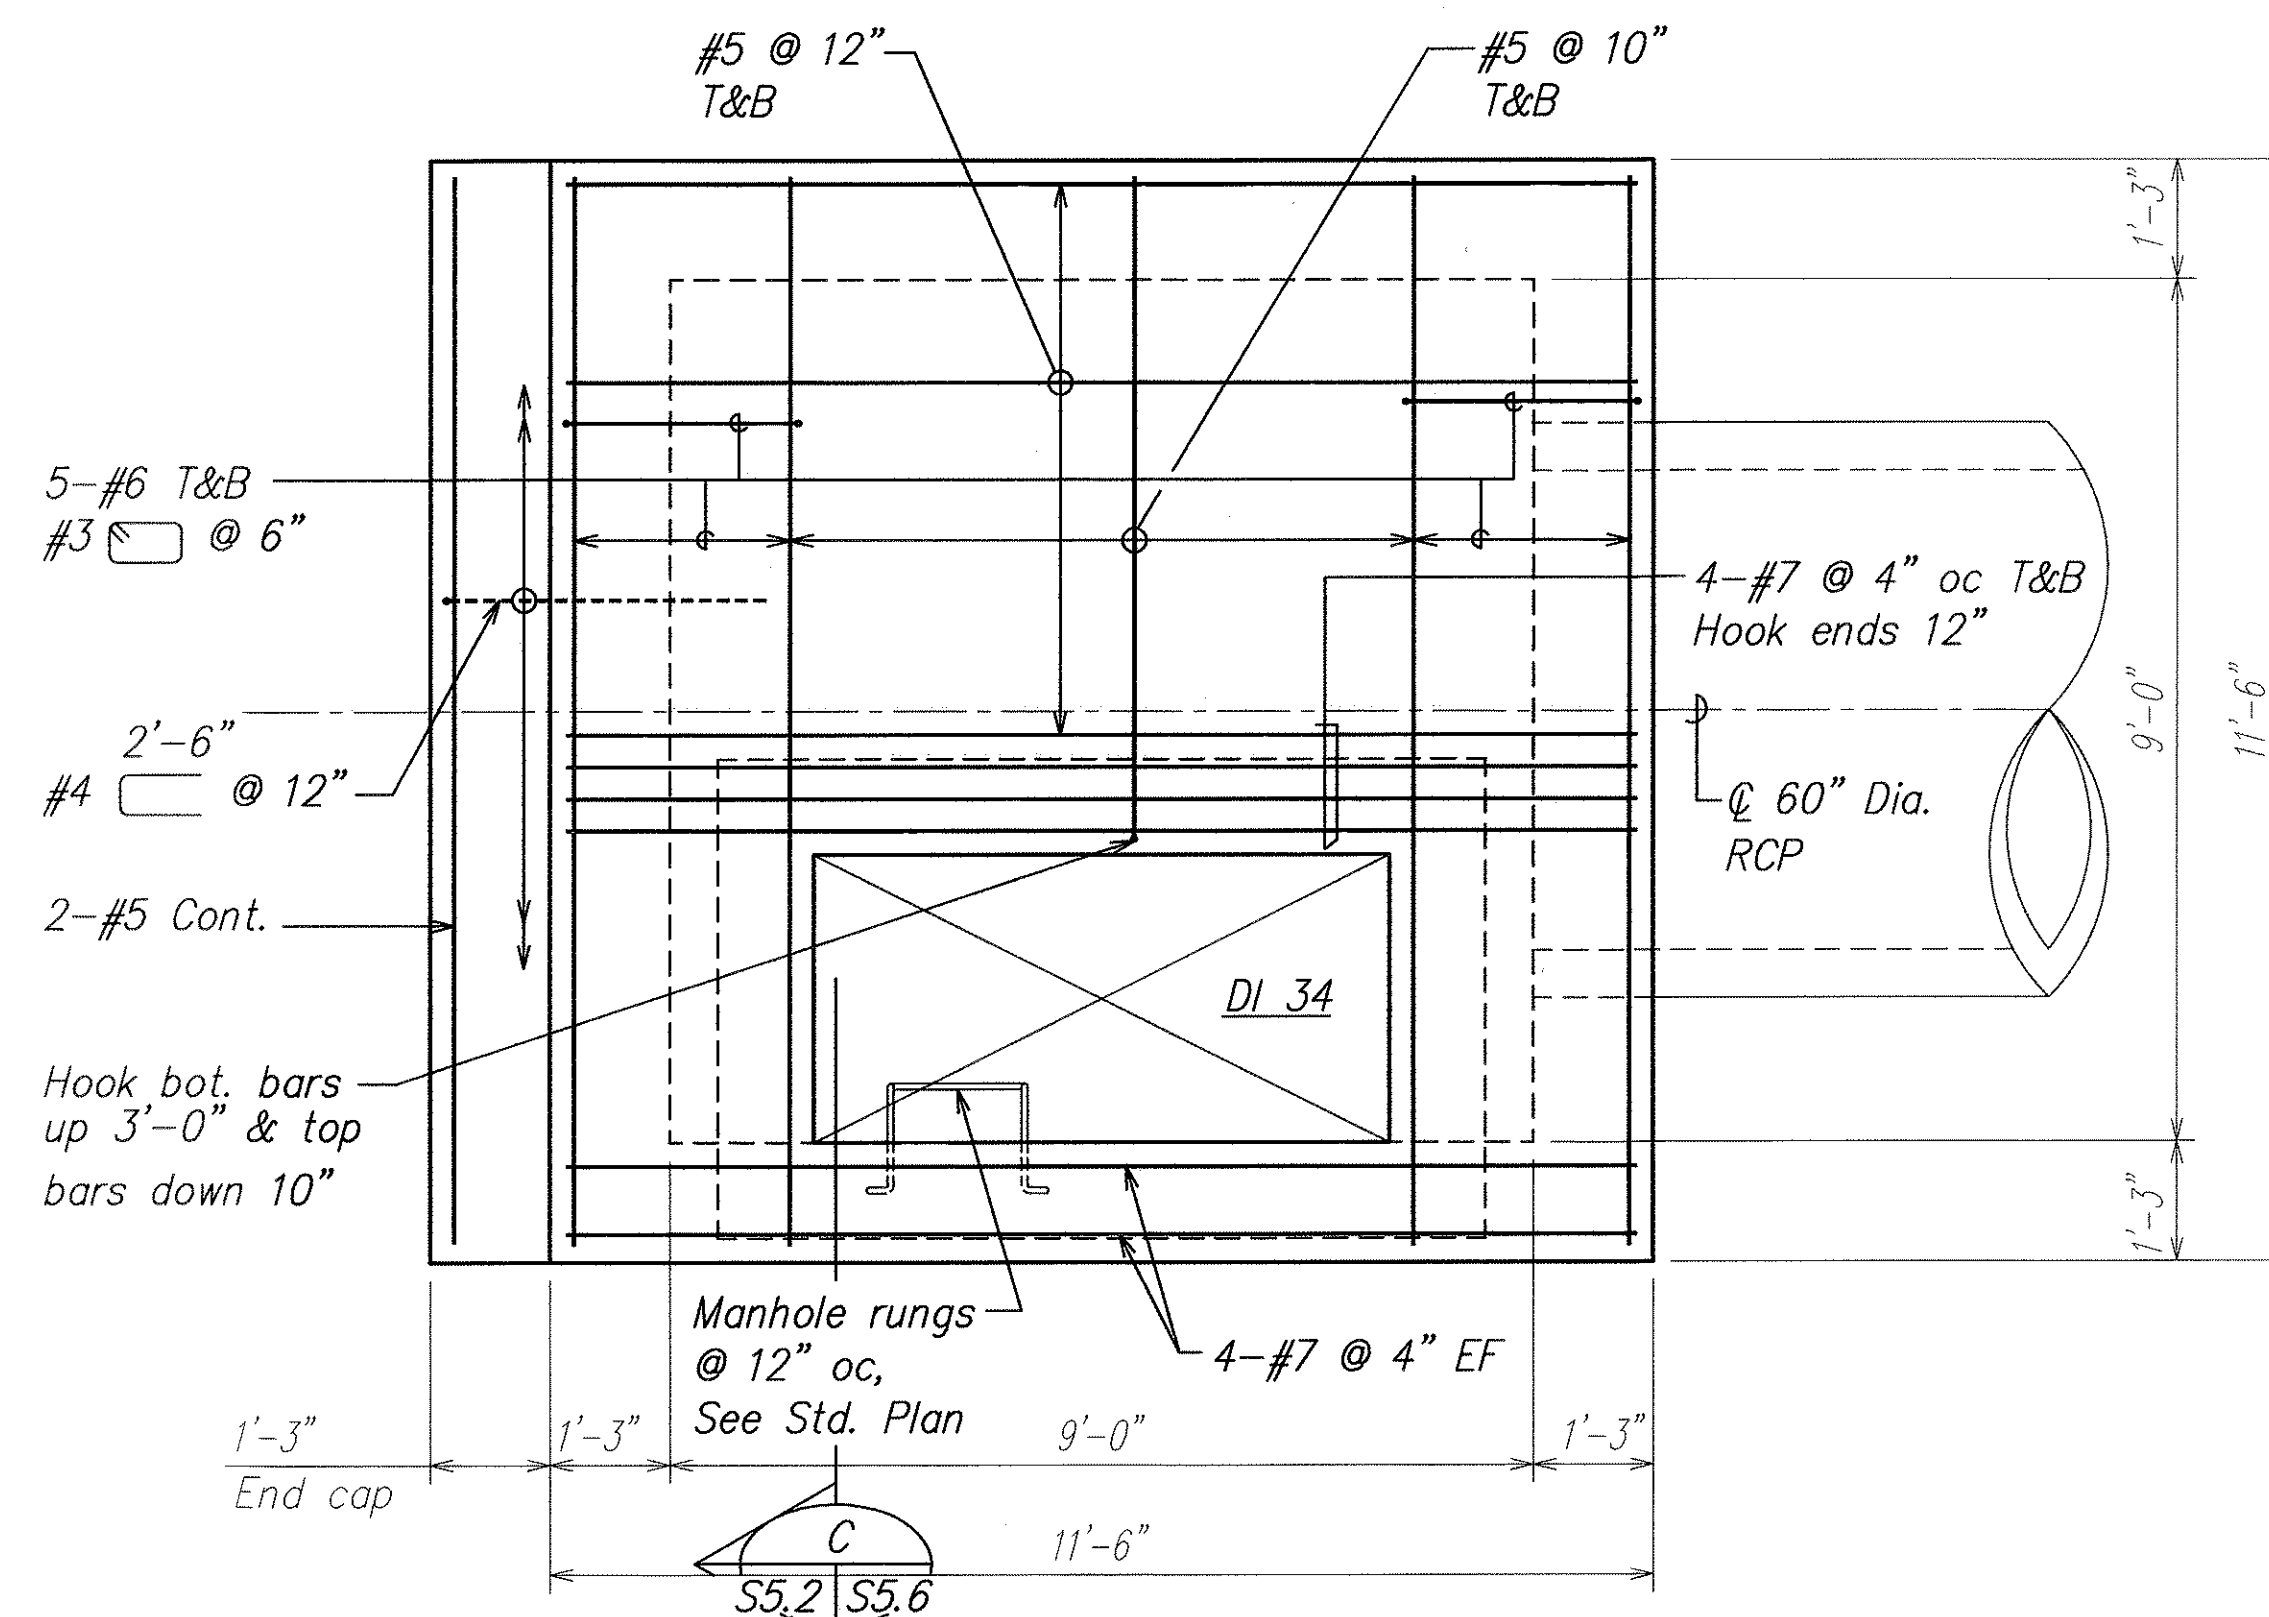

DRAIN CULVERT "E" - SECTION AT DI 34
SCALE: 1/2" = 1'-0" S4.1, S5.1 S5.2

ORIGINAL PLAN	SURVEY PLOTTED BY	DATE
NOTE BOOK	DRAWN BY	
	DESIGNED BY	
	CHECKED BY	

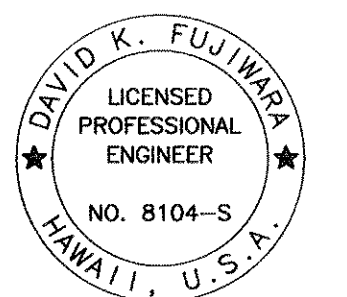

THIS WORK WAS PREPARED BY ME OR UNDER MY SUPERVISION.

Signature: David K. Fujimura
EXPIRATION DATE OF THE LICENSE: 4-30-06

STATE OF HAWAII
DEPARTMENT OF TRANSPORTATION
HIGHWAYS DIVISION


DRAIN CULVERT "E"
SECTIONS AT DI 34
North-South Road
Phase 1A
F.A.I. Proj. No. STP-8930(1)

Scale: As Noted Date: Dec. 22, 2004


SHEET No. S5.2 OF 43 SHEETS

1/18/05	1 Clarification of Notes and Clarify Rebar
DATE	REVISION


FED. ROAD DIST. NO.	STATE	FED. AID PROJ. NO.	FISCAL YEAR	SHEET NO.	TOTAL SHEETS
HAWAII	HAW.	STP-8930(1)	2005	ADD. 95	144

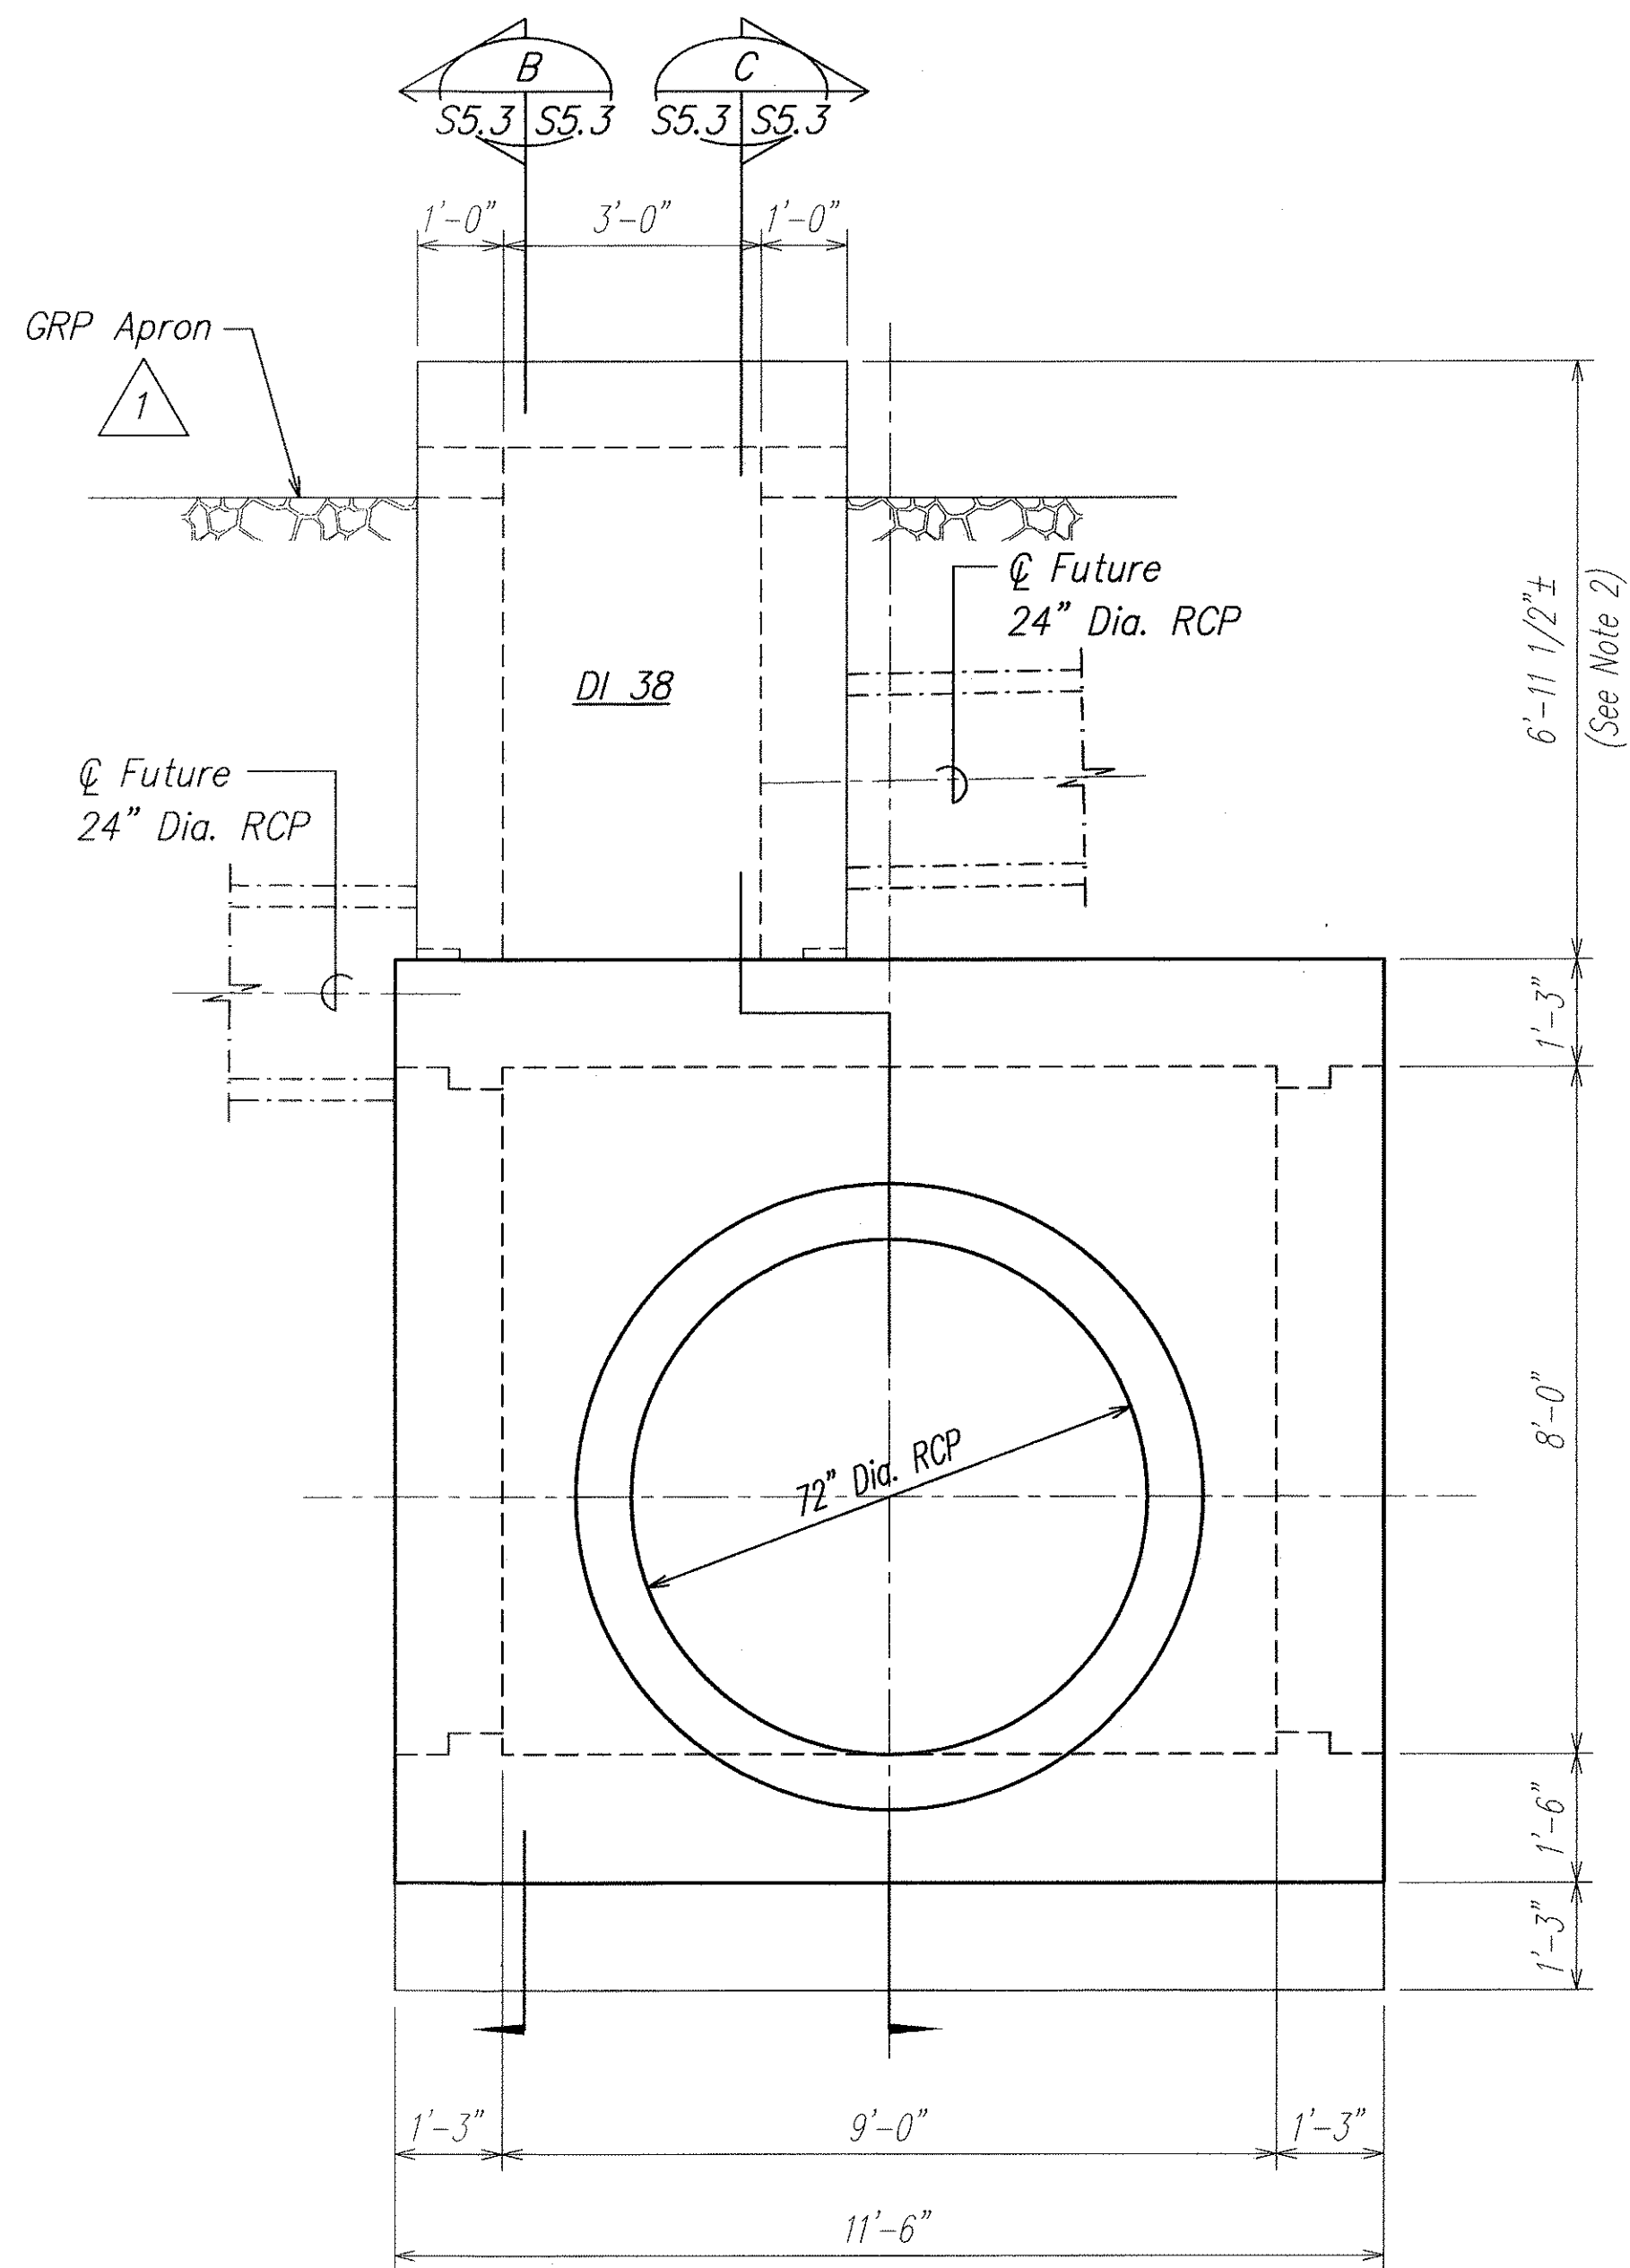

SECTION A
SCALE: 1/2" = 1'-0"
S4.2 | S5.3

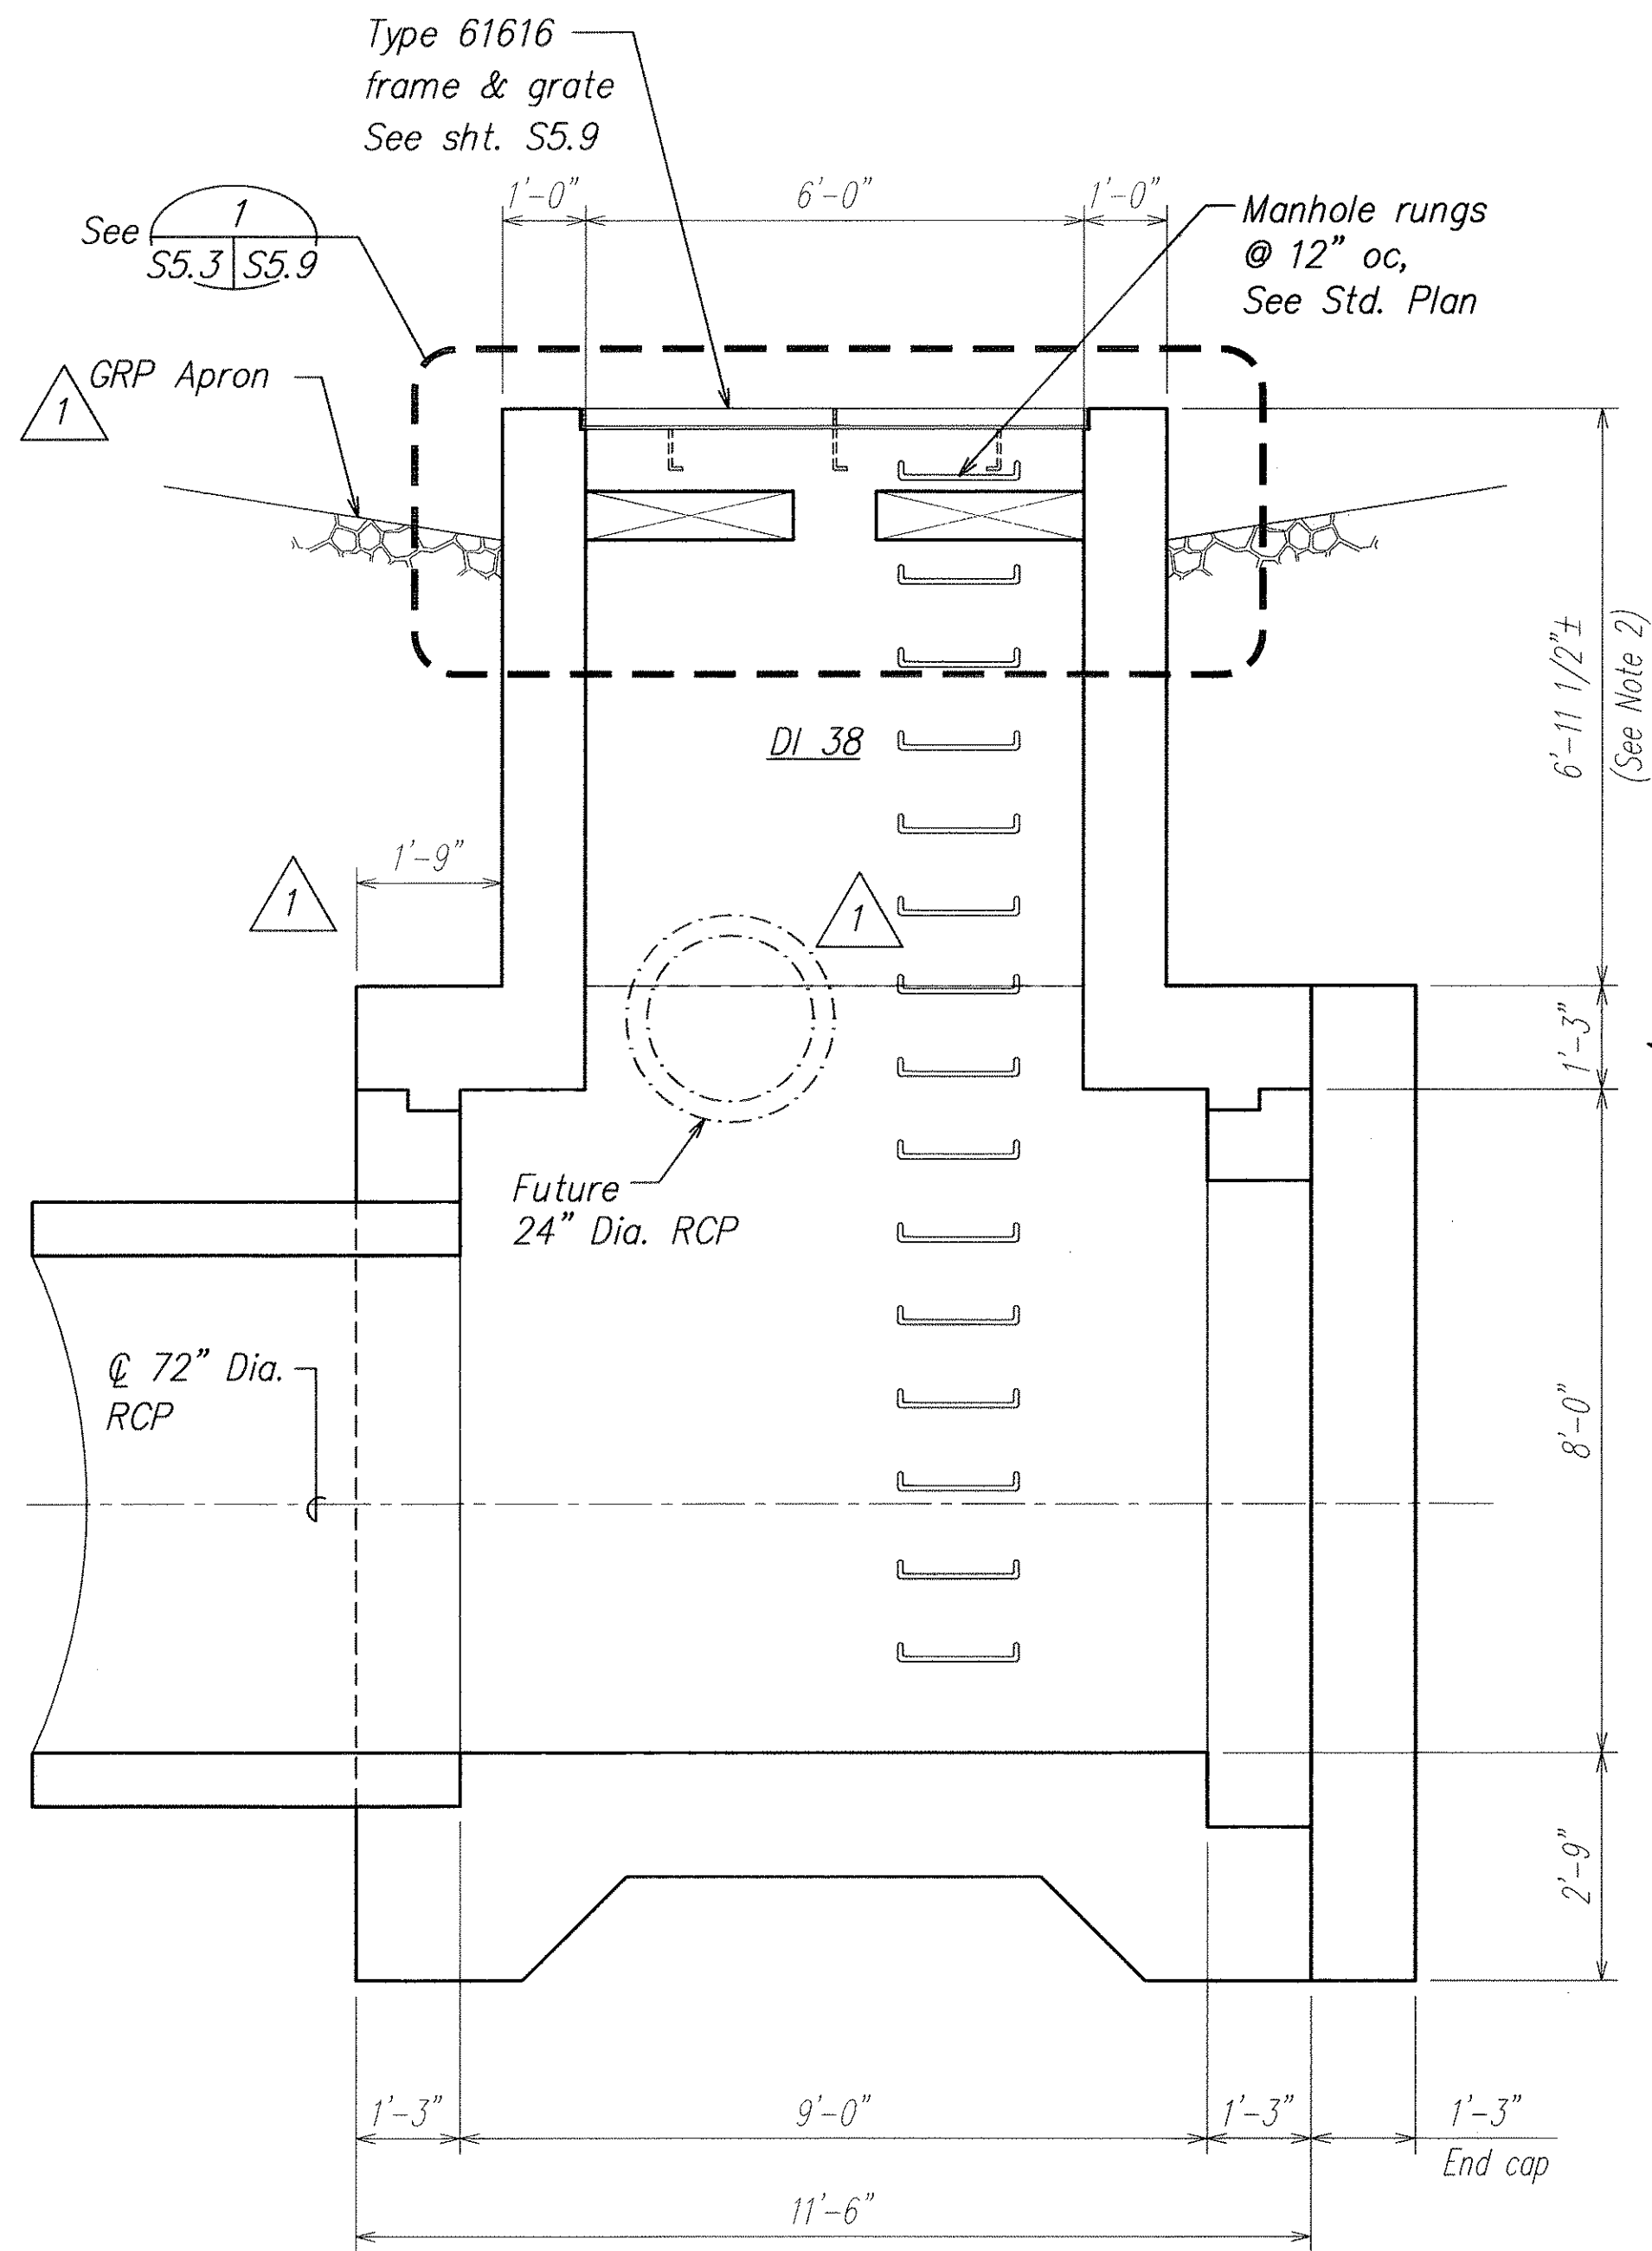


SECTION B
SCALE: 1/2" = 1'-0"
S5.3 | S5.3

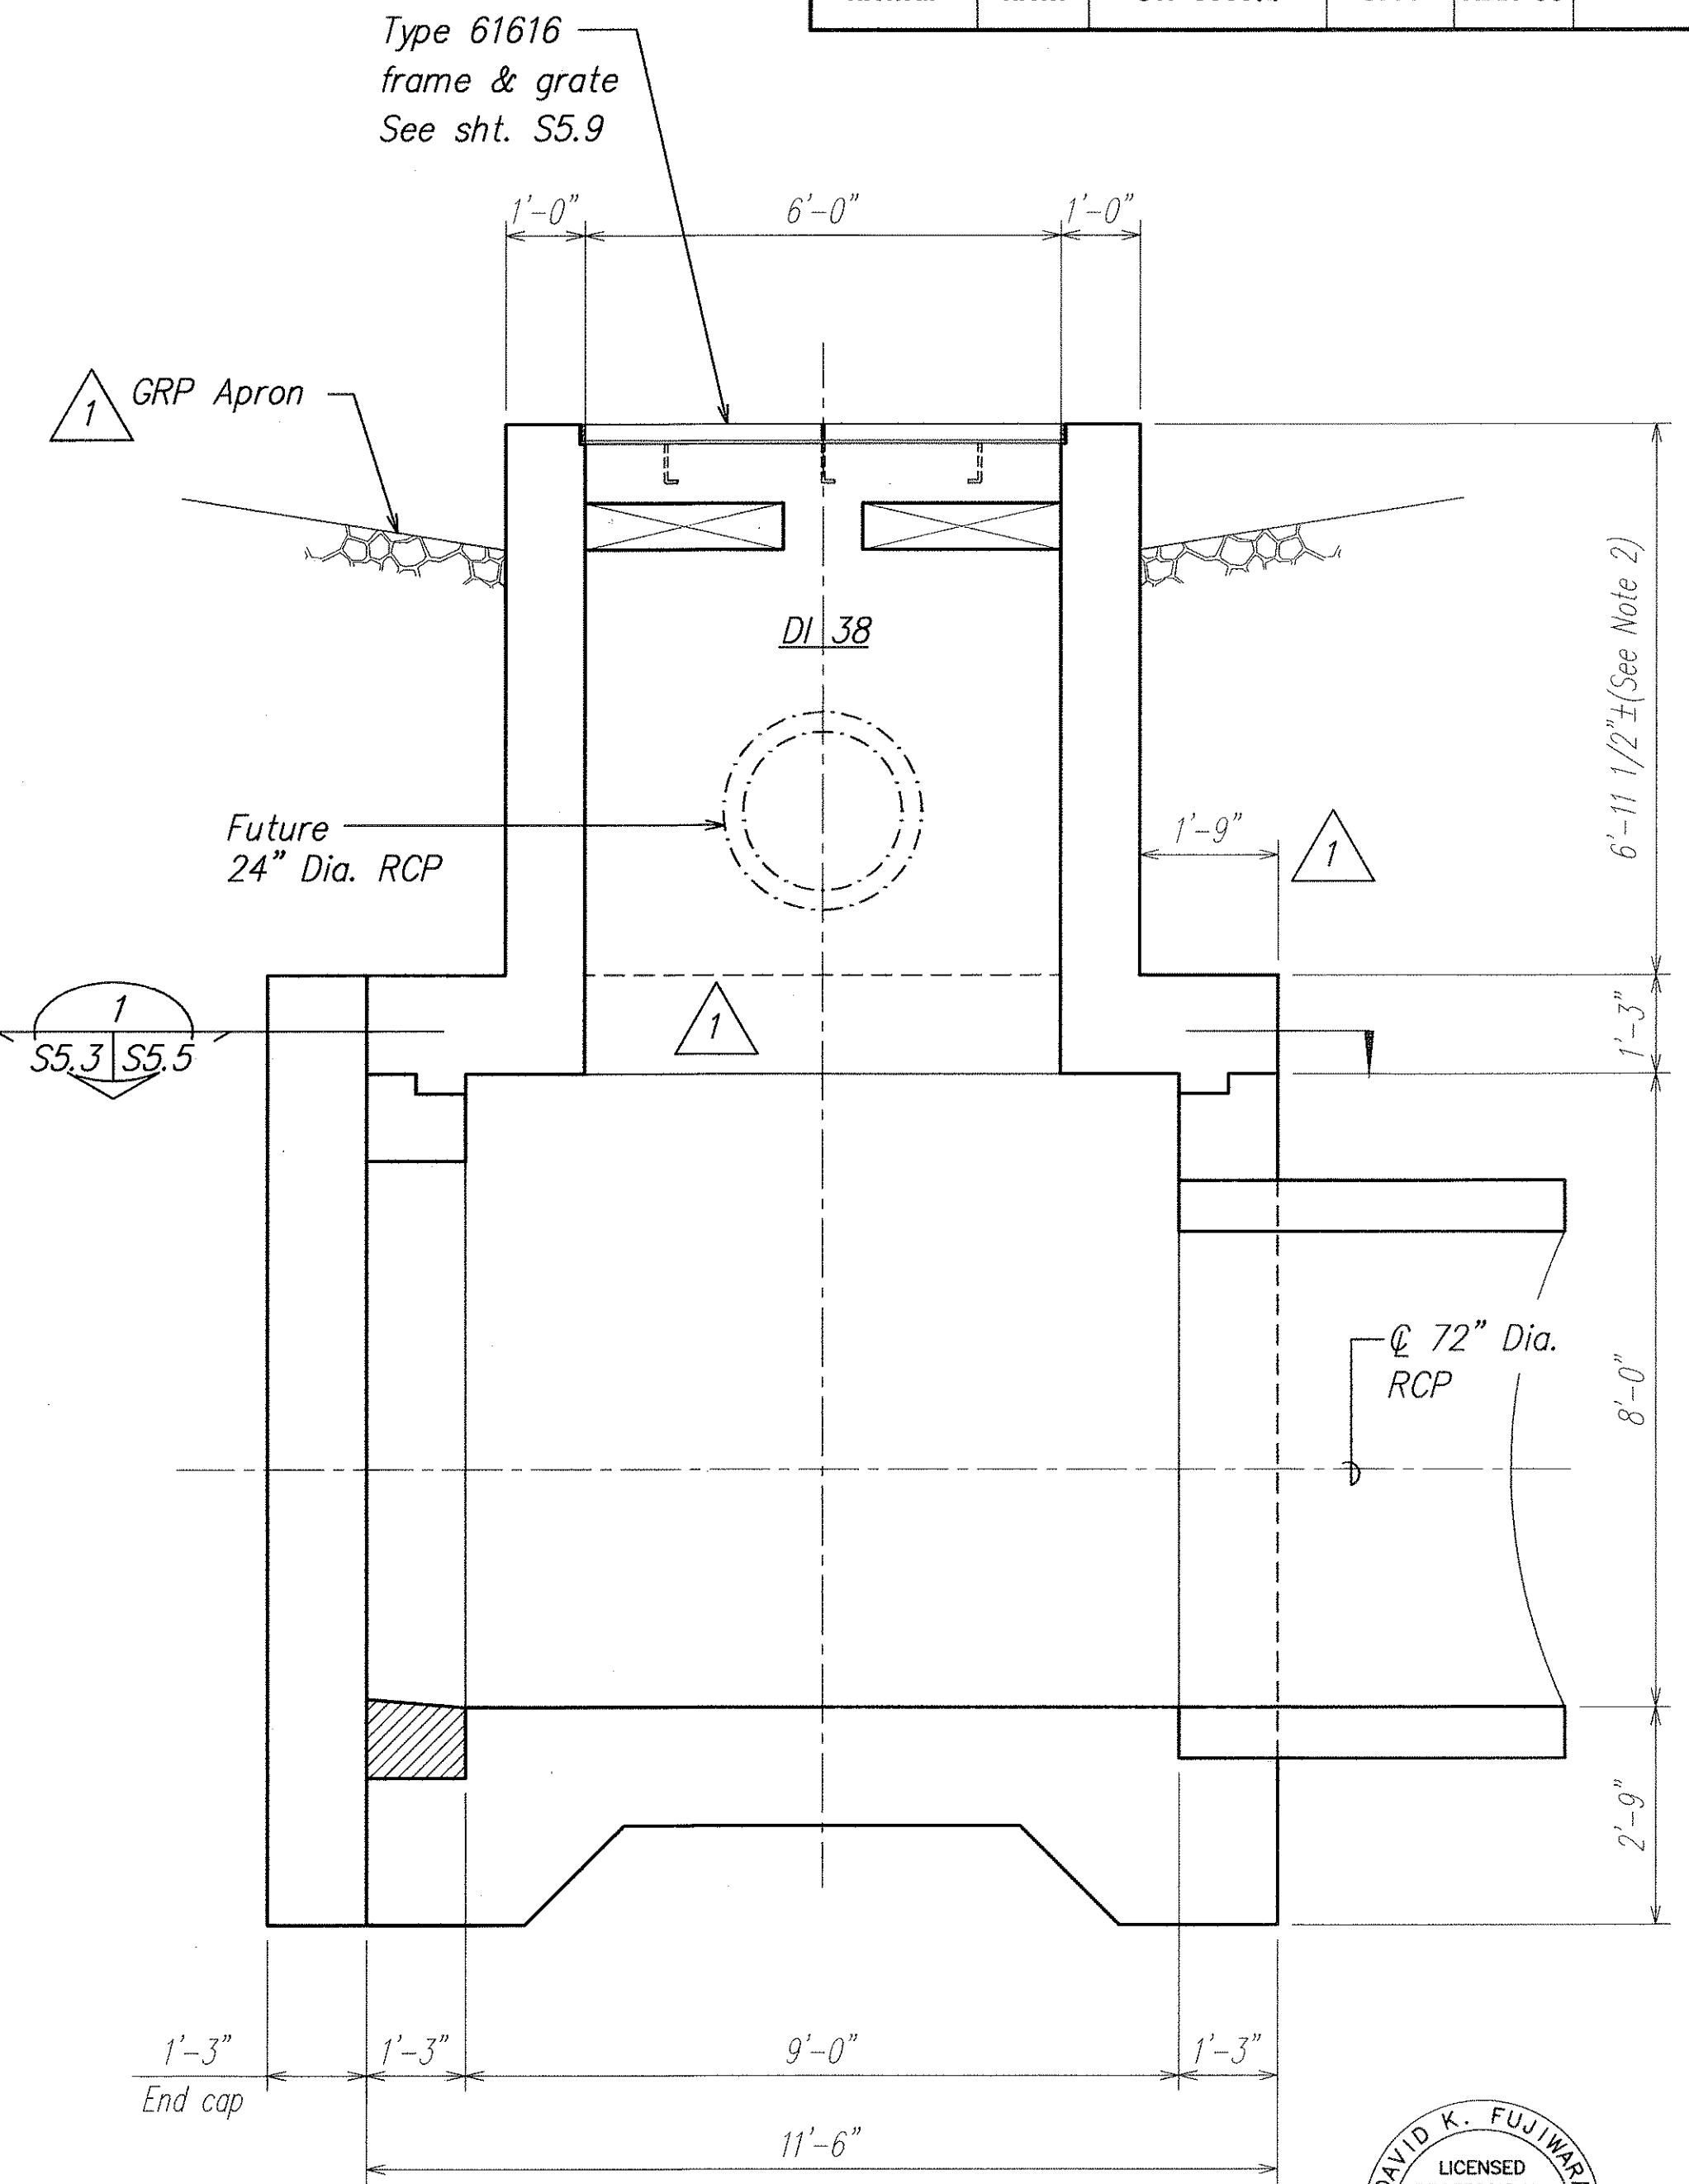

SECTION C
SCALE: 1/2" = 1'-0"
S5.3 | S5.3

- Note:
1. Refer to sheets S5.5, S5.6 and S5.7 for reinforcing.
 2. Refer to civil drawings for DI elevations and verify dimensions.

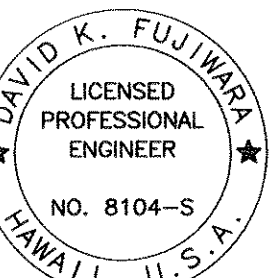

THIS WORK WAS PREPARED BY ME OR UNDER MY SUPERVISION.

Signature: David K. Fujiwara
Expiration Date of the License: 4-30-06

STATE OF HAWAII
DEPARTMENT OF TRANSPORTATION
HIGHWAYS DIVISION

DRAIN CULVERT "F"
SECTIONS AT DI 38

North-South Road
Phase 1A

F.A.I. Proj. No. STP-8930(1)

Scale: As Noted Date: Dec. 22, 2004


SHEET No. S5.3 OF 43 SHEETS

ADD. 95

1/18/05	1 Clarification of Note and Added Dimension
DATE	REVISION


ORIGINAL PLAN	SURVEY PLOTTED BY	DATE
NOTE BOOK	DRAWN BY	
	DESIGNED BY	
	QUANTITIES BY	
	CHECKED BY	

FED. ROAD DIST. NO.	STATE	FED. AID PROJ. NO.	FISCAL YEAR	SHEET NO.	TOTAL SHEETS
HAWAII	HAW.	STP-8930(1)	2005	ADD. 96	144

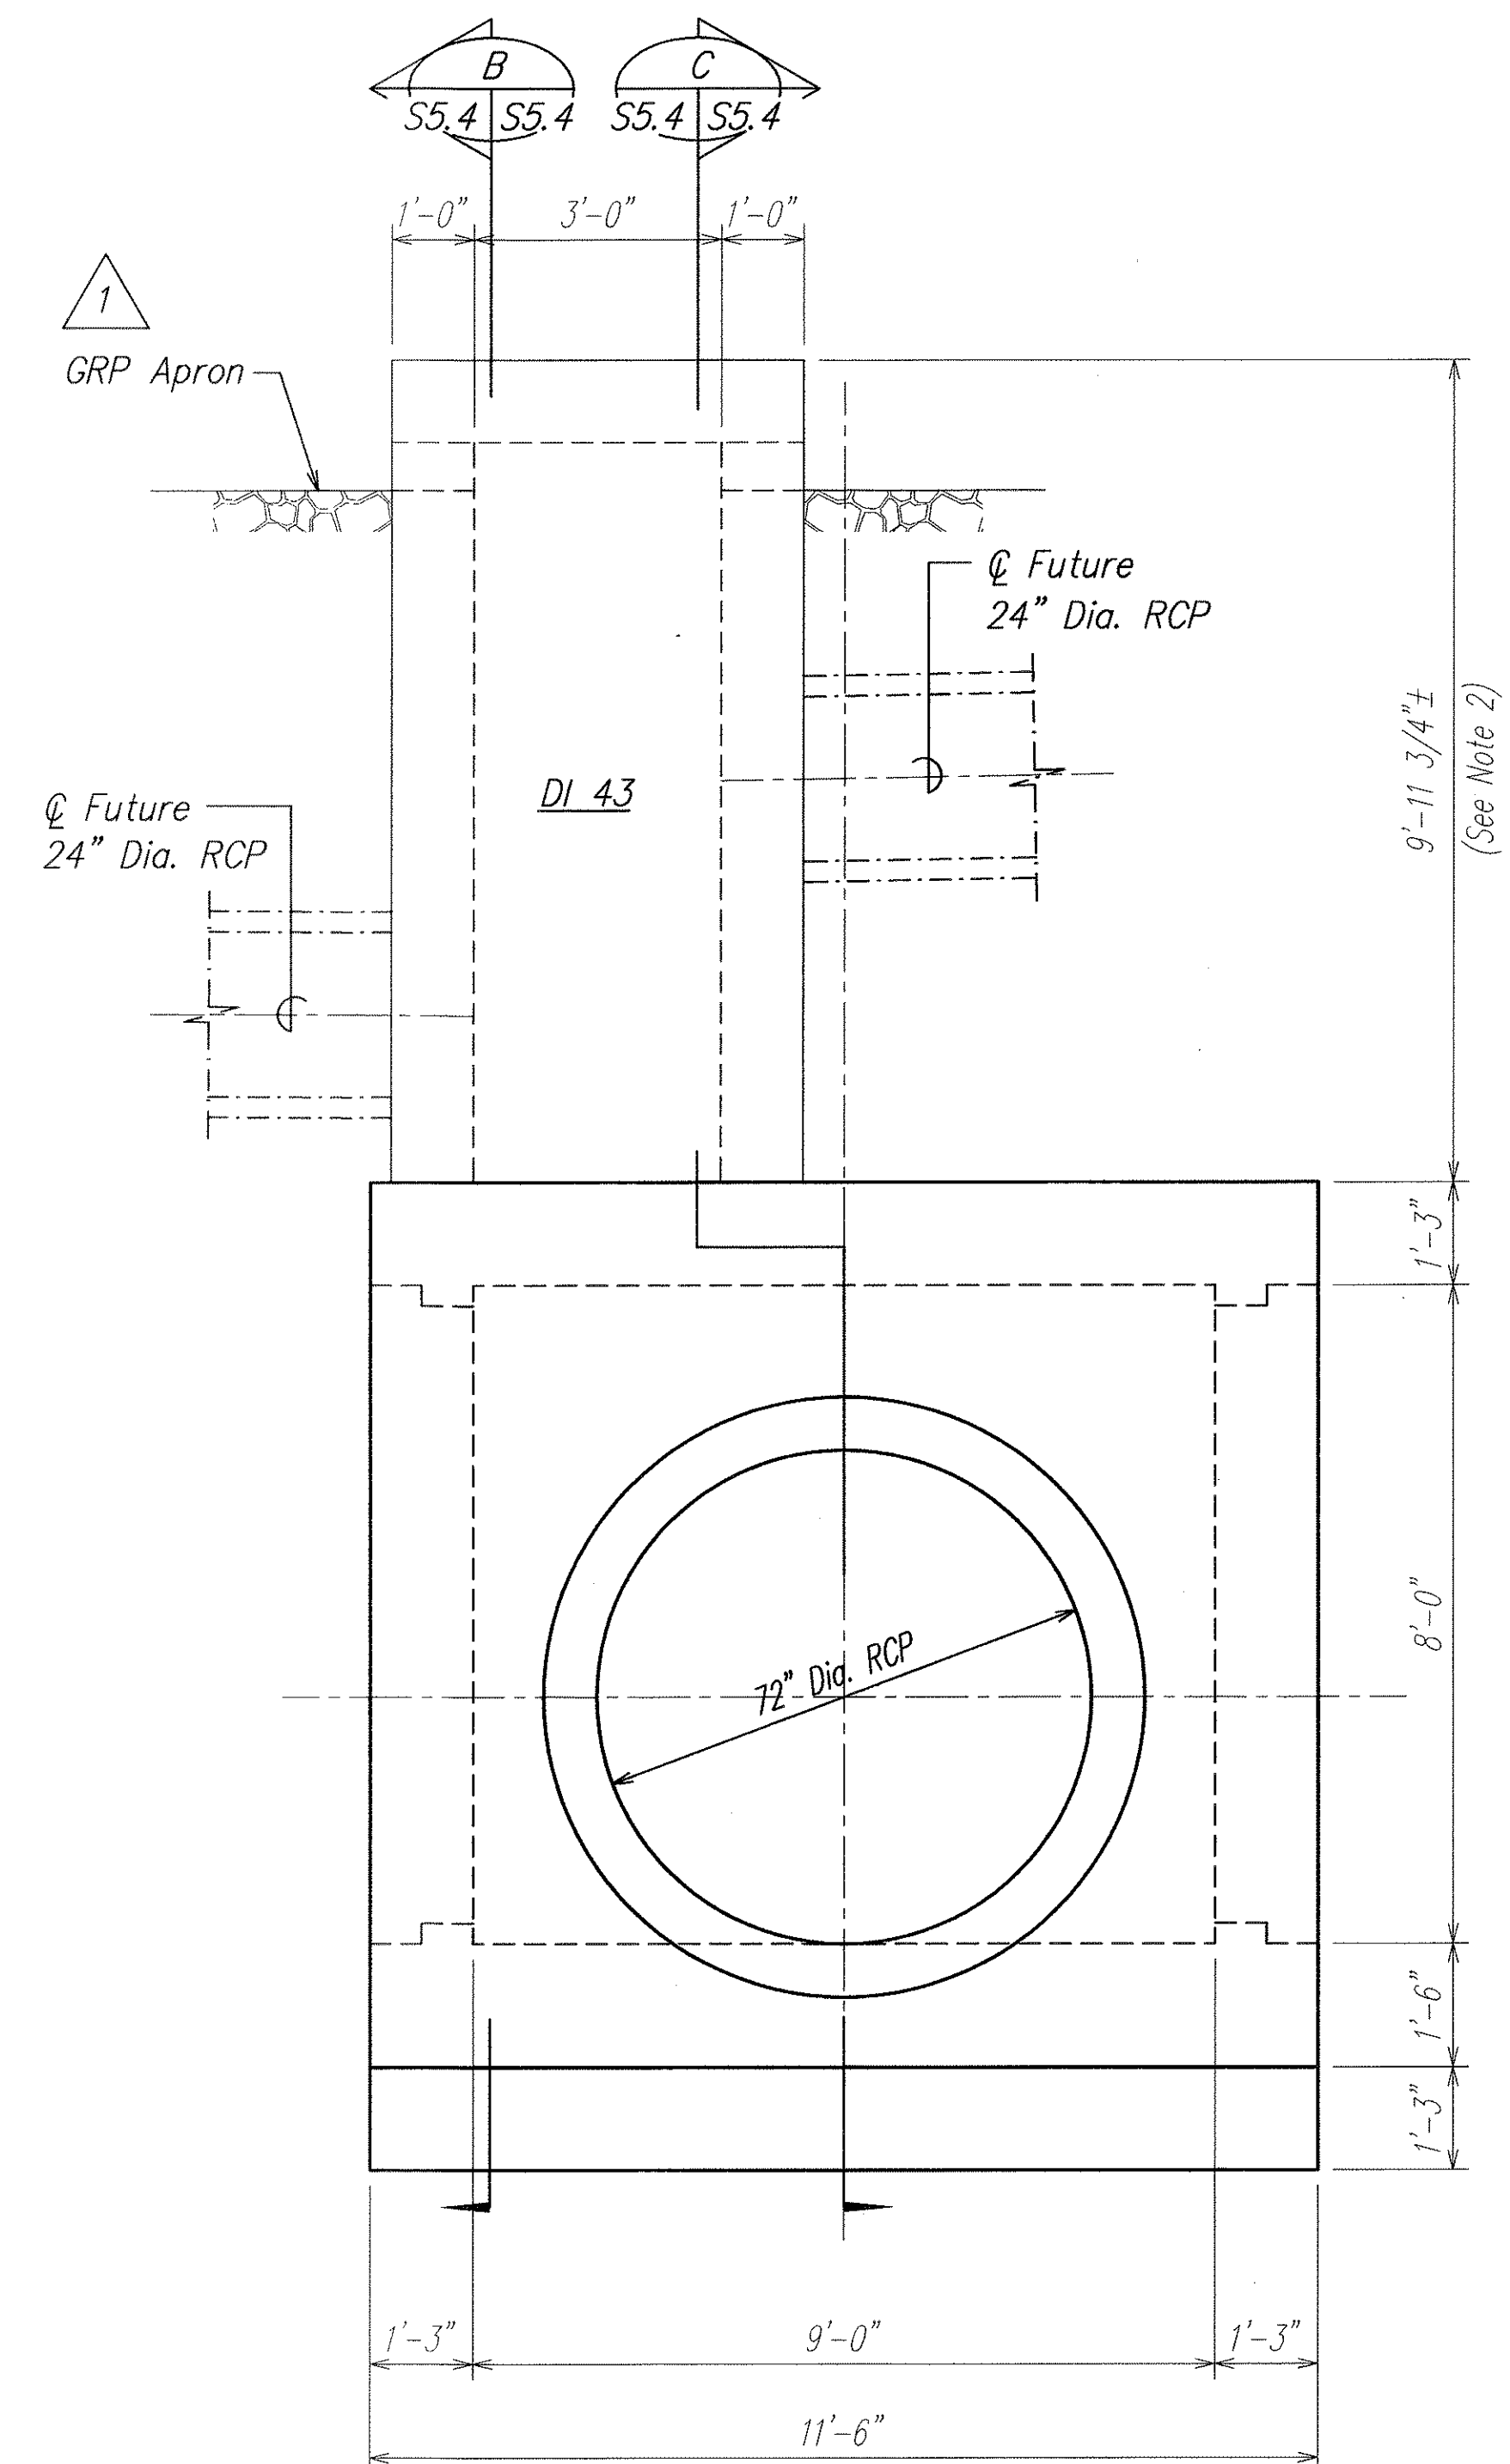


SECTION 

SCALE: $1/2" = 1'-0"$

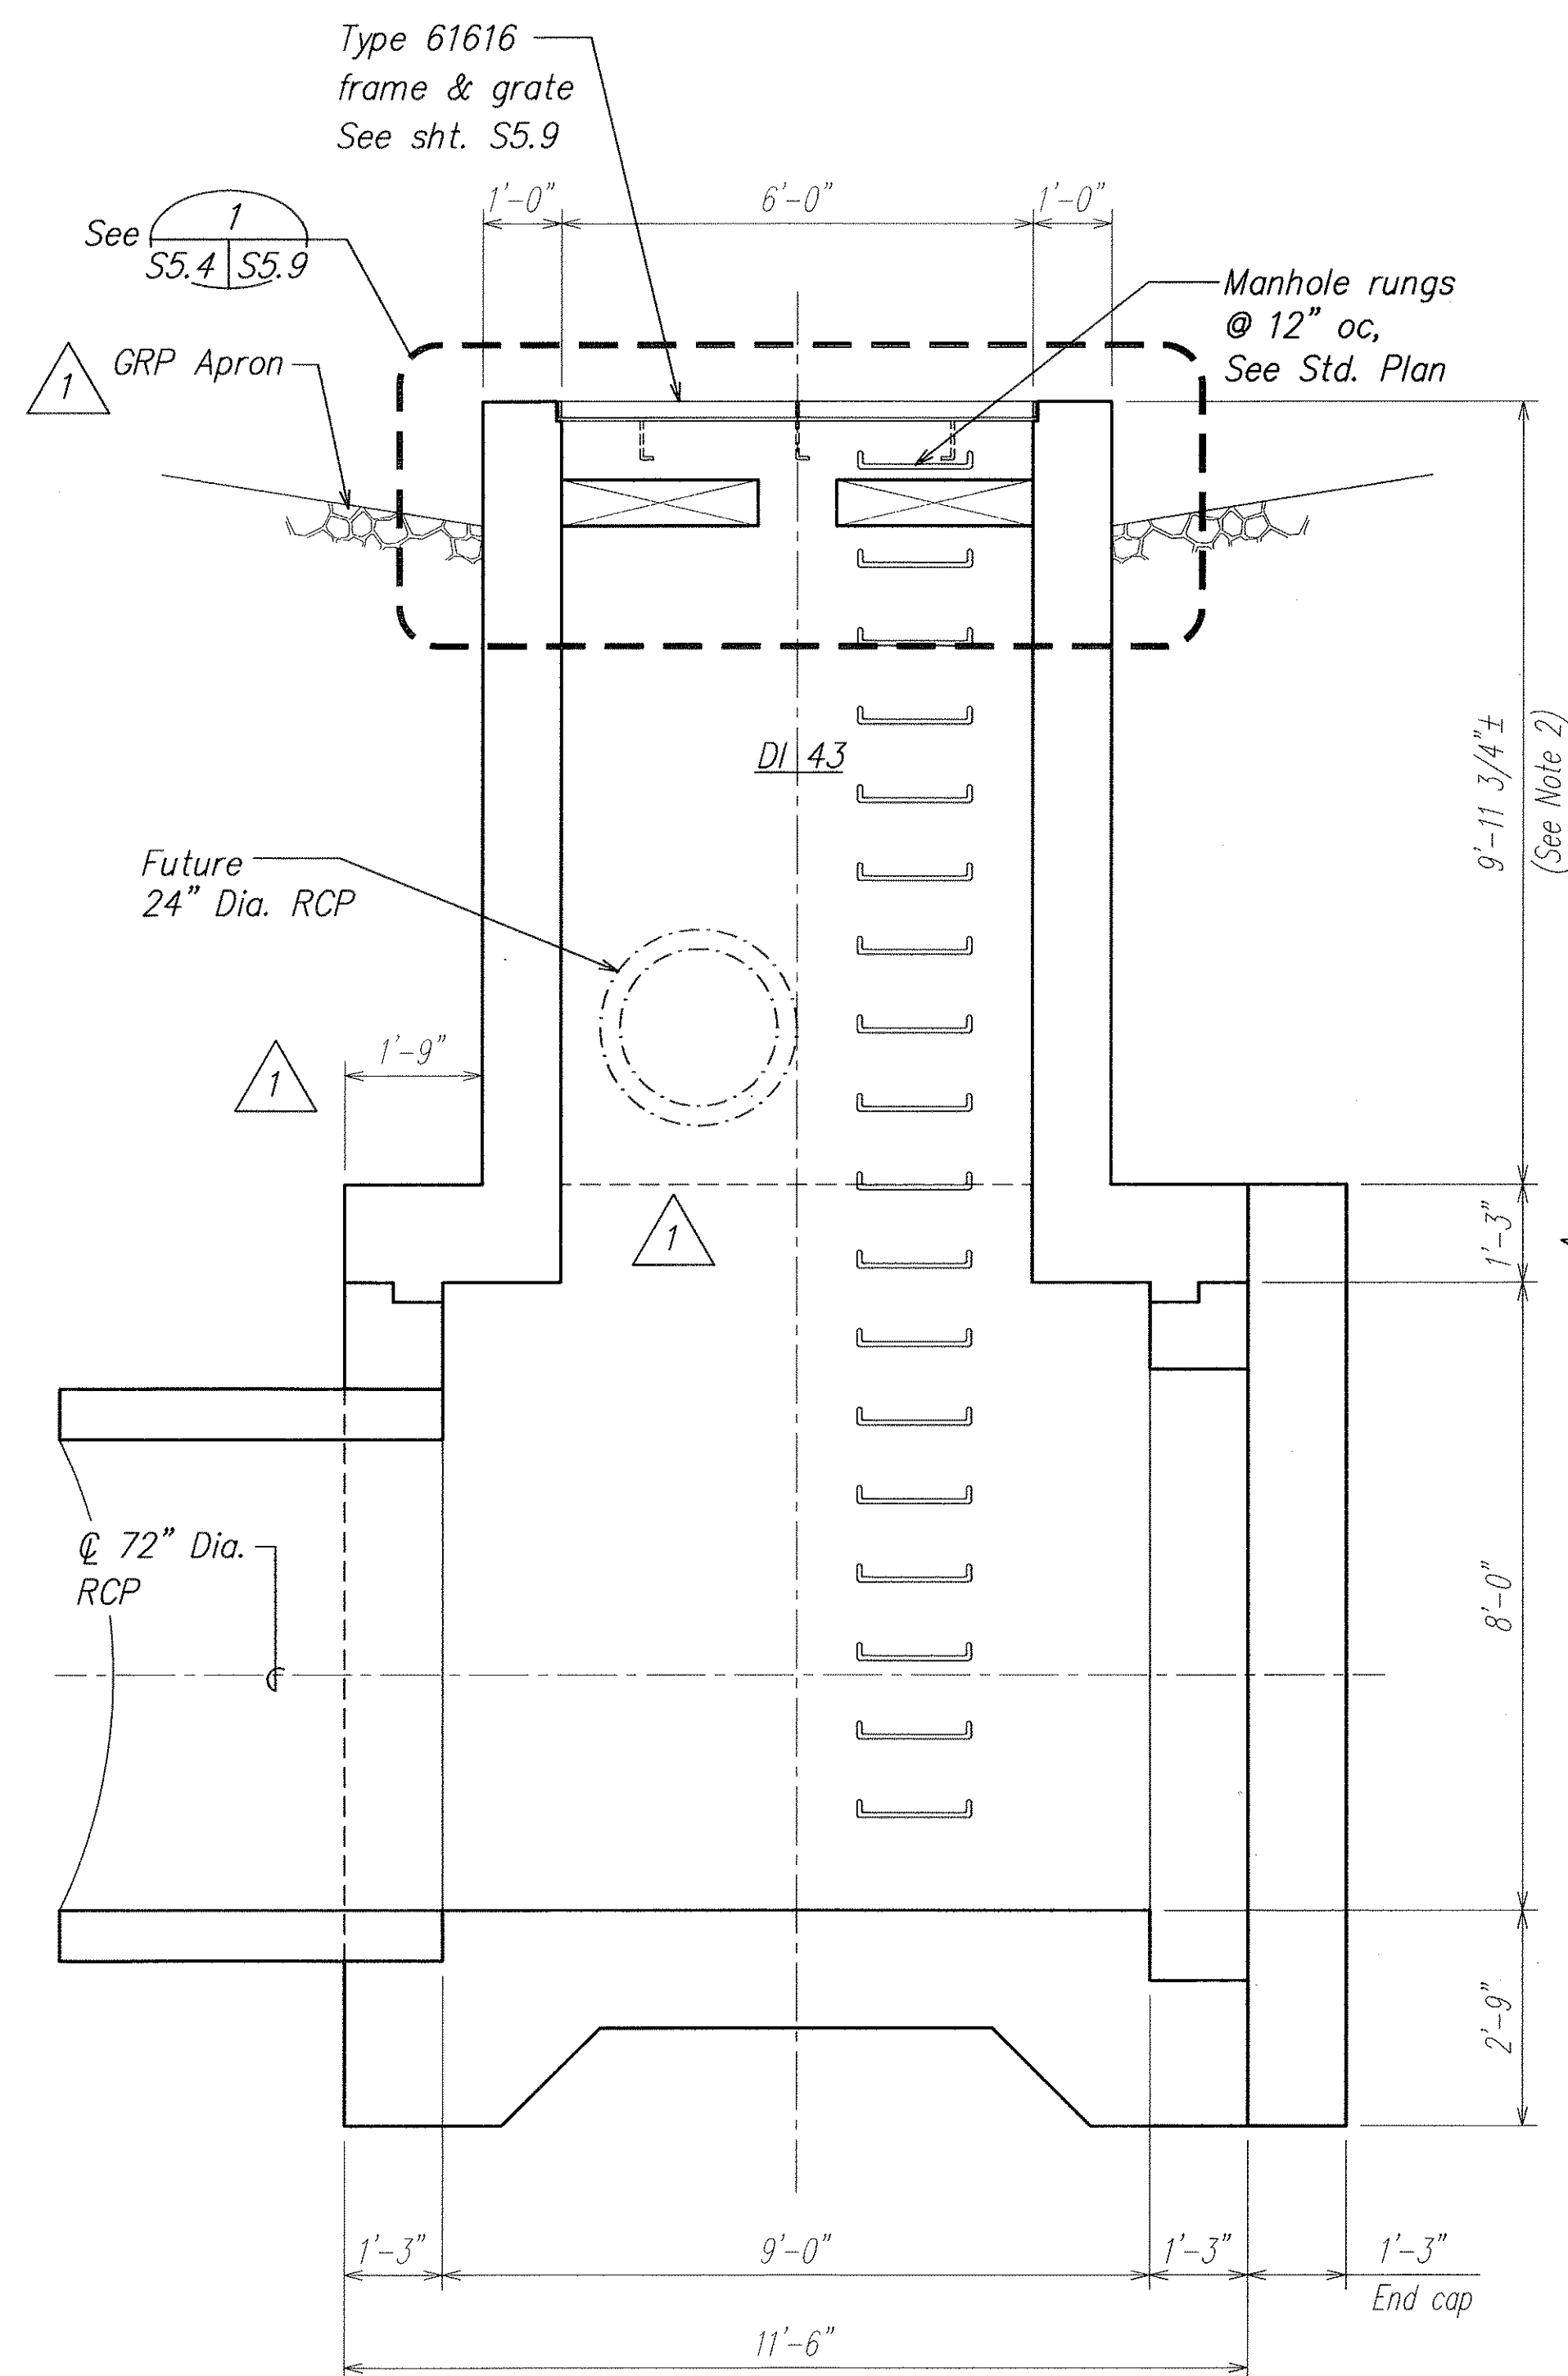


SECTION 

SCALE: $1/2" = 1'-0"$

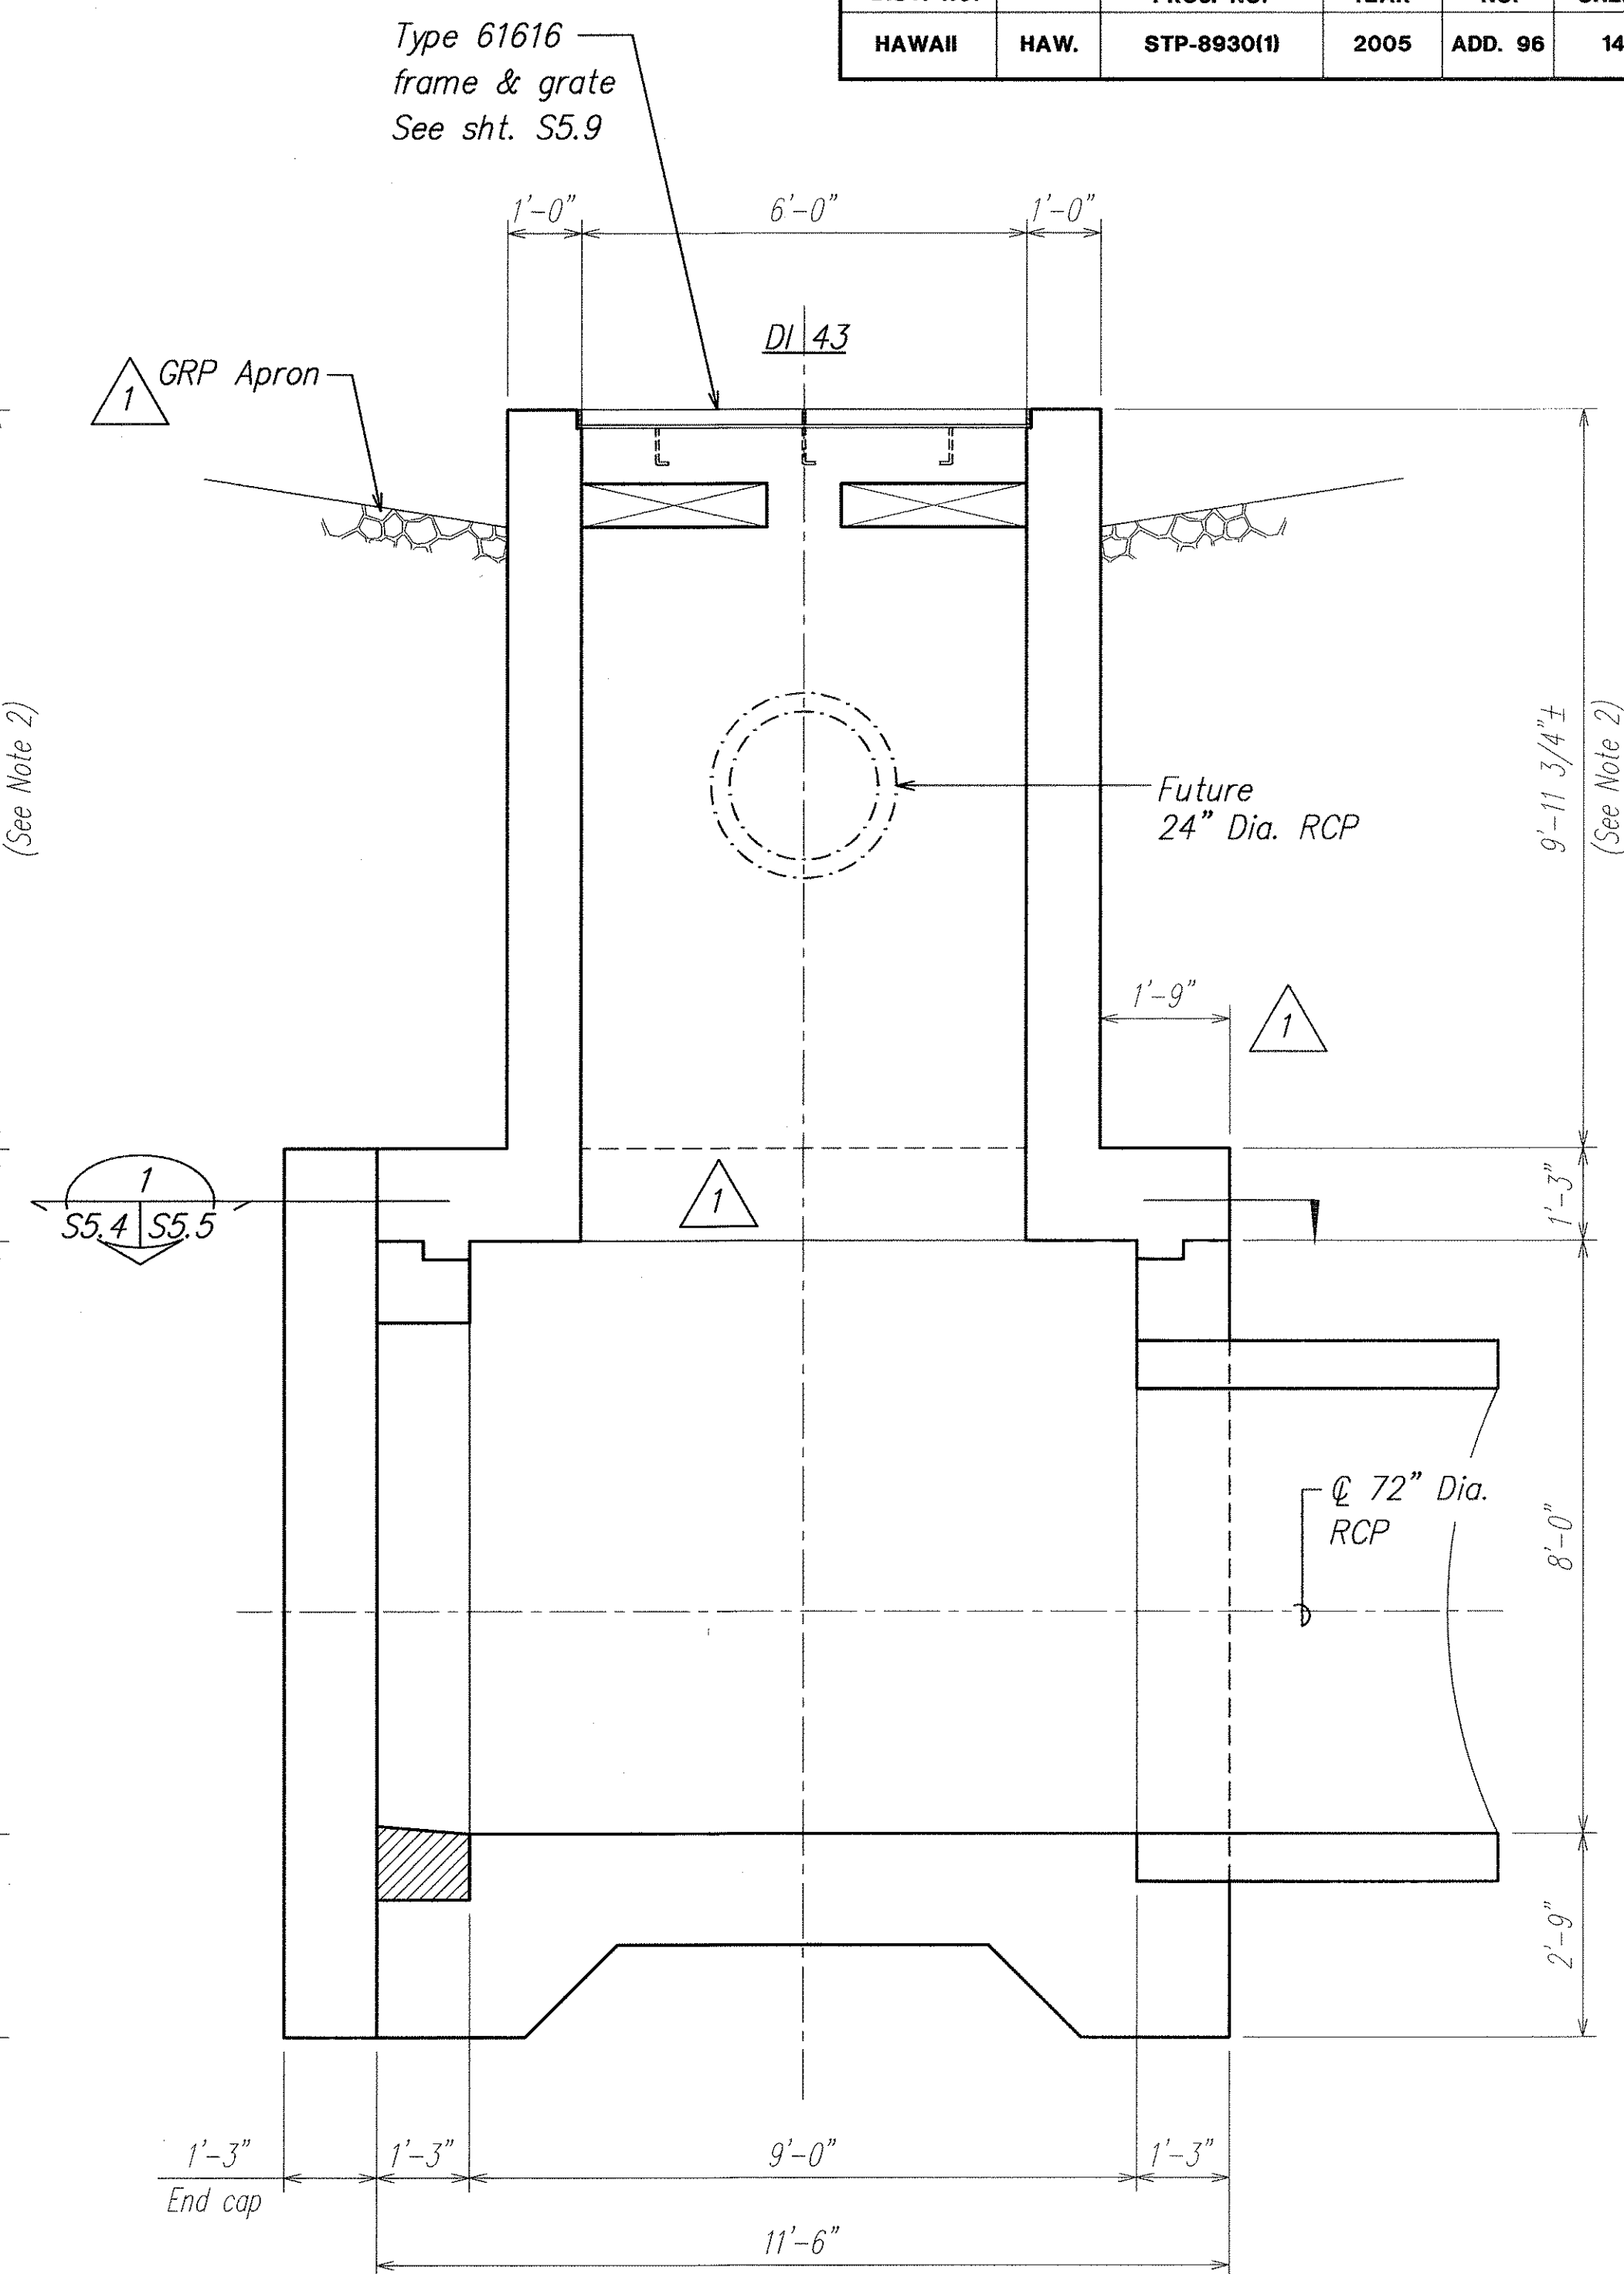

SECTION 

ORIGINAL PLAN	NOTE BOOK	SURVEY PLOTTED BY _____	DATE _____
		DRAWN BY _____	BY _____
		TRACED BY _____	BY _____
		DESIGNED BY _____	BY _____
		QUANTITIES BY _____	BY _____
	No. _____	CHECKED BY _____	BY _____

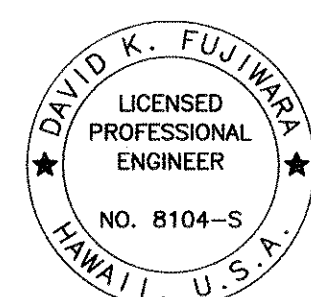

THIS WORK WAS PREPARED BY
ME OR UNDER MY SUPERVISION

David K. Ferguson
4-30-06
SIGNATURE EXPIRATION DATE OF THE LICENSE

Note:

1. Refer to sheets S5.5, S5.6 and S5.7 for reinforcing.
2. Refer to civil drawings for DI elevations and verify dimensions.

1/18/05	 Clarification of Notes and Added Dimensions
DATE	REVISION

STATE OF HAWAII
DEPARTMENT OF TRANSPORTATION
HIGHWAYS DIVISION

DRAIN CULVERT "G"
SECTIONS AT DI 43


North-South Road
Phase 1A

F.A.I. Proj. No. STP-8930(1)


Scale: As Noted Date: Dec. 22, 2004

SHEET No. S5.4 OF 43 SHEETS


FED. ROAD DIST. NO.	STATE	FED. AID PROJ. NO.	FISCAL YEAR	SHEET NO.	TOTAL SHEETS
HAWAII	HAW.	STP-8930(1)	2005	ADD. 97	144

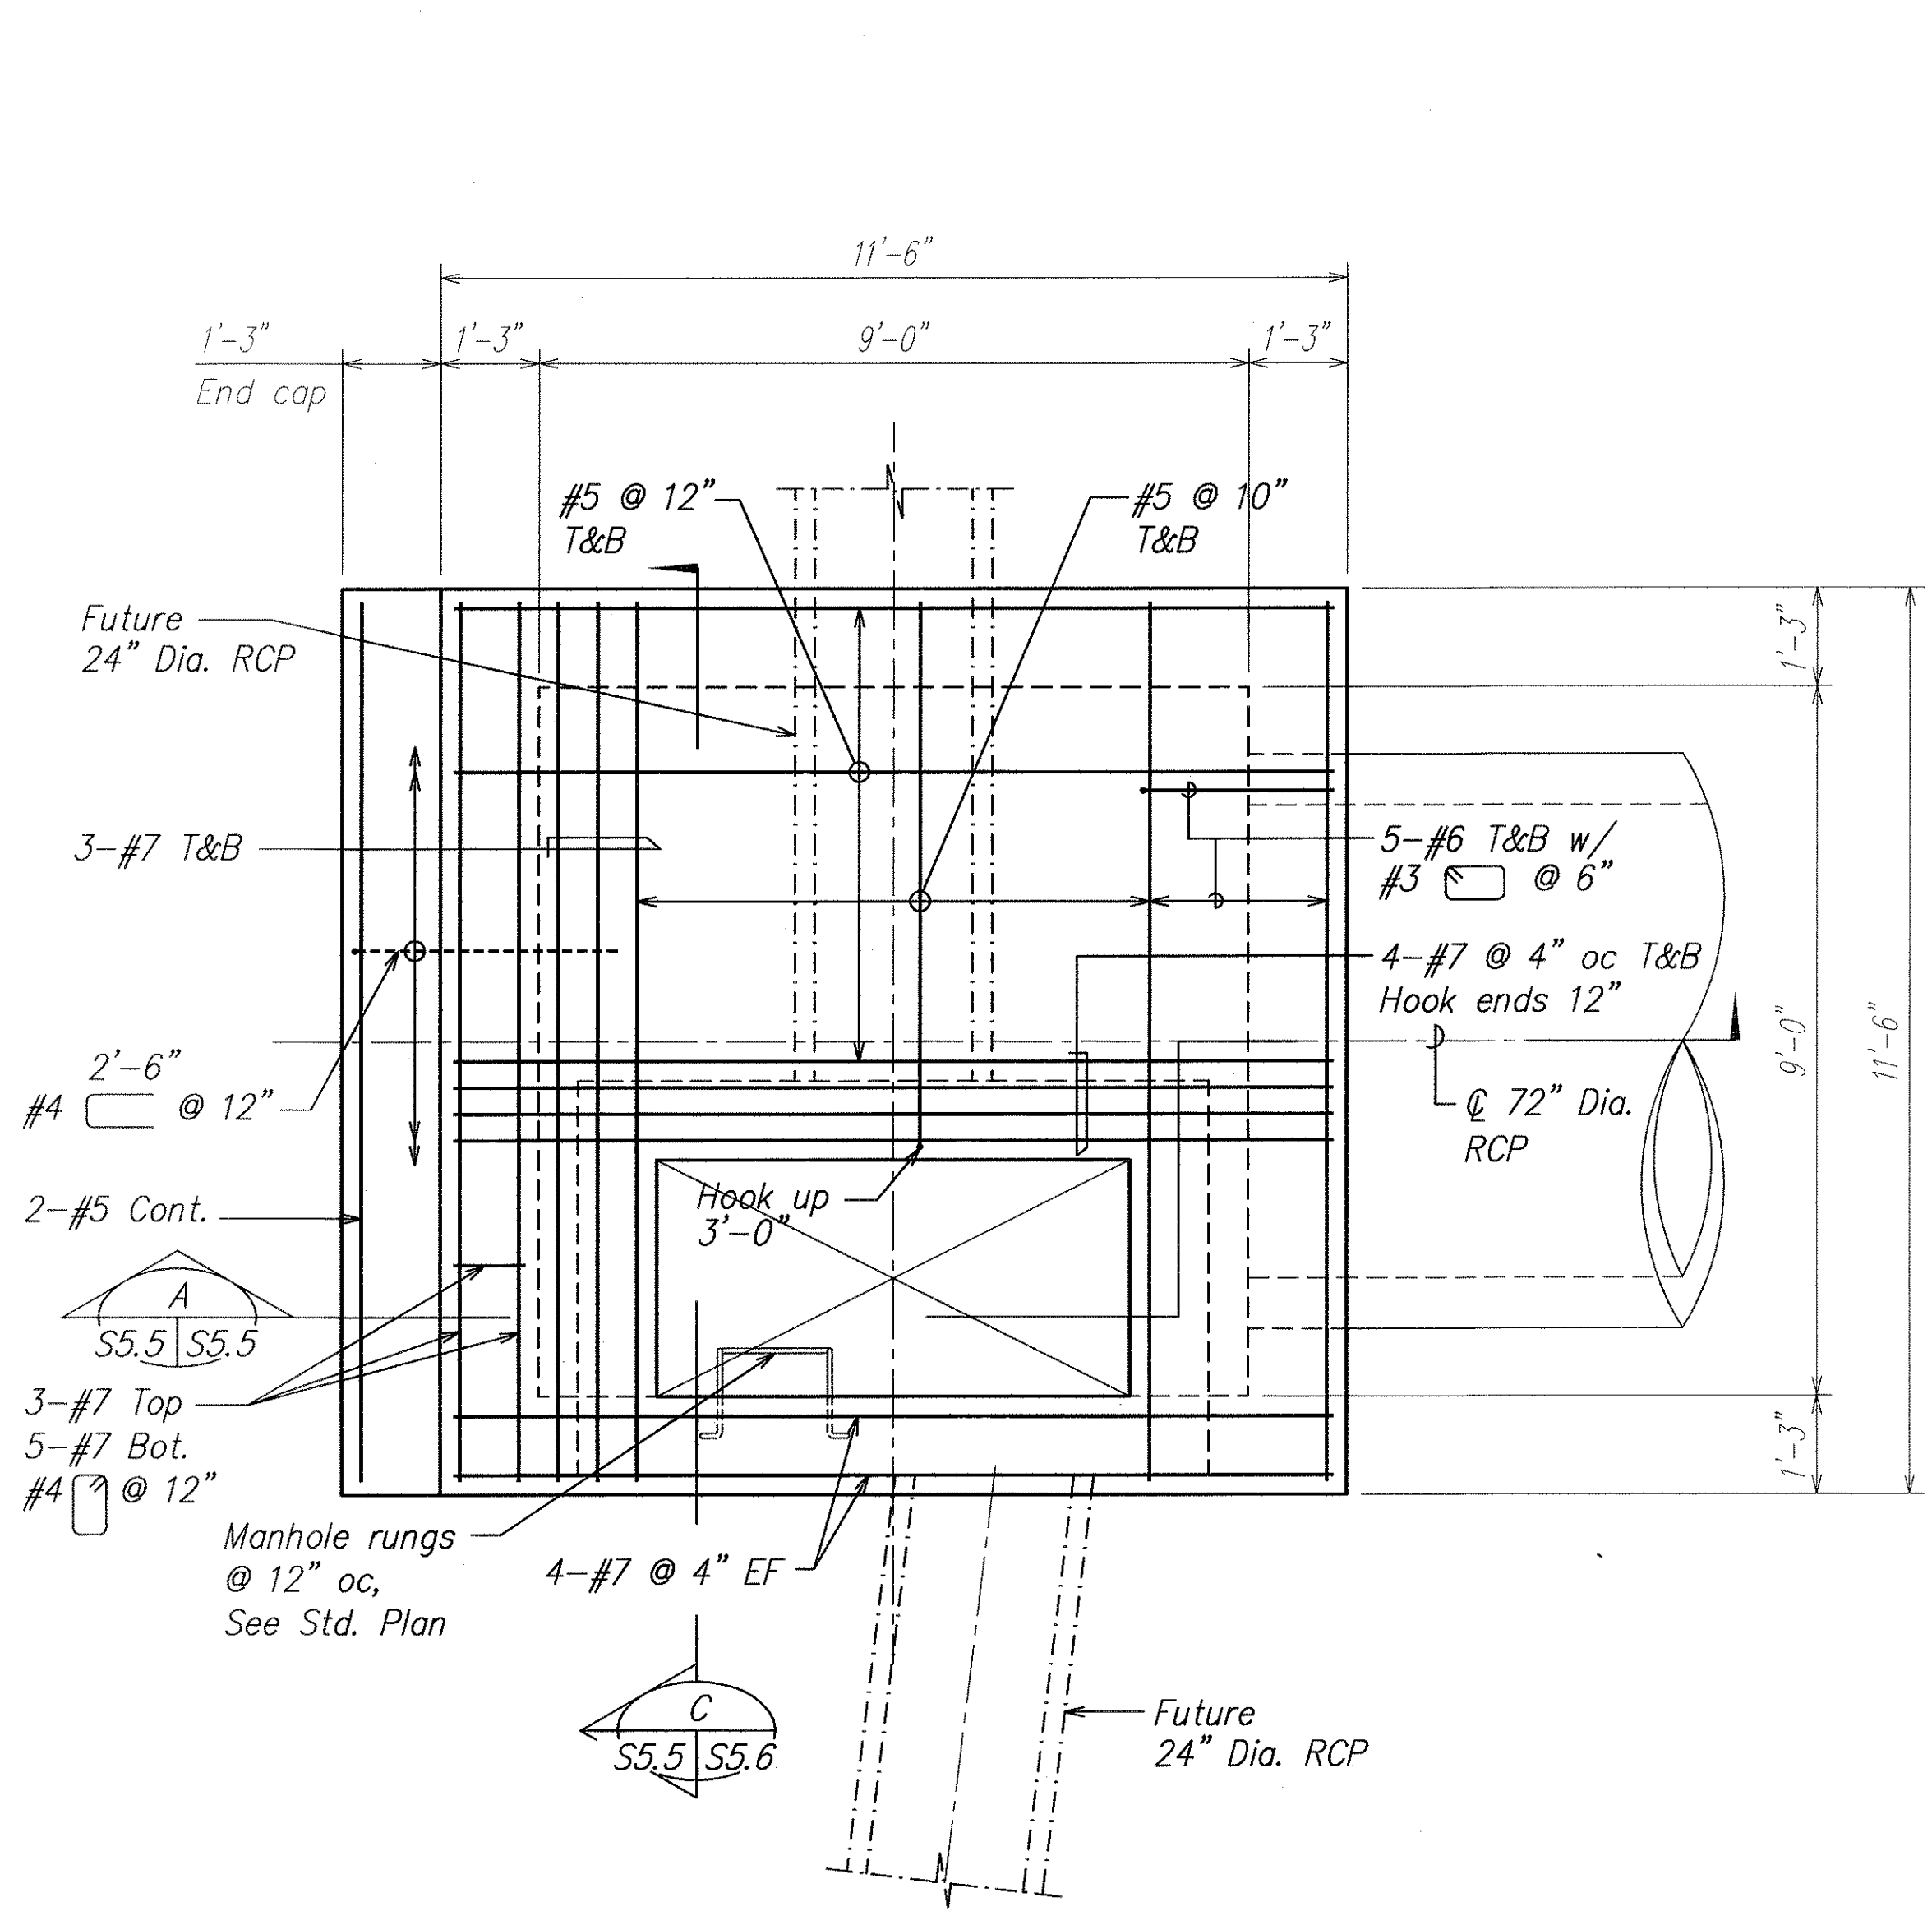

DRAIN CULVERT "F" & "G" - SECTION AT DI 38 & 43
SCALE: 1/2" = 1'-0" S4.2, S4.3, S5.3, S5.4, S5.5, S5.5

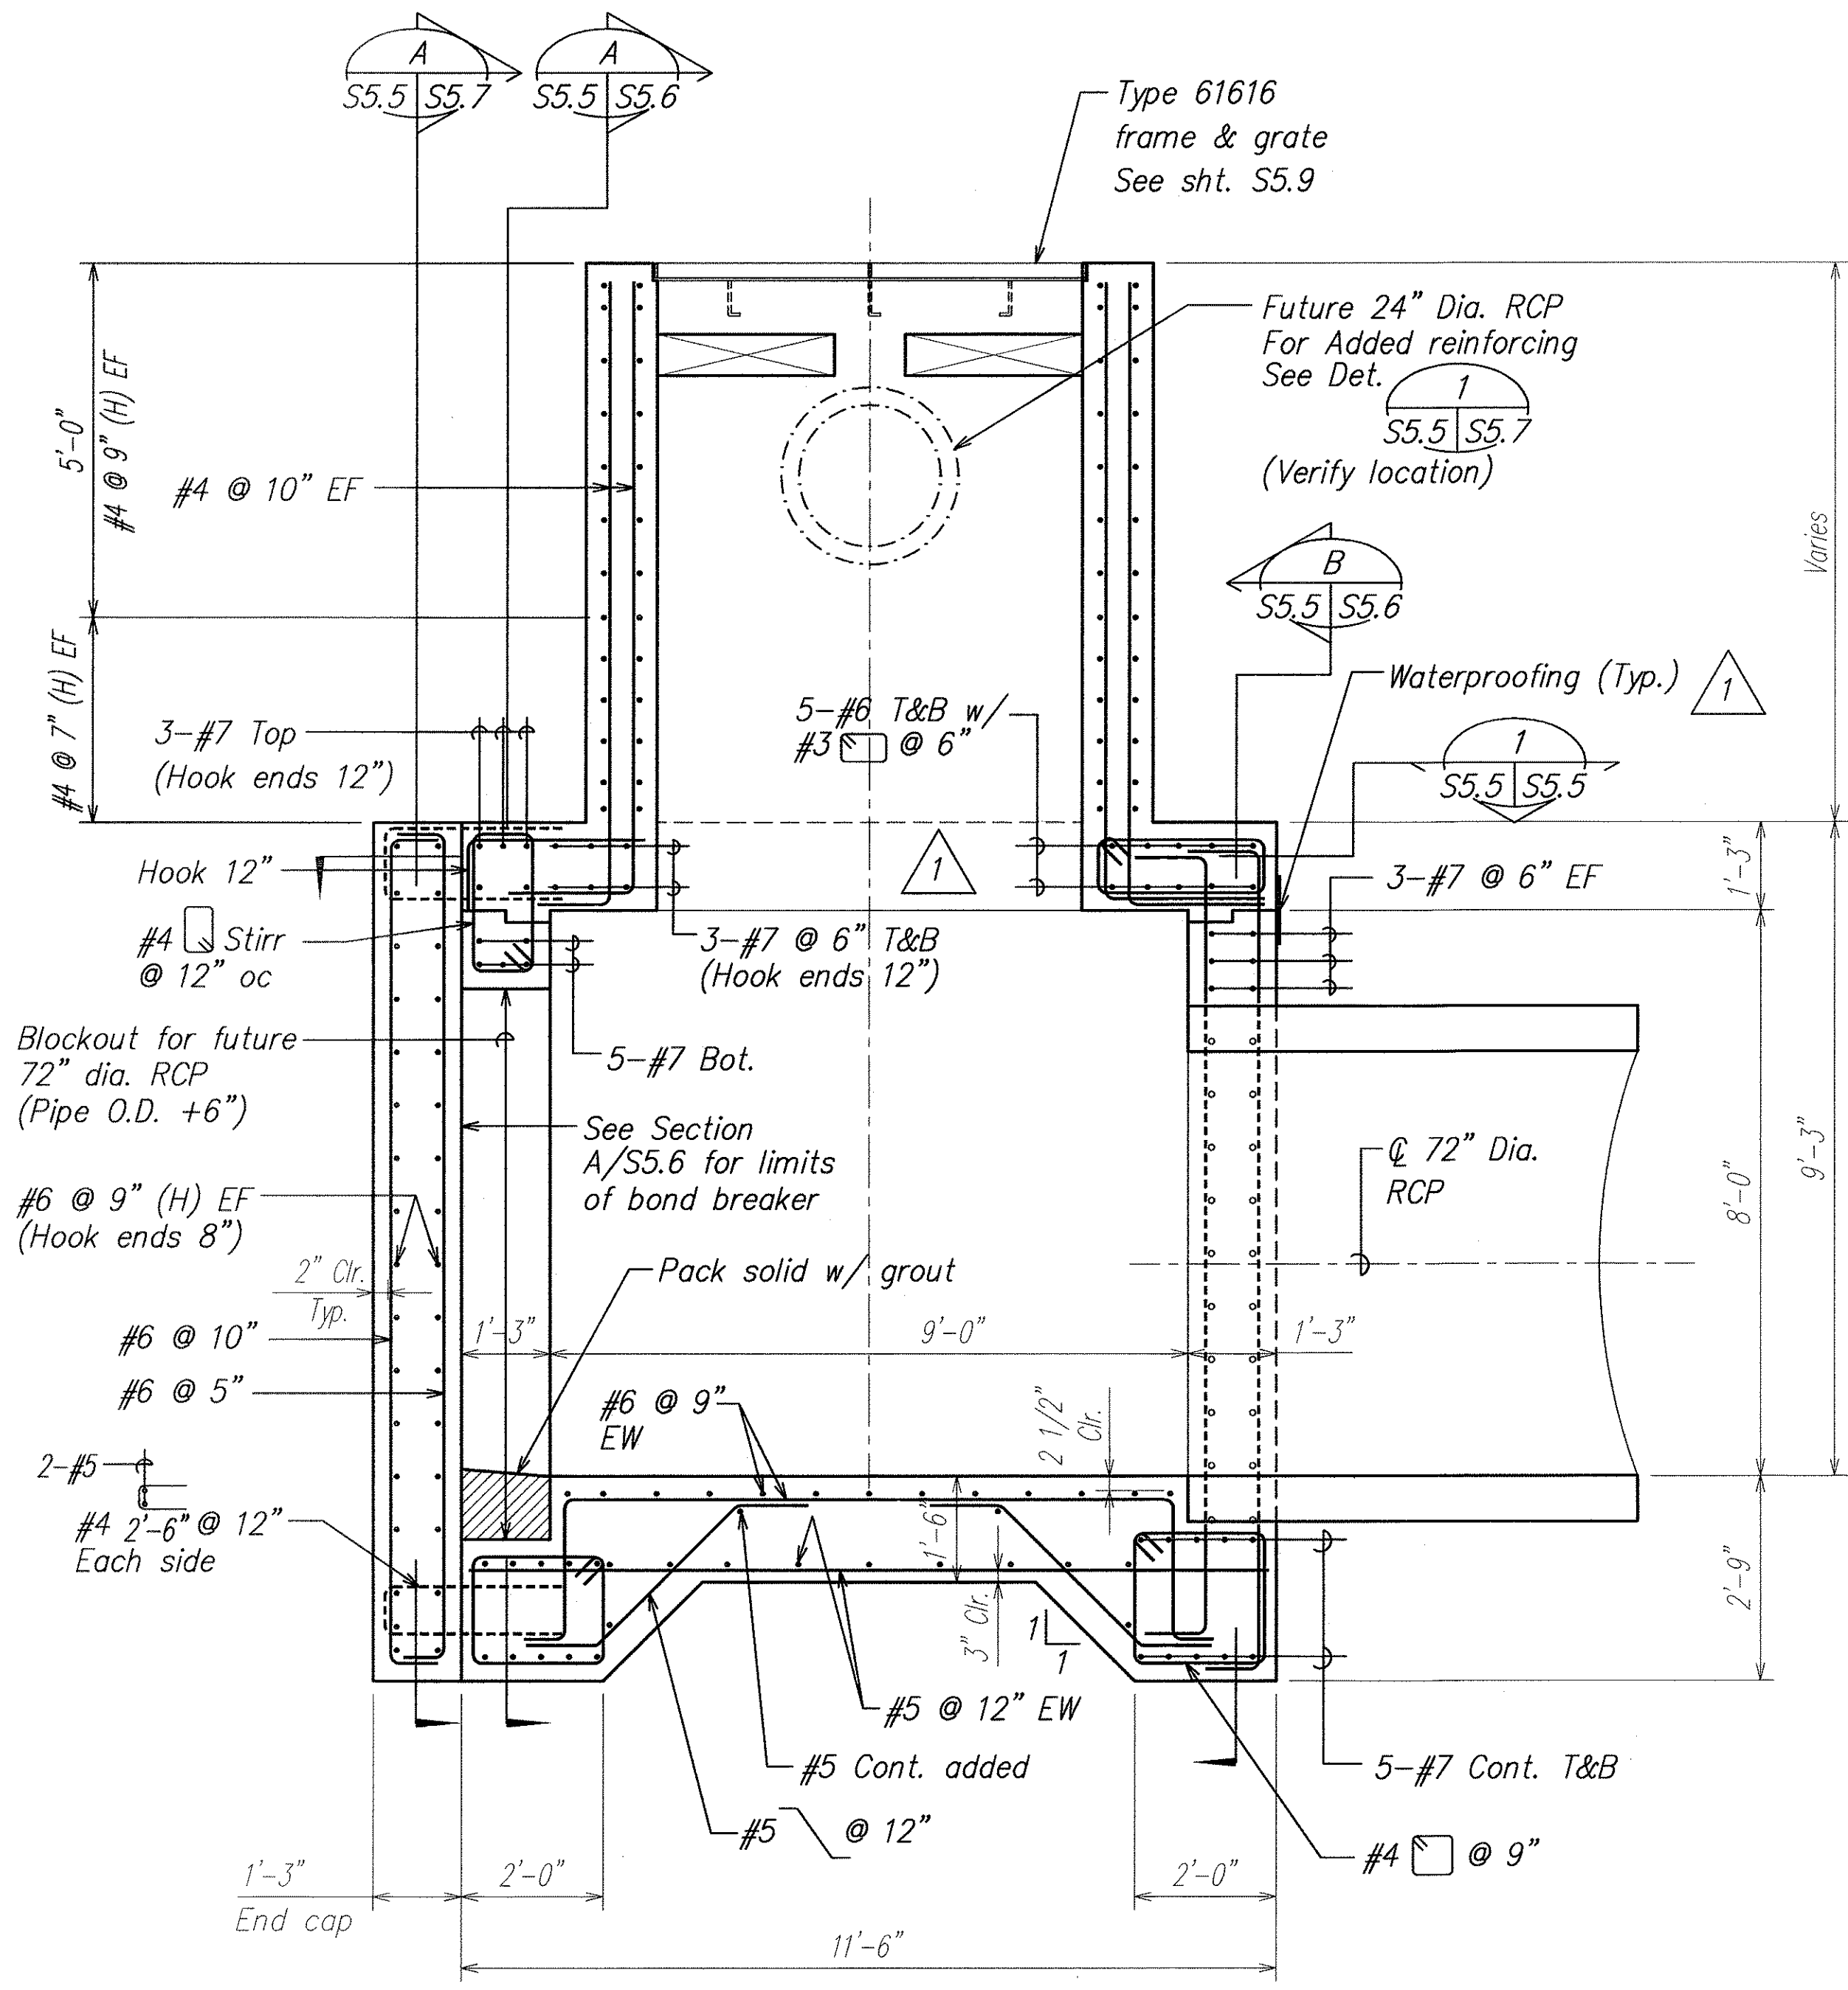

SECTION
SCALE: 1/2" = 1'-0" S4.2, S4.3, S5.5, S5.6, S5.7, S5.5

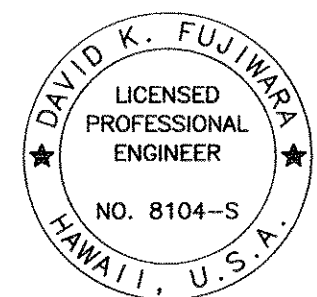

THIS WORK WAS PREPARED BY ME OR UNDER MY SUPERVISION.

Signature: David K. Fujiwara
EXPIRATION DATE OF THE LICENSE: 4-30-06

STATE OF HAWAII
DEPARTMENT OF TRANSPORTATION
HIGHWAYS DIVISION

DRAIN CULVERT "F" AND "G"
SECTIONS AT DI 38 AND 43


North-South Road
Phase 1A
F.A.I. Proj. No. STP-8930(1)

Scale: As Noted Date: Dec. 22, 2004


SHEET No. S5.5 OF 43 SHEETS

1/18/05	1	Clarification
DATE	REVISION	


FED. ROAD DIST. NO.	STATE	FED. AID PROJ. NO.	FISCAL YEAR	SHEET NO.	TOTAL SHEETS
HAWAII	HAW.	STP-8930(1)	2005	ADD. 98	144

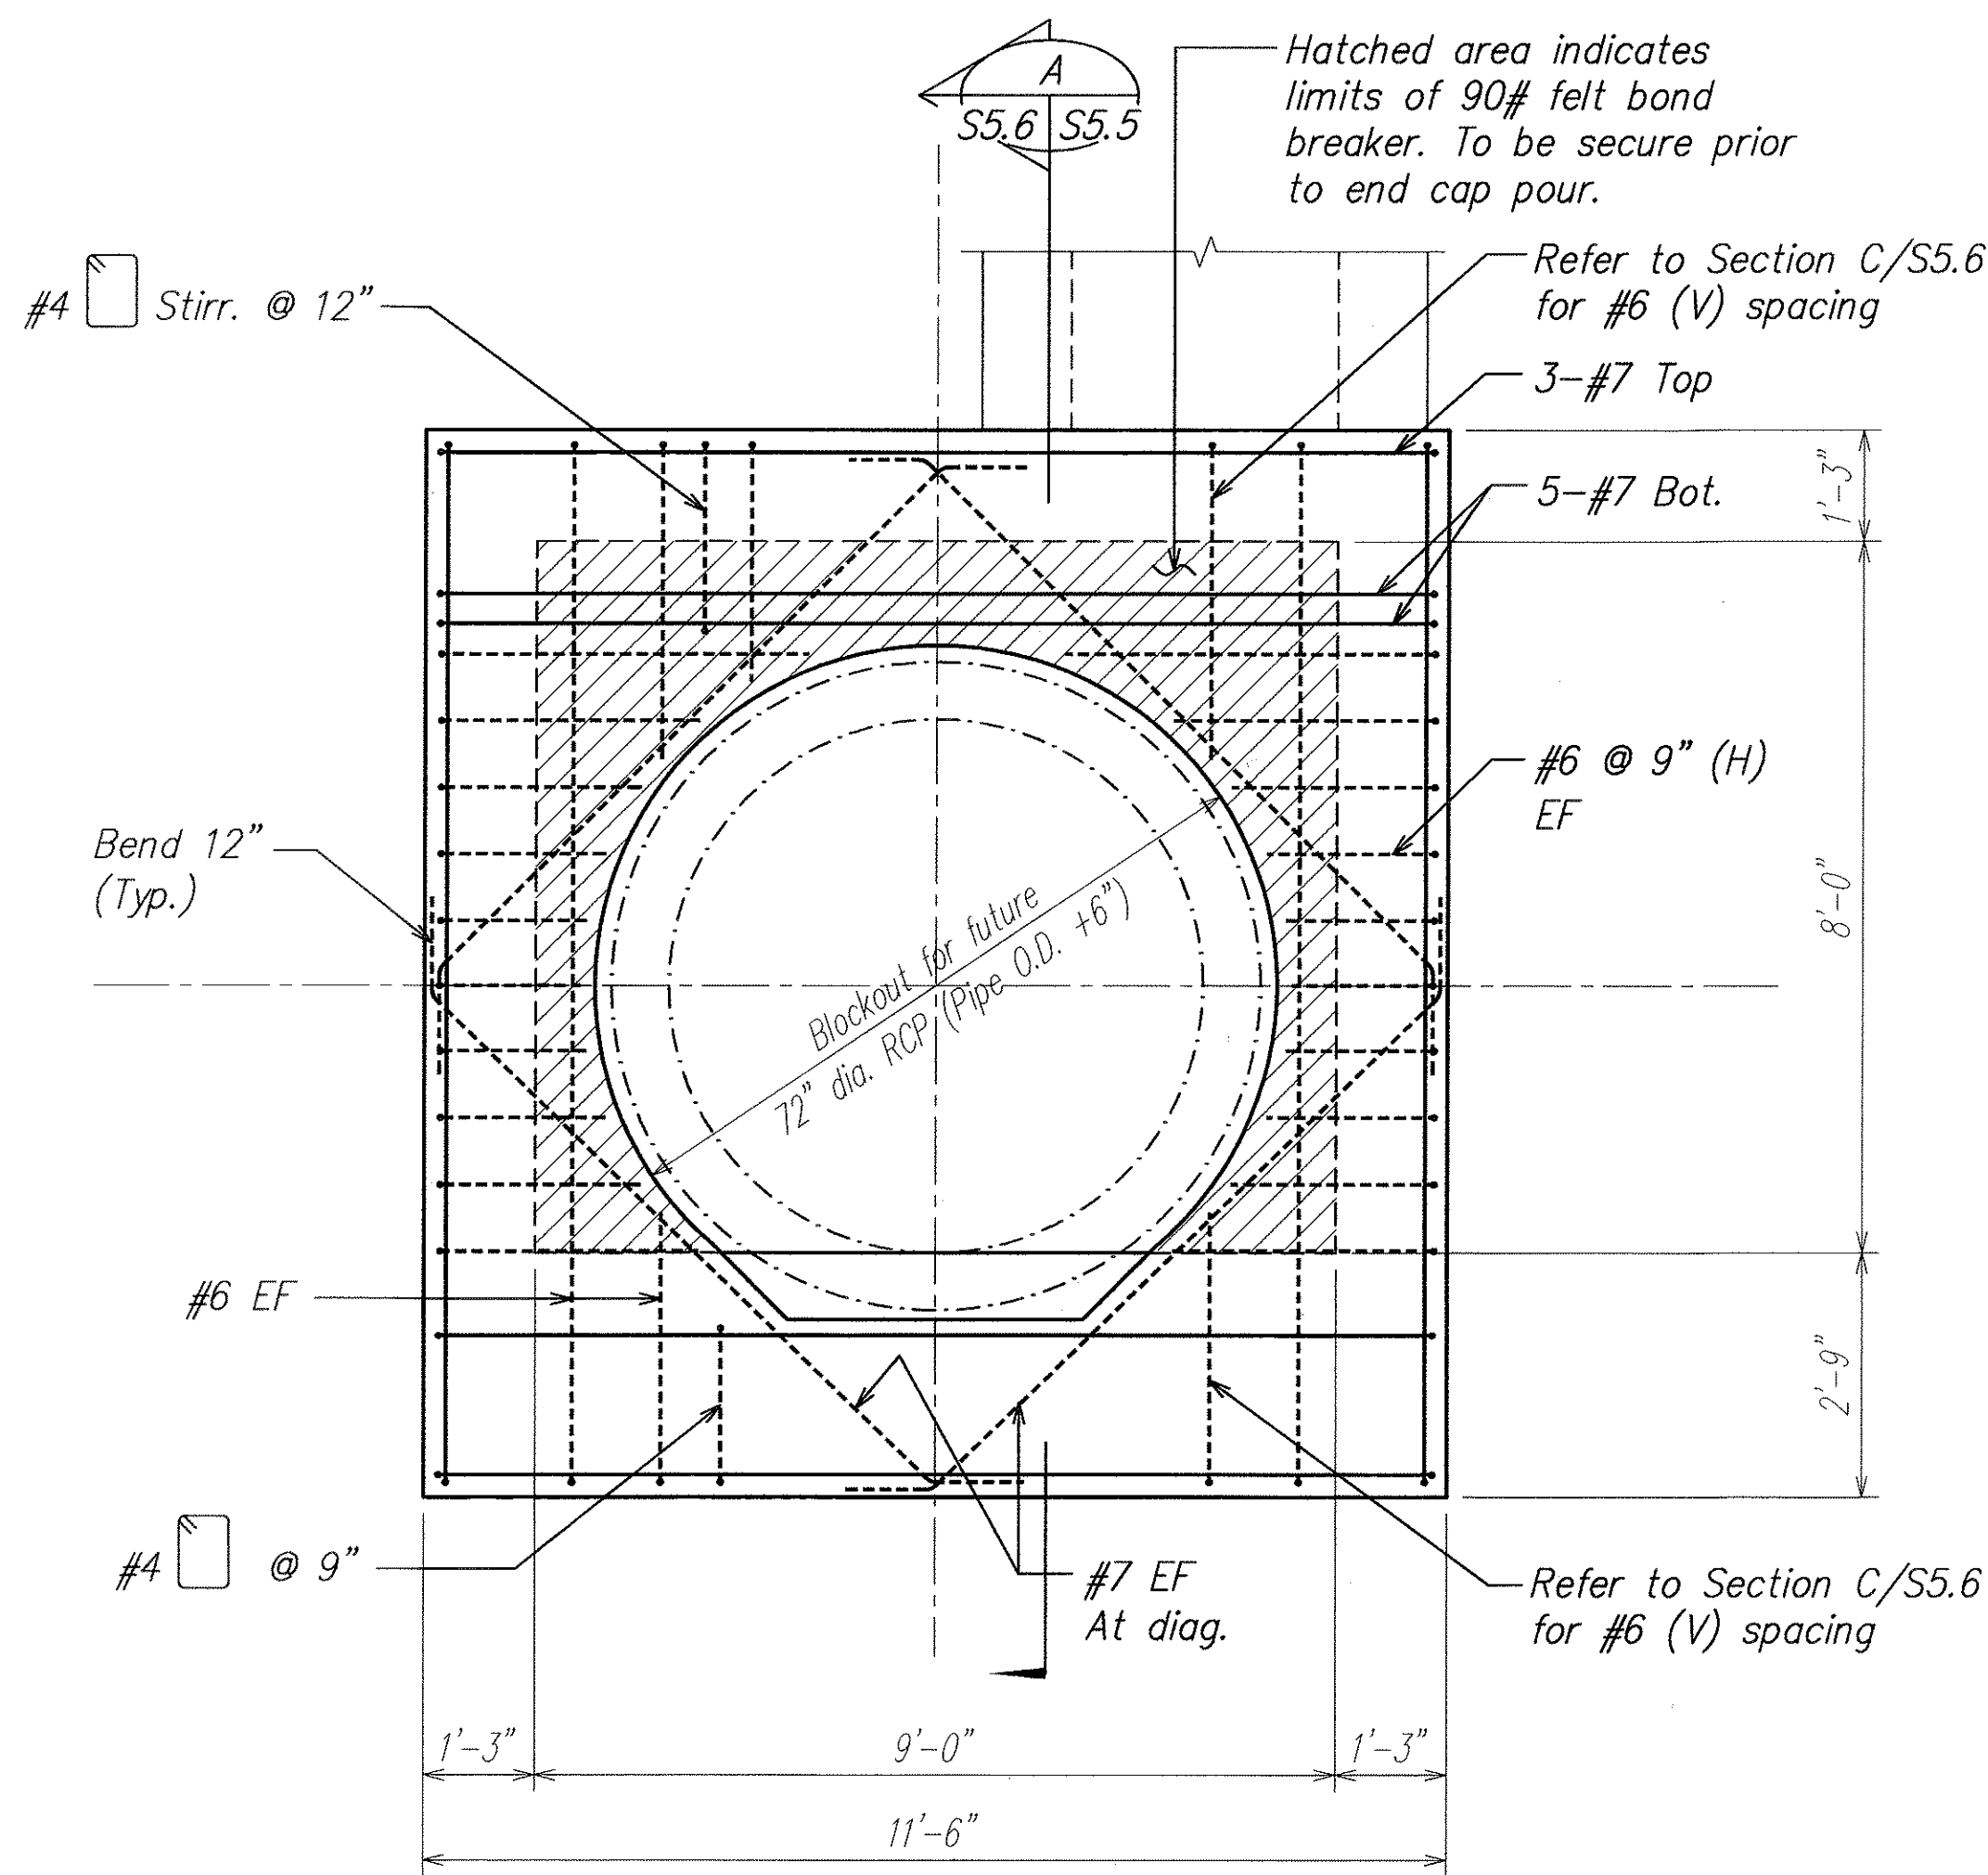


SECTION A
SCALE: 1/2" = 1'-0"
S5.5 S5.6

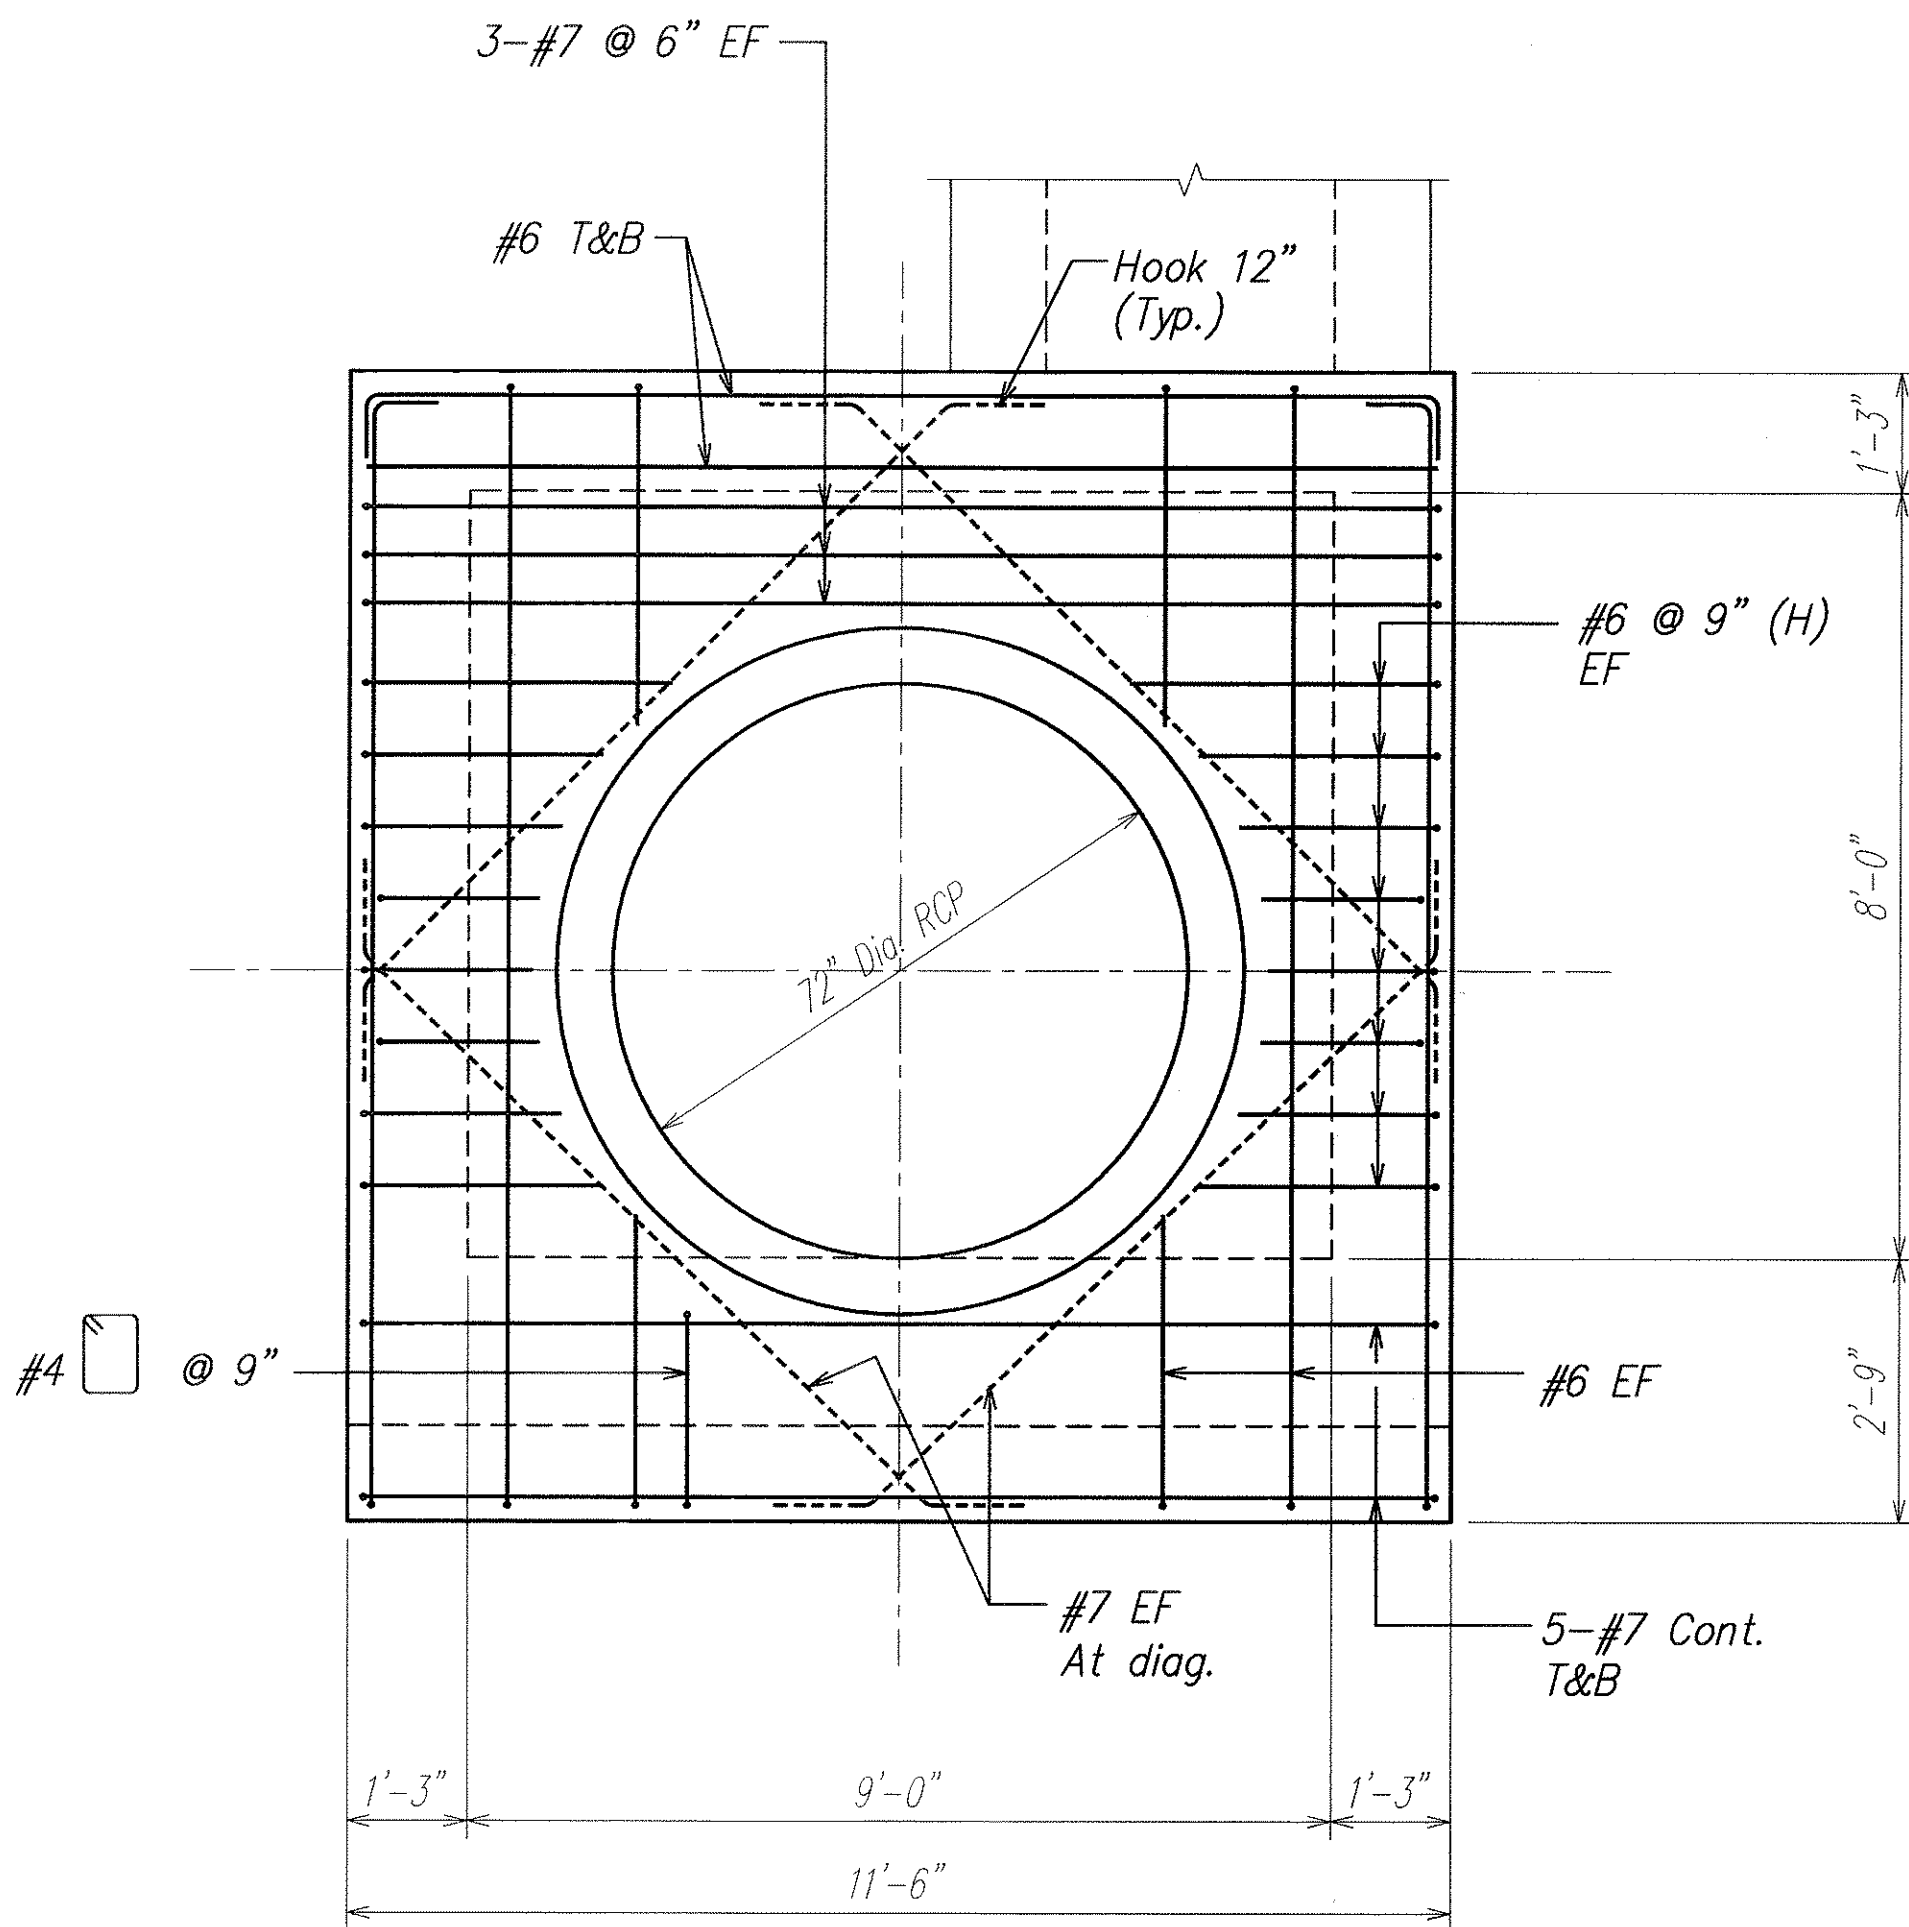


SECTION B
SCALE: 1/2" = 1'-0"
S5.5 S5.6

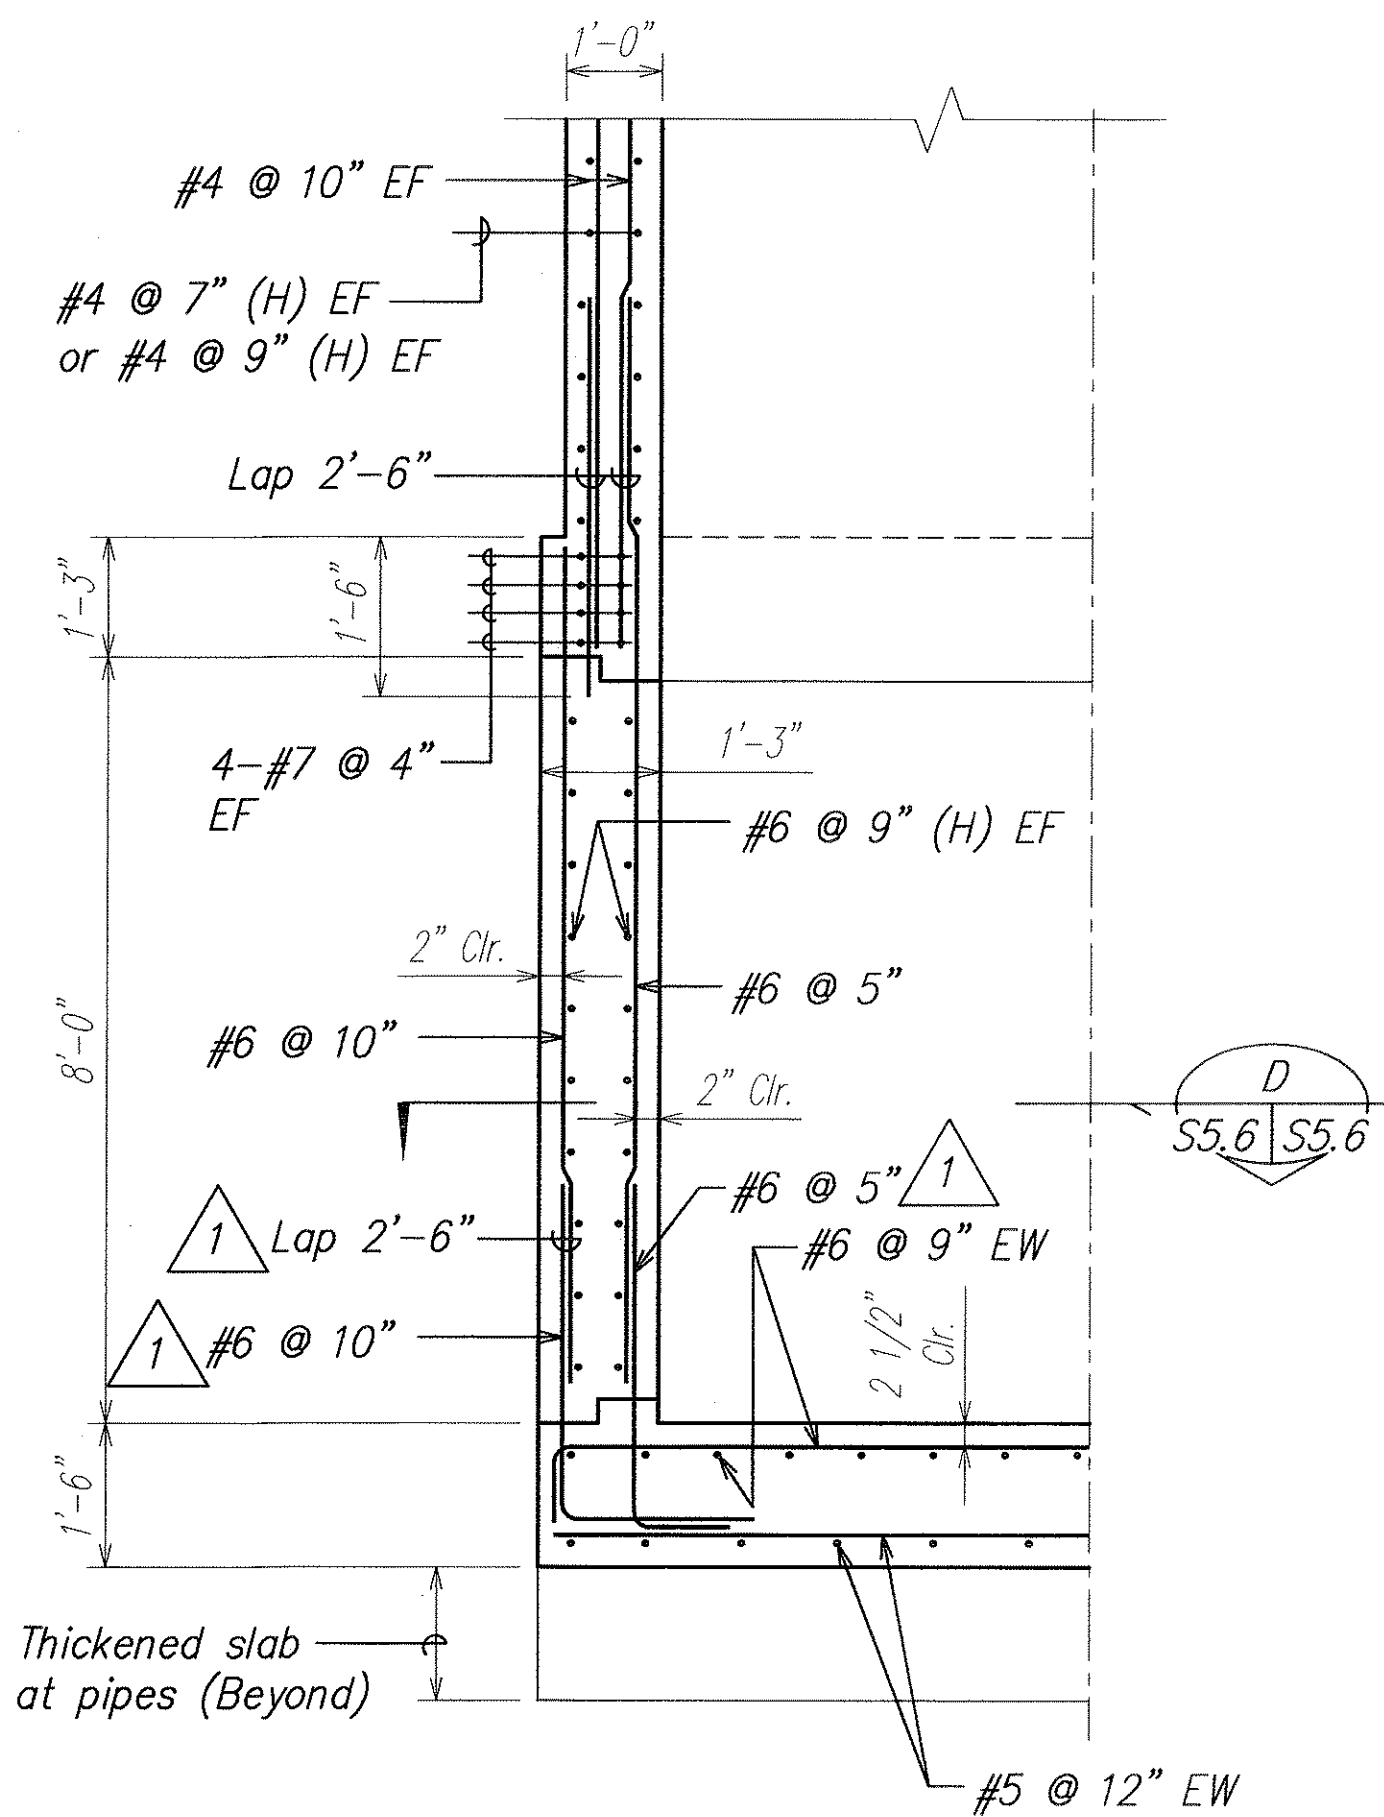

SECTION C
SCALE: 1/2" = 1'-0"
S5.2 S5.5 S5.6 S5.6

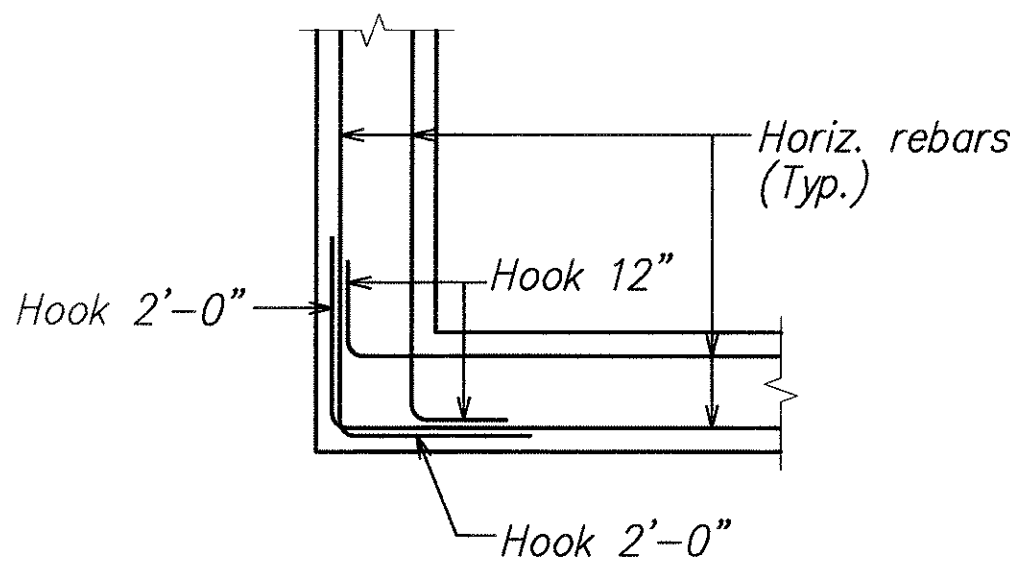

SECTION D
SCALE: 1/2" = 1'-0"
S5.6 S5.6

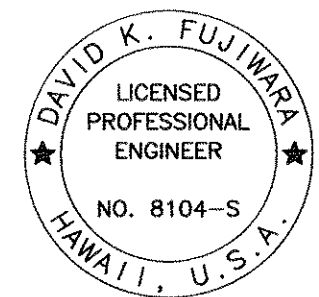

THIS WORK WAS PREPARED BY ME OR UNDER MY SUPERVISION.

Signature: David K. Fujiwara
Expiration Date of License: 4-30-08

STATE OF HAWAII
DEPARTMENT OF TRANSPORTATION
HIGHWAYS DIVISION

DRAIN CULVERT "E", "F" AND "G" SECTIONS


North-South Road
Phase 1A
F.A.I. Proj. No. STP-8930(1)

Scale: As Noted Date: Dec. 22, 2004


SHEET No. S5.6 OF 43 SHEETS

1/18/05	1	Clarification of Note
DATE	REVISION	


FED. ROAD DIST. NO.	STATE	FED. AID PROJ. NO.	FISCAL YEAR	SHEET NO.	TOTAL SHEETS
HAWAII	HAW.	STP-8930(1)	2005	ADD. 99	144

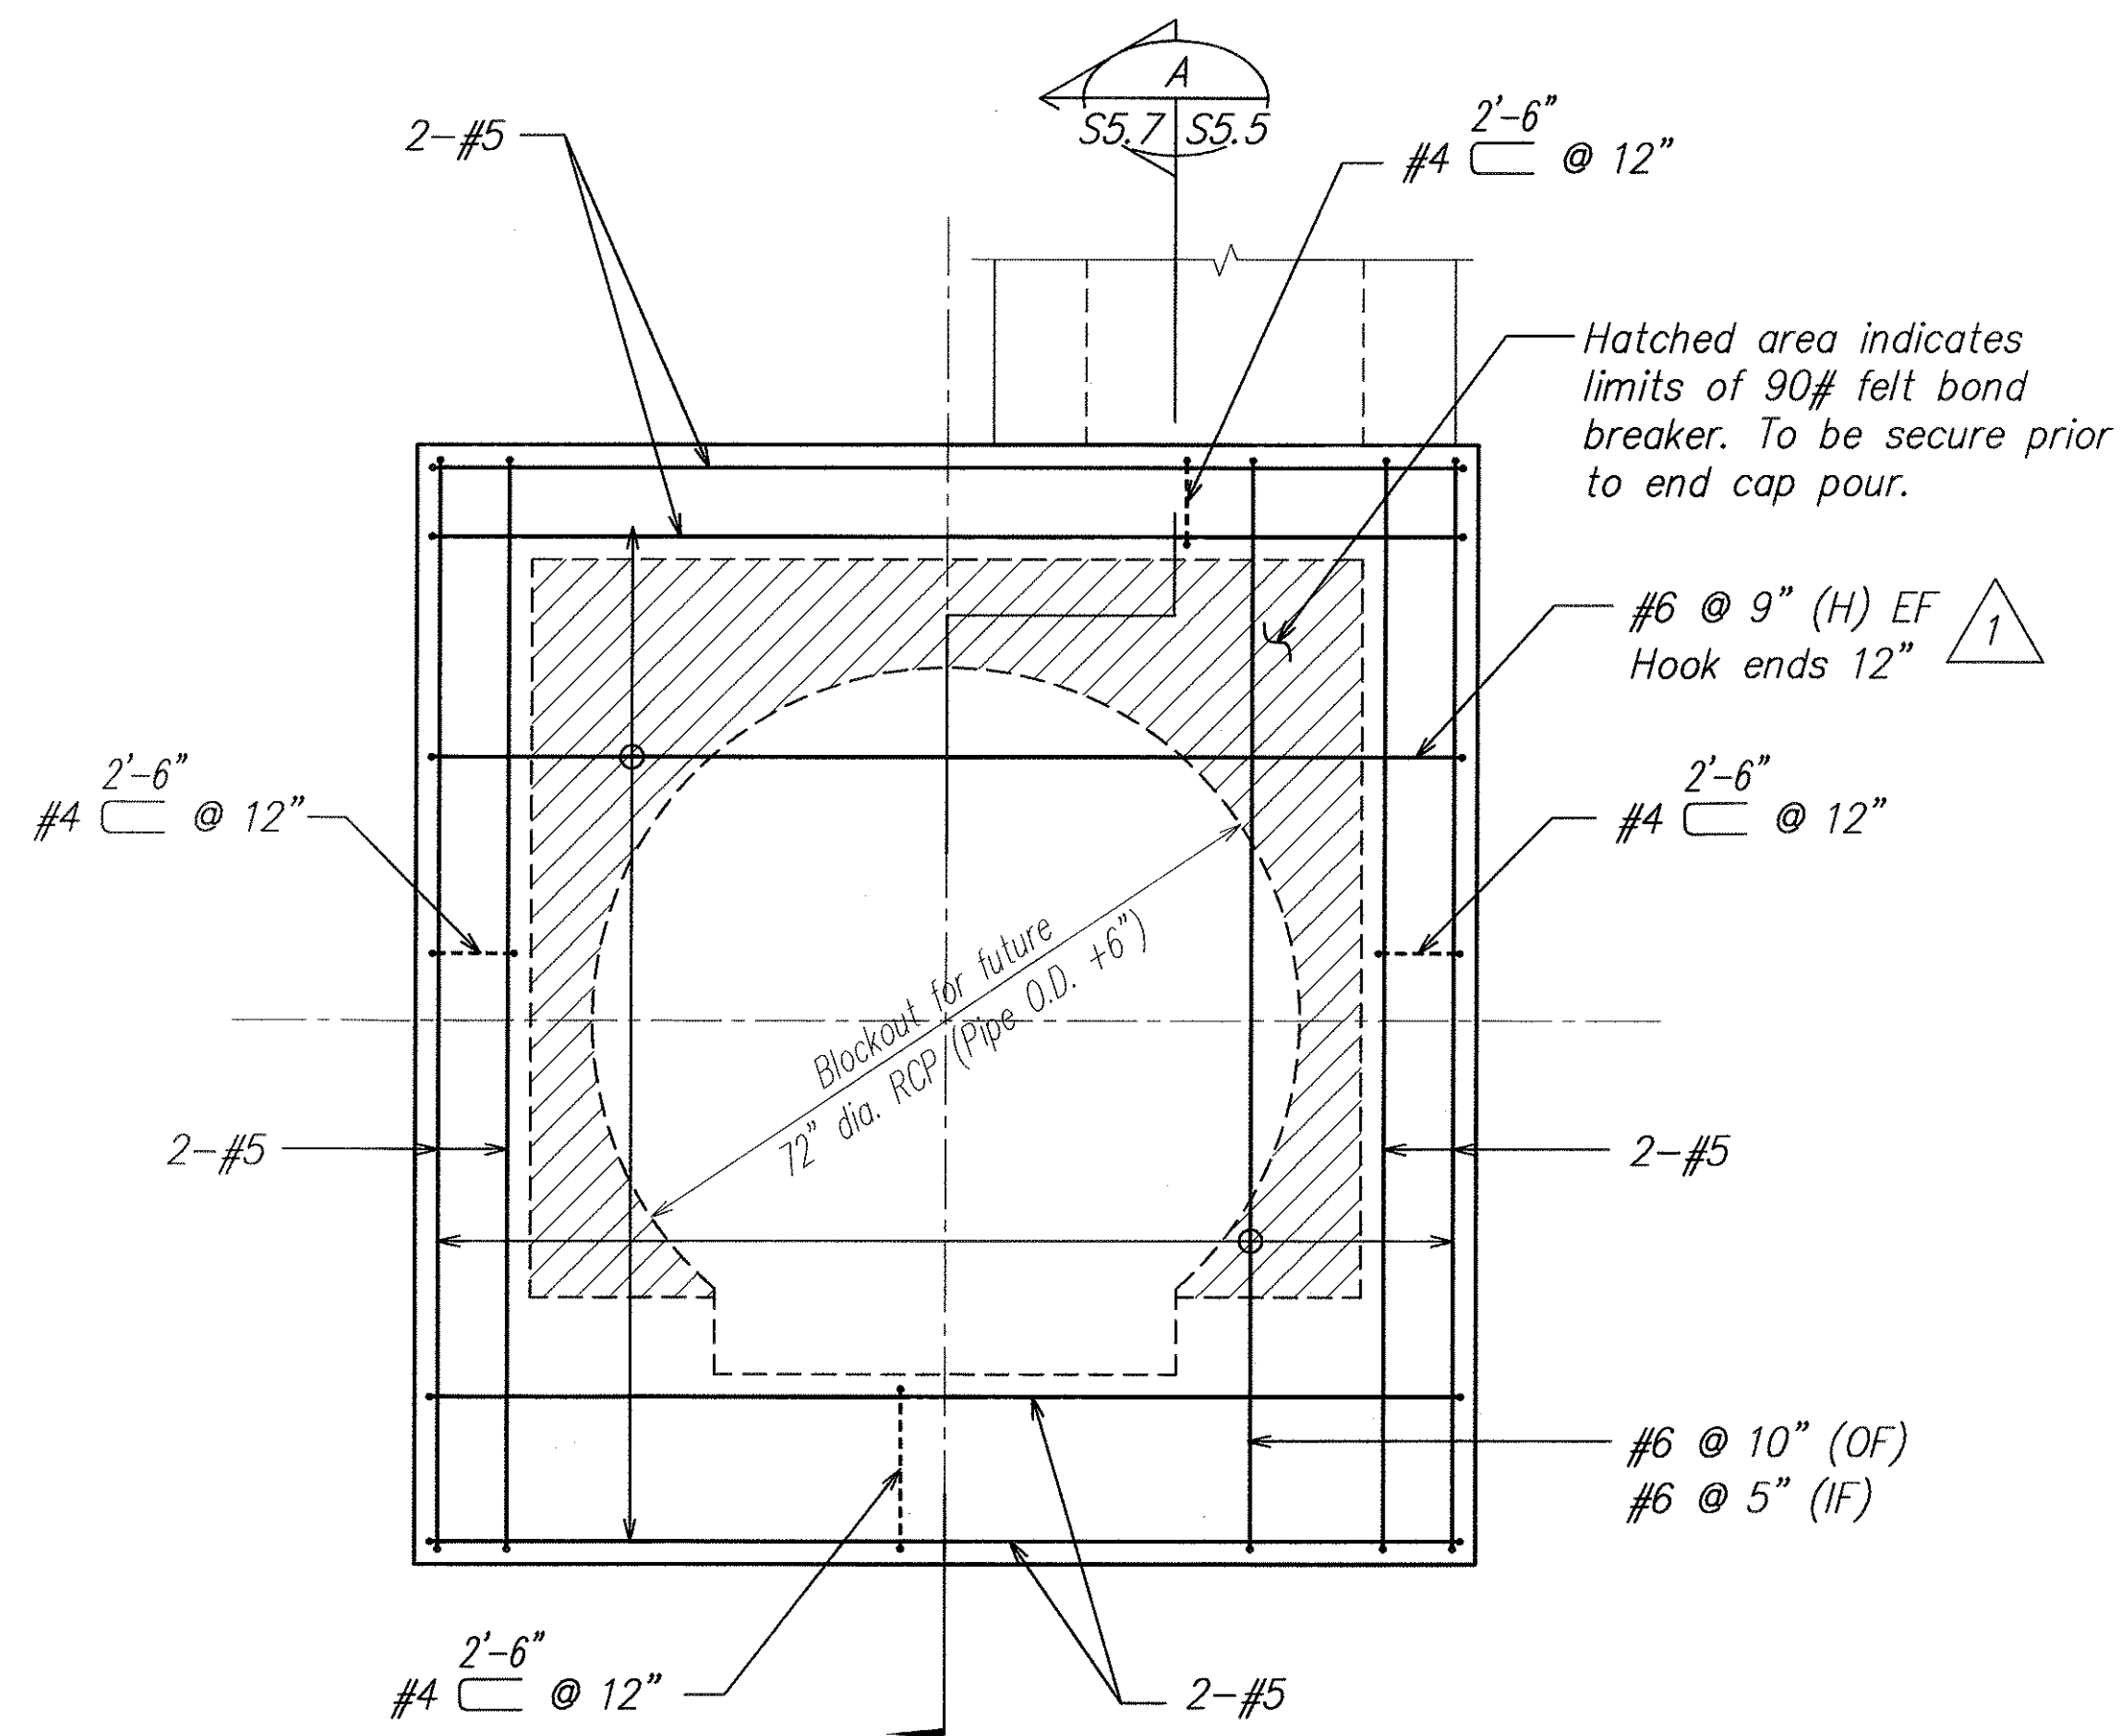

SECTION A
SCALE: 1/2" = 1'-0"
S5.5 S5.7

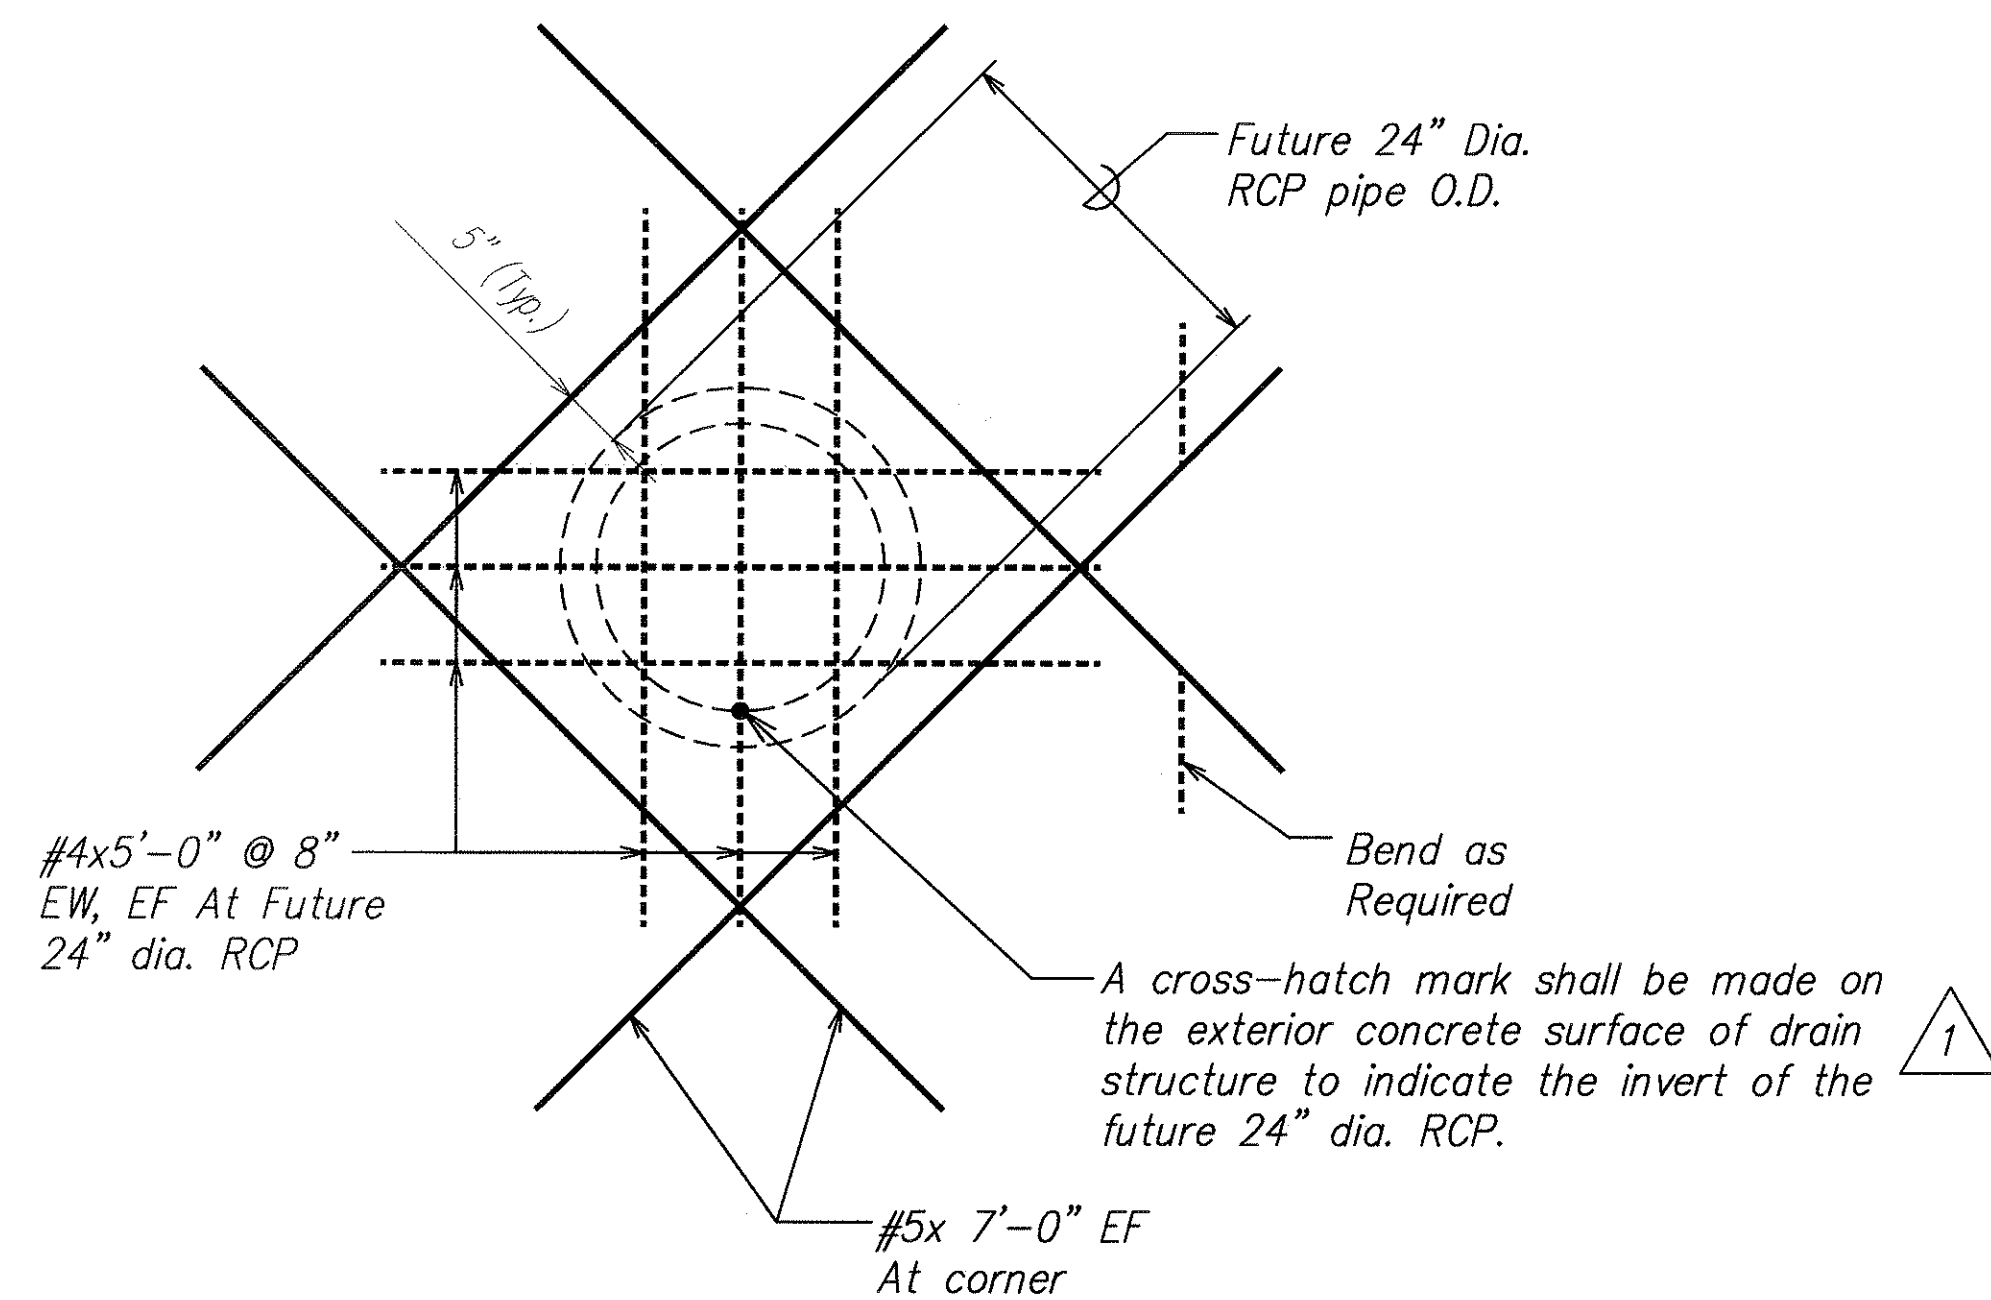

REINF. AT FUTURE 24" DIA. RCP 1
SCALE: 3/4" = 1'-0"
S2.1, S5.1, S5.5, S5.7 S5.7

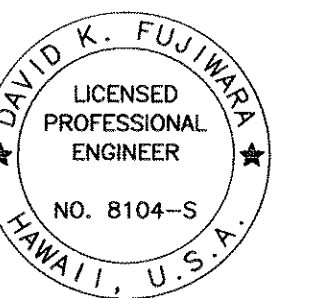

THIS WORK WAS PREPARED BY
ME OR UNDER MY SUPERVISION.

Signature: David K. Fujiwara
EXPIRATION DATE OF THE LICENSE: 4-30-06

STATE OF HAWAII
DEPARTMENT OF TRANSPORTATION
HIGHWAYS DIVISION

DRAIN CULVERT "E", "F" AND "G"
SECTION


North-South Road
Phase 1A
F.A.I. Proj. No. STP-8930(1)

Scale: As Noted Date: Dec. 22, 2004


SHEET No. S5.7 OF 43 SHEETS

1/18/05	1	Clarification of Note
DATE		REVISION


FED. ROAD DIST. NO.	STATE	FED. AID PROJ. NO.	FISCAL YEAR	SHEET NO.	TOTAL SHEETS
HAWAII	HAW.	STP-8930(1)	2005	ADD. 100	144

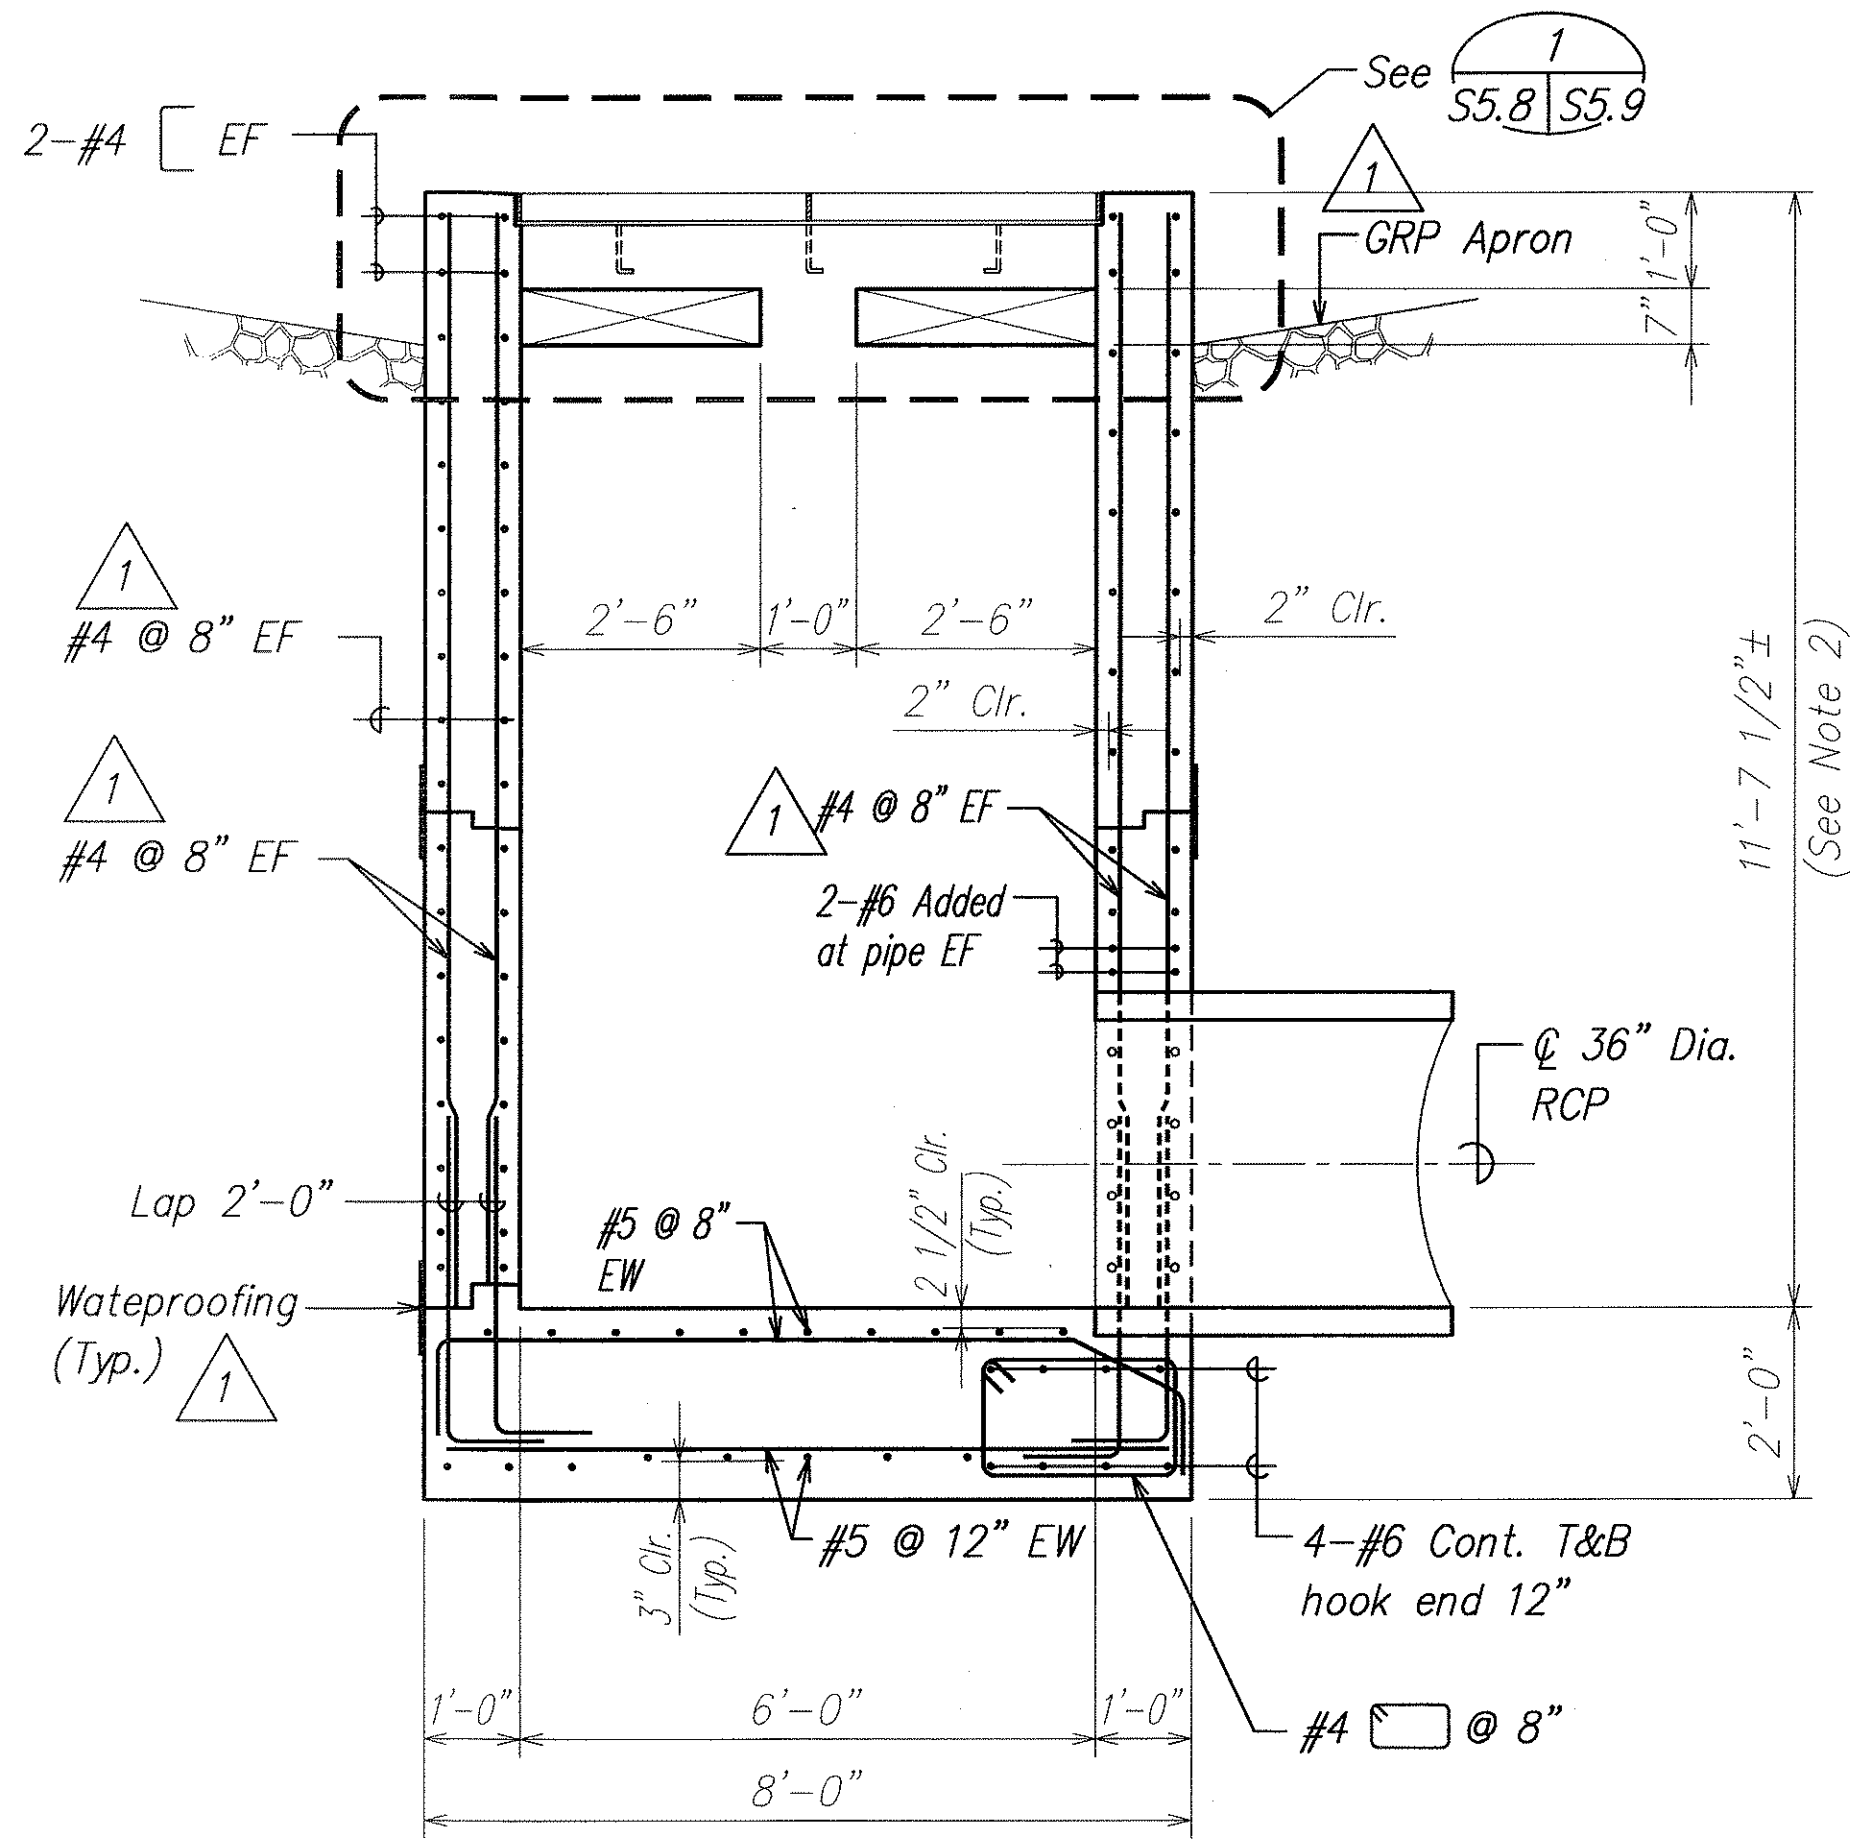

SECTION A
SCALE: 1/2" = 1'-0" S4.4, S5.8 S5.8

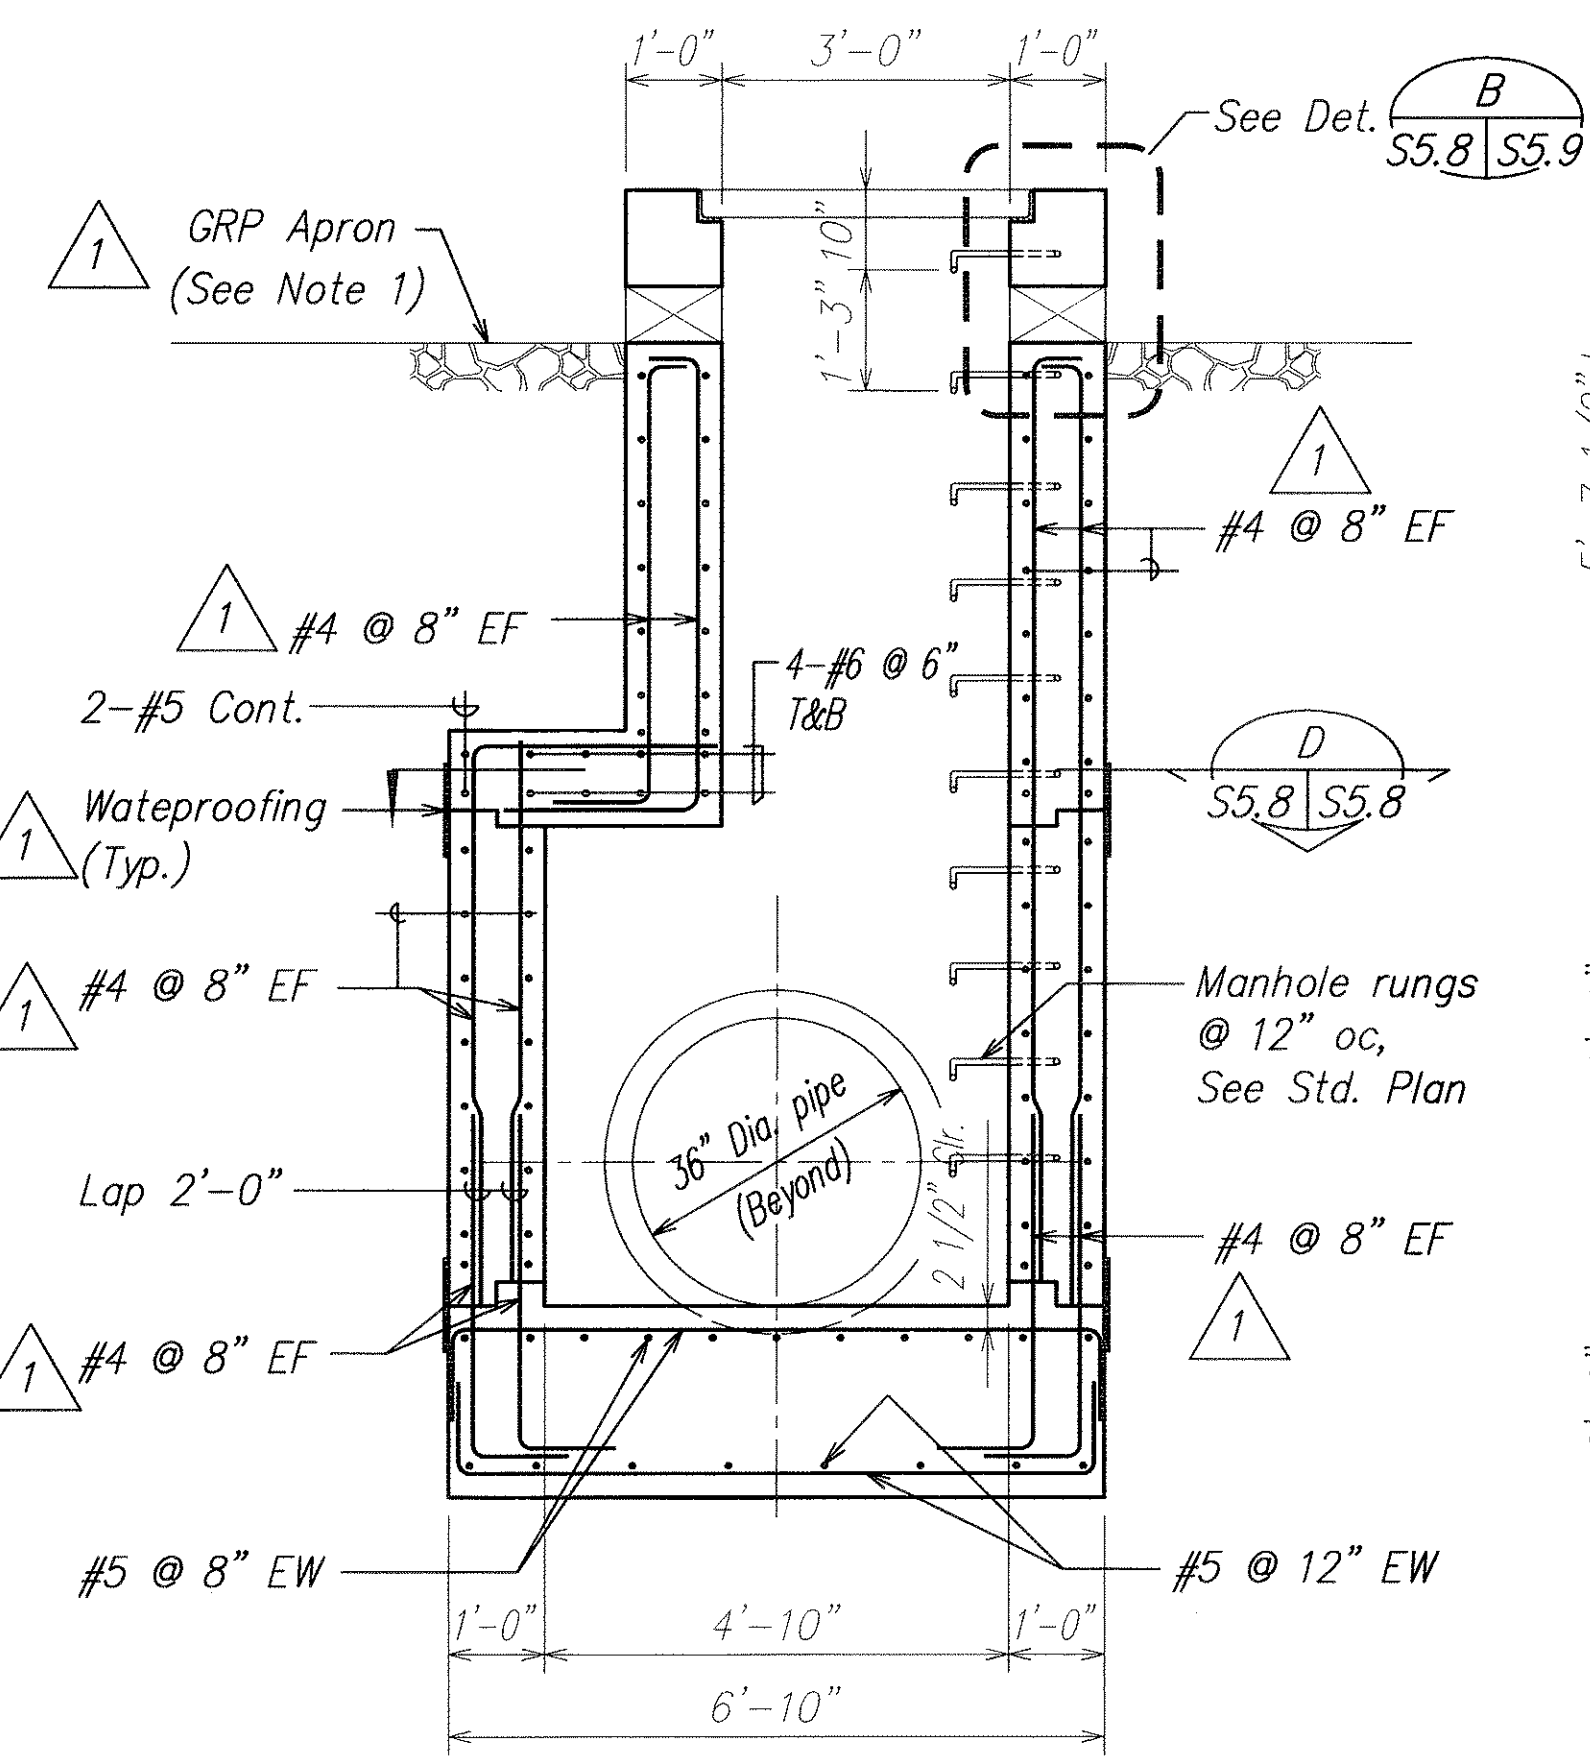


SECTION B
SCALE: 1/2" = 1'-0" S5.8 S5.8

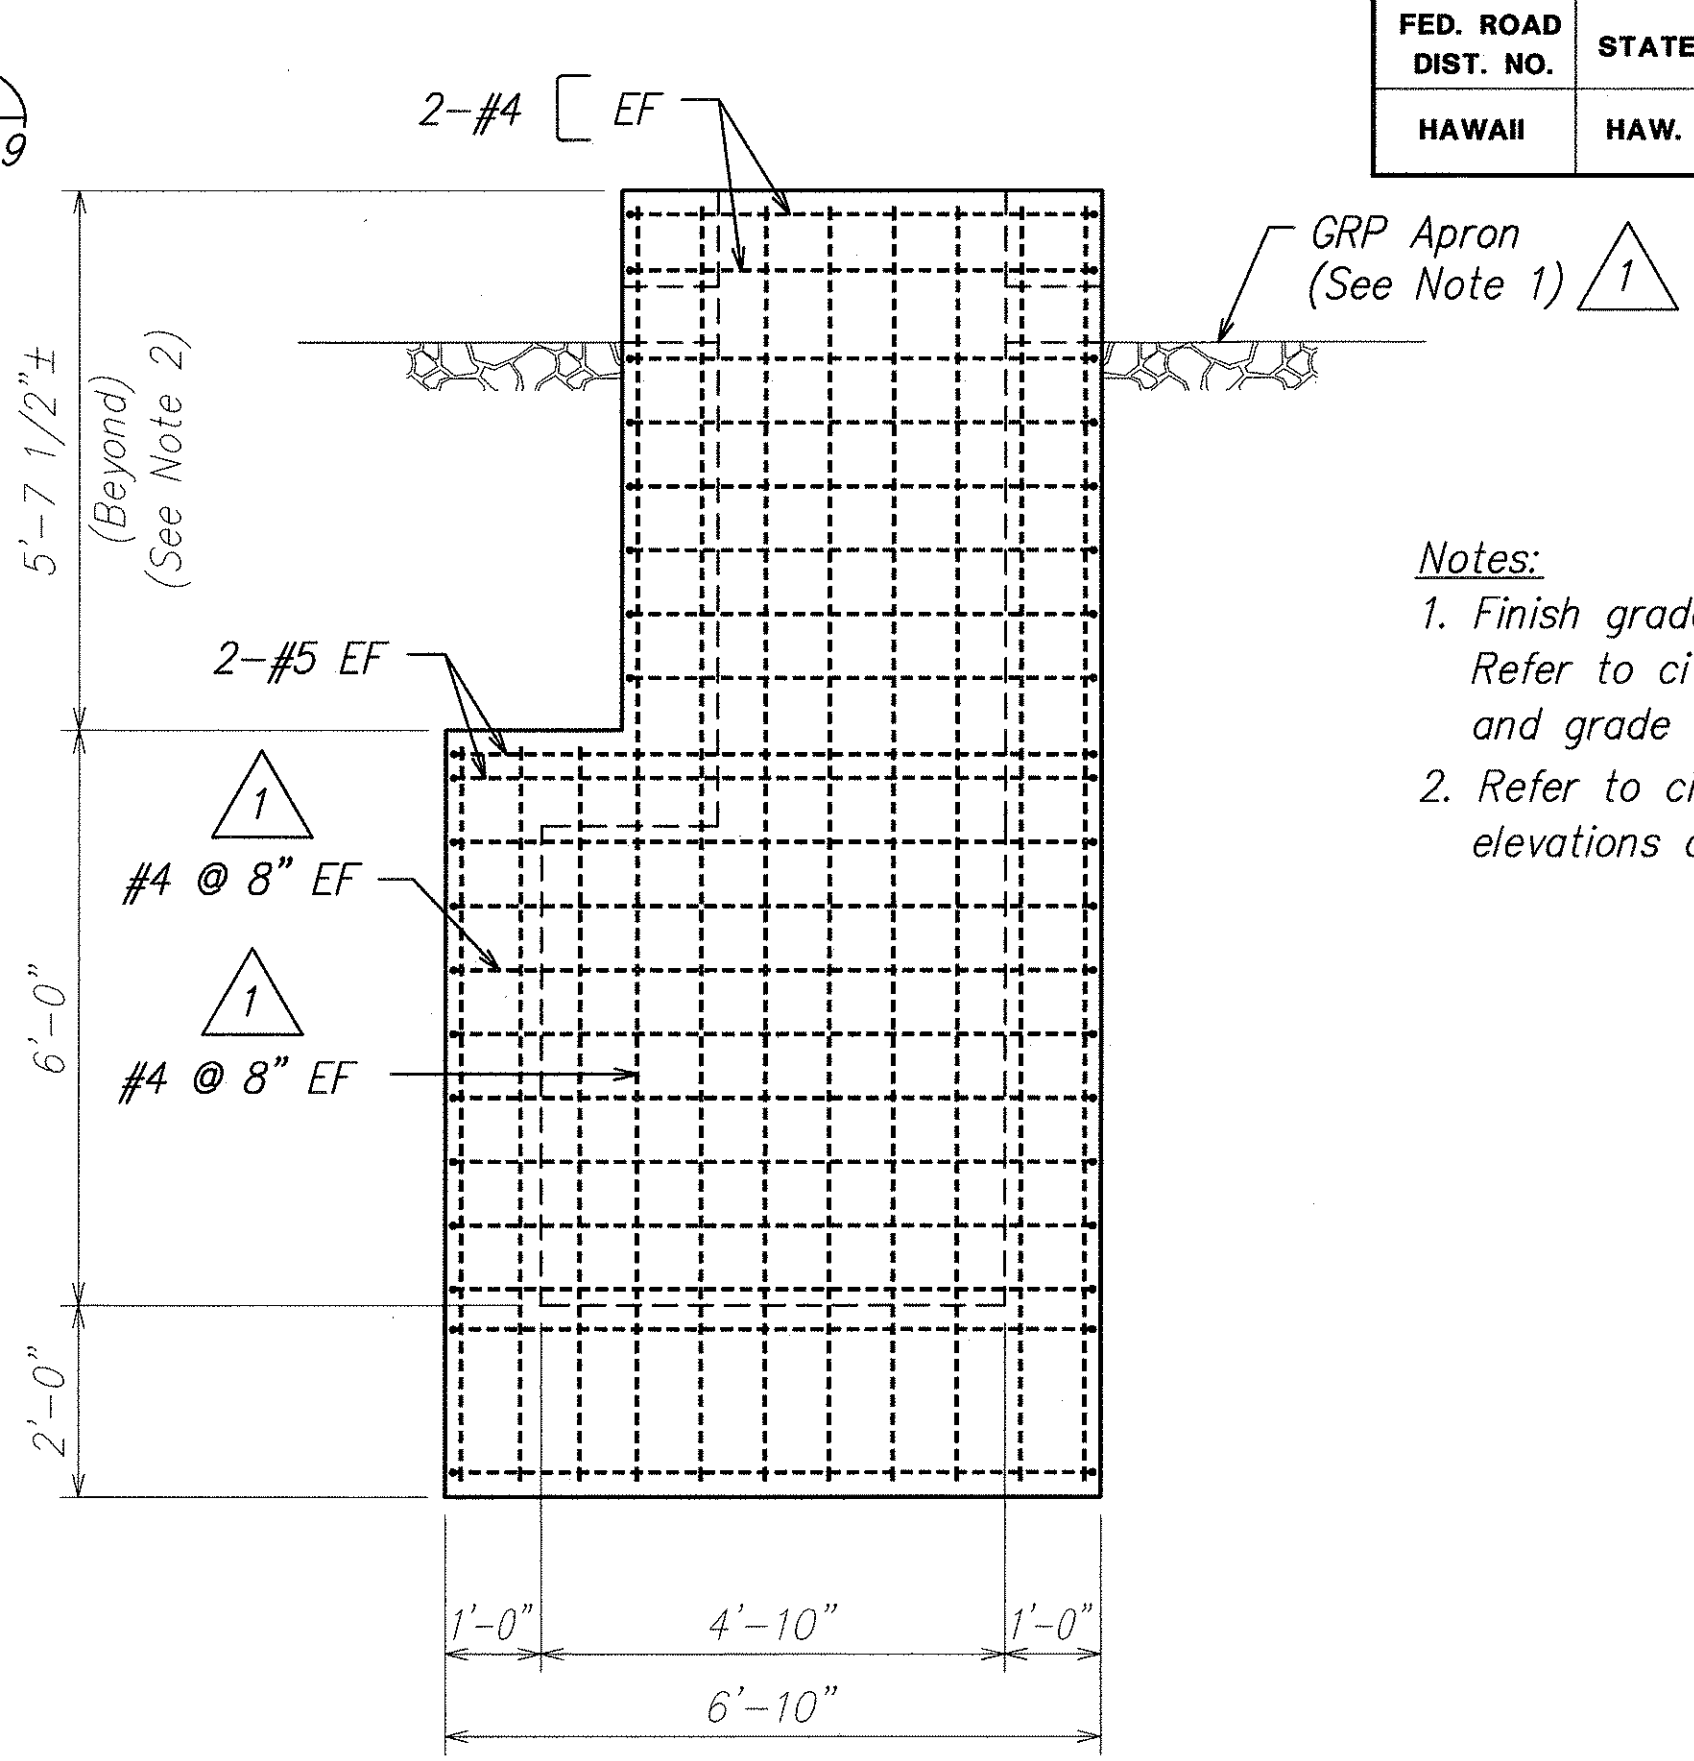


SECTION C
SCALE: 1/2" = 1'-0" S5.8 S5.8

- Notes:
1. Finish grades are approximate. Refer to civil plans for slopes and grade elevations.
 2. Refer to civil drawings for DI elevations and verify dimensions.

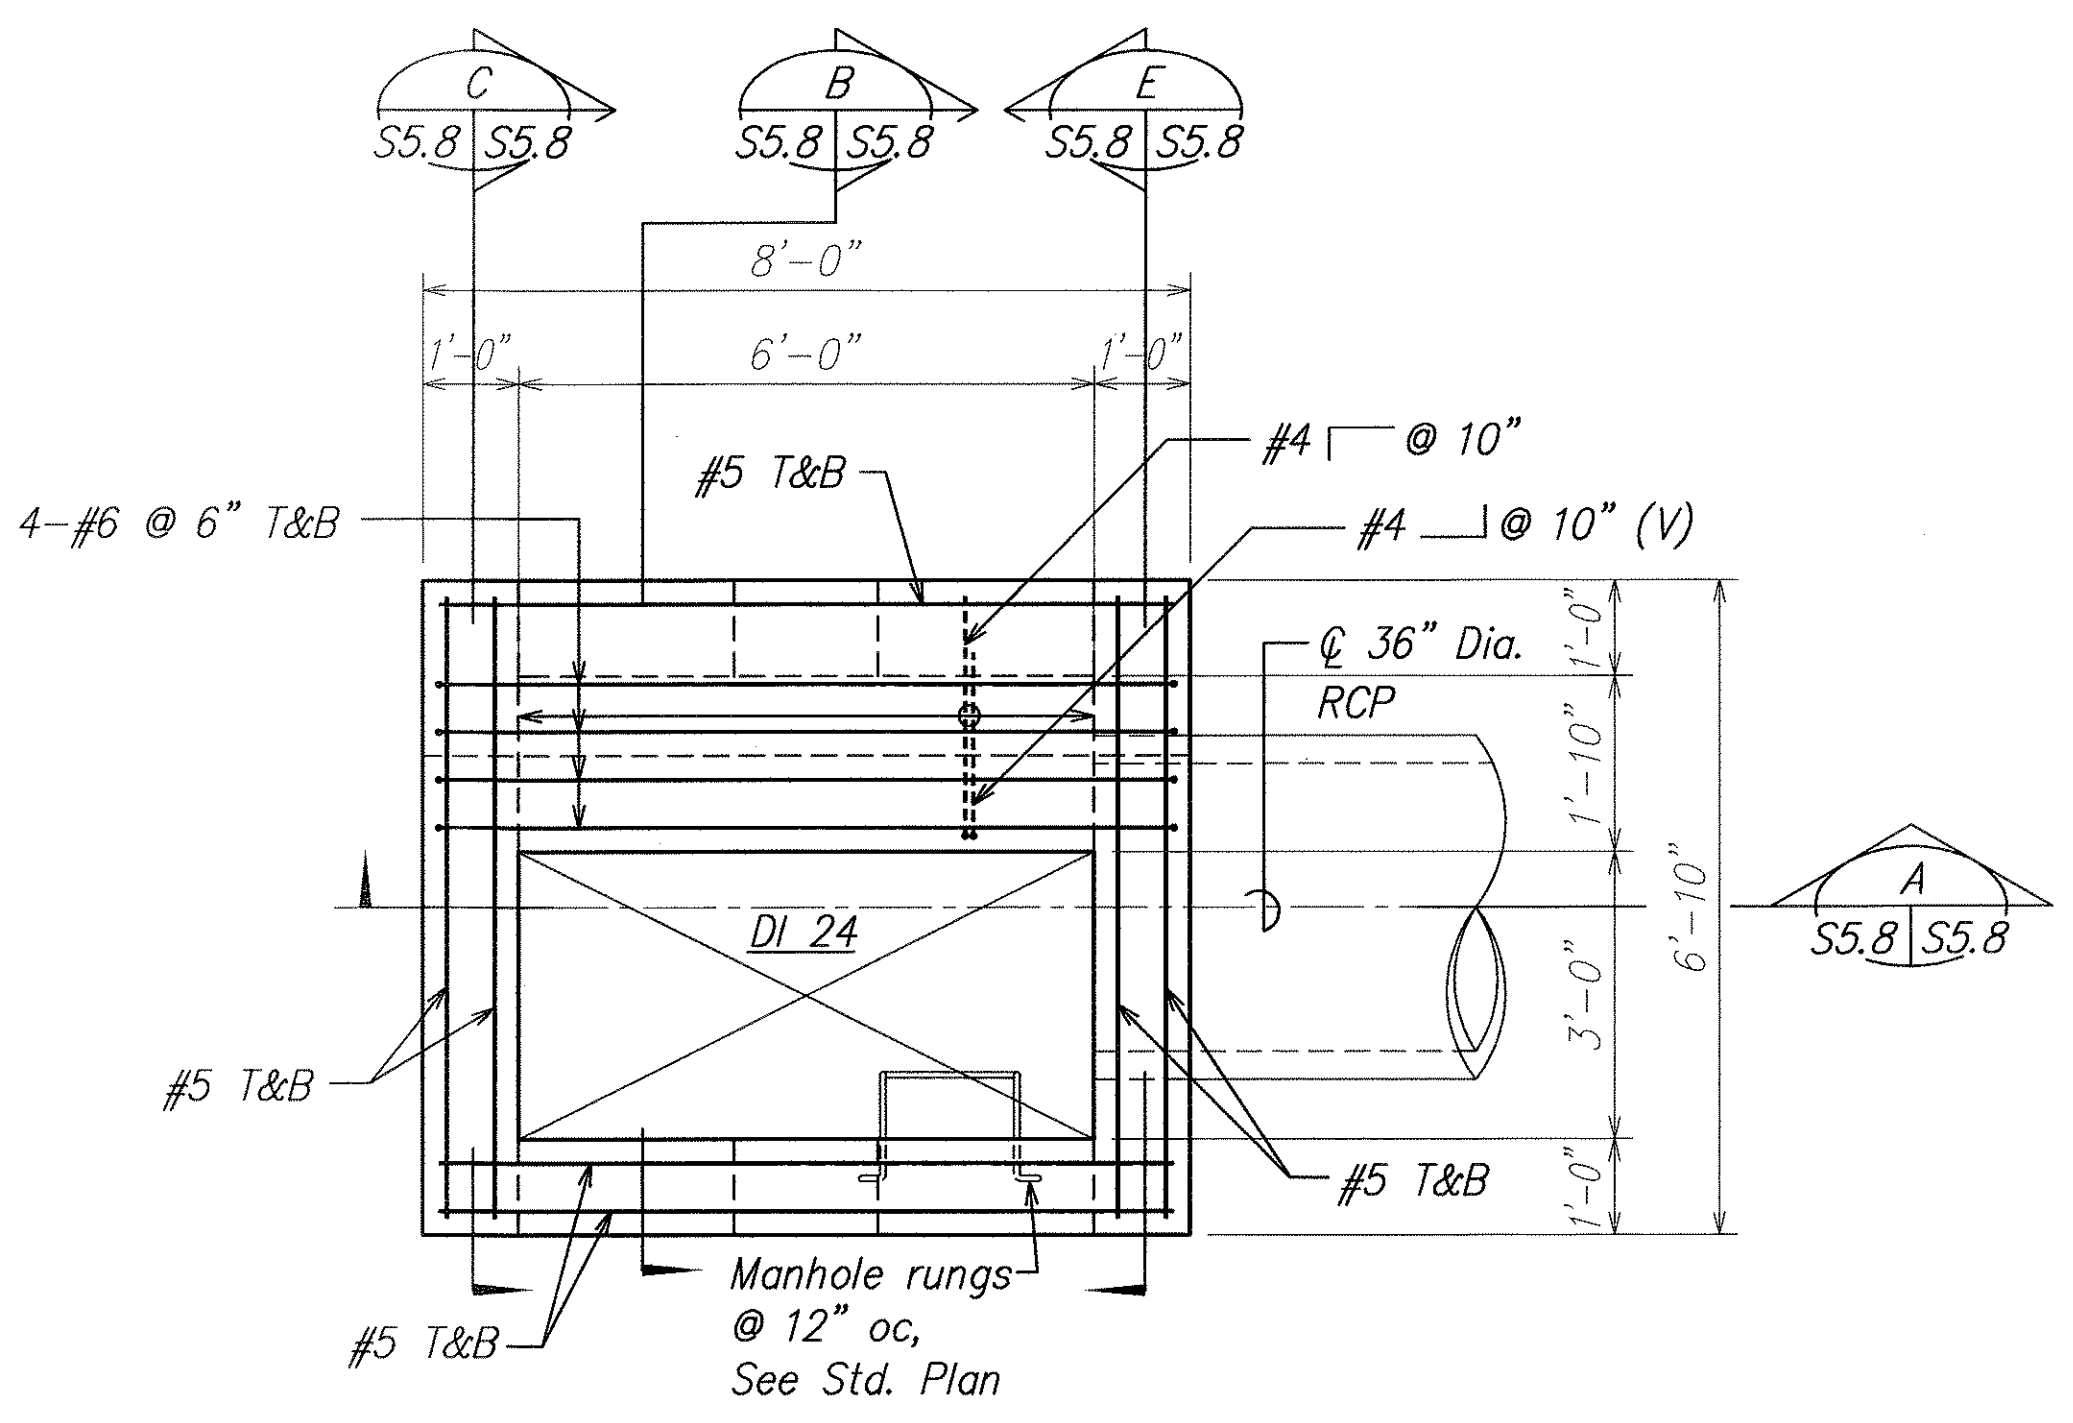


SECTION D
SCALE: 1/2" = 1'-0" S4.4, S5.8 S5.8

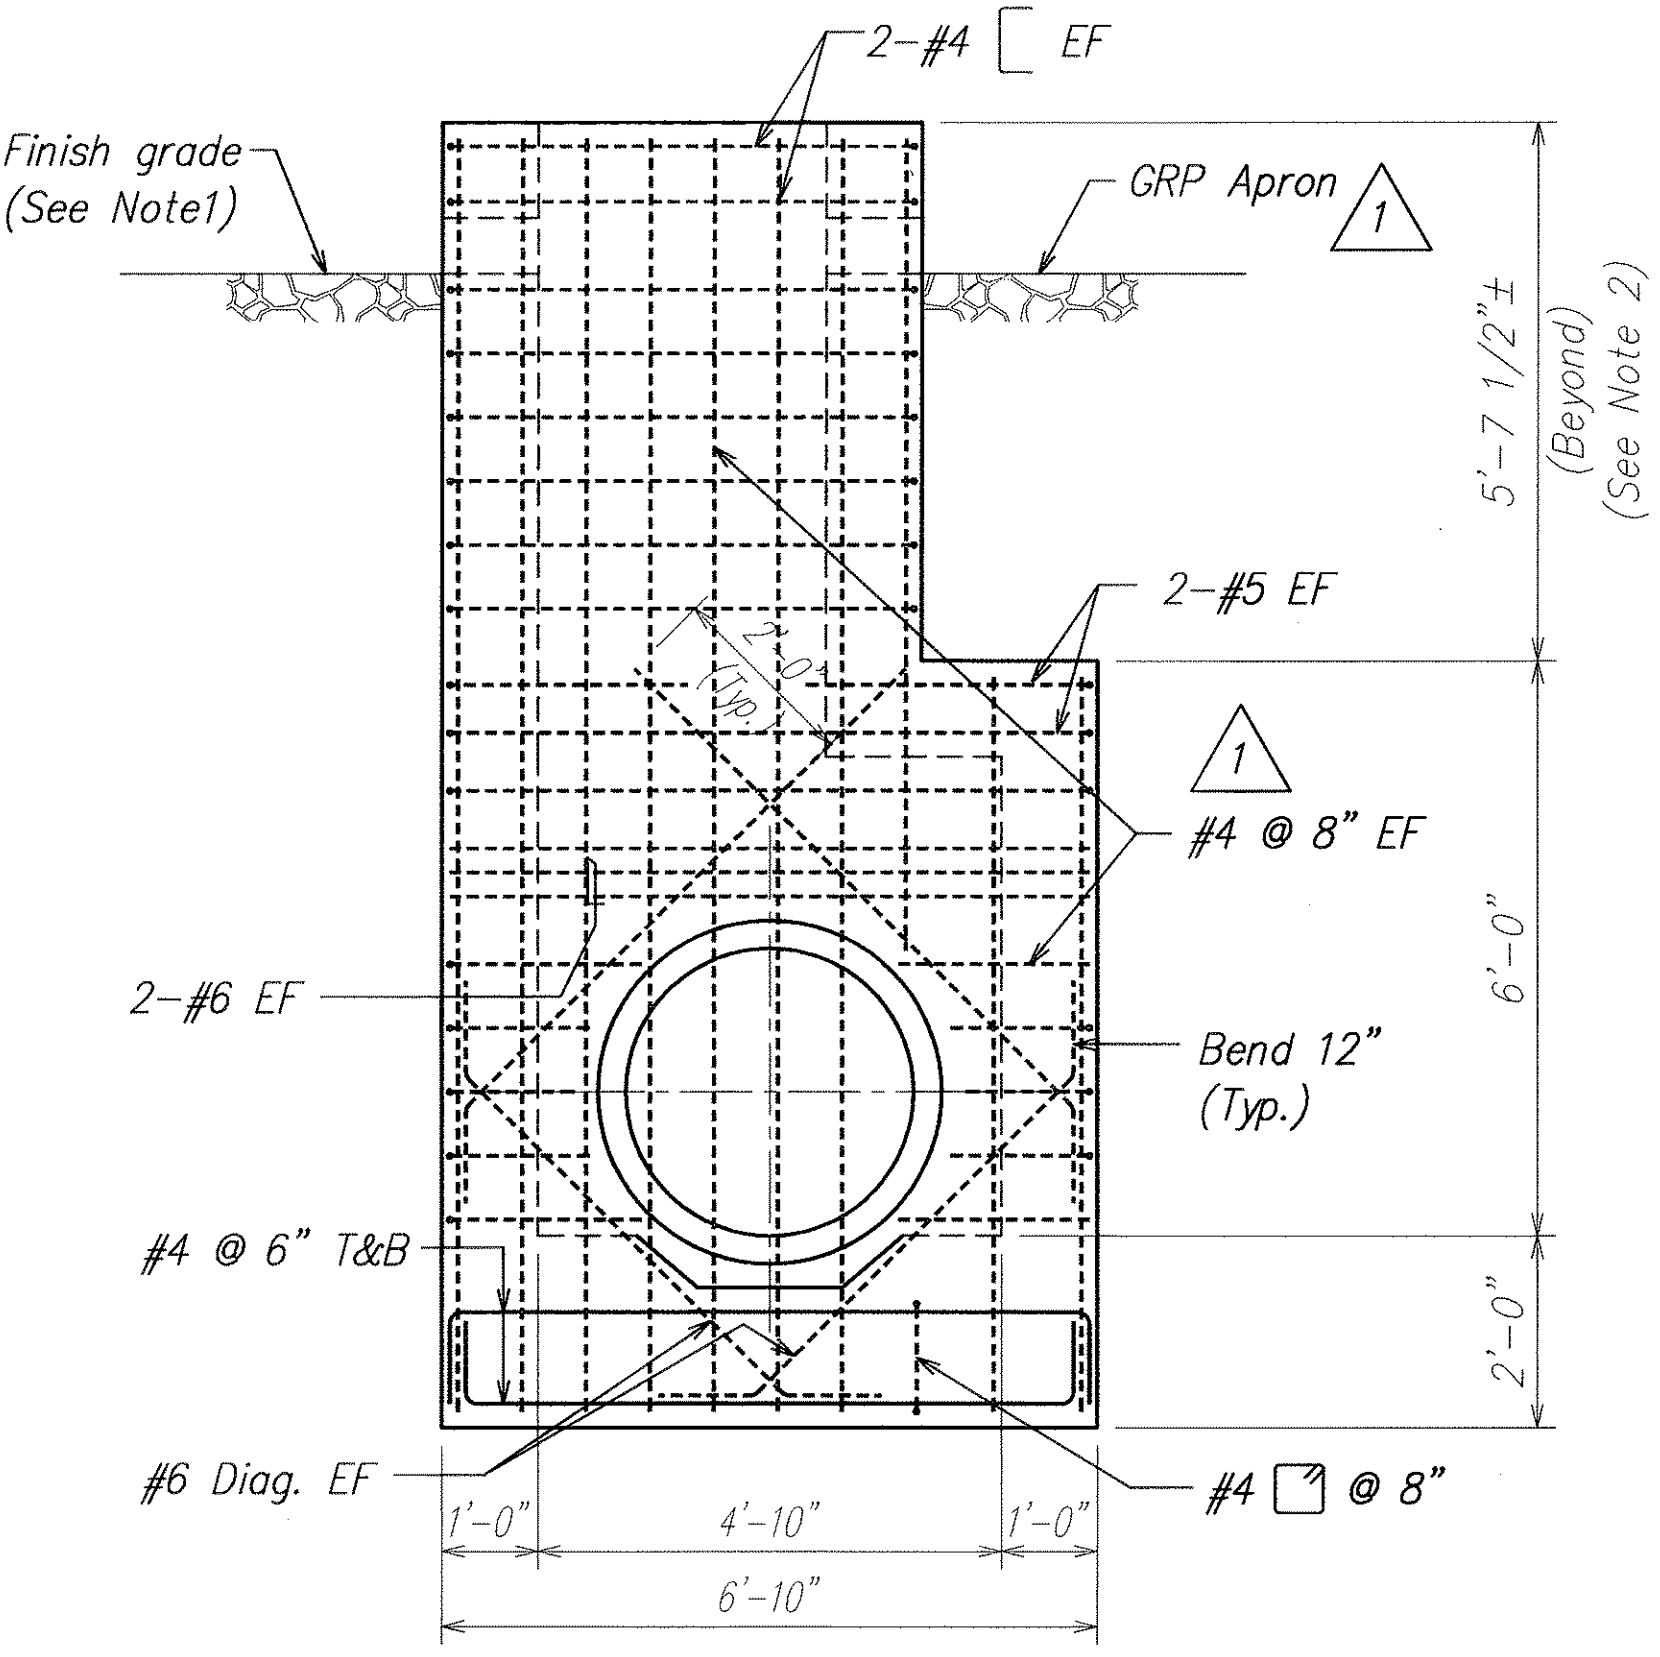

SECTION E
SCALE: 1/2" = 1'-0" S5.8 S5.8

ORIGINAL PLAN	DATE
NO. _____	_____
DESIGNED BY	CHECKED BY
_____	_____
TRACED BY	_____
_____	_____
SURVEY PLATTED BY	_____
_____	_____

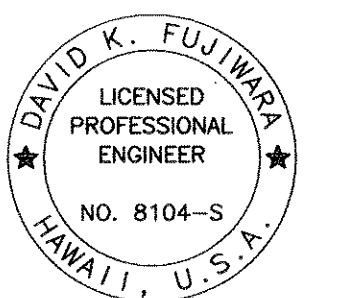

THIS WORK WAS PREPARED BY ME OR UNDER MY SUPERVISION.

Signature: David K. Fujimura
EXPIRATION DATE OF THE LICENSE: 4-30-06

STATE OF HAWAII
DEPARTMENT OF TRANSPORTATION
HIGHWAYS DIVISION


DRAIN CULVERT "R1"
SECTIONS AND DETAIL AT DI 24
North-South Road
Phase 1A
F.A.I. Proj. No. STP-8930(1)

Scale: As Noted Date: Dec. 22, 2004


SHEET No. S5.8 OF 43 SHEETS

1/18/05	1 Clarification of Notes and Modify Reinforcing
DATE	REVISION


FED. ROAD DIST. NO.	STATE	FED. AID PROJ. NO.	FISCAL YEAR	SHEET NO.	TOTAL SHEETS
HAWAII	HAW.	STP-8930(1)	2005	ADD. 101	144

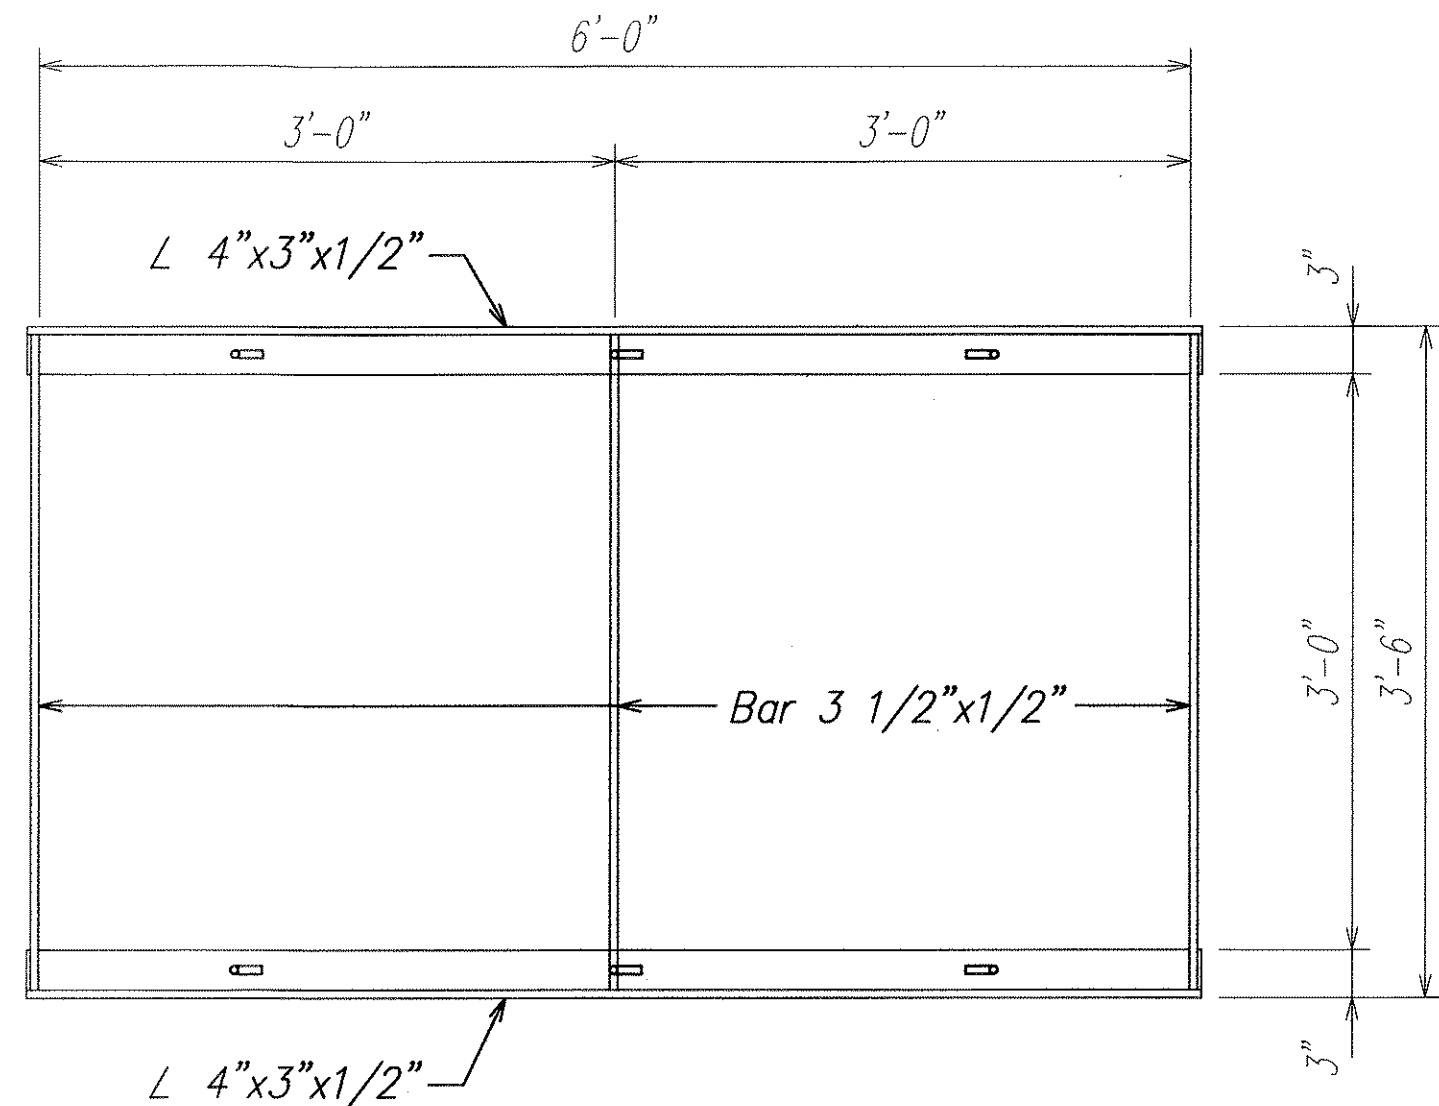

PLAN

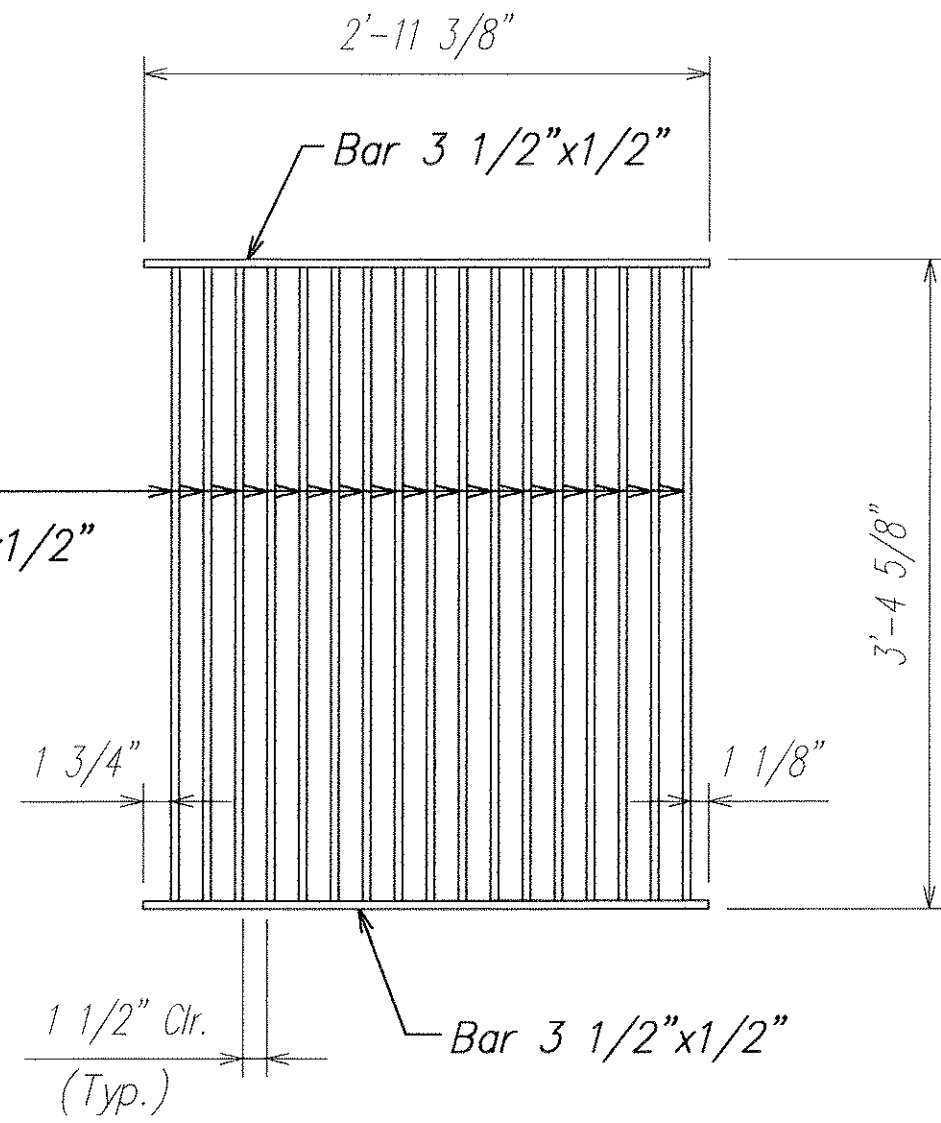


TYPE 61616 GRATE

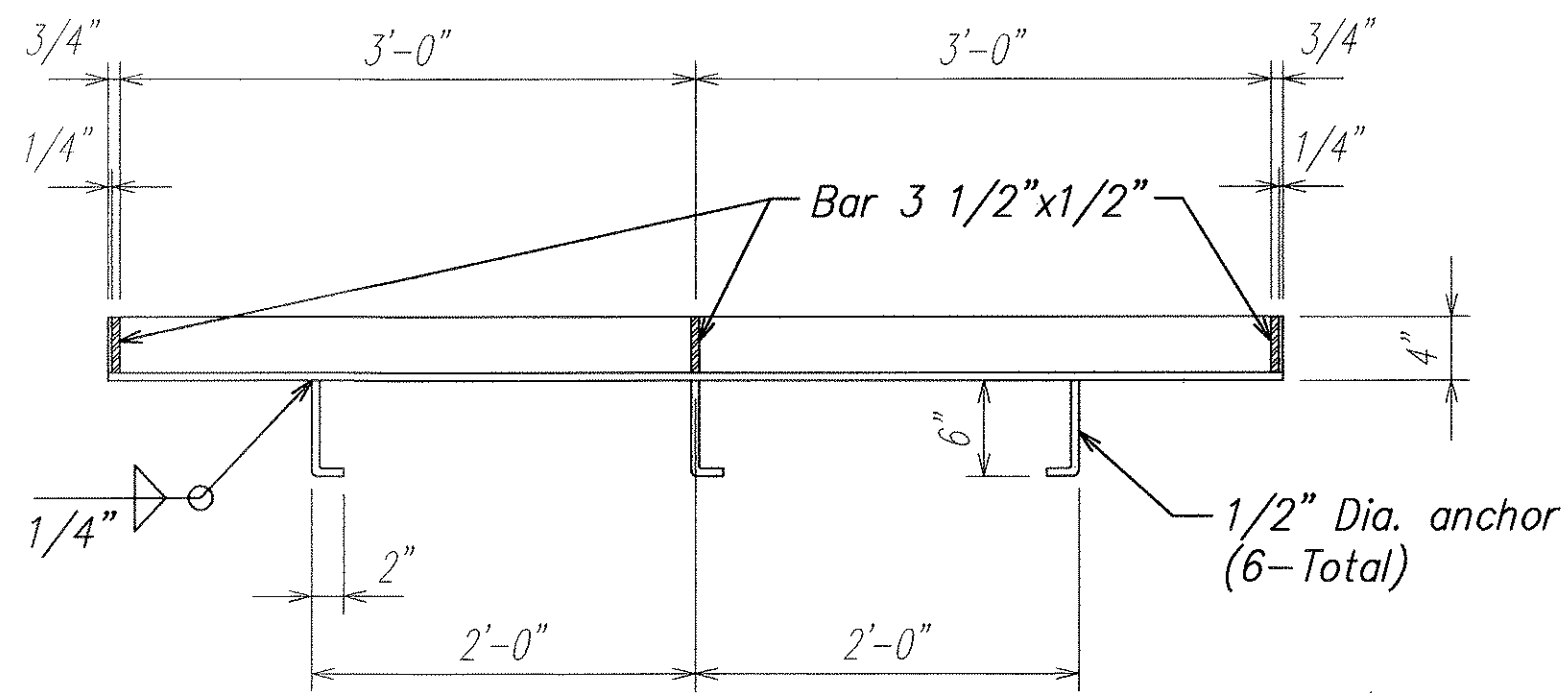


SECTION


DRAIN INLET FRAME AT DI 17, 24, 26, 34, 38 AND 43 2
SCALE: 1" = 1'-0" S5.9 | S5.9

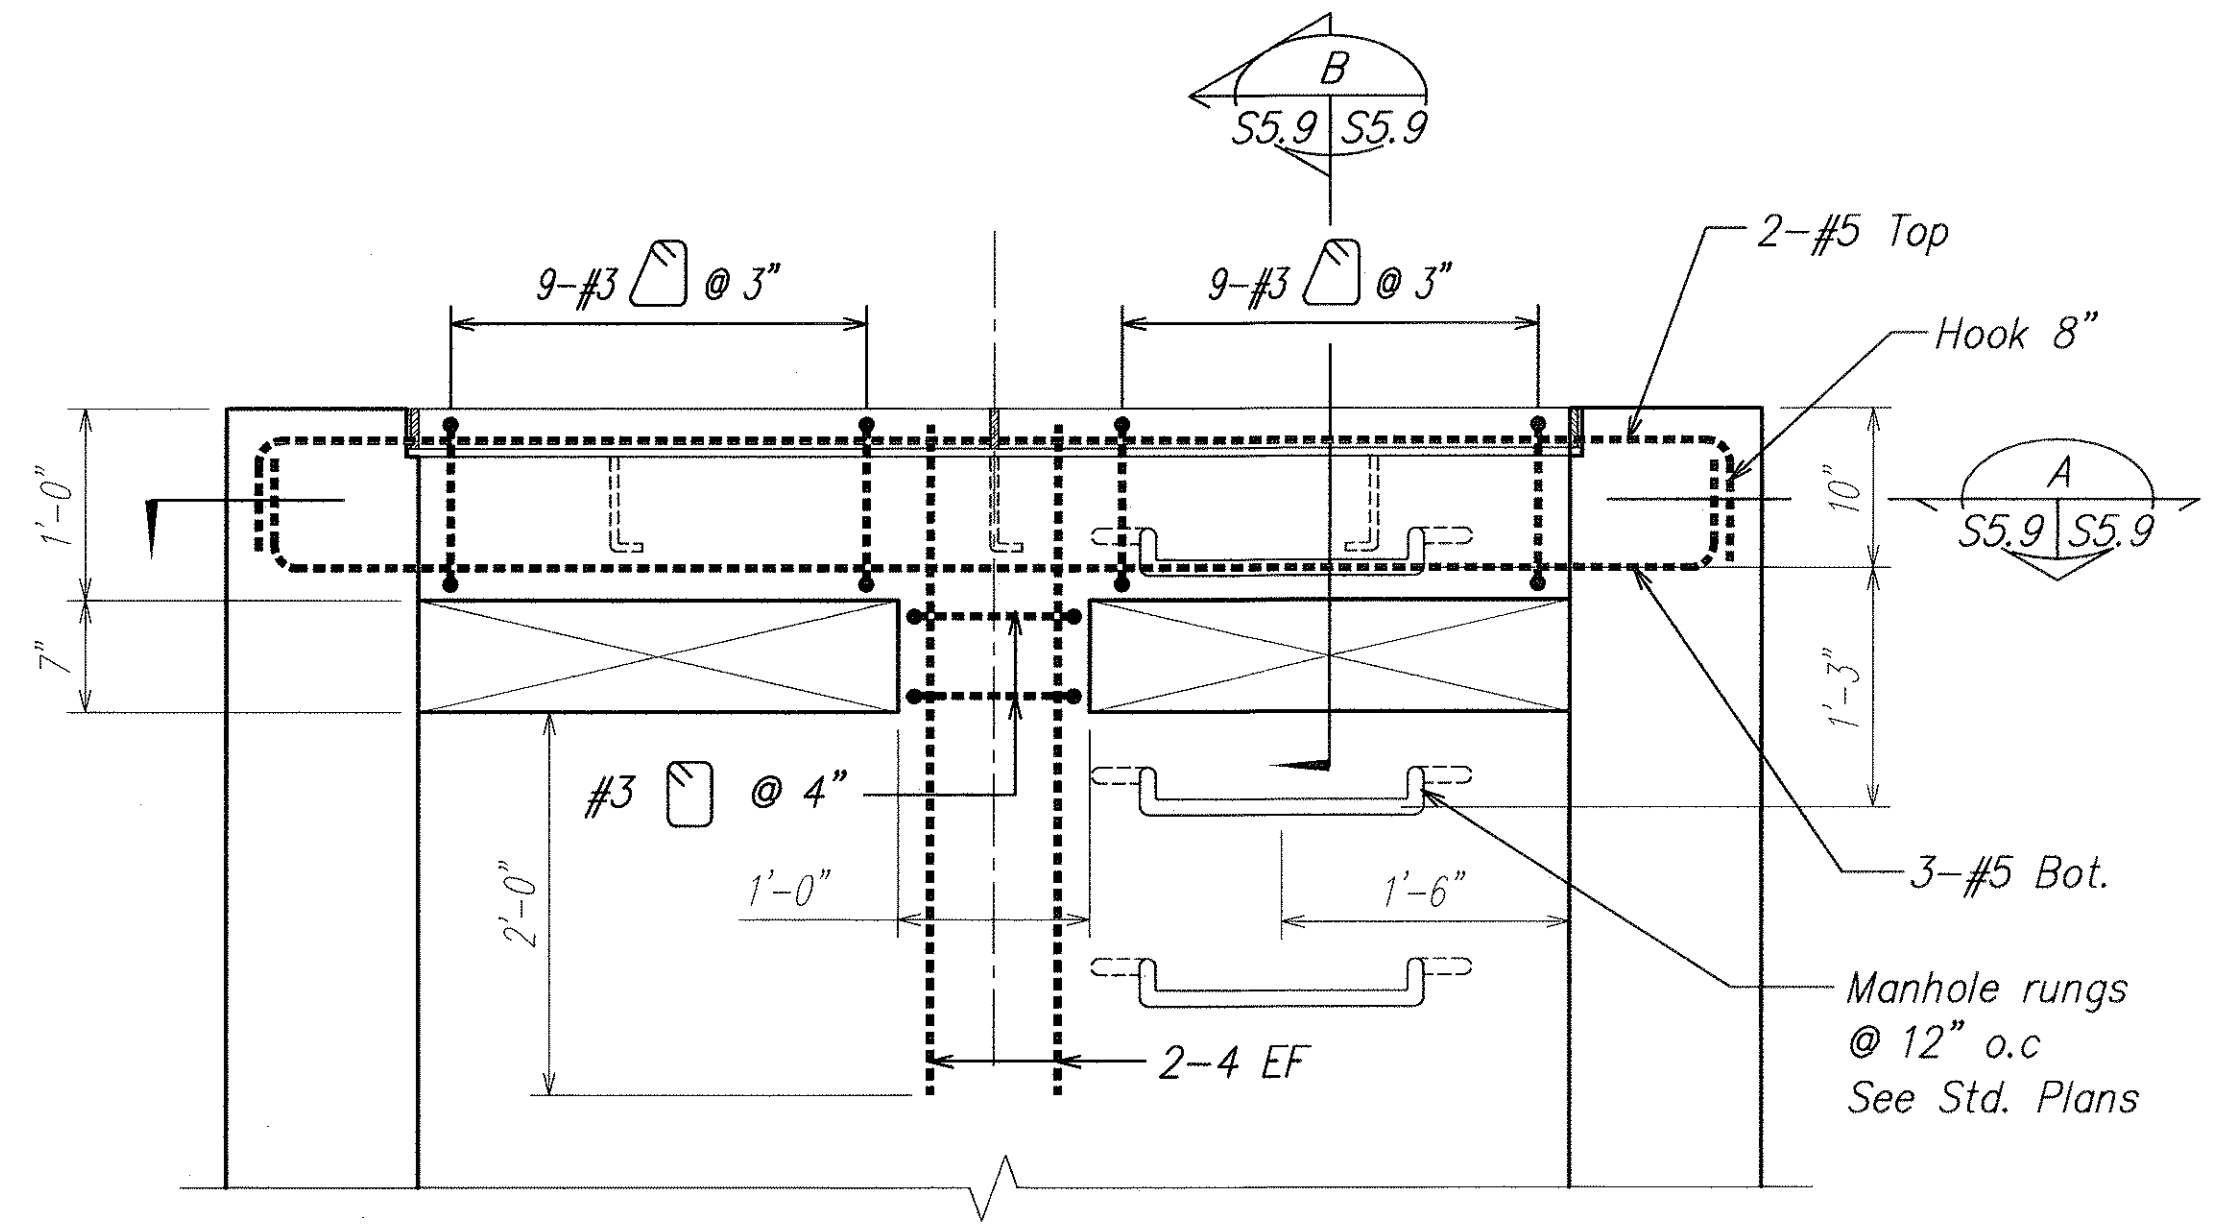


TYPICAL INLET AT DI 17, 24, 26, 34, 38 AND 43 1
SCALE: 1" = 1'-0" S1.2, S5.1, S5.3, S5.4, S5.8 | S5.9

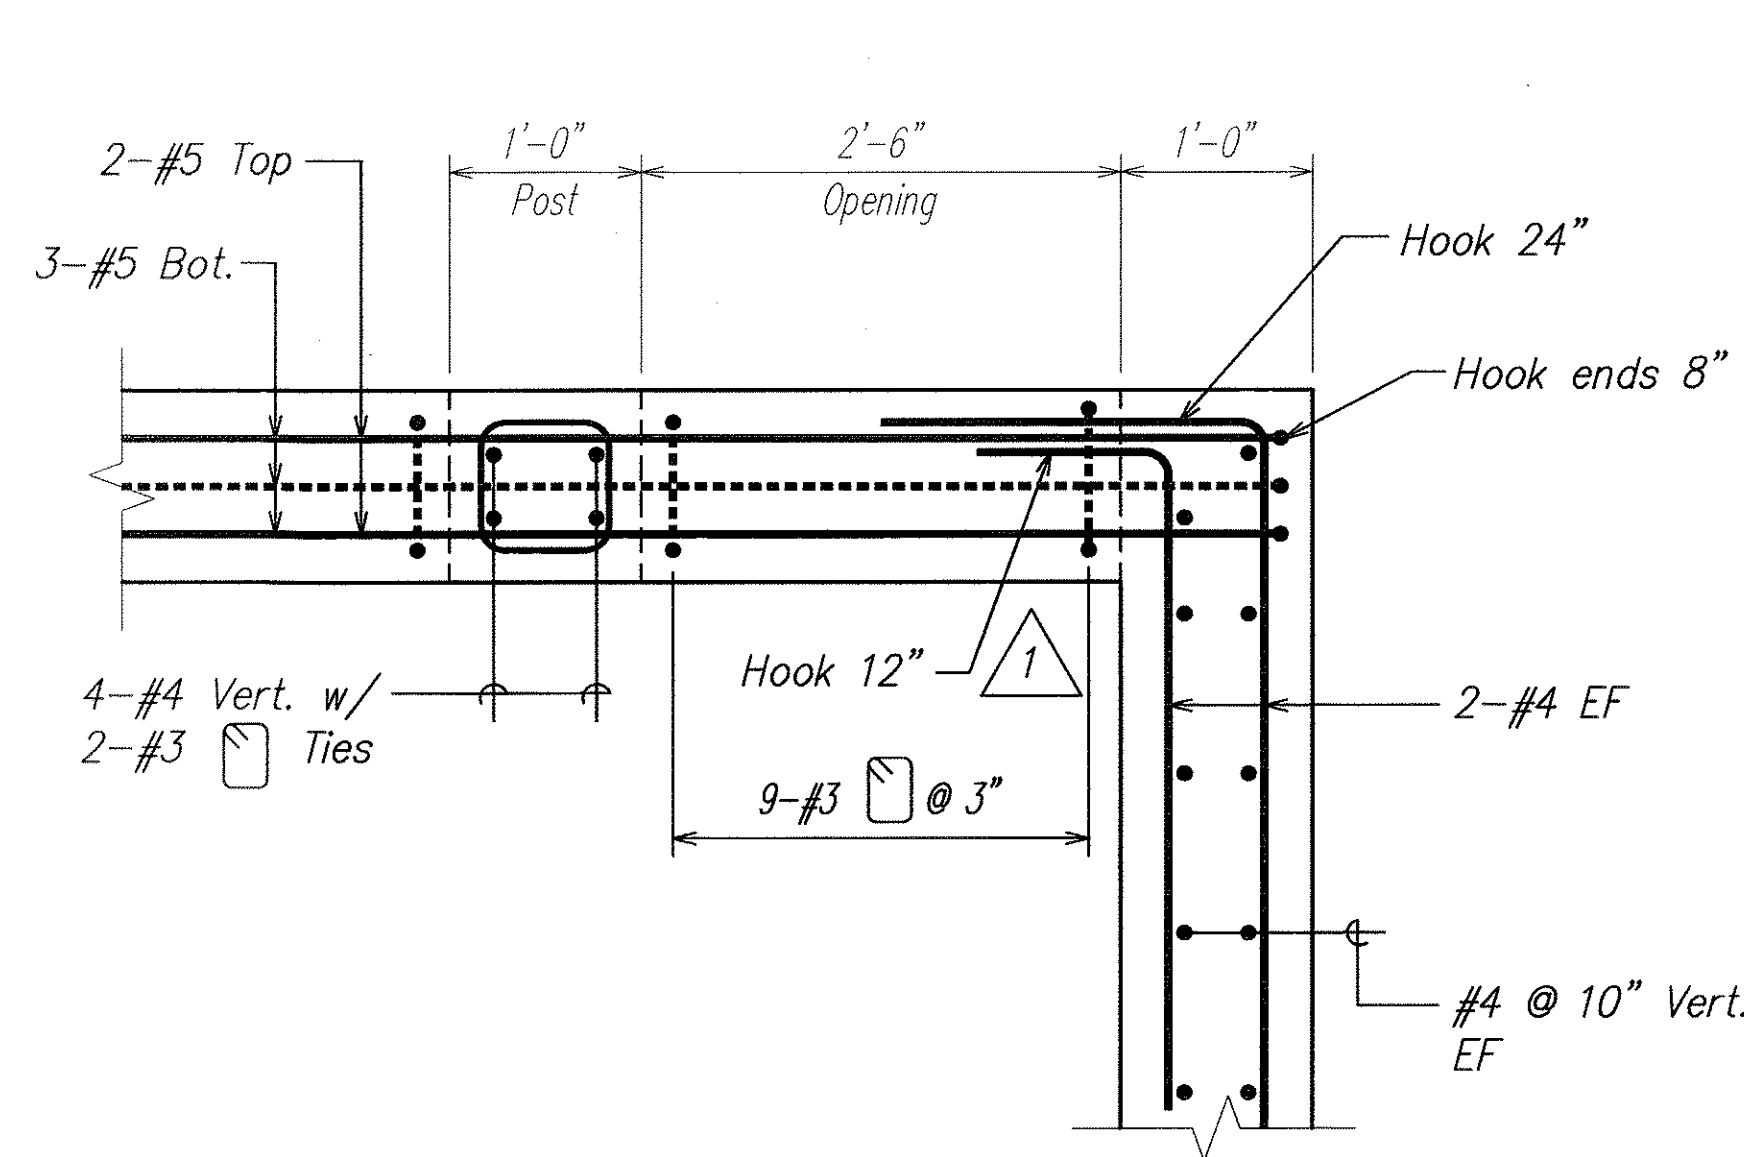

SECTION A
SCALE: 1" = 1'-0" S5.9 | S5.9

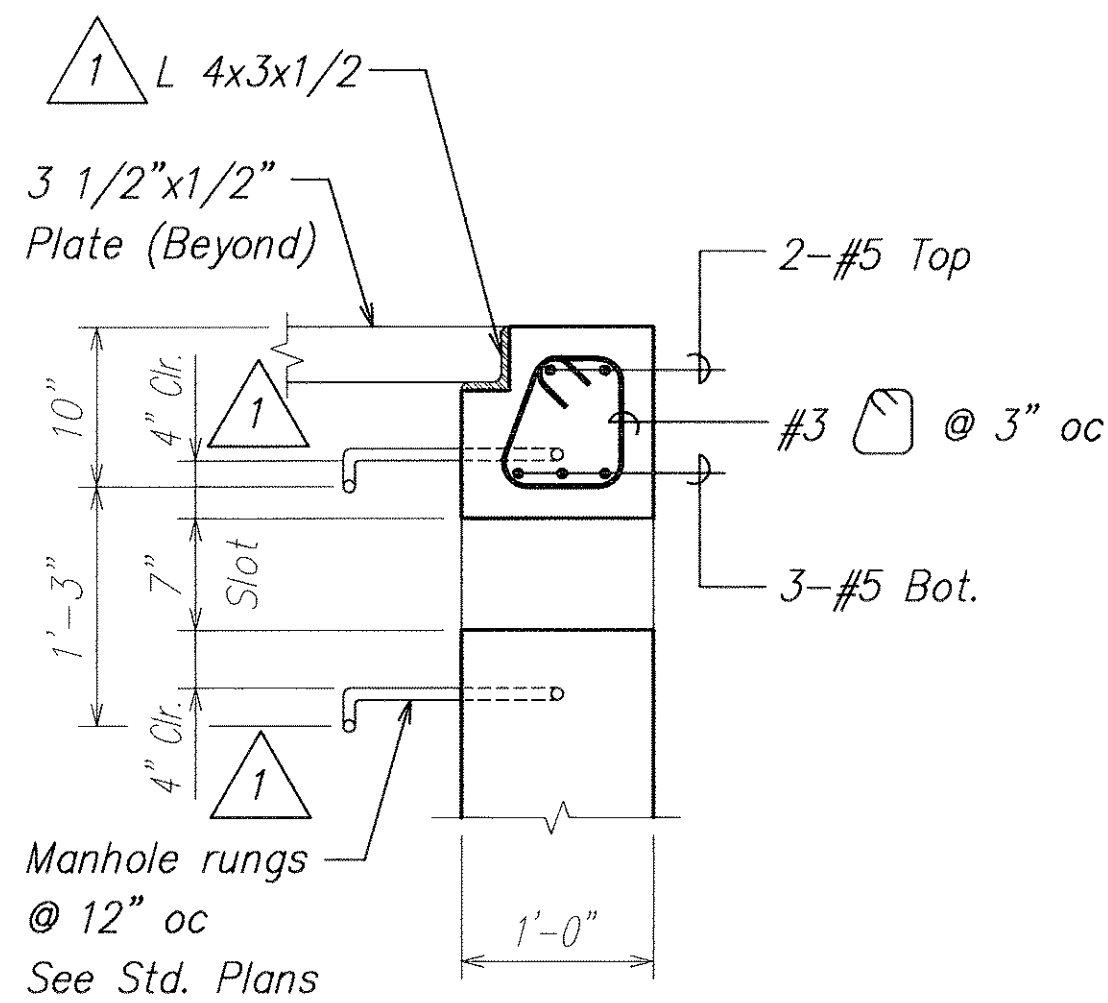

DETAIL B
SCALE: 1" = 1'-0" S5.8, S5.9 | S5.9

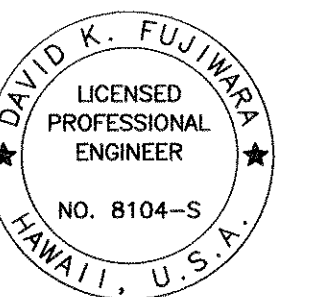

THIS WORK WAS PREPARED BY ME OR UNDER MY SUPERVISION.

Signature: David K. Fujiwara
EXPIRATION DATE OF THE LICENSE: 4-30-06


STATE OF HAWAII
DEPARTMENT OF TRANSPORTATION
HIGHWAYS DIVISION

DRAIN INLET FRAME AT
DI 17, 24, 26, 34, 38 AND 43
North-South Road
Phase 1A
F.A.I. Proj. No. STP-8930(1)


Scale: As Noted Date: Dec. 22, 2004
SHEET No. S5.9 OF 43 SHEETS

1/18/05	1 Clarification of Notes
DATE	REVISION


FED. ROAD DIST. NO.	STATE	FED. AID PROJ. NO.	FISCAL YEAR	SHEET NO.	TOTAL SHEETS
HAWAII	HAW.	STP-8930(1)	2005	ADD. 102	144

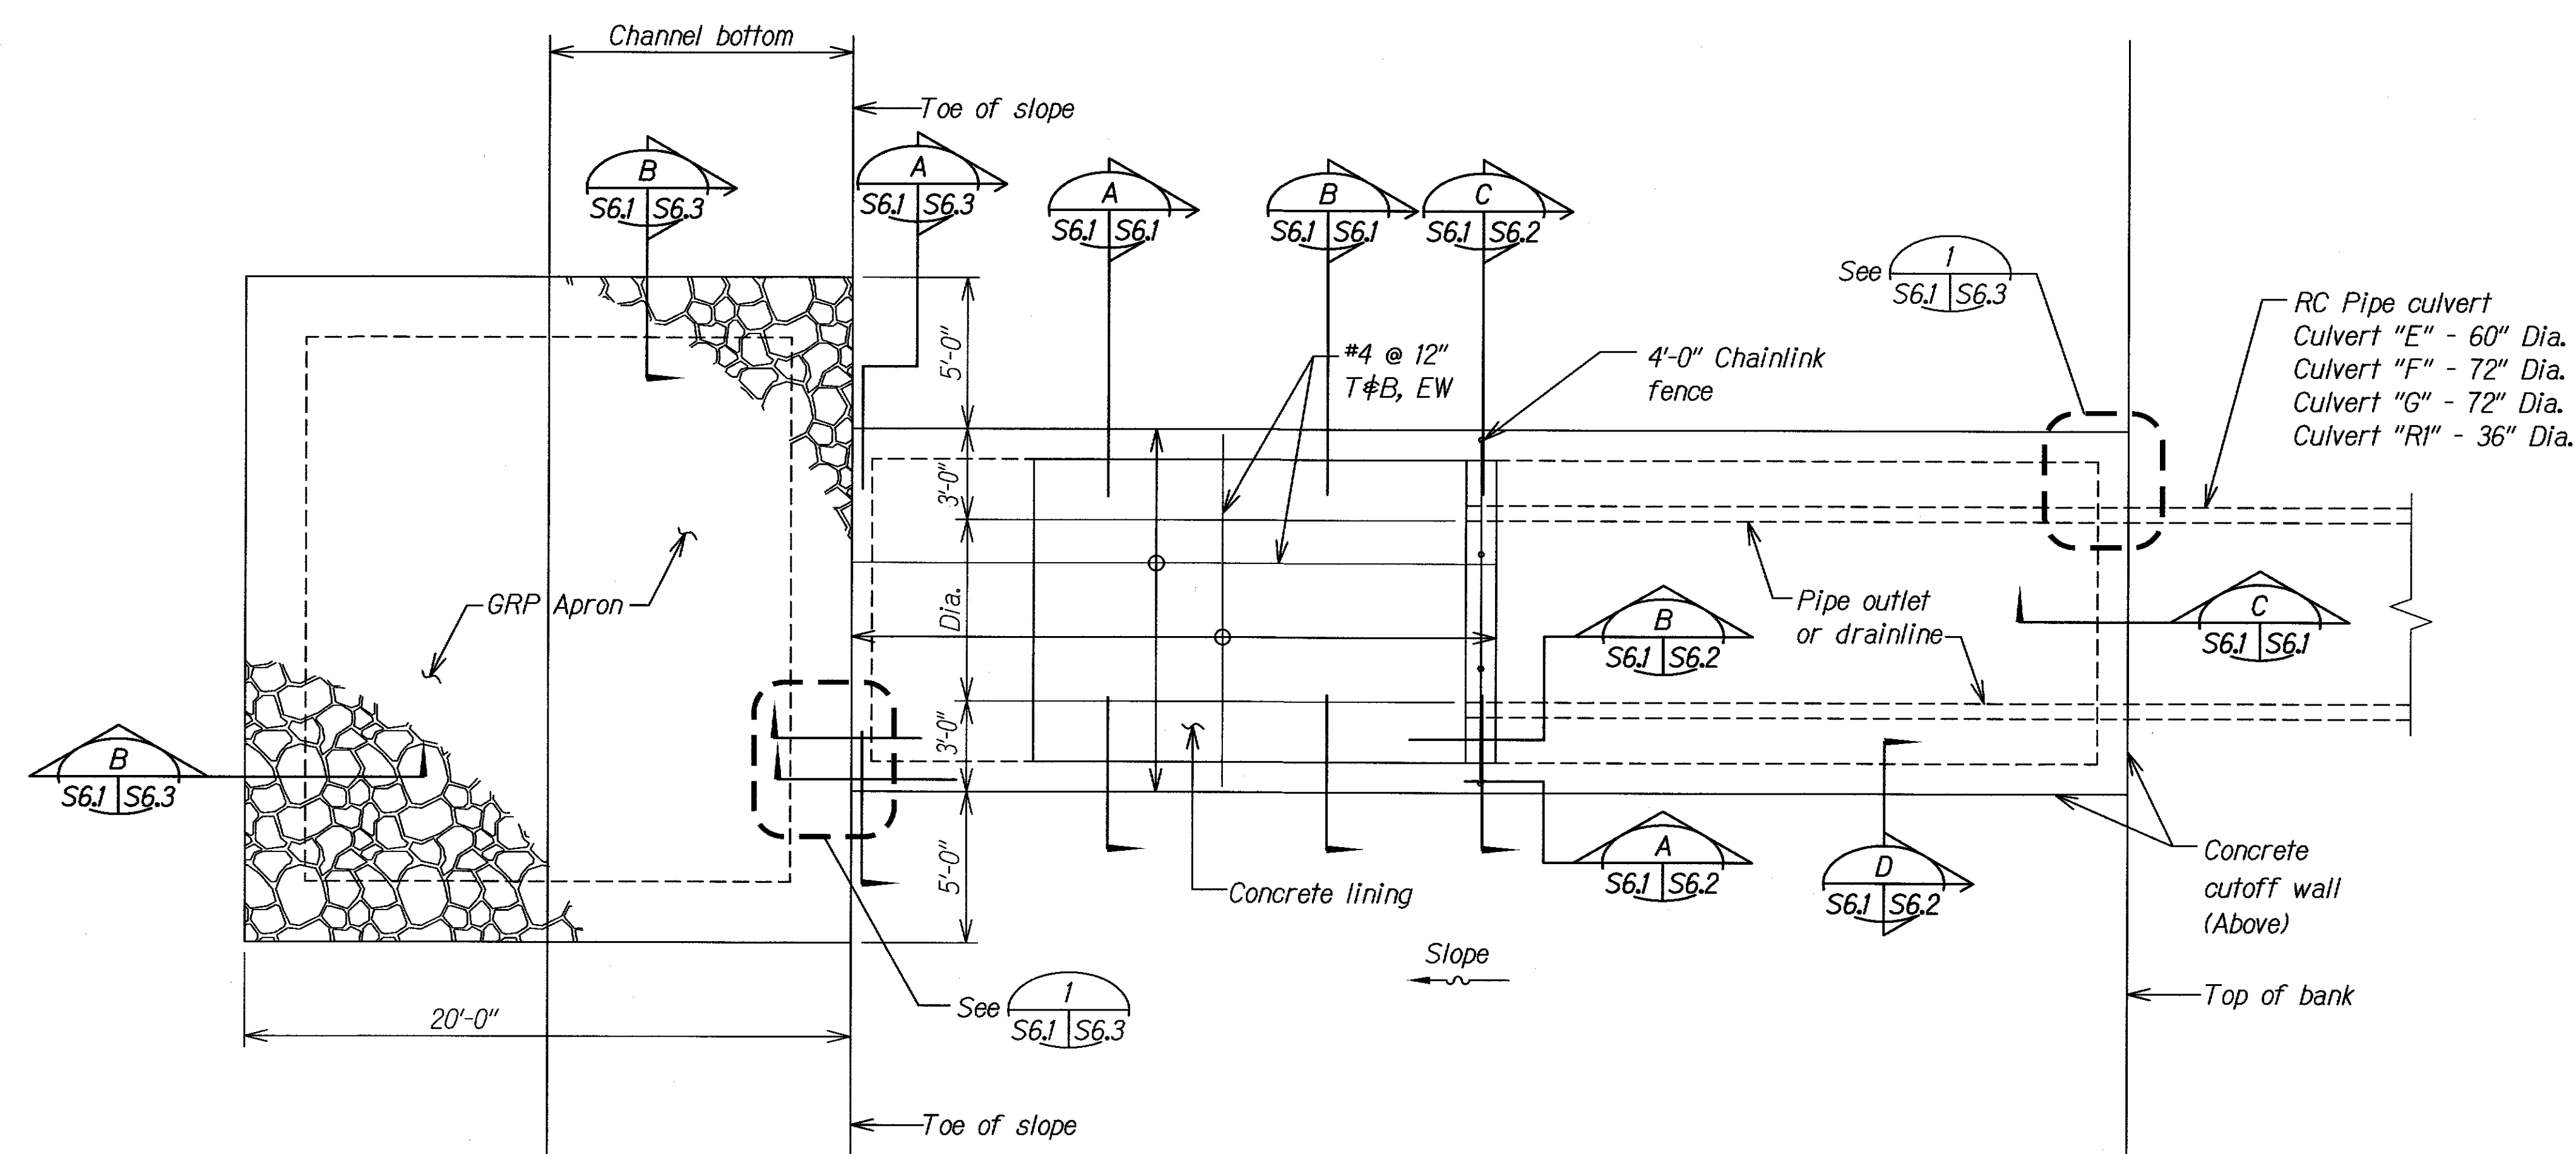


DRAIN CULVERT "E", "F", "G" AND "R-1" LAYOUT PLAN
 SCALE: 1/4" = 1'-0" S4.1, S4.2, S4.3, S4.4 | S6.1

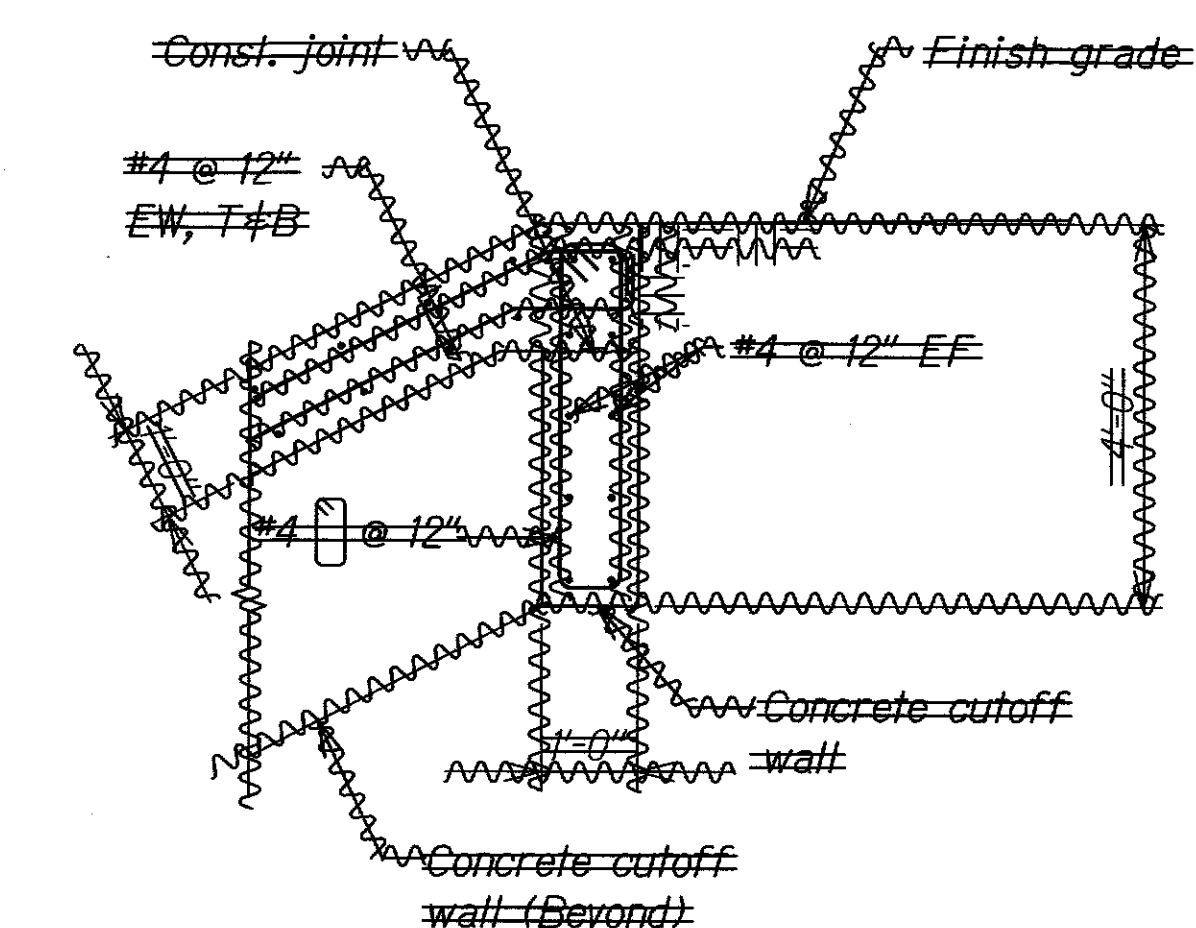

SECTION C
 SCALE: 1/2" = 1'-0"

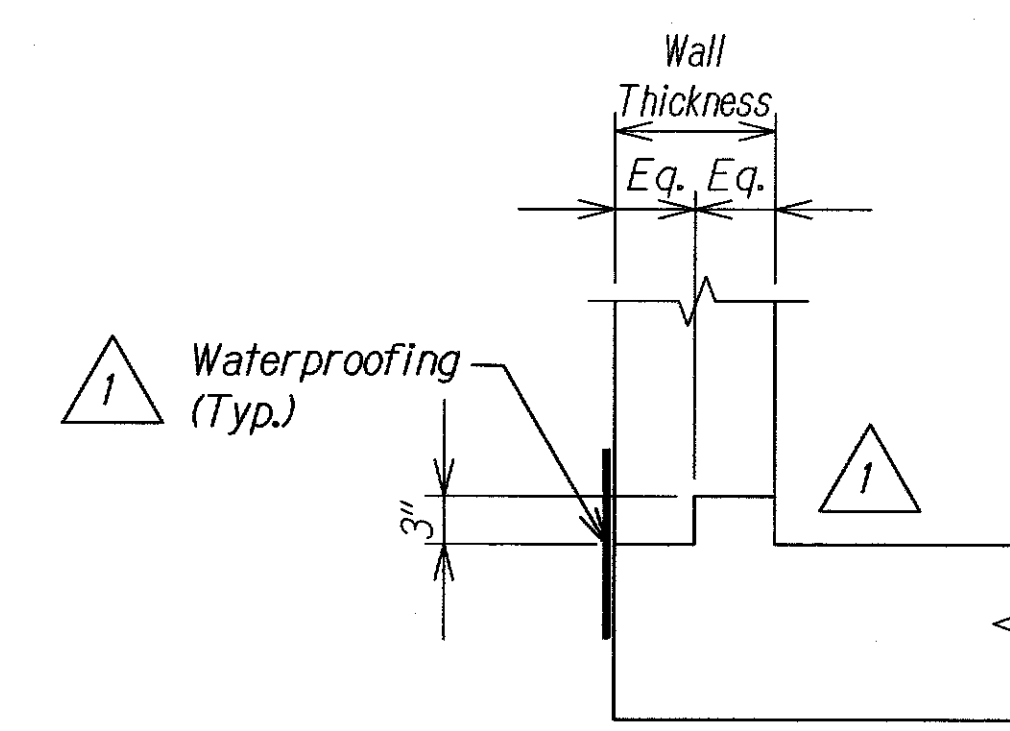

TYPICAL KEY DETAIL D
 SCALE: 1" = 1'-0" S6.1 | S6.1

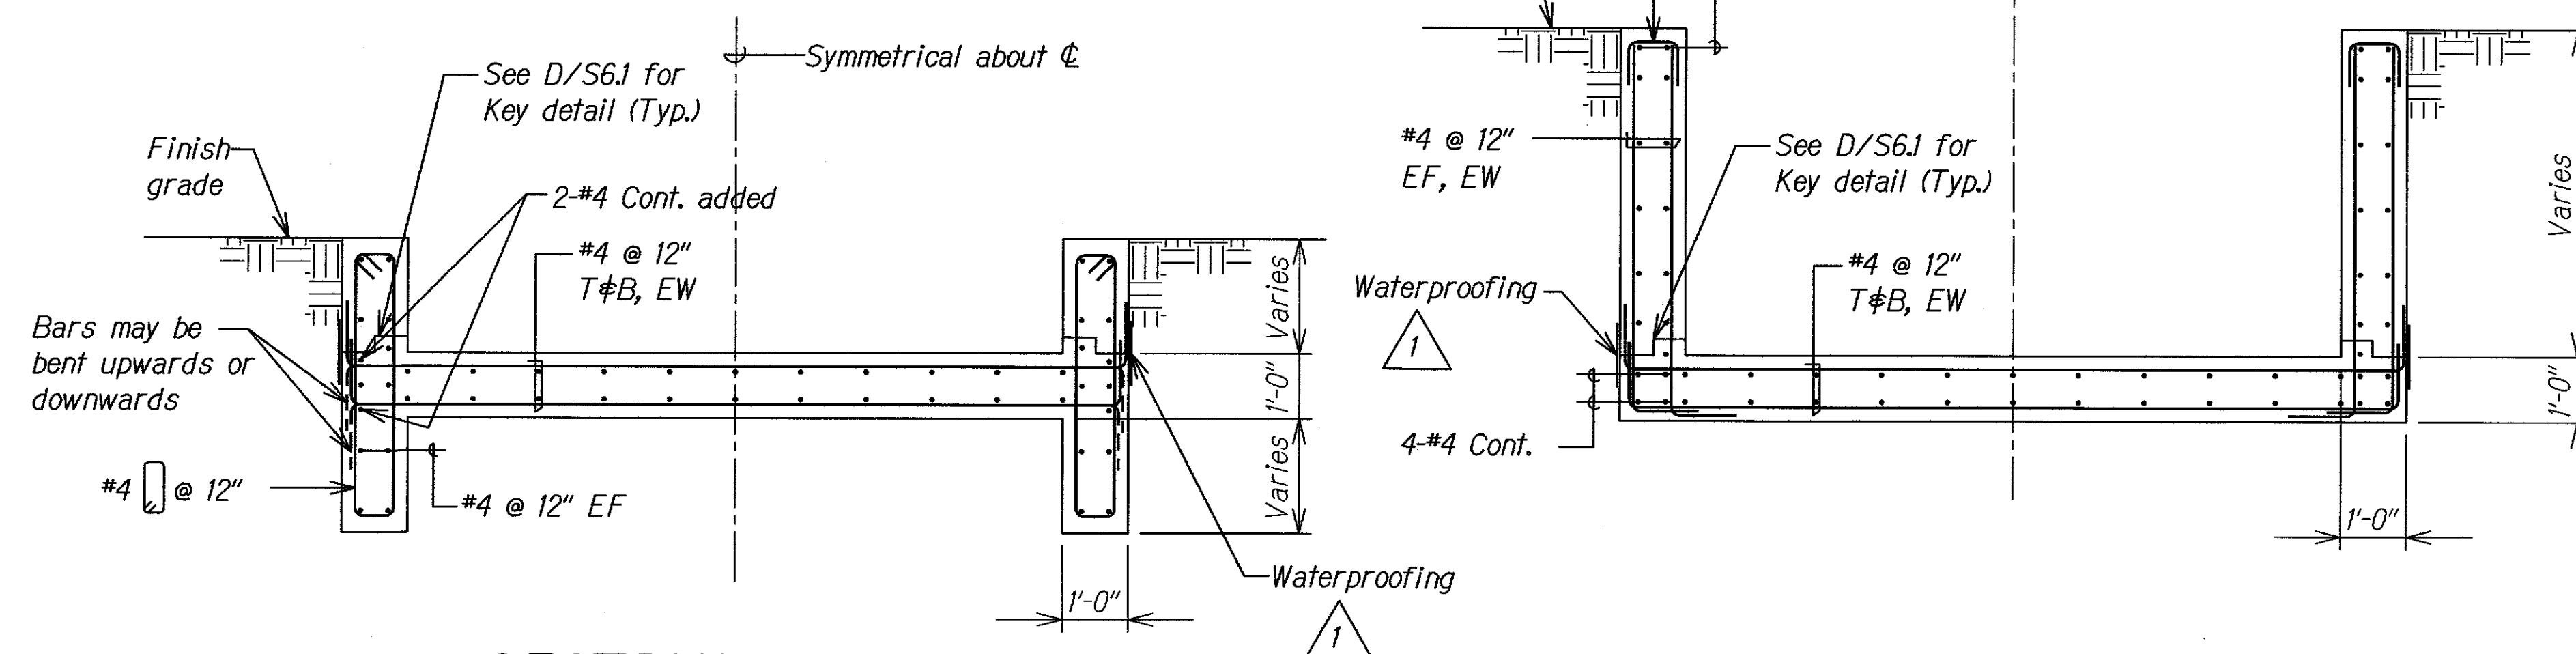


SECTION A
 SCALE: 1/2" = 1'-0" S6.1, S6.2 | S6.1

SECTION B
 SCALE: 1/2" = 1'-0" S6.1, S6.2 | S6.1

LEGEND FOR AS-BUILT POSTINGS	
	Squiggly line for as-built deletion
	Double line for as-built deletion
Roadway	Text for as-built posting

-	2	As Built - Field Order 8
1/18/05	1	Clarification of Notes
DATE	REVISION	

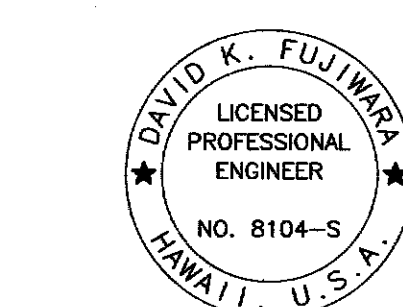

THIS WORK WAS PREPARED BY ME OR UNDER MY SUPERVISION.

David K. Fujimura
 SIGNATURE EXPIRATION DATE OF THE LICENSE

STATE OF HAWAII
DEPARTMENT OF TRANSPORTATION
HIGHWAYS DIVISION



DRAIN CULVERT "E", "F", "G" AND "R-1" OUTLET
LAYOUT PLAN AND SECTIONS
North-South Road
Phase 1A
F.A.I. Proj. No. STP-8930(1)



Scale: As Noted
SHEET No. S6.1 OF 43 SHEETS

Date: Dec. 22, 2004


FED. ROAD DIST. NO.	STATE	FED. AID PROJ. NO.	FISCAL YEAR	SHEET NO.	TOTAL SHEETS
HAWAII	HAW.	STP-8930(1)	2005	ADD. 103	144

LEGEND FOR
AS-BUILT POSTINGS

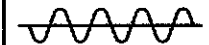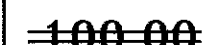
 Squiggly line for as-built deletion
 Double line for as-built deletion
Roadway Text for as-built posting

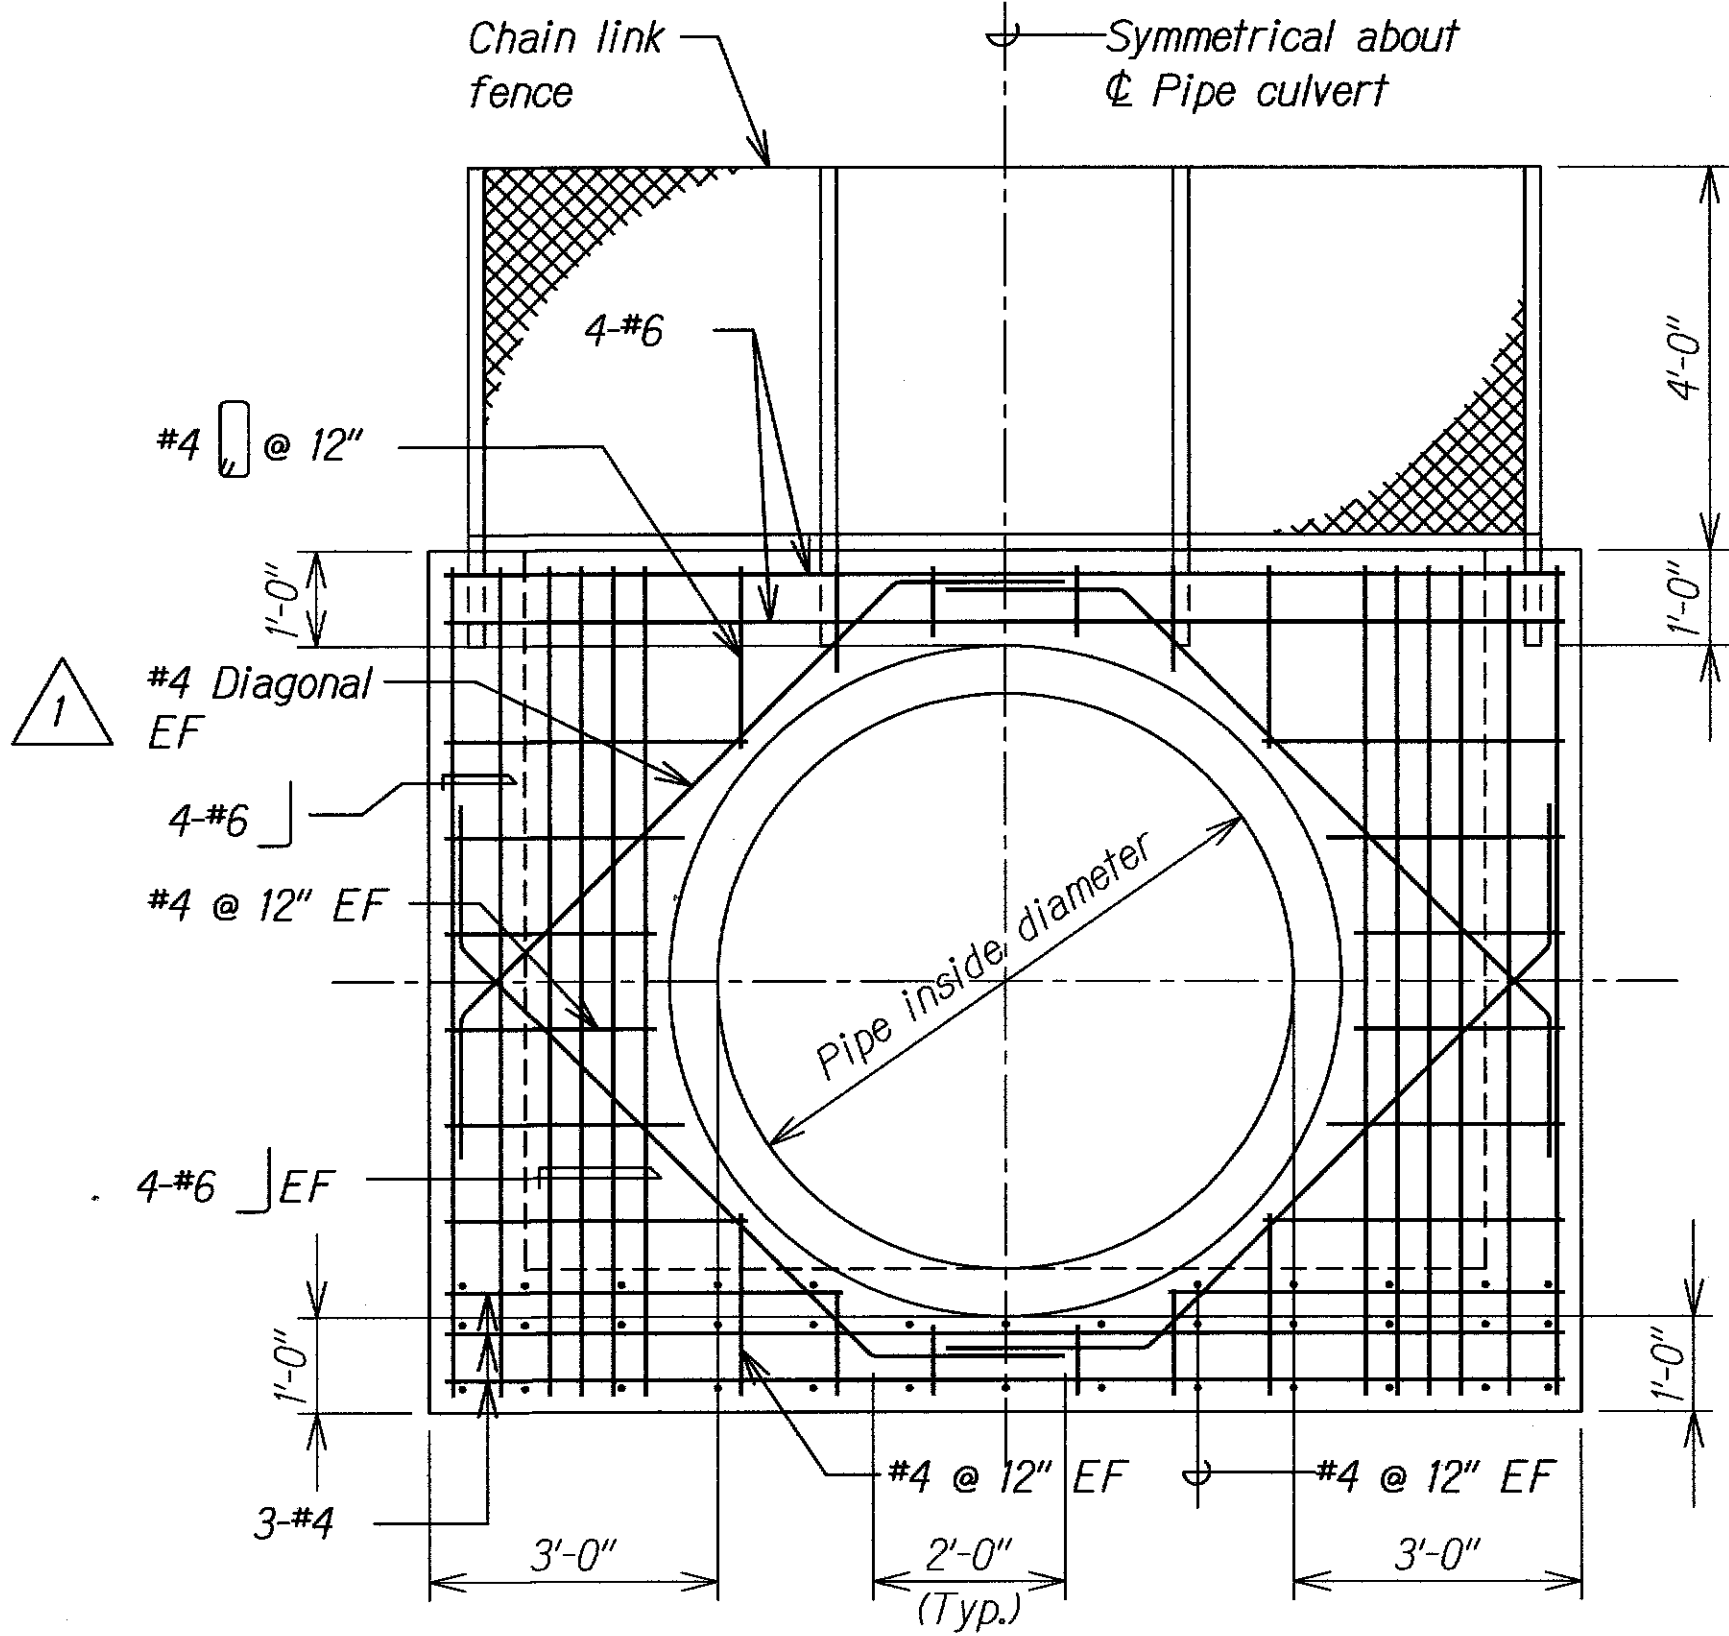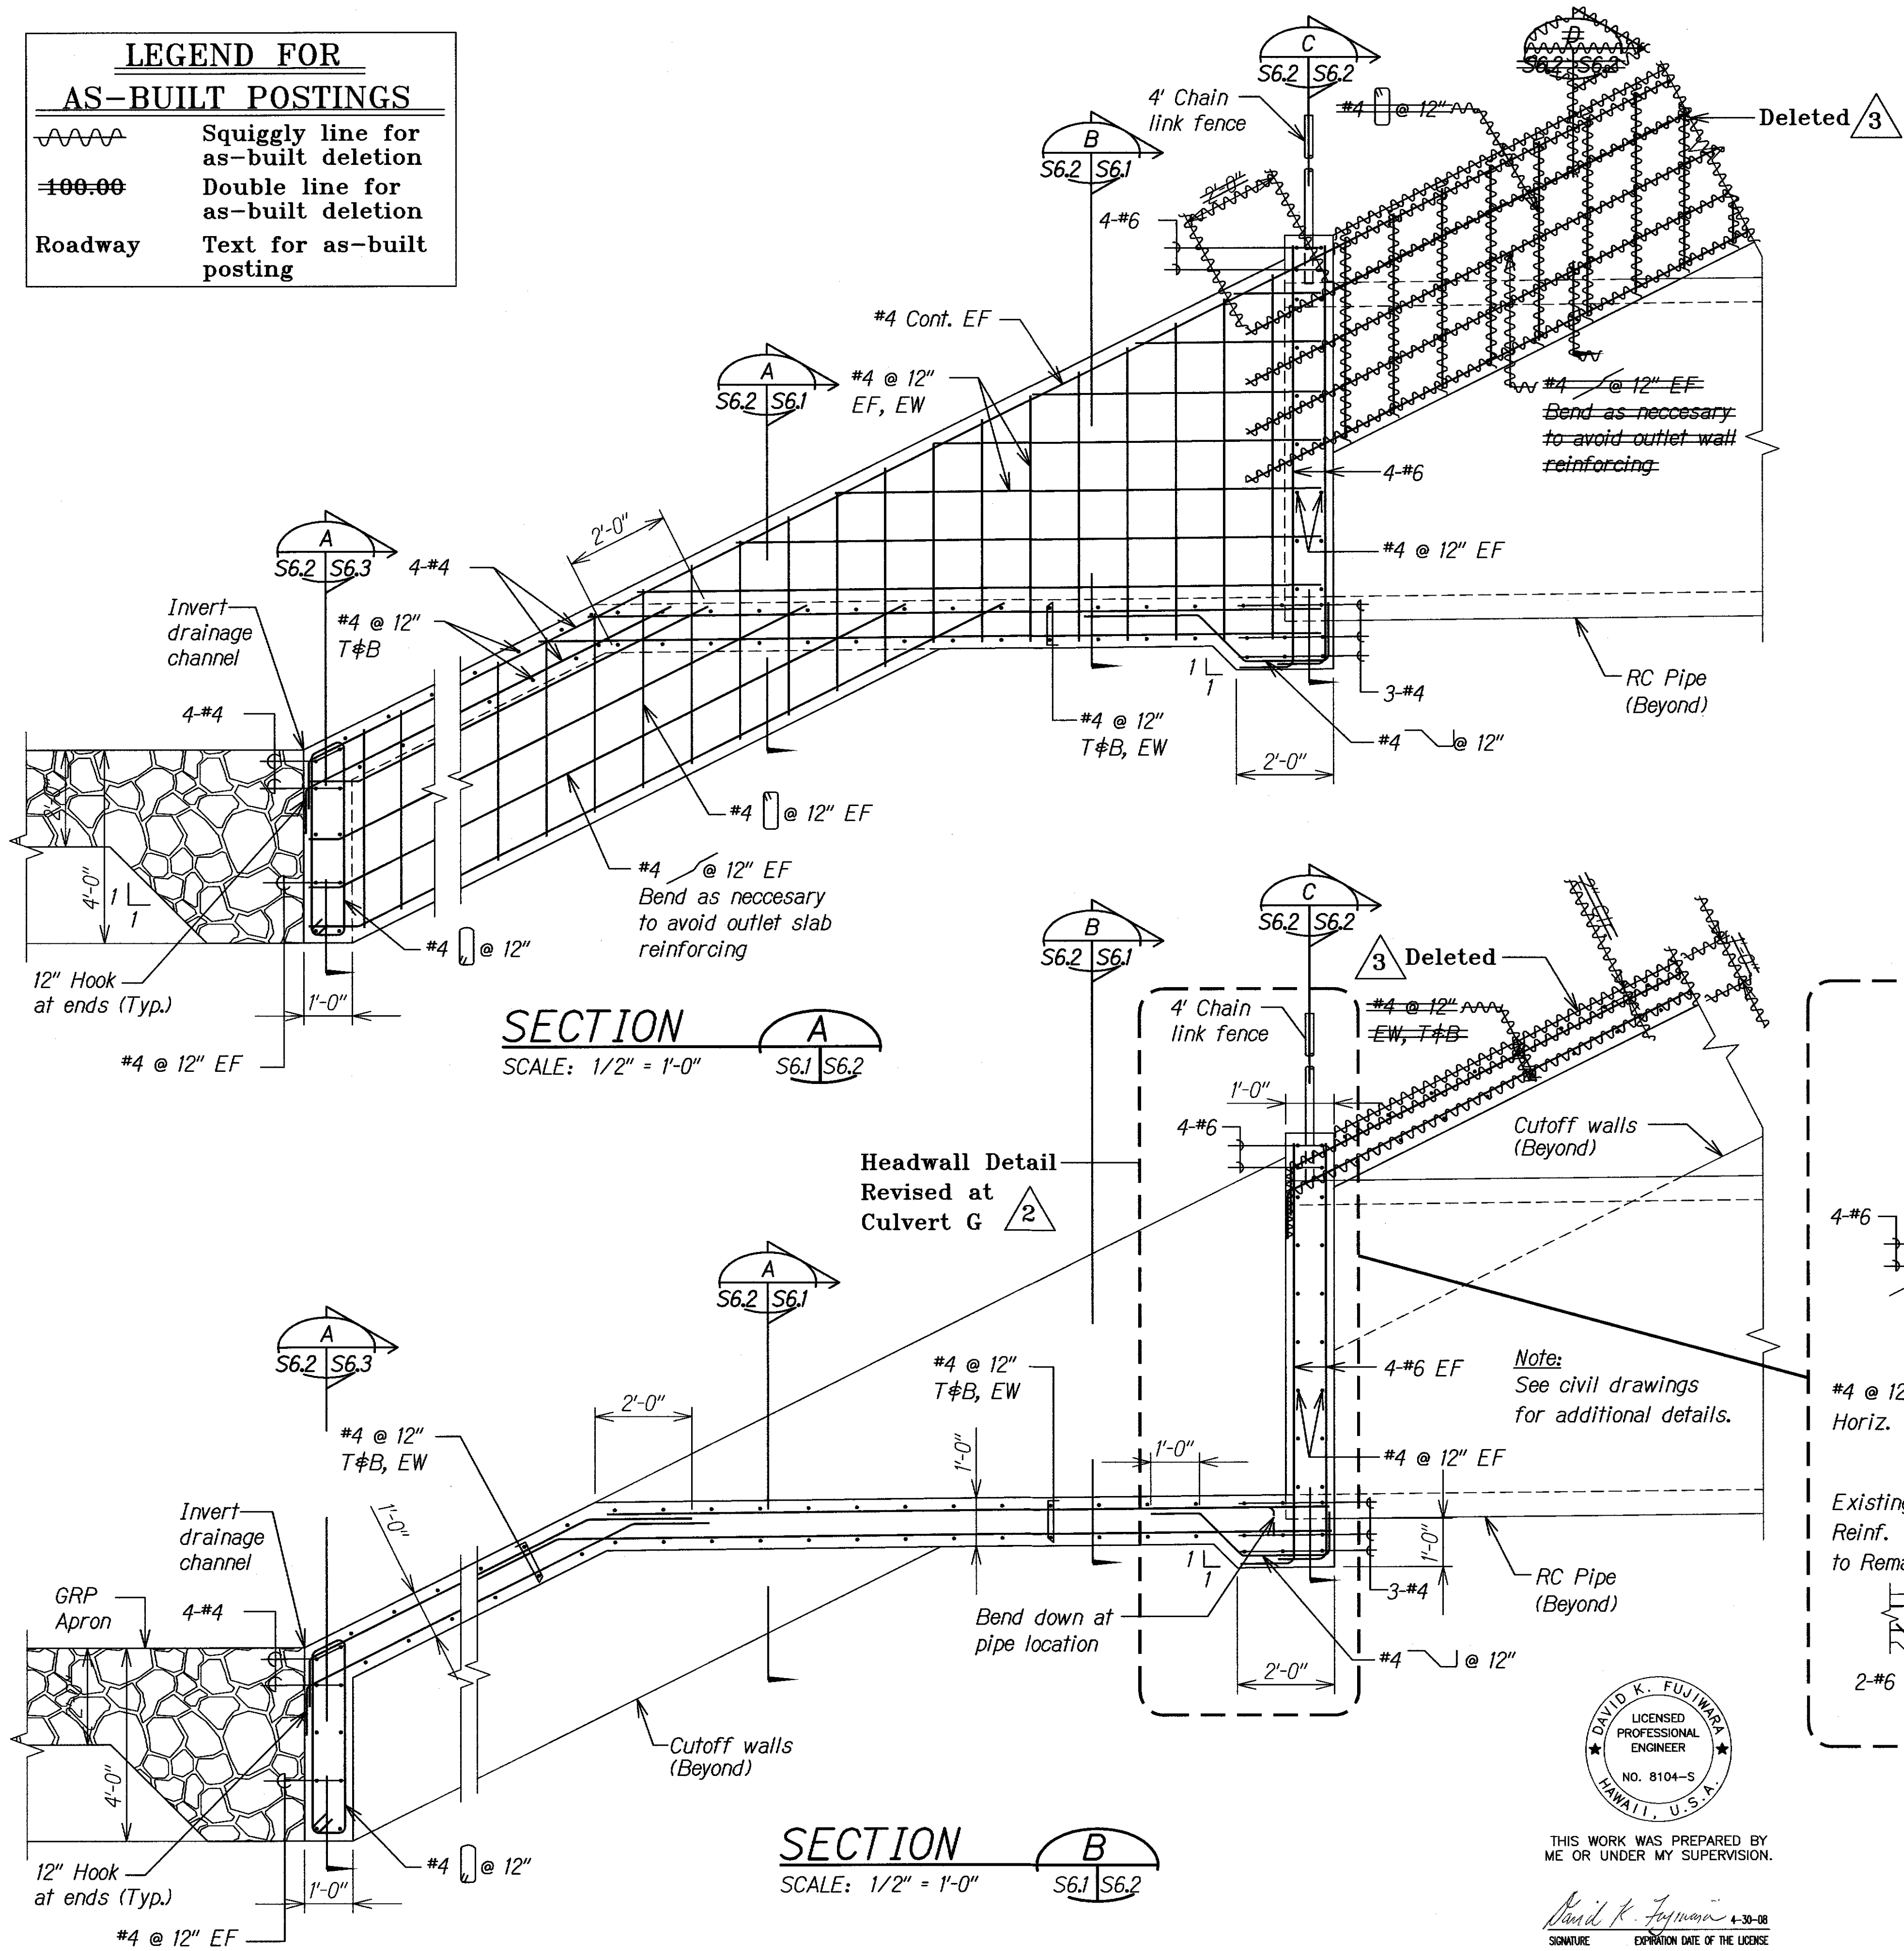

SECTION C
SCALE: 1/2" = 1'-0" S6.1, S6.2 S6.2

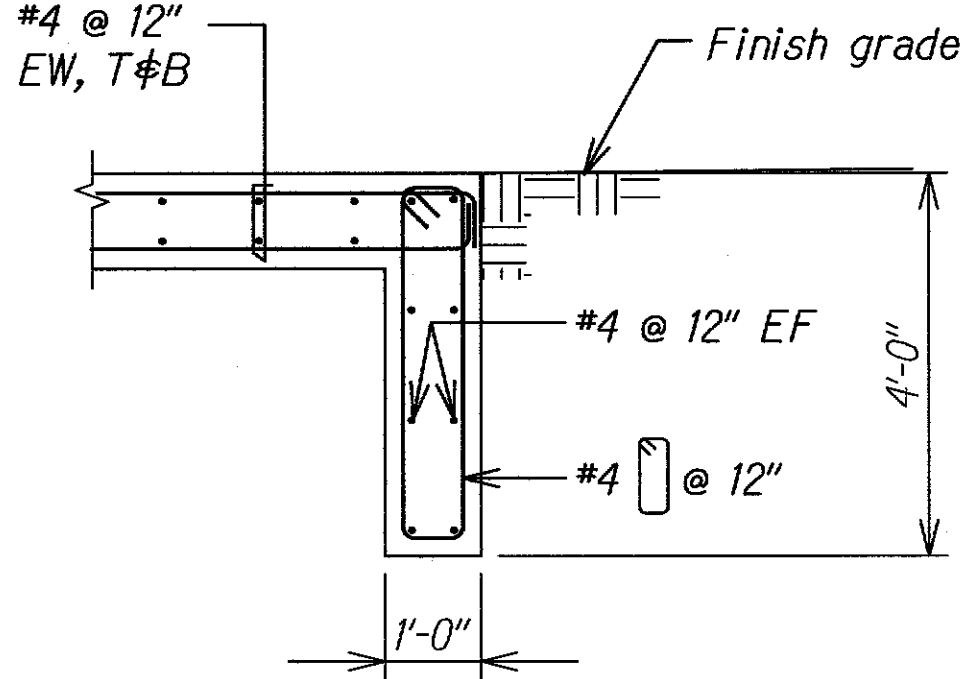

SECTION D
SCALE: 1/2" = 1'-0" S6.1, S6.2 S6.2

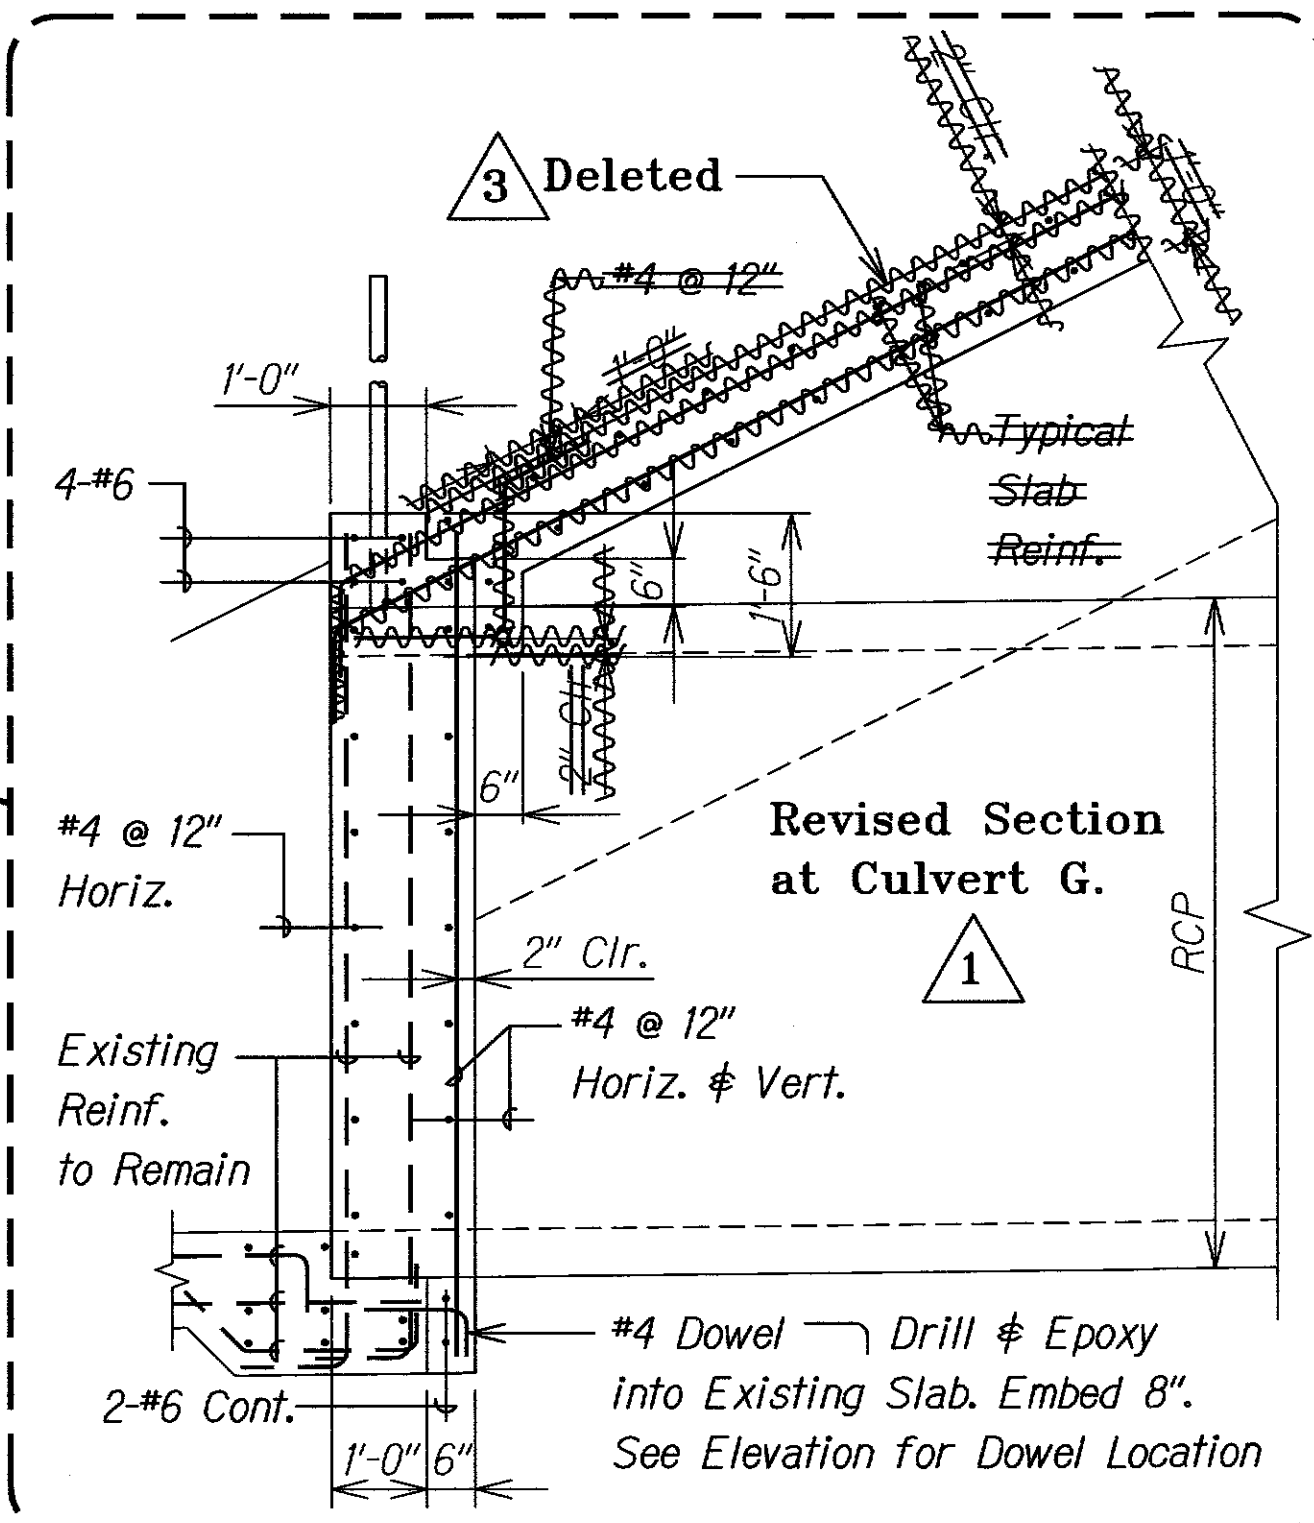

-	3	As Built - Field Order 8
-	2	As Built - RFI 35
1/18/05	1	Clarification of Notes
DATE		REVISION

STATE OF HAWAII
DEPARTMENT OF TRANSPORTATION
HIGHWAYS DIVISION

DRAIN CULVERT "E," "F," "G" AND "R" OUTLET SECTIONS
North-South Road
Phase 1A
F.A.I. Proj. No. STP-8930(1)


Scale: As Noted Date: Dec. 22, 2004
SHEET No. S6.2 OF 43 SHEETS

ORIGINAL PLAN	DATE
NOTE BOOK	DESIGNED BY
	QUANTITIES BY
	CHECKED BY


DAVID K. FUJIMURA
LICENSED PROFESSIONAL ENGINEER
NO. 8104-S
HAWAII, U.S.A.

THIS WORK WAS PREPARED BY ME OR UNDER MY SUPERVISION.
Signature: David K. Fujimura
EXPIRATION DATE OF THE LICENSE: 4-30-08


FED. ROAD DIST. NO.	STATE	FED. AID PROJ. NO.	FISCAL YEAR	SHEET NO.	TOTAL SHEETS
HAWAII	HAW.	STP-8930(1)	2005	ADD. 104	144

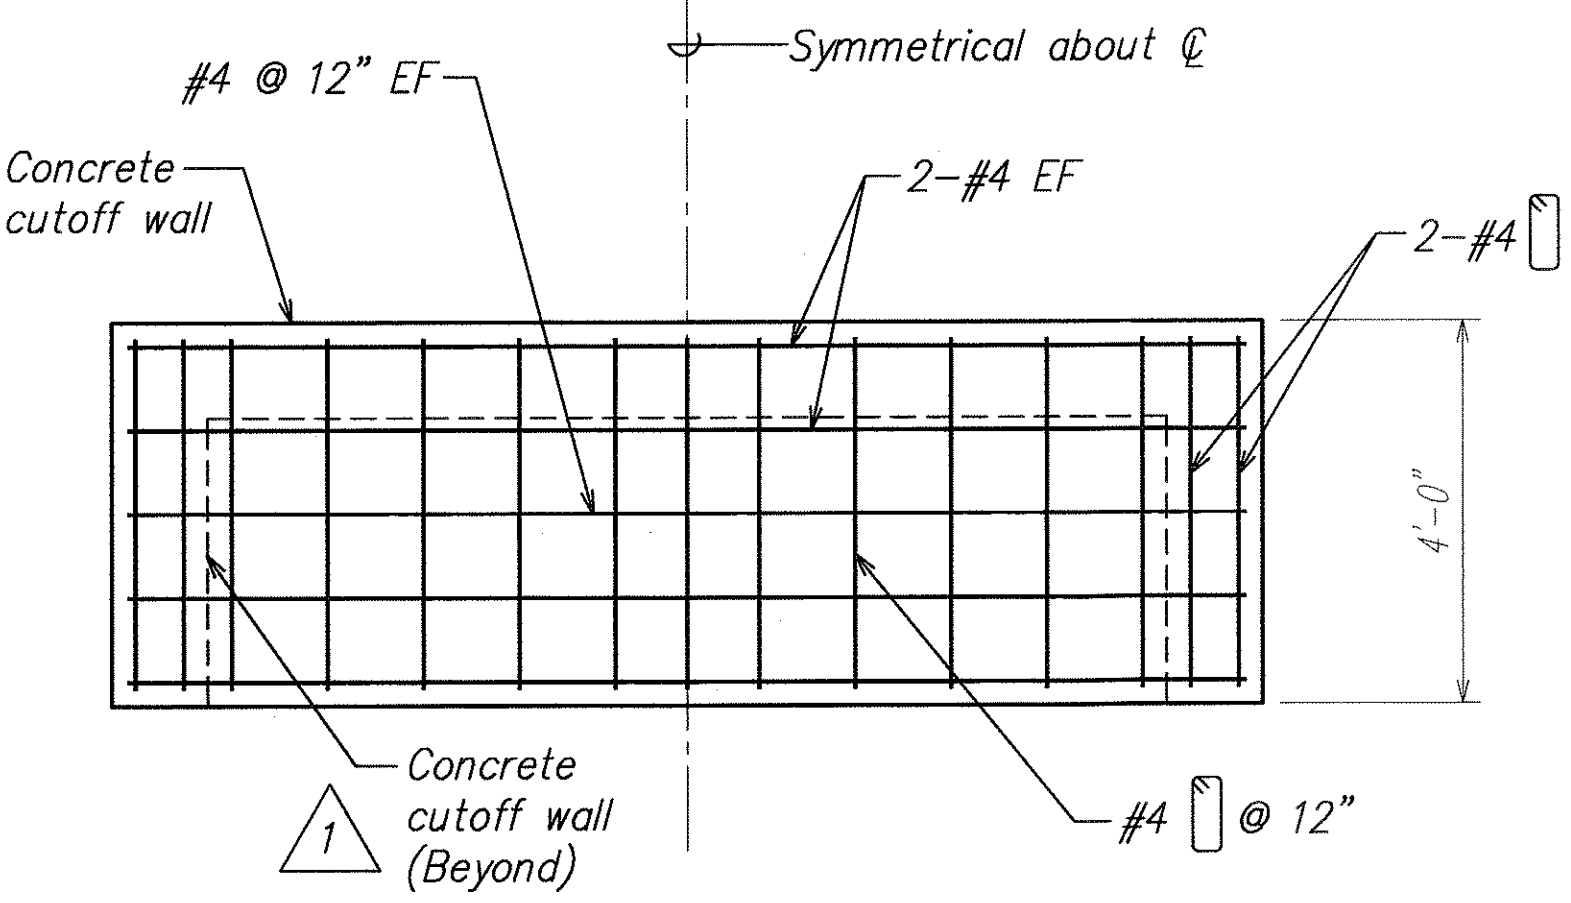


SECTION A
SCALE: 1/2" = 1'-0" S6.1, S6.2, S6.3

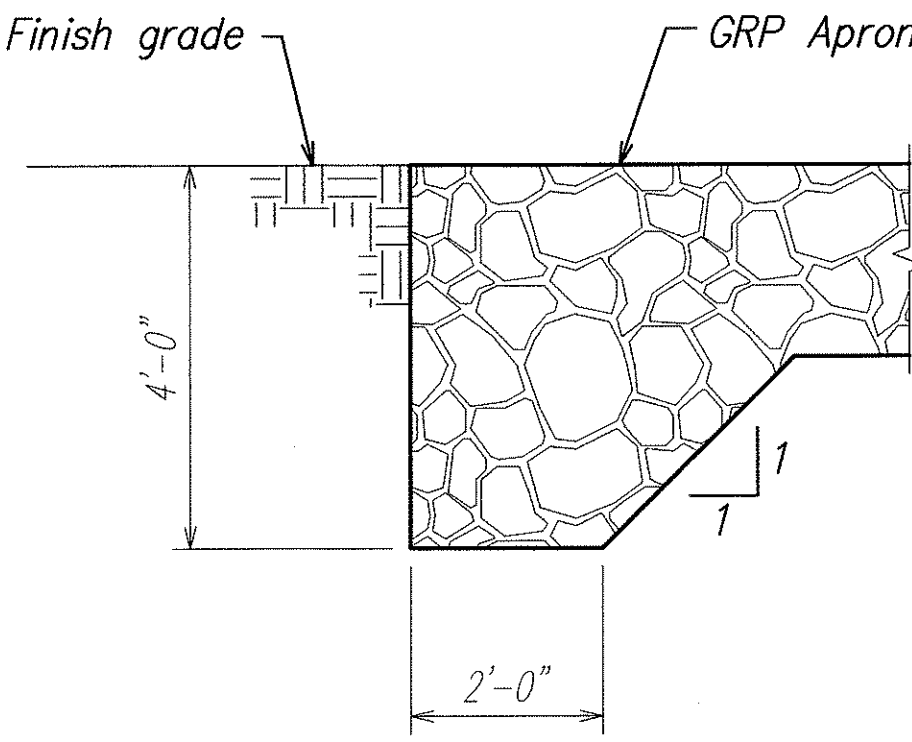

SECTION B
SCALE: 1/2" = 1'-0" S6.1, S6.3

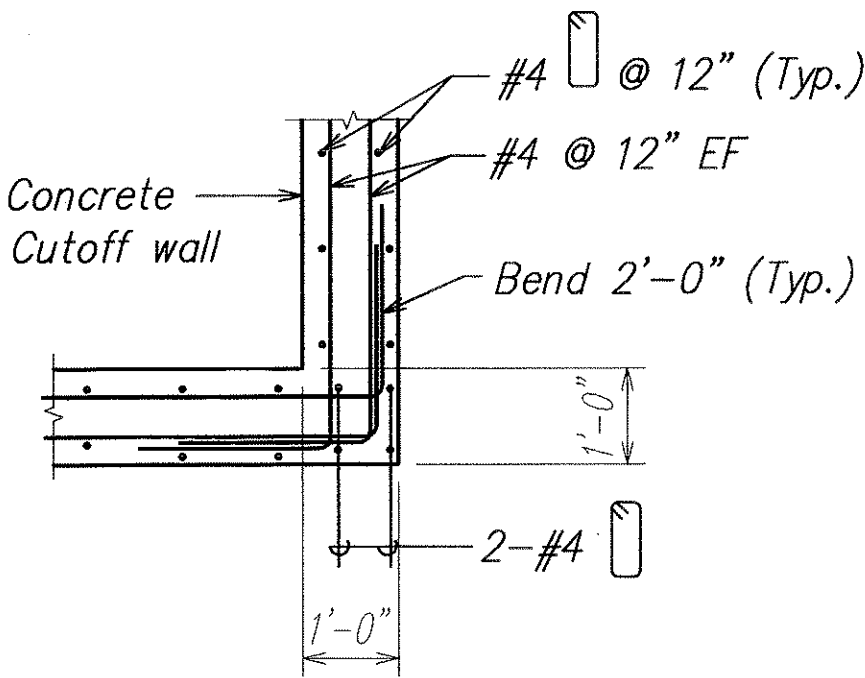

TYPICAL CORNER DETAIL 1
SCALE: 1/2" = 1'-0" S6.1, S6.3

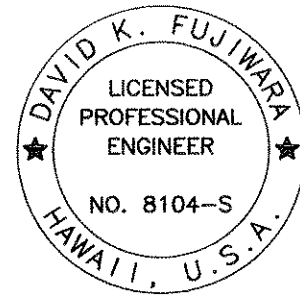

THIS WORK WAS PREPARED BY ME OR UNDER MY SUPERVISION.

Signature: David K. Fujiwara
EXPIRATION DATE OF THE LICENSE: 4-30-06

STATE OF HAWAII
DEPARTMENT OF TRANSPORTATION
HIGHWAYS DIVISION

TYPICAL GRP APRON SECTIONS AND DETAIL

North-South Road
Phase 1A
F.A.I. Proj. No. STP-8930(1)


Scale: As Noted Date: Dec. 22, 2004

SHEET No. S6.3 OF 43 SHEETS

1/18/05	1 Clarification of Notes
DATE	REVISION


ORIGINAL PLAN	SURVEY PLOTTED BY	DATE
NOTE BOOK	DRAWN BY	
	DESIGNED BY	
	CHECKED BY	

FED. ROAD DIST. NO.	STATE	FED. AID PROJ. NO.	FISCAL YEAR	SHEET NO.	TOTAL SHEETS
HAWAII	HAW.	STP-8930(1)	2005	105	144

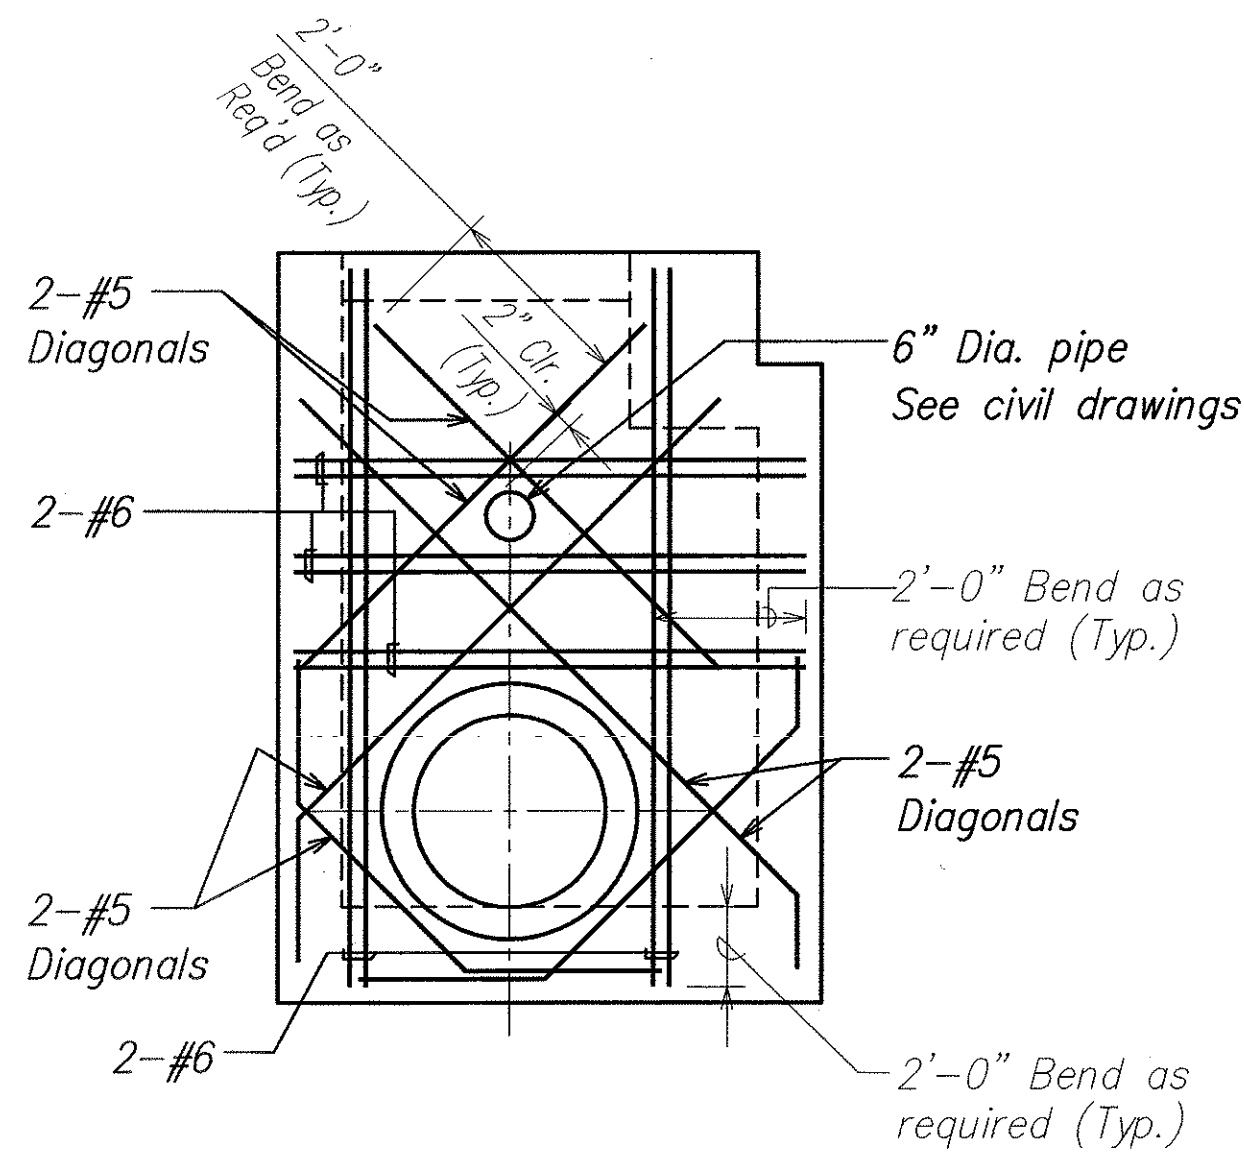


ADDED REINFORCING
AT PIPE OPENING **A**
SCALE: 1/2" = 1'-0" S6.4 S6.4

Note:
For additional details
see Standard Plans.

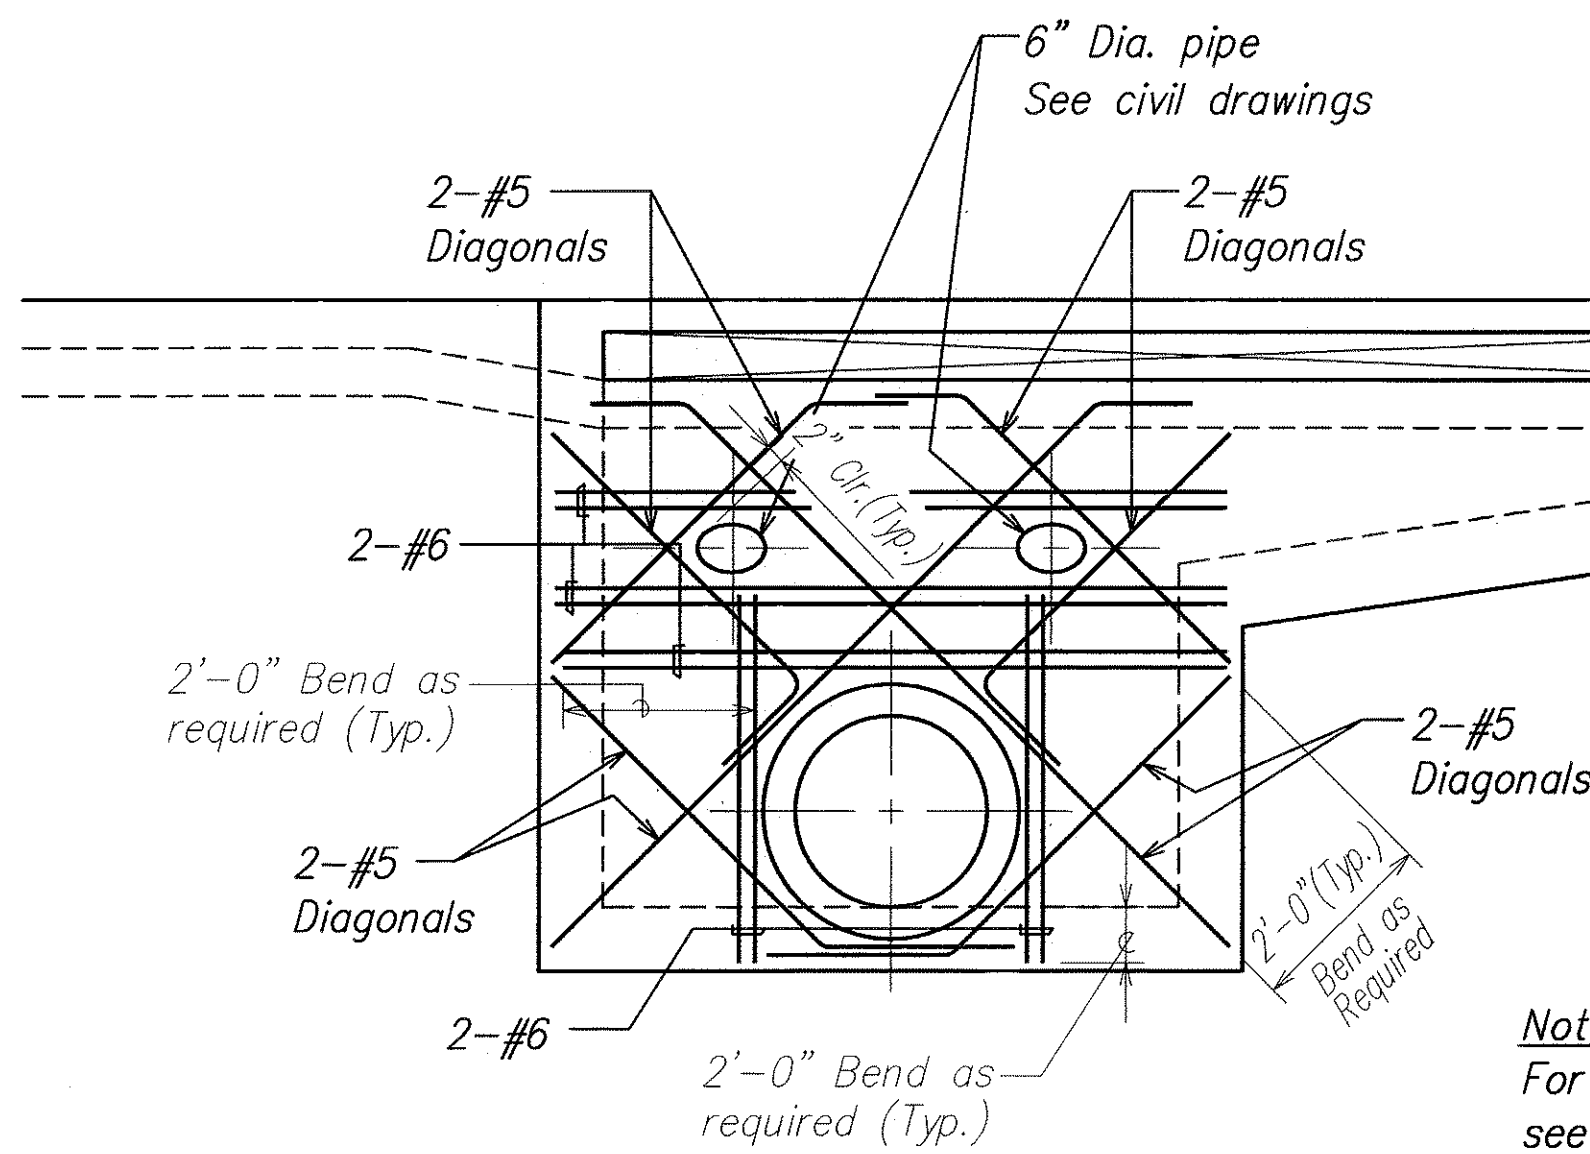


ADDED REINFORCING
AT PIPE OPENINGS **B**
SCALE: 1/2" = 1'-0" S6.4 S6.4

Note:
For additional details
see Standard Plans.

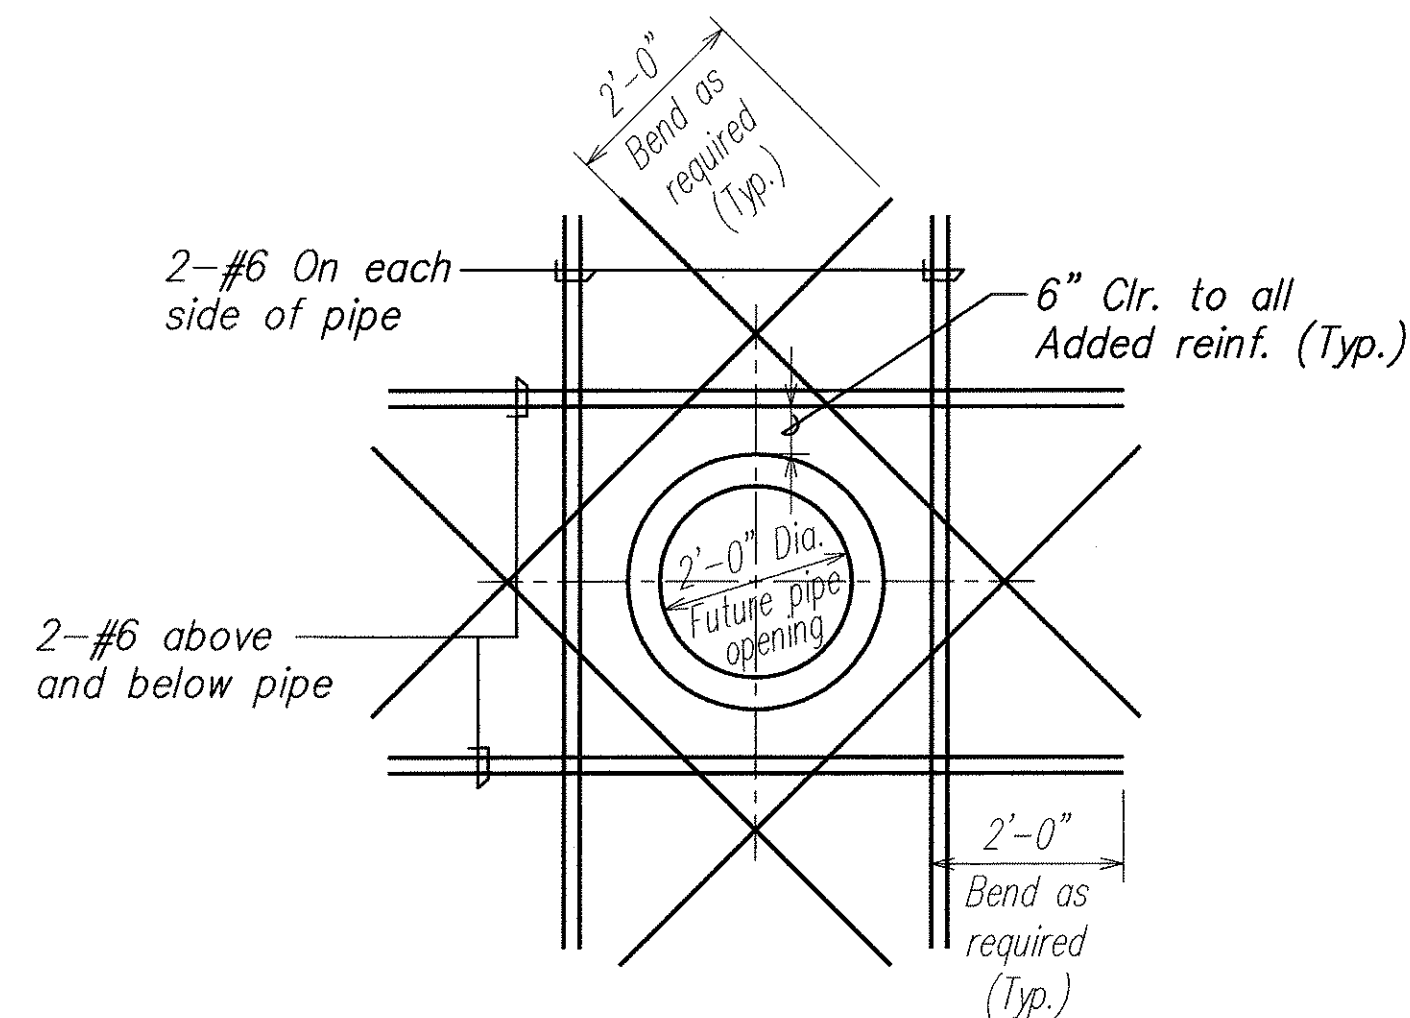

ADDED REINFORCING
FUTURE 24" PIPE OPENING **C**
SCALE: 1/2" = 1'-0" S6.4 S6.4

SURVEY PLOTTED BY	DATE
DRAWN BY	
TRACED BY	
QUANTITIES BY	
CHECKED BY	
ORIGINAL PLAN	
NOTE BOOK	
No.	

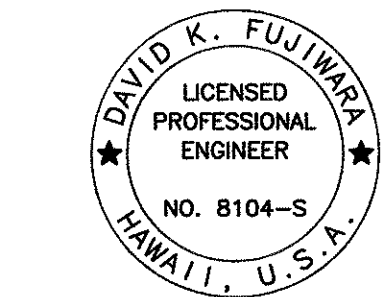

THIS WORK WAS PREPARED BY
ME OR UNDER MY SUPERVISION.

Signature: David K. Fujiwara
EXPIRATION DATE OF THE LICENSE: 4-30-08

STATE OF HAWAII
DEPARTMENT OF TRANSPORTATION
HIGHWAYS DIVISION

TYPICAL ADDED REINFORCING
AT PIPE OPENING SECTIONS

North-South Road
Phase 1A
F.A.I. Proj. No. STP-8930(1)






Scale: As Noted Date: Dec. 22, 2004

SHEET No. S6.4 OF 43 SHEETS

FED. ROAD DIST. NO.	STATE	FED. AID PROJ. NO.	FISCAL YEAR	SHEET NO.	TOTAL SHEETS
HAWAII	HAW.	STP-8930(1)	2005	ADD. 106	144

LEGEND:

- Structure excavation pay limits
- Aggregate subbase

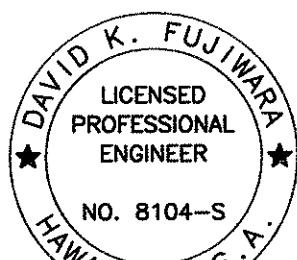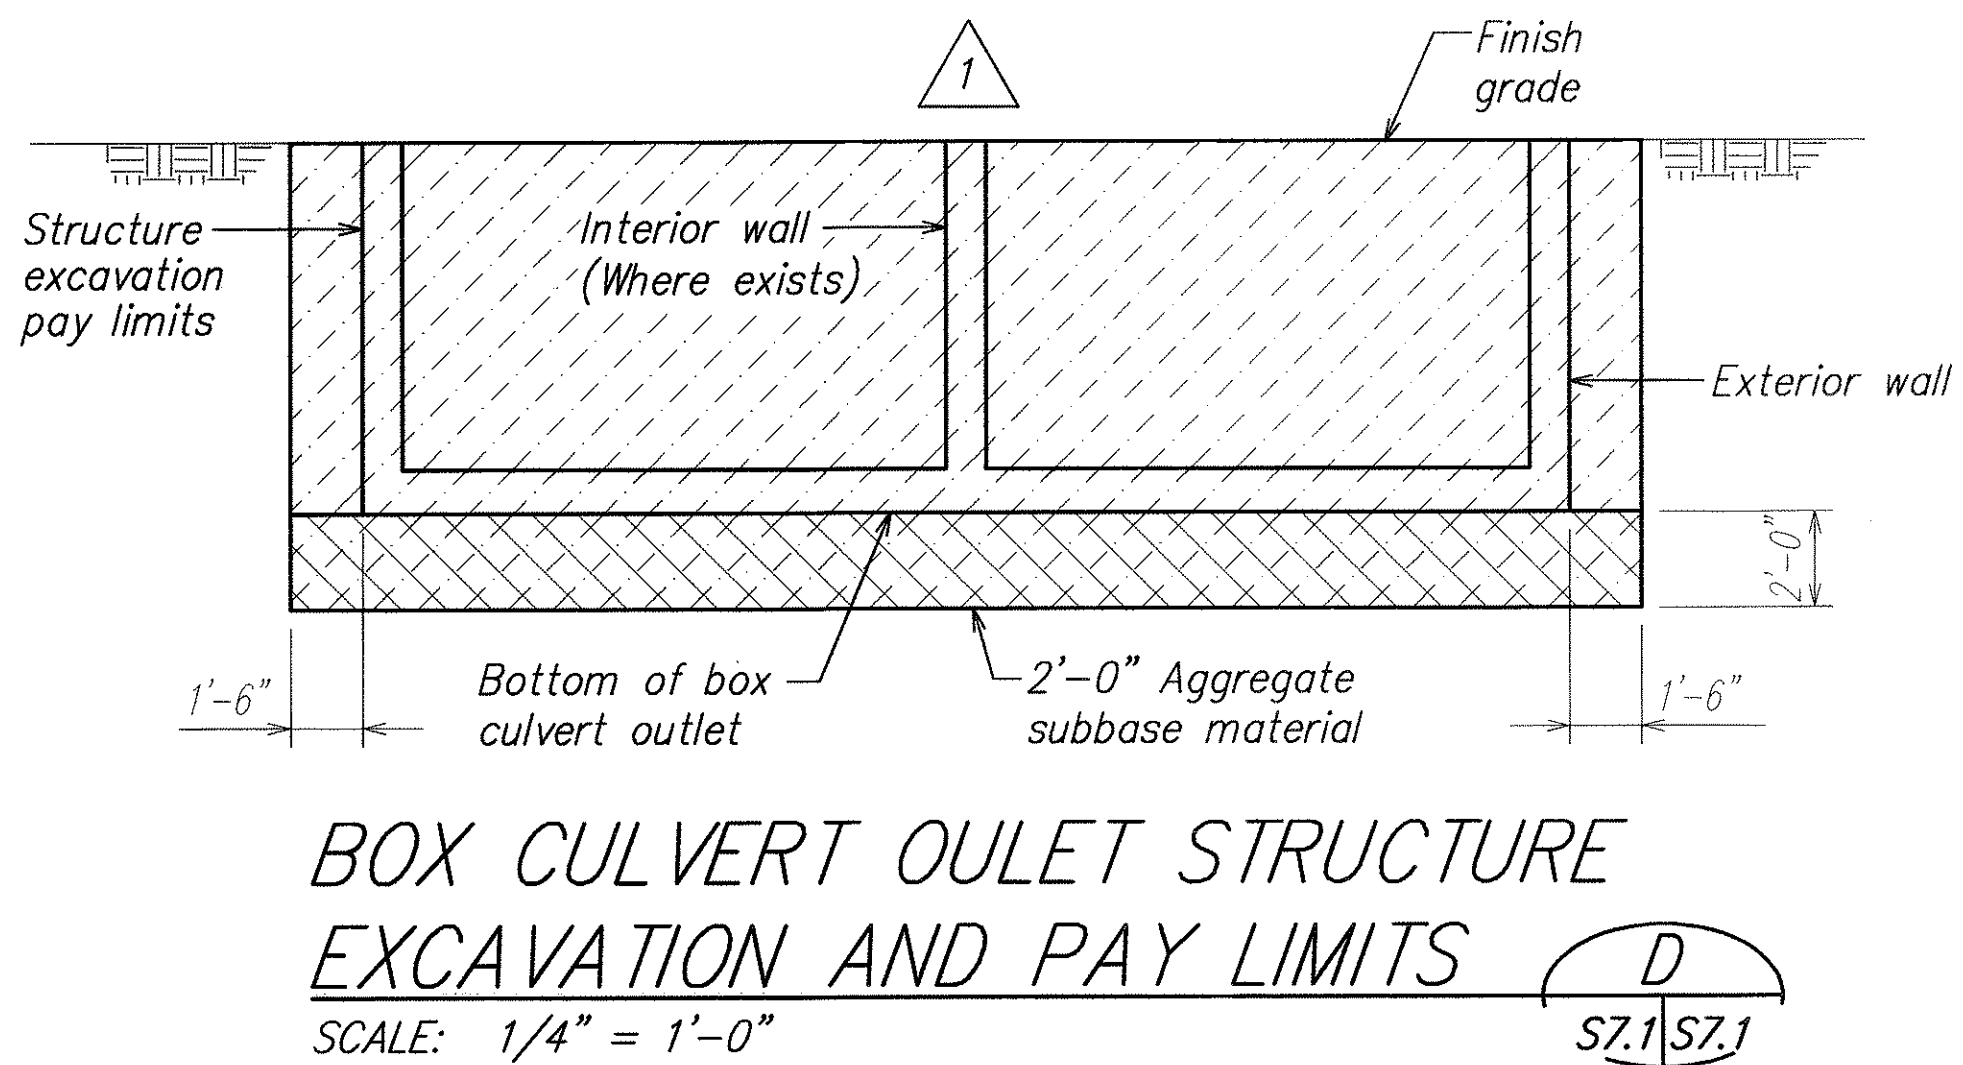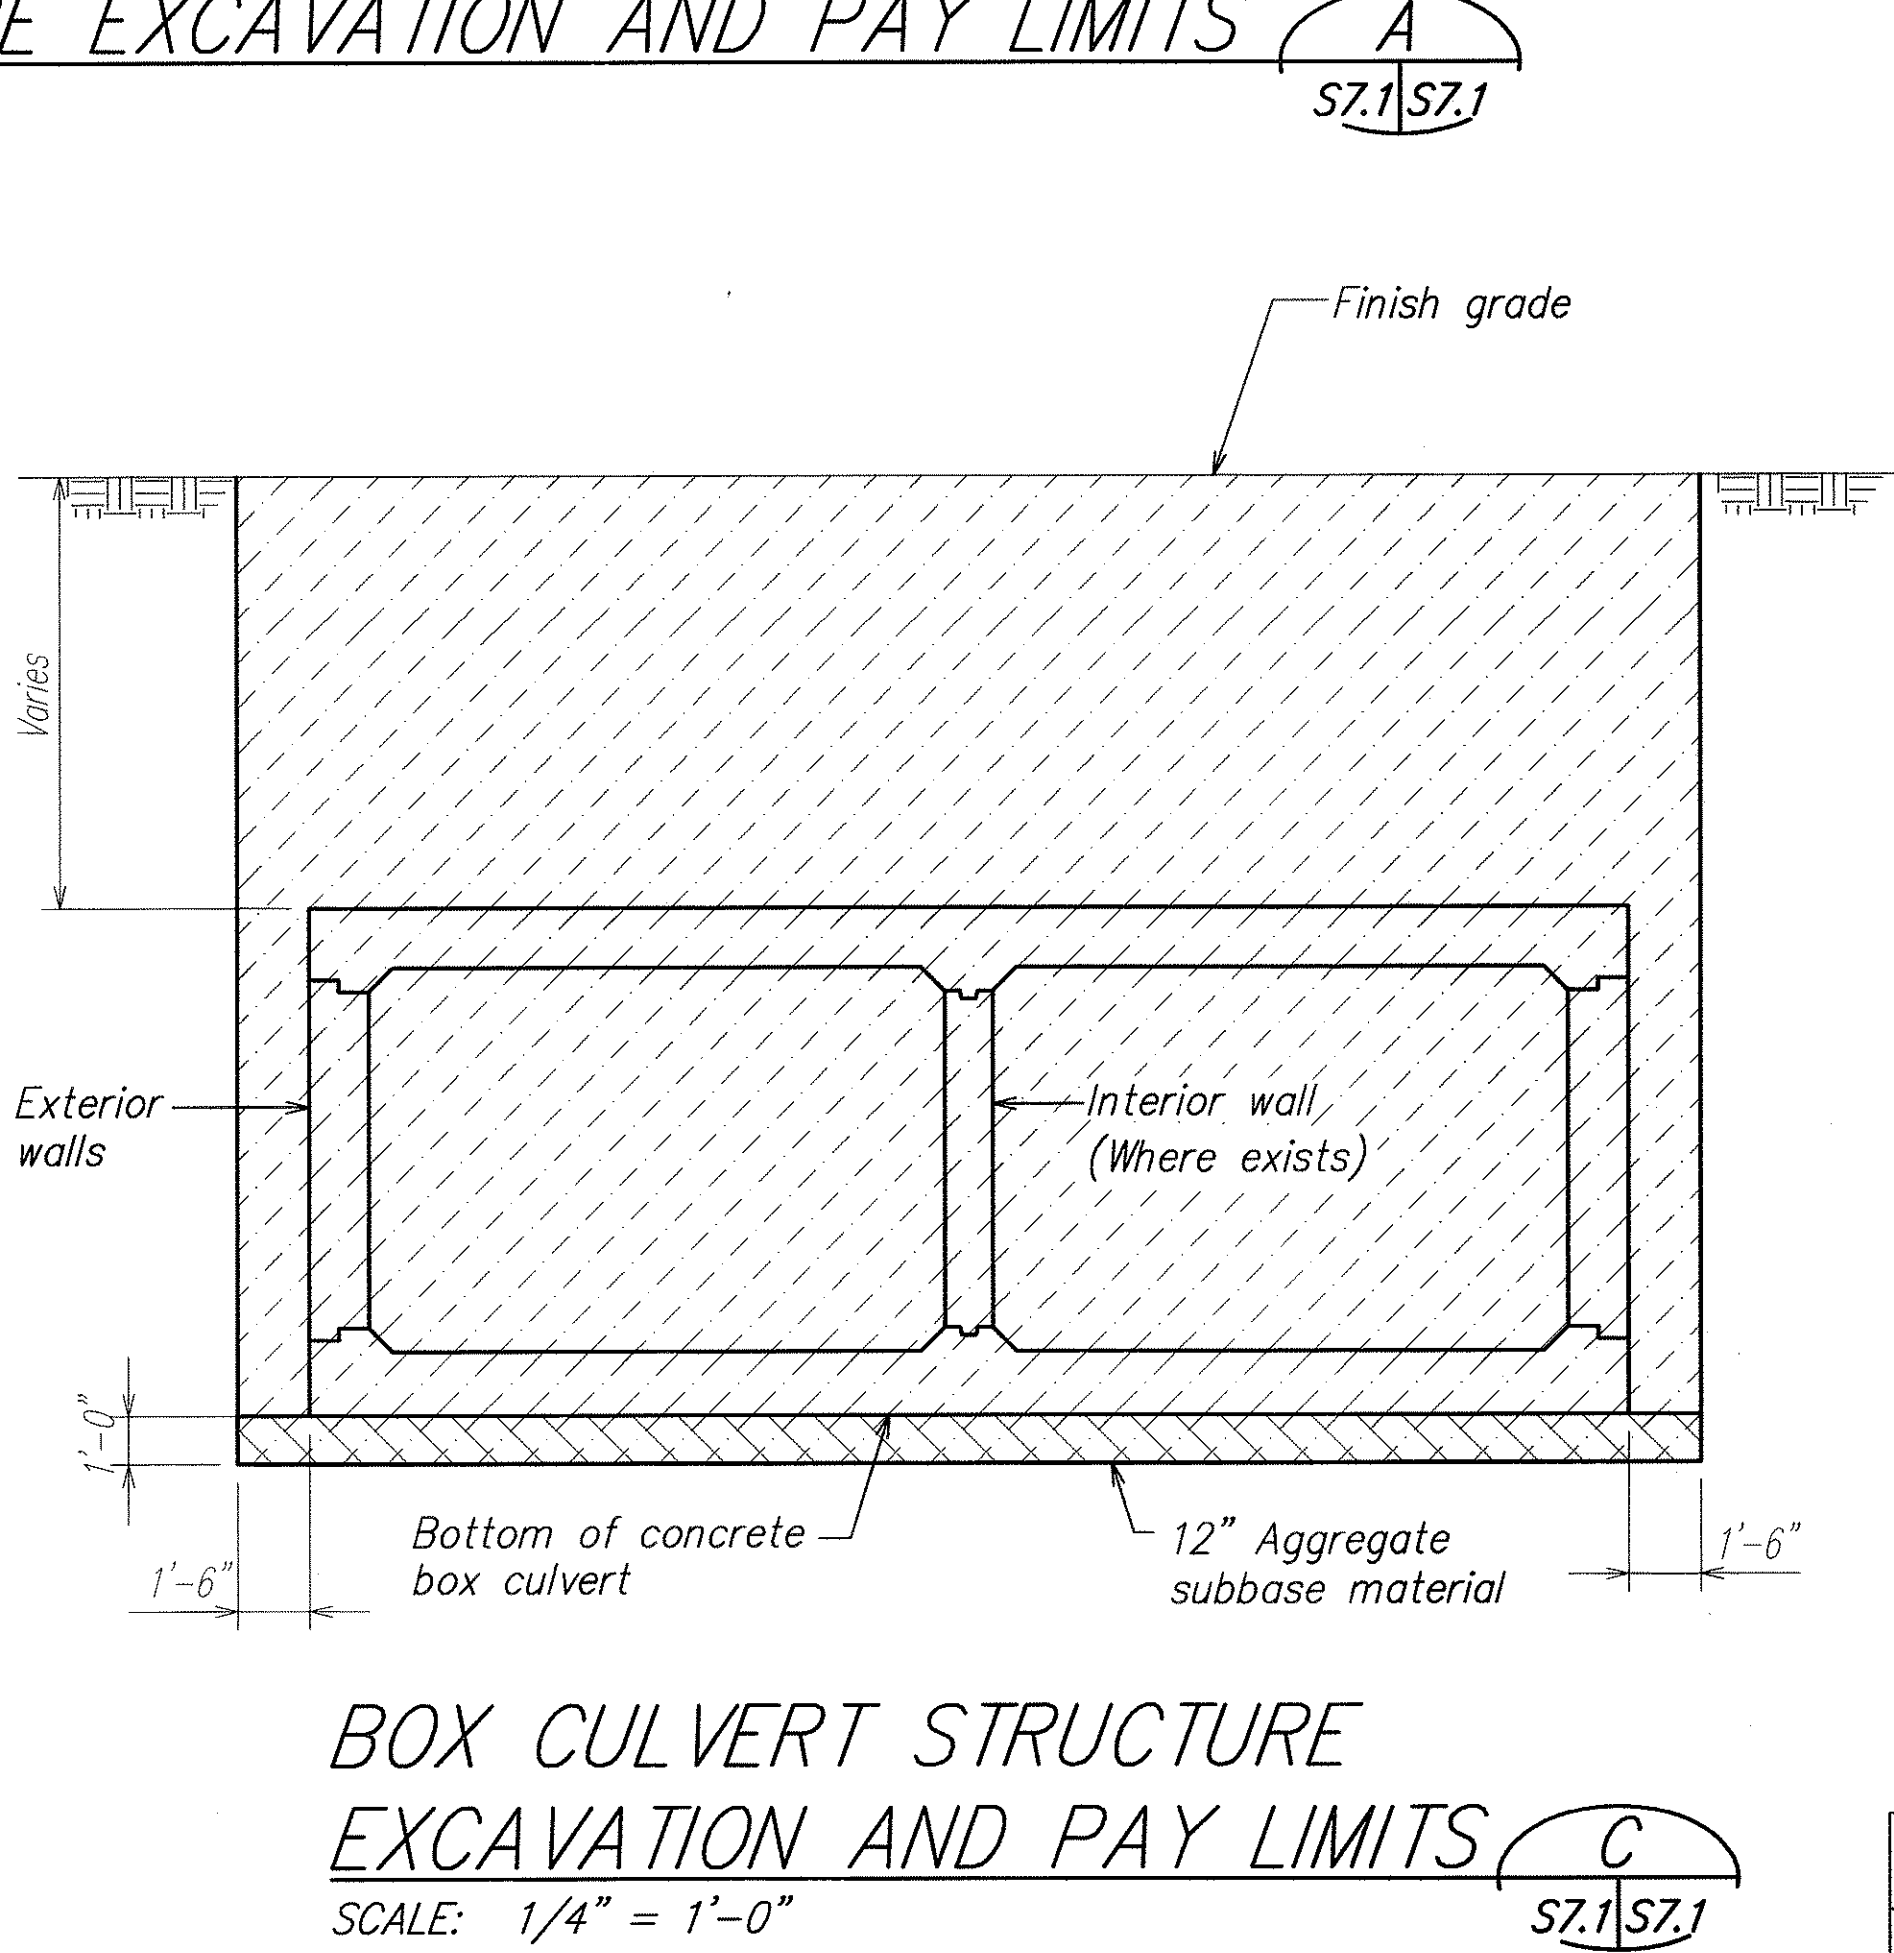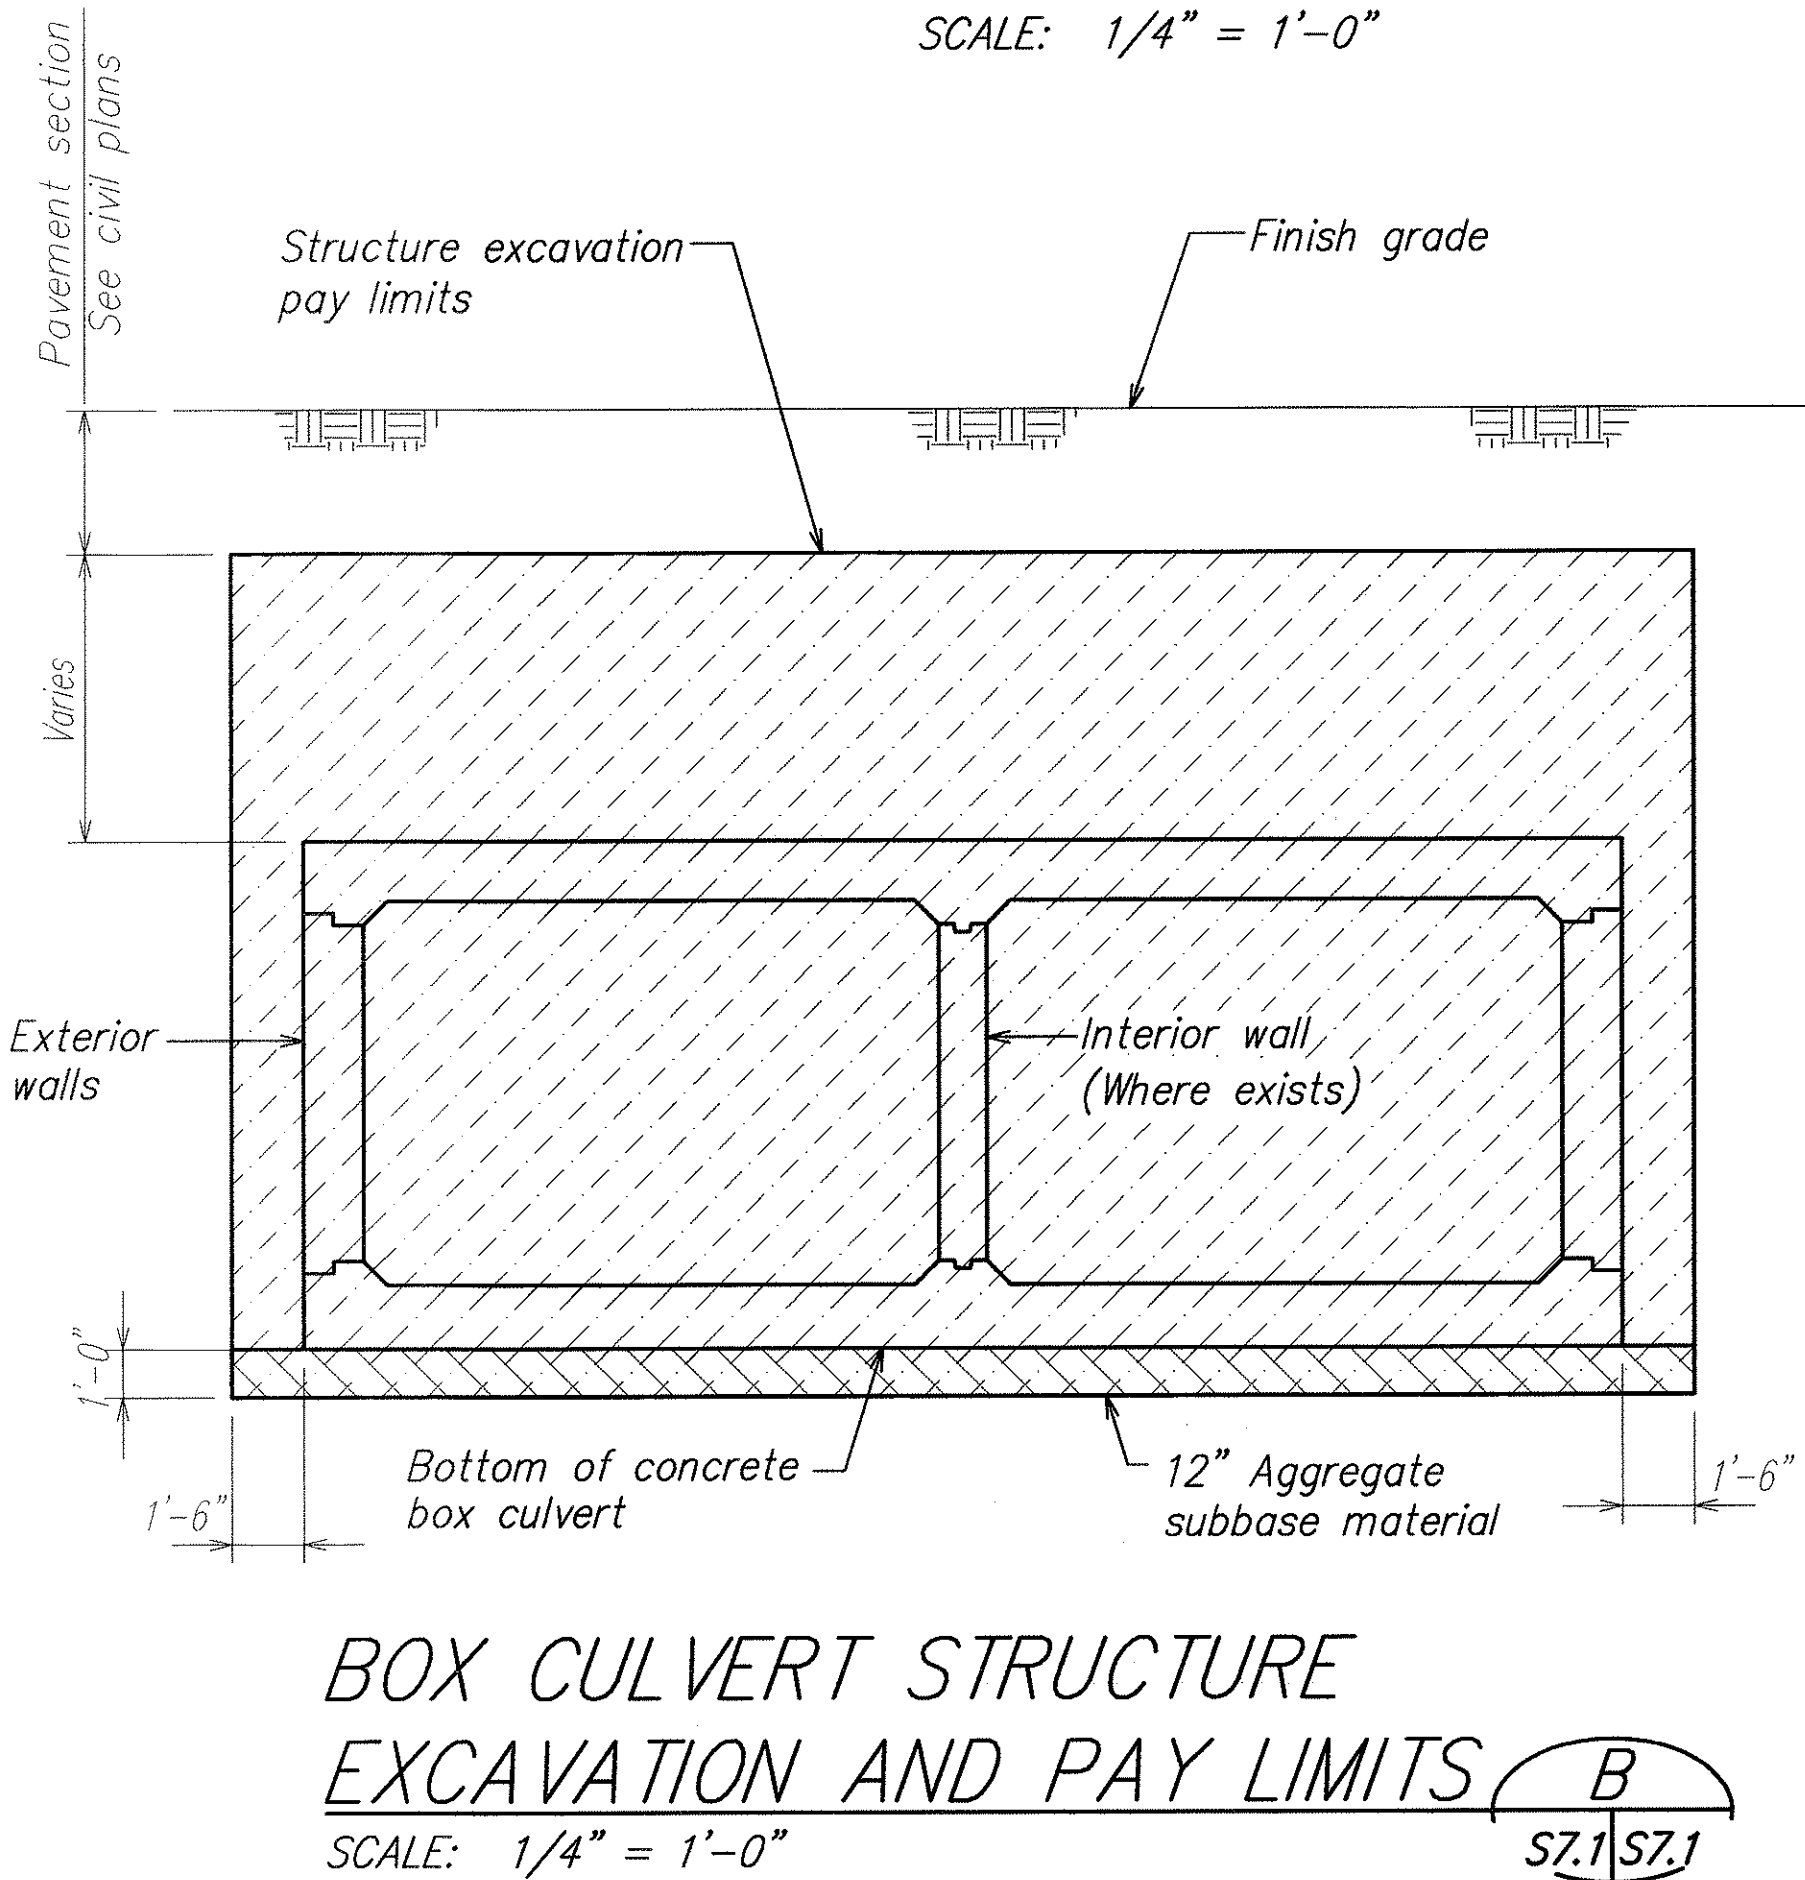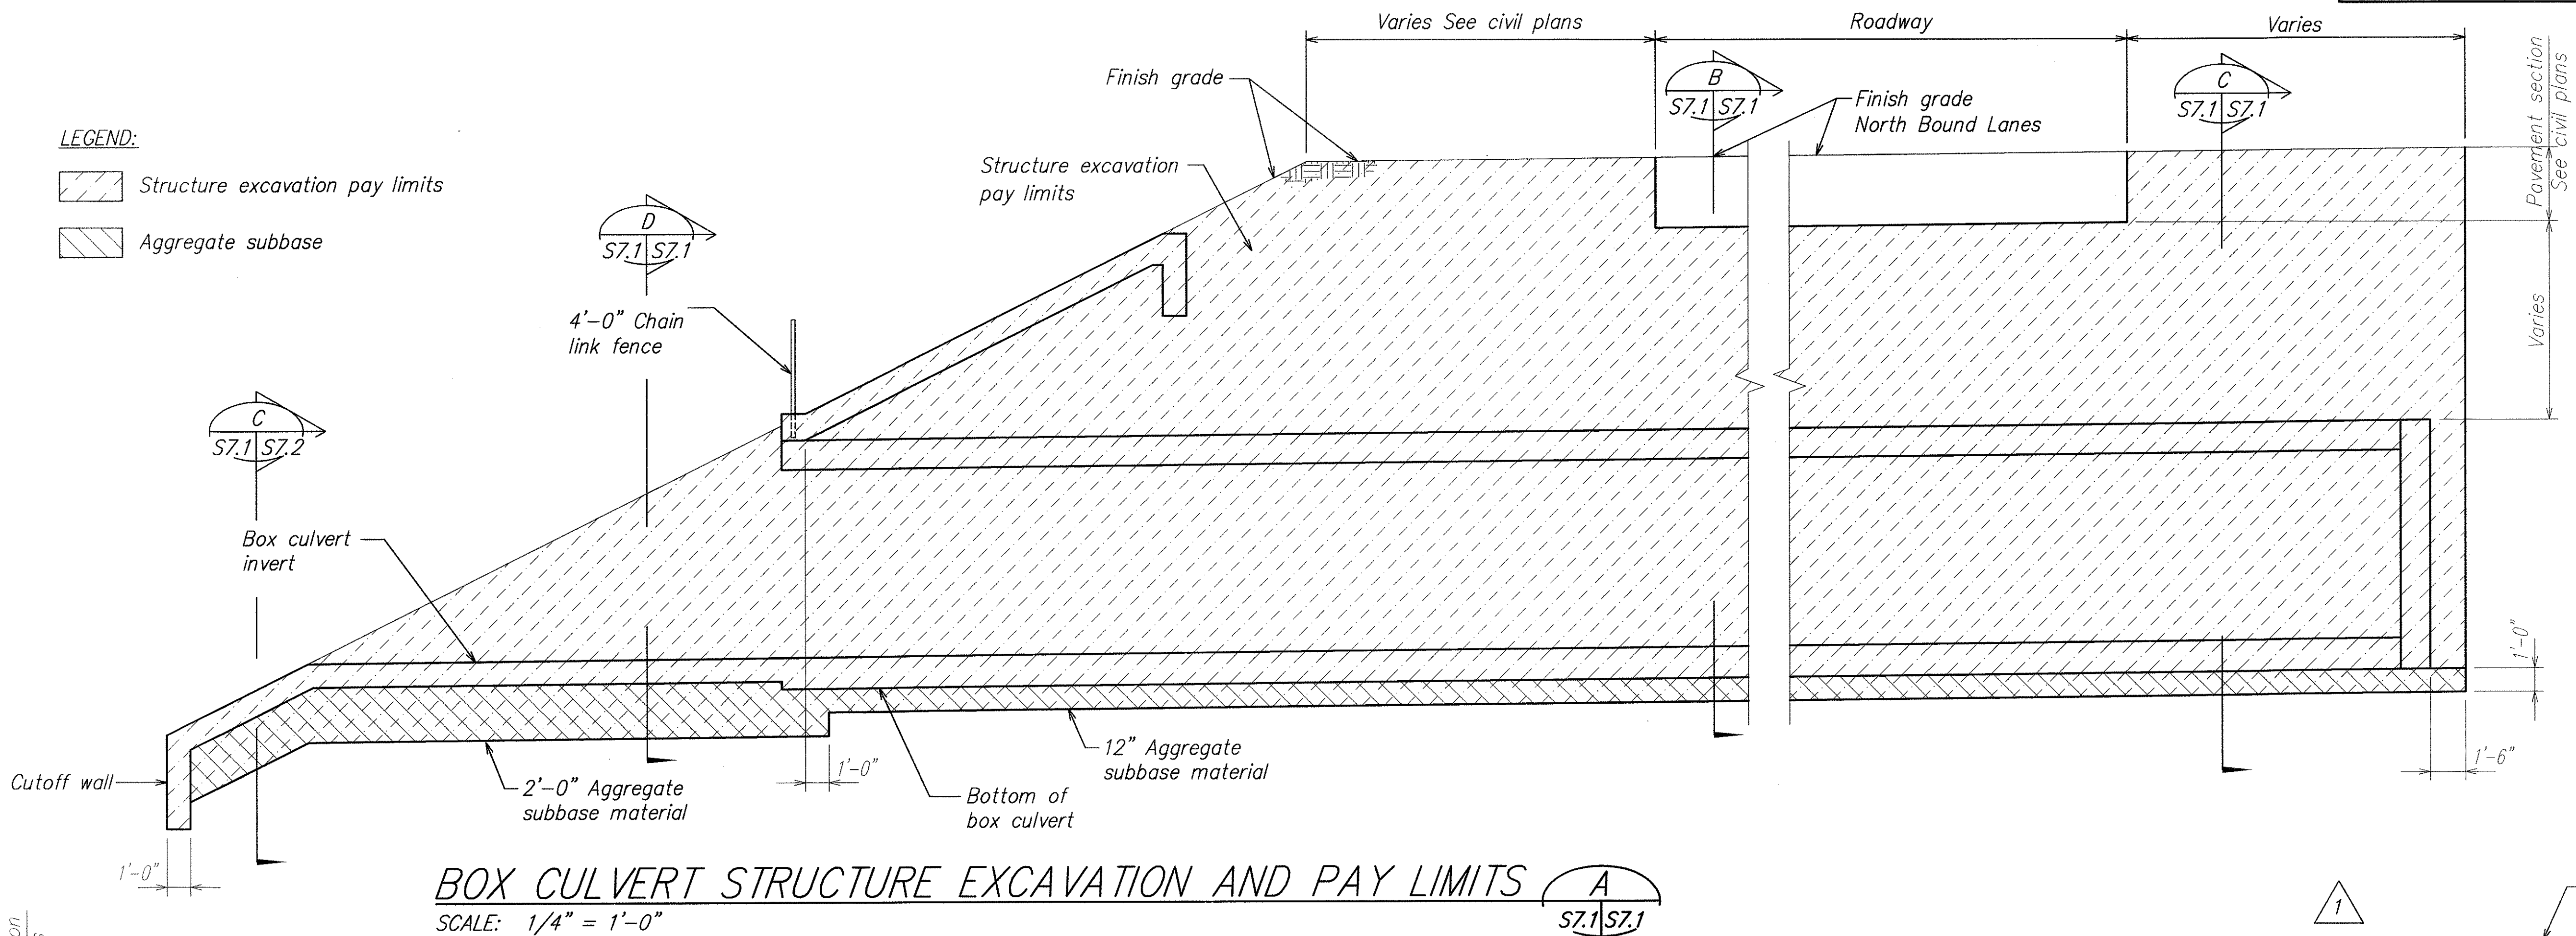

THIS WORK WAS PREPARED BY ME OR UNDER MY SUPERVISION.

David K. Fujiwara 4-30-08
SIGNATURE EXPIRATION DATE OF THE LICENSE

1/18/05	1	Clarified Detail
DATE	REVISION	

STATE OF HAWAII
DEPARTMENT OF TRANSPORTATION
HIGHWAYS DIVISION

**BOX CULVERT OULET
EXCAVATION AND PAY LIMITS**


North-South Road
Phase 1A
F.A.I. Proj. No. STP-8930(1)

Scale: As Noted Date: Dec. 22, 2004


SHEET No. S7.1 OF 43 SHEETS

ORIGINAL PLAN	SURVEY PLOTTED BY	DATE
NOTE BOOK	DRAWN BY	
No.	DESIGNED BY	
	CHECKED BY	


FED. ROAD DIST. NO.	STATE	FED. AID PROJ. NO.	FISCAL YEAR	SHEET NO.	TOTAL SHEETS
HAWAII	HAW.	STP-8930(1)	2005	ADD. 107	144

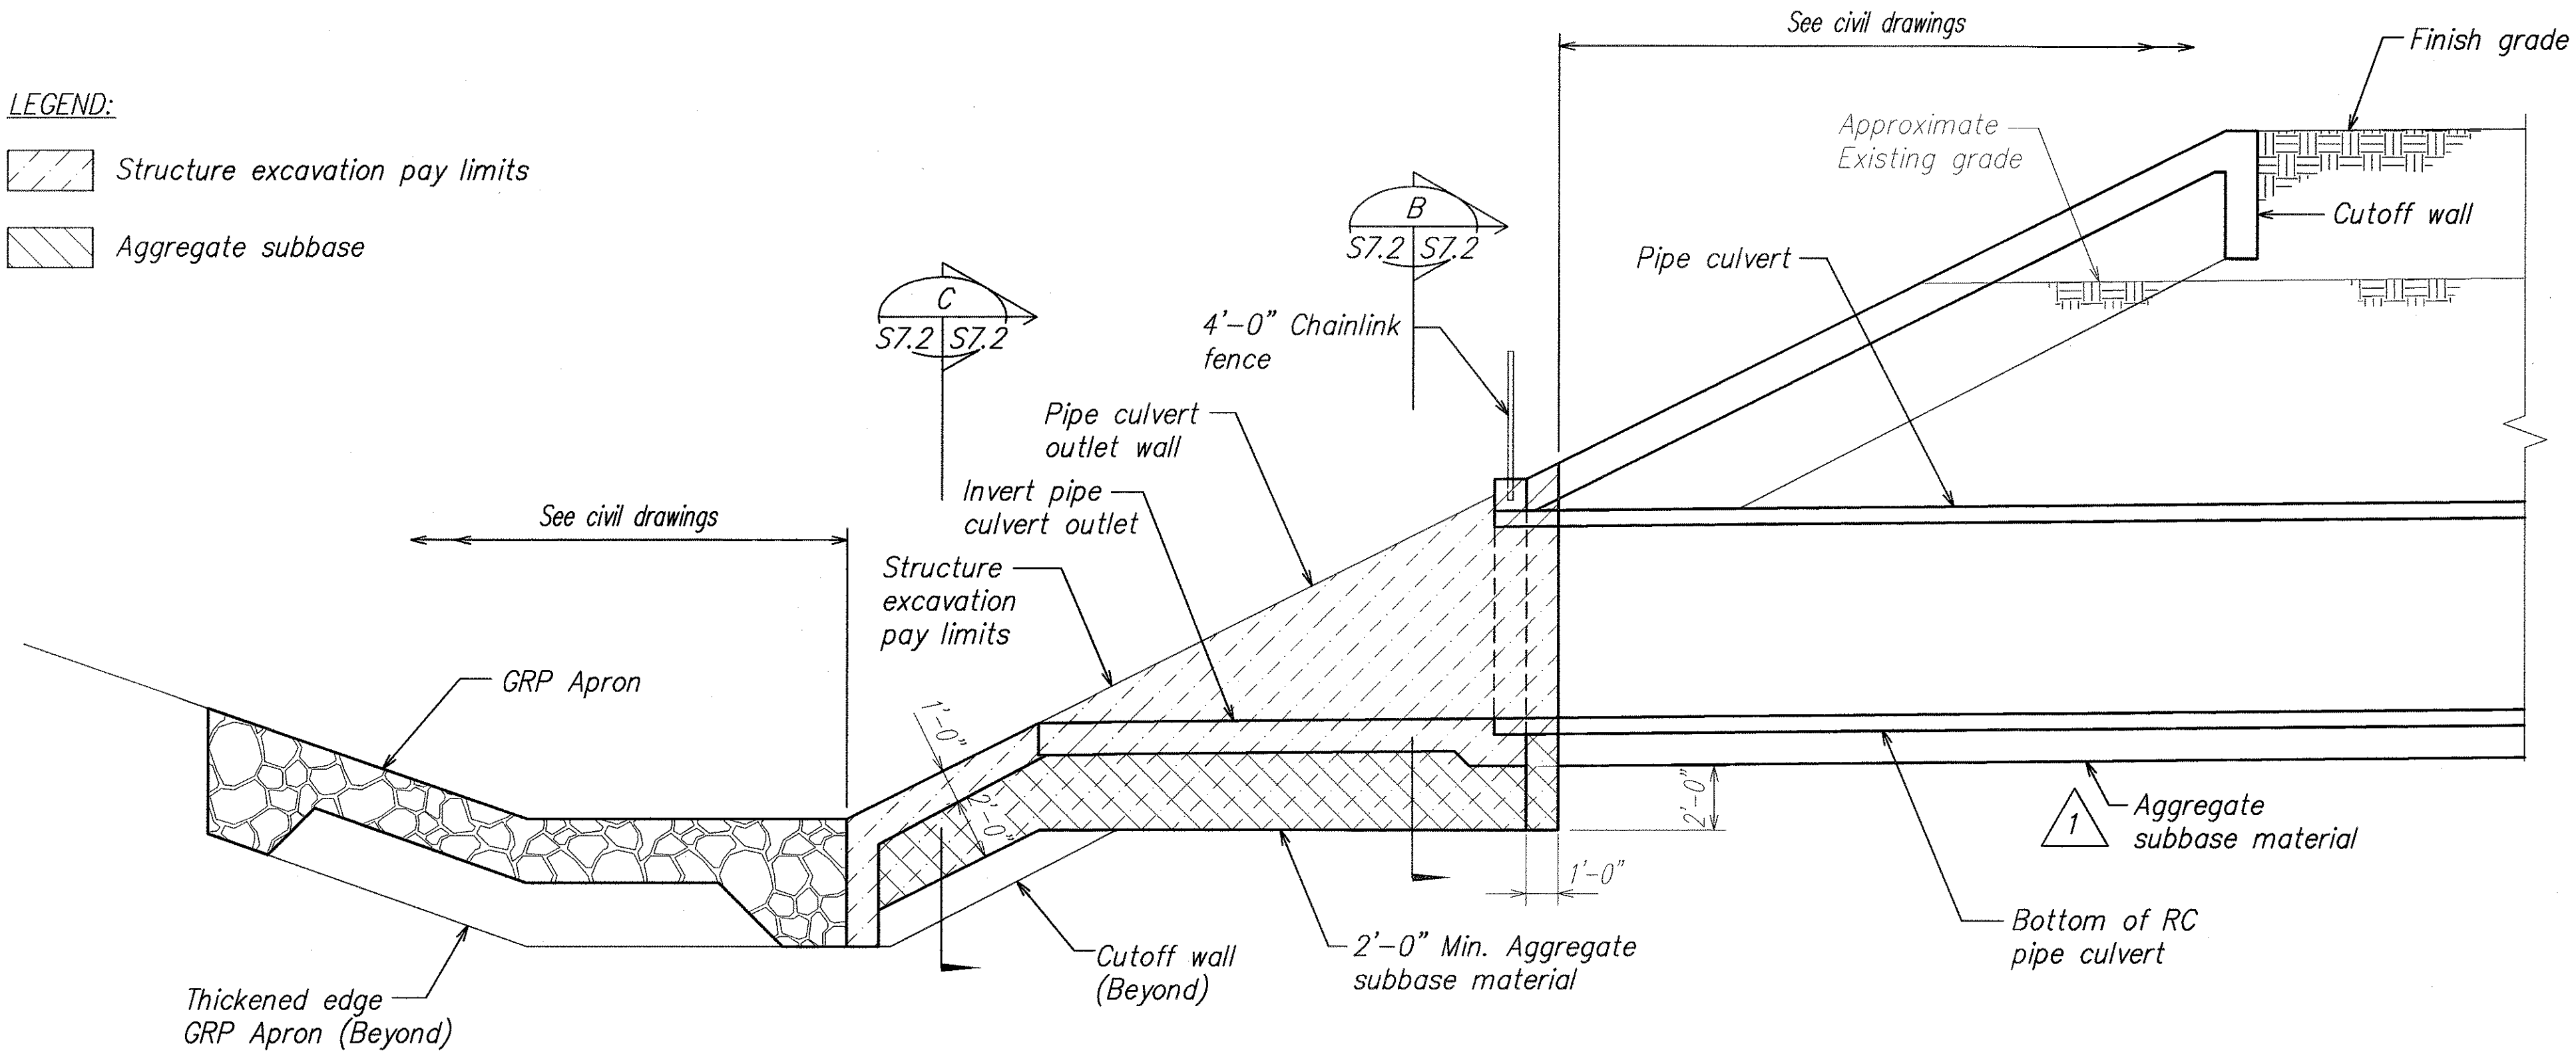


RC PIPE CULVERT OUTLET EXCAVATION AND PAY LIMITS A
SCALE: 1/4" = 1'-0" S7.2 S7.2

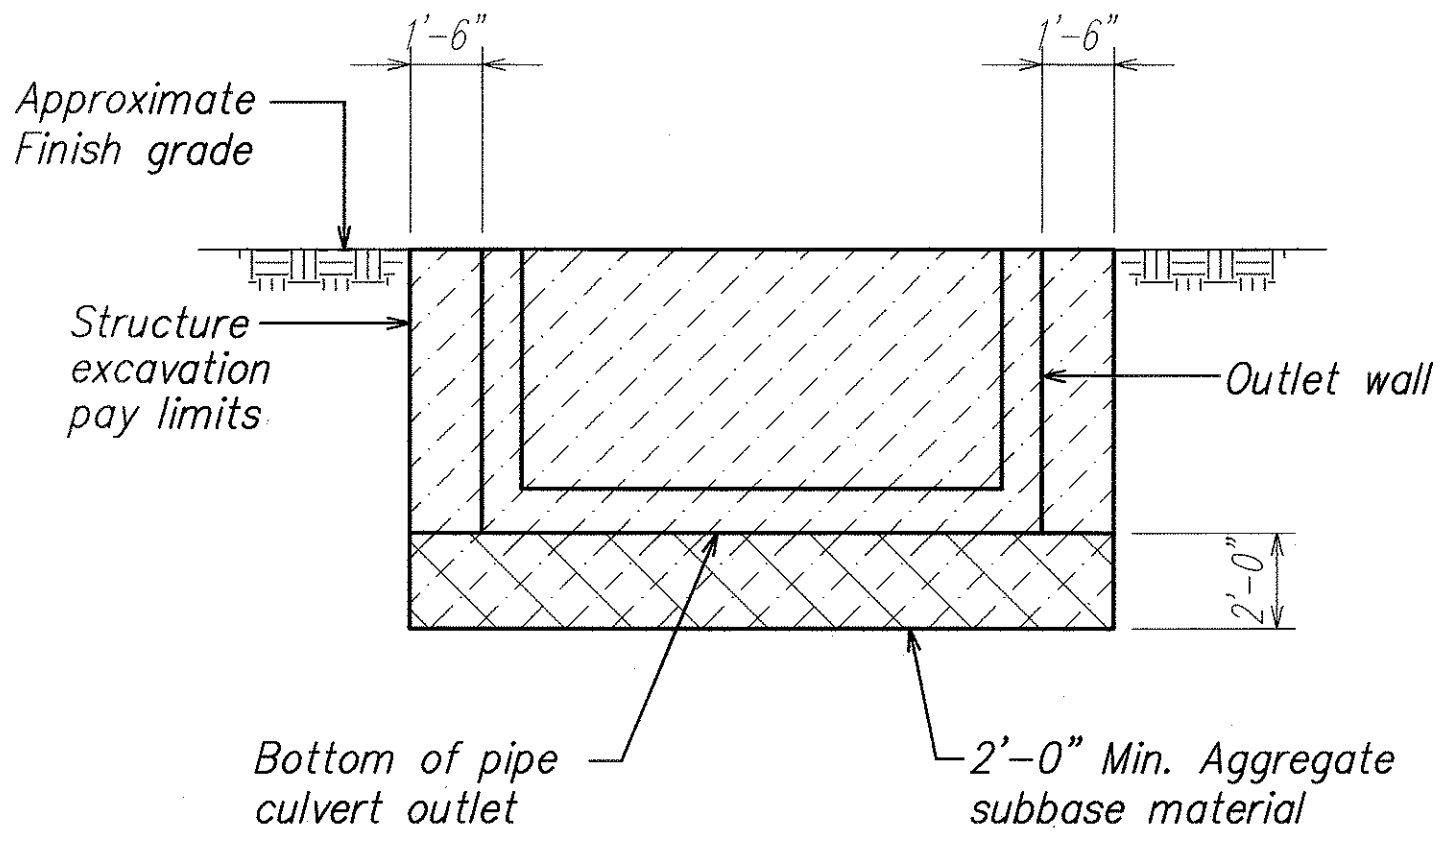

RC PIPE CULVERT OUTLET EXCAVATION AND PAY LIMITS B
SCALE: 1/4" = 1'-0" S7.2 S7.2

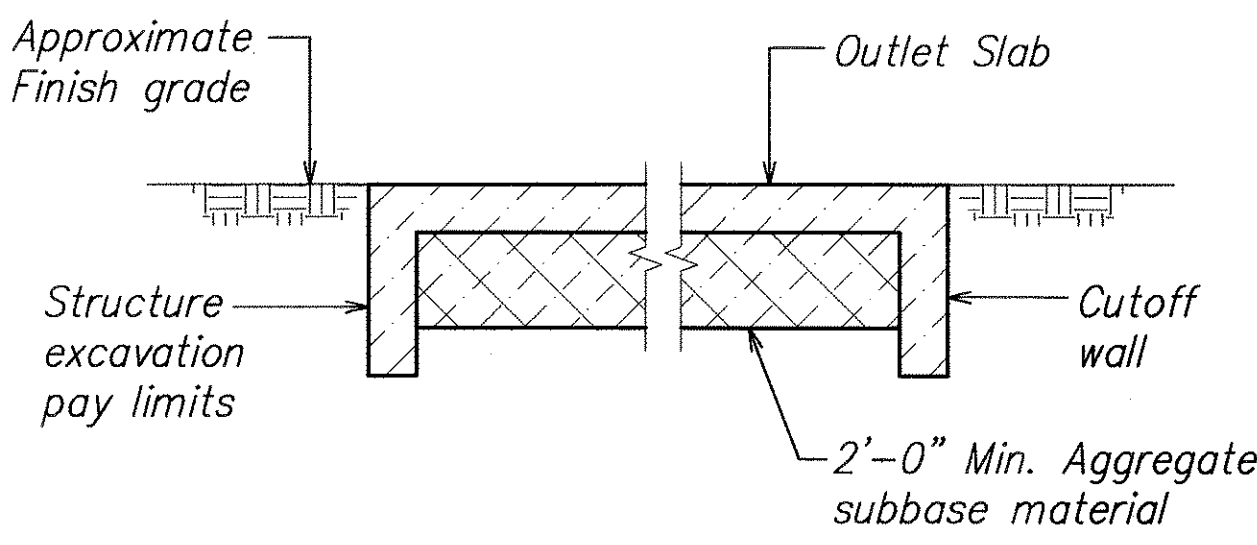

RC PIPE CULVERT OUTLET EXCAVATION AND PAY LIMITS C
SCALE: 1/4" = 1'-0" S7.1, S7.2 S7.2

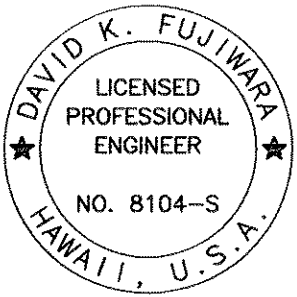

THIS WORK WAS PREPARED BY ME OR UNDER MY SUPERVISION.
David K. Fujimura
SIGNATURE EXPIRATION DATE OF THE LICENSE 4-30-06

STATE OF HAWAII
DEPARTMENT OF TRANSPORTATION
HIGHWAYS DIVISION

RC PIPE CULVERT OUTLET
EXCAVATION AND PAY LIMITS
North-South Road
Phase 1A
F.A.I. Proj. No. STP-8930(1)

1/18/05
DATE

1 Clarified Detail
REVISION

Scale: As Noted
Date: Dec. 22, 2004

SHEET No. S7.2 OF 43 SHEETS


ORIGINAL PLAN
NOTE BOOK
No.

SURVEY PLOTTED BY
DRAWN BY
DESIGNED BY
CHECKED BY


DATE

C:\X5\05\01-17-05 ADD\NS-S702 ADD.dwg, 1/17/2005 1:12:04 PM, K5fnc.pc3, 1:1


FED. ROAD DIST. NO.	STATE	FED. AID PROJ. NO.	FISCAL YEAR	SHEET NO.	TOTAL SHEETS
HAWAII	HAW.	STP-8930(1)	2005	ADD. 108	144

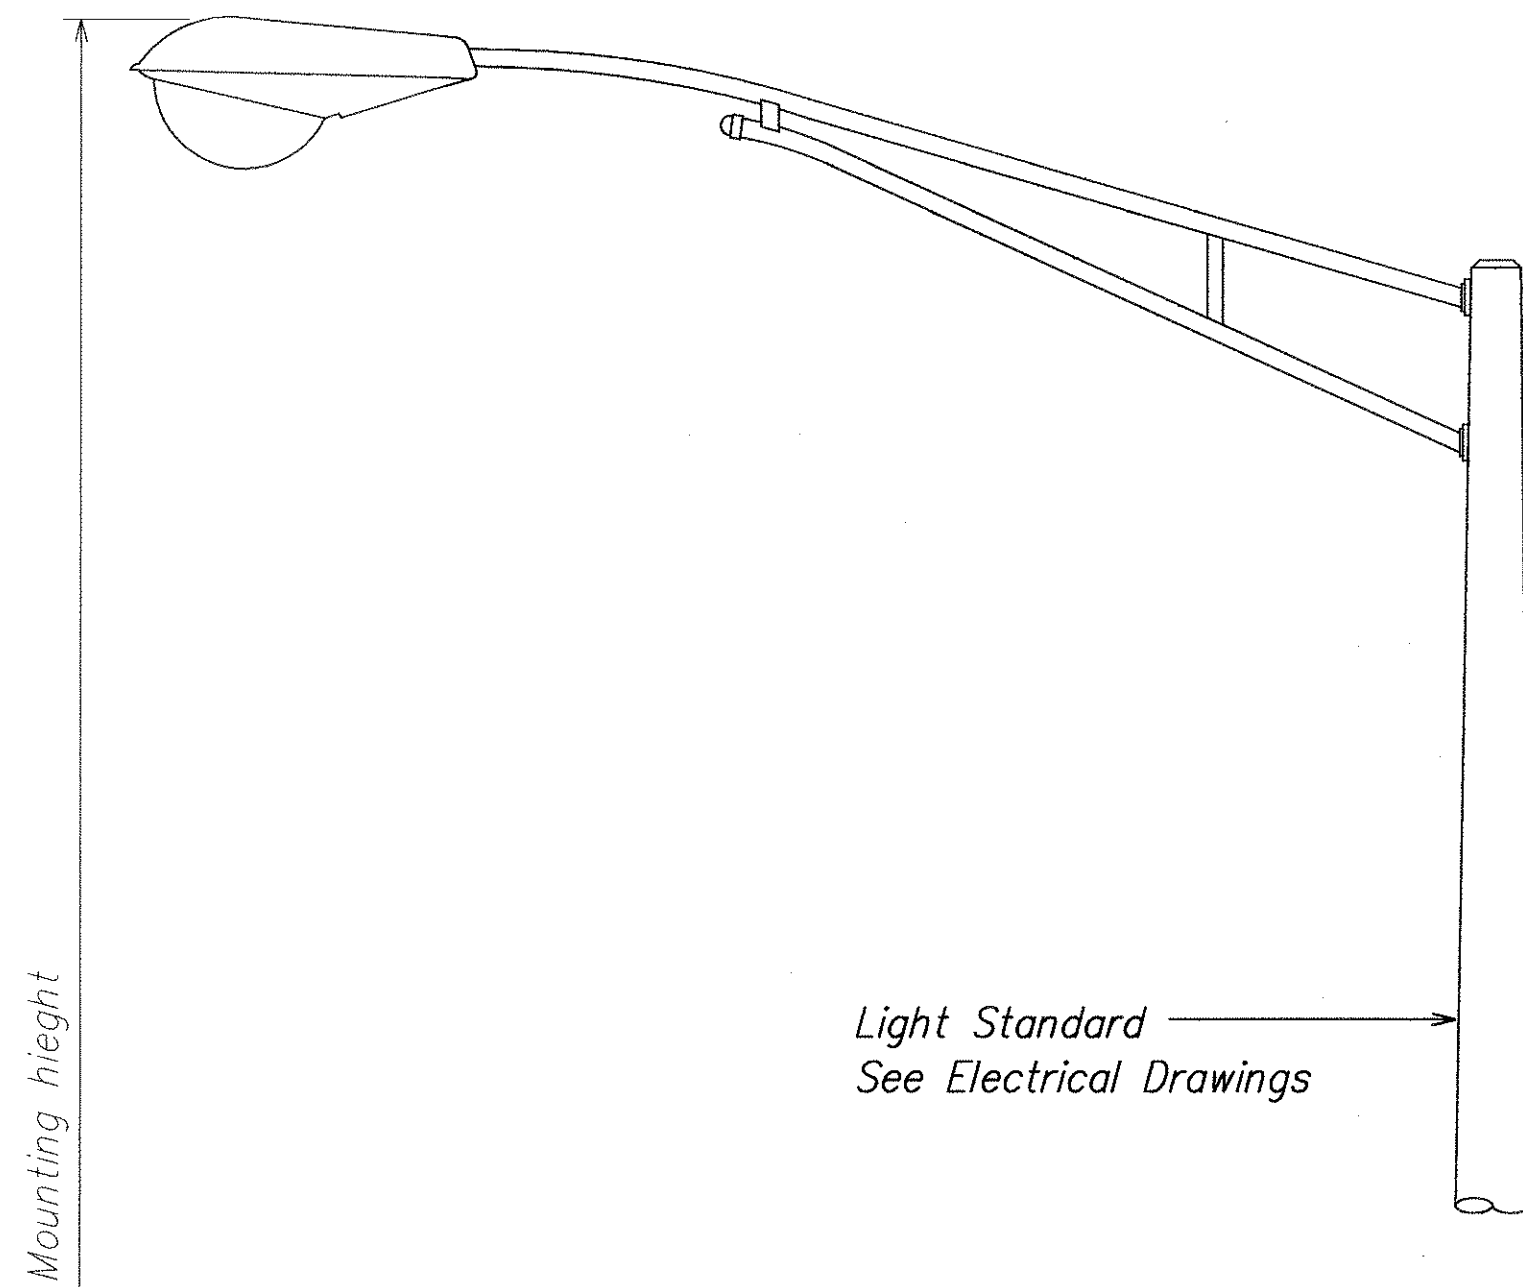


- Notes:
1. See electrical drawings for additional details.
 2. Pipe location may be on either side of light pole center line.
 3. When centerline of pipe is less than 6'-0" away from centerline of light pole and the clear distance is between the pipe and the drilled shaft is greater than 2'-0", see sections D/S8.1 & E/S8.1.
 4. When centerline of pipe is greater than 6'-0" away from centerline of light pole, see civil drawings for typical trench details.
 5. When clear distance between shaft and pipe is less than 2'-0", use 2-shaft foundation, see sheet S8.2.

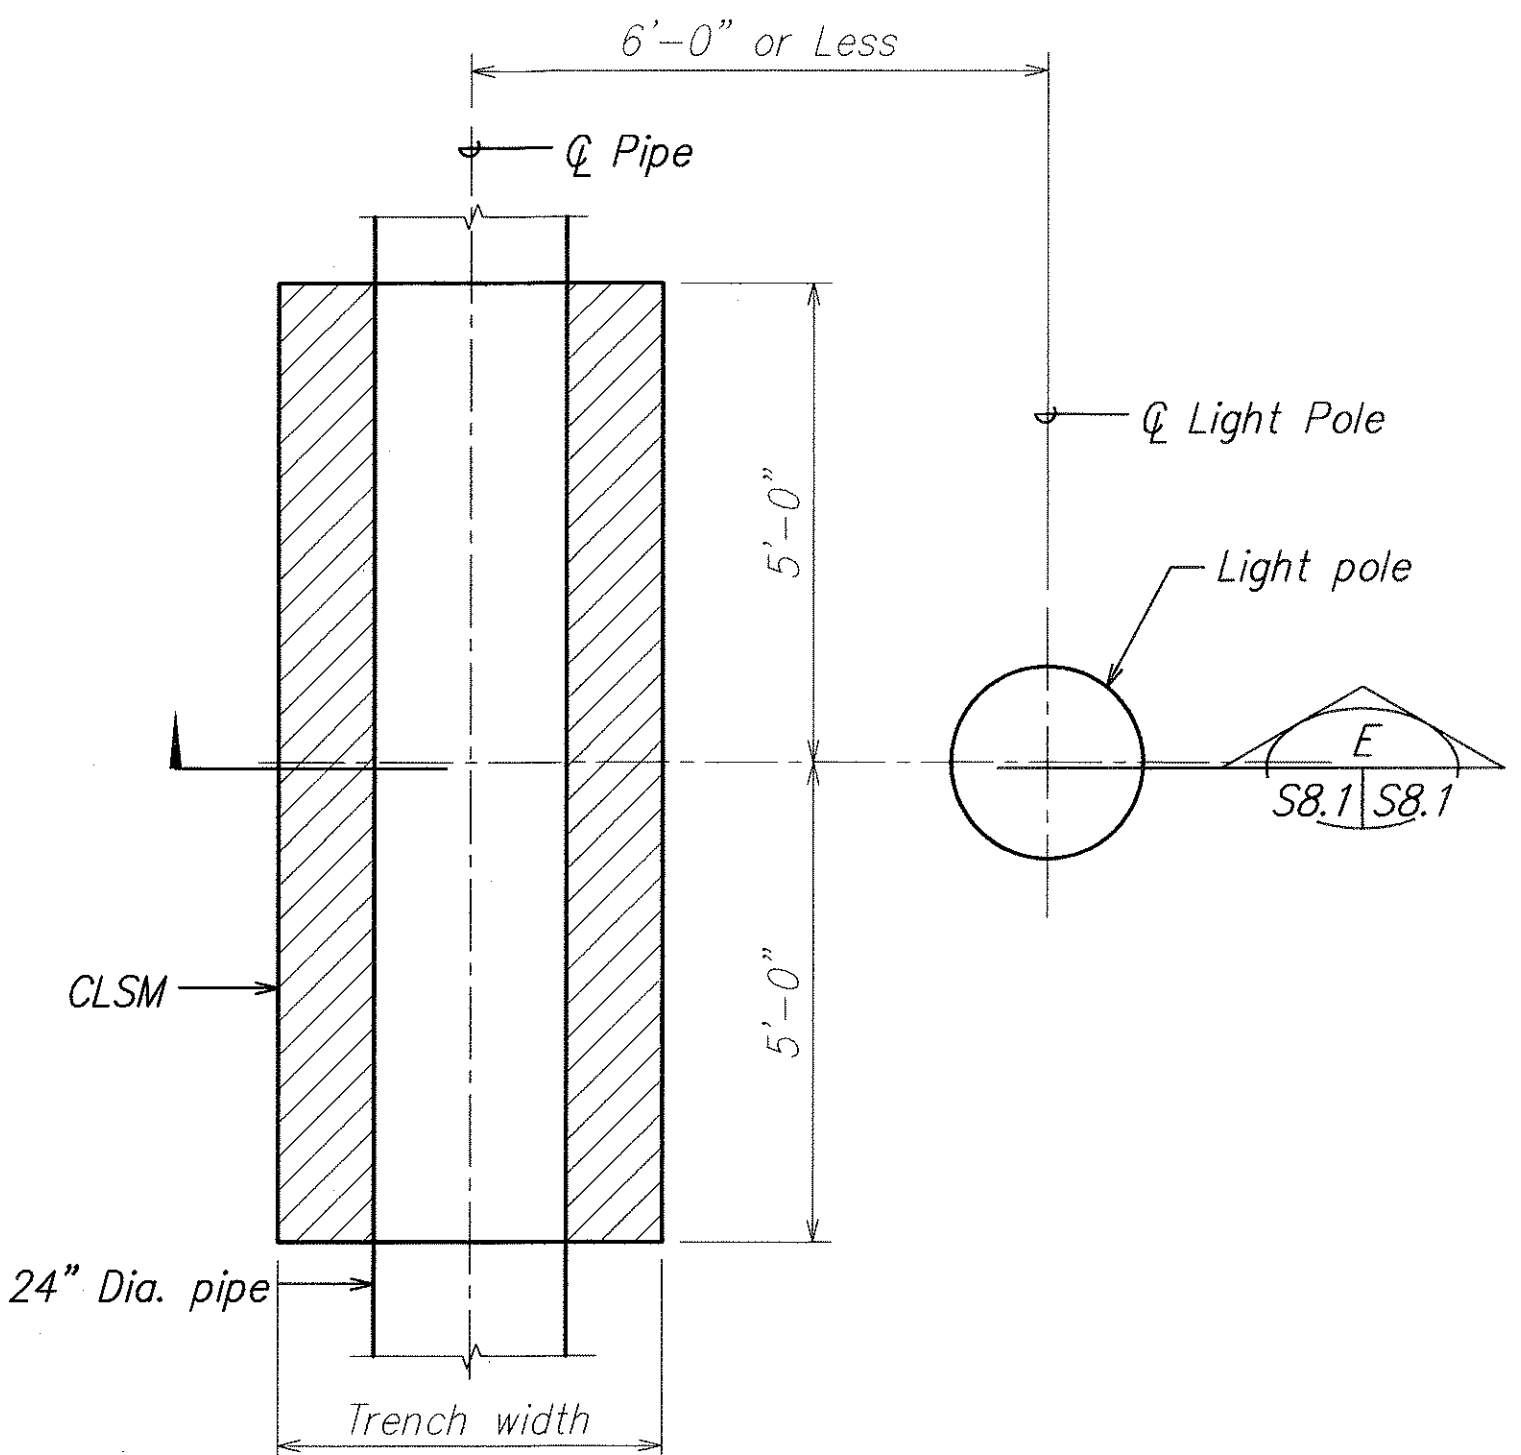


PLAN
SCALE: 1/2" = 1'-0" S8.1/S8.1

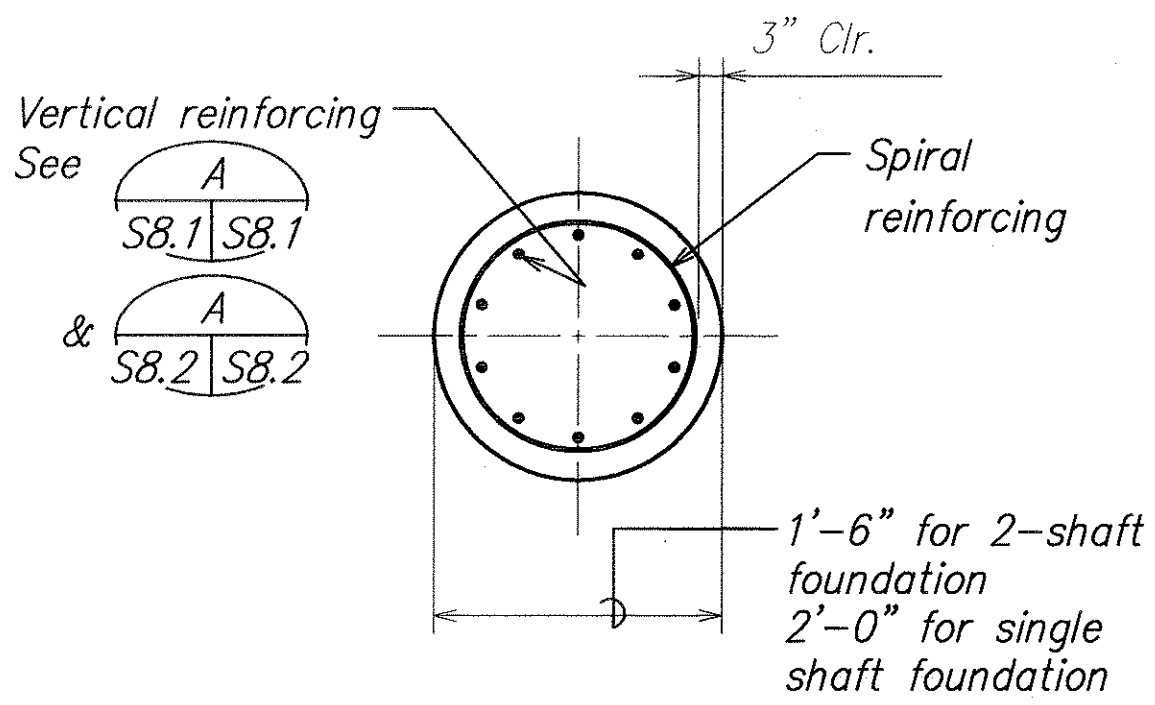


SECTION B
SCALE: 3/4" = 1'-0" S8.1/S8.1

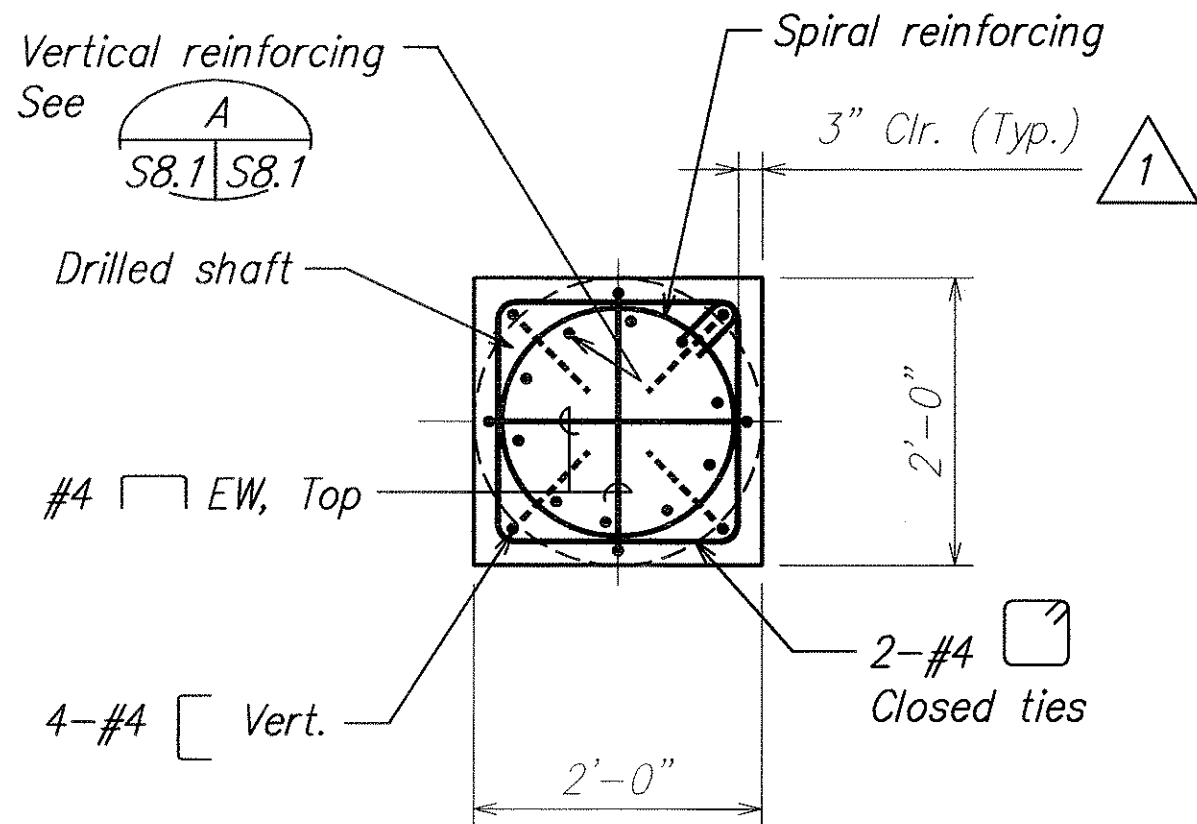


SECTION C
SCALE: 3/4" = 1'-0" S8.1/S8.1

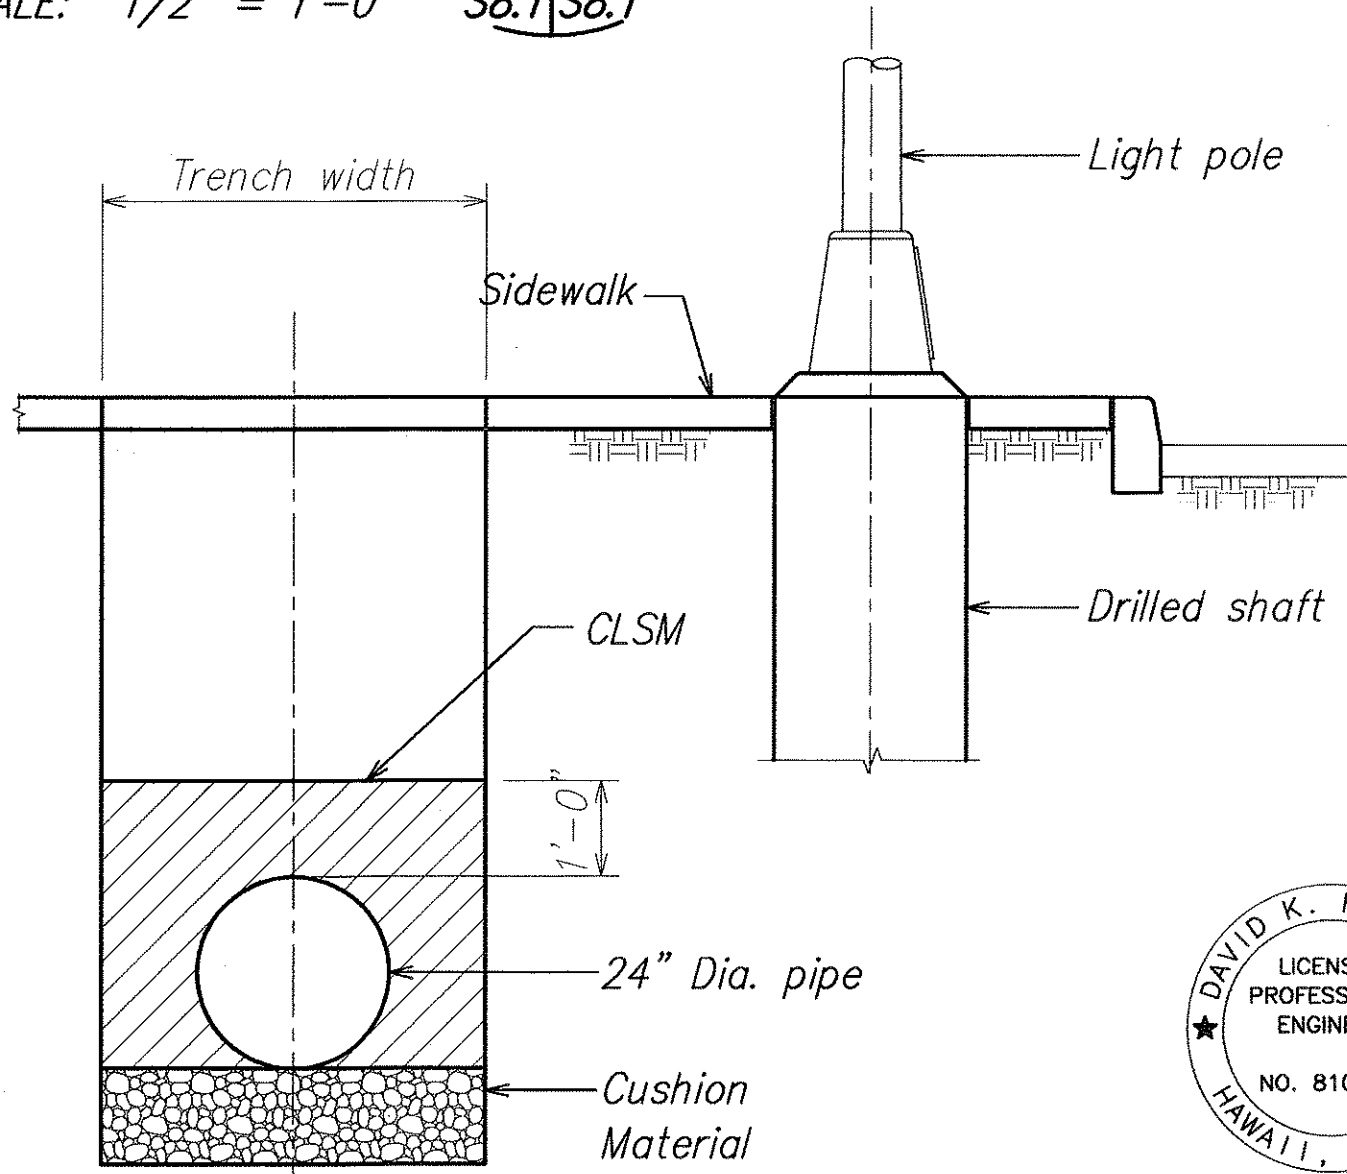

SECTION E
SCALE: 1/2" = 1'-0" S8.1/S8.1

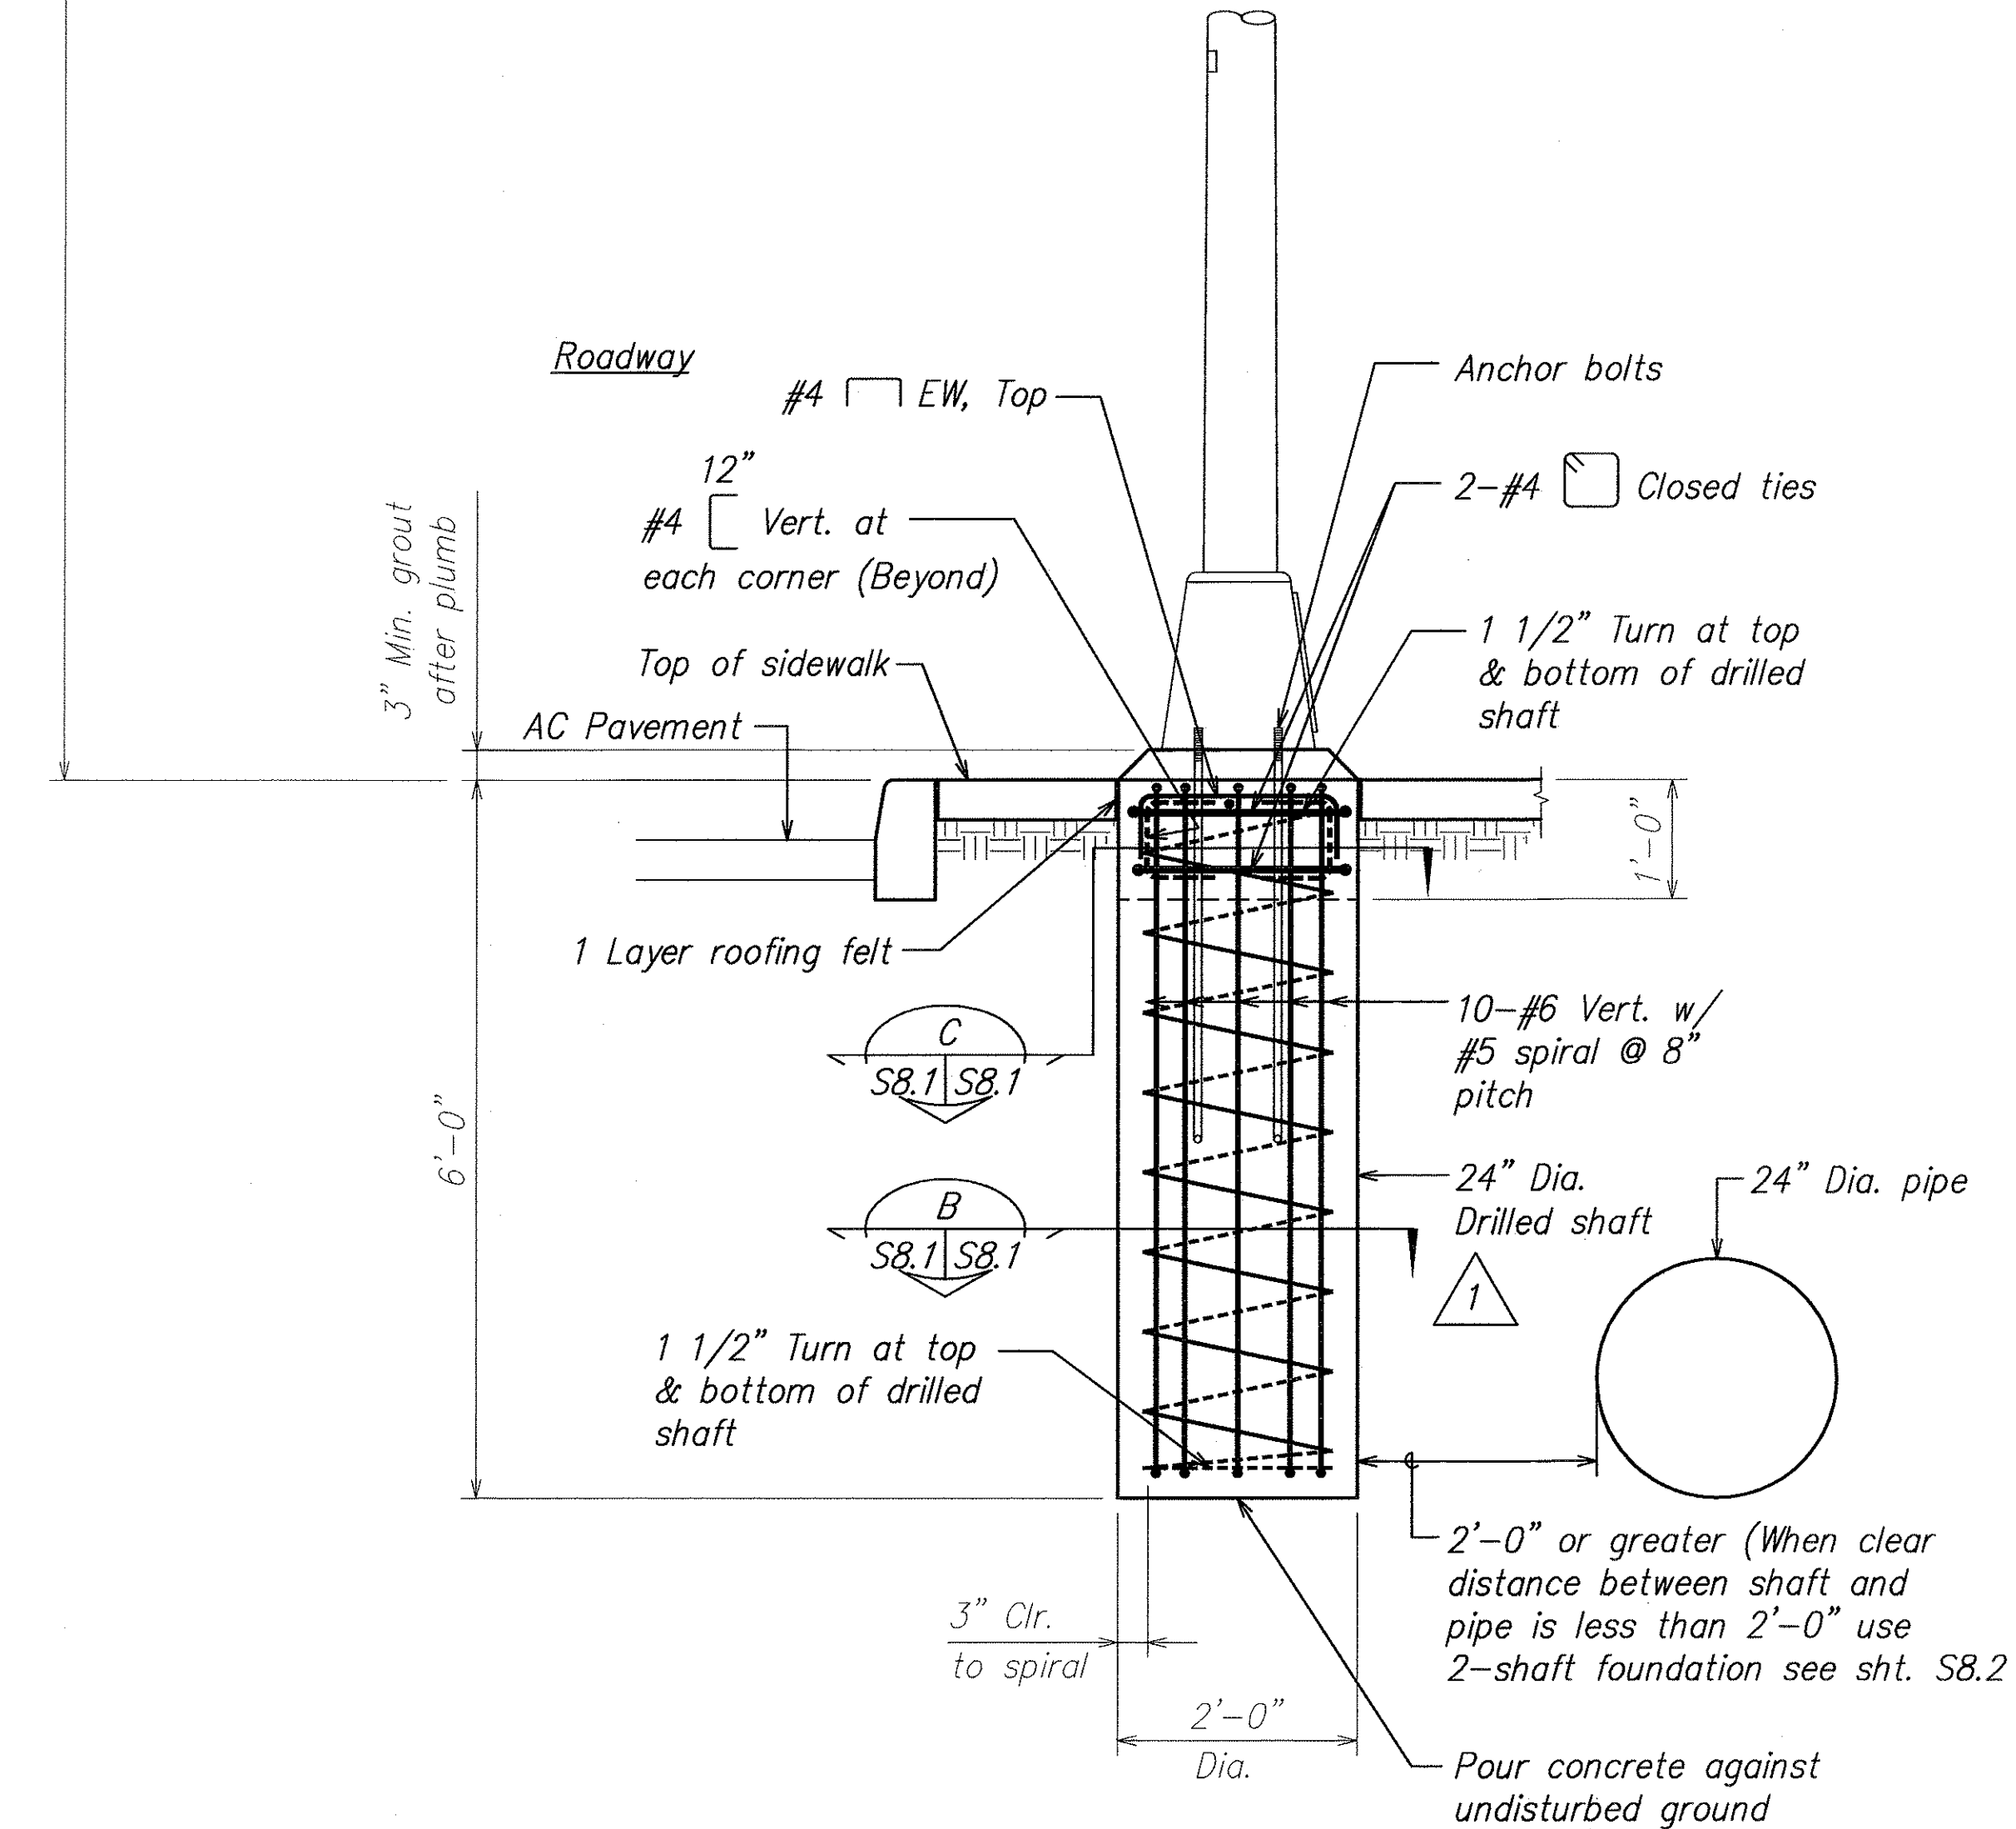

TYPICAL SINGLE SHAFT LIGHT POLE FOUNDATION
SCALE: 3/4" = 1'-0" S8.1/S8.1

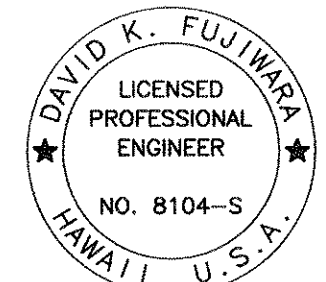

THIS WORK WAS PREPARED BY ME OR UNDER MY SUPERVISION.

Signature: David K. Fujiwara
EXPIRATION DATE OF THE LICENSE: 4-30-06


STATE OF HAWAII
DEPARTMENT OF TRANSPORTATION
HIGHWAYS DIVISION

TYPICAL LIGHT POLE FOUNDATION
North-South Road
Phase 1A
F.A.I. Proj. No. STP-8930(1)
Scale: As Noted
Date: Dec. 22, 2004


SHEET No. S8.1 OF 43 SHEETS

1/18/05	Clarification of Notes and Revised Dimension
DATE	REVISION


FED. ROAD DIST. NO.	STATE	FED. AID PROJ. NO.	FISCAL YEAR	SHEET NO.	TOTAL SHEETS
HAWAII	HAW.	STP-8930(1)	2005	ADD. 109	144

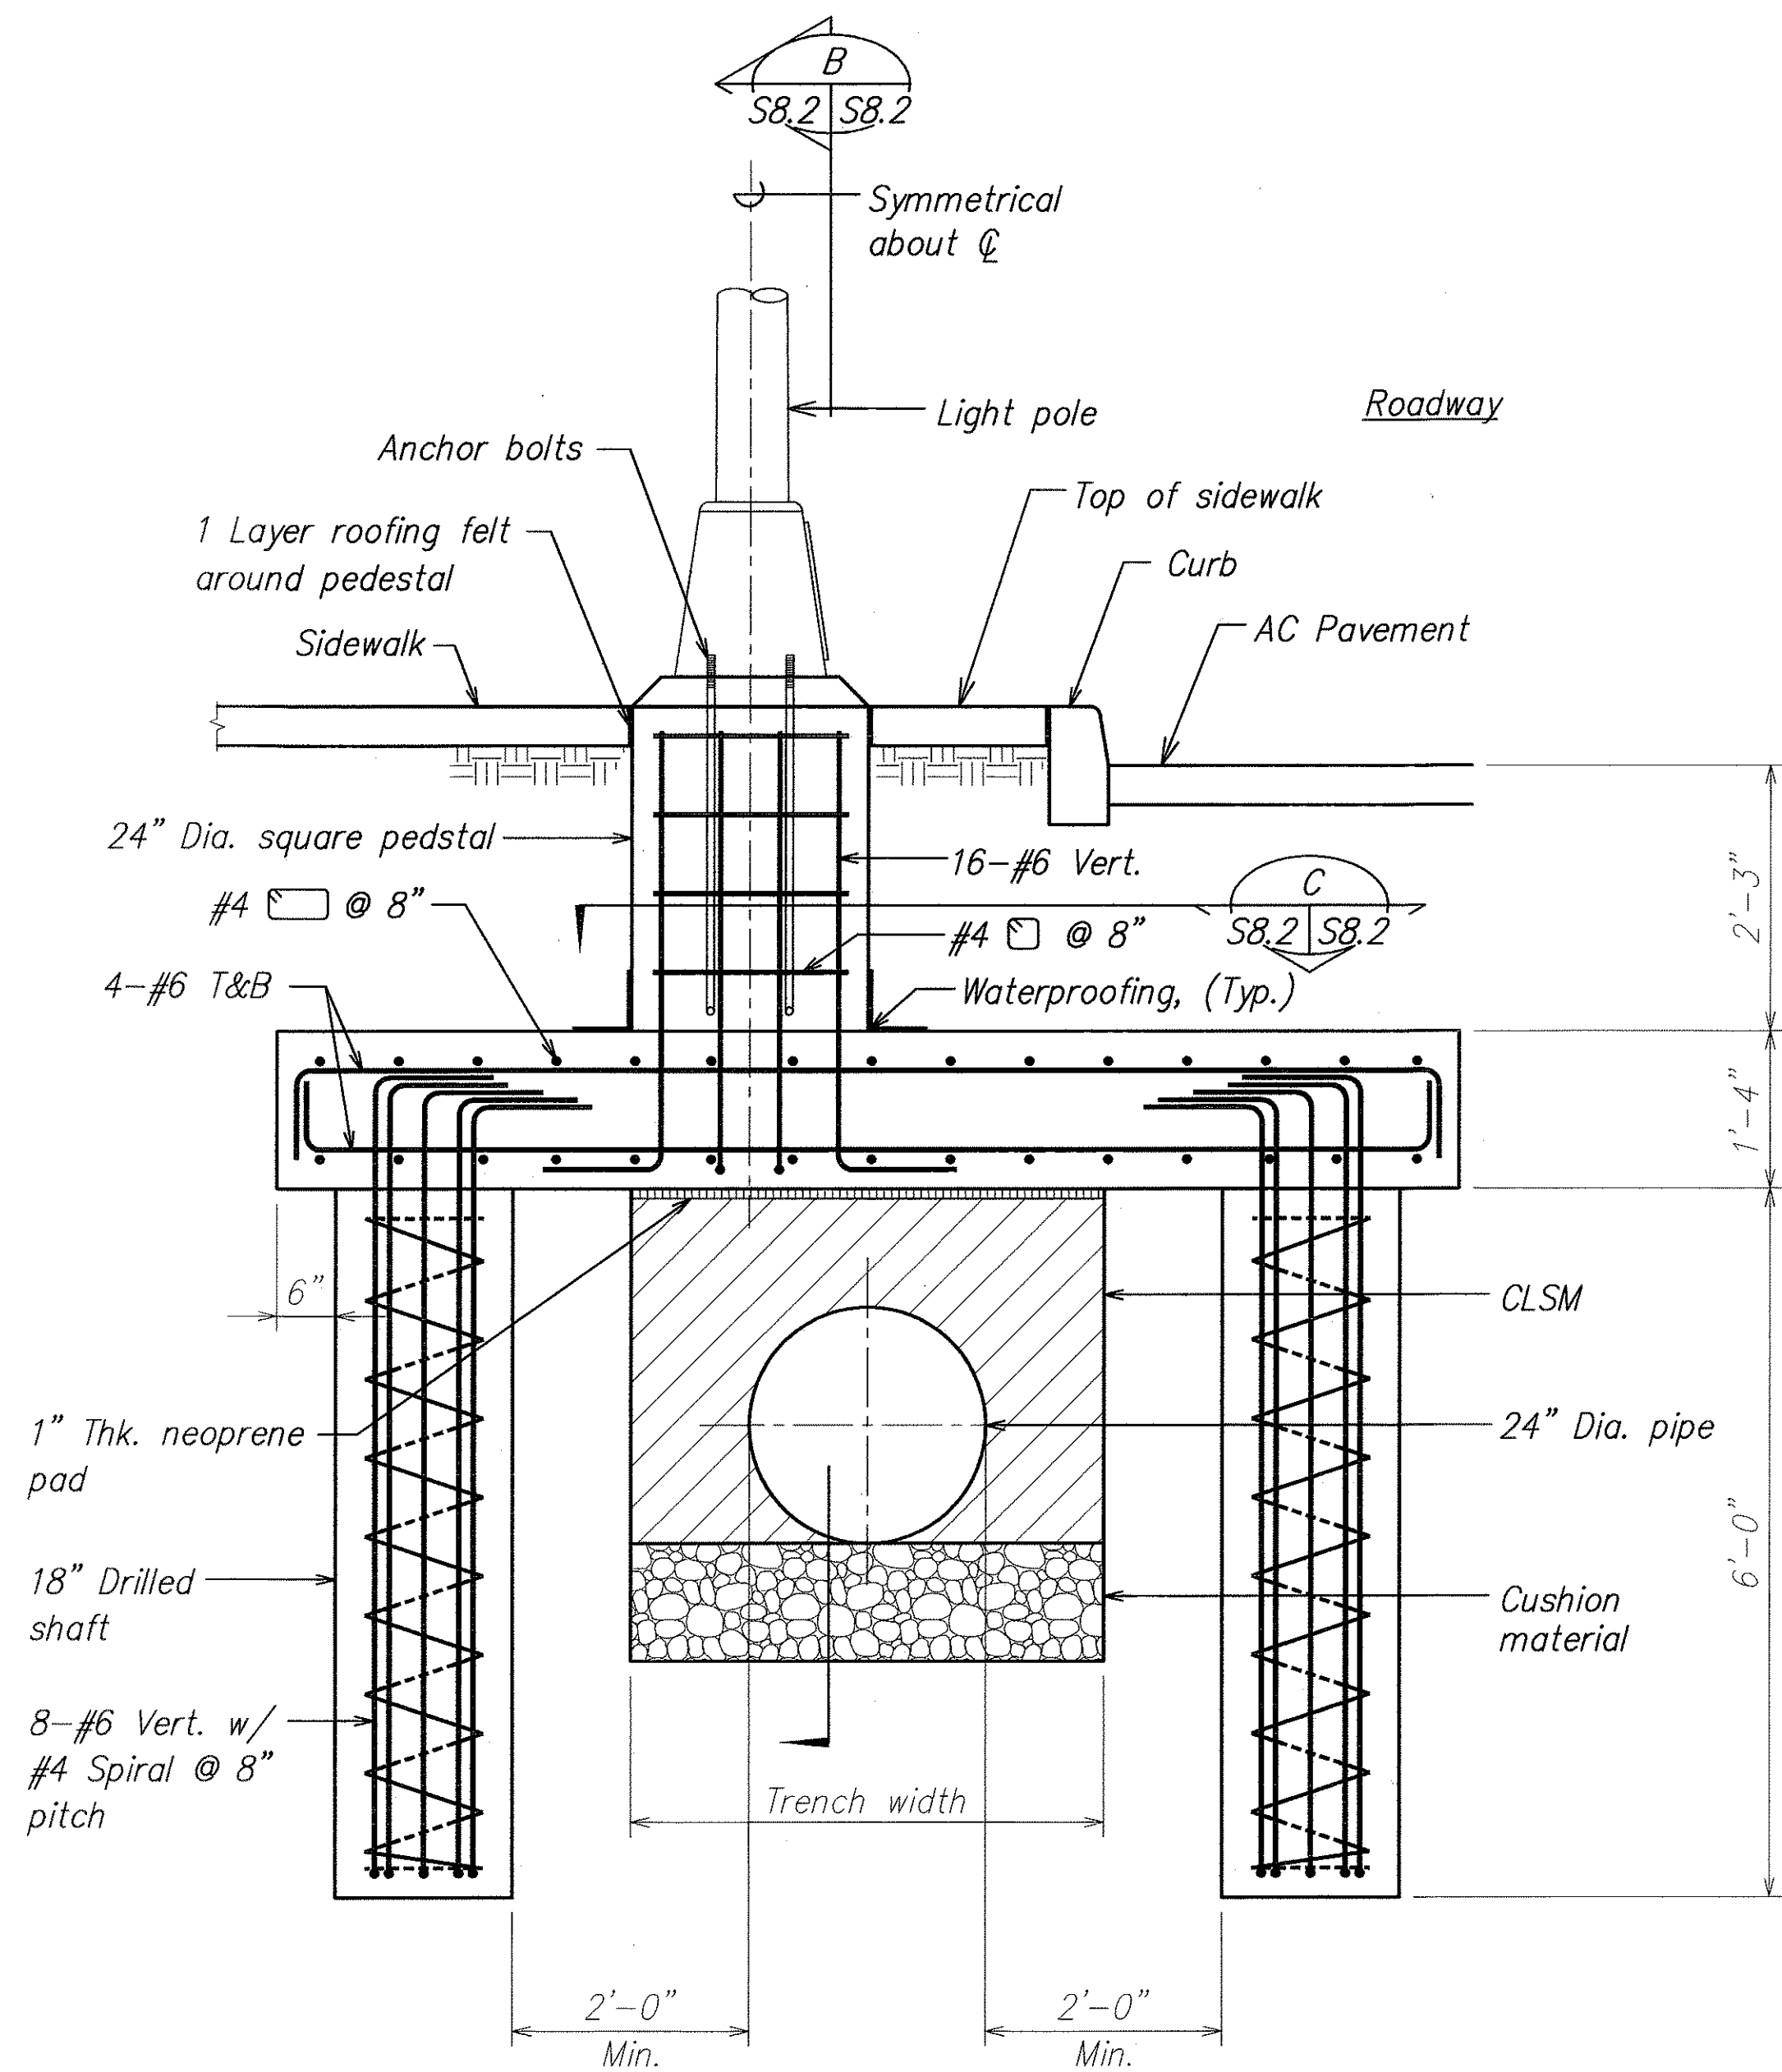


SECTION A
SCALE: 3/4" = 1'-0" S8.2 S8.2

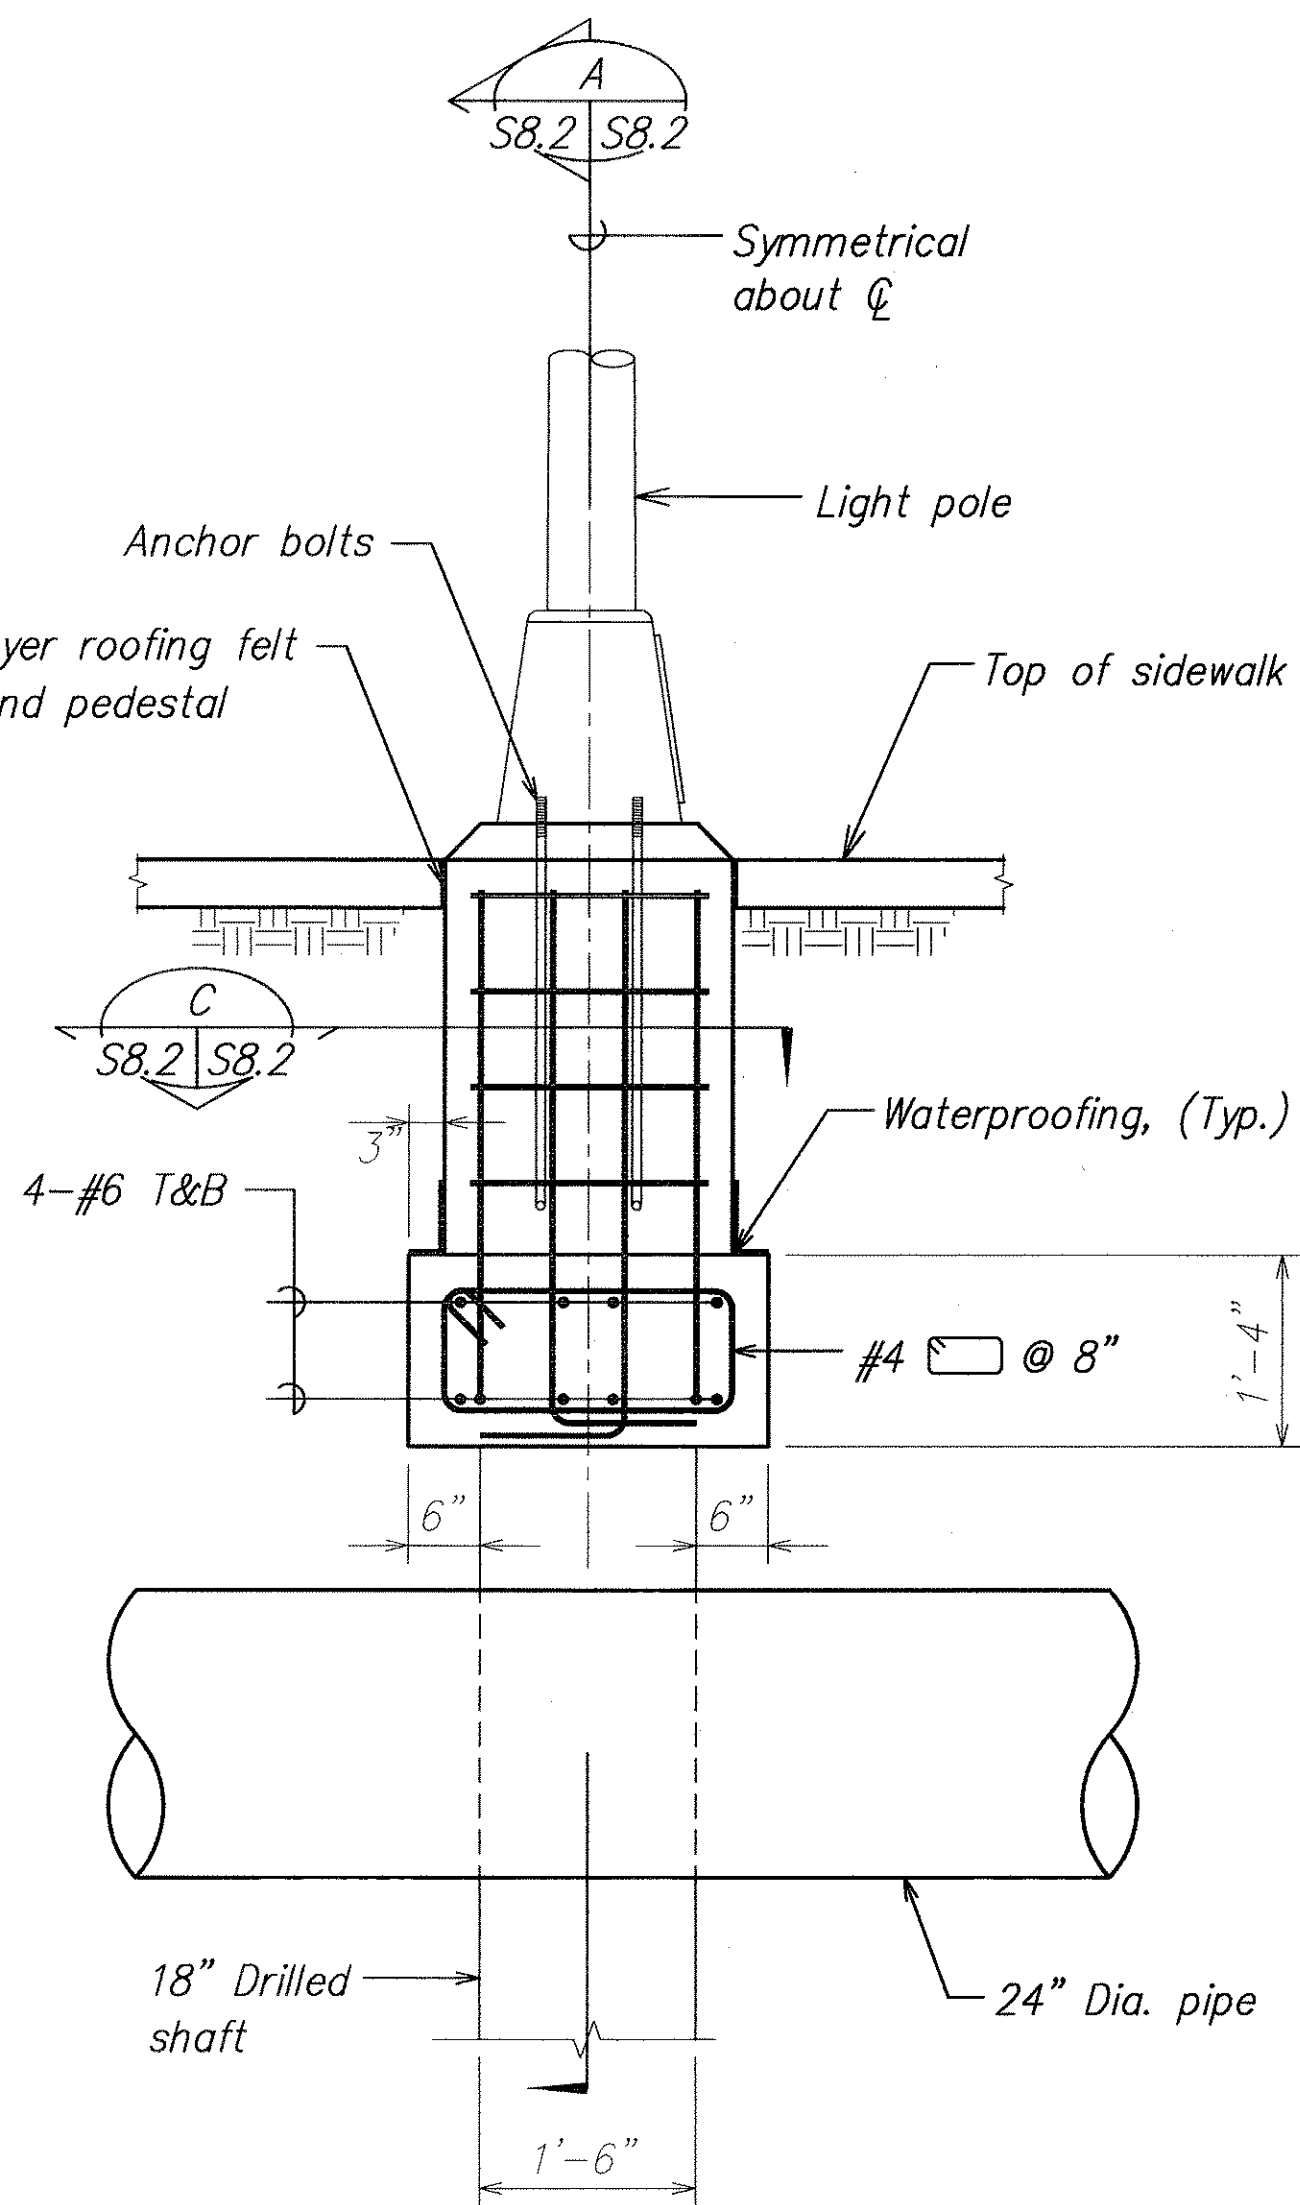

SECTION B
SCALE: 3/4" = 1'-0" S8.2 S8.2

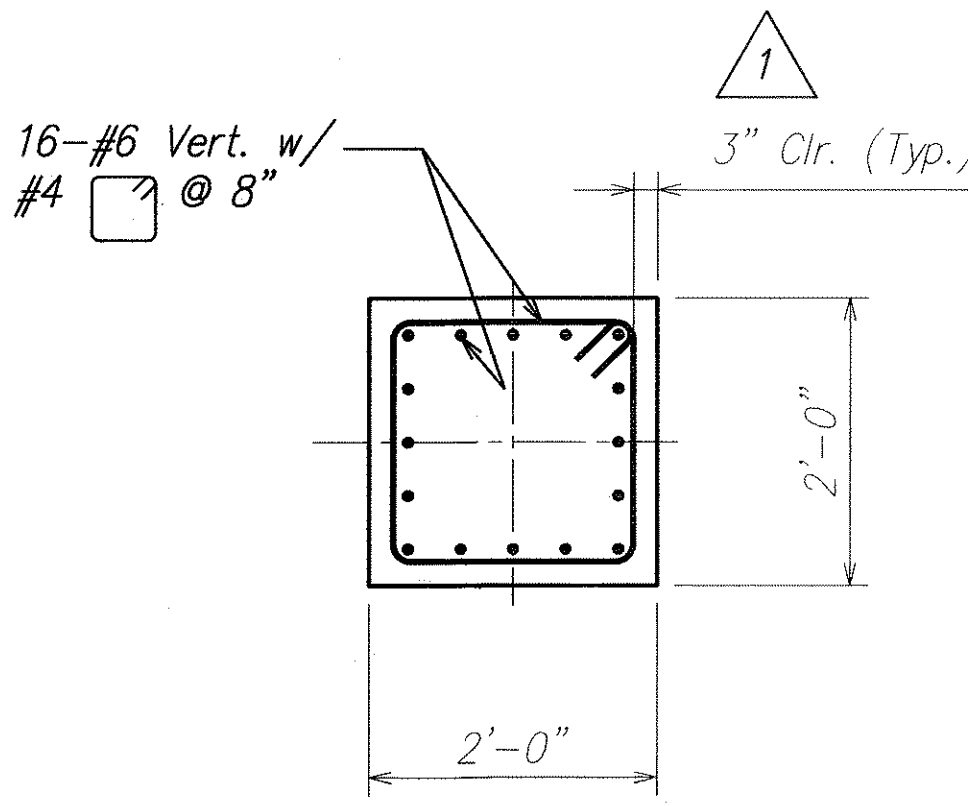

SECTION C
SCALE: 3/4" = 1'-0" S8.2 S8.2

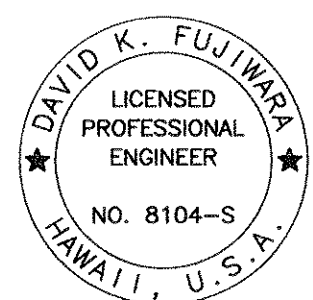

THIS WORK WAS PREPARED BY ME OR UNDER MY SUPERVISION.

Signature: David K. Fujiwara
EXPIRATION DATE OF THE LICENSE: 4-30-08

STATE OF HAWAII
DEPARTMENT OF TRANSPORTATION
HIGHWAYS DIVISION

TYPICAL LIGHT POLE FOUNDATION

North-South Road
Phase 1A
F.A.I. Proj. No. STP-8930(1)


Scale: As Noted Date: Dec. 22, 2004

SHEET No. S8.2 OF 43 SHEETS

1/18/05	1	Revised Dimension
DATE	REVISION	


ORIGINAL PLAN	SURVEY PLOTTED BY	DATE
NOTE BOOK	DRAWN BY	
	TRACED BY	
	DESIGNED BY	
	CHECKED BY	

FED. ROAD DIST. NO.	STATE	FED. AID PROJ. NO.	FISCAL YEAR	SHEET NO.	TOTAL SHEETS
HAWAII	HAW.	STP-8930(1)	2005	110	144

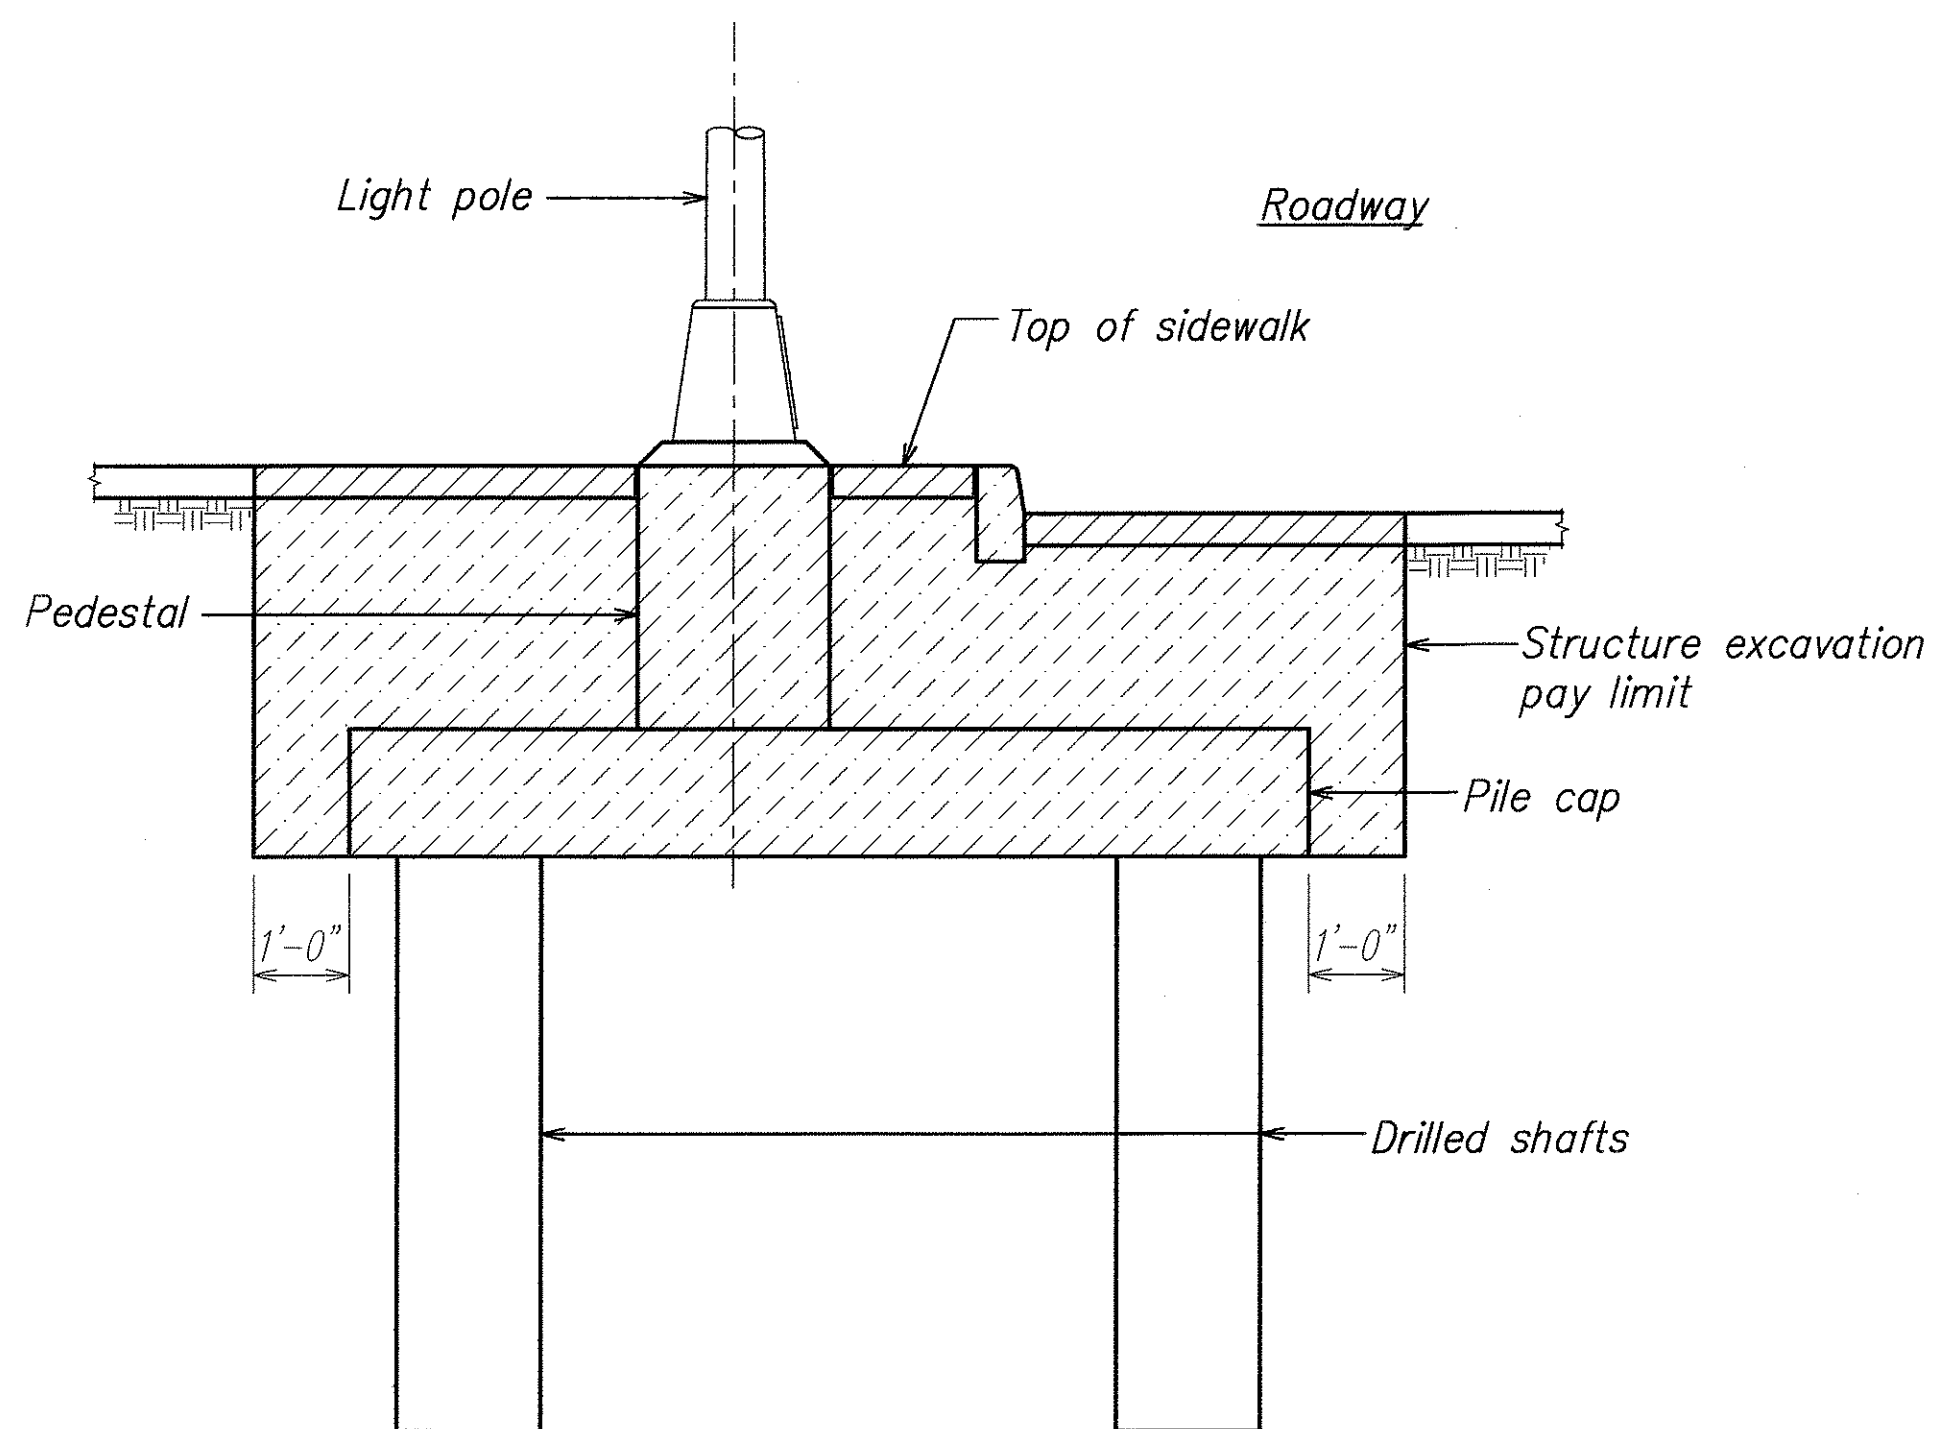


SECTION A
SCALE: 1/2" = 1'-0" S8.3 | S8.3

Note:
Drilled shafts excavation shall be paid under Section 511.

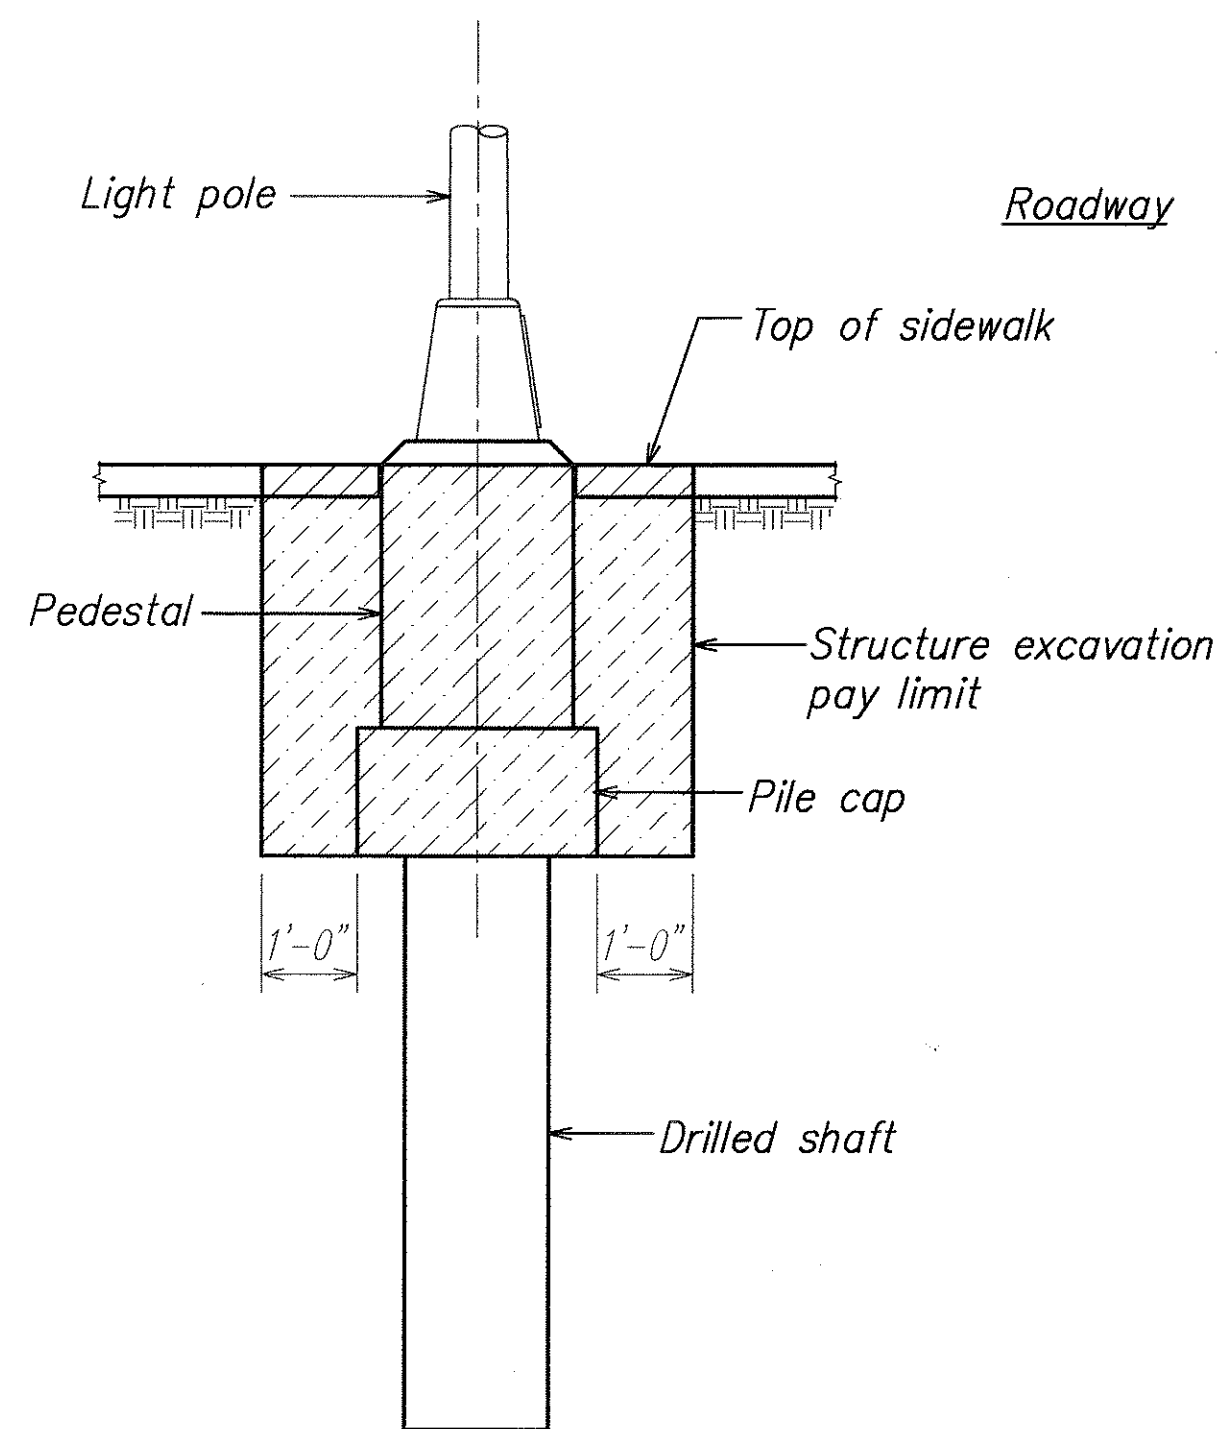

SECTION B
SCALE: 1/2" = 1'-0" S8.3 | S8.3

ORIGINAL PLAN	SURVEY LOCATED BY	DATE
NOTE BOOK	DRAWN BY	" "
No.	DESIGNED BY	" "
	QUANTITIES BY	" "
	CHECKED BY	" "

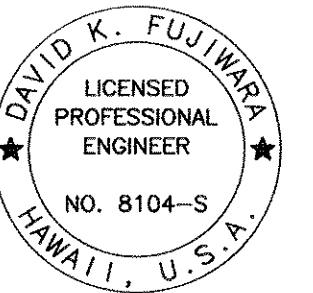

THIS WORK WAS PREPARED BY ME OR UNDER MY SUPERVISION.

Signature: David K. Fujiwara
EXPIRATION DATE OF THE LICENSE: 4-30-06

STATE OF HAWAII
DEPARTMENT OF TRANSPORTATION
HIGHWAYS DIVISION

**LIGHT POLE STRUCTURE
EXCAVATION PAY LIMITS**


North-South Road
Phase 1A
F.A.I. Proj. No. STP-8930(1)

Scale: As Noted Date: Dec. 22, 2004

SHEET No. S8.3 OF 43 SHEETS



STRUCTURAL GENERAL NOTES:

1. General Specifications: Hawaii Department of Transportation, Standard Specifications for Road, Bridge, and Public Works Construction, 1994, together with Special Provisions prepared for this contract.
2. Design Specifications: AASHTO 1998 LRFD Bridge Design Specifications (Second Edition) and its subsequent interim specifications with interim supplements and modifications by the Highways Division, Department of Transportation, State of Hawaii.
3. Materials:
- (A) All concrete strengths shall be as noted below:
- | Item No. | Structural Parts | Compressive Strength
f'c (28 Days) | W/C Ratio |
|----------|-------------------------------------|---------------------------------------|-----------|
| (1) | All concrete unless otherwise noted | 4000 PSI | 0.45 |
- (B) The use of any calcium chloride in any concrete is prohibited.
- (C) All reinforcing steel shall be ASTM A 615 Grade 60 unless otherwise noted.
4. Reinforcement:
- (A) The covering measured from the surface of the concrete to the face of any reinforcing bars shall be as follows, except as otherwise shown:
- (1) Concrete cast against and permanently exposed to earth = 3"
- (2) All others unless otherwise noted = 2".
- (B) Reinforcing bars shall be detailed in accordance with the latest edition of the A.C.I. Detailing Manual unless otherwise noted.
- (C) Minimum clear spacing between parallel bars shall be 1 1/2 times the diameter of bars (for non bundled bars). In no case shall the clear distance between the bars be less than 1 1/2 times the maximum size of the coarse aggregate or 1 1/2".
- (D) All dimensions relating to reinforcing bars are to centers of bars unless otherwise noted.
- (E) Reinforcing bars shall be securely tied at all intersections and lap splices except where the spacing of intersections is less than one foot in each direction, in which case alternate intersections shall be tied.
5. Construction Notes:
- (A) The Contractor shall verify all dimensions and site conditions and shall report any discrepancies in writing to the Engineer before commencing work or ordering materials.
- (B) The Contractor shall be solely responsible for the protection of adjacent properties, utilities and existing and new structures from damage due to construction. Repairing any damage shall be at the Contractor's own expense, to the satisfaction of the Engineer.
- (C) The Contractor shall verify the location of all utility lines and notify the respective owners before commencing with excavation, and any temporary piling or sheeting.
- (D) Except as otherwise noted, all vertical dimensions are measured plumb.
- (E) For concrete finish see Standard Specifications and Special Provisions.
- (F) Construction joints may be relocated or additional ones added subject to the approval of the Engineer.
- (G) Unless otherwise noted, all exposed concrete edges shall be chamfered 3/4" x 3/4".
- (H) The Contractor shall refer to the existing drawings for the approximate location and size of all existing reinforcing bars prior to demolishing wall.
- (J) The Contractor shall submit shop drawings for maintenance manhole prior to start of manhole fabrication.

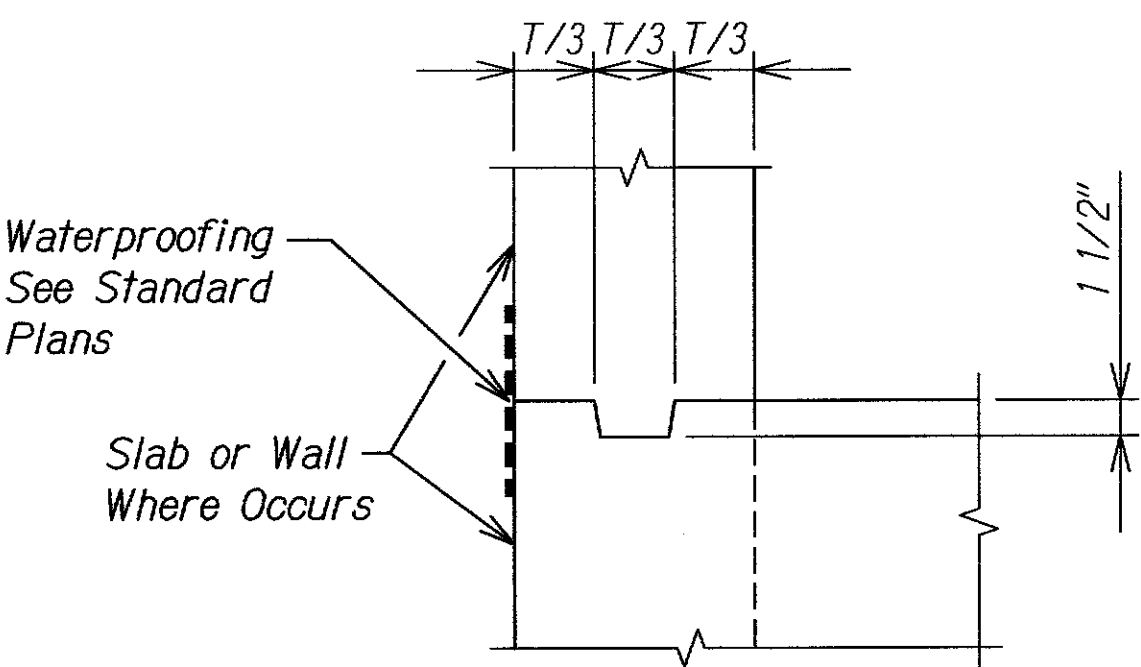



TYPICAL KEY DETAIL

SCALE: 1 1/2" = 1'-0"

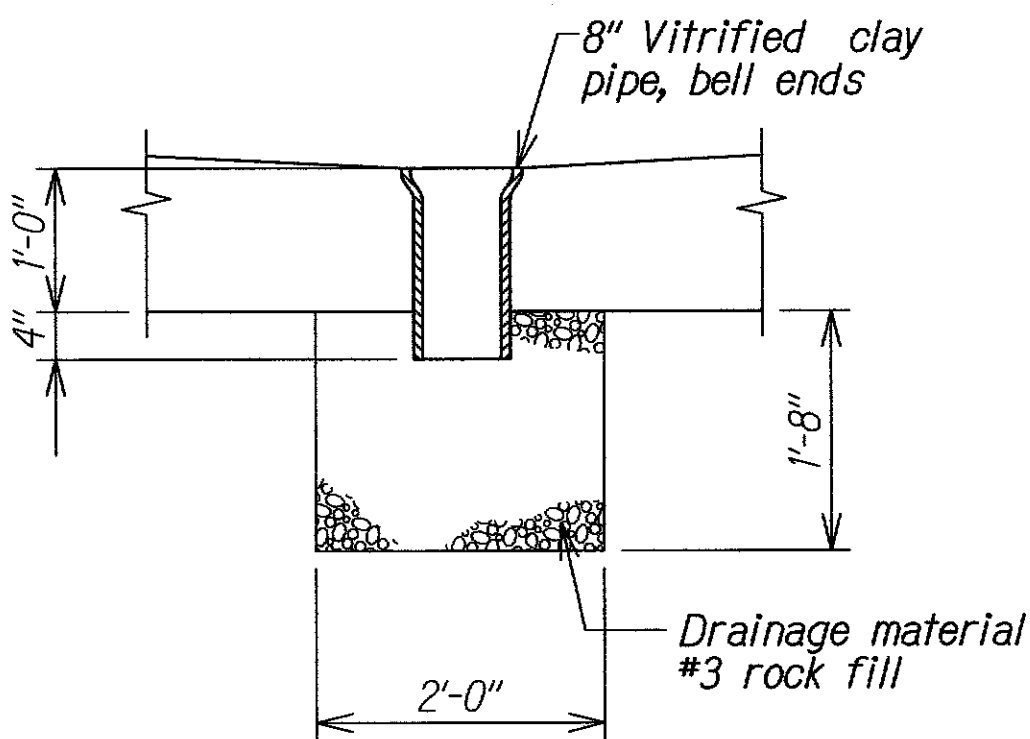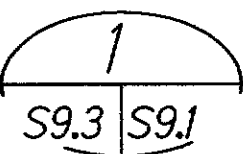



MANHOLE SUMP DETAIL

SCALE: 3/4" = 1'-0"

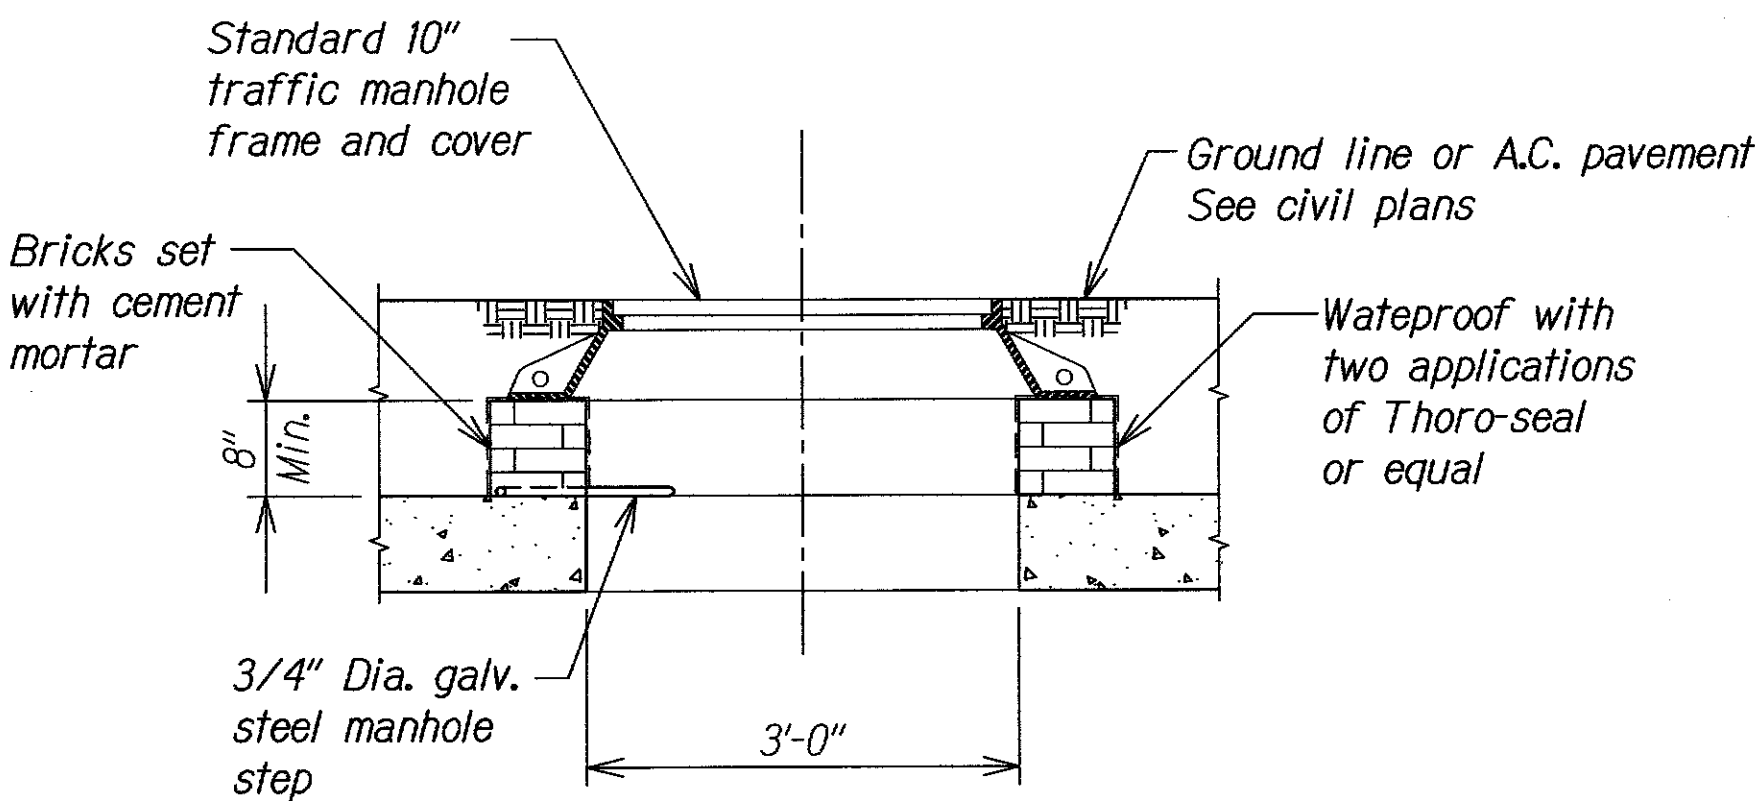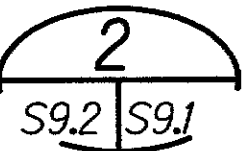

BRICK COLLAR DETAIL

SCALE: 3/4" = 1'-0"

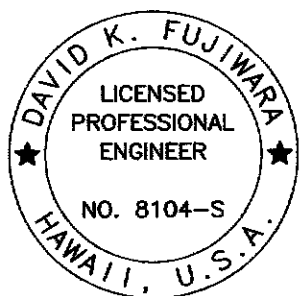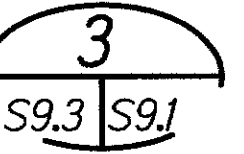

THIS WORK WAS PREPARED BY ME OR UNDER MY SUPERVISION.

SIGNATURE: David K. Fujimura
EXPIRATION DATE OF THE LICENSE: 4-30-08

FED. ROAD DIST. NO.	STATE	FED. AID PROJ. NO.	FISCAL YEAR	SHEET NO.	TOTAL SHEETS
HAWAII	HAW.	STP-8930(1)	2005	C.O. 110 S-1	144

10/27/06 New Sheet

DATE REVISION

STATE OF HAWAII
DEPARTMENT OF TRANSPORTATION
HIGHWAYS DIVISION

STRUCTURAL GENERAL NOTES
AND TYPICAL DETAILS

North-South Road
Phase 1A

F.A.I. Proj. No. STP-8930(1)

Scale: As Noted

Date: Dec. 22, 2004



SHEET No. S9.1 OF 43 SHEETS

C.O. 110 S-1

DESIGNED BY	DATE
CHECKED BY	
NOTED BY	
ORIGINAL PLAN	
NO. 1	

FED. ROAD DIST. NO.	STATE	FED. AID PROJ. NO.	FISCAL YEAR	SHEET NO.	TOTAL SHEETS
HAWAII	HAW.	STP-8930(1)	2005	C.O. 110 8-2	144

TOP SLAB - REINFORCING PLAN
 SCALE: 3/4" = 1'-0"
 A
 S9.2 S9.2

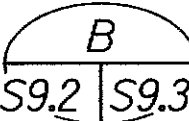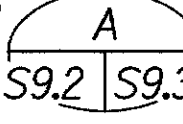NOTE:
 Top bars not shown for clarity.
 For reinforcing see
 and  

WALL - REINFORCING PLAN
 SCALE: 3/4" = 1'-0"
 B
 S9.3 S9.2

BOTTOM SLAB - REINFORCING PLAN
 SCALE: 3/4" = 1'-0"
 C
 S9.2 S9.2

THIS WORK WAS PREPARED BY ME OR UNDER MY SUPERVISION.

David K. Fujiwara
 SIGNATURE EXPIRATION DATE OF THE LICENSE 4-30-08

10/27/06	New Sheet
DATE	REVISION
STATE OF HAWAII DEPARTMENT OF TRANSPORTATION HIGHWAYS DIVISION NEW MAINTENANCE MANHOLE TYPICAL PLANS AND SECTIONS North-South Road Phase 1A F.A.I. Proj. No. STP-8930(1)	
Scale: As Noted	Date: Dec. 22, 2004
SHEET No. S9.2 OF 43 SHEETS	

DAVID K. FUJIWARA
LICENSED
PROFESSIONAL
ENGINEER
NO. 8104-S
HAWAII, U.S.A.

THIS WORK WAS PREPARED BY
ME OR UNDER MY SUPERVISION

David K. Fujiwara 4-30-08
SIGNATURE EXPIRATION DATE OF THE LICENSE

10/27/06	New Sheet
DATE	REVISION

STATE OF HAWAII
 DEPARTMENT OF TRANSPORTATION
 HIGHWAYS DIVISION

NEW MAINTENANCE MANHOLE
TYPICAL PLANS AND SECTIONS


North-South Road
Phase 1A
F.A.I. Proj. No. STP-8930(1)

Scale: As Noted *Date: Dec. 22, 2004*


SHEET No. S9.2 OF 43 SHEETS

C.O. 110 S-2

FED. ROAD DIST. NO.	STATE	FED. AID PROJ. NO.	FISCAL YEAR	SHEET NO.	TOTAL SHEETS
HAWAII	HAW.	STP-8930(1)	2005	C.O. 110 S-3	144

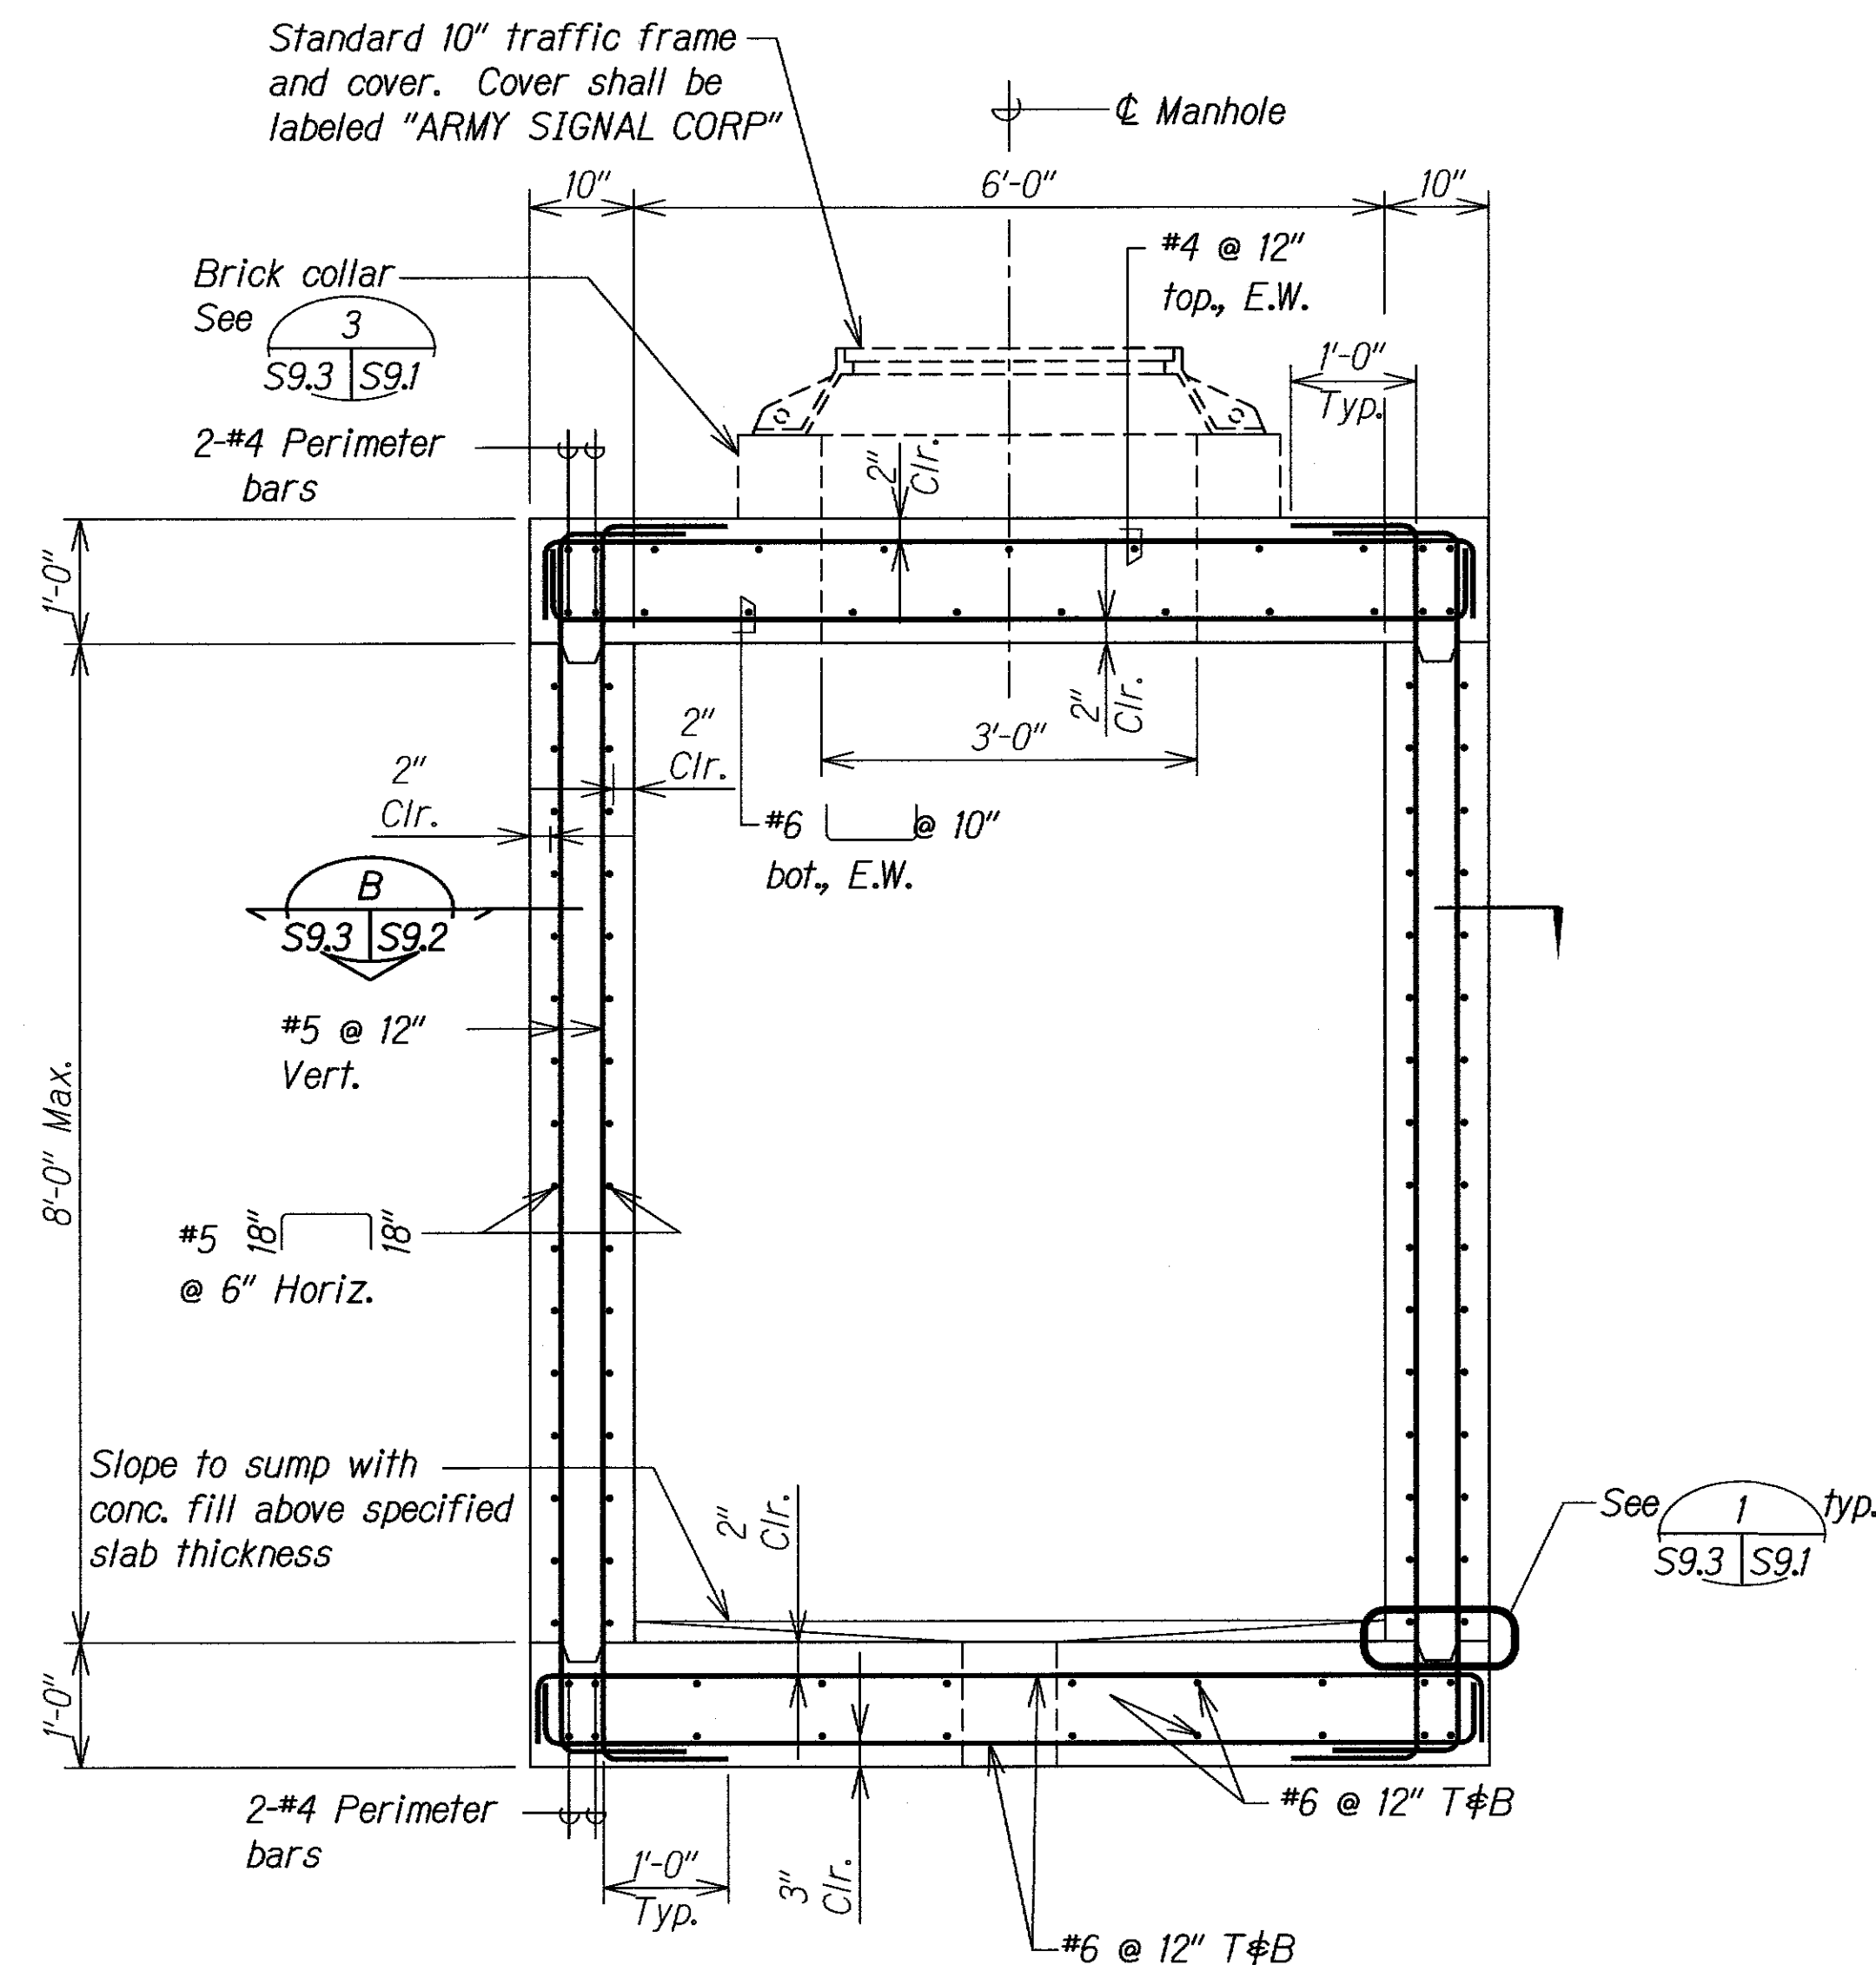


WALL - REINFORCING SECTION A
SCALE: 3/4" = 1'-0" S9.2 S9.3

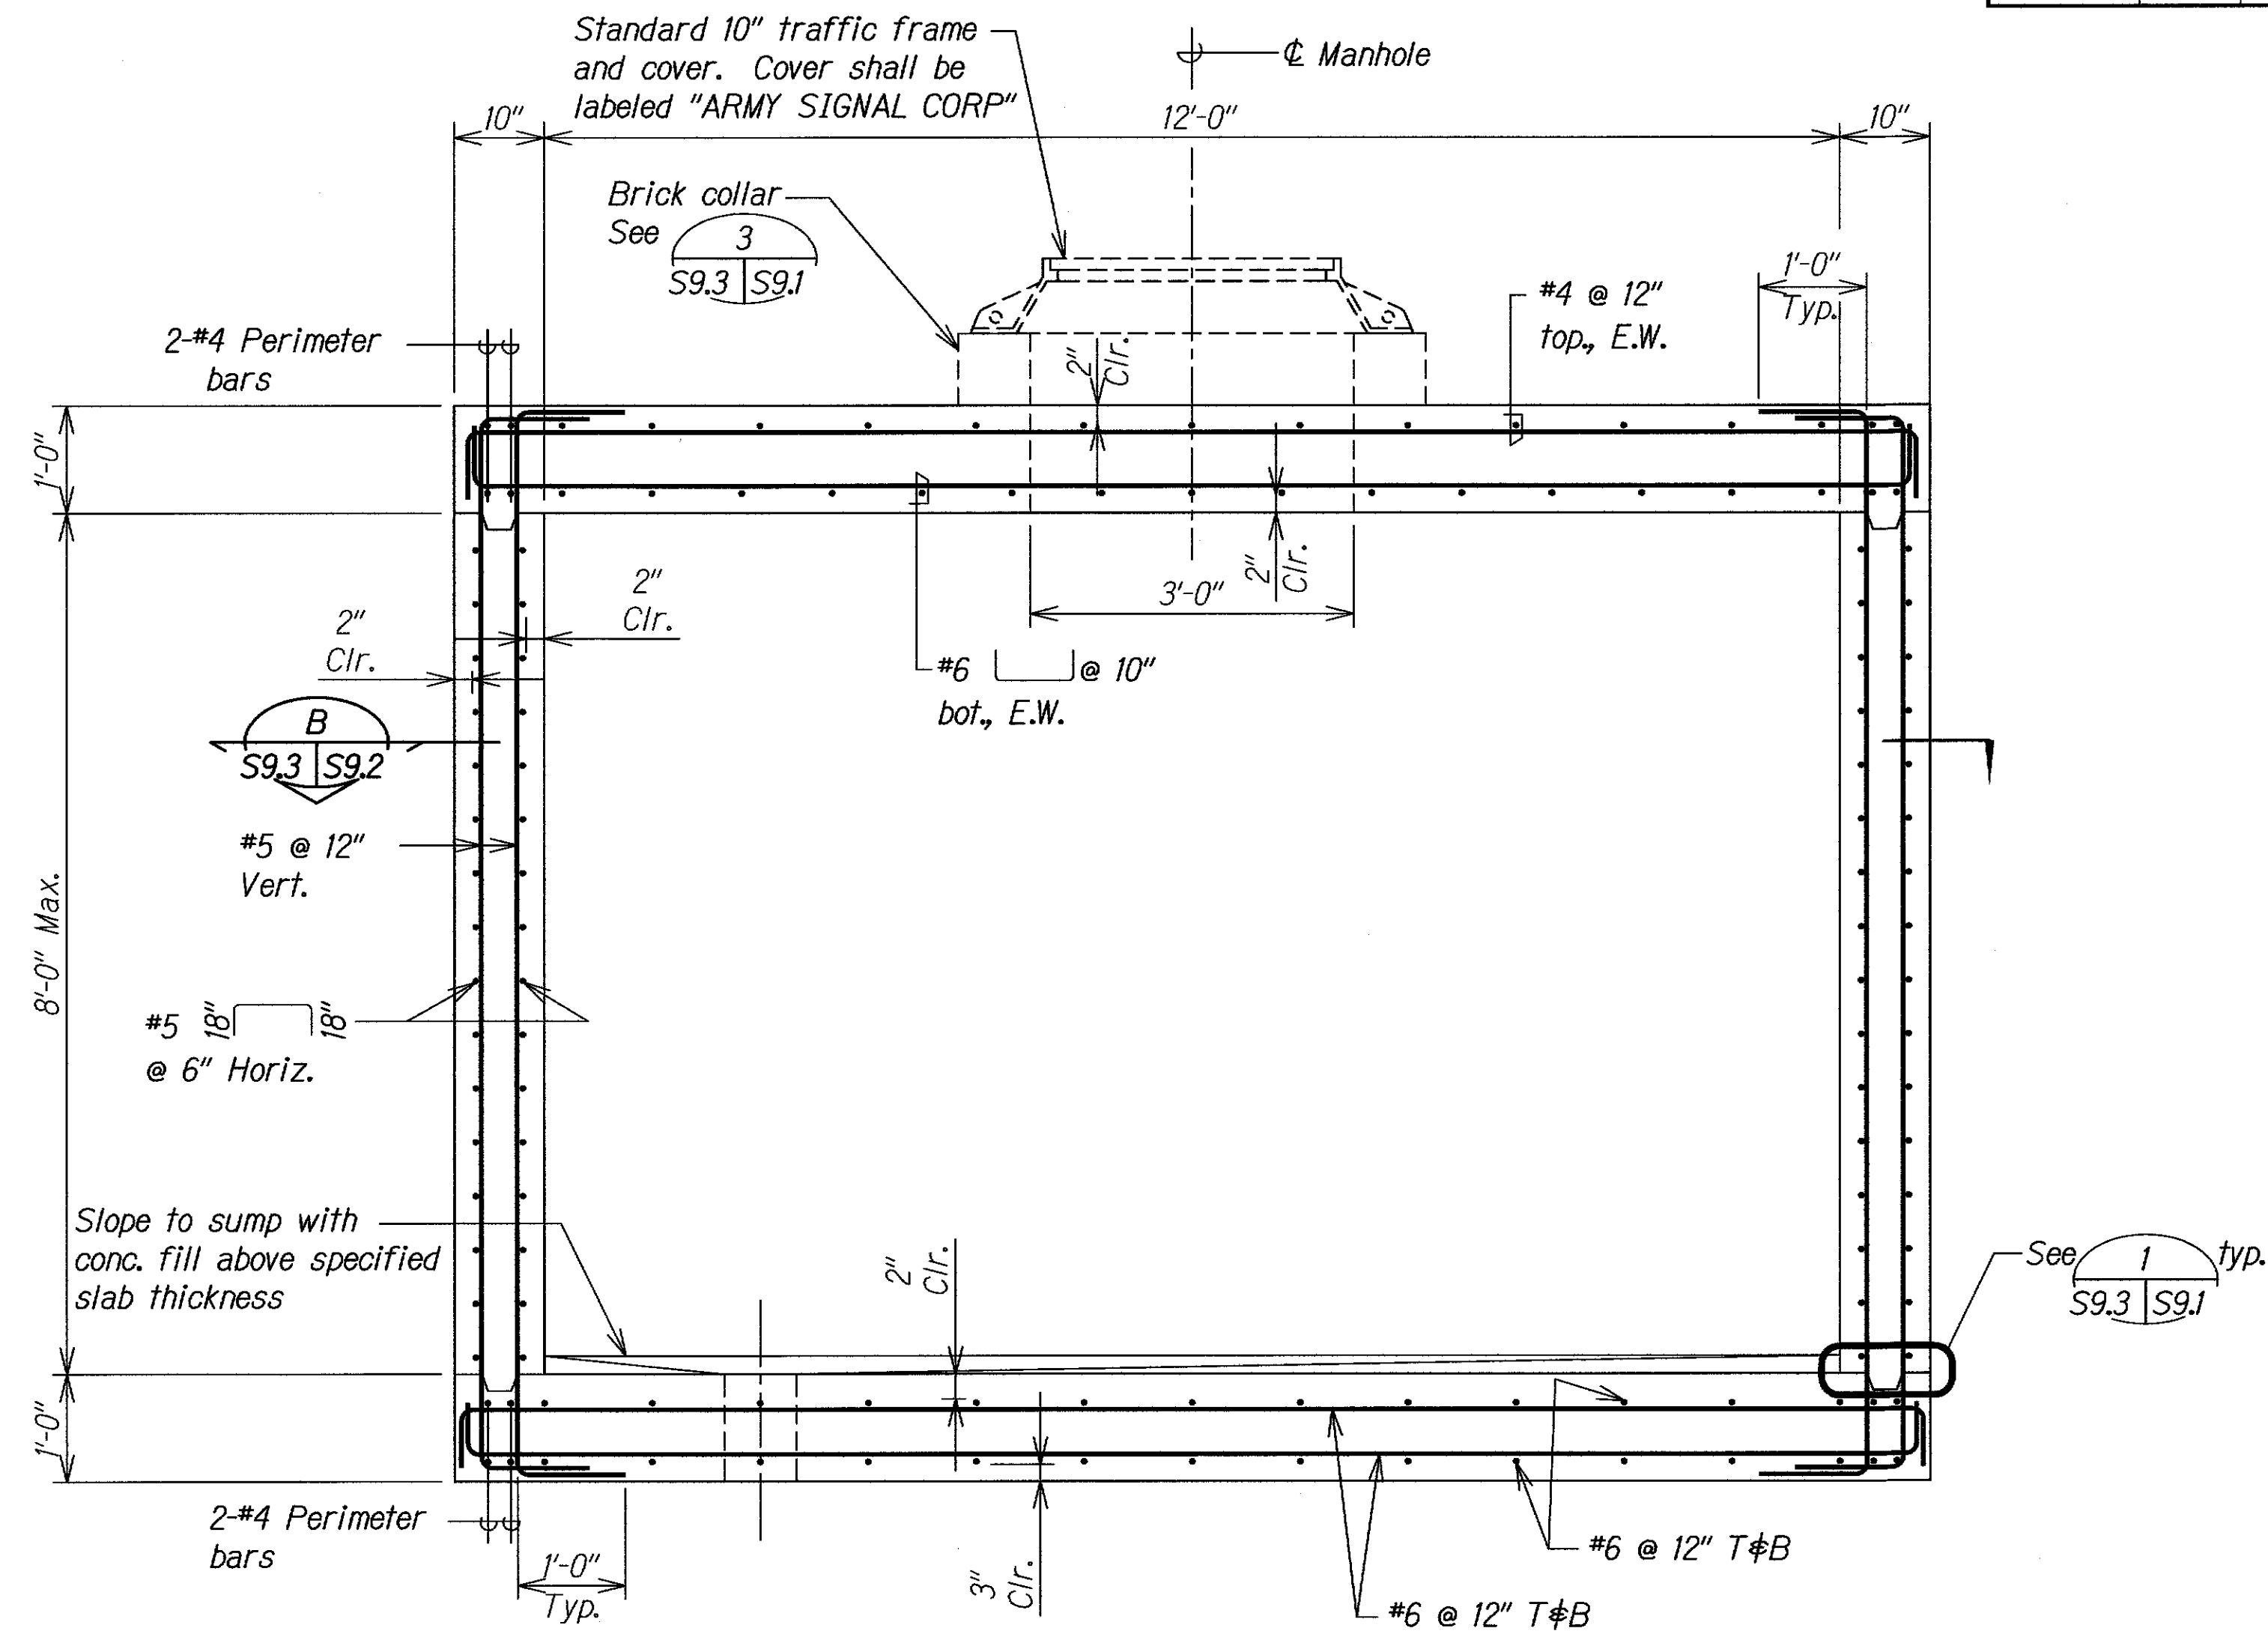

WALL - REINFORCING SECTION B
SCALE: 3/4" = 1'-0" S9.2 S9.3

SURVEY PLOTTED BY	DATE
DRAWN BY	
TRACED BY	
DESIGNED BY	
QUANTITIES BY	
CHECKED BY	
ORIGINAL PLAN	
NOTE BOOK	
No.	

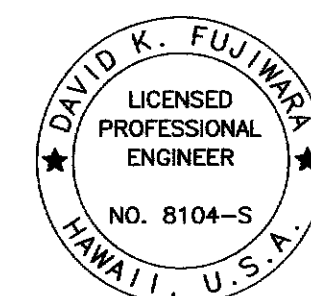


THIS WORK WAS PREPARED BY ME OR UNDER MY SUPERVISION.

David K. Fujimura
SIGNATURE EXPIRATION DATE OF THE LICENSE 4-30-08


10/27/06	New Sheet
DATE	REVISION
STATE OF HAWAII DEPARTMENT OF TRANSPORTATION HIGHWAYS DIVISION MAINTENANCE MANHOLE EXTENSION SECTIONS North-South Road Phase 1A F.A.I. Proj. No. STP-8930(1) Scale: As Noted Date: Dec. 22, 2004 SHEET No. S9.3 OF 43 SHEETS	

FED. ROAD DIST. NO.	STATE	FED. AID PROJ. NO.	FISCAL YEAR	SHEET NO.	TOTAL SHEETS
HAWAII	HAW.	STP-8930(1)	2005	C.O. 110 S-4	144

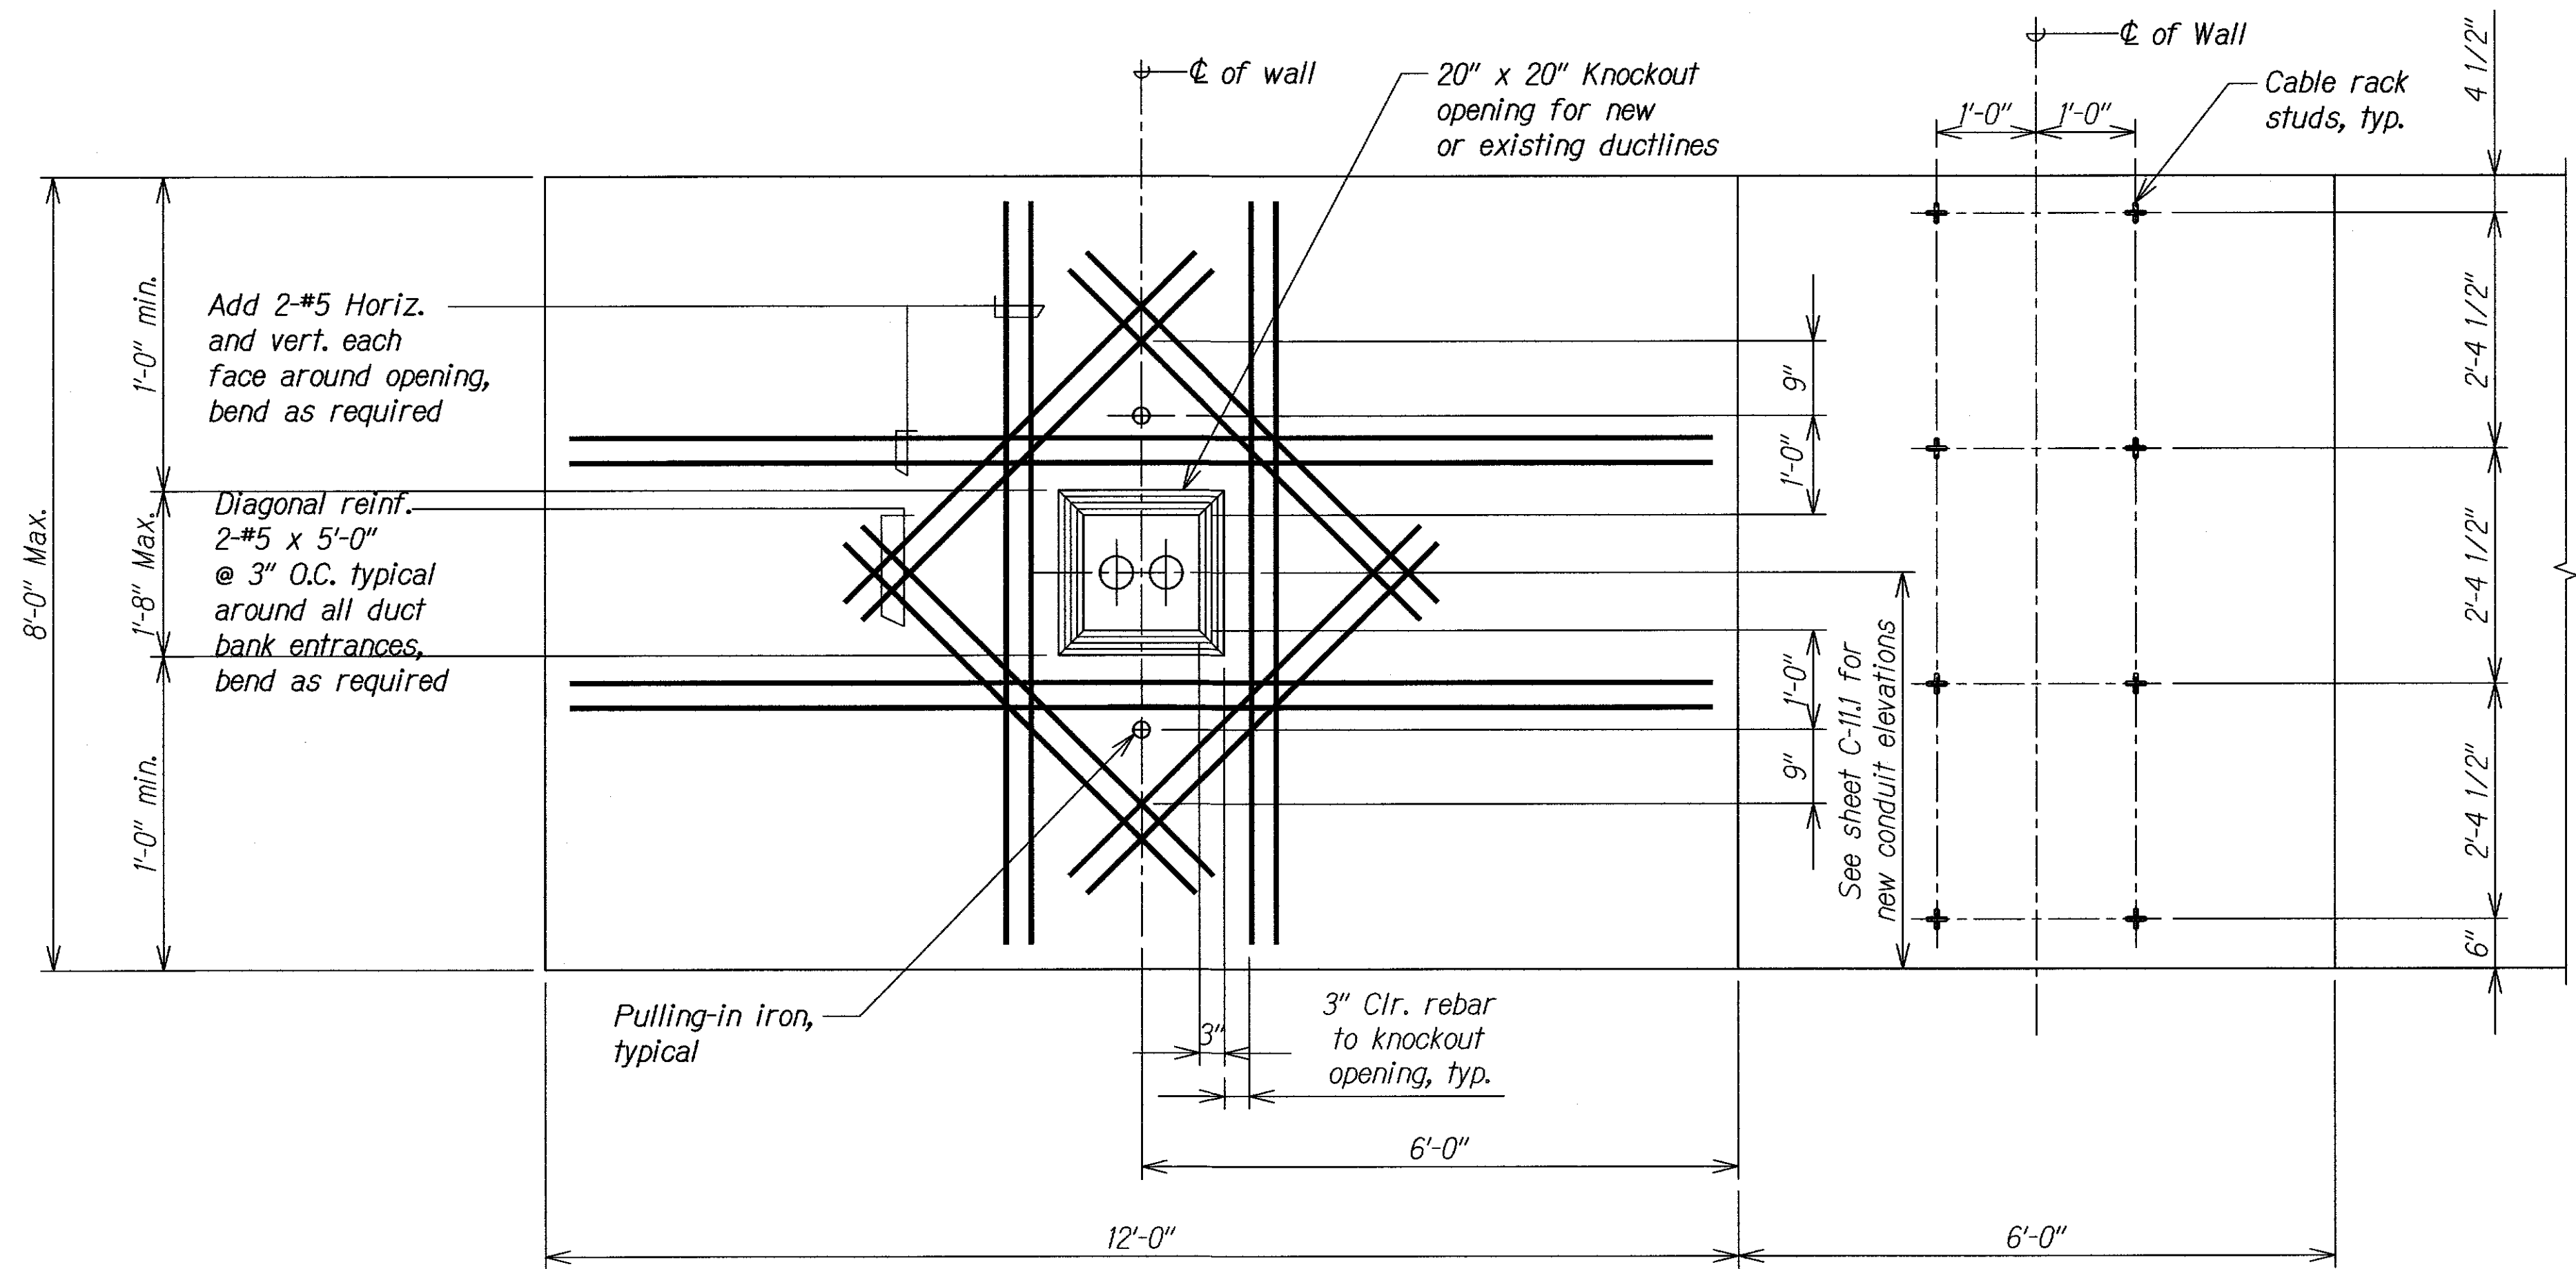

ELEVATION OF MANHOLE WALLS (OPPOSITE FACES SIMILAR)
 SCALE: 3/4" = 1'-0"

SURVEY LOCATED BY	DATE
DRAWN BY	
DESIGNED BY	
QUANTITIES BY	
CHECKED BY	
ORIGINAL PLAN	
NOTE BOOK	
No.	

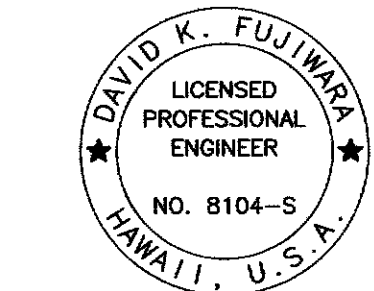

THIS WORK WAS PREPARED BY
 ME OR UNDER MY SUPERVISION.
David K. Fujiwara
 SIGNATURE EXPIRATION DATE OF THE LICENSE 4-30-08

10/27/06	New Sheet
DATE	REVISION
STATE OF HAWAII DEPARTMENT OF TRANSPORTATION HIGHWAYS DIVISION MAINTENANCE MANHOLE WALL ELEVATION <i>North-South Road</i> <i>Phase 1A</i> <i>F.A.I. Proj. No. STP-8930(1)</i> Scale: As Noted Date: Dec. 22, 2004 SHEET No. S9.4 OF 43 SHEETS	