
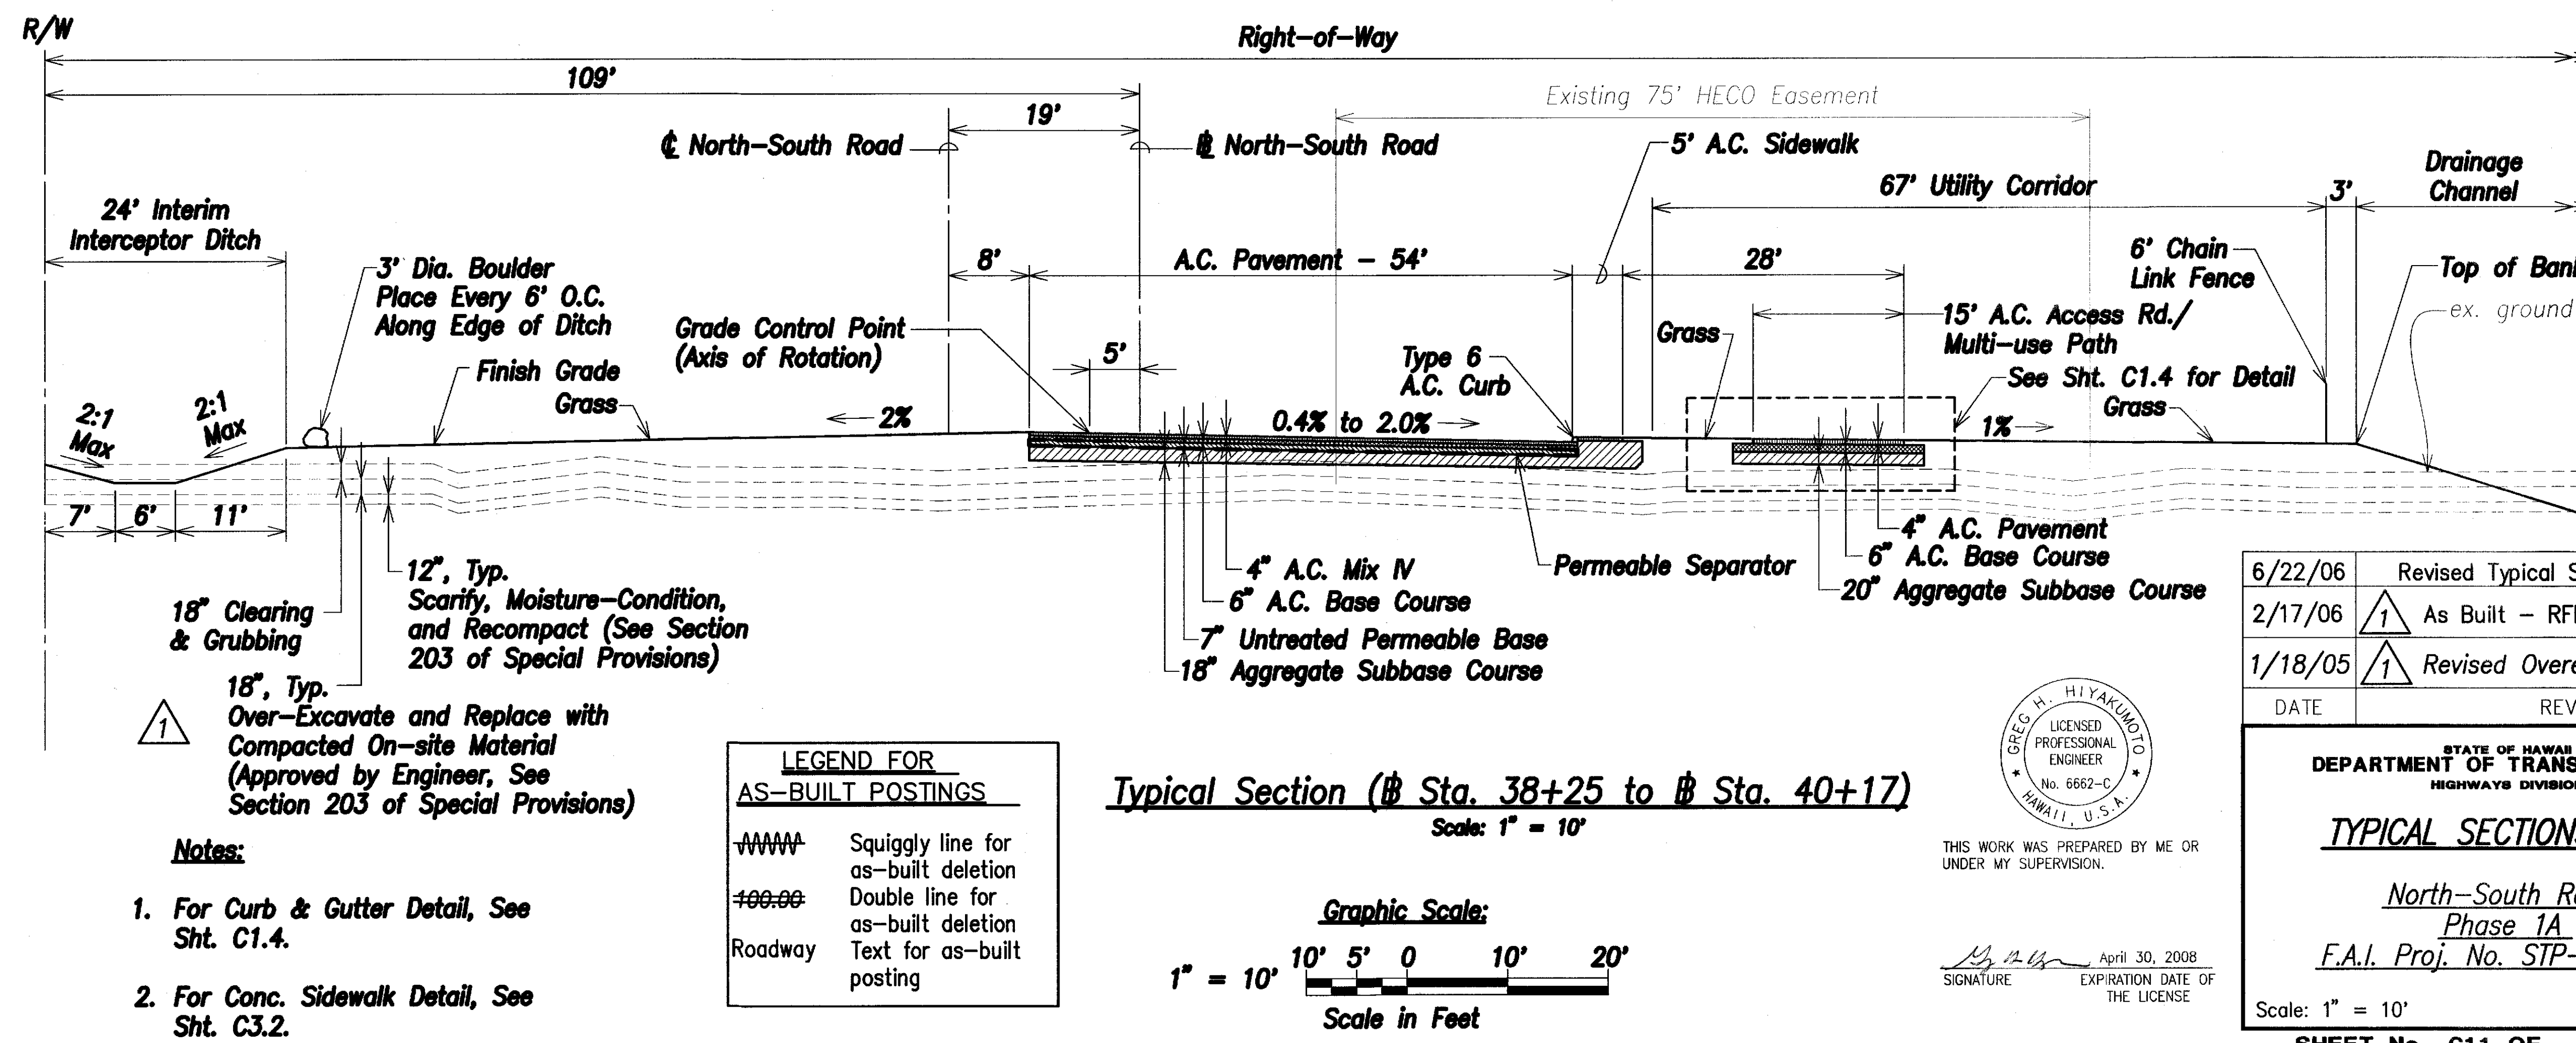




FED. ROAD DIST. NO.	STATE	FED. AID PROJ. NO.	FISCAL YEAR	SHEET NO.	TOTAL SHEETS
HAWAII	HAW.	STP-8930(1)	2005	CO ADD. 13	144

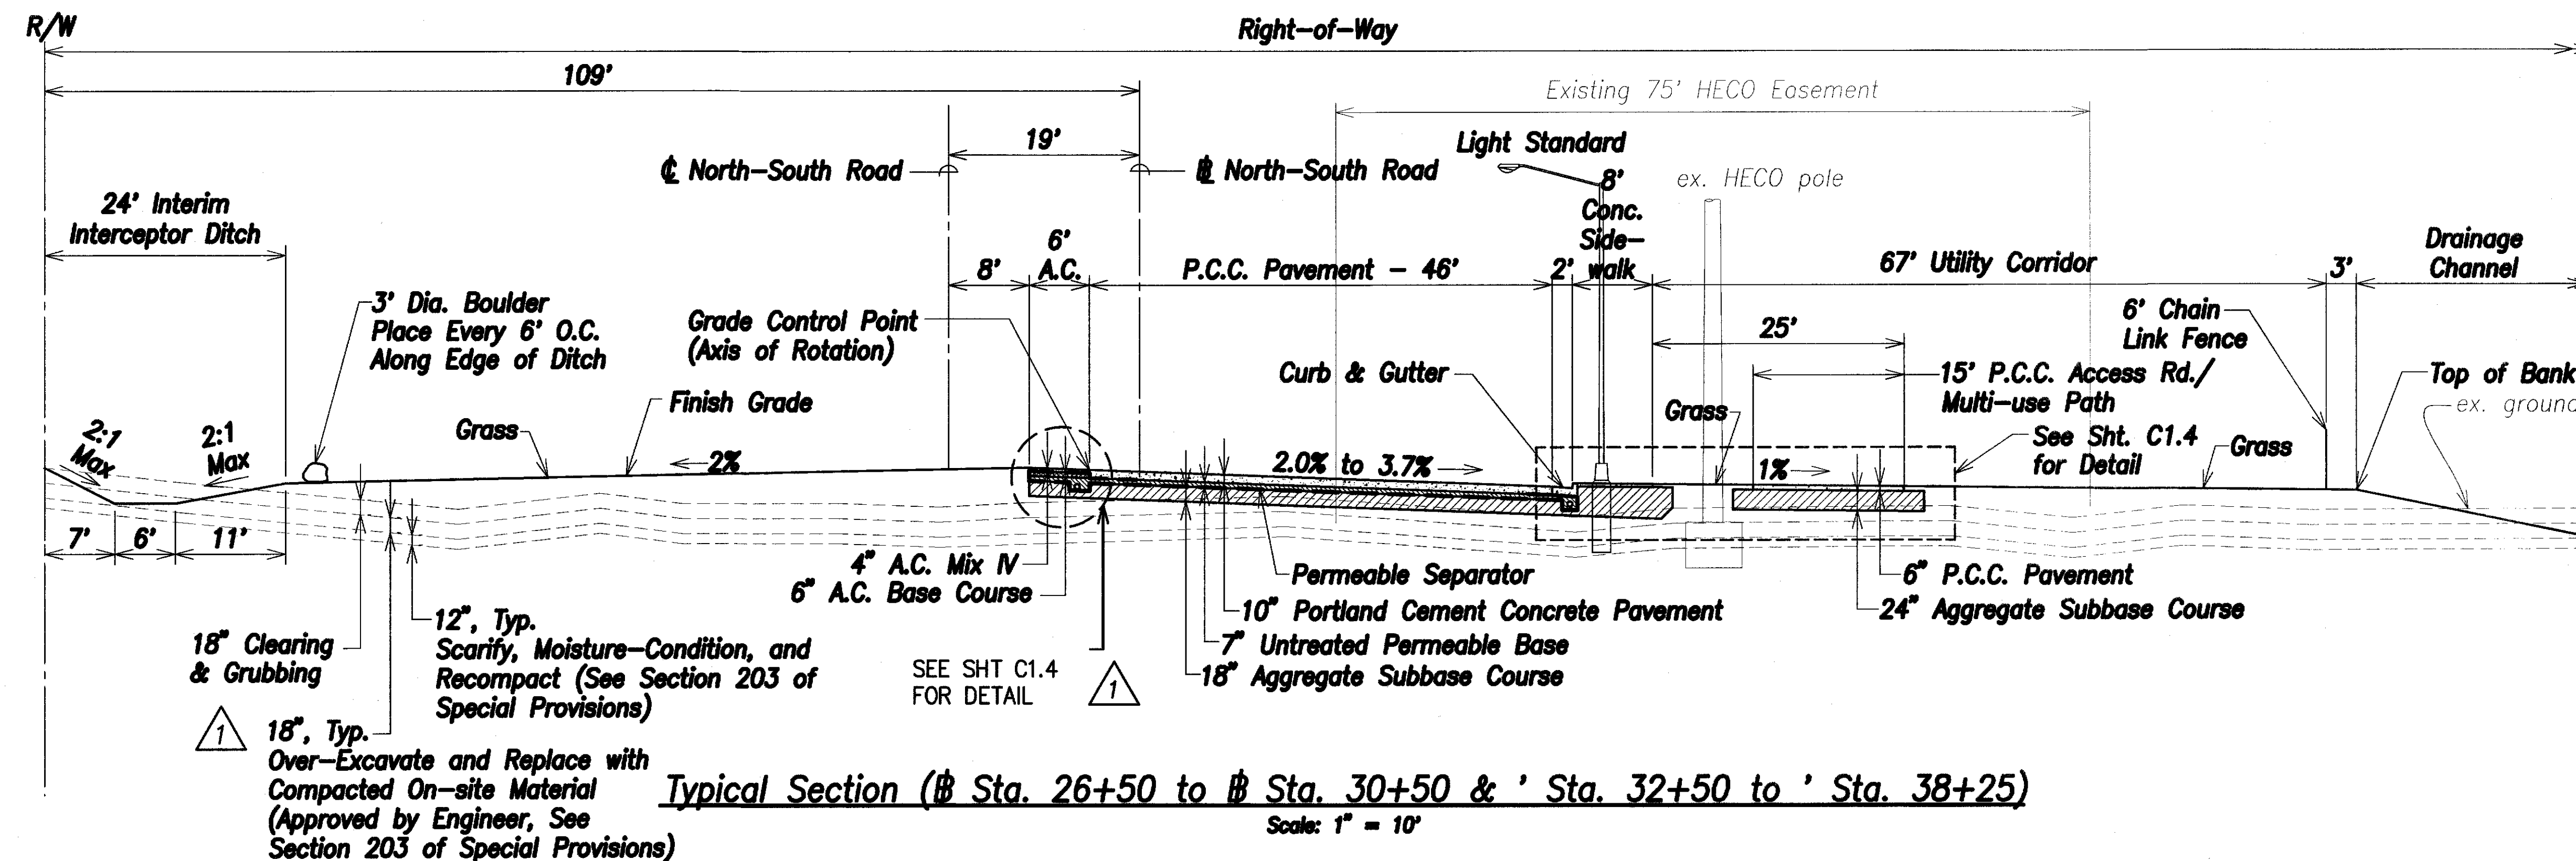

LEGEND FOR AS-BUILT POSTINGS

~~~~~	Squiggly line for as-built deletion
==	Double line for as-built deletion
Roadway	Text for as-built posting

**Typical Section (# Sta. 38+25 to # Sta. 40+17)**  
Scale: 1" = 10'

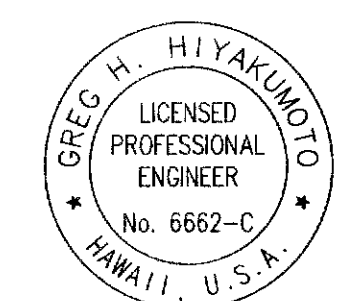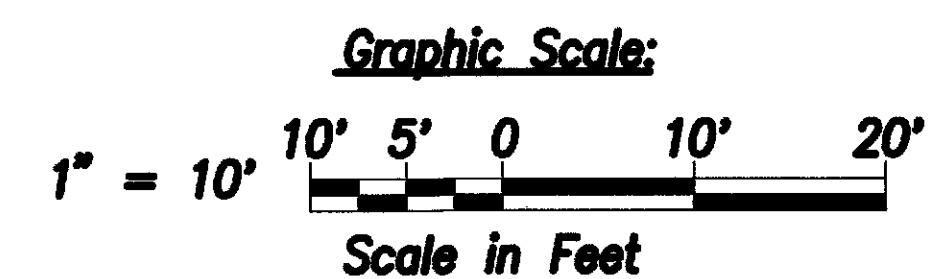

THIS WORK WAS PREPARED BY ME OR UNDER MY SUPERVISION.

SIGNATURE: *[Signature]* April 30, 2008  
EXPIRATION DATE OF THE LICENSE

6/22/06	Revised Typical Section Stations
2/17/06	1 As Built - RFI 13A
1/18/05	1 Revised Overexcavation Limits
DATE	REVISION

STATE OF HAWAII DEPARTMENT OF TRANSPORTATION HIGHWAYS DIVISION	
<b>TYPICAL SECTIONS - 1</b>	
North-South Road Phase 1A F.A.I. Proj. No. STP-8930(1)	
Scale: 1" = 10'	Date: Dec 22, 2004
SHEET No. C1.1 OF SHEETS	

DATE	
DESIGNED BY	
CHECKED BY	
NO. 1	

- Notes:**
- For Curb & Gutter Detail, See Sht. C1.4.
  - For Conc. Sidewalk Detail, See Sht. C3.2.















FED. ROAD DIST. NO.	STATE	FED. AID PROJ. NO.	FISCAL YEAR	SHEET NO.	TOTAL SHEETS
HAWAII	HAW.	STP-8930(1)	2005	16	144

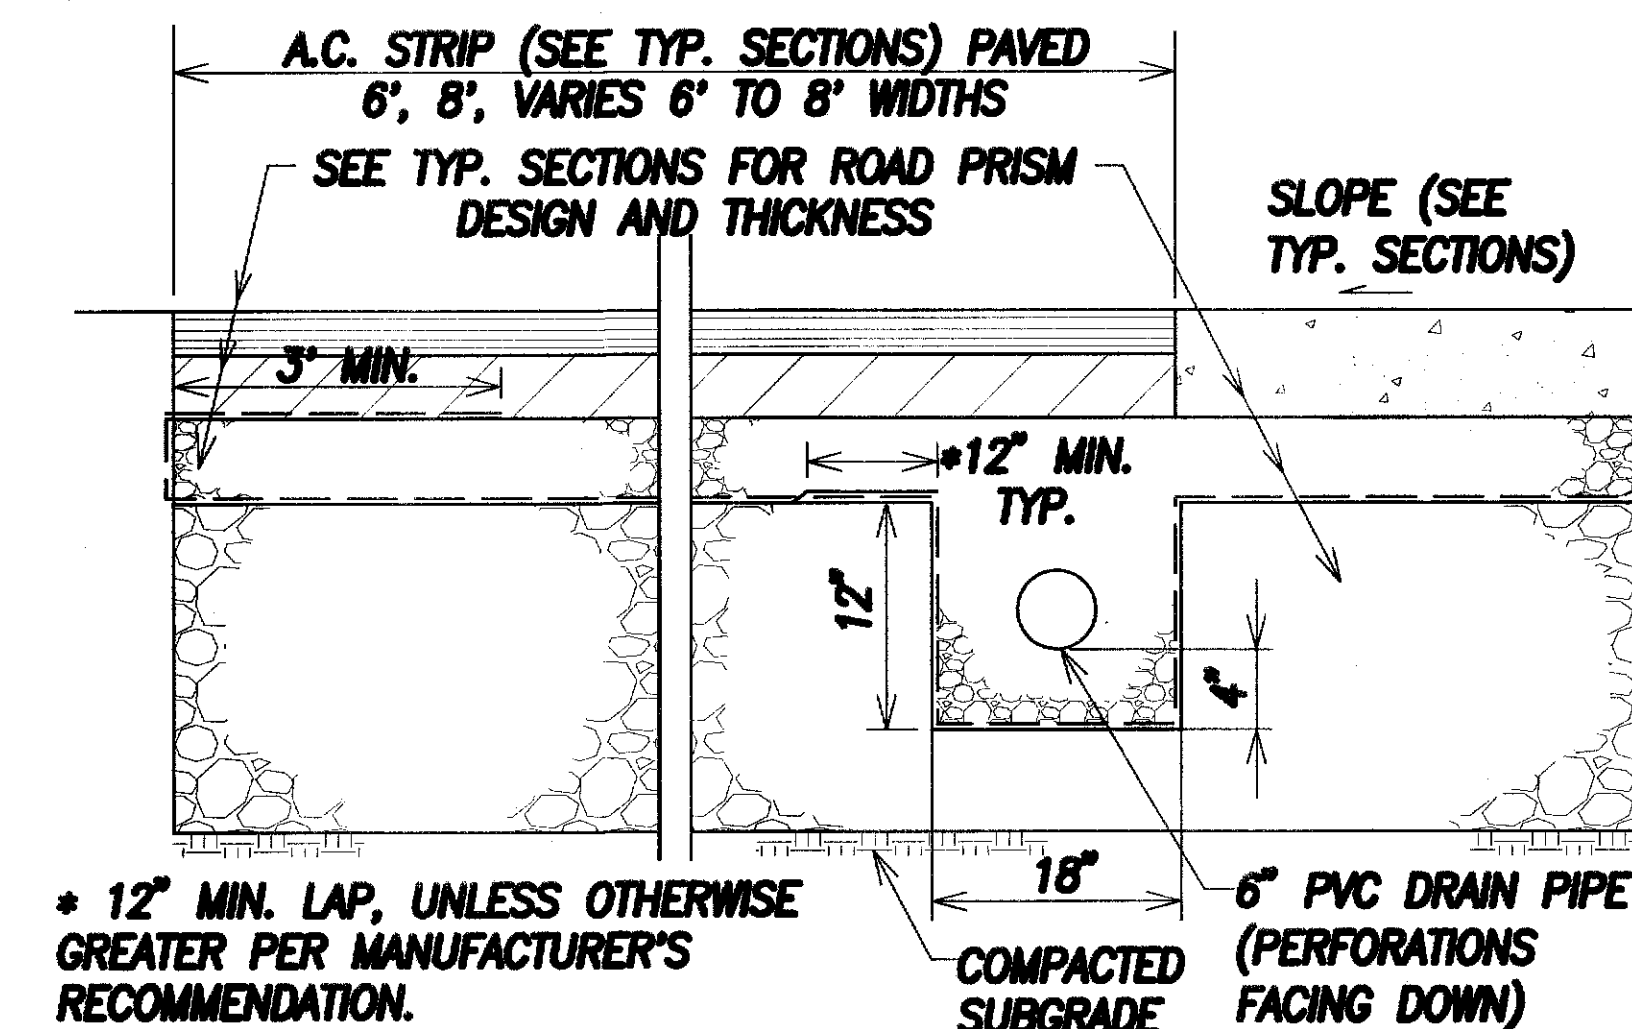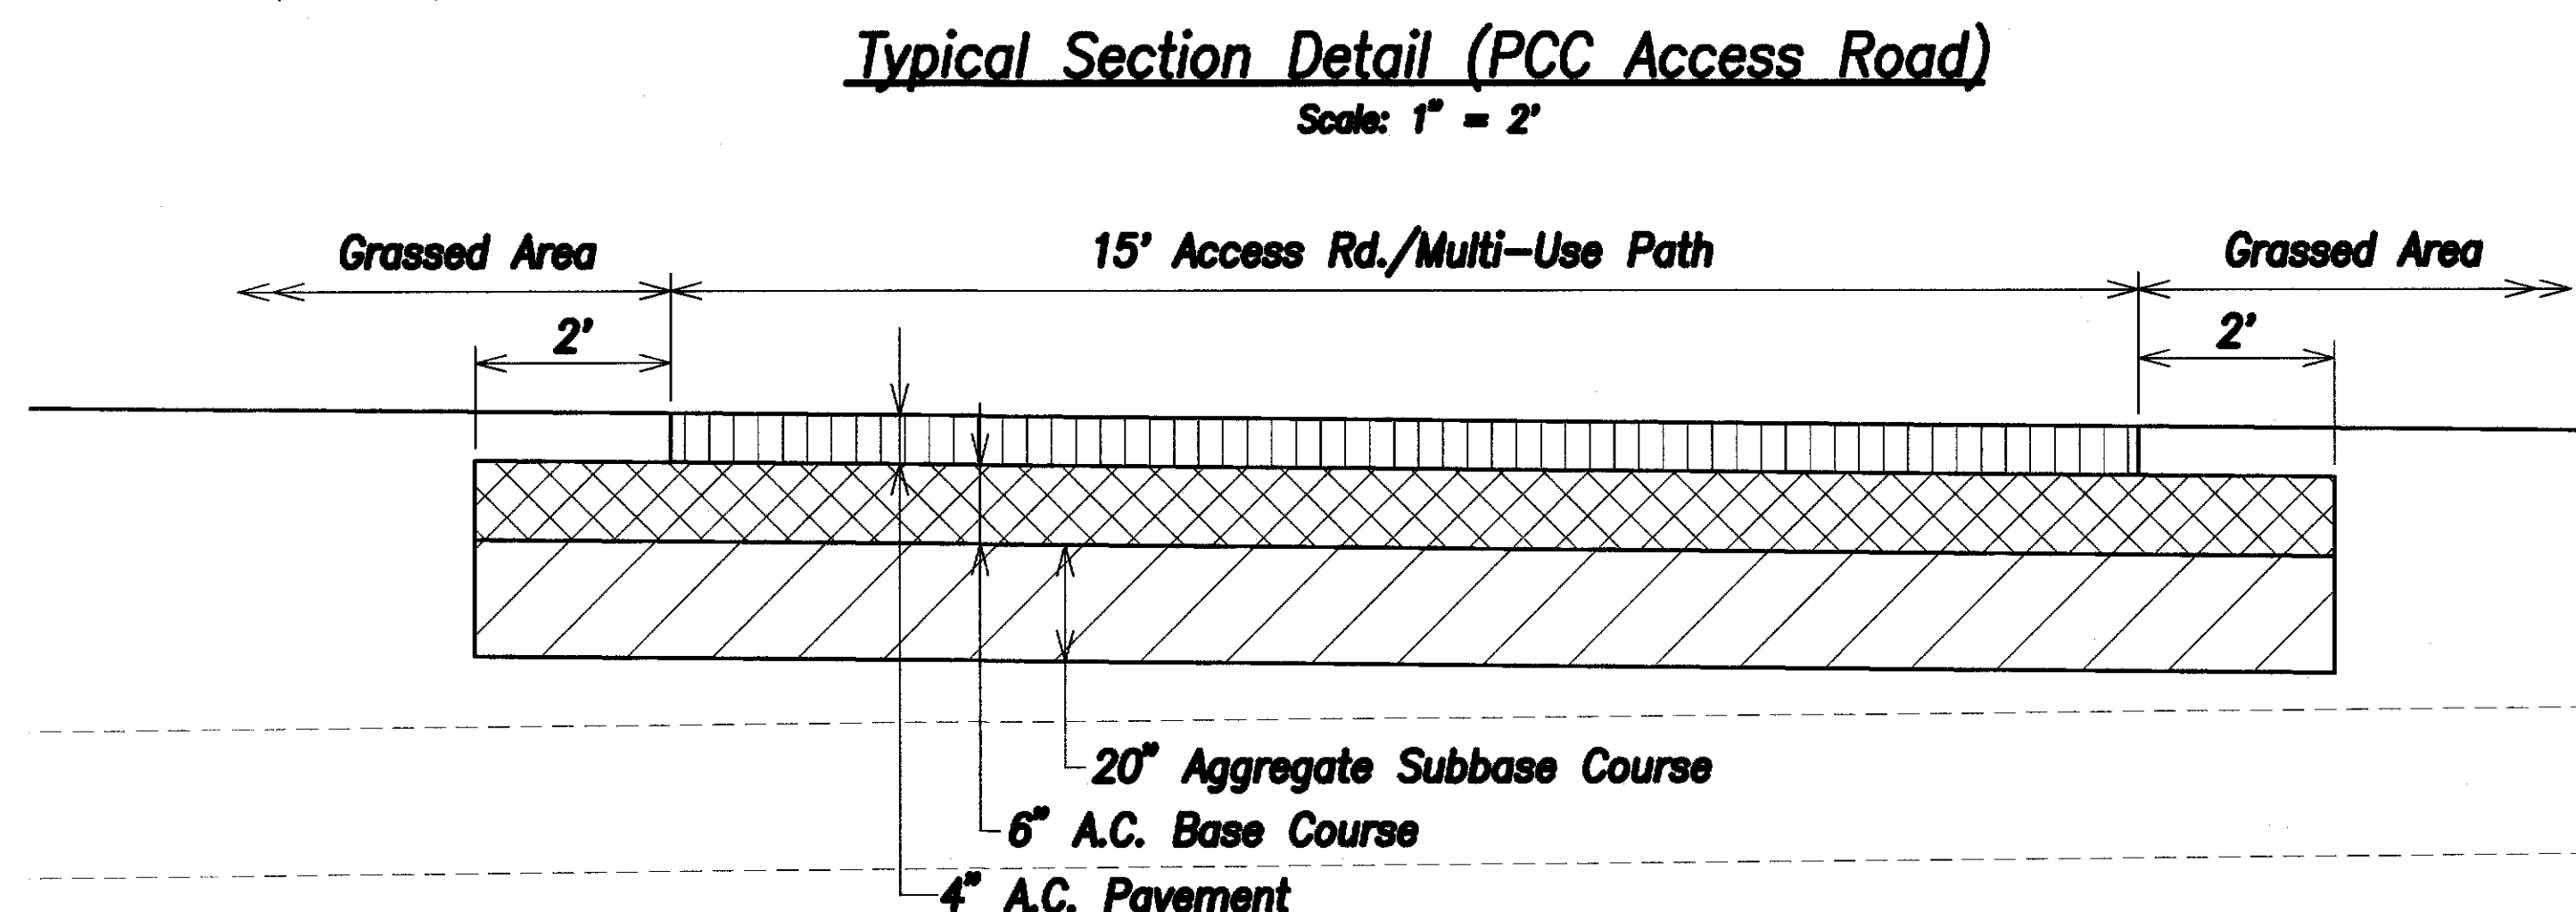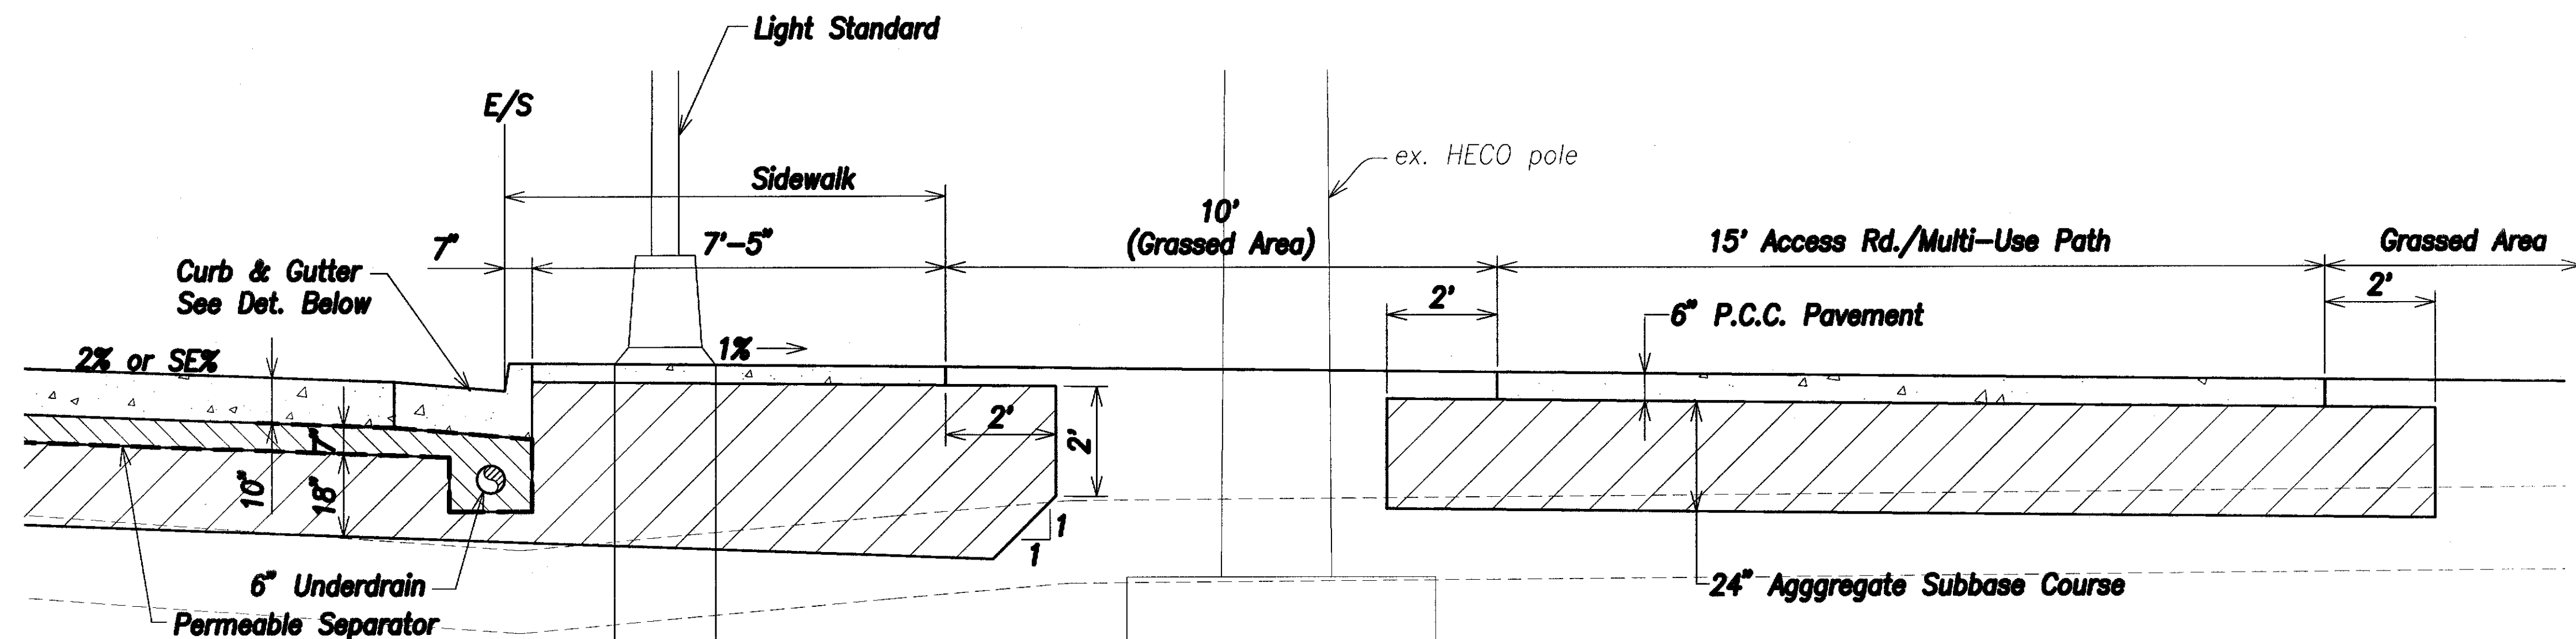

6" UNDERDRAIN AT A.C. STRIP PAVED AREA  
ADDED DETAIL


LEGEND FOR AS-BUILT POSTINGS	
~~~~~	Squiggly line for as-built deletion
100.00	Double line for as-built deletion
Roadway	Text for as-built posting

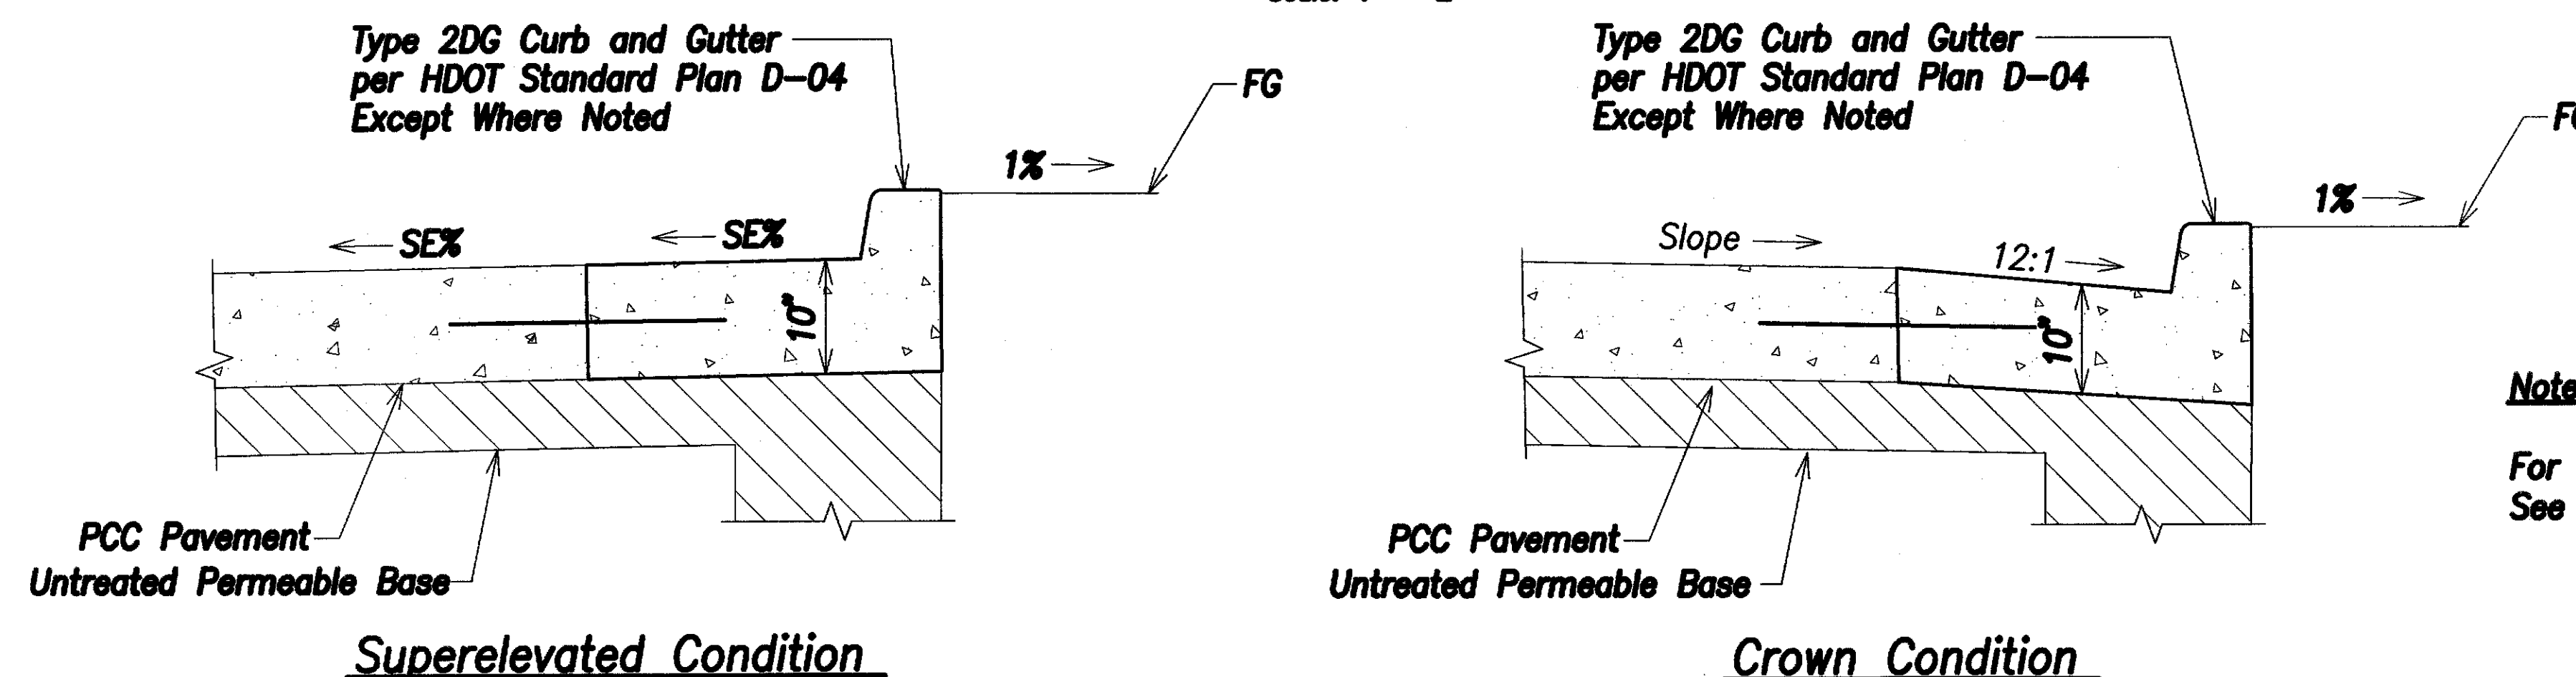

Curb and Gutter Detail
Scale: 1" = 1'


Note:

For Conc. Sidewalk Details, See Sht. C3.2.

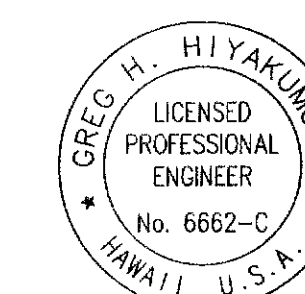

THIS WORK WAS PREPARED BY ME OR UNDER MY SUPERVISION.

SIGNATURE April 30, 2008
EXPIRATION DATE OF THE LICENSE

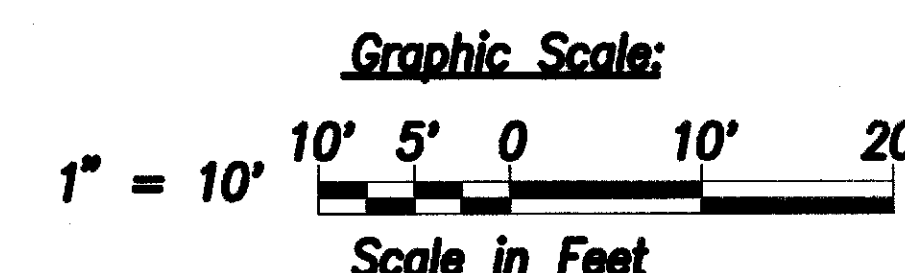

2/17/06	As Built - RFI 17A
DATE	REVISION
As Built - RFI 13A	
DEPARTMENT OF TRANSPORTATION HIGHWAYS DIVISION TYPICAL SECTION DETAILS North-South Road Phase 1A F.A.I. Proj. No. STP-8930(1) Scale: 1" = 10' Date: Dec 22, 2004 SHEET No. C14 OF SHEETS	

"AS-BUILT"