

			ELECTRICAL SYMBOLS		
SYMBOL	DESCRIPTION	SYMBOL	DESCRIPTION	SYMBOL	DESCRIPTION
	Street Light Standard, 250W HPS Luminaire,	<del></del>	Electric/Signal Ductline with Designators; Indicates Duct	S	Concrete Stub-Out Marker, See Detail D/E2.13
•—	Aluminum Pole with Bracket Arm, Transformer Base		Section "A" with "2-2L" Ducts. See Sheets E2.1, E2.2,	5	Note Symbol; See Sheet
	& Concrete Foundation. See Detail Sheets E2.11,	(2-21)	& E2.3 for Duct Sections and Sheet E2.2 for Conduit		
	E2.12, and E2.13		Schedules.	⊢ <b>⊕</b> WP	Junction Box, Weatherproof
•—	Temporary Street Light, 150W HPS Luminaire, See	<b>-</b> 3	Stub, Cap, & Mark Conduits; Provide Pullwire		
Ψ	Detail A/E4.8	——Е——	Electric Ductline		
·	Existing Street Light	SL	Street Light Ductline & Wiring		
×-×-{**)	Remove Existing Street Light		Signal Ductline		
		TS	Traffic Signal Ductline & Wiring		
	HTCO 2' X 4' Handhole				
	HECo 3' X 5' Pullbox	e	Exst Elec/Signal Ductline & Wiring		
X	HECo 5' X 7' Handhole FC #94	sl	Exst Street Light Ductline & Wiring		
lacksquare	HECo 4' X 6' Handhole		Exst Street Light Ductline to be Abandoned In Place		
	HECo Transformer Pad Lot				
	HECo Switch Equipment Pad Lot	e/oh	Exst Elec Overhead Lines		
		t/oh	Exst Signal Overhead Lines to be Removed		
	Traffic Signal Pullbox, Type "A", See Sheet E2.10	,	By HTCo and Catv		
	Traffic Signal Pullbox, Type "B", See Sheet E2.10	et/oh	Exst Elec/Signal Overhead Lines		
	Traffic Signal Pullbox, Type "C", See Sheet E2.10	SL/OH	Overhead Street Light Wiring	UEOC	DECEDENCE ODEOLEIOATIONO
				HECC	REFERENCE SPECIFICATIONS
	WIM Pullbox, Type "C", See Sheet E2.10		Standard Traffic Signal Head	SDEC NO	DESCRIPTION
	Traffic Bearing WIM Pullbox, See Structural Sheets		Standard Traffic Signal and Pedestrian Signal Heads Mounted	<u>SPEC. NO.</u>	DESCRIPTION
				CS7001	Construction of Underground Facilities
	Street Light Pullbox, Type "B", See Sheet E2.10		Programmable Visibility Traffic Signal Head		
	Street Light Pullbox, Type "C", See Sheet E2.10		Traffic Signal Heads Mounted On Mast Arm Standard, See	CS7003	Construction of Electrical Facilities
			Sheet E2.16	007000	
[2]	Existing Street Light Pullbox			CS7202	General Conditions for Construction of Projects
		HO	Pedestrian Pushbutton		110,000
		HO	Farm Vehicle Pushbutton	CS9301	Concrete Work
0	Exst Utility Pole		Vehicle Loop Detector, See Sheet E2.19		
<i>\\\\\\\</i>	Exst Utility Pole to be Removed By Utility Co.			CS9401	Design and Construction of Precast
	Exst Guying and Anchor				Manholes and Handholes
1//////////////////////////////////////	Exst Guying and Anchor to be Removed By	1	State Street Light I.D. Tag, See A/E2.13		
	Respective Utility Co.	M123 C1AB 480V N250 III			
•	35' Wood Pole and Guy, See Detail A/E4.7	STATION NO.		APPROVED	RY•
· 		· · · · · · · · · · · · · · · · · · ·		ALTROVED	
				HAWAIIAN ELEC	CTRIC COMPANY, INC. DATE
					COM DATE
				HAWAIIAN IELC	DATE

FISCAL SHEET DIST. NO. YEAR 2007 CO308 380 STP-8930(4)

FED. ROAD

### HECO REFERENCE DRAWINGS

<u>DWG NO.</u>	<u>DESCRIPTION</u>
16688 Sht. 1 <b>&amp;</b> 2	Details Handholes & Manholes, UG Standards
100904	Handhole Type 611 UG Standard
100925	Manhole Type 614 Structural Details UG Standards
11249	Material Drawing for Concrete Pad System
22–2005	Type. 3 Phase Padmounted TSF Requirements, Commercial Distribution System
30–5000	Location, Clearances and Protection Details, Pad- Mounted Equipment
30–5001	1 Phase Pad Mounted TSF Con— crete Pad URD Installation
30–5011	Concrete Pad For 75 to 300 KVA 3 Phase Padmounted TSF — Conc. Pads, UG Ducts & Structures
Note:	Reference Drawings Referred to in Description of Equip—

ment Schedule.

# THIS WORK WAS PREPARED BY ME OR UNDER MY SUPERVISION.

#### HIGHWAY LIGHT TAG LEGEND:

109+35 – Station Number — Light Pole No., Circuit No., Phase Conn.

— Pole Centerline Offset From Edge of Travelway

(BGR Indicates Behind Guardrail; BSW Indicates Behind Sidewalk,

BC Indicates Behind Curb, TB Indicates Top of Barrier)

— Bracket Arm Length, Light Distribution

— Luminaire Mounting Height Above Travelway NS 2, C3AB 10' 15', III

#### LEGEND FOR AS-BUILT POSTINGS

Squiggly line for as-built deletion Double line for as-built deletion Roadway Text for as-built posting

DATE

DEPARTMENT OF TRANSPORTATION
HIGHWAYS DIVISION

ELECTRICAL SYMBOLS

North-South Road <u>Phase 1C</u> F.A.I. Proj. No. STP-8930(4)

?/??/08 Revised HHs per HECO Scale: AS NOTED REVISION

SHEET No. E0.2 OF 66 SHEETS

Date: Feb 21, 2007

CO308

#### NOTES FOR CONSTRUCTION WITHIN STATE RIGHT-OF-WAY

- 1. The Contractor shall obtain a permit to perform work upon State Highways from the State Highways' District Engineer, at 727 Kakoi Street, prior to commencement of work within the State's Highway Right-of-Way.
- 2. Construction and restoration of all existing Highway facilities within the State's Right-of-Way shall be done in accordance with all applicable Sections of the current Standard Specifications For Road, Bridge and Public Works Construction, and the Specifications for Installation of Miscellaneous Improvements Within State Highway, of the State Highways Division.
- 3. See Contract Documents for Work Hours.
- 4. The Contractor shall provide, install, and maintain all necessary signs, lights, flares, barricades, markers, cones and other protective facilities, and shall take all necessary precautions for the protection, convenience, and safety of public traffic. All such protective facilities and precautions to be taken shall conform with the "Administrative Rules of Hawaii Governing the Use of Traffic Control Devices at Work Sites on or Adjacent to Public Streets and Highways", adopted by the Director of Transportation, and the current U.S. Federal Highways Administration "Manual on Uniform Traffic Control Devices for Streets and Highways, Part VI -Standards and Guides for Traffic Control for Street and Highway Construction, Maintenance, Utility and Incident Management Operations". If lane closures are required during construction, a Traffic Control Plan shall be incorporated into the construction plans and must be approved by the Division prior to issuance of the permit.
- 5. The minimum pavement structure shall consist of:
  - a. Residential Driveways
    - 1) 2" Asphalt Concrete (Mix IV) and 6" Aggregate Base Course, or 2" Asphalt Concrete and 2 1/2" Asphalt Concrete Base Course or Asphalt Concrete.
    - 2) 4" Class "A" Concrete Reinforced with 6" x 6" W2.9 x W2.9 Wire Mesh on 12" Aggregate Subbase, if deemed necessary by the Engineer.
  - b. Commercial Driveways, Sideroads, and Utility Installations on Minor Highways
    - 1) 2 1/2" Asphalt Concrete (Mix IV), 8" Aggregate Base Course and 12" Subbase, or 2 1/2" Asphalt Concrete and 8" Asphalt Concrete Base Course or Asphalt Concrete.
    - 2) 6" of Class "A" Concrete Reinforced with 6" x 6" W2.9 x W2.9 Wire Mesh on 12" Aggregate Subbase, if deemed necessary by the Engineer.
- 6. No material and/or equipment shall be stockpiled or otherwise stored within the Highway right-of-way, except at locations designated in writing and approved by the District Engineer.


- 7. Compaction tests shall be taken in accordance with the Specification's for installation of miscellaneous improvements within State Highways, as follows:
  - a. Subbase:
- One (1) Compaction Test per lift per 100 lineal feet of roadway.

  - b. Base Course: One (1) Compaction Test per lift per 100 lineal feet of roadway.
  - c. One (1) Compaction Test per lift per 300 lineal feet of trench.
- 8. Prior to commencing trench excavation work, the Contractor shall take a profile along the centerline of the proposed utility trench. This information shall be used in the verification of restoring the roadway to its original condition. A copy of the profile shall be submitted to the District Engineer.
- 9. The Contractor shall provide an adequate and safe non-skid bridging material, including shoring, over trenches in pavement areas. The bridging shall be able to support all types of vehicular traffic.
- 10. Unless otherwise noted, no trench shall be opened more than 300 feet in advance of installed and tested pipeline and/or ductline.
- 11. Existing drainage systems shall be functional at all times.
- 12. The Contractor shall exercise care to minimize damages to existing Highway improvements. All damages shall be repaired by the Contractor, at his expense, to the satisfaction of the District Engineer.
- 13. All regulatory, guide, and construction signs and barricades shall have a high—intensity reflective background.
- 14. Driveways shall be kept open unless the Owners of the properties using these rights—of—way are otherwise provided for satisfactorily.
- 15. Where pedestrian walkways exist, they shall be maintained in a safe and passable condition, or other facilities for pedestrians shall be provided. Passages between walkways at intersections shall likewise be provided.
- 16. The Contractor shall reference to the satisfaction of the District Engineer, all existing traffic signs, posts, and pavement markings prior to the commencement of construction. The Contractor shall replace or repair all traffic signs, posts, and pavement markings disturbed by his activities, at his expense, unless directed otherwise by the District Engineer or his representative.
- 17. The Contractor shall exercise care when performing work in or adjacent to the State Highway Right—of—Way. Damages to existing facilities shall be immediately reported to the respective Utility Companies, and/or City or State Agencies. The repair work shall be done at the Contractor's expense.
- 18. The Contractor shall notify the State Highways' Highway Lighting and Traffic Signal Supervisor (834-4581), three (3) working days prior to commencing work.
- 19. Traffic signals shall be kept operational during construction, and if deemed necessary by the District Engineer or his representative, a temporary vehicle detection device shall be installed. All work shall be done in accordance to the require ments of the Department of Transportation Services, City and County of Honolulu, and paid for by the Contractor.

- 20. The Contractor shall notify Oahu Transit Services, Inc. (OTS), Ed Sniffen at 848-4571, or Lowell Tom at 848-4578, two weeks prior to commencing any work. The Contractor shall inform OTS of the location and scope of work, proposed closure of any street or traffic lane, and the need to relocate any bus stop.
- 21. The Permit to perform work upon State Highways may be revoked because of default in any of the following, but not limited to, conditions:
  - a. Work performed before or after permitted hours.
  - b. Failure to maintain roadway surfaces in a smooth and safe condition.
  - c. Failure to clean up construction debris generated from Project work.
  - d. Failure to provide proper traffic control.
  - e. Failure to replace damaged pavement markings and signs.

#### TRAFFIC SIGNALS & TECHNOLOGY NOTES:

- All work shall be done in accordance with the "Standard Specifications for Public Works Construction", September, 1986, of the Department of Public Works, City and County of Honolulu, except as modified herein or in the Special Provisions.
- The Contractor shall verify with the respective Utility Companies and Government Agencies, the locations of all electric, telephone, traffic signal, street light, fire alarm, gas, water, sewer, drain, and other lines crossing the excavation path or in excavation areas.
- Locations of traffic signal conduits shall be staked out by the Contractor and approved by the Engineer prior to any excavation.
- All structures, pavements, utilities, landscaping, and other topographical features shown on the Intersection Drawings are existing and are to remain unless noted or indicated otherwise.
- The Contractor shall notify all affected Utility Companies and Government Agencies of their intent to begin construction on any intersection or street at least two (2) weeks prior to the start of such construction.
- The Contractor may close only one lane of traffic at a time for any reason. during the peak traffic periods from 6:00 to 9:00 a.m. and from 3:00 to 6:00 p.m., Monday through Friday, all lanes shall be kept open and maintained at all times.
- The Contractor shall notify the Traffic Control Branch, Department of Transportation Services, three (3) working days prior to commencing work on the traffic signal system (phone: 523-4589).
- The Contractor shall be responsible for any damages to the existing traffic signal facilities, including the Traffic Signal Interconnecting System. Any and all damages to these facilities shall be repaired by the Contractor at his cost in accordance with the requirements of the City and County of Honolulu.

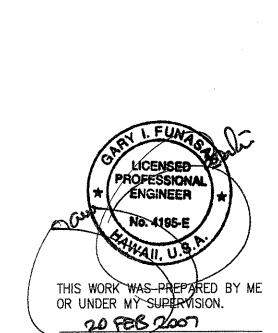

DEPARTMENT OF TRANSPORTATION

STATE NOTES AND MISCELLANEOUS DETAILS

North-South Road Phase 1C F.A.I. Proj. No. STP-8930(4)

Scale: AS NOTED

FED. ROAD

HAW.

DIST. NO.

HAWAII

FISCAL

2007

FED. AID

PROJ. NO.

STP-8930(4)

SHEET

309

TOTAL

SHEETS

380

Date: Feb 21, 2007 SHEET No. E0.3 OF 66 SHEETS

**.** . . . .

REVISION DATE

#### HAWAIIAN ELECTRIC COMPANY (HECO) NOTES

#### 1. LOCATION OF HECO FACILITIES

The location of HECO's overhead and underground facilities shown on the plans are from existing records with varying degrees of accuracy and are not guaranteed as shown. The Contractor shall verify in the field the locations of the facilities and shall exercise proper care in excavating and working in the area. wherever connections of new utilities to existing utilities and utility crossings are shown, the Contractor shall expose the existing lines at the proposed connections and crossings to verify the depths prior to excavation for the new lines. The Contractor shall be responsible for any damages to HECO's facilities whether shown or not shown on the plans.

#### 2. COMPLIANCE WITH HAWAII OCCUPATIONAL SAFETY AND HEALTH LAWS

The Contractor shall comply with the state of Hawaii's Occupational Safety and Health Laws and Regulations, including without limitation, those related to working on or near exposed or energized electrical lines and equipment.

#### 3. EXCAVATION PERMIT

The Contractor shall obtain an excavation permit from HECO's Techinical Division (543—5654) located at 820 Ward Avenue, 4th floor, two weeks prior to starting construction. Please refer to our request number at that time.

#### 4. <u>CAUTION!!! ELECTRICAL HAZARD!!!</u>

Existing HECO overhead and underground lines are energized and will remain energized during construction unless prior special arrangements have been made with HECO. Only HECO personnel are to handle these energized lines and erect temporary guards to protect these lines from damage. The Contractor shall work cautiously at all times to avoid accidents and damage to existing HECO facilities, which can result in electrocution.

#### 5. OVERHEAD LINES

State law (OSHA 1910.269(k)(2B)) requires that a worker and the longest object he or she may contact cannot come closer than a minimum radial clearance of 10 feet when working close to or under any overhead lines rated 50kV and below. For each additional 1kV above 50kV, an additional 0.4 inch shall be added to the 10—foot clearance requirement. The preceding information on line clearance requirements is provided as a convenience and it is the Contractor's responsibility to be informed of and comply with any revisions or amendments to the law.

Should the Contractor anticipate that his work will result in the need to encroach within the minimum required clearance at any time, the Contractor shall notify HECO at least four (4) weeks prior to the planned encroachment so that, if feasible, the necessary protections (e.g. relocate, de-energize, or blanket HECO lines) can be put in place. HECO's cost of safeguarding its lines will be charged to the Contractor.

Contact HECO's Customer Installations Department at 543—7846 for assistance in identifying and safeguarding overhead power lines.

Refer to Section X of HECO's Electric Service Installation Manual for additional guidelines when working around HECO's facilities. A copy may be obtained from HECO's Customer Installations Department.

#### 6. POLE BRACING

A minimum clearance of 10 feet must be maintained when excavating around utility poles and/or their anchor system to prevent weakening or pole support failure. Should work require excavating within 10 feet of a pole and/or its anchor system, the Contractor shall protect, support, secure, and take all other precautions to prevent damage to or leaning of these poles. The Contractor is responsible for all associated costs to brace, repair, or straighten poles. All means of structural support for the pole proposed by the Contractor shall first be reviewed by HECO before implementation. For pole bracing instructions, the Contractor shall call the HECO Construction and Maintenance Dept., Customer & System Superintendent at 543–4223 a minimum of two (2) weeks in advance.

#### 7. UNDERGROUND LINES

The Contractor shall exercise extreme caution whenever construction crosses or is in close proximity of underground lines. HECO's existing electrical cables are energized and will remain energized during construction. Only HECO personnel are to break into existing HECO facilities, handle these cables, and erect temporary guards to protect these cables from damage. The cost of HECO's assistance in providing proper support and protection of its underground lines will be charged to the Contractor. Special precautions are required when excavating near HECO's 138kV underground lines (see HECO Instructions to Consultants/Contractors on "excavation near HECO's underground 138kV lines" for detailed requirements).

For verification of underground lines, the Contractor shall call HECO's Underground Division at 543-7049 a minimum of 72 hours in advance.

For assistance in providing proper support and protection of these lines, the Contractor shall call HECO's Construction & Maintenance Dept., Customer & System Superintendent, at 543—4223, a minimum of two (2) weeks in advance.

#### 8. UNDERGROUND FUEL PIPELINES

The Contractor shall exercise extreme caution whenever construction crosses or is in close proximity of HECO's underground fuel oil pipelines. Special precautions are required when excavating near HECO's underground fuel oil pipelines (see HECO Instructions to Consultants/Contractors on "excavation near HECO's underground fuel pipelines" for detailed requirements).

#### 9. EXCAVATIONS

When trench excavation is adjacent to or beneath HECO's existing structures or facilities, the Contractor is responsible for:

- a) sheeting and bracing the excavation and stabilizing the existing ground to render it safe and secure and to prevent possible slides, cave—ins, and settlements.
- b) properly supporting existing structures or facilities with beams, struts, or under-pinnings to fully protect it from damage.
- c) backfilling with proper backfill material including special thermal backfill where existing (refer to Engineering Department for thermal backfill specifications).

#### 10. RELOCATION OF HECO FACILITIES

Any work required to relocate or modify HECO facilities shall be done by HECO, or by the Contractor under HECO's supervision. The Contractor shall be responsible for all coordination, and shall provide necessary support for HECO's work, which may include, but not be limited to, excavation and backfill, permits and traffic control, barricading, and restoration of pavement, sidewalks, and other facilities.

All costs associated with any relocation or modification (either temporary or permanent) for the convenience of the Contractor, or to enable the Contractor to perform his work in a safe and expeditious manner in fulfilling his contract obligations shall be borne by the Contractor.


#### 11. CONFLICTS

Any redesign or relocation of HECO's facilities not shown on the plans may be cause for lengthy delays. The Contractor acknowledges that HECO is not responsible for any delay or damage that may arise as a result of any conflicts discovered or identified with respect to the location or construction of HECO's electrical facilities in the field, regardless of whether the Contractor has met the requested minimum advance notices. In order to minimize any delay or impact arising from such conflicts, HECO should be notified immediately upon discovery or identification of such conflict.

#### 12. <u>DAMAGE TO HECO FACILITIES</u>

The Contractor shall be responsible for the protection of all HECO surface and subsurface utilities and shall be responsible for any damages to HECO's facilities as a result of his operations. The Contractor shall immediately report such damages to HECO's Trouble Dispatcher at 548–7961. Repair work shall be done by HECO or by the Contractor under HECO's supervision costs for damages to HECO's facilities shall be borne by the Contractor.

In case of damage or suspected damage to HECO's fuel pipeline, the Contractor shall immediately notify HECO's Honolulu Power Plant Shift Supervisor at 533-2102 (a 24-hour number) so HECO personnel can secure the damaged section and report any oil spills to the proper authorities. all costs associated with the damage, repair, and oil spill cleanup shall be borne by the Contractor.

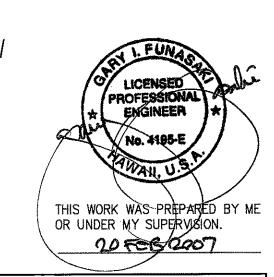

DEPARTMENT OF TRANSPORTATION
HIGHWAYS DIVISION

HECO NOTES 1

<u>North-South Road</u> <u>Phase 1C</u> F.A.I. Proj. No. STP-8930(4)

DATE REVISION

AS NOTED Date: Feb 21, 2007

SHEET No. EO.4 OF 66 SHEETS

FED. ROAD DIST. NO.	STATE	FED. AID PROJ. NO.	FISCAL YEAR	SHEET NO.	TOTAL SHEETS
HAWAII	HAW.	STP-8930(4)	2007	311	380

#### HAWAIIAN ELECTRIC COMPANY (HECO) NOTES CONT.

#### 13. <u>HECO STAND-BY PERSONNEL</u>

The Contractor may request HECO to provide an inspector to stand—by during construction near HECO's facilities. The cost of such inspection will be charged to the Contractor.

The Contractor shall call the HECO Construction and Maintenance Dept., Customer & System Superintendent at 543-4223 a minimum of 5 working days in advance to arrange for HECO stand—by personnel.

#### 14. CLEARANCES

The following clearances shall be maintained between HECO's ductline and all adjacent structures (charted and uncharted) in the trench:

Structure Type	Minimum Clearance(inches)
Water Lines, Parallel	36 (a)
Water Lines, Crossing	12 (b)
Sewer Lines, Parallel	36 (c)
Sewer Lines, Crossing	24 (d)
Drain Lines, Parallel	12
Drain Lines, Crossing	6 (e)
Electrical and Gas Lines, Parallel	12
Electrical and Gas Lines, Crossing	12
Telephone Lines, Parallel	6 (e)
Telephone Lines, Crossing	6 (e)
Chevron Oil Lines, Parallel	36
Chevron Oil Lines, Crossing	48 below oil line (f)

- (a) The minimum horizontal clearances to water lines parallel to electrical ductlines must be increased to 60 inches if the water line is greater than 16 inches in diameter
- (b) The minimum vertical clearances to water lines crossing electrical ductlines can be reduced to 6 inches if the electrical ductline structure is concrete encased and is below the water line and the water line is less than 16 inches in diameter.
- (c) A minimum horizontal clerance of 36 inches is required between new handholes and existing sewer laterals.
- (d) The minimum vertical clearances to sewer pipes crossing electrical ductlines can be reduced to 12 inches if the sewer pipe is jacketed in concrete.
- (e) The minimum clearances shall be increased to 12 inches if the electrical ductline is direct buried.
- (f) The minimum vertical clearances to oil lines crossing electrical ductlines can be reduced to 24 inches below oil lines if the crossings are encased in 6 inches of concrete.

The Contractor shall notify the Engineer & HECO of any heat sources (power cable duct bank, steamline, etc.) encountered that are not properly identified on the drawing.

The following clearance shall be maintained between HECO's fuel oil pipelines and all adjacent structures: 24-inches, parallel or crossing. The minimum clearance can be reduced to 12 inches (parallel and below only) if the structure is jacketed in concrete.

#### 15. <u>INDEMNITY</u>

The Contractor shall indemnify, defend and hold harmless HECO from and against all losses, damages, claims, and actions, including but not limited to reasonable attorney's fees and costs based upon or arising out of damage to property or injuries to persons, or other tortious acts caused or contributed to by Contractor or anyone acting under its direction or control or on its behalf; provided Contractor's indemnity shall not be applicable to any liability based upon the sole negligence of HECO.

#### 16. <u>SCHEDULE</u>

Contractor shall furnish his construction schedule 45 working days prior to starting work on HECO facilities. Contractor shall give HECO, in writing, 40 working days notice to proceed with HECO's portion of work.

#### 17. <u>AUTHORITY</u>

All construction, restoration work, and inspection shall be subject to whichever governmental agency has authority over the work.

#### 18. <u>SPECIFICATIONS</u>

Construction of HECO's underground facilities shall be constructed in accordance with the latest revisions of HECO Specifications CS7001, CS7003, CS7202, CS9301, and CS9401 and applicable HECO Standards.

#### 19. <u>CONSTRUCTION</u>

Contractor shall furnish all labor, materials, equipment, and services to properly perform and fully complete all work shown on the contract, drawings, and specifications. All materials shall be new and manufactured in the United States of America. All manhole, handhole, and ductline installations shall be inspected and approved by HECO prior to excavation and prior to placing concrete. Contractor shall notify HECO's Inspection Division at 543-4356 at least 48 hours prior to placing concrete.

Contractor to coordinate work to break into HECO's existing electrical facilities with HECO's Underground Division at 543-7871 at least 10 working days in advance.

#### <u>STAKEOUT</u>

The Contractor shall arrange for toneouts of all underground facilities and shall stakeout all proposed HECO facilities within the project area so as to not conflict with any utility (existing or proposed) and any proposed construction or improvement work for verification by HECO before proceeding with HECO work.

#### 21. <u>DUCTLINES</u>


All ductline installations shall be PVC Schedule 40 encased in concrete, unless otherwise noted. All completed ductlines shall be mandrel tested by the Contractor in the presence of HECO's inspector using HECO's Standard Practice. The Contractor shall install a 1/8" polyolefin pull line in all completed ductlines after mandrel testing is complete.

#### 22. JOINT POLE REMOVAL

The last joint pole occupant off the poles shall remove the poles.

#### 23. AS-BUILT PLANS

The Contractor shall provide HECO with two sets of as-built reproducible tracings showing the offsets, stationing, and vertical elevation of the duct line(s) constructed.

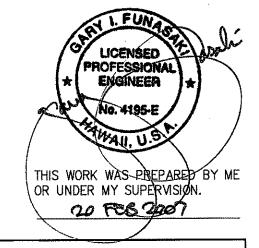

DEPARTMENT OF TRANSPORTATION <u>HECO NOTES II</u>

North-South Road <u>Phase 1C</u> F.A.I. Proj. No. STP-8930(4)


Scale: AS NOTED

REVISION

DATE

Date: Feb 21, 2007

SHEET No. EO.5 OF 66 SHEETS

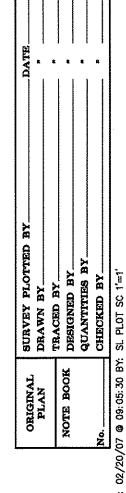

#### Hawaiian Telcom (HTCO) Notes

- 1. The Contractor shall procure and pay for all licenses and permits and shall give all notices necessary and incident to the due and lawful prosecution of the work.
- 2. The Contractor shall obtain an excavation permit and toning request from Hawaiian Telcom's Excavation Permit Section located at 3239 Ualena St., 3rd flr., two weeks prior to the start of construction. Hours of business are: 8:00 am to 11:00 am and 12:00 pm to 3:30 pm Monday thru Friday, except holidays.
- 3. Prior to the excavation of the ductline, the Contractor shall request Hawaiian Telcom to locate existing ductline wherever required. For underground cable locating and marking, Five (5) working days advance notice is required. Three (3) working days advance notice is required for any inspection by a designated representative.
- 4. The location of existing utilities are approximate only. the contractor shall exercise extreme caution and shall maintain proper clearances whenever construction crosses or is in close proximity of Hawaiian Telcom facilities. The Contractor shall verify their location and shall be liable for any damages to Hawaiian Telcom facilities. Any damages shall be reported immediately to Hawaiian Telcom's Repair Section at #611 (24 hours) or to the Excavation Permit Section at 840–1444 (normal working hours, Monday through Friday, except holidays). As a result of his operations, adjustments to the new ductline alignment, if required, shall be made to provide required clearances.
- 5. The Contractor shall take necessary precaution not to damage existing cables or ducts. A Hawaiian Telcom inspector or designated representative is required to be at any job site whenever there will be breakage into or entry into any structure that contain Hawaiian Telcom facilities. Temporary cable and duct supports shall be provided whenever necessary.
- 6. The Contractor shall notify Hawaiian Telcom's inspector or designated representative a minimum of 72 hours prior to excavation, bracing or backfilling of Hawaiian Telcom's structures or facilities.
- 7. All applicable construction work shall be done in accordance with the "Hawaiian Telcom Standard Specifications for Placing Underground Telephone Systems" dated March 1999. All subsequent amendments and addition, and all other pertinent standard for telephone construction. Contractor shall familiarize his personnel by obtaining applicable specifications.
- 8. When excavation is adjacent to or beneath Hawaiian Telcom's existing structures or facilities, the Contractor shall:
  - a) Sheet and/or brace the excavation to prevent slides, cave—ins or settlement ensuring no movement to Hawaiian Telcom's structures or facilities.
  - b) Protect existing structures and/or facilities with beams, struts or underpinnings while excavating beneath them to ensure no movement to Hawaiian Telcom's structures or facilities.
- 9. The Contractor shall brace all poles or light standard near the new ductline, manhole, or handhole during his operations.
- 10. The Contractor shall saw—cut A.C. pavement and concrete gutter wherever new manholes, handholes, or ductlines are to be placed and shall restore to existing condition or better.


- 11. After ductline has been completed, a mandrel with a square front not less than 12" long and having a diameter of 1/4" less than the inside diameter of the duct, shall be pulled through each duct after which a brush with stiff bristles shall be pulled through to make certain that no particles of earth, sand or gravel have been left inside. Ducts shall be completely dry and clean.
- 12. All ducts and conduits shall have an 1800# polyester mule—tape (NEPTCO, WP1800P, Hawaiian Telcom Material Code No. 571154) installed throughout its entire length. All ducts shall be capped to prevent entry of foreign material during construction and at the completion of installation.
- 3. The Contractor shall comply with the policy adopted by the Department of Public Works, City and County of Honolulu, concerning the replacement of concrete sidewalks after excavation work.
- 14. The underground pipes, cables or ductlines known to exist by the Engineer from his search of records are indicated on the plans. The Contractor shall verify the locations and depth of the facilities and exercise proper care in excavating in the area. Wherever connections of new utilities to existing utilities are shown on the plans, the Contractor shall expose the existing line at the proposed connections to verify their locations and depth prior to excavation for the new lines.
- 5. Wherever connections to existing utilities are shown on the plans, the Contractor shall expose the existing lines prior to excavation of the main trenches to verify their locations and depths.
- 16. The Contractor, at his own expense, shall keep the project and surrounding area free from dust nuisance. The cost for supplementary measures, which will be required by the City and County, shall be borne by the Contractor.
- 17. The Contractor shall pump all manholes dry during final inspection.
- 8. The Contractor shall notify Hawaiian Telcom inspector 24 hours prior to pouring of concrete or backfilling.
- 19. When connecting to manhole walls, all existing reinforcing bars shall be left intact. Ducts shall be adjusted in the field in order to clear reinforcing.
- 20. The Contractor shall be responsible for laying out all required lines and grades and shall preserve all bench marks and working points necessary to lay out the work correctly. The new ductline shall be adjusted by the contractor to suit the existing conditions and the details as described in the plans.
- 21. Minimum concrete strength shall be: for ductline, 2500 psi at 28 days for manhole, 3000 psi at 28 days or as specified in design notes
- 22. Bends in the duct alignment, due to changes in grade shall have a minimum radius of 25 feet. All 90 degree c—bends at a pole or at the building floor slab penetration, shall have a bend radius of ten times the diameter of the duct or greater.

APPROVE	) RY·
ALLUATI	, DI.

HAWAIIAN	TELCOM	DA

FED. ROAD DIST. NO. STATE FED. AID PROJ. NO. FISCAL SHEET NO. SHEETS

HAWAII HAW. STP-8930(4) 2007 312 380

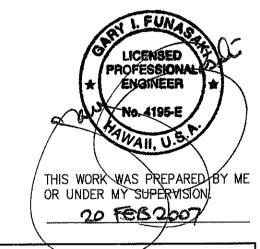

DEPARTMENT OF TRANSPORTATION
HIGHWAYS DIVISION

HTCO NOTES

<u>North-South Road</u> <u>Phase 1C</u> F.A.I. Proj. No. STP-8930(4)


Scale: AS NOTED


Date: Feb 21, 2007


REVISION

DATE

SHEET No. EO.6 OF 66 SHEETS

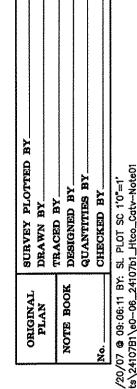


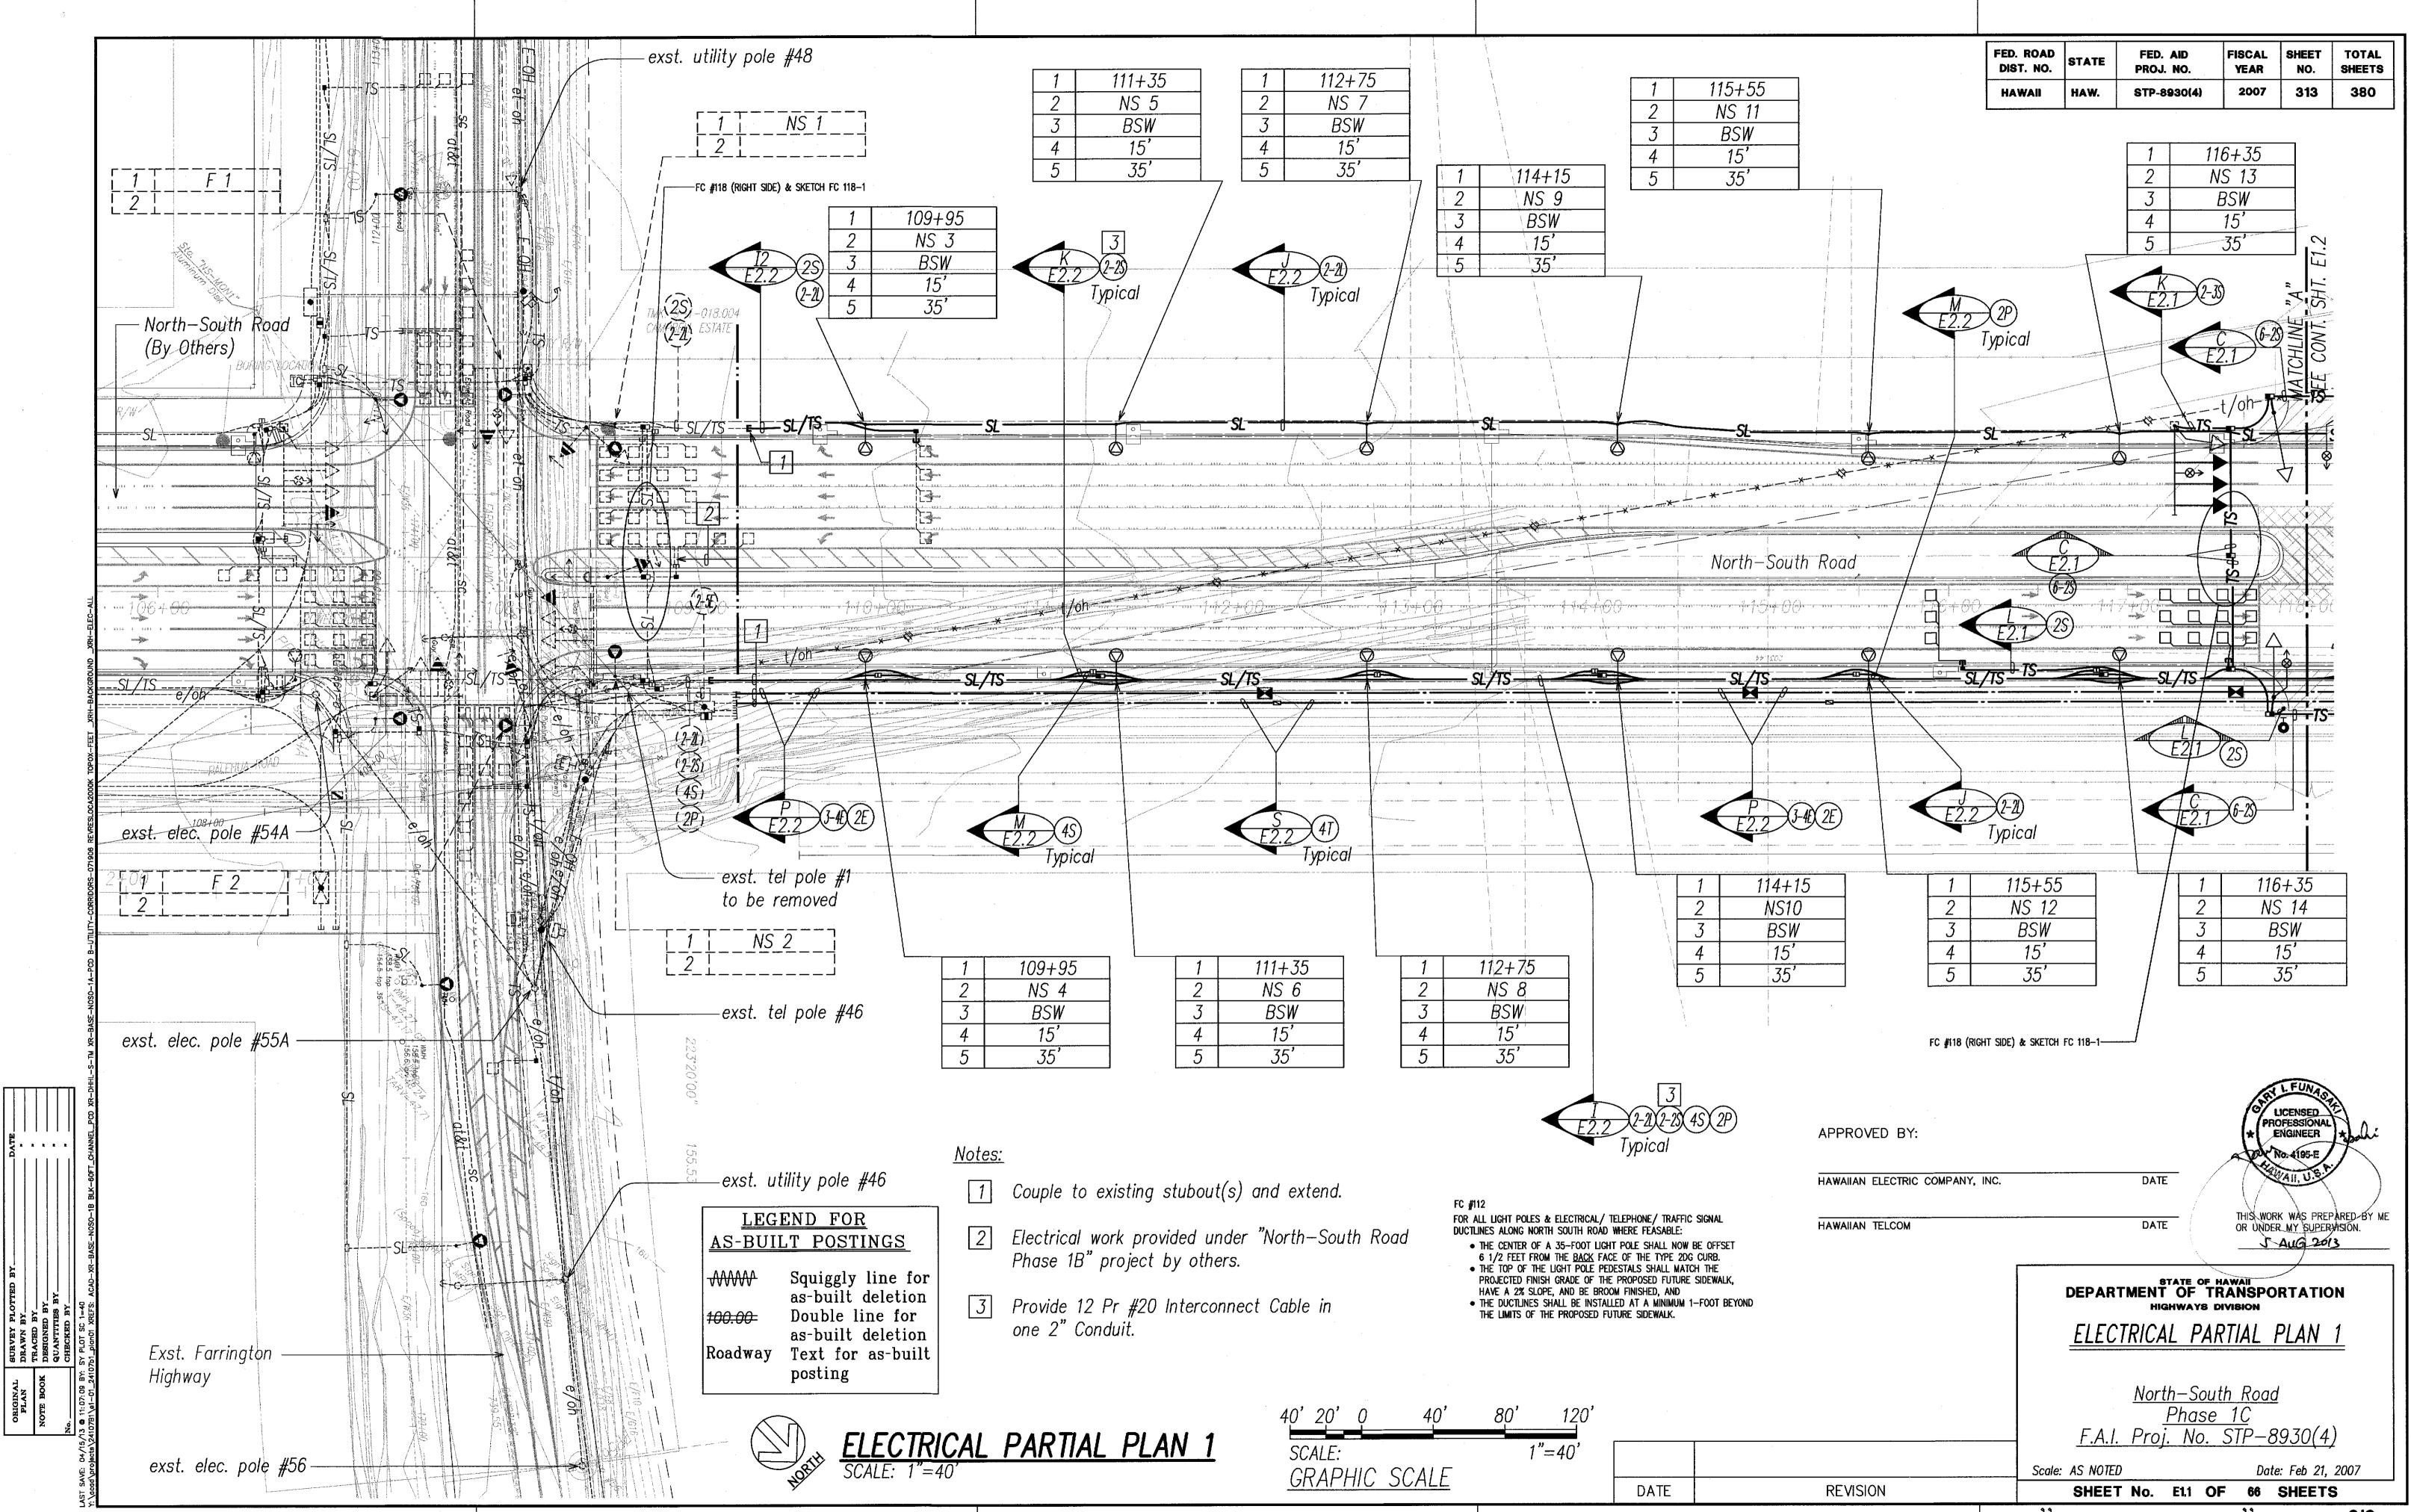


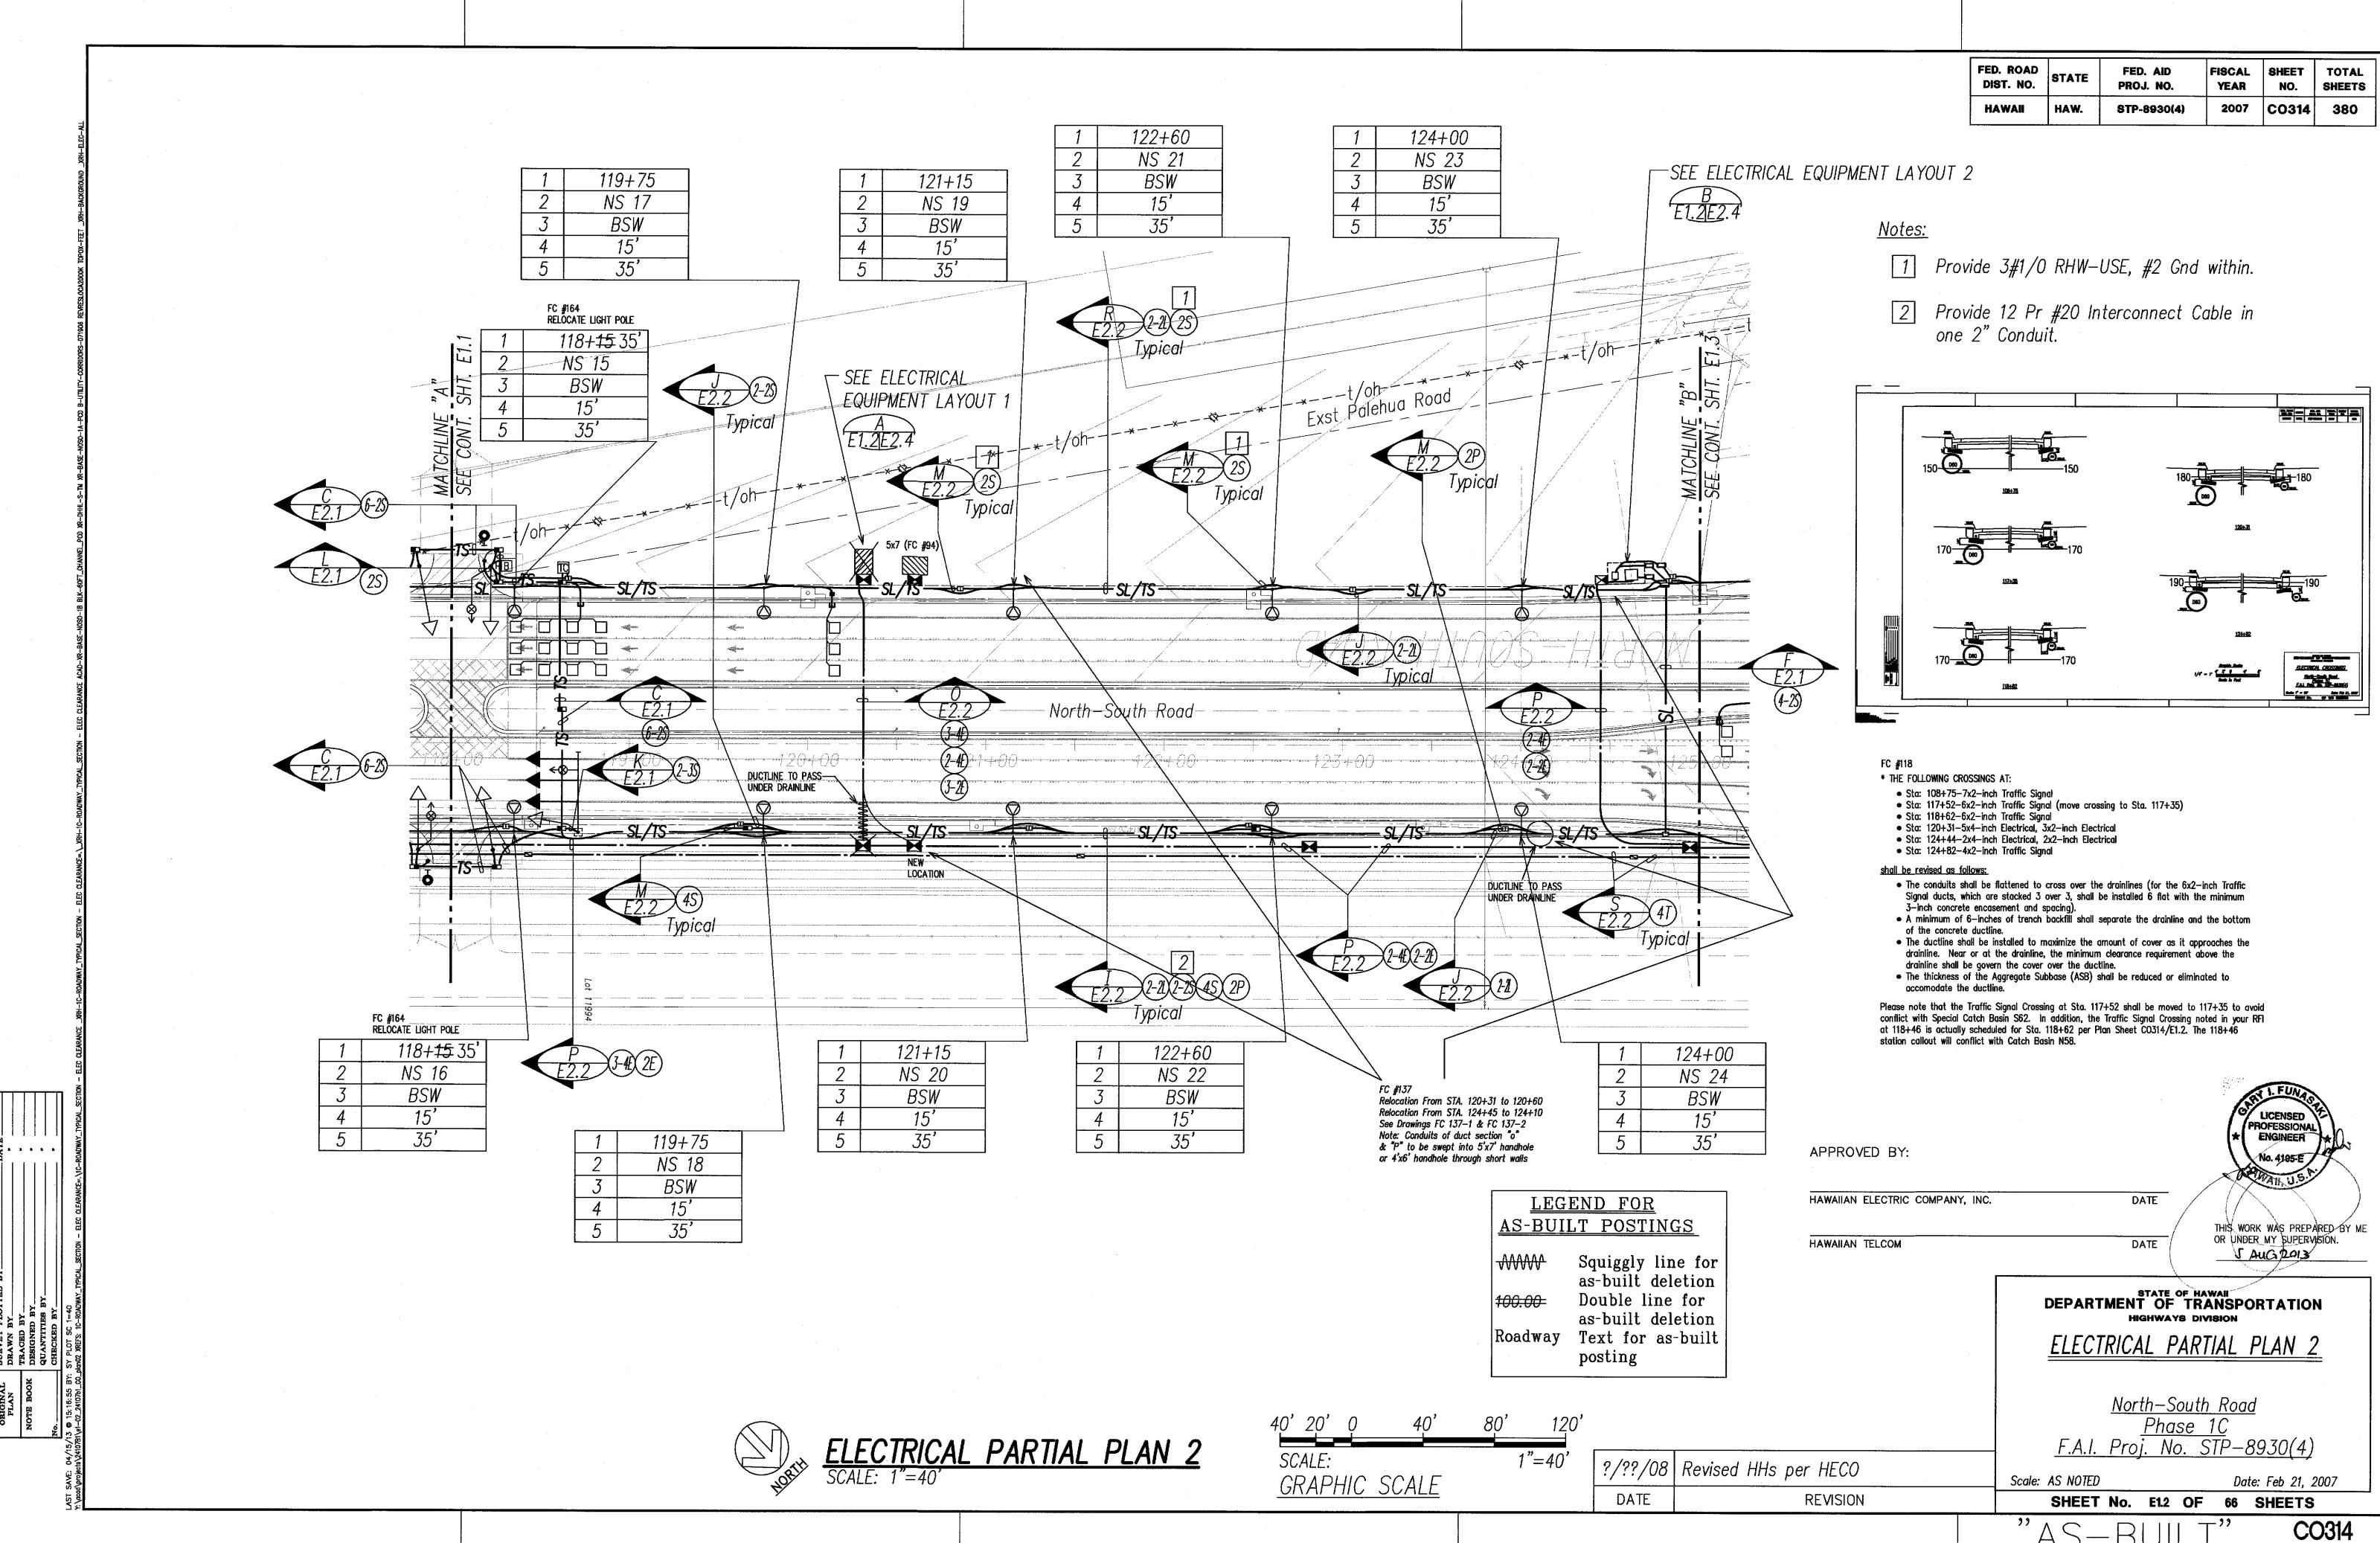



FC #144
TYPE B PULLBOX ELIMINATION ACCEPTABLE © STA 208+14 IF: ALL 3 PHASE OF CIRCUIT C2 SHALL BE EXTENDED INTO THE LIGHT STANDARD TRANSFORMER BASE


• UNCONNECTED PHASE OF CIRCUIT TO BE TERMINATED & CAPPED. RELOCATION OF CABLE SPLICING TO TRANSFORMER BASE OF HWY LIGHT H1 • 2" CONDUIT TO BE ADDED FOR FUTURE CIRCULIT EXTENSION. SPARE CONDUIT TO BE DIRECTED TOWARD PALEHUA BRIDGE, EXTENDING MIN. DISTANCE OF 5' FROM LIGHT STD FOUNDATION. (2-25) (4S) (2P) (2-2E) H1 341\* \_\_\_\_M3\_\_ FED. ROAD FISCAL SHEET TOTAL YEAR NO. SHEETS FED. AID DIST. NO. PROJ. NO. 213+80 211+97 206+39 -MATCHLINE "C" 2007 ADD. 315 380 IIAWAH HAW. STP-8930(4) H1 335, C4AB 2 H1 337, C2AB H1 341, C2BC SEE CONT. SHT. E1.4 H1 343 Remove Exst Street Light and Foundation after New Lighting *35*′ *35*′ 204+54 System is Operational. 2 H1 343, C4AC 2 Remove Exst Wiring and Pullboxes, Abandon Exst Conduits in Place. *35*′ Provide 12 Pr #20 Interconnect Cable \* \* - + - × - instance \*2 Conduist -208+19 131+53 131+53 Provide 3#1, #2 Gnd within (TS). 210+19 2 H1 339A, C2AB REVISED STATION FC #158 210+19 2 NS 33, C4AC **Underpass** NS 34, C2AC 2 H1 340, C2AC Provide 3#4/0, #2 Gnd within (WIM). 2 H1 339, C4AC H1 344 BSW 12<del>9</del>+60 M5 NS 32, C4AC BSW Interstate H-1 Freeway FROM UNDER PASS LIGHTING JUNCTION BOXES, UNDER BRIDGES, H1 335<sup>^</sup> ADJ. HWY = GRS CONDUIT, EXPOSED 204+54 ONDUIT TO BURIED ENCASED (CONCRETE)  $C^*$ CONDUIT = SCH 40 PVC. 2 H1 344, C2BC H1 342\* 206+39 208+19 2 H1 342, C4AB 2 H1 340A, C4BC 1 H1 336\* 2 KY3 \* H1 338 15' 213+80 2 H1 336, C2BC 126+60 128+20/ 1 1 H1 340 / 1/20 -211+97 NS 31, C2AC NS 30, C2AB 128+20 2 H1 338, C4BO M5\_/\* BSW BSW NS 29, C4AB 15 15' BSW TR Ace-141 (Pk Nail) Elev=203.00 35' 0+91 D1/D2, C4AB (-)5+22 C4, C4AC 4+65 D4, C2BC (-)1+14(-)3+50 C1, C2AB C3, C2AC BC 16'/ 35' 2+73 15'/ D3, C4BC 35'/ 126+80 (FC #65: 1ST. SUPPLEMENT) -1+91 O/S 55' (FROM BASELINE) NS 28, C4AB -1-4 126+80 BSW C2, C4AB Exst Palehua Raod 2 NS 27, C2/AB APPROVED BY: BSW/ HAWAIIAN ELECTRIC COMPANY, INC. /35' THIS WORK WAS PREPARED BY ME OR UNDER MY SUPERVISION. LEGEND FOR HAWAIIAN TELCOM AS-BUILT POSTINGS 125+40 DEPARTMENT OF TRANSPORTATION
HIGHWAYS DIVISION NS 26, C3AB Squiggly line for as-built deletion 125+40 BSW NS 25, C1AB 15' ELECTRICAL PARTIAL PLAN 3 Double line for BSW as-built deletion *15'* / Roadway Text for as-built *35*′ posting North-South Road <u>Phase 1C</u> ELECTRICAL PARTIAL PLAN 3
SCALE: 1"=40" F.A.I. Proj. No. STP-8930(4) SCALE: 4/20/07 \(\frac{1}{2\infty}\) Revised Lighting Scale: AS NOTED Date: Feb 21, 2007 GRAPHIC SCALE DATE REVISION SHEET No. E1.3 OF 66 SHEETS ADD. 315

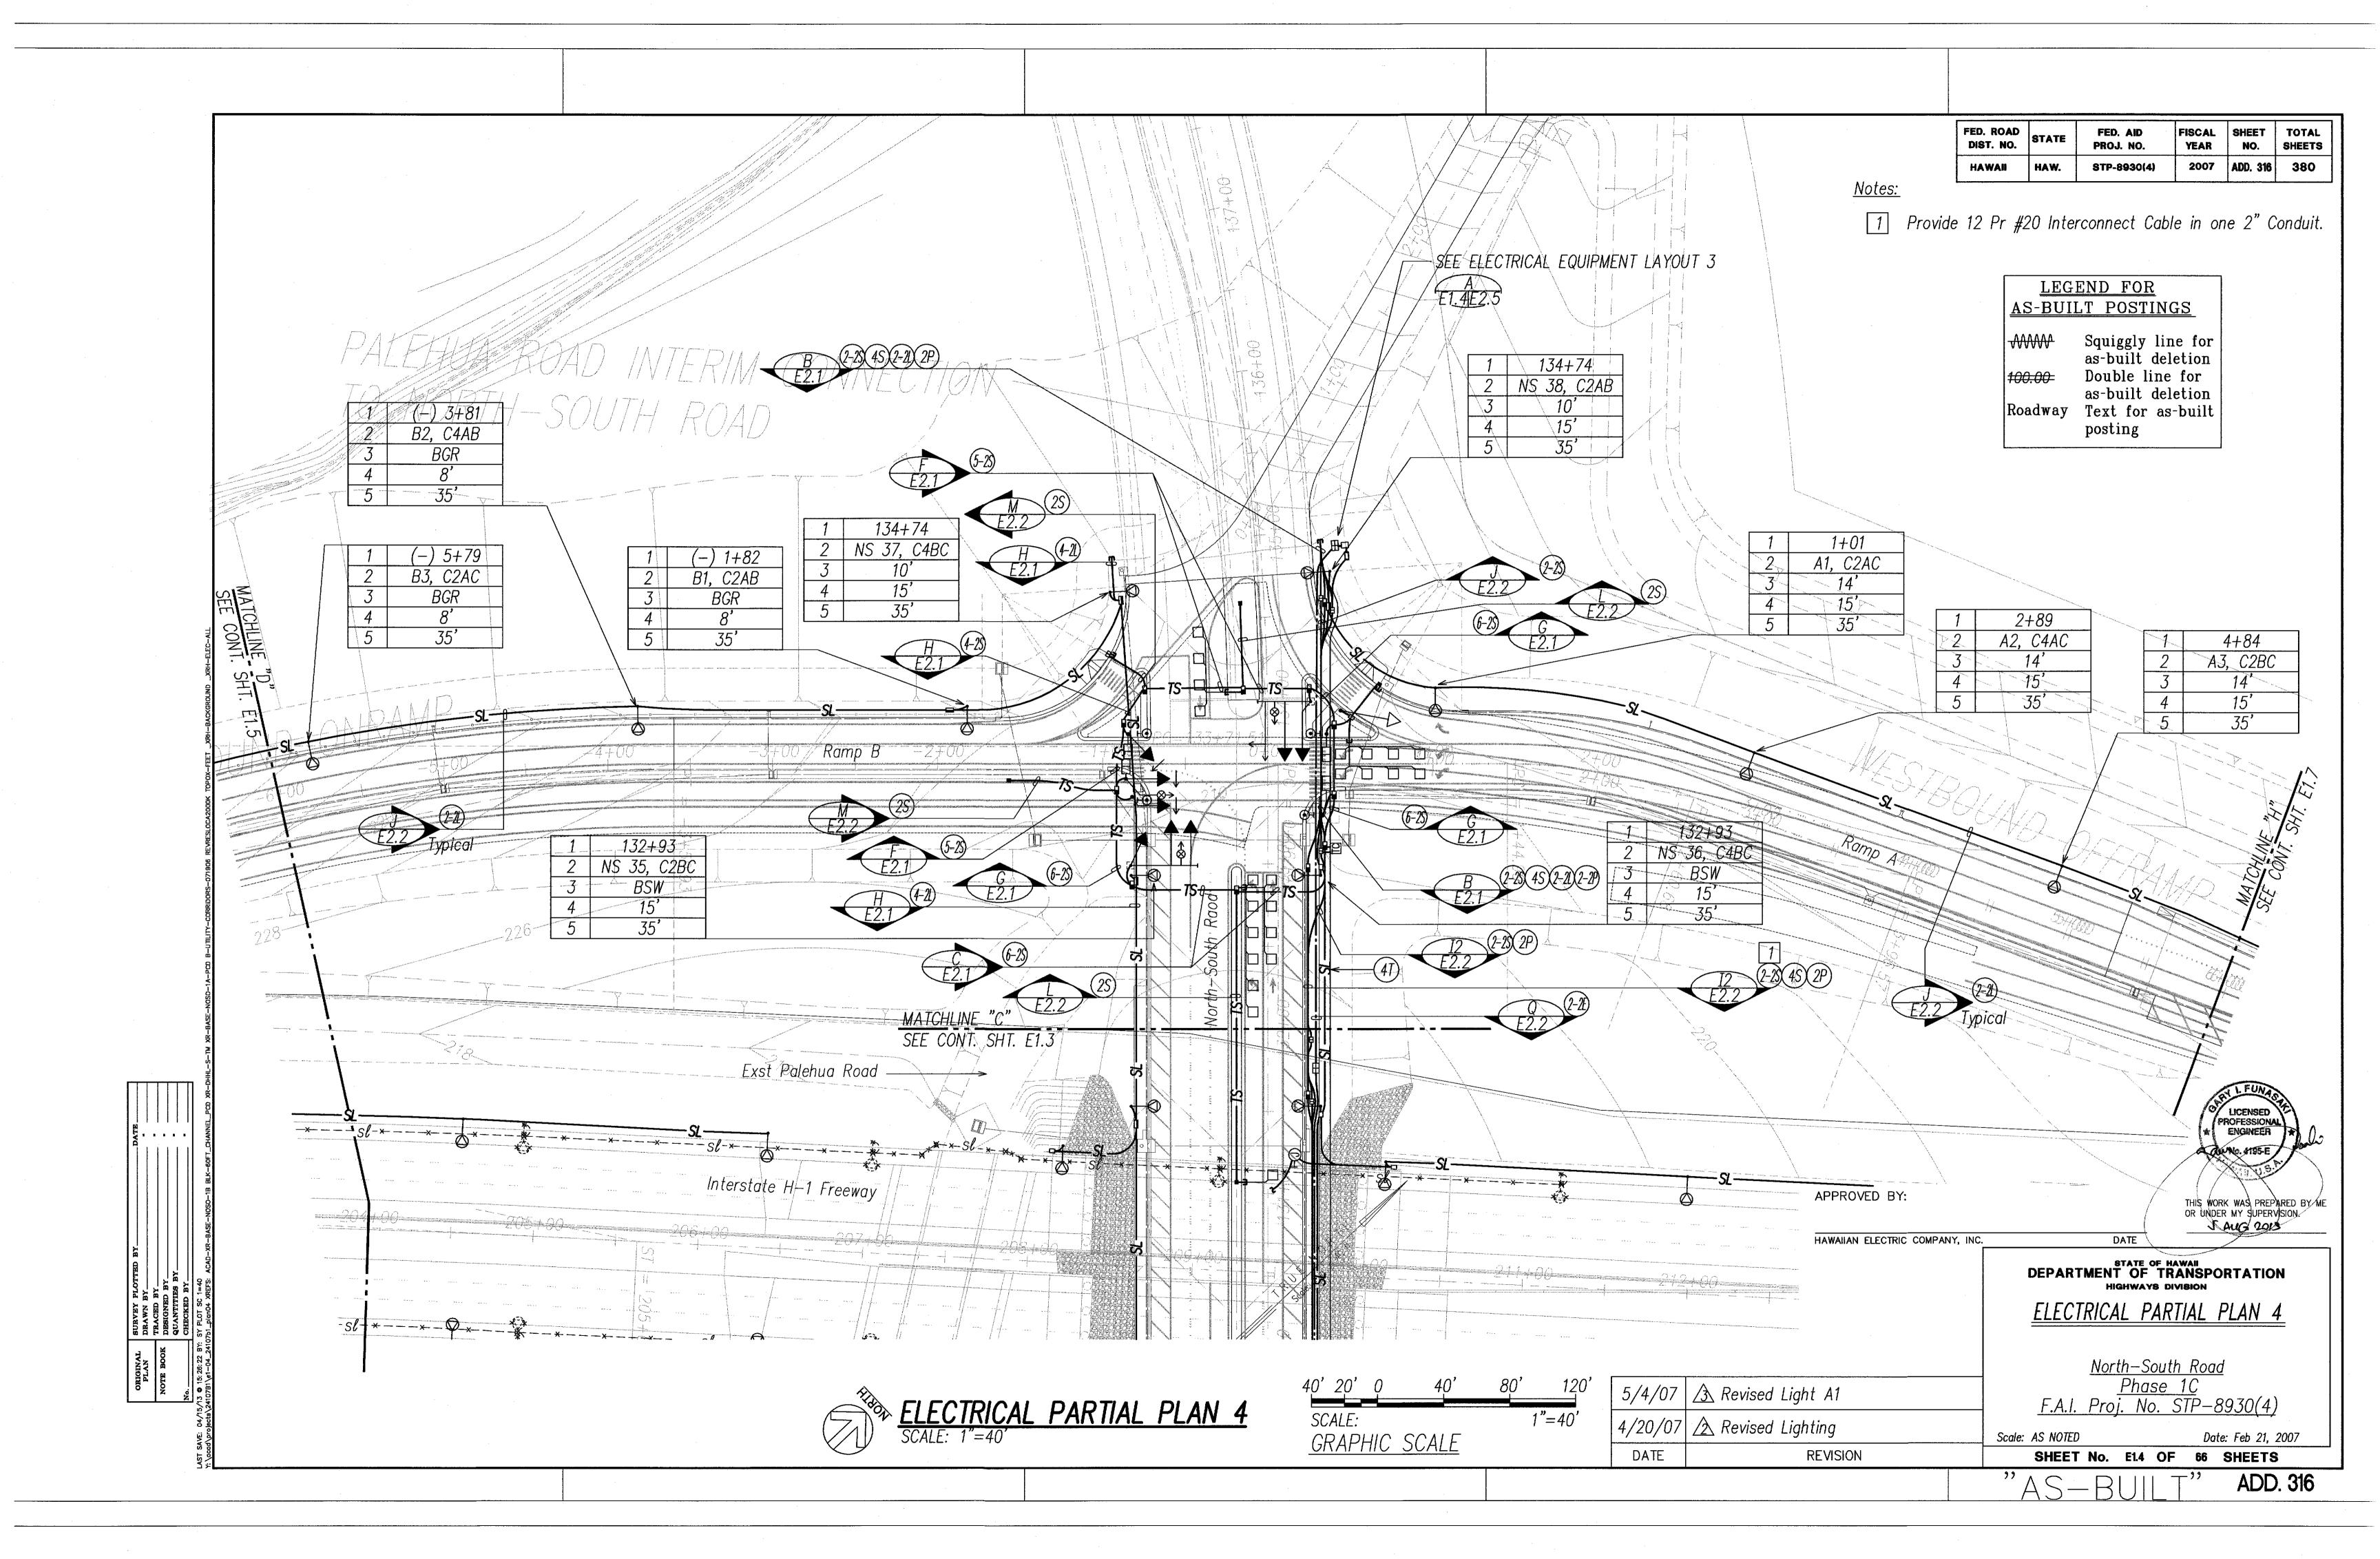


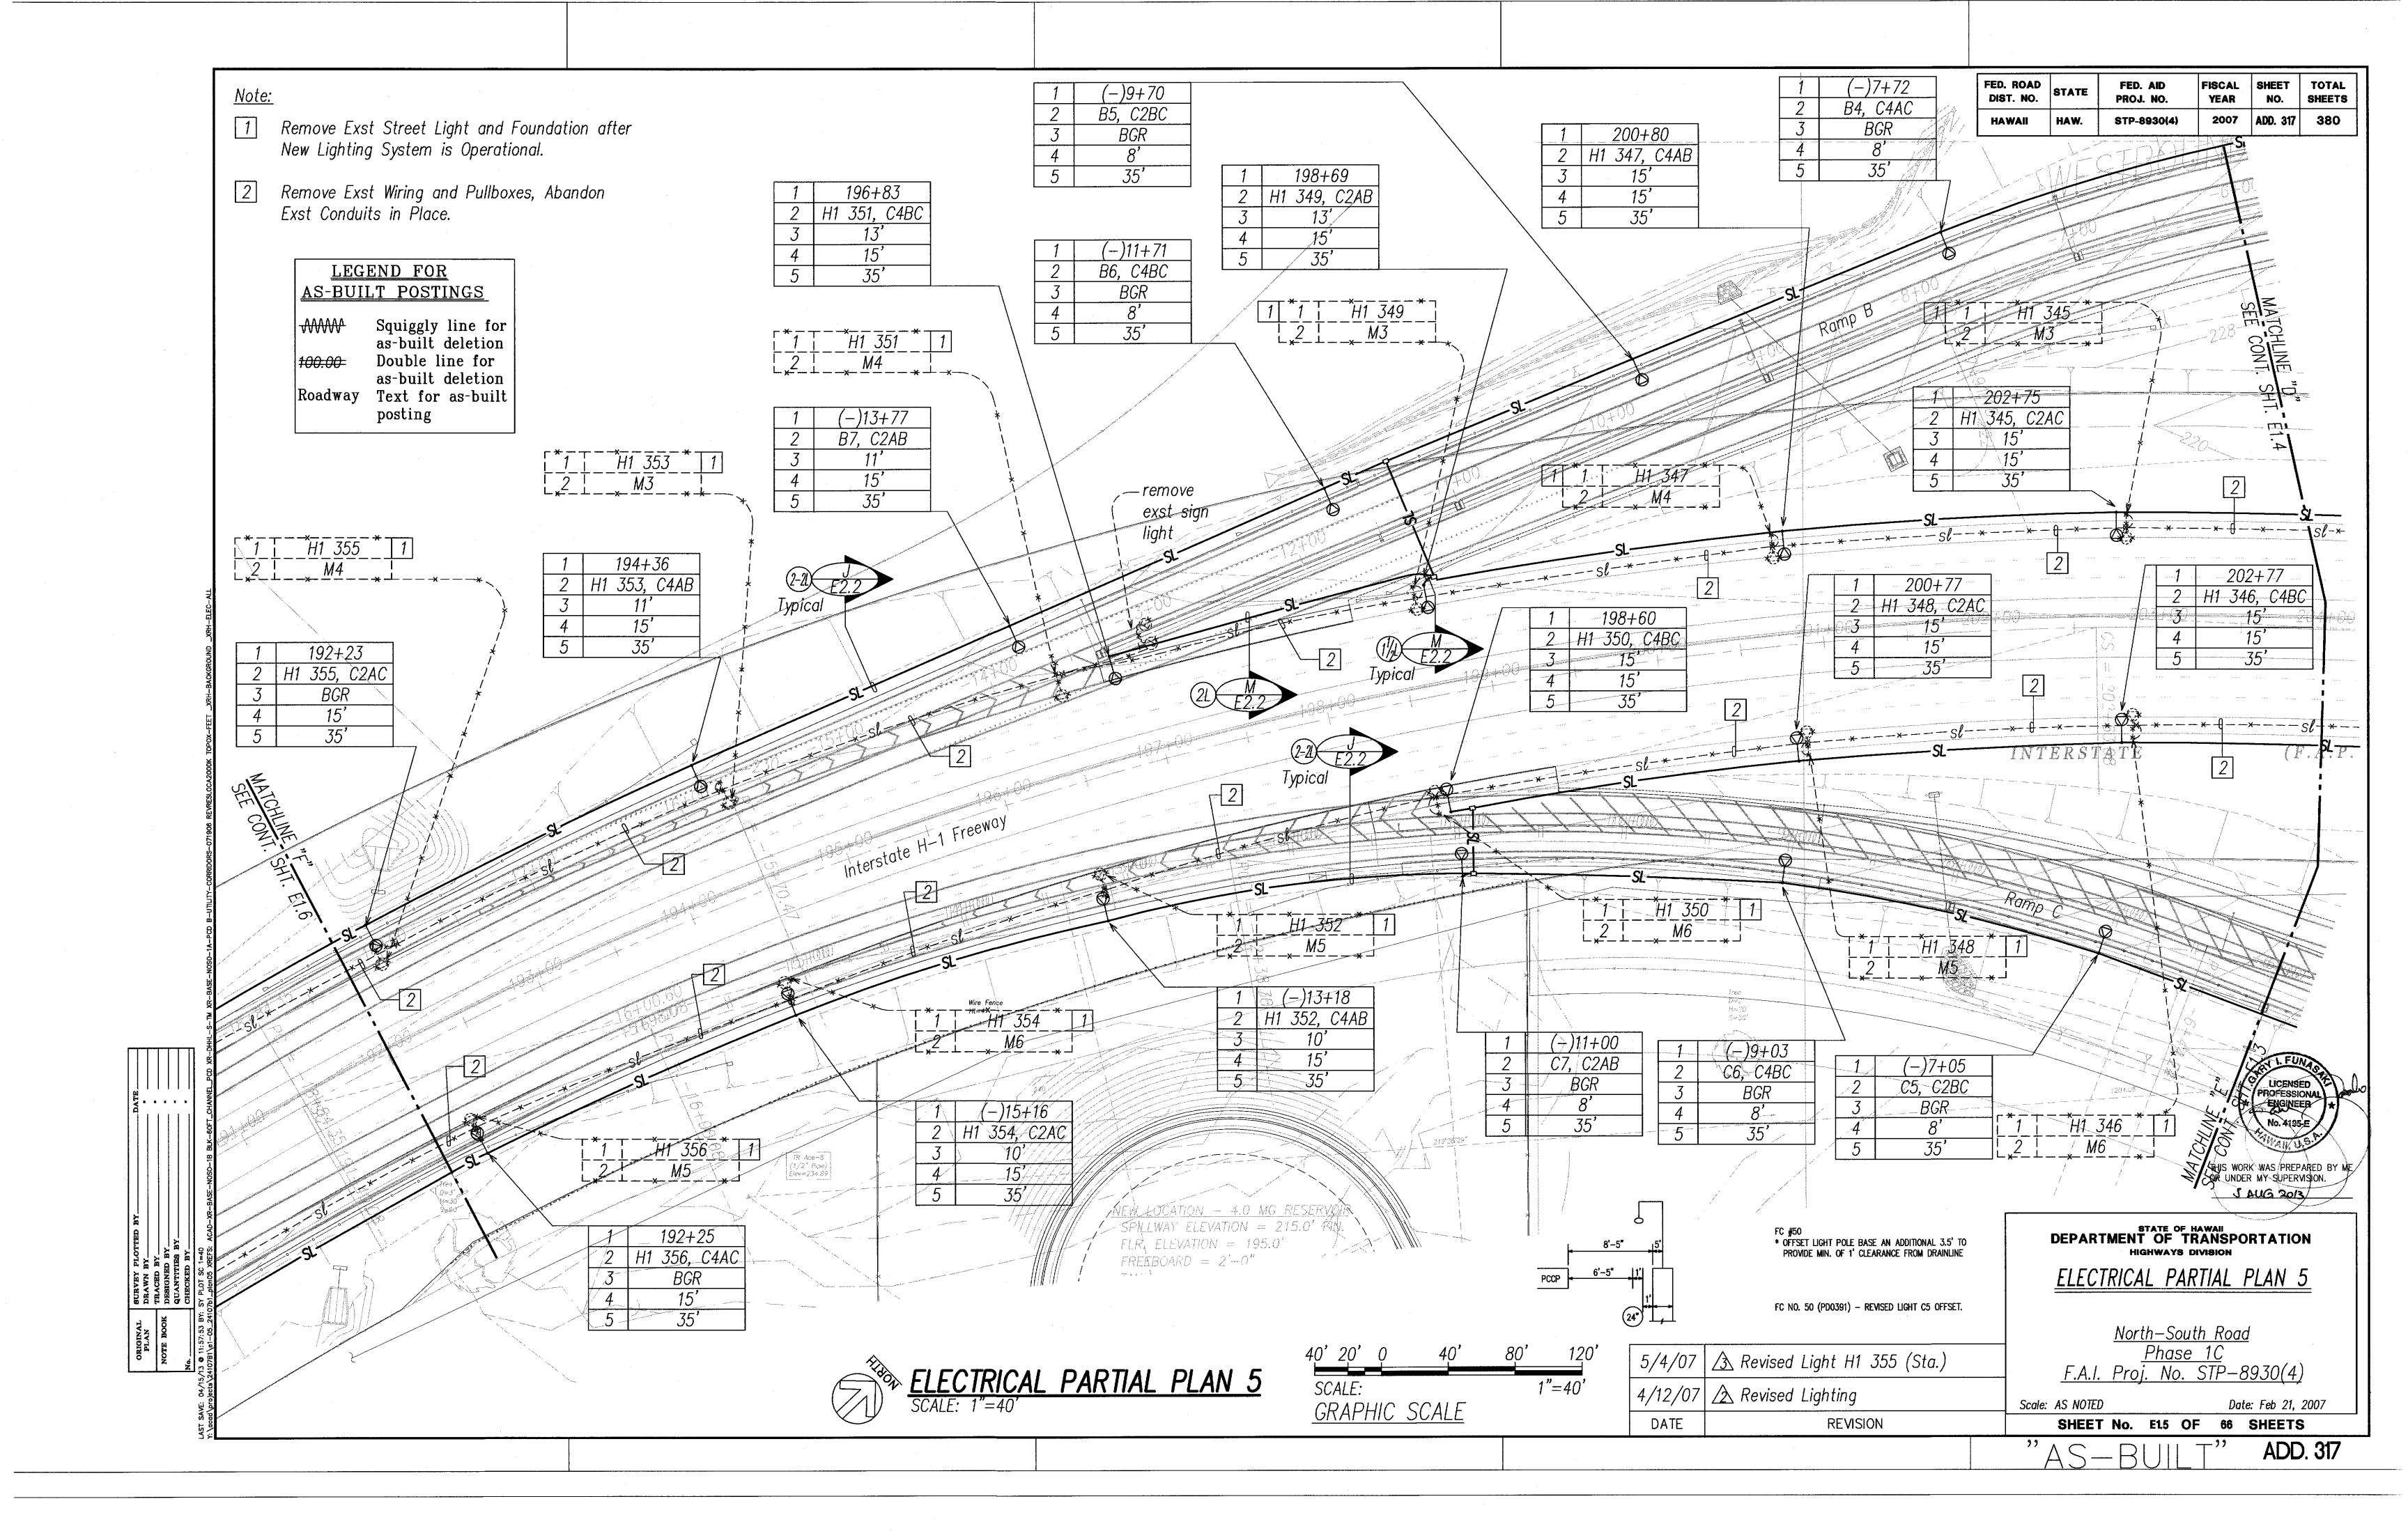

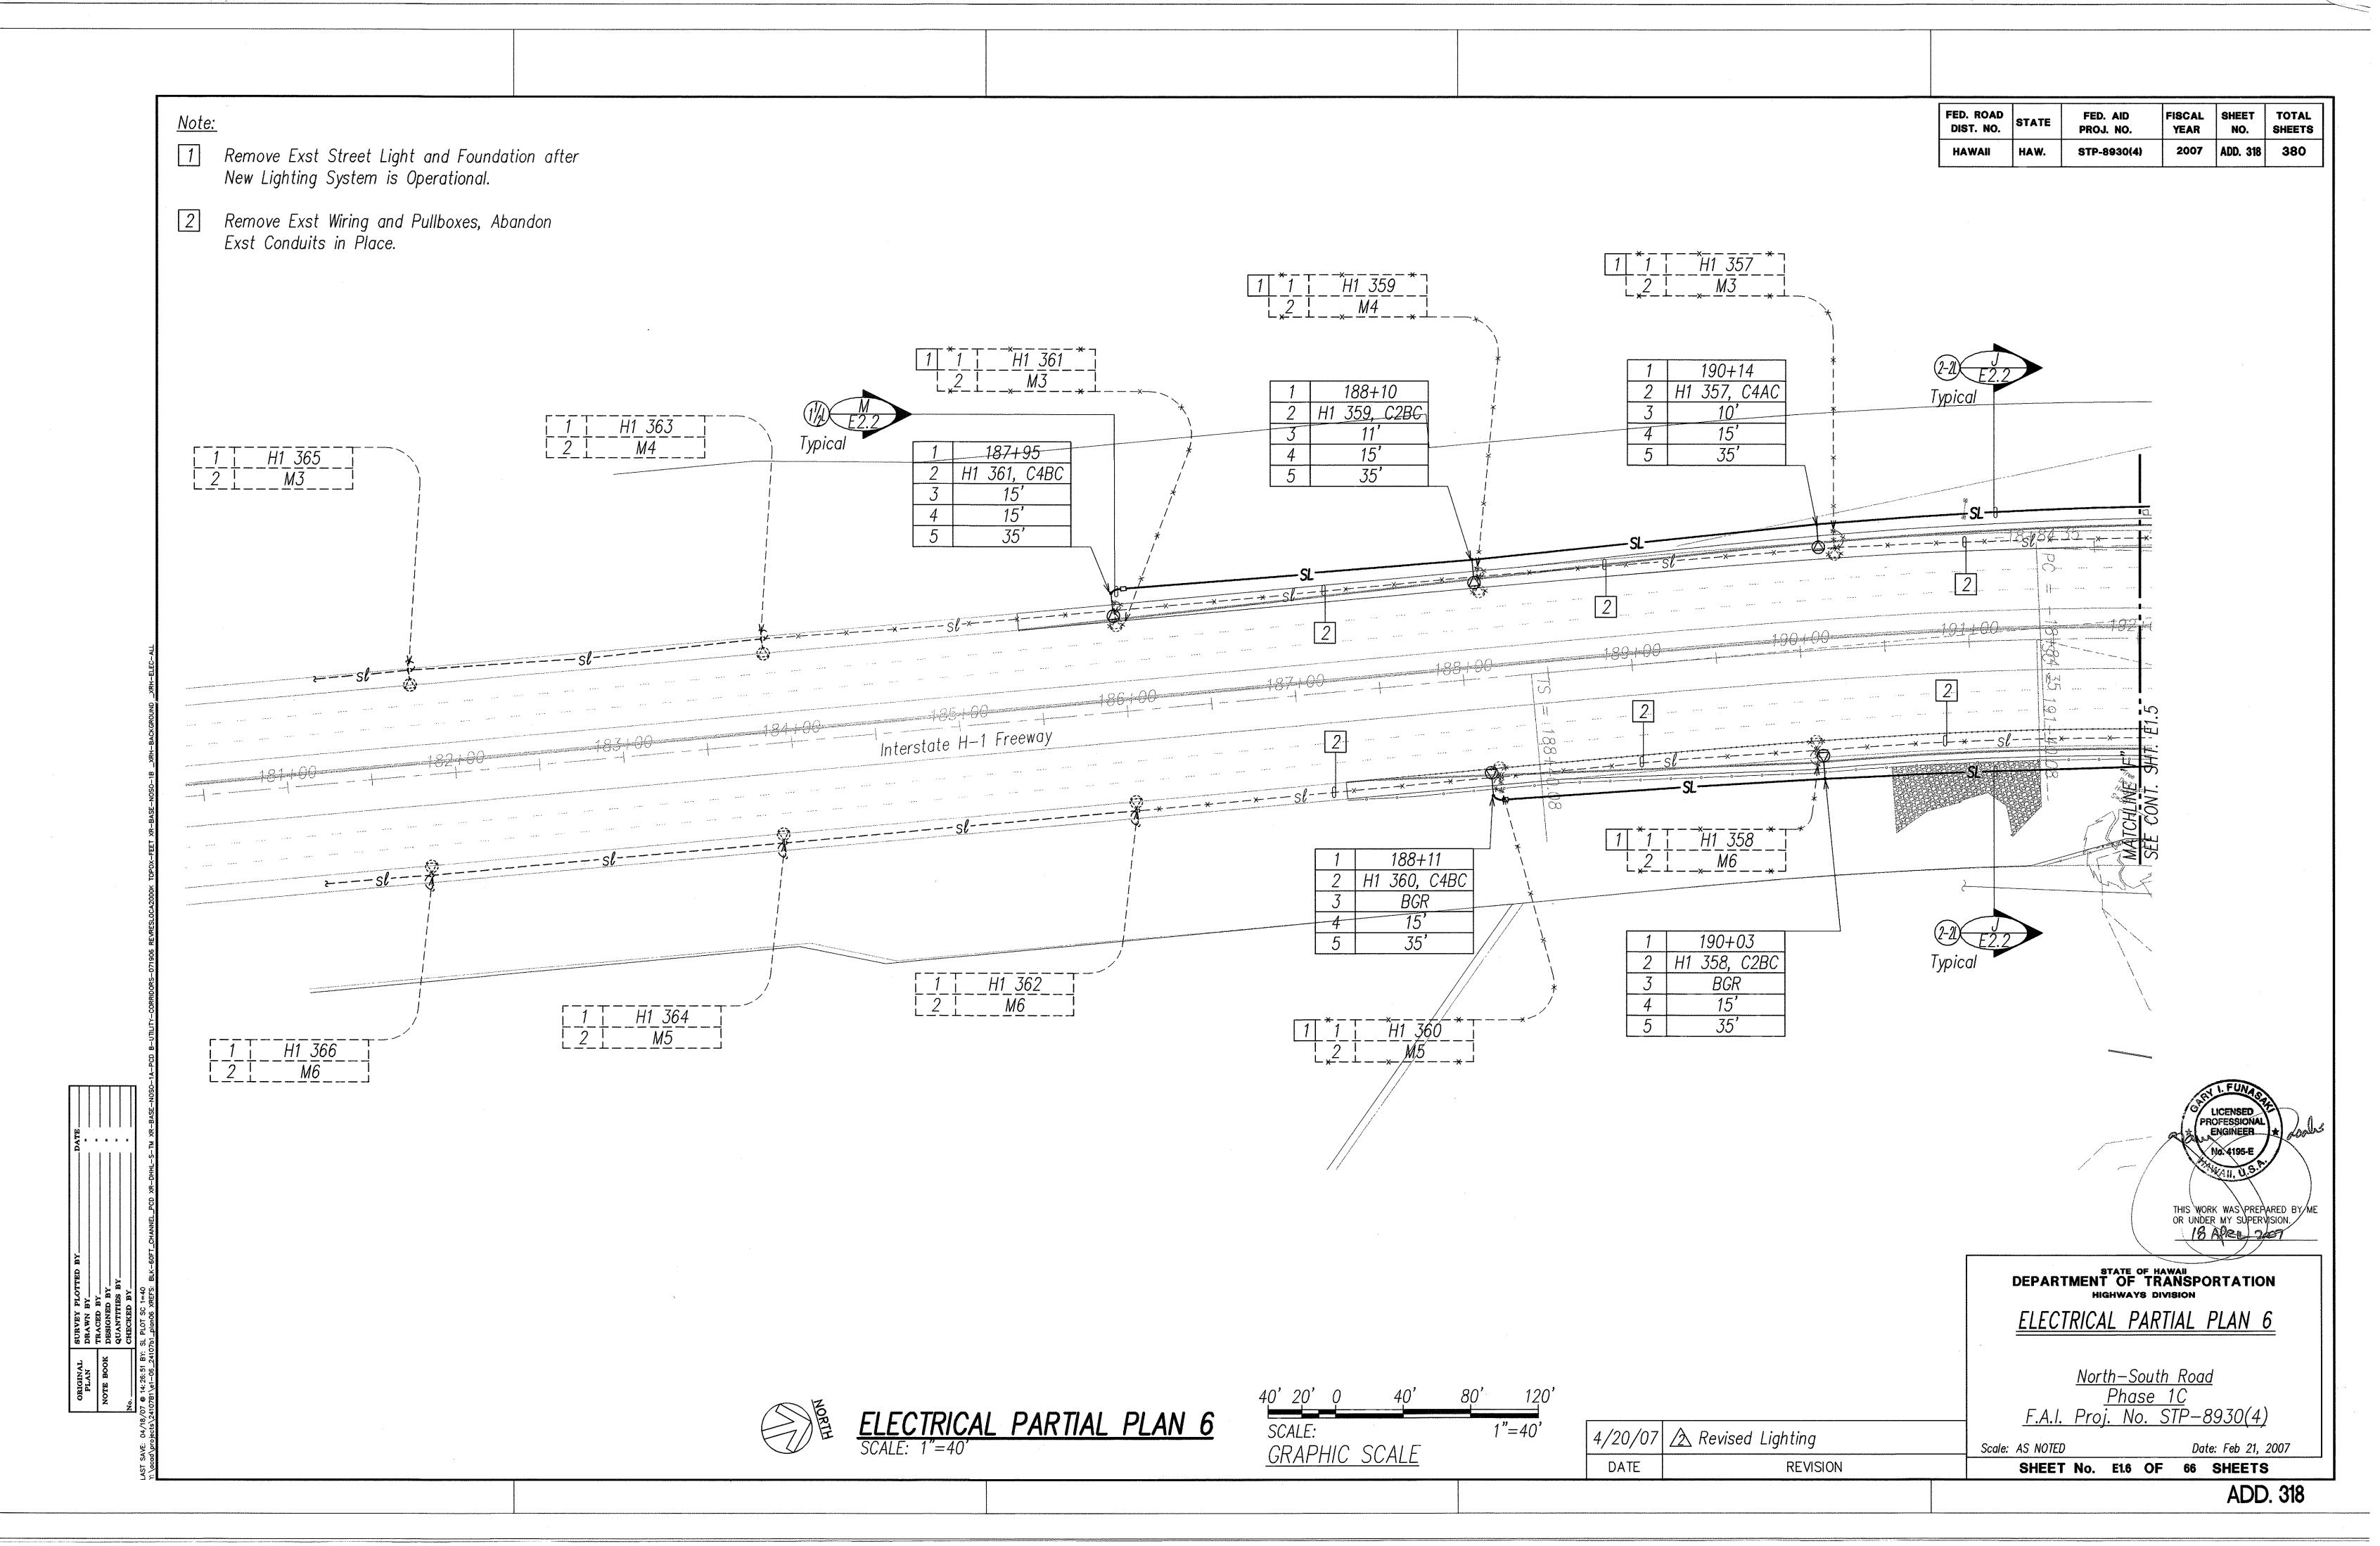

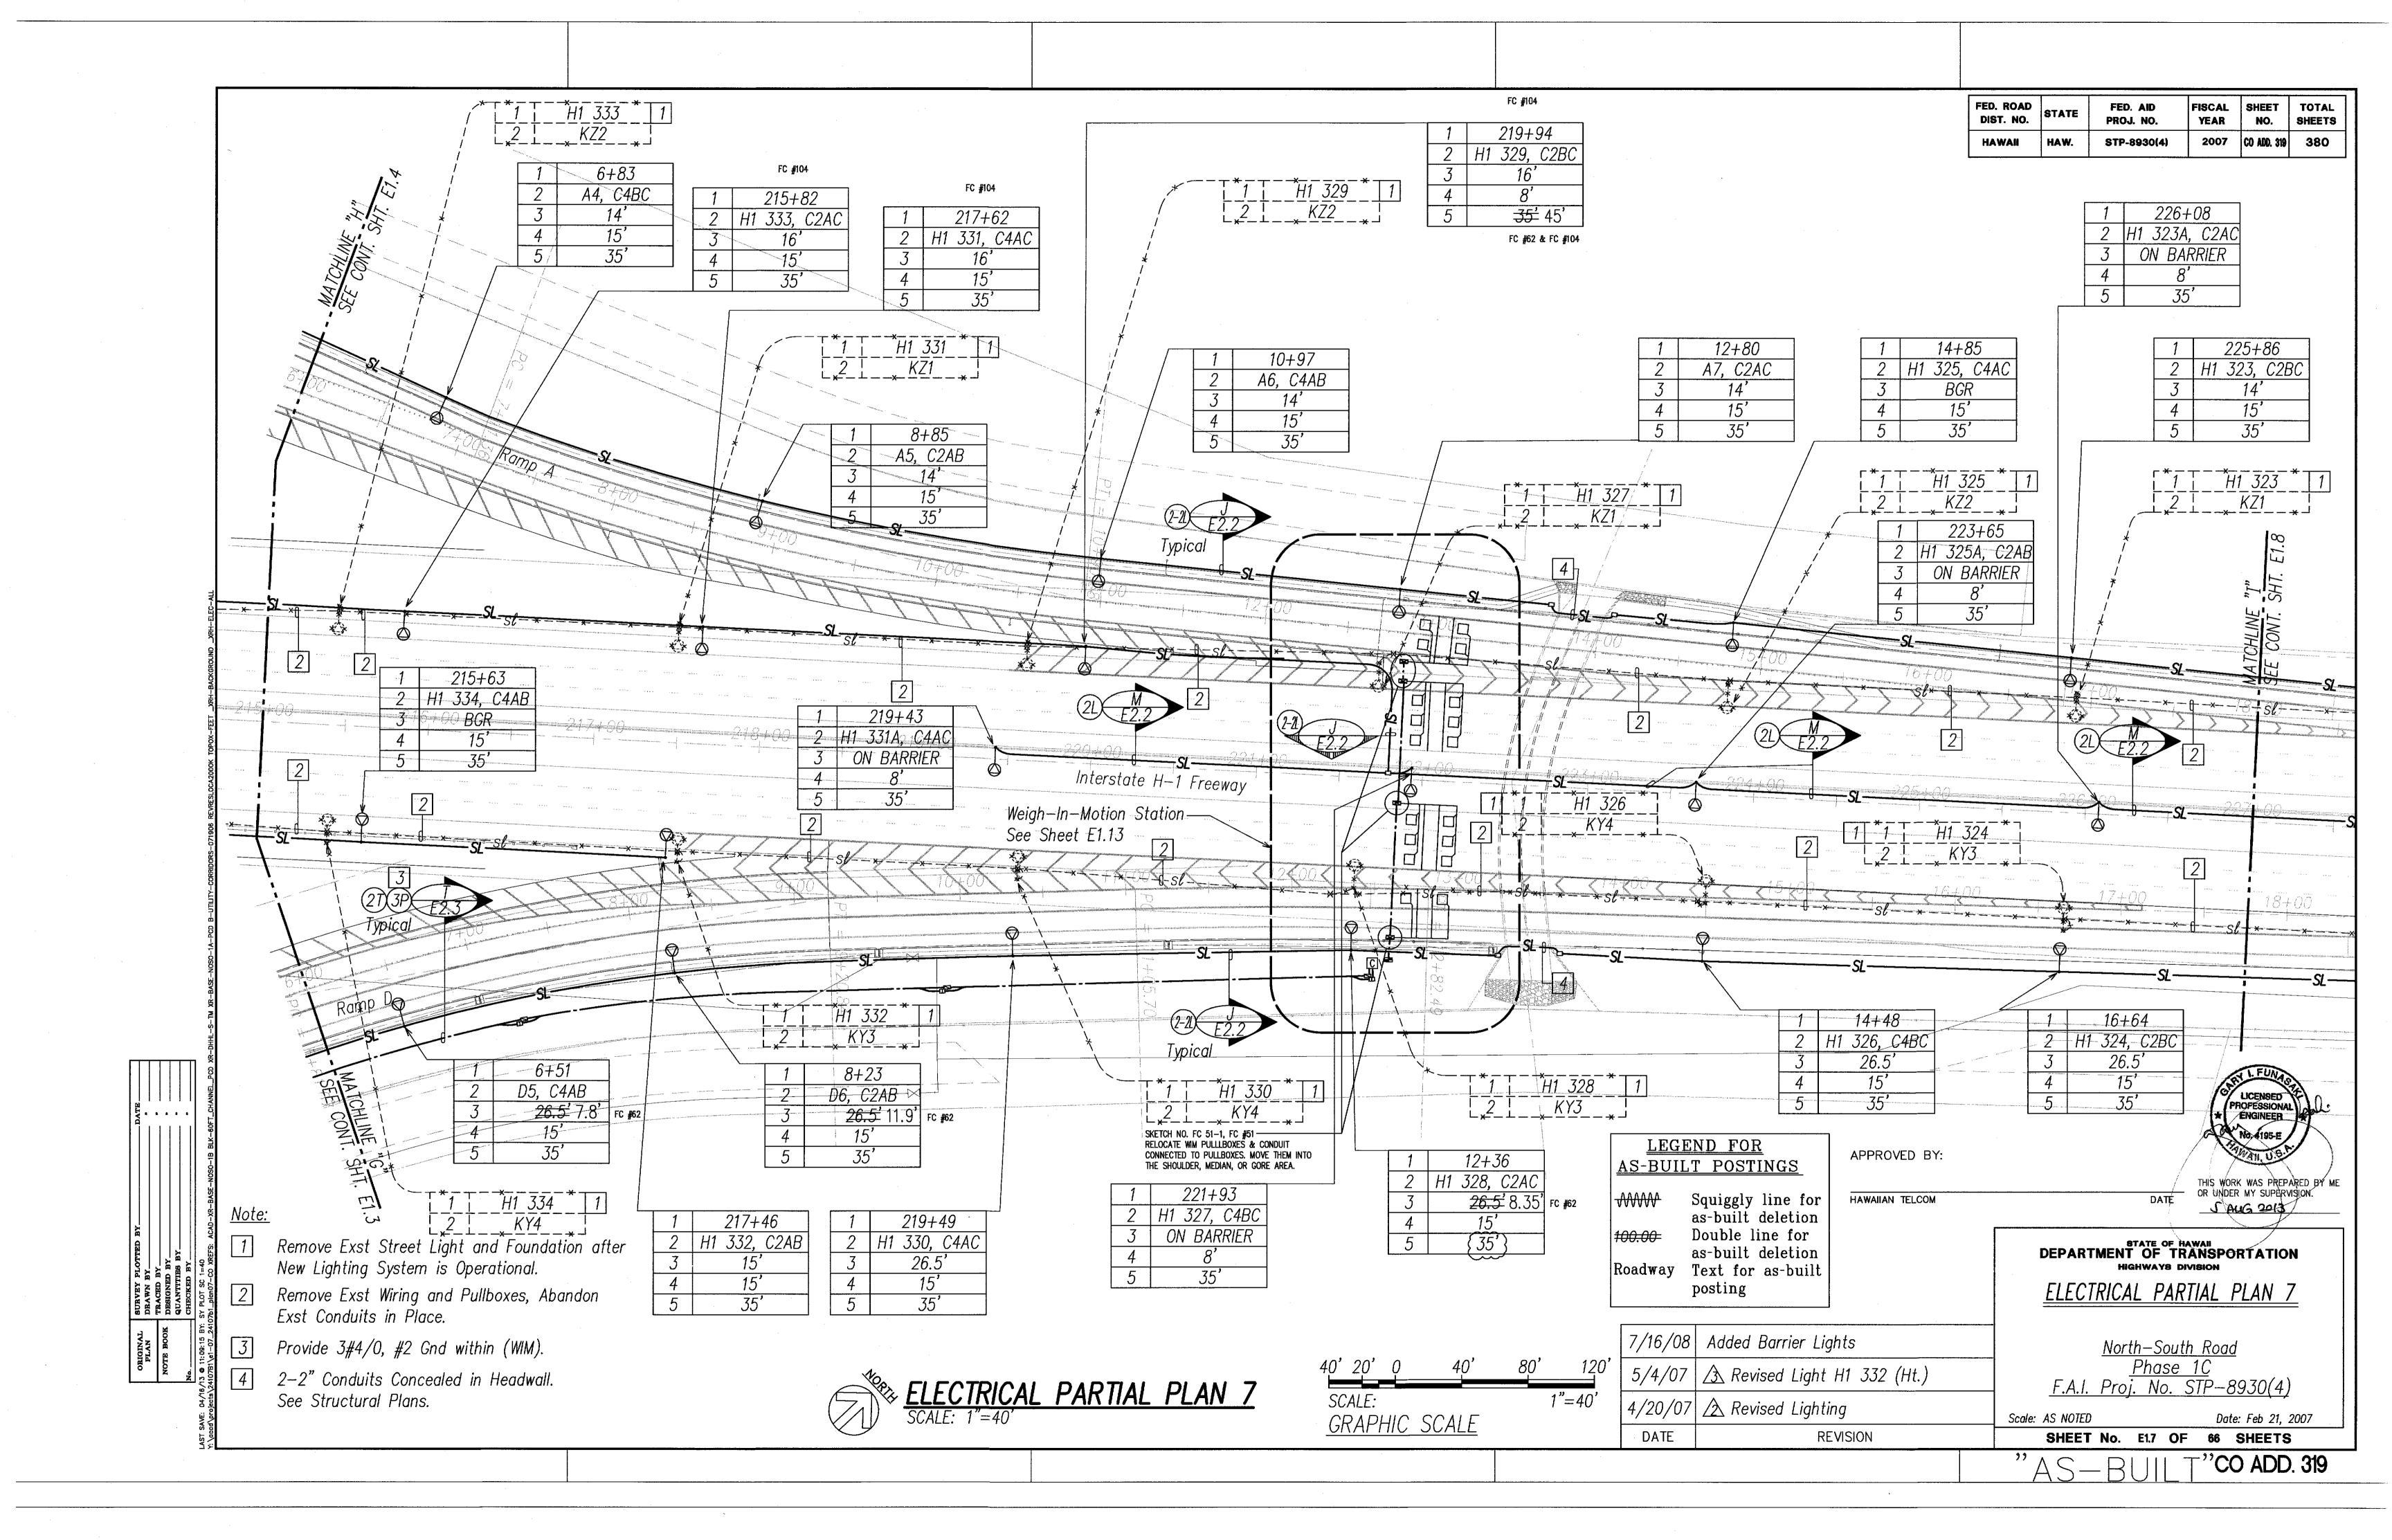

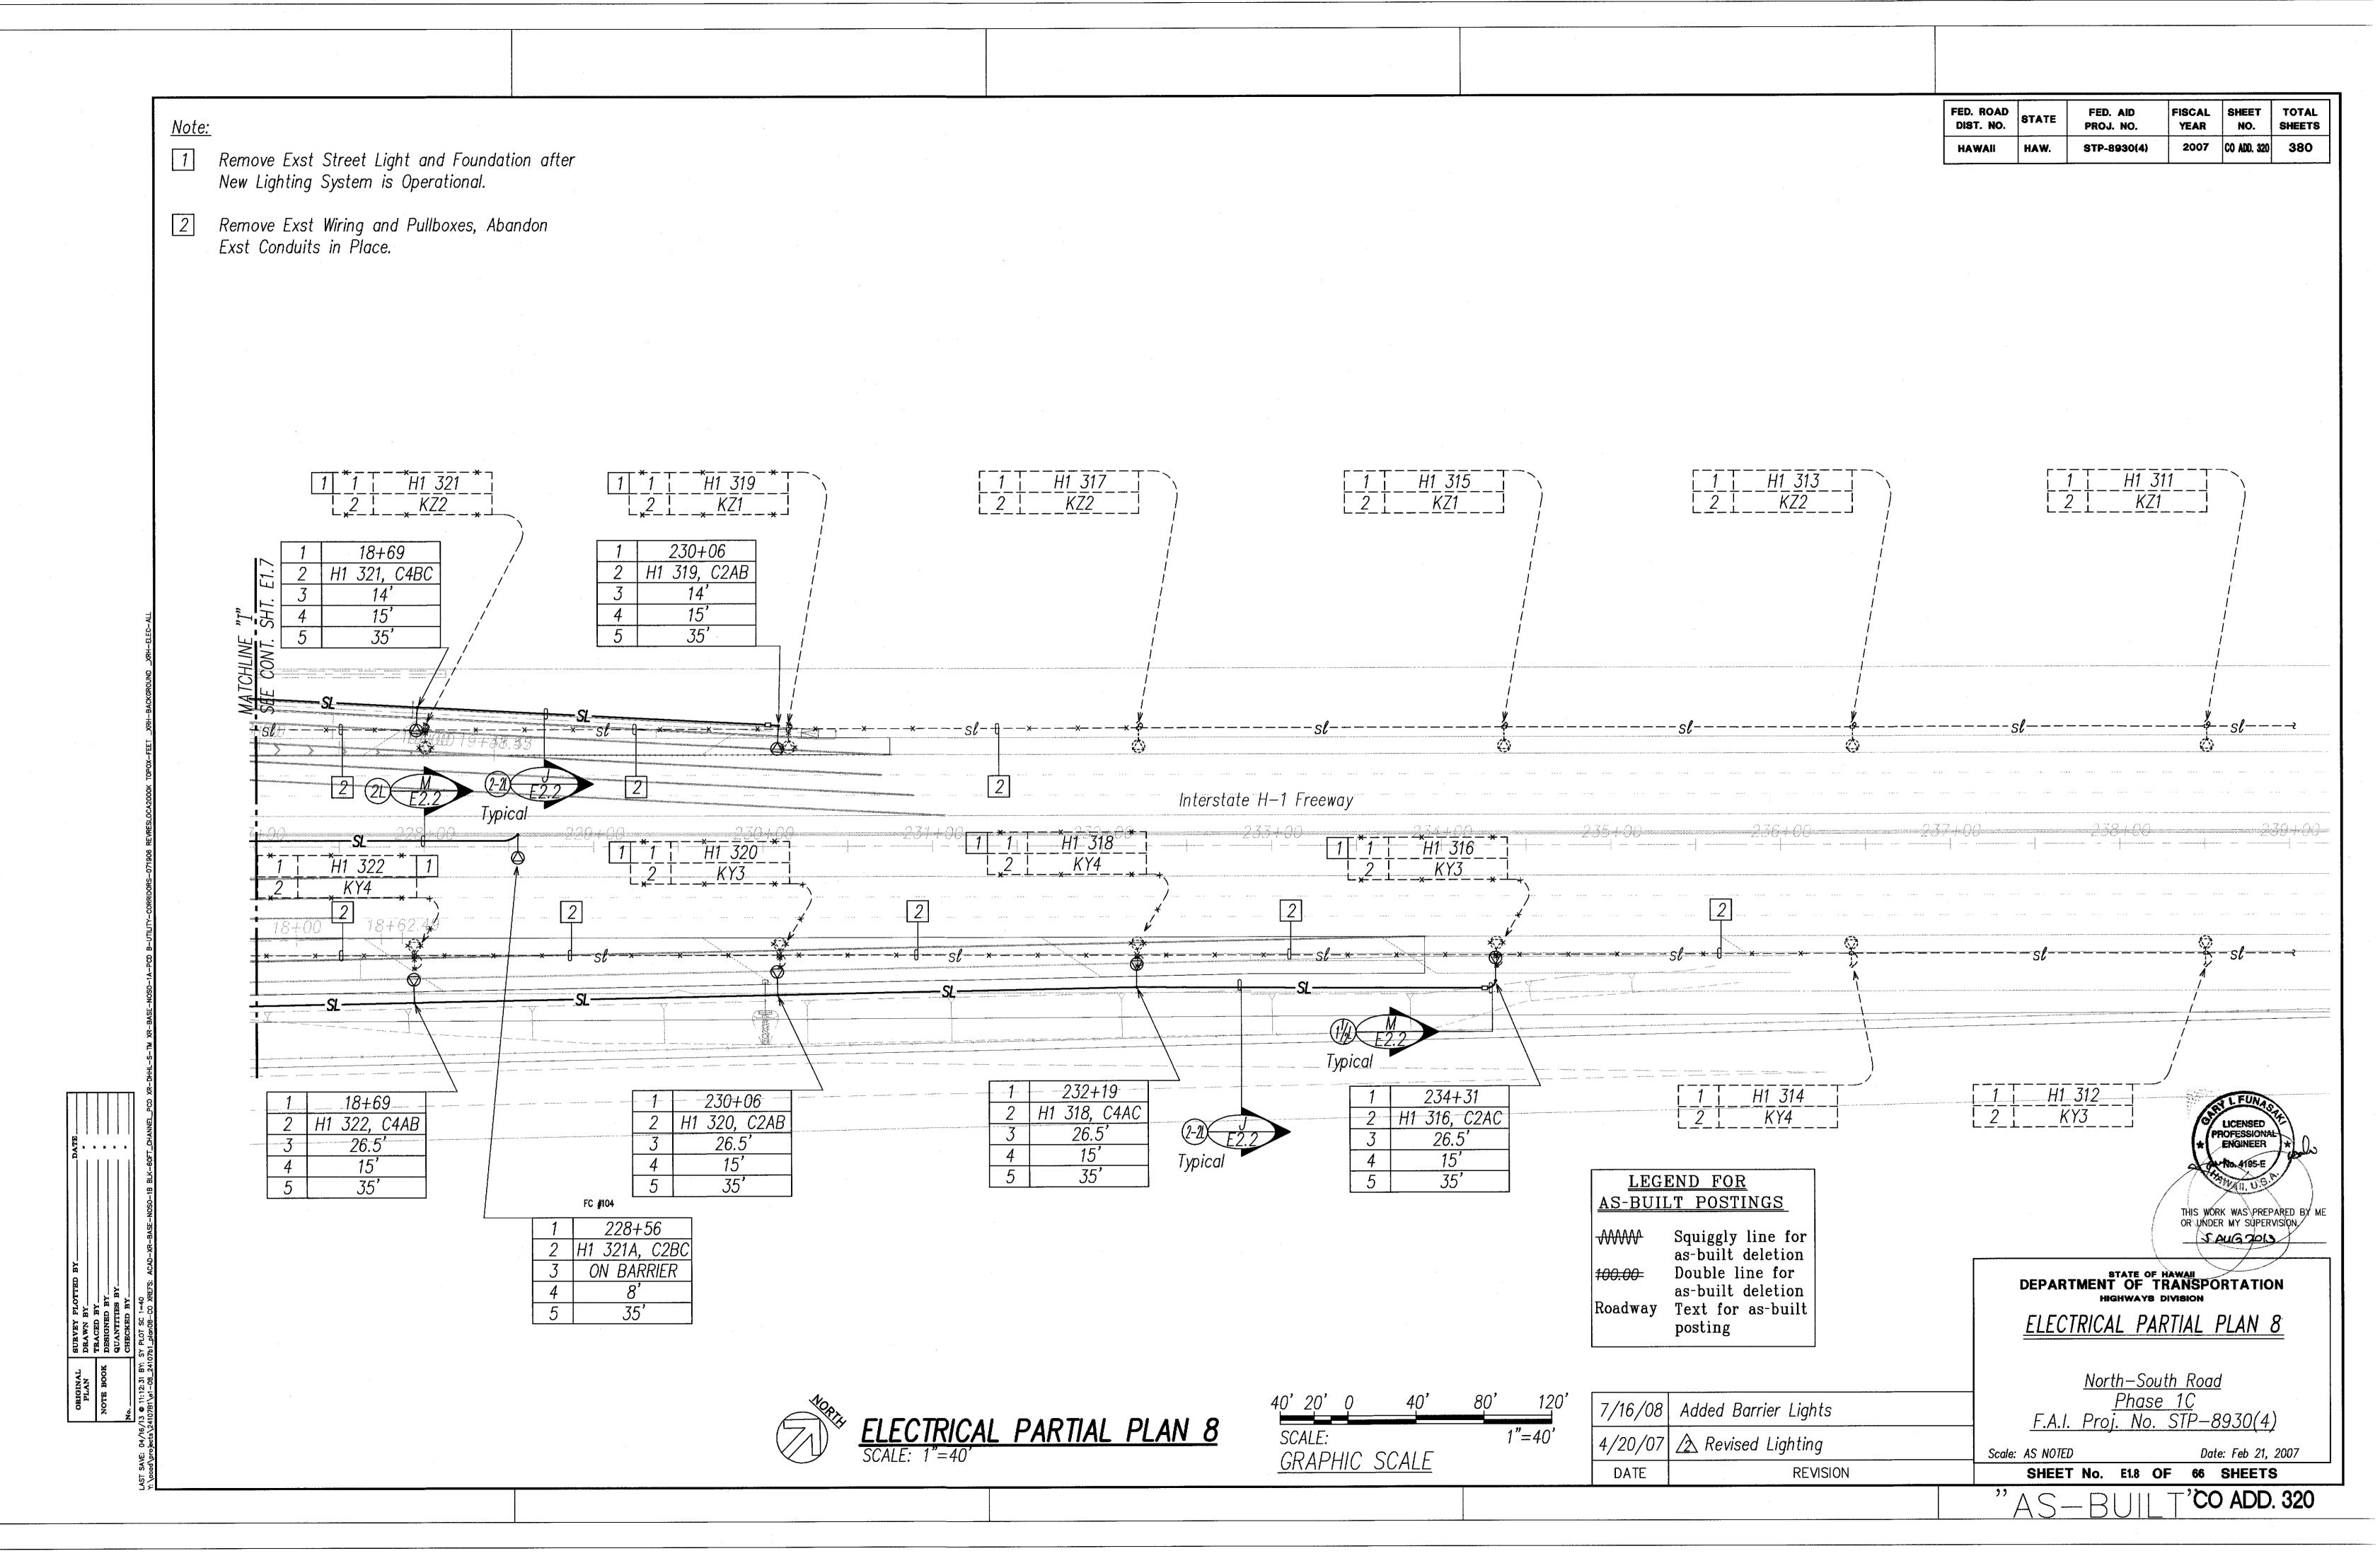

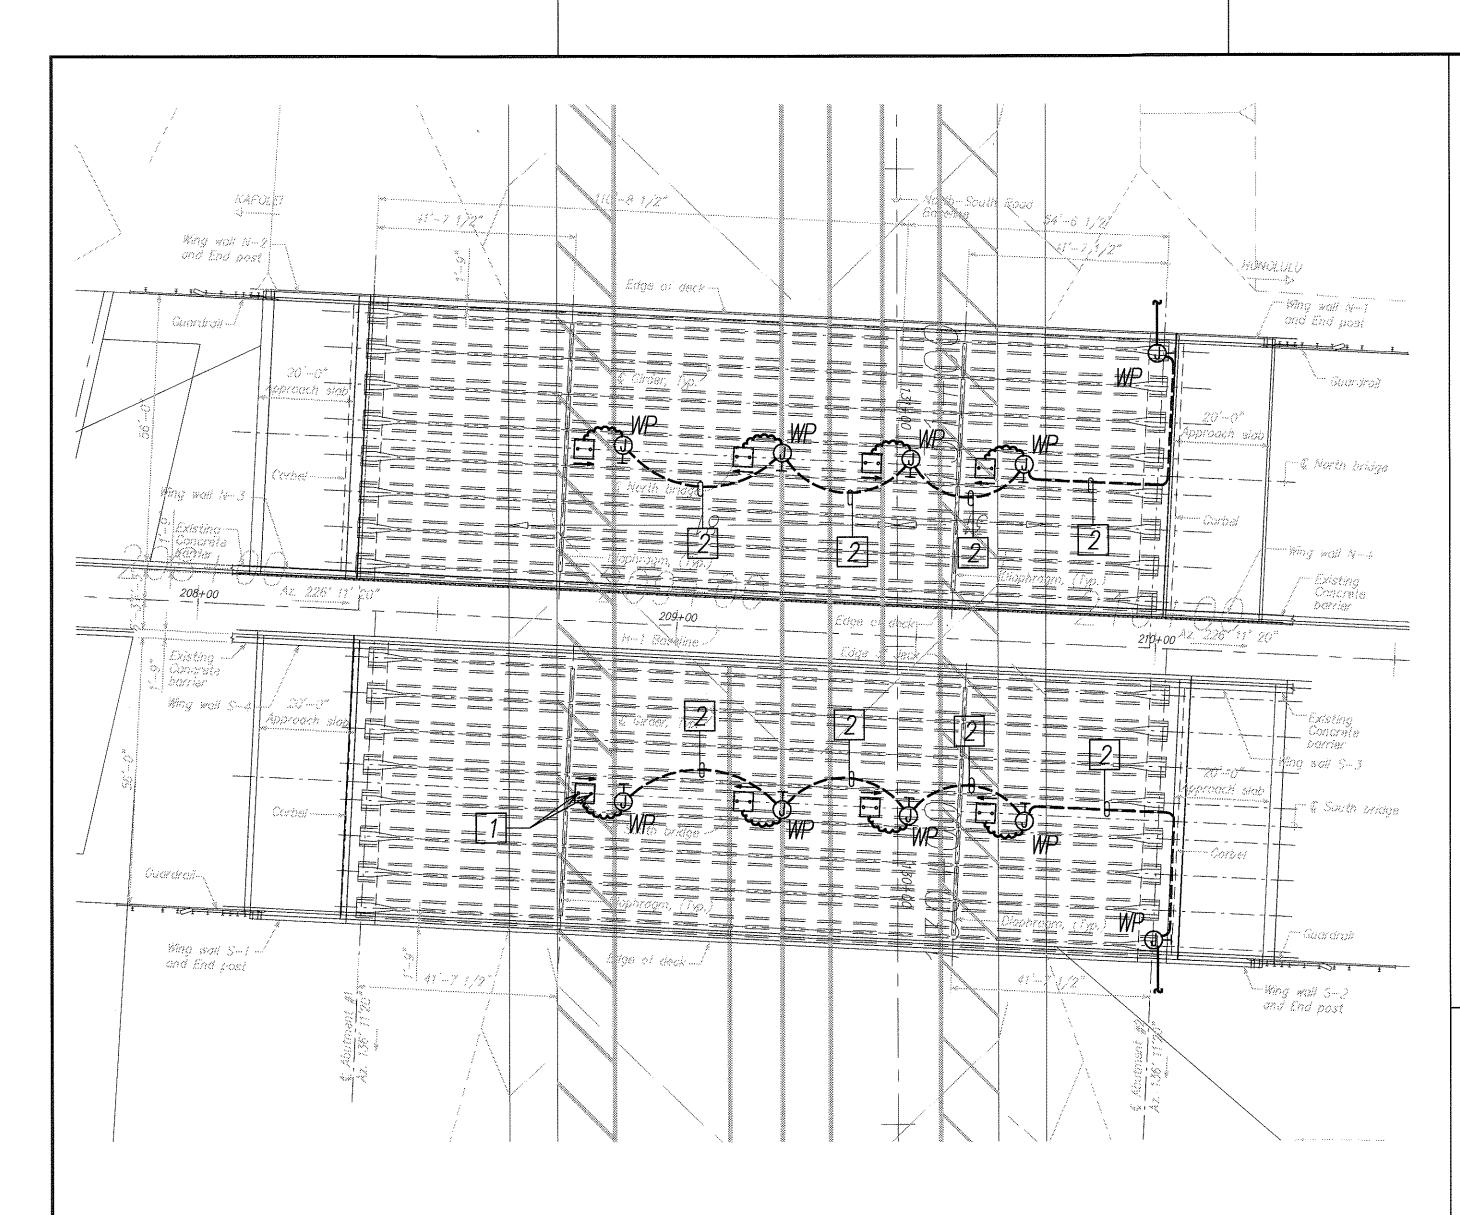


<u>Notes:</u>

1 Provide Concrete Inserts for Mounting Stems. Concrete Inserts shall Drills shall not be used to Drill Mounting Holes. Avoid all Bridge Structural Reinforcing when Drilling. All Unused Holes shall be filled with

withstand w 100 LB Pull-Out. Impact Epoxy Grout. Typical.


2 3/4" PVC Coated GRS, 3#10 RHW—USE, #10 Gnd.


UNDERPASS LIGHTING PLAN
Scale: 1"=20'-0"

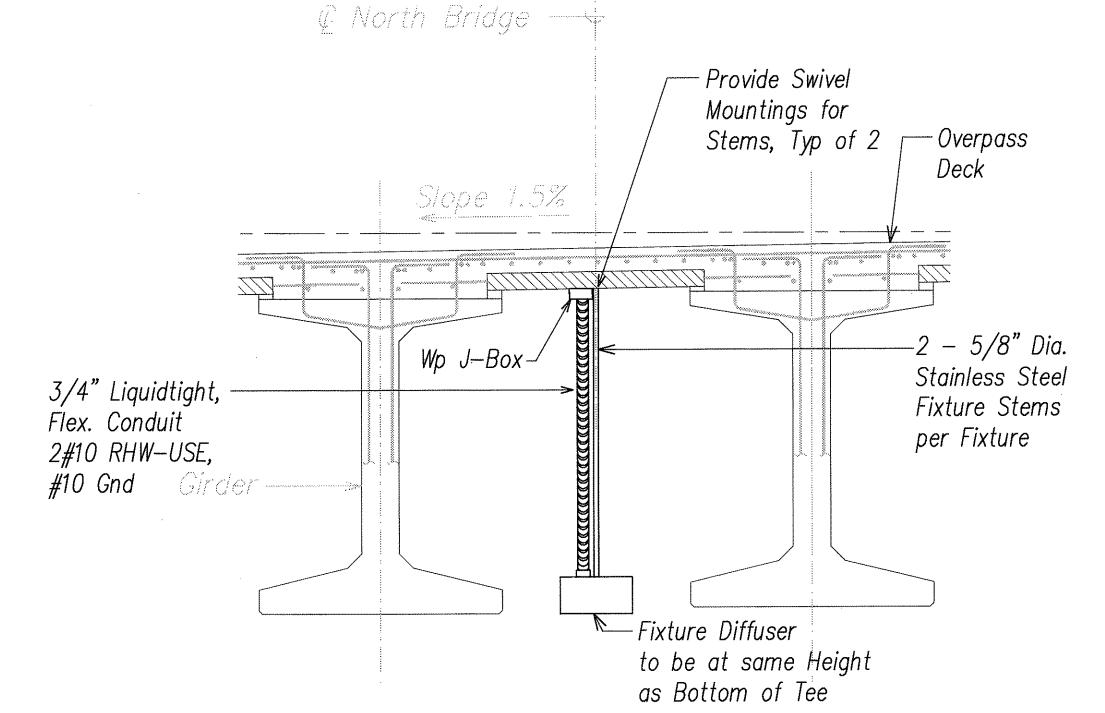

All Ceiling Inserts for Fixture Mounting Hardware shall withstand a 100 LB Pull—Out.

# B TYPICAL UNDERPASS LIGHT FIXTURE. MTG. DETAIL E1.9 NOT TO SCALE

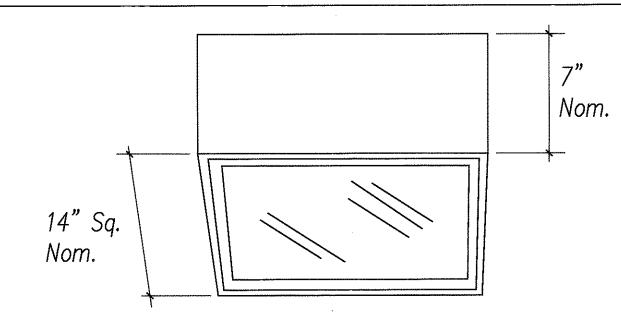

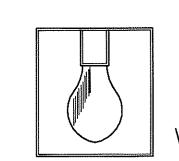


Arrow Indicates Installation Direction of Lamp

Lamp: 100W HPS, Clear

Description: Extruded Aluminum Chassis with Mitered, Welded Corners, Dark Bronze Anodized Finish, U.L. Listed for Wet Locations, Clear, Tempered Glass Diffuser, Hydroformed Specular Aluminum Reflector with IES Type II Optics, HPF, Constant Wattage Autotransformer Ballast. As a Standard Feature, Fixture shall be Suitable for Stem Mounting.



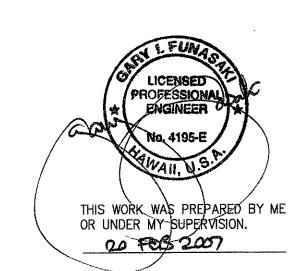

DEPARTMENT OF TRANSPORTATION
HIGHWAYS DIVISION <u>UNDERPASS LIGHTING PLAN</u>

North—South Road <u>Phase 1C</u> F.A.I. Proj. No. STP-8930(4)

Scale: AS NOTED

FED. ROAD DIST. NO.

FED. AID PROJ. NO.

STP-8930(4)


321


2007


Date: Feb 21, 2007 SHEET No. E1.9 OF 66 SHEETS

SCALE: GRAPHIC SCALE

DATE REVISION

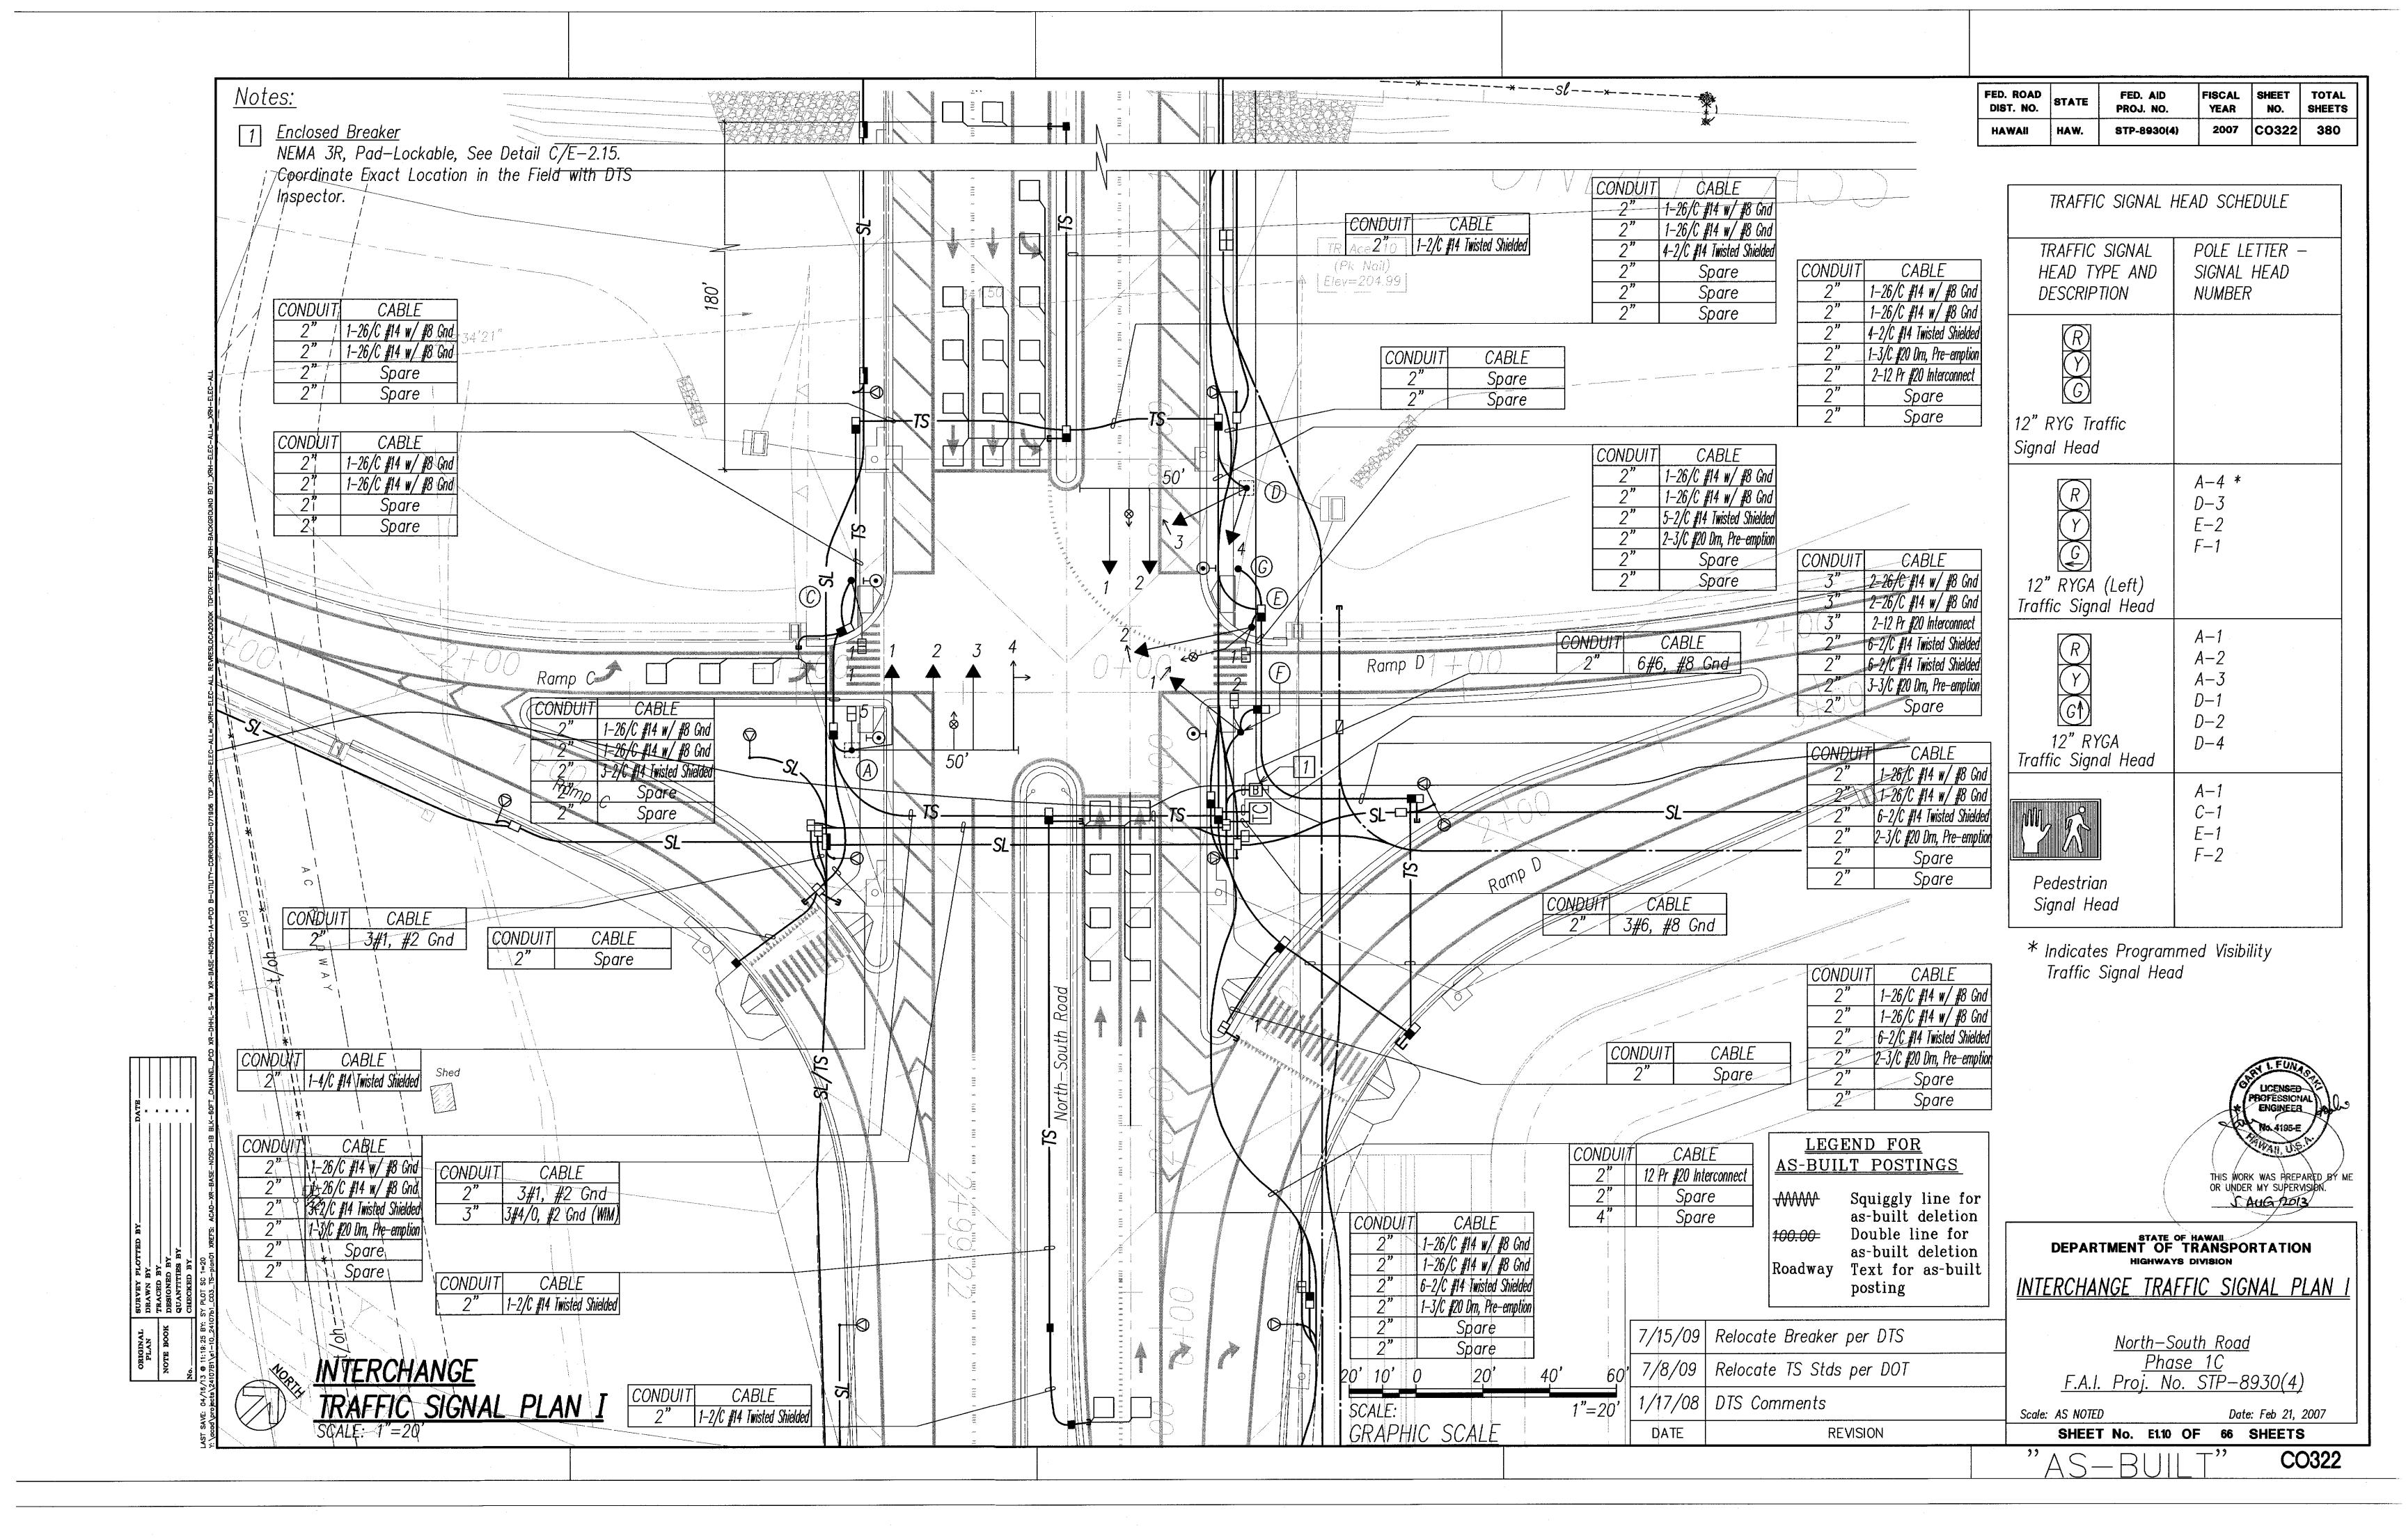

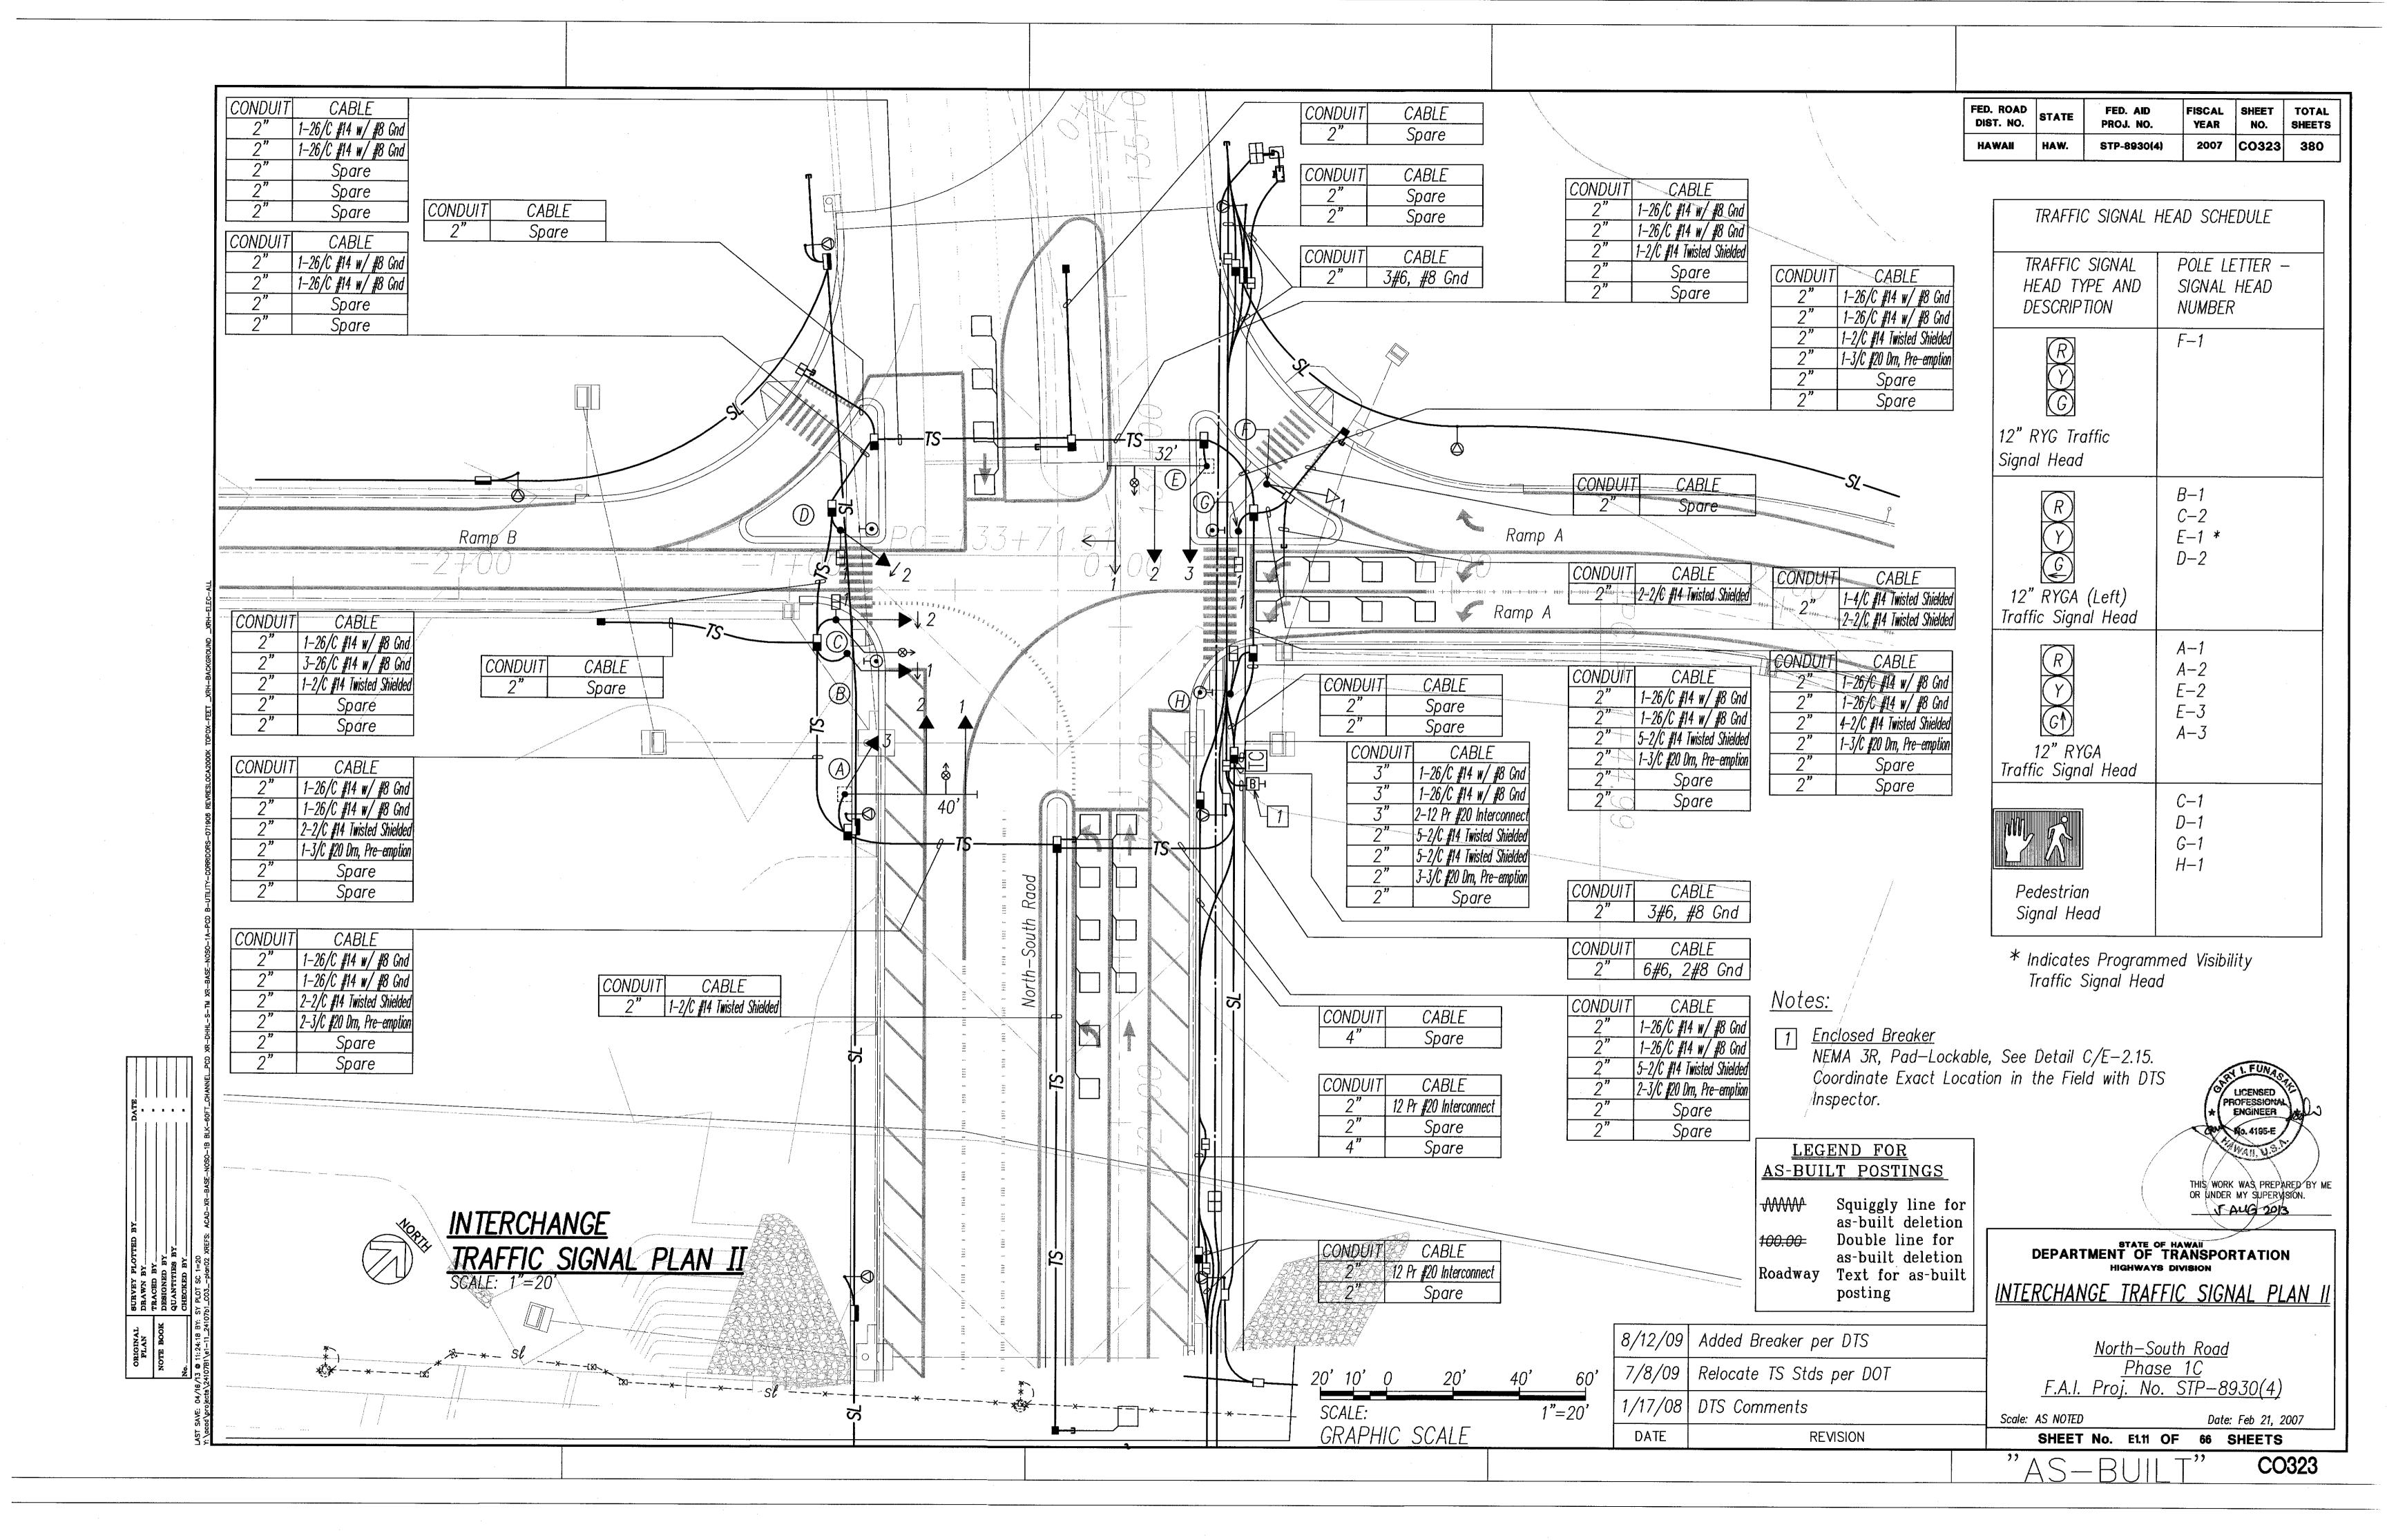

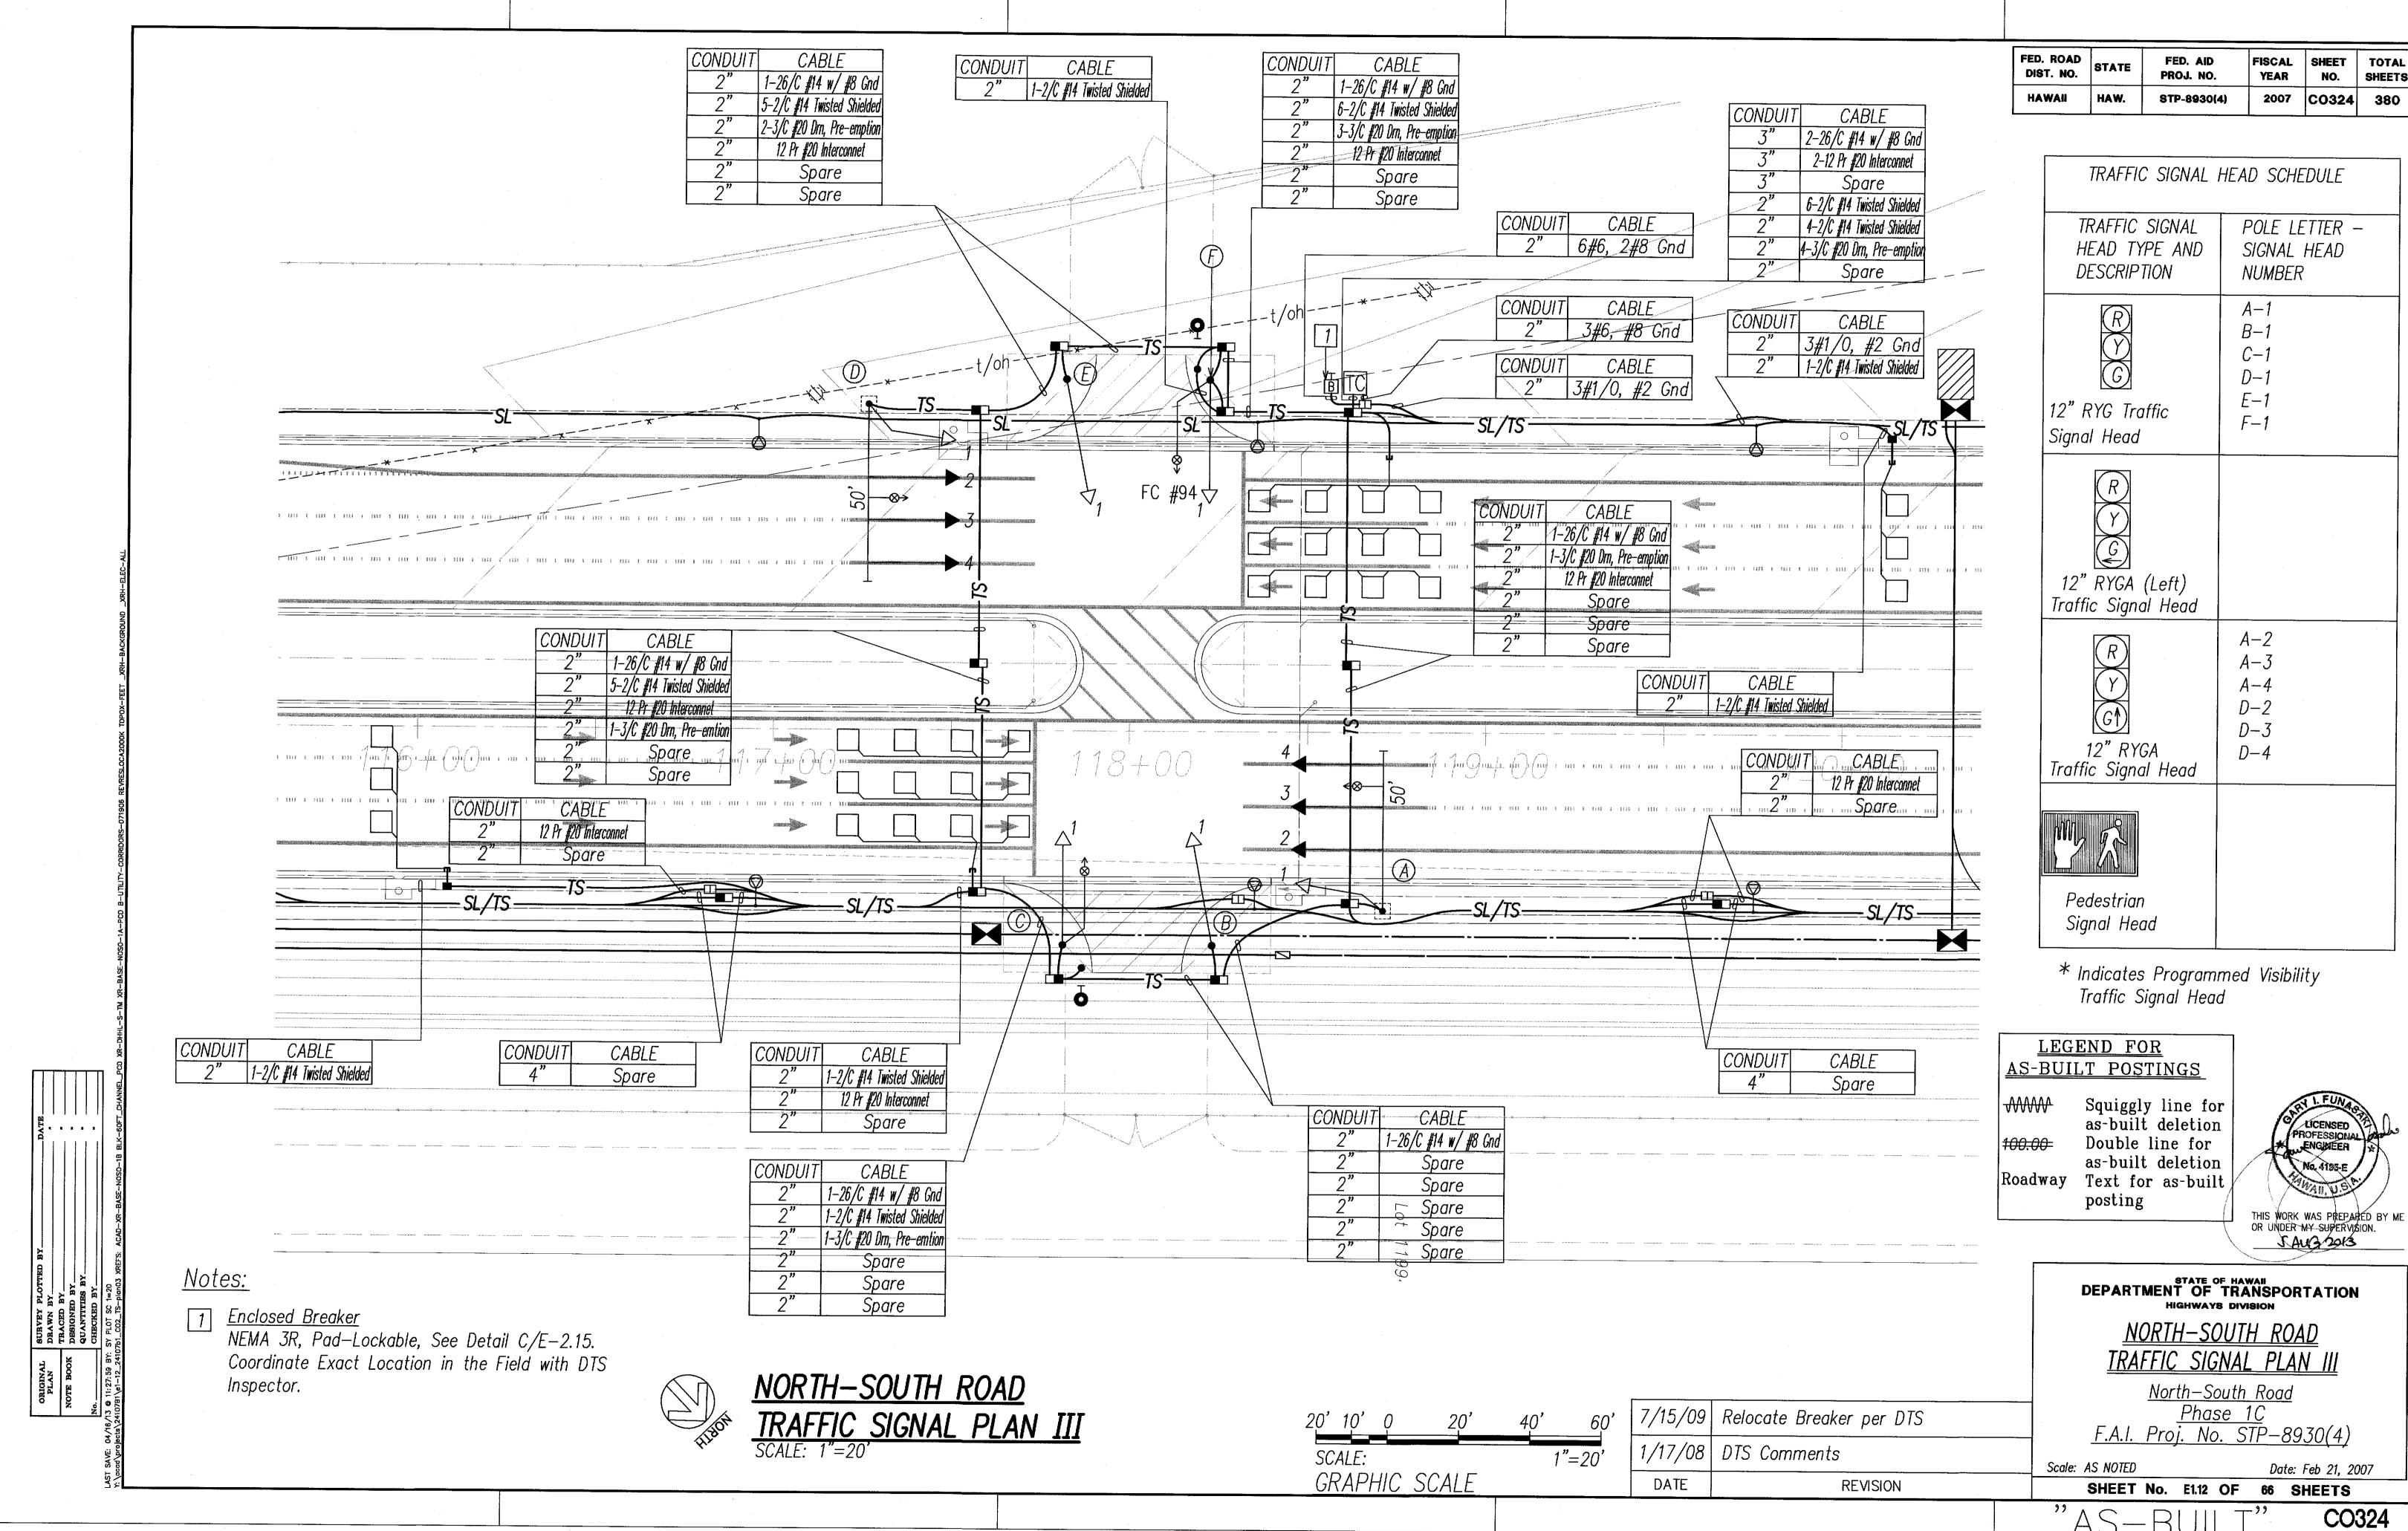


#### GENERAL NOTES

- 1. The locations of new inductance loops, piezo sensors, pullboxes and cabinets/junction boxes shall be staked out in the field by the Contractor and approved by the Engineer prior to installation.
- 2. The Contractor shall inform the Engineer at least three days prior to saw—cutting pavement and installing inductance loops.
- 3. Continuity of inductance loops, piezo sensors, and lead—in wires shall be tested and warranted by the Contractor for one year from date of acceptance.
- 4. The Contractor shall restore all affected areas to their original condition. This item of work shall not be paid for separately, but shall be considered incidental to work of other paid items.
- 5. The Contractor shall verify the locations of the existing utilities and underground structures whether or not shown on plans.
- 6. The Contractor shall assume that existing underground utilities not shown on the plans may exist, therefore, he shall contact the utility companies for information and toning.
- 7. The Contractor shall be held liable for any damages incurred to the existing utilities and under ground structures as a result of his operation. All damaged portions shall be replaced in accordance with the Standards and Specifications of the affected utility company at no cost to the STATE.
- 8. Changes to the contract plans and specifications shall not be permitted, unless otherwise authorized by the Engineer, upon written justification and request for approval by the Contractor.
- Highway crossing sleeve shall be provided with 36" cover.

#### GENERAL NOTES

- 1. Detector loop shall consist of four (4) turns of 1/c #12 meeting IMSA SPEC 51-5 or equivalent embedded in a 3/8" minimum sawcut, except as noted.
- 2. Loop and lead—in to the first pullbox shall be one continuous wire. Lead—in wires from the same loop shall be twisted in pairs, two turns per foot. DO NOT twist one loop-pairs with another loop-pairs.
- 3. All lead—in wires shall be crimped with open end lugs that will fit into the terminal board slots snugly.
- 4. Stager traffic loops on roadway less than 12 foot lane width.
- 5. The Contractor shall connect the inductance wires on each terminal slot.
- 6. The left lane in the direction of traffic flow is designated as Lane 1, and the lane next to its right as Lane 2 and so on as indicated on plans.
- Vacuum and clean sawcut thoroughly before installing sensors and/or cables and filling with hot tar or epoxy sealant.
- 8. All loop lead—in wires in all enclosures including pullboxes shall be identified and labeled by direction of traffic flow and lane numbers as shown on plans.
- additional slack.

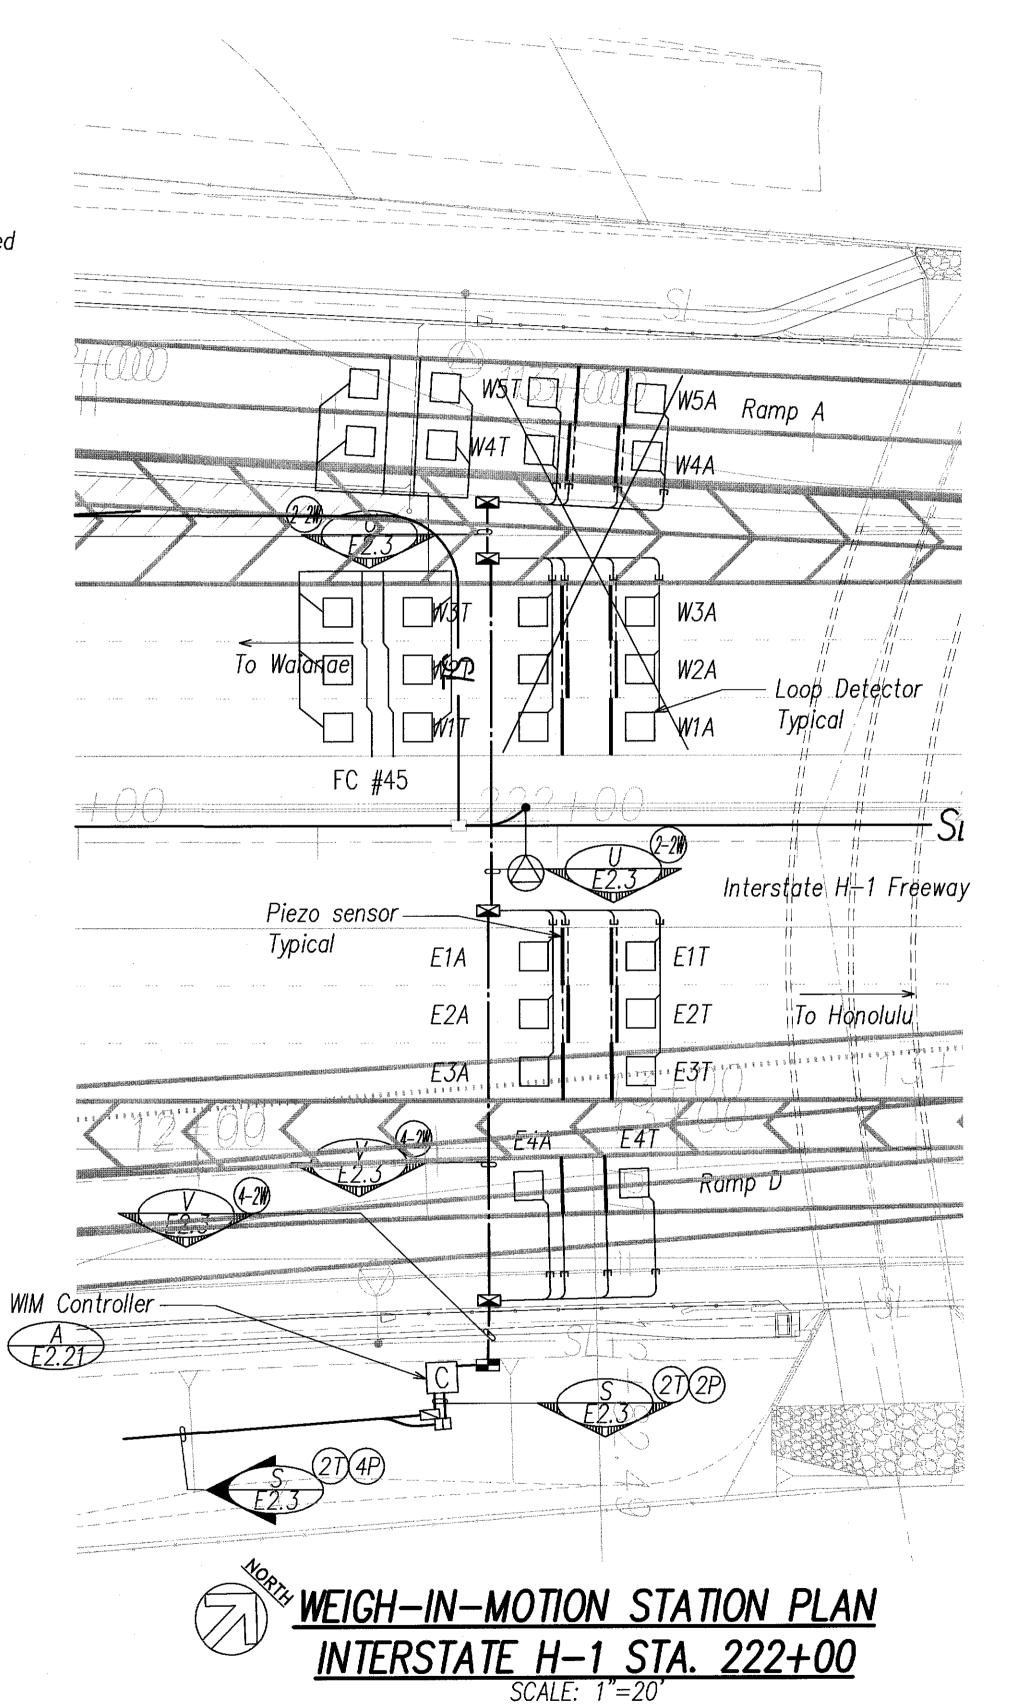

SCALE:

GRAPHIC SCALE

FED. ROAD FED. AID FISCAL SHEET TOTAL DIST. NO. PROJ. NO. YEAR SHEETS 2007 ADD. 325 380 HAW. STP-8930(4)


LEGEND:

W = WEST

E = EAST

T = TRAILING

A = APPROACHING

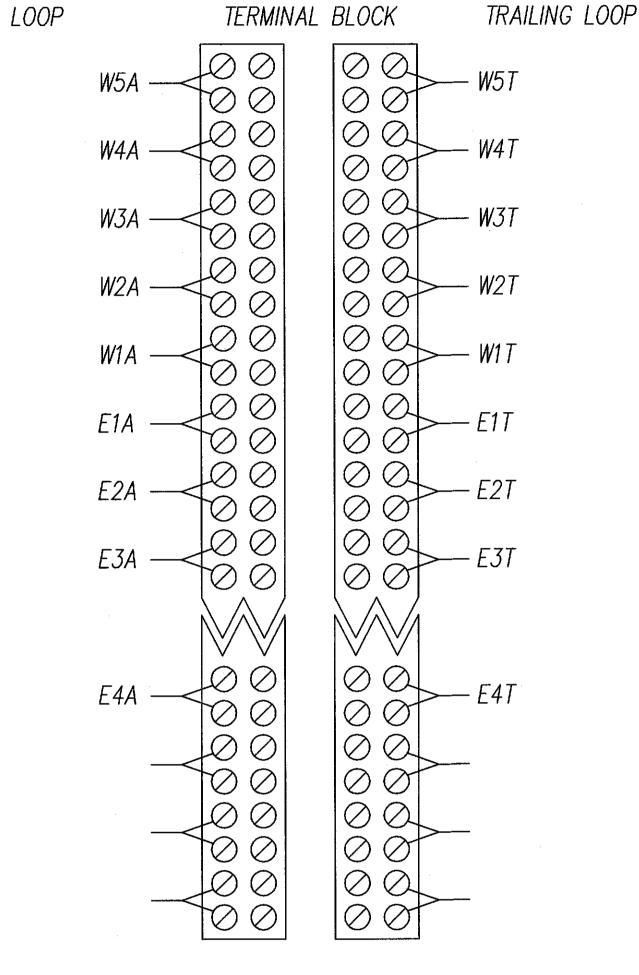


TOP OF

**APPROACHING** 

BOTTOM OF TERMINAL BLOCK

> M - 332ACABINET

CONNECTING LAYOUT OF LOOP LEAD-IN WIRES TO TERMINAL BLOCK INSIDE M332A CABINET

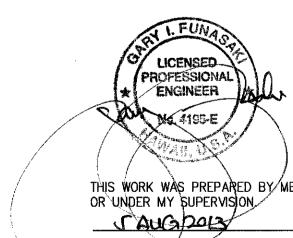

Squiggly line for as-built deletion Double line for as-built deletion Roadway Text for as-built

DEPARTMENT OF TRANSPORTATION WEIGH-IN-MOTION STATION PLAN

INTERSTATE H-1 STA. 222+00 North-South Road

<u>Phase 1C</u> F.A.I. Proj. No. STP-8930(4)

Scale: AS NOTED Date: Feb 21, 2007 SHEET No. E1.13 OF 66 SHEETS

ADD. 325


LEGEND FOR AS-BUILT POSTINGS


posting


4/20/07 A Revised WIM notes REVISION


DATE

All cables and wires terminated within an enclosure shall have a minimum 12"

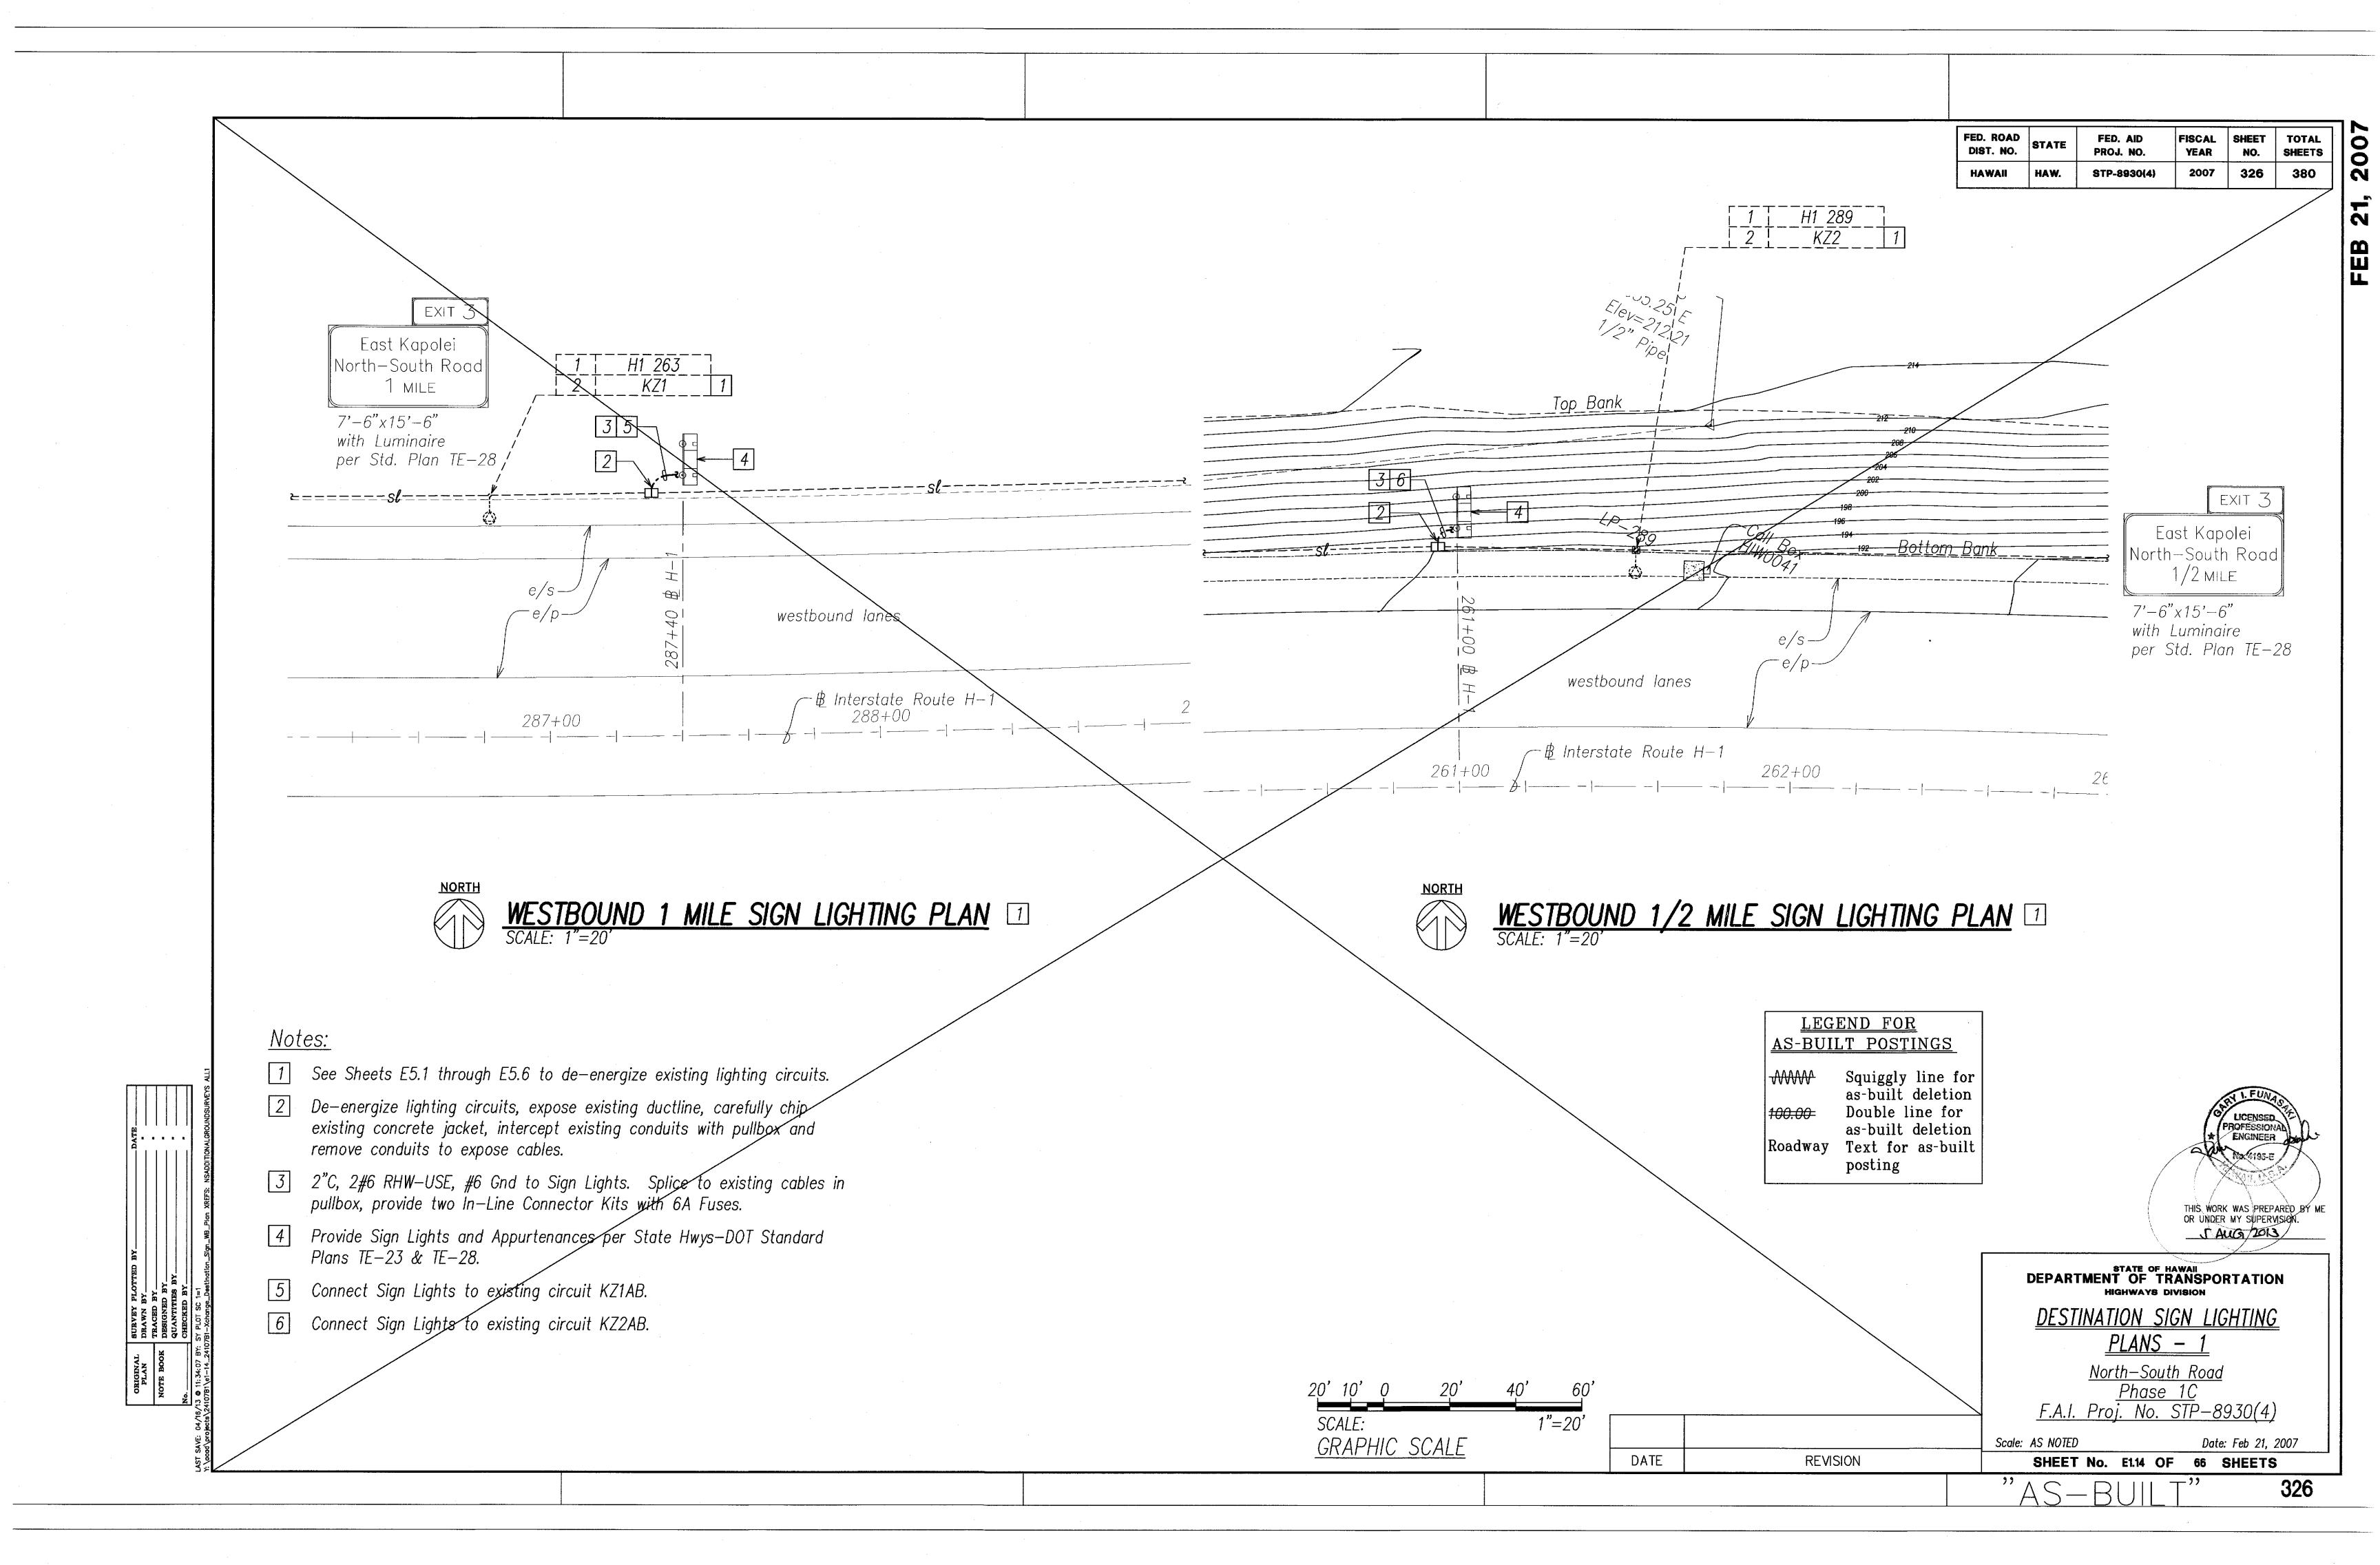

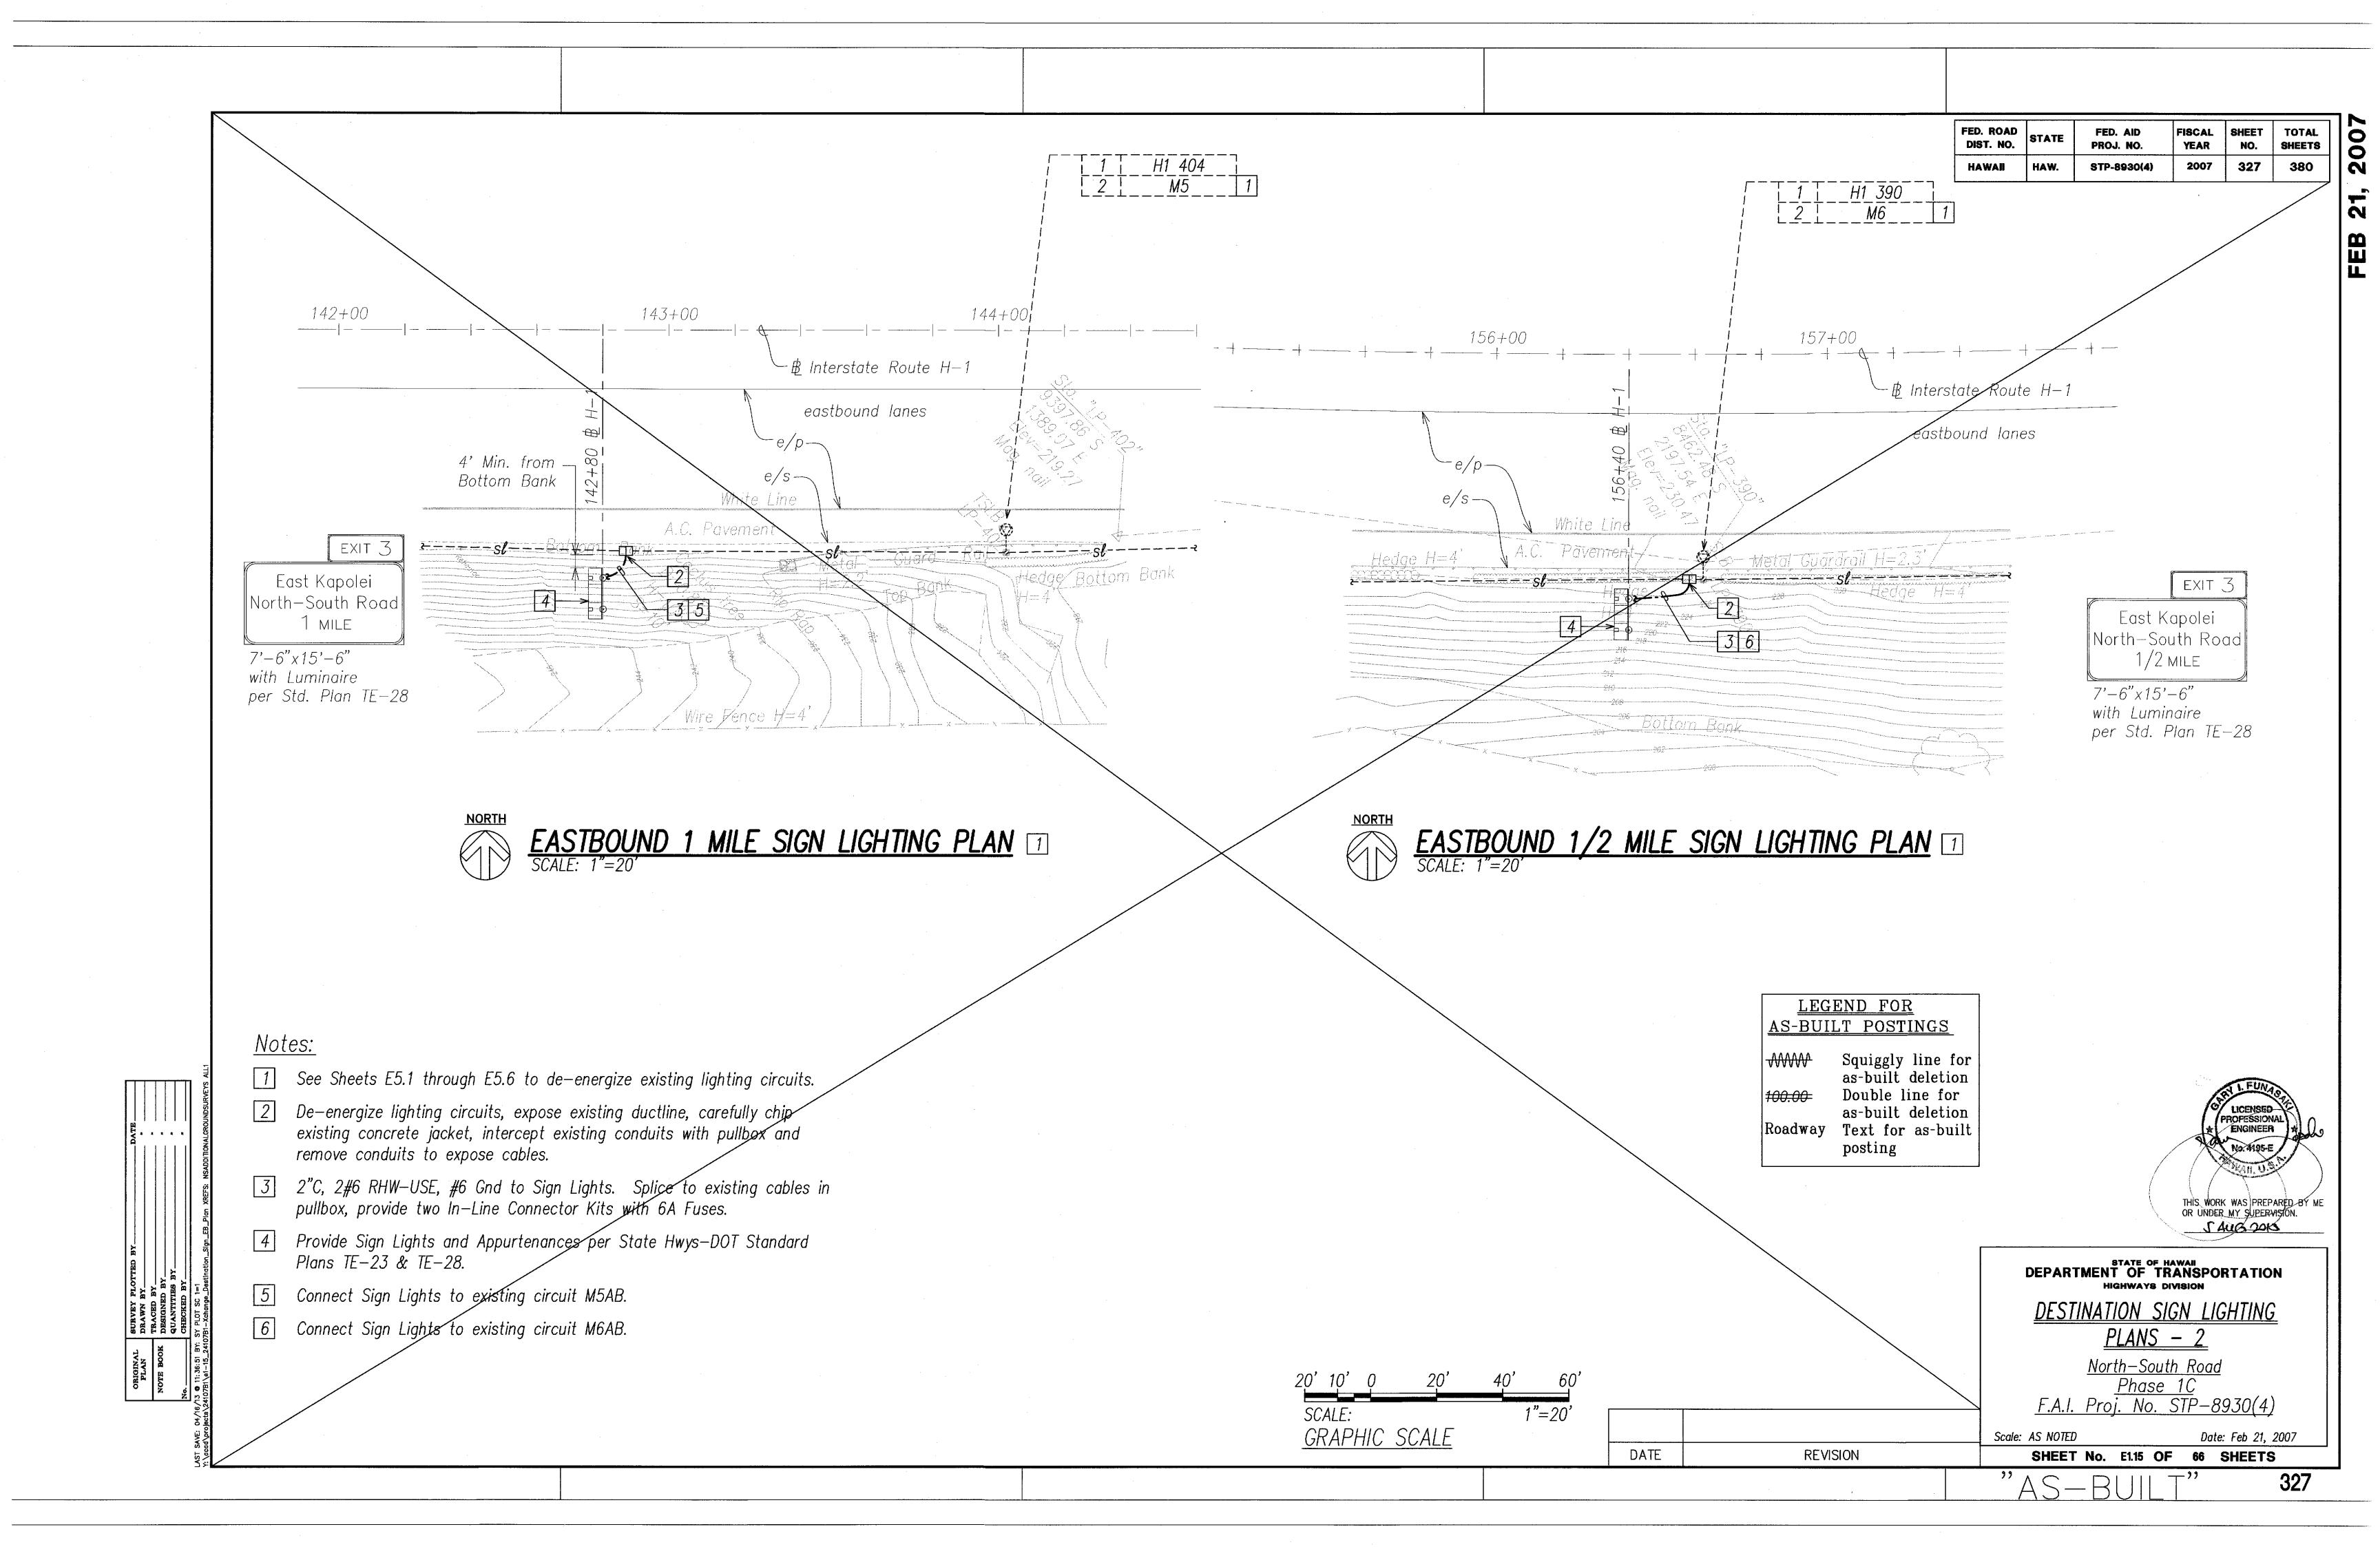


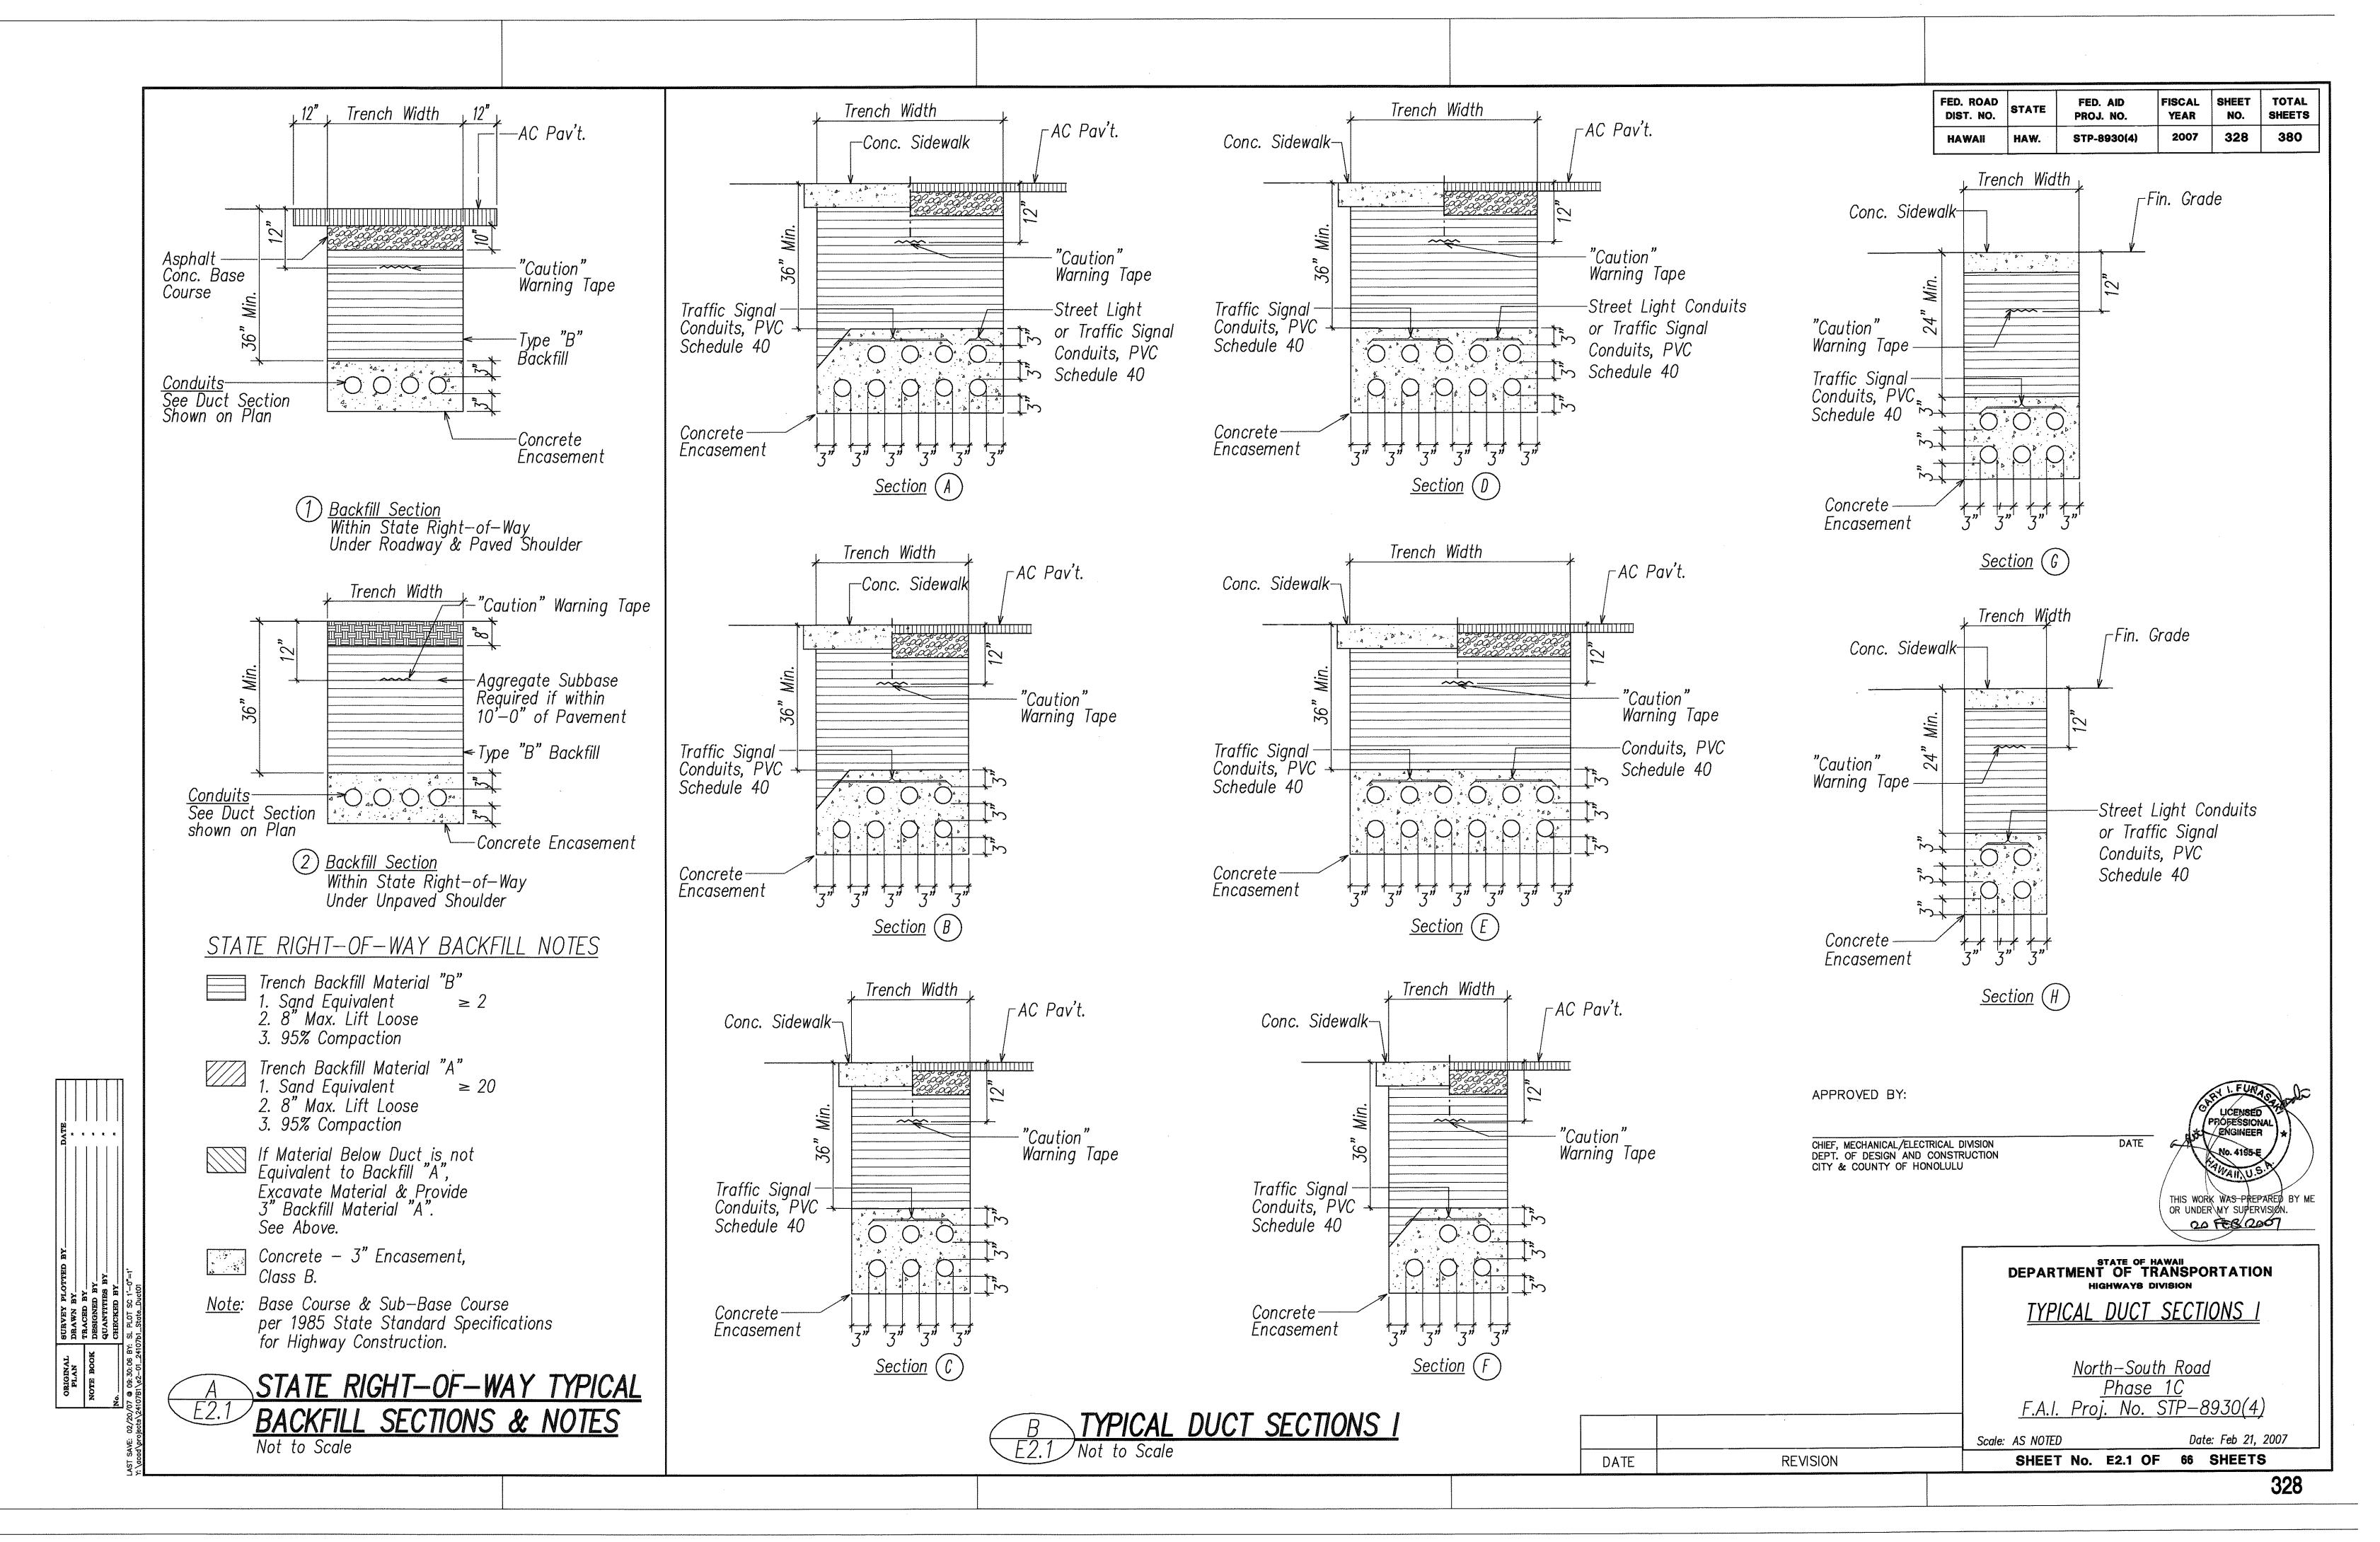


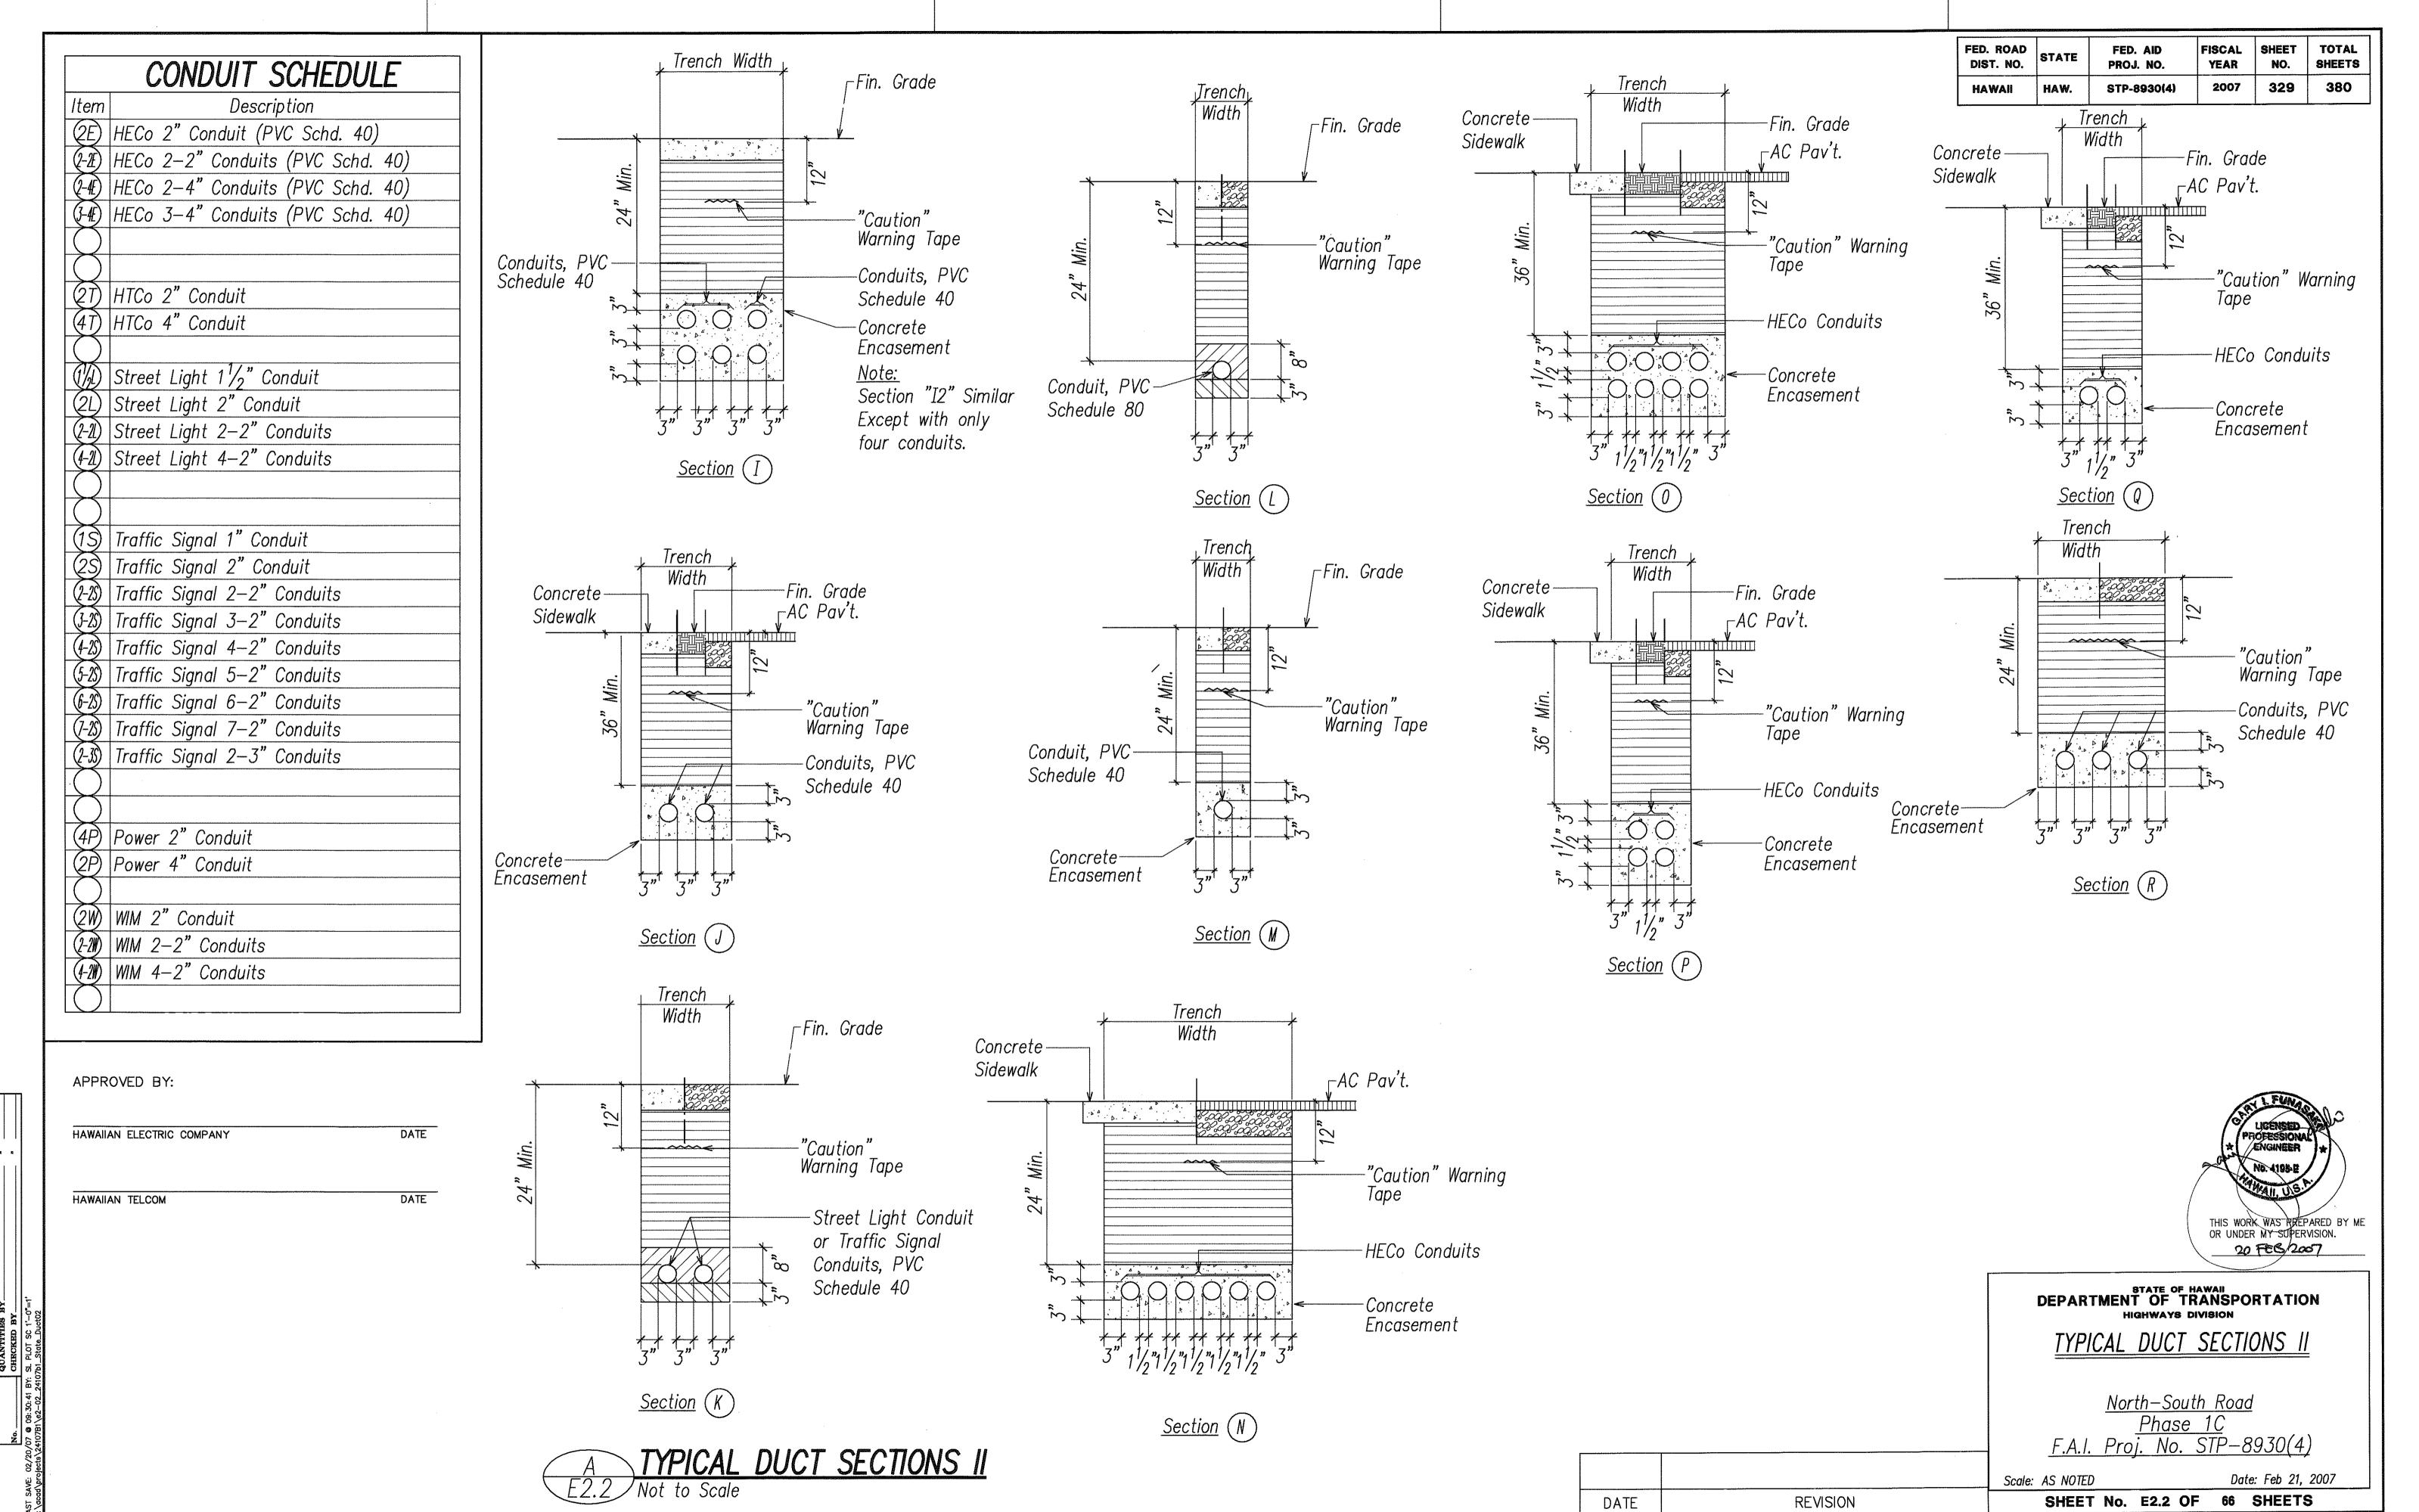


329


Complete the Compl

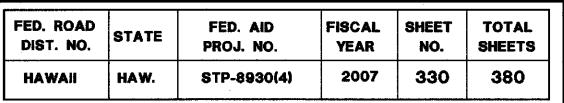

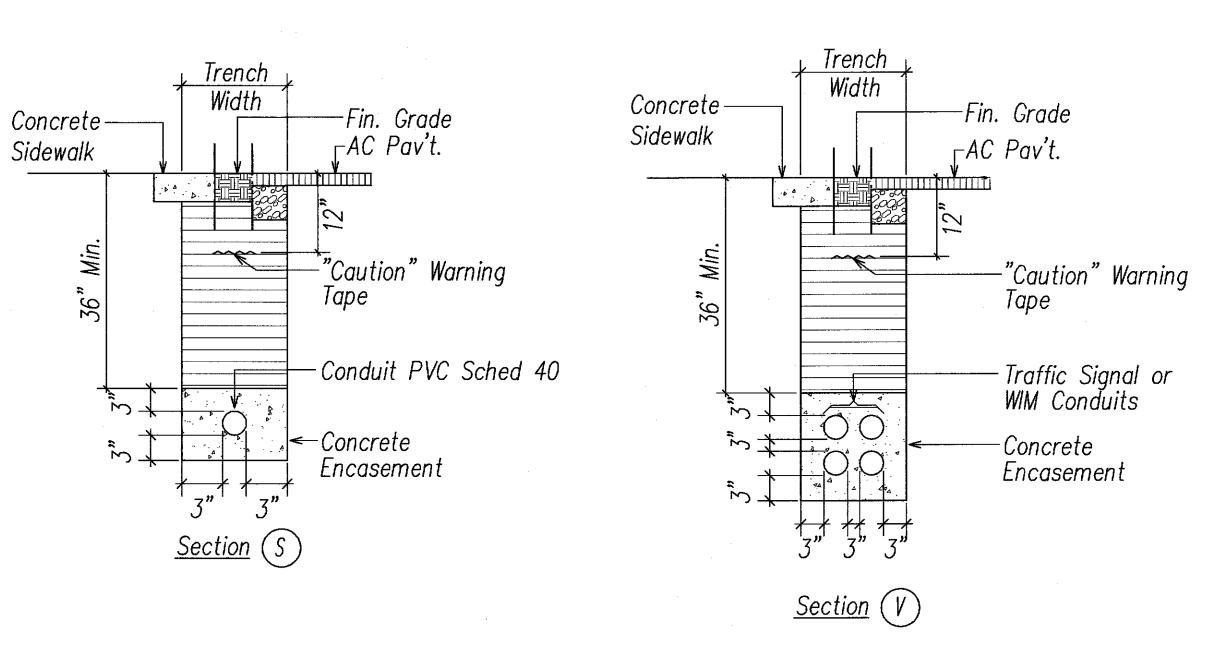

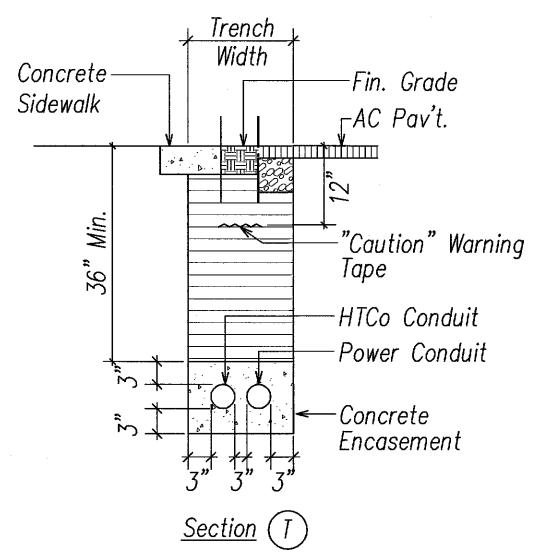

FC #45 \* REPARE OF H-1 PAVEMENT FOR WIM TRENCH CROSSING THE H1 FREEWAY WILL NOT FOLLOW THE TYPICAL DETAILS ON THIS PAGE. REPAIR SHALL CONSIST OF REPLACING FULL PANELS BETWEEN TRANSVERSE JOINTS. OVER THE COMPACTED TRENCH BACKFILL: 11" PCC PAVEMENT13" AGG SUB BASE SEE 'TRANSVERSE CONSTRUCTION JOINT @ EXISTING PCC PAVEMENT' DETAIL ON PG ADD 110 / C4.8

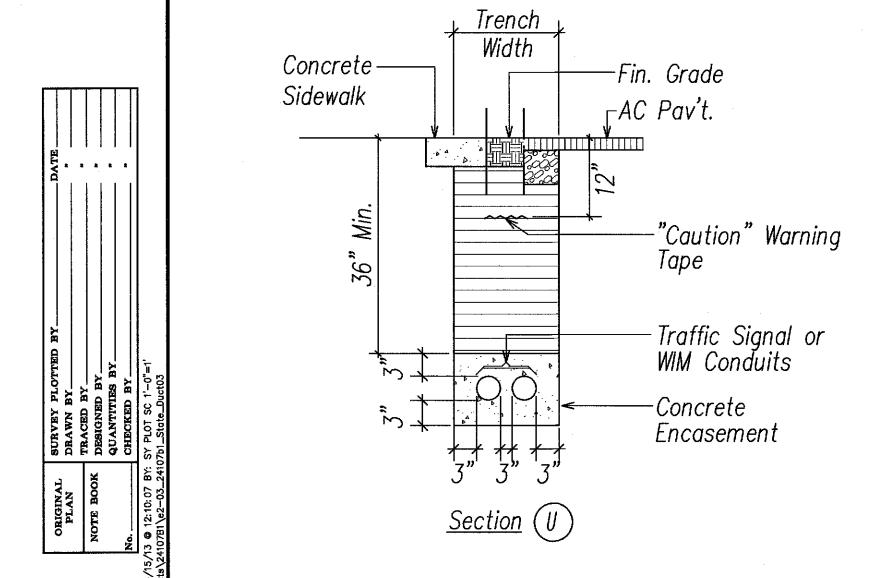

TYPICAL DUCT SECTIONS III Not to Scale

LEGEND FOR AS-BUILT POSTINGS

Squiggly line for as-built deletion Roadway Text for as-built

DATE

Double line for as-built deletion posting

APPROVED BY:

REVISION

HAWAIIAN ELECTRIC COMPANY

THIS WORK WAS PREPARED BY ME OR UNDER MY SUPERVISION. DATE HAWAIIAN TELCOM

STATE OF HAWAII
DEPARTMENT OF TRANSPORTATION
HIGHWAYS DIVISION

DATE

TYPICAL DUCT SECTIONS III


North—South Road <u>Phase 1C</u> F.A.I. Proj. No. STP-8930(4)

Scale: AS NOTED


Date: Feb 21, 2007 SHEET No. E2.3 OF 66 SHEETS


330


LICENSED PROFESSIONAL ENGINEER

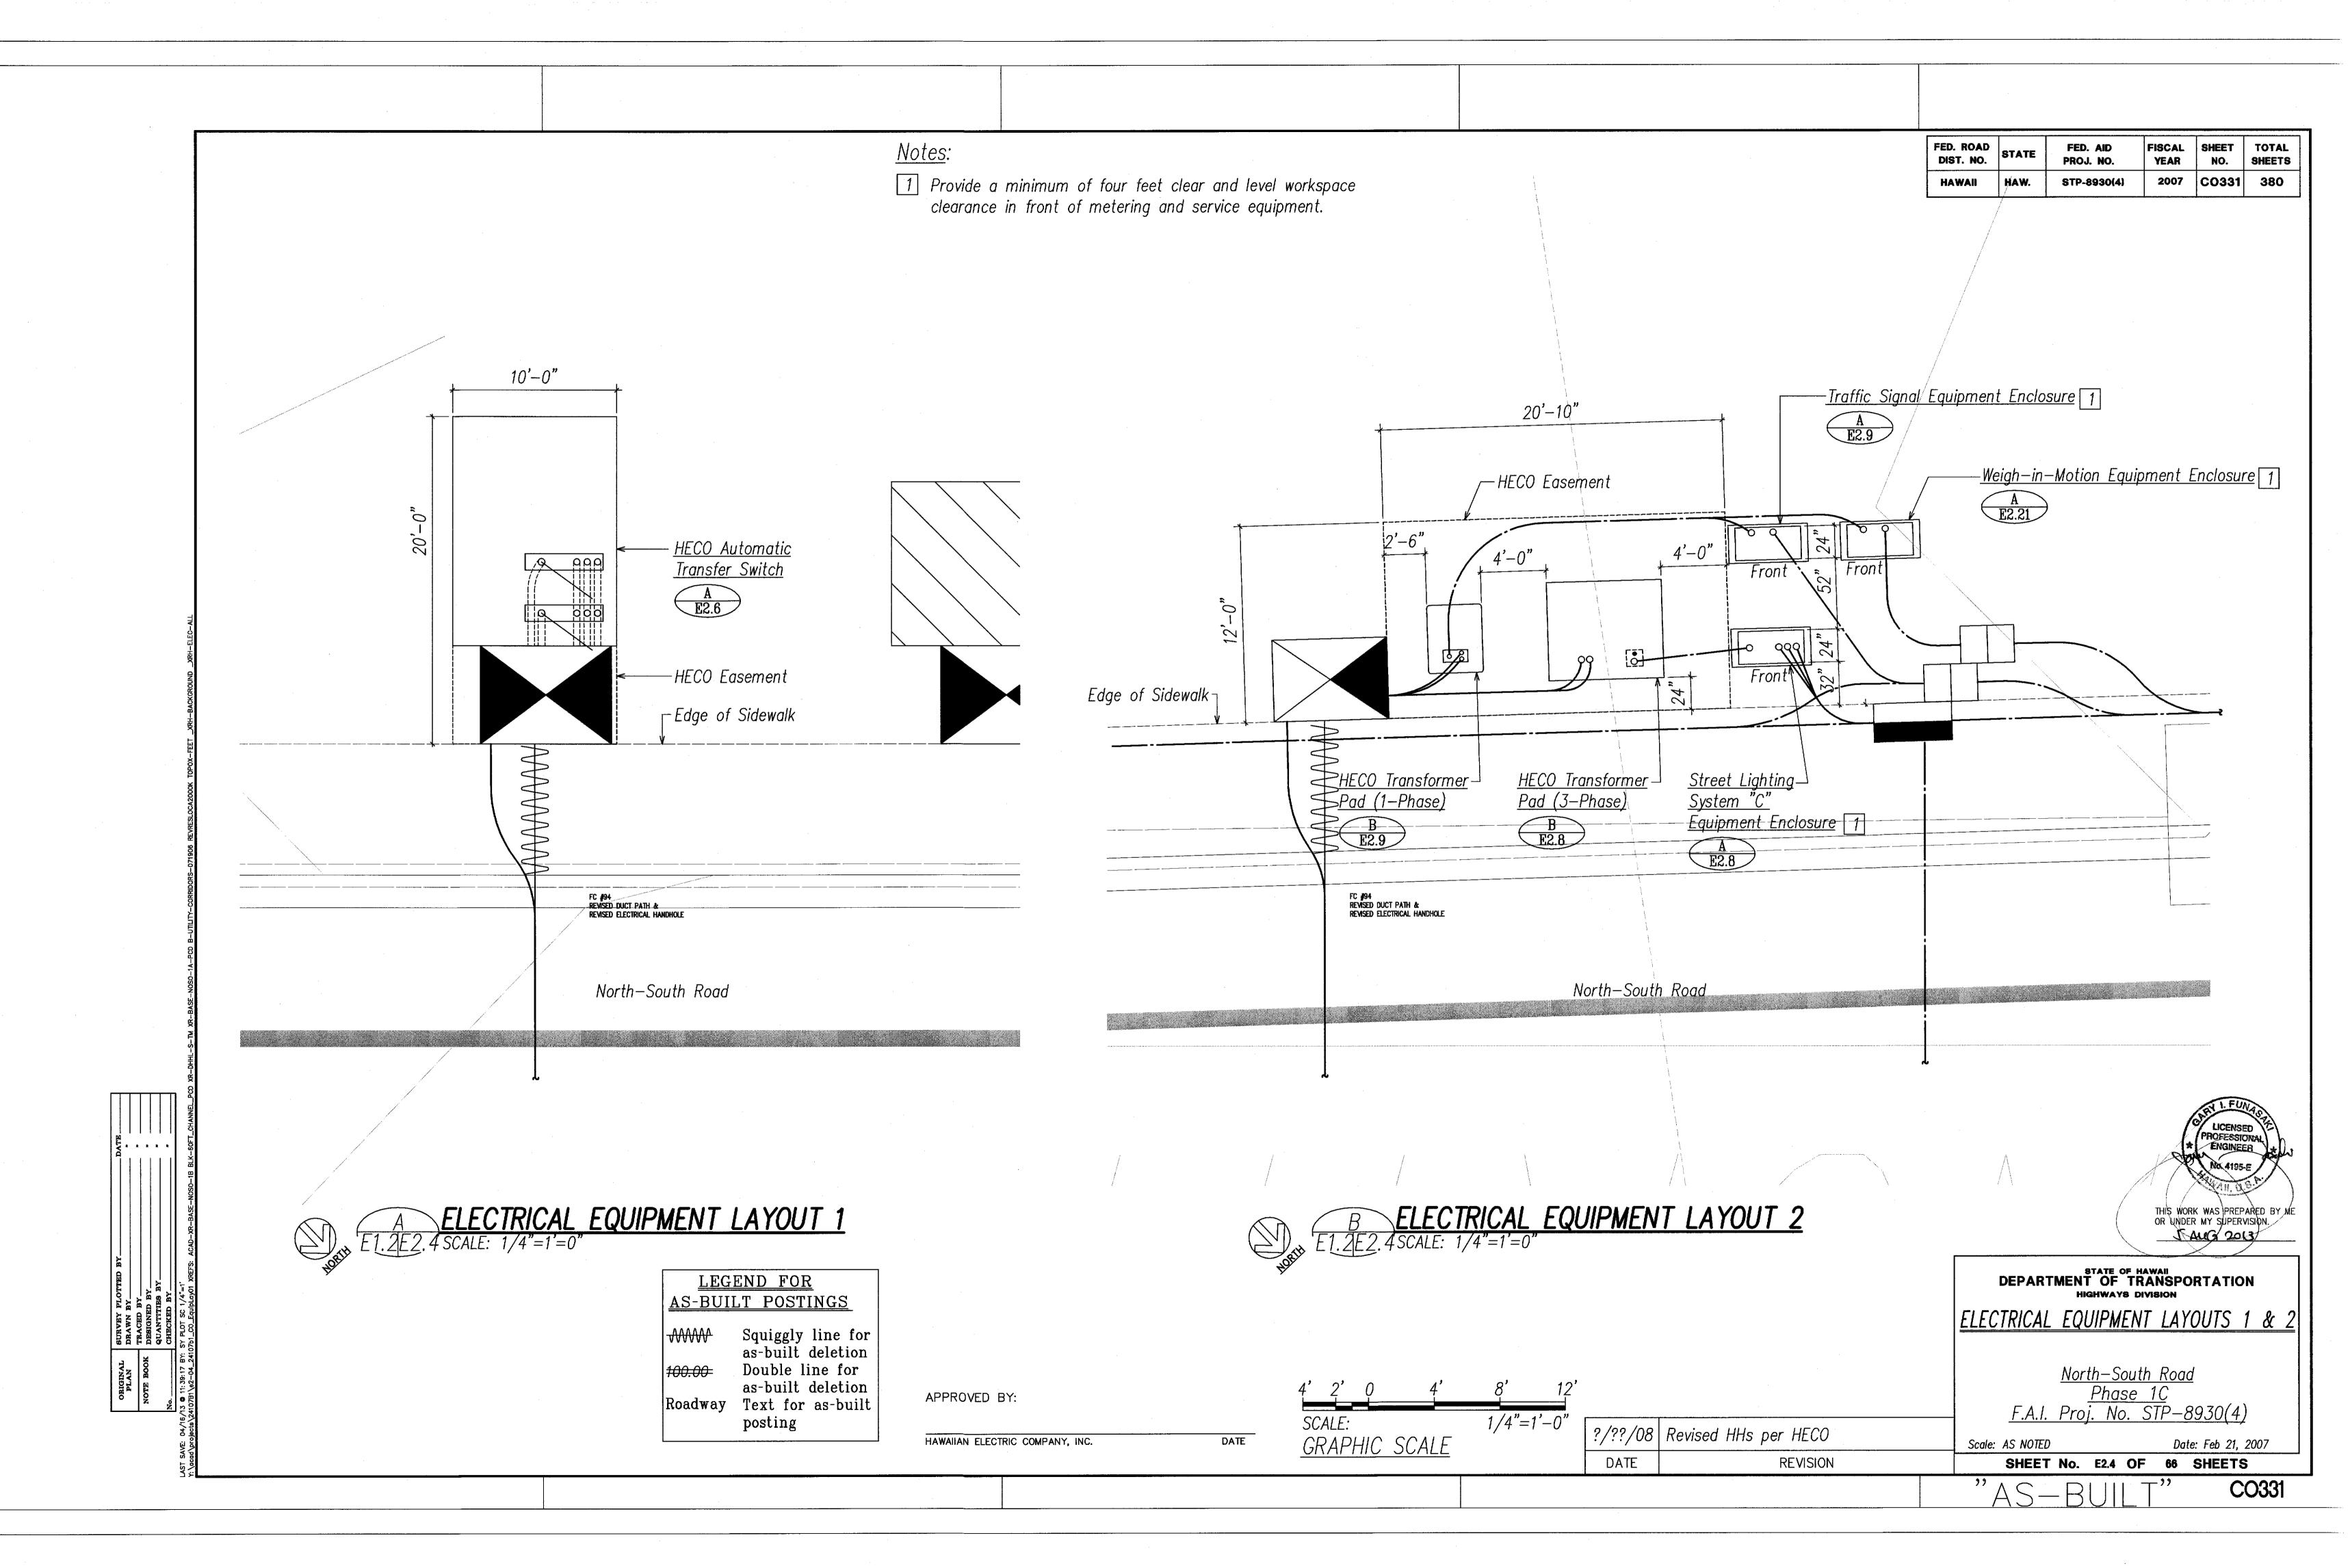

FED. ROAD	STATE	FED. AID	FISCAL	SHEET	TOTAL
DIST. NO.		PROJ. NO.	YEAR	NO.	SHEETS
HAWAII	HAW.	STP-8930(4)	2007	332	380

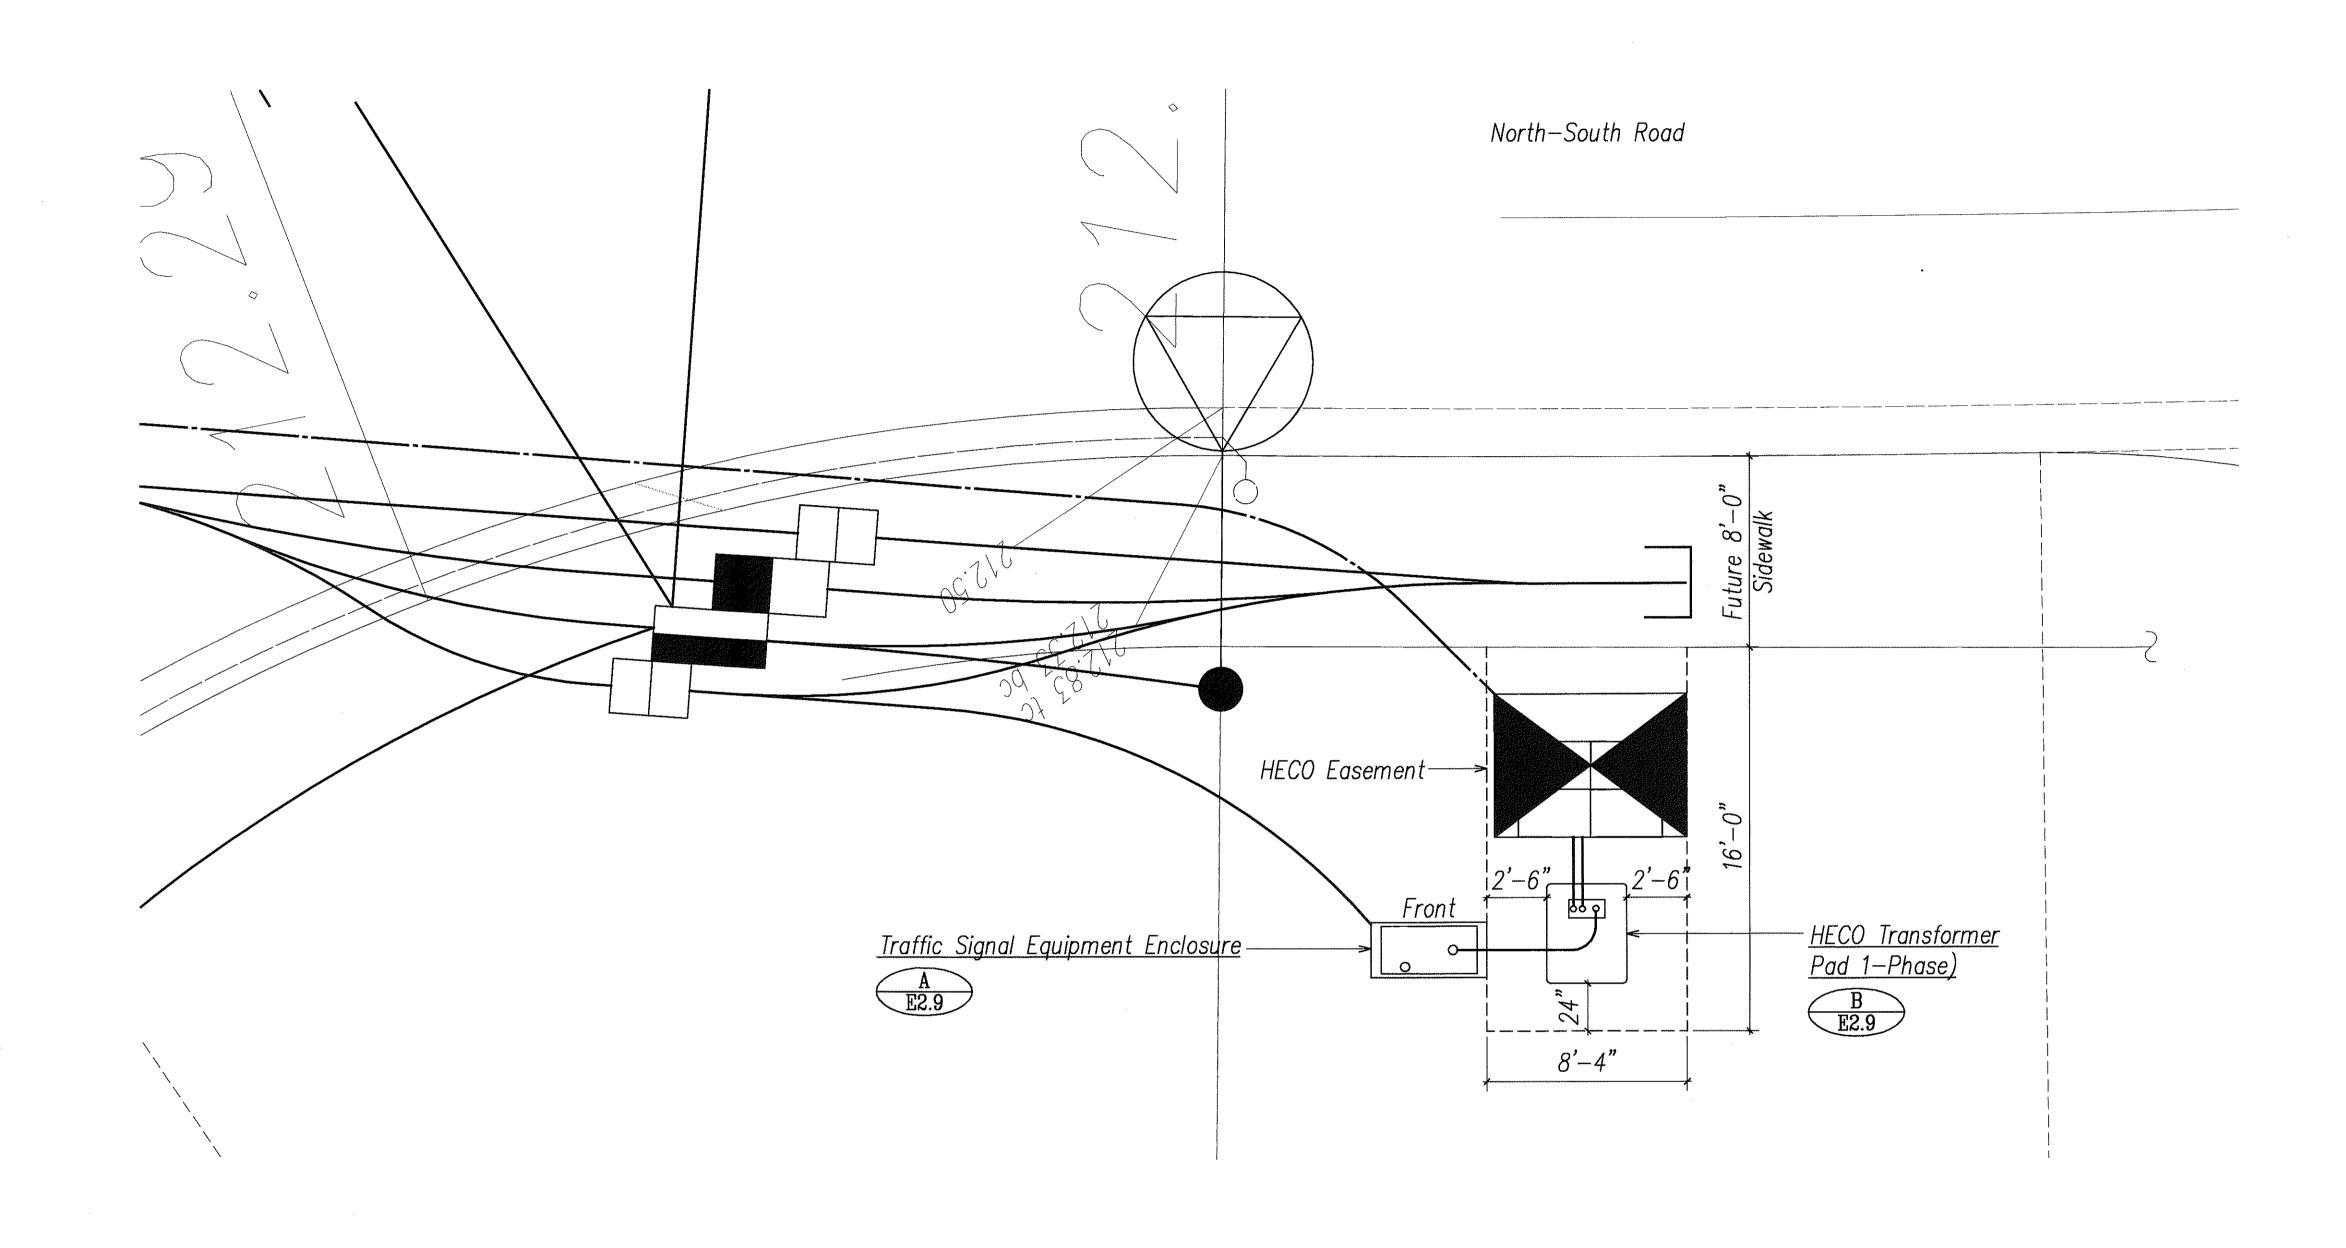

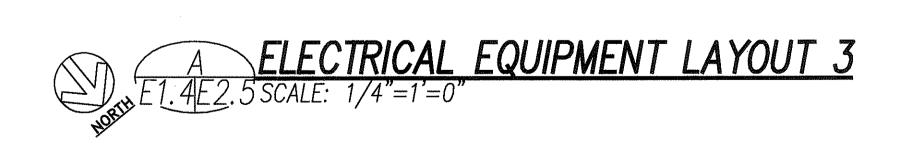

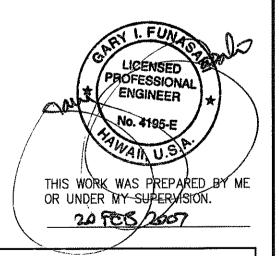

APPROVED BY:

DATE HAWAIIAN ELECTRIC COMPANY, INC.

1/4"=1'-0" GRAPHIC SCALE


REVISION DATE

DEPARTMENT OF TRANSPORTATION
HIGHWAYS DIVISION ELECTRICAL EQUIPMENT LAYOUT 3

<u>North-South Road</u> <u>Phase 1C</u> F.A.I. Proj. No. STP-8930(4)

Scale: AS NOTED

Date: Feb 21, 2007 SHEET No. E2.5 OF 66 SHEETS

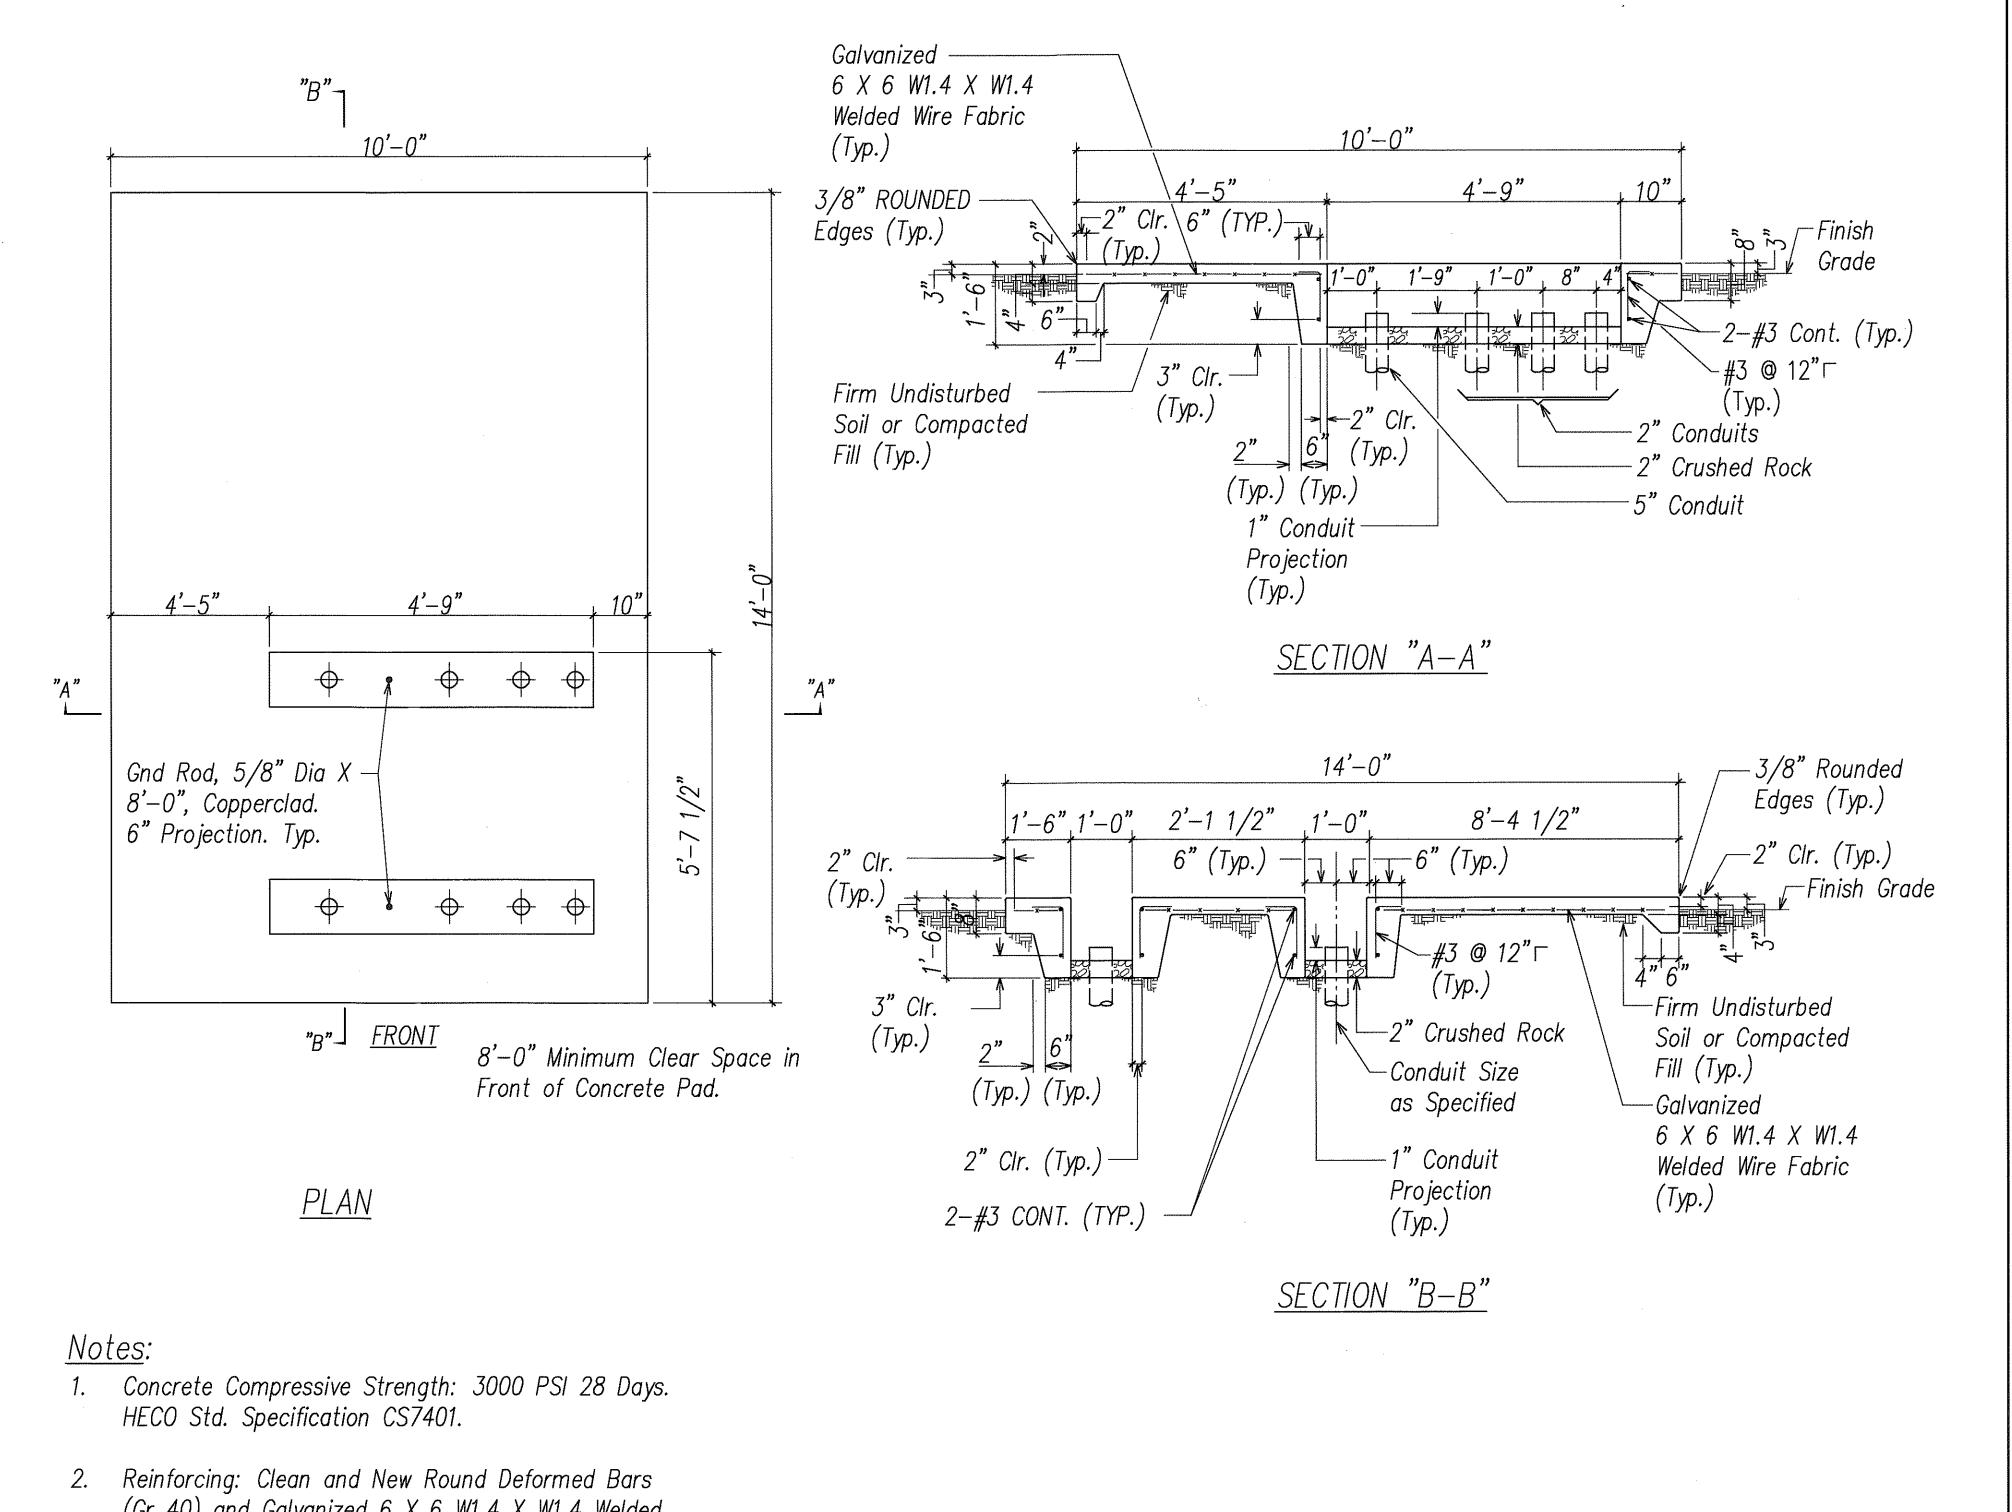

FED. ROAD DIST. NO. FED. AID FISCAL PROJ. NO. YEAR 2007 333 380 HAW. IIAWAH STP-8930(4)

# THIS WORK WAS PREPARED BY ME OR UNDER MY SUPERVISION.

# DEPARTMENT OF TRANSPORTATION HIGHWAYS DIVISION

AUTOMATIC TRANSFER SWITCHING EQUIPMENT PAD

North—South Road

<u>Phase 1C</u> F.A.I. Proj. No. STP-8930(4)

- (Gr 40) and Galvanized 6 X 6 W1.4 X W1.4 Welded Wire Fabric.
- 3. Top of Concrete Pad to be Smooth and True. Other Exposed Surfaces to be Smooth and Free from Defects.
- Construction to Comply with ACI 318 as Amended.
- 5. Weight of Switchgear Equals 2,150 Pounds.

AUTOMATIC TRANSFER SWITCHING EQUIPMENT PAD E2.6 Not to Scale (HECO Std. 30-5040)

HAWAIIAN ELECTRIC COMPANY, INC.

APPROVED BY:


DATE

DATE


REVISION

Scale: AS NOTED

Date: Feb 21, 2007 SHEET No. E2.6 OF 66 SHEETS

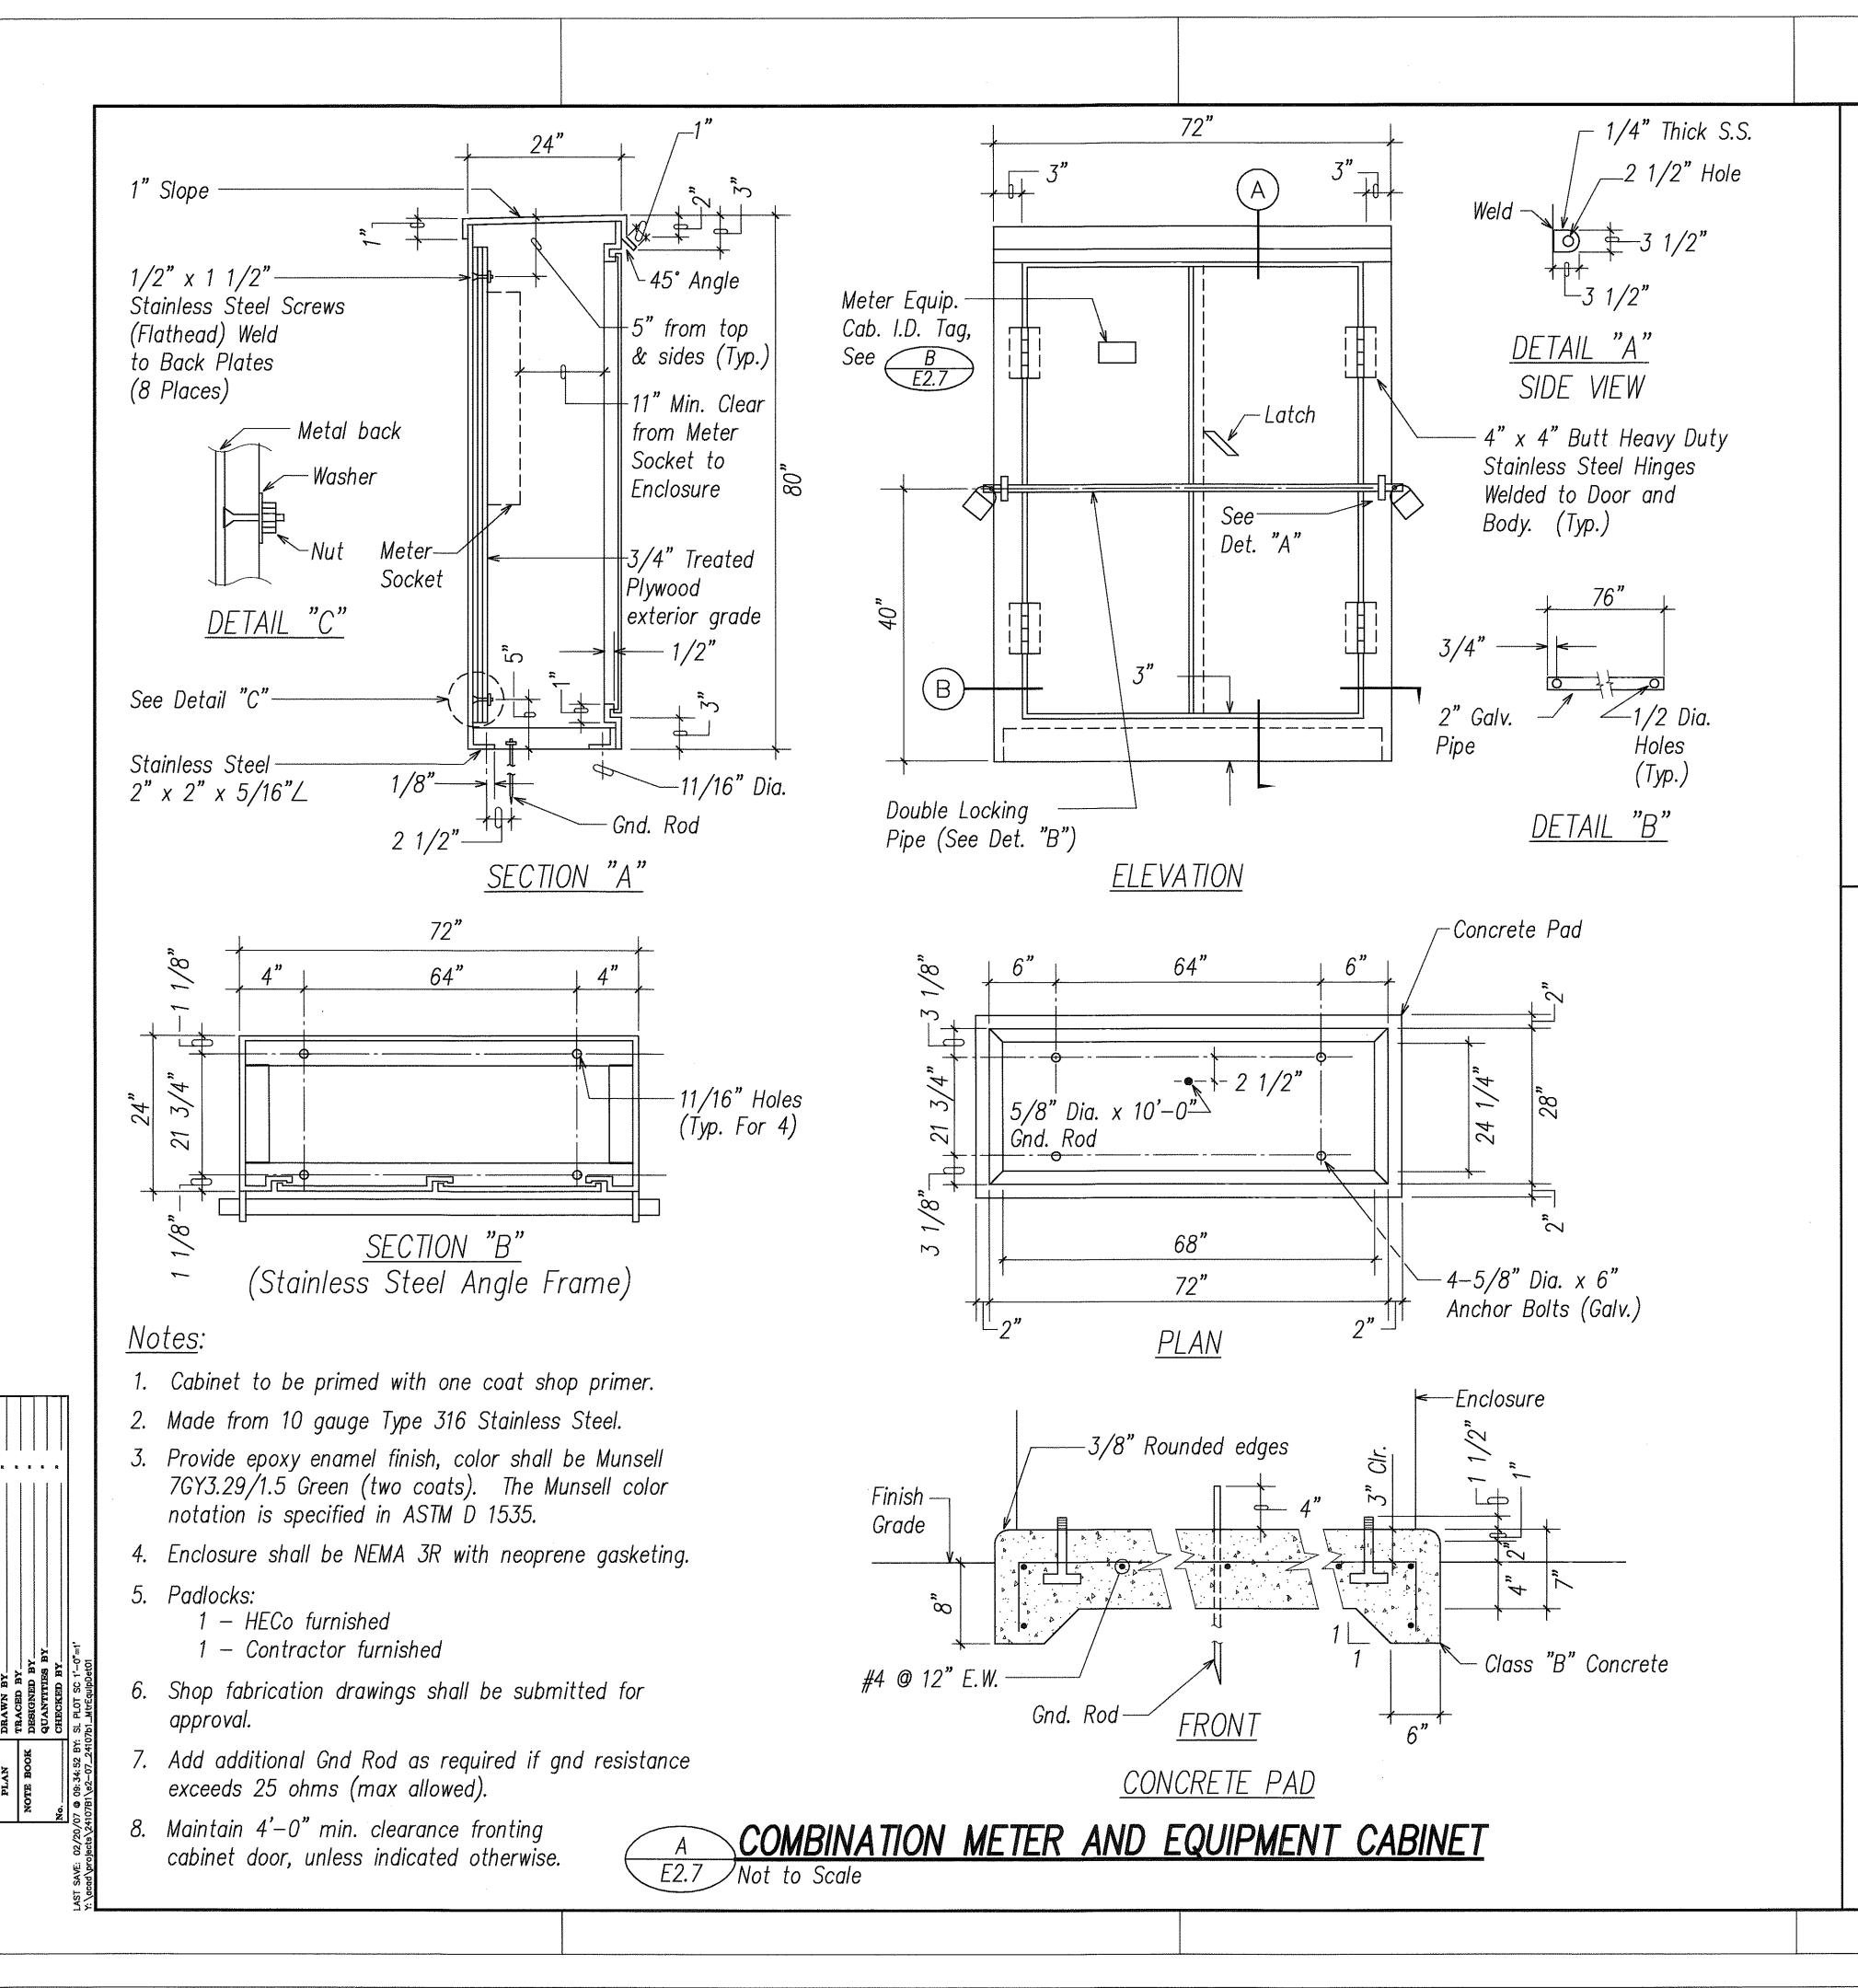

FED. ROAD DIST. NO. FISCAL YEAR SHEET FED. AID PROJ. NO. 2007 334 380 HAW. STP-8930(4) HAWAII

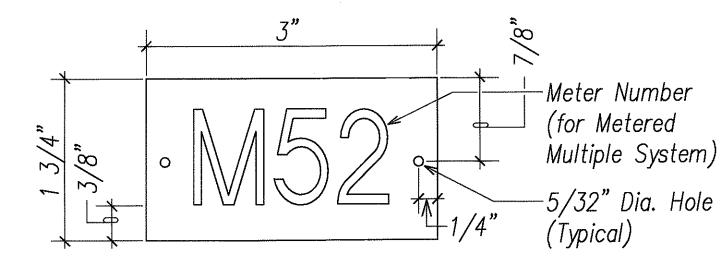

#### *Notes*:

APPROVED BY:

DATE

- 1. Use 2 ply plastic black, white. Thickness: black cap sheet 0.010"; white base sheet - 0.052"
- 2. Number size shall be 1" high and engraved 1/8" wide, white in color (number as required).
- 3. Attach to meter enclosure with No. 8 stainless steel drive screws.
- 4. Numbers are inscribed by cutting through "black cap sheet" to expose "white letters".







DEPARTMENT OF TRANSPORTATION
HIGHWAYS DIVISION

METER AND EQUIPMENT ENCLOSURE DETAILS

North—South Road Phase 1C F.A.I. Proj. No. STP-8930(4)

Date: Feb 21, 2007 Scale: AS NOTED SHEET No. E2.7 OF 66 SHEETS REVISION

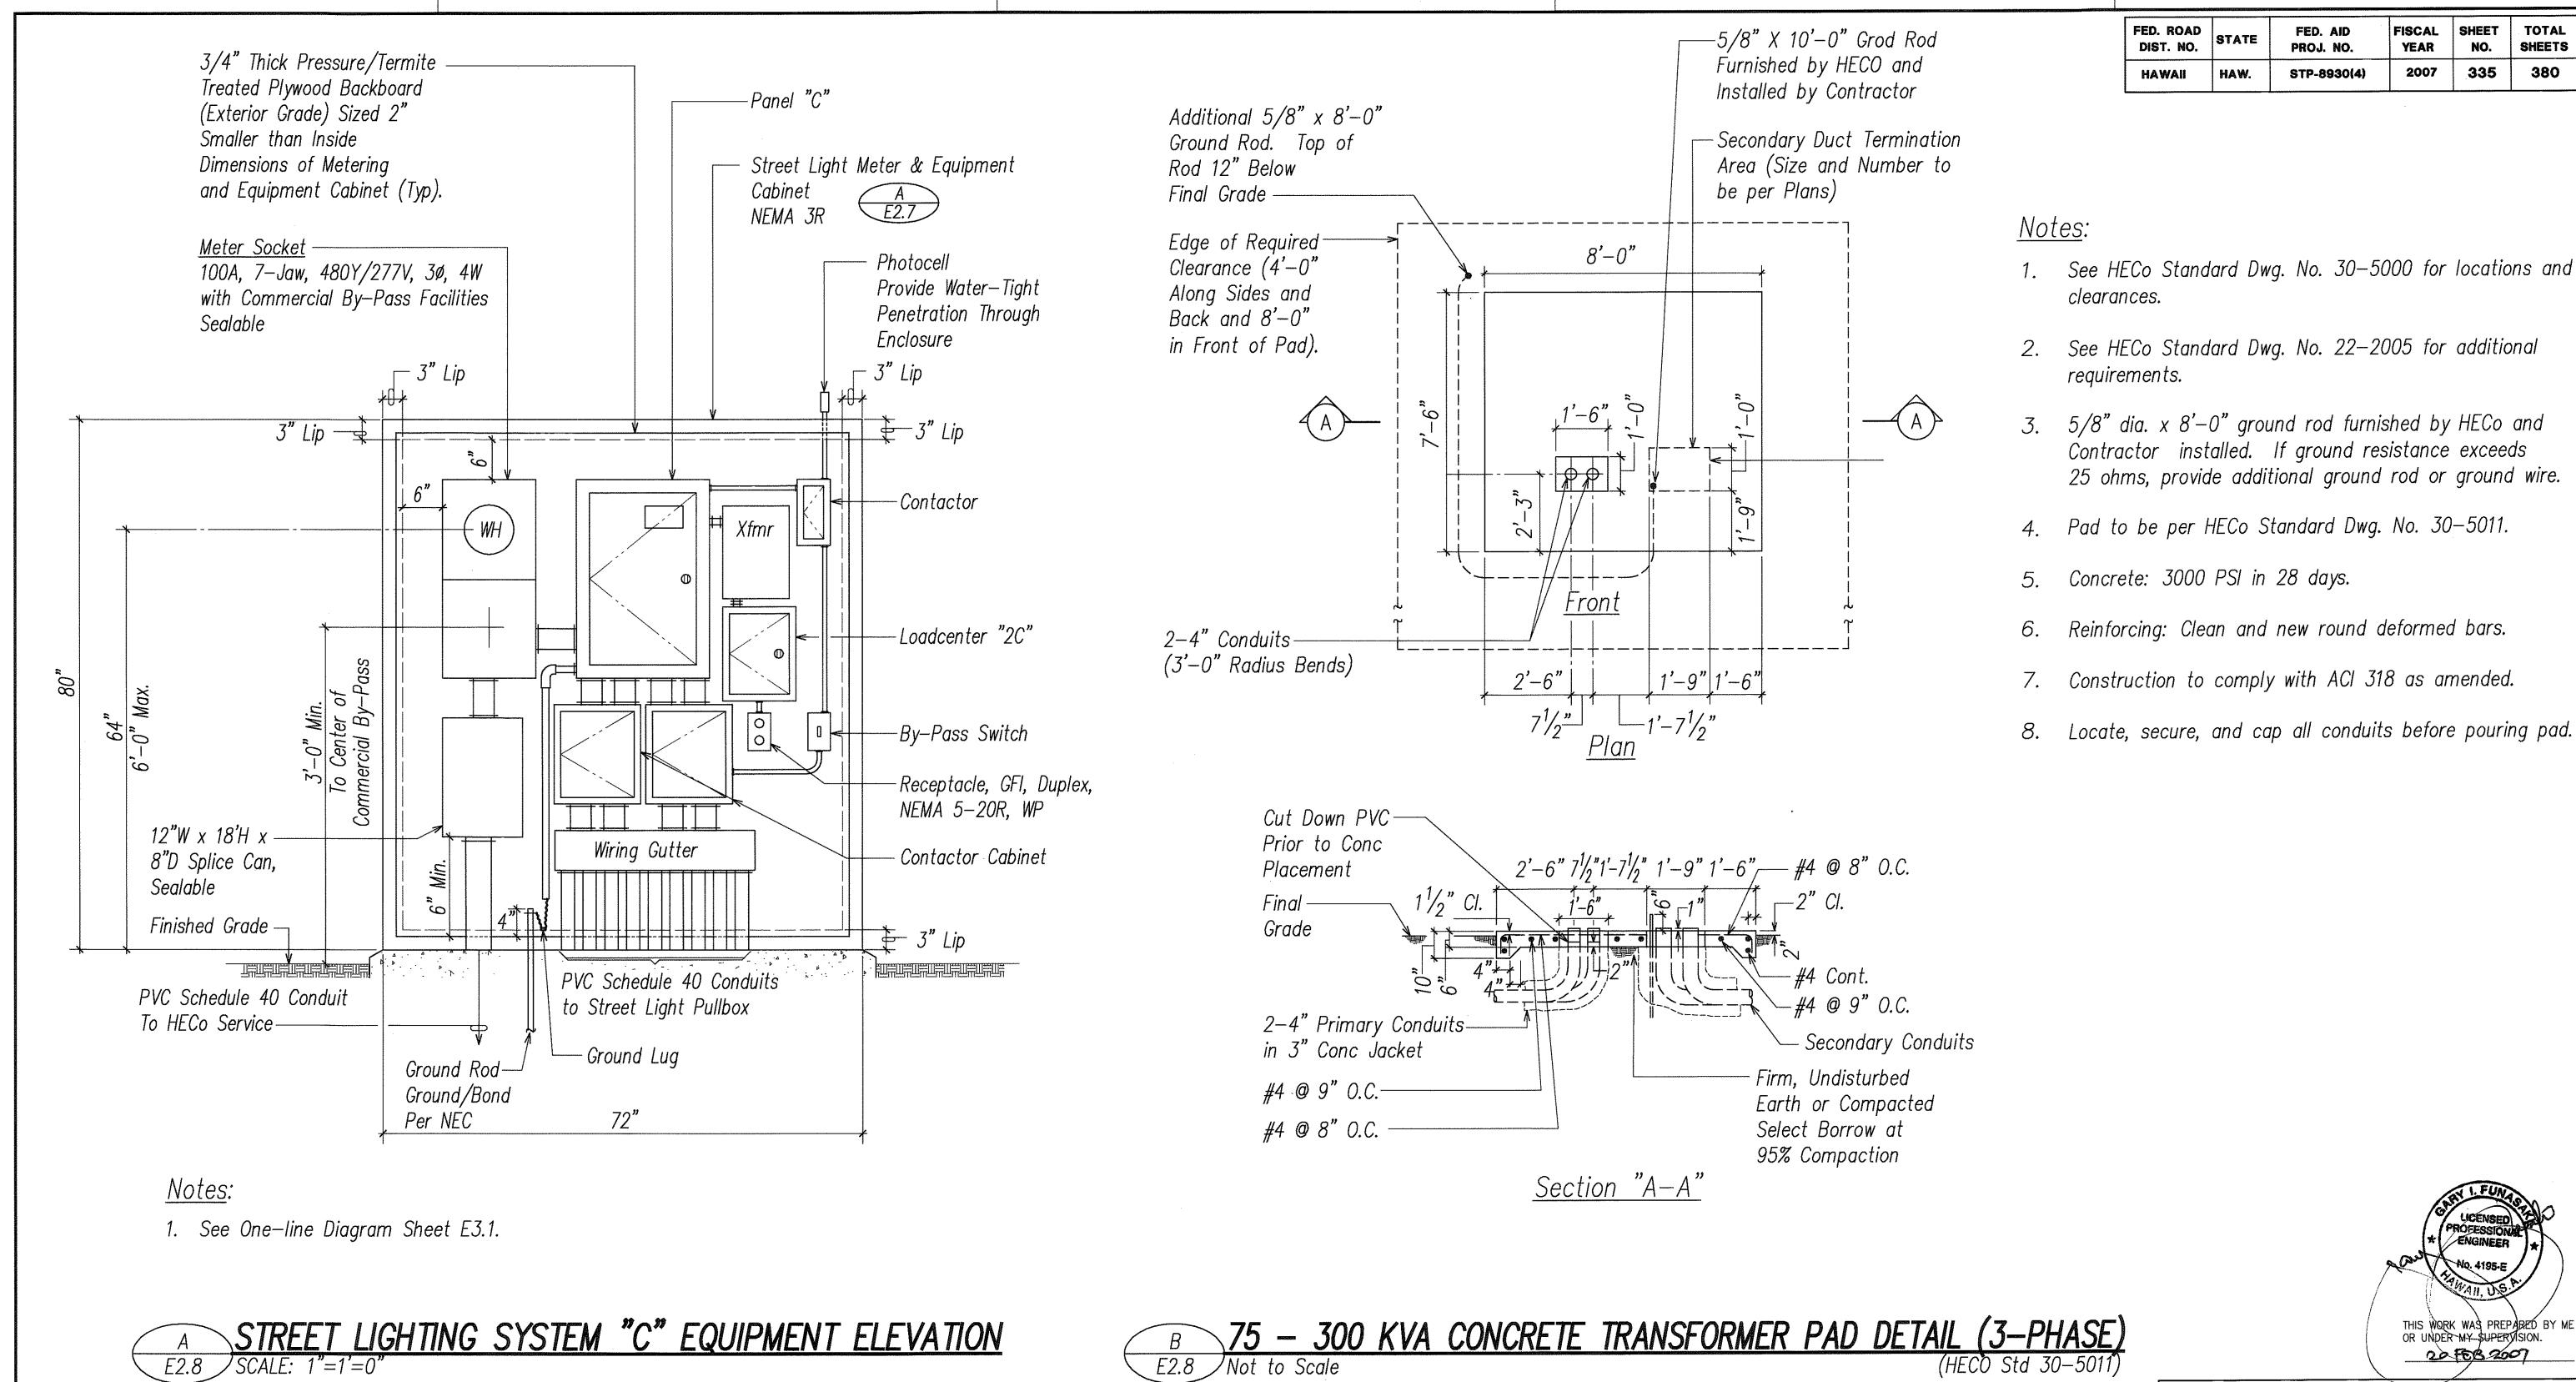

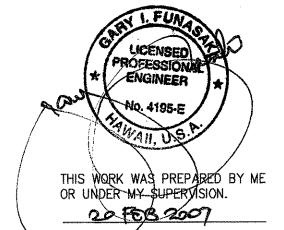

SHEET

335

380

75 — 300 KVA CONCRETE TRANSFORMER PAD DETAIL (3—PHASE)
Not to Scale
(HECO Std 30—5011)

APPROVED BY:

E2.8 Not to Scale

DATE HAWAIIAN ELECTRIC COMPANY, INC.

> 1"=1'-0" SCALE: GRAPHIC SCALE


REVISION DATE


DEPARTMENT OF TRANSPORTATION
HIGHWAYS DIVISION STREET LIGHTING EQUIPMENT ELEVATION

> North—South Road <u>Phase 1C</u> F.A.I. Proj. No. STP-8930(4)

Scale: AS NOTED

Date: Feb 21, 2007 SHEET No. E2.8 OF 66 SHEETS

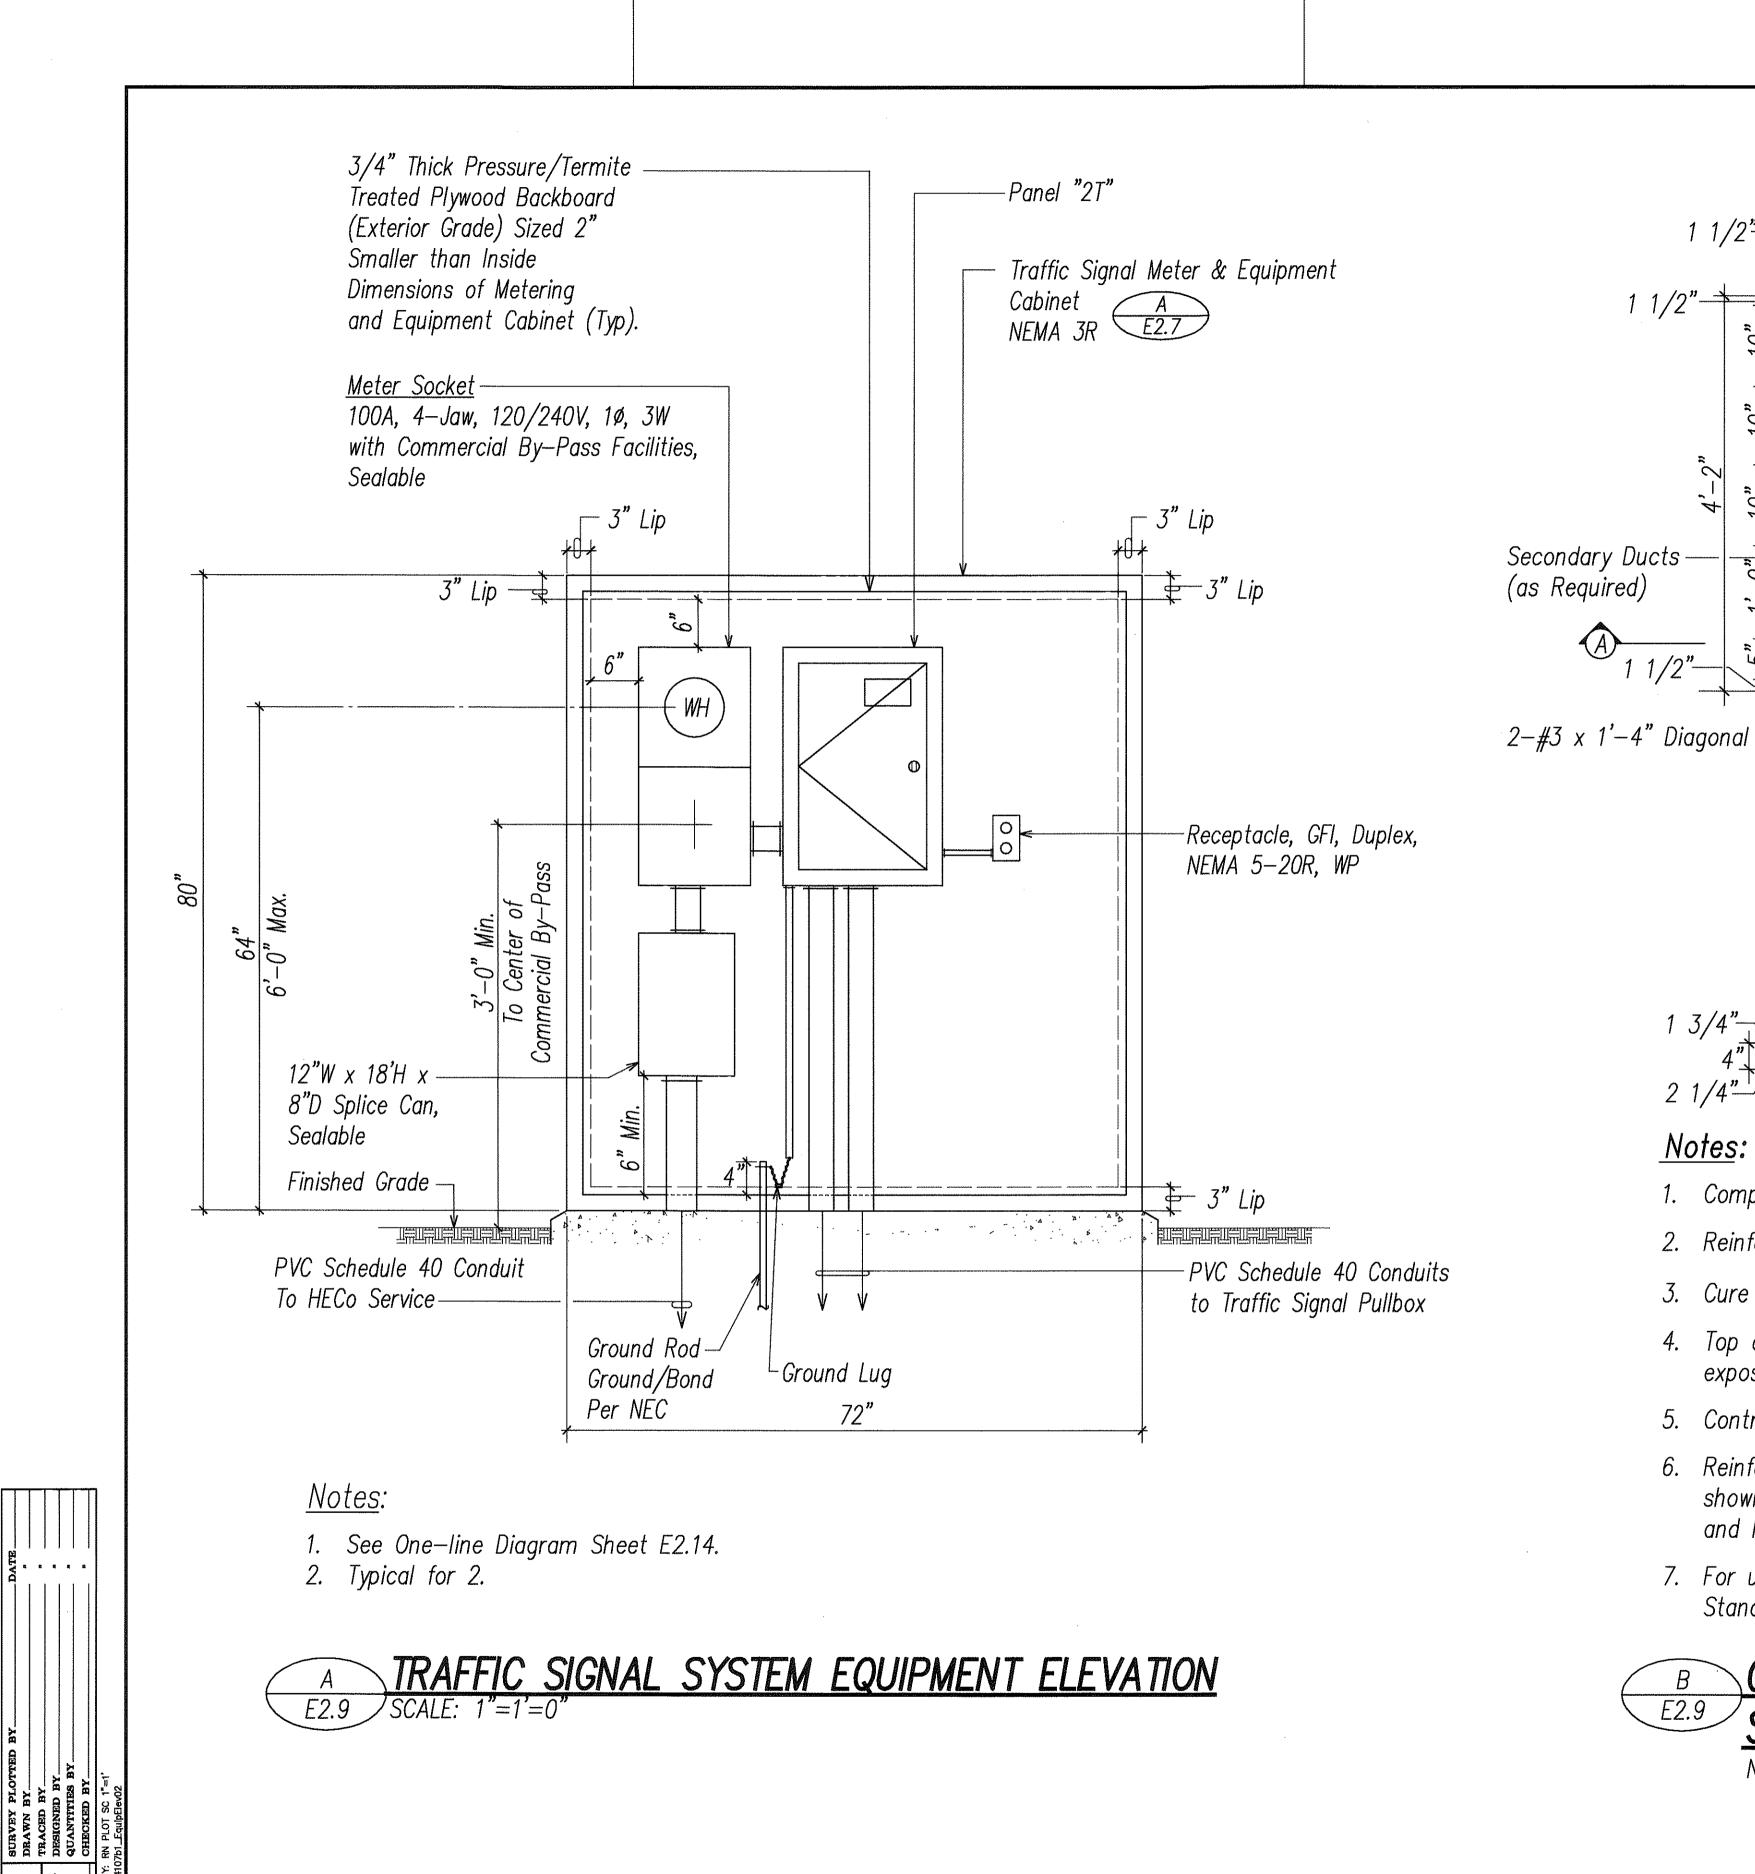

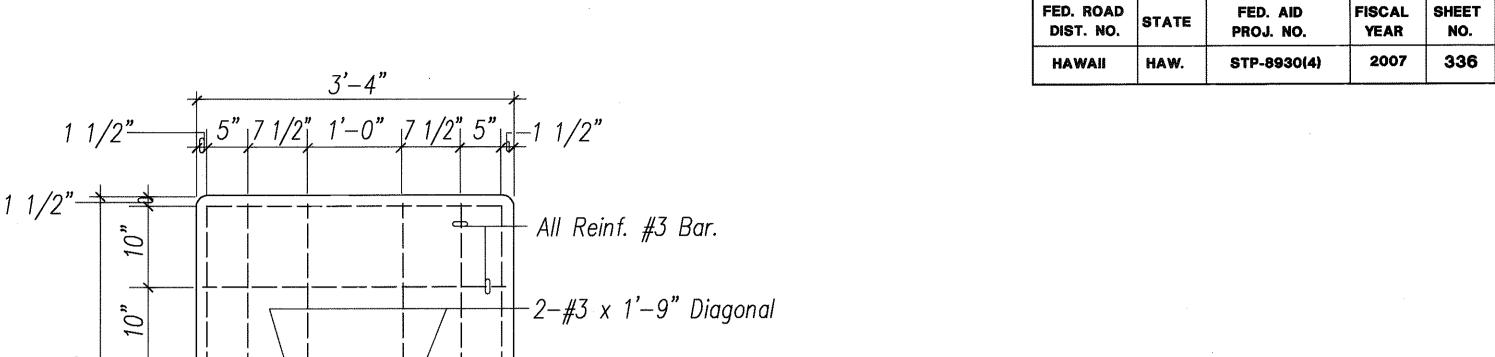

- Ground Rod:

Primary Ducts


−2−#3 x 1'−4" Diagonal

-5/8" Dia. x 4" Galvanized

Anchor Bolts

5/8" Dia. x 8'-0" Round

Copper Rod Steel Core

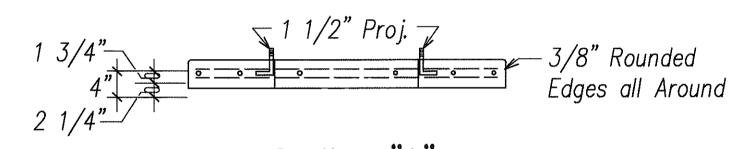



Plan View

#### Section "A" Notes:

- 1. Compressive strength of concrete: 3000 PSI in 28 days.
- 2. Reinforcing: Clean and new round deformed bar.
- 3. Cure concrete by approved method.
- 4. Top of concrete pad to be smooth, true and level. Other exposed surfaces to be smooth and free from defects.
- 5. Contractor has option of furnishing cast—in—place or precast.
- 6. Reinforced concrete transformer pad to be constructed as shown on this sheet & HECo Standard Drawing No. 011249 and No. 30-5001.
- 7. For use with 1 phase padmounted transformers per HECo Standard Drawing No. 23–1022.



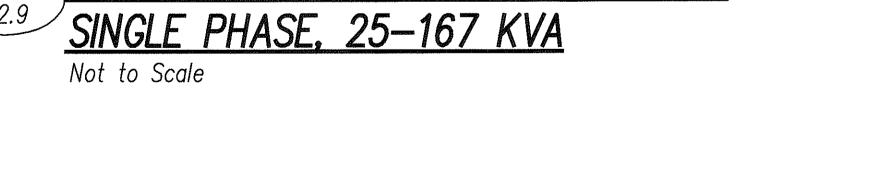

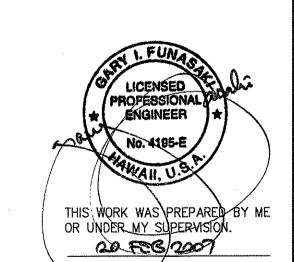

SHEETS

380

DEPARTMENT OF TRANSPORTATION

TRAFFIC SIGNAL EQUIPMENT ELEVATION

North—South Road Phase 1C F.A.I. Proj. No. STP-8930(4)

Scale: AS NOTED


Date: Feb 21, 2007 SHEET No. E2.9 OF 66 SHEETS


SCALE: 1"=1'-0" GRAPHIC SCALE

APPROVED BY:


DATE HAWAIIAN ELECTRIC COMPANY, INC.

REVISION DATE

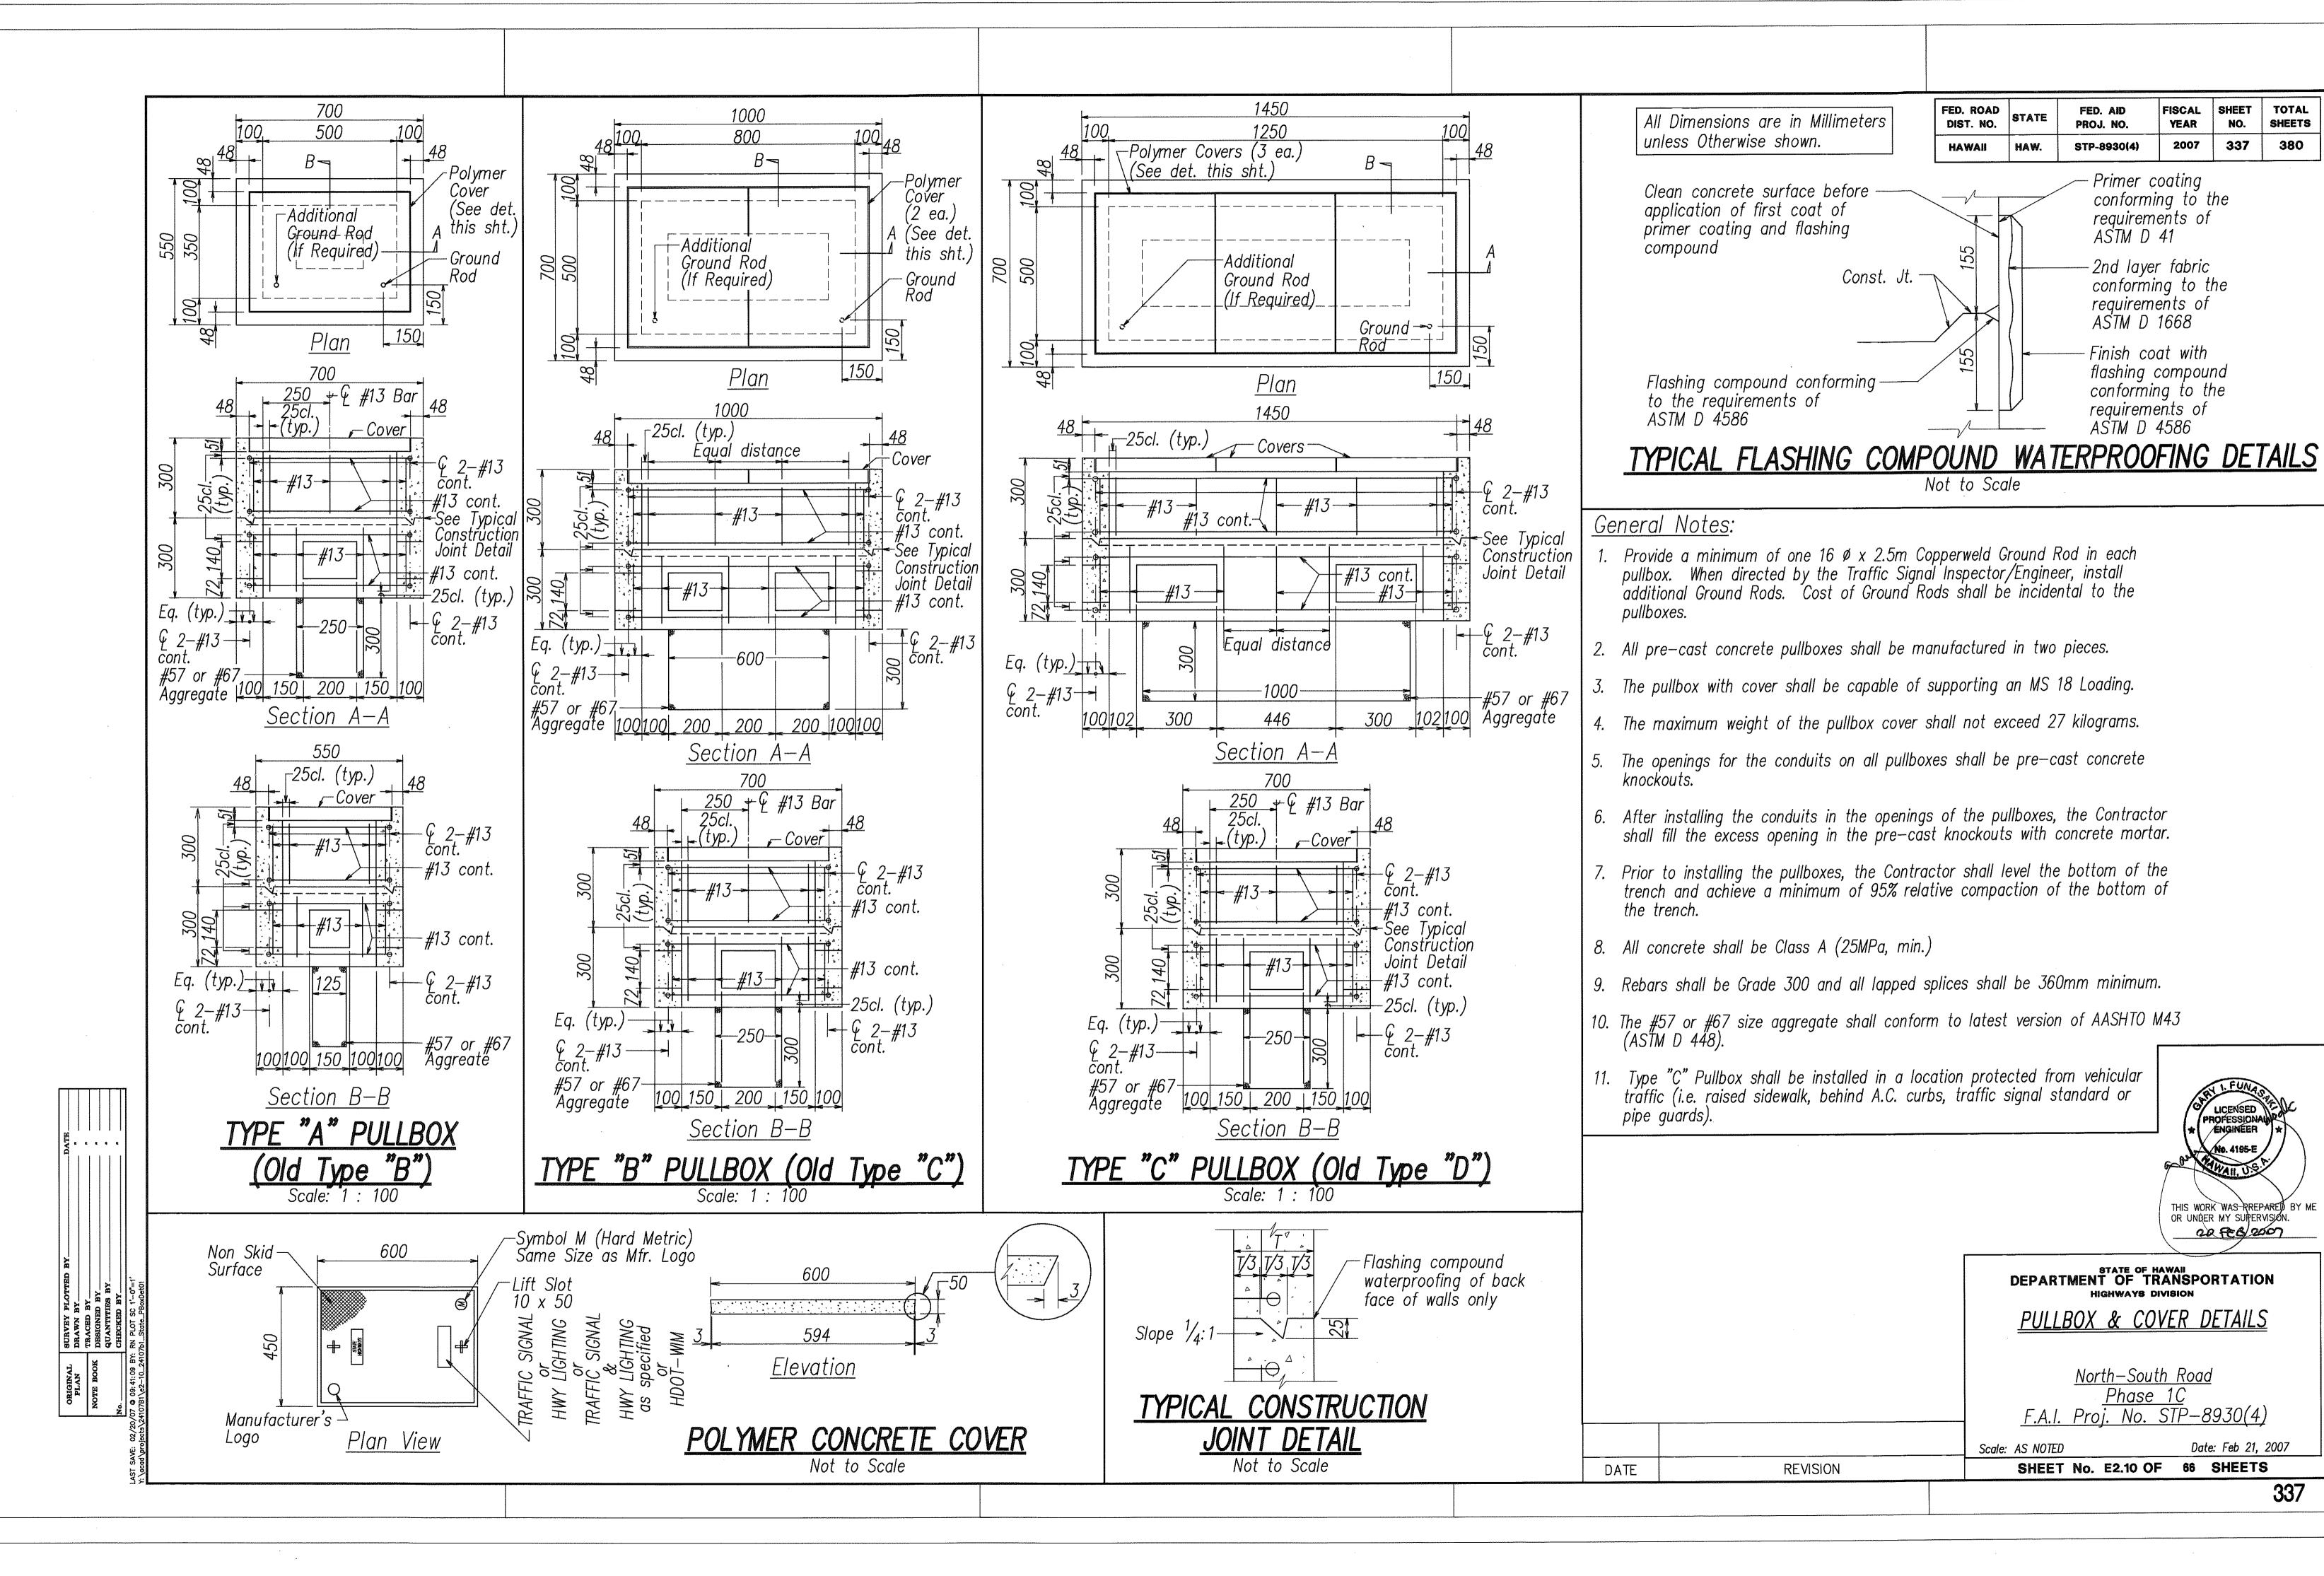

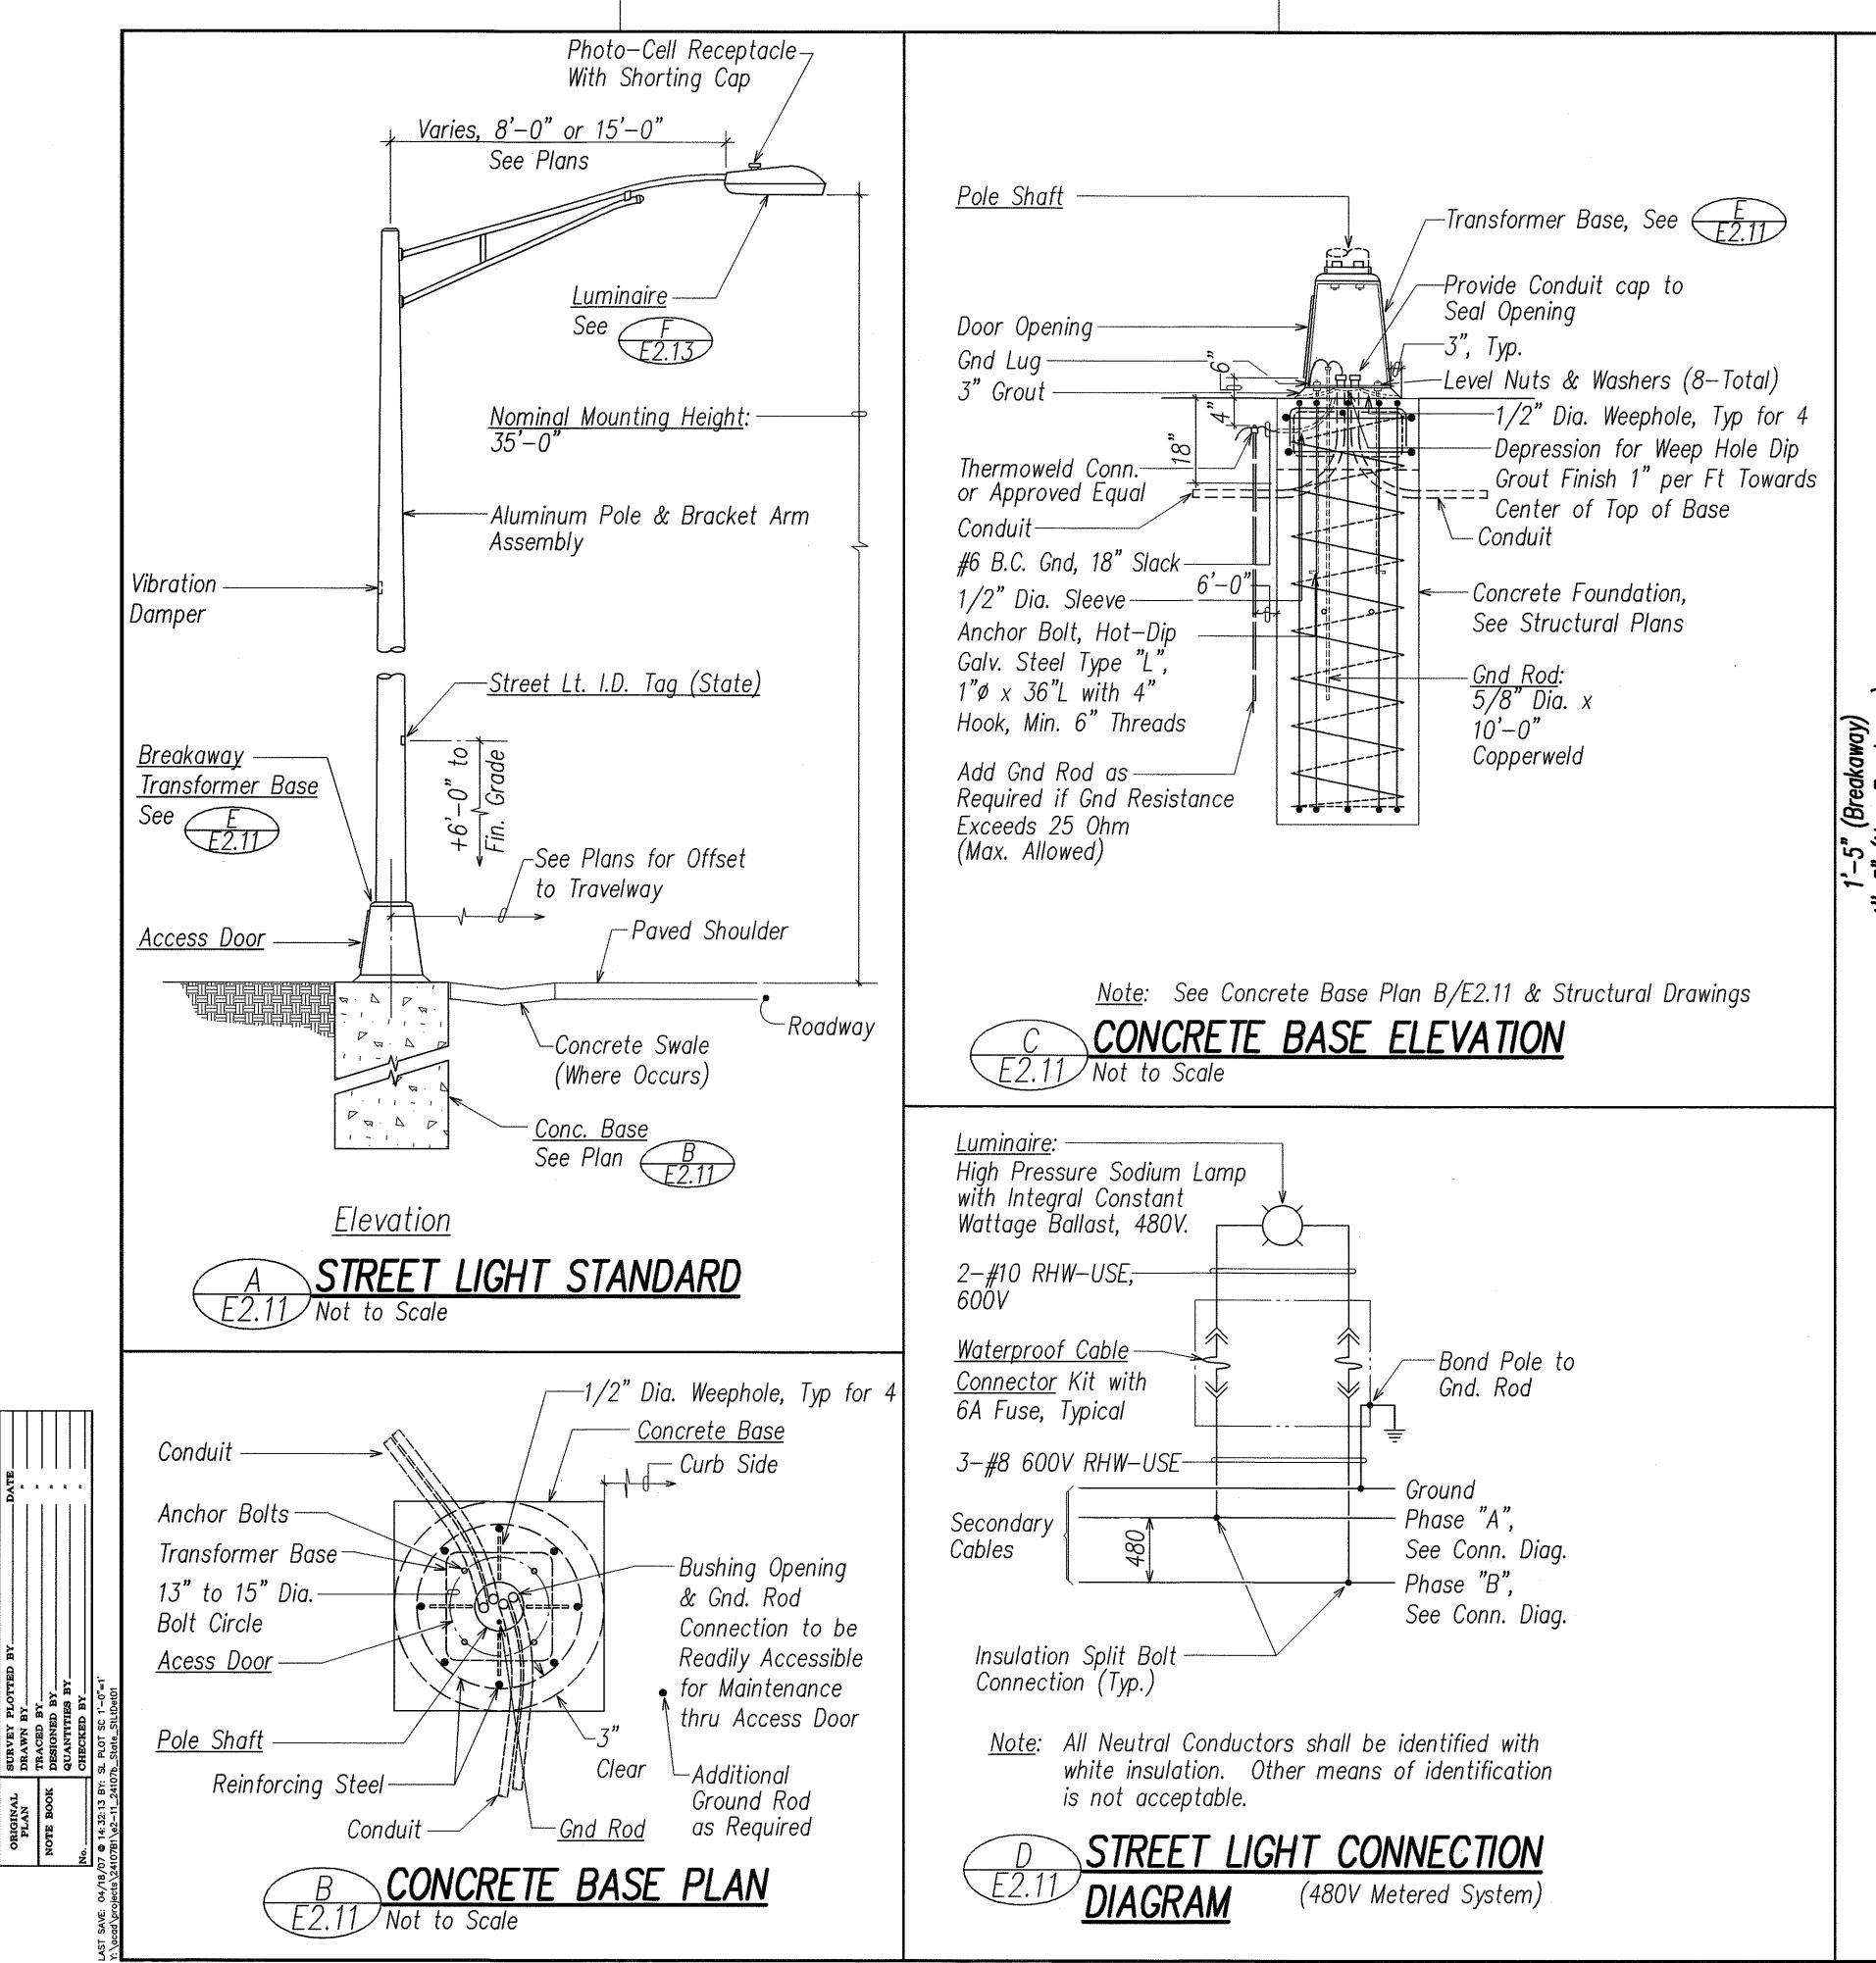

FED. ROAD DIST. NO. FISCAL SHEET TOTAL FED. AID STATE PROJ. NO. YEAR NO. SHEETS 2007 ADD. 338 380 HAWAII HAW. STP-8930(4)

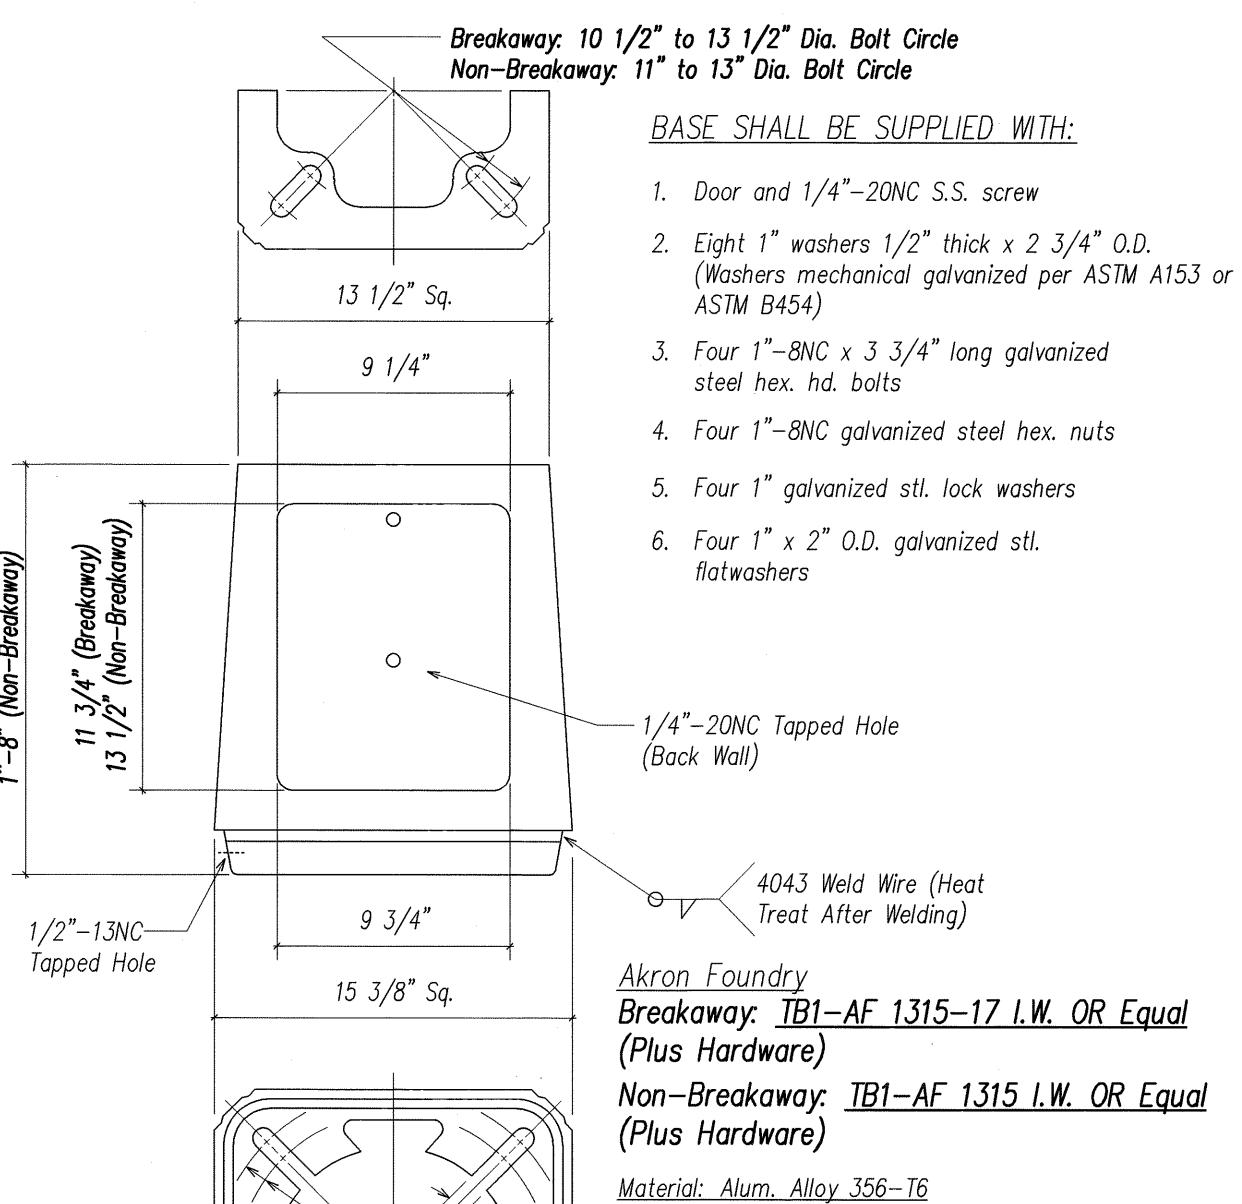

Breakaway: 13" to 15" Dia. Bolt Circle Non-Breakaway: 15" Dia. Bolt Circle

### BREAKAWAY AND NON-BREAKAWAY TRANSFORMER BASE DETAIL NOT TO SCALE

4/20/07 🛕 Added Luminaire Detail

REVISION

DATE

THIS WORK WAS PREPARED BY ME OR UNDER MY SUPERVISION.

LICENSED PROFESSIONAL ENGINEER

No. 4195-E

DEPARTMENT OF TRANSPORTATION
HIGHWAYS DIVISION STREET LIGHT DETAILS I


North-South Road Phase 1C

F.A.I. Proj. No. STP-8930(4)

Scale: AS NOTED

Date: Feb 21, 2007 SHEET No. E2.11 OF 66 SHEETS

ADD. 338

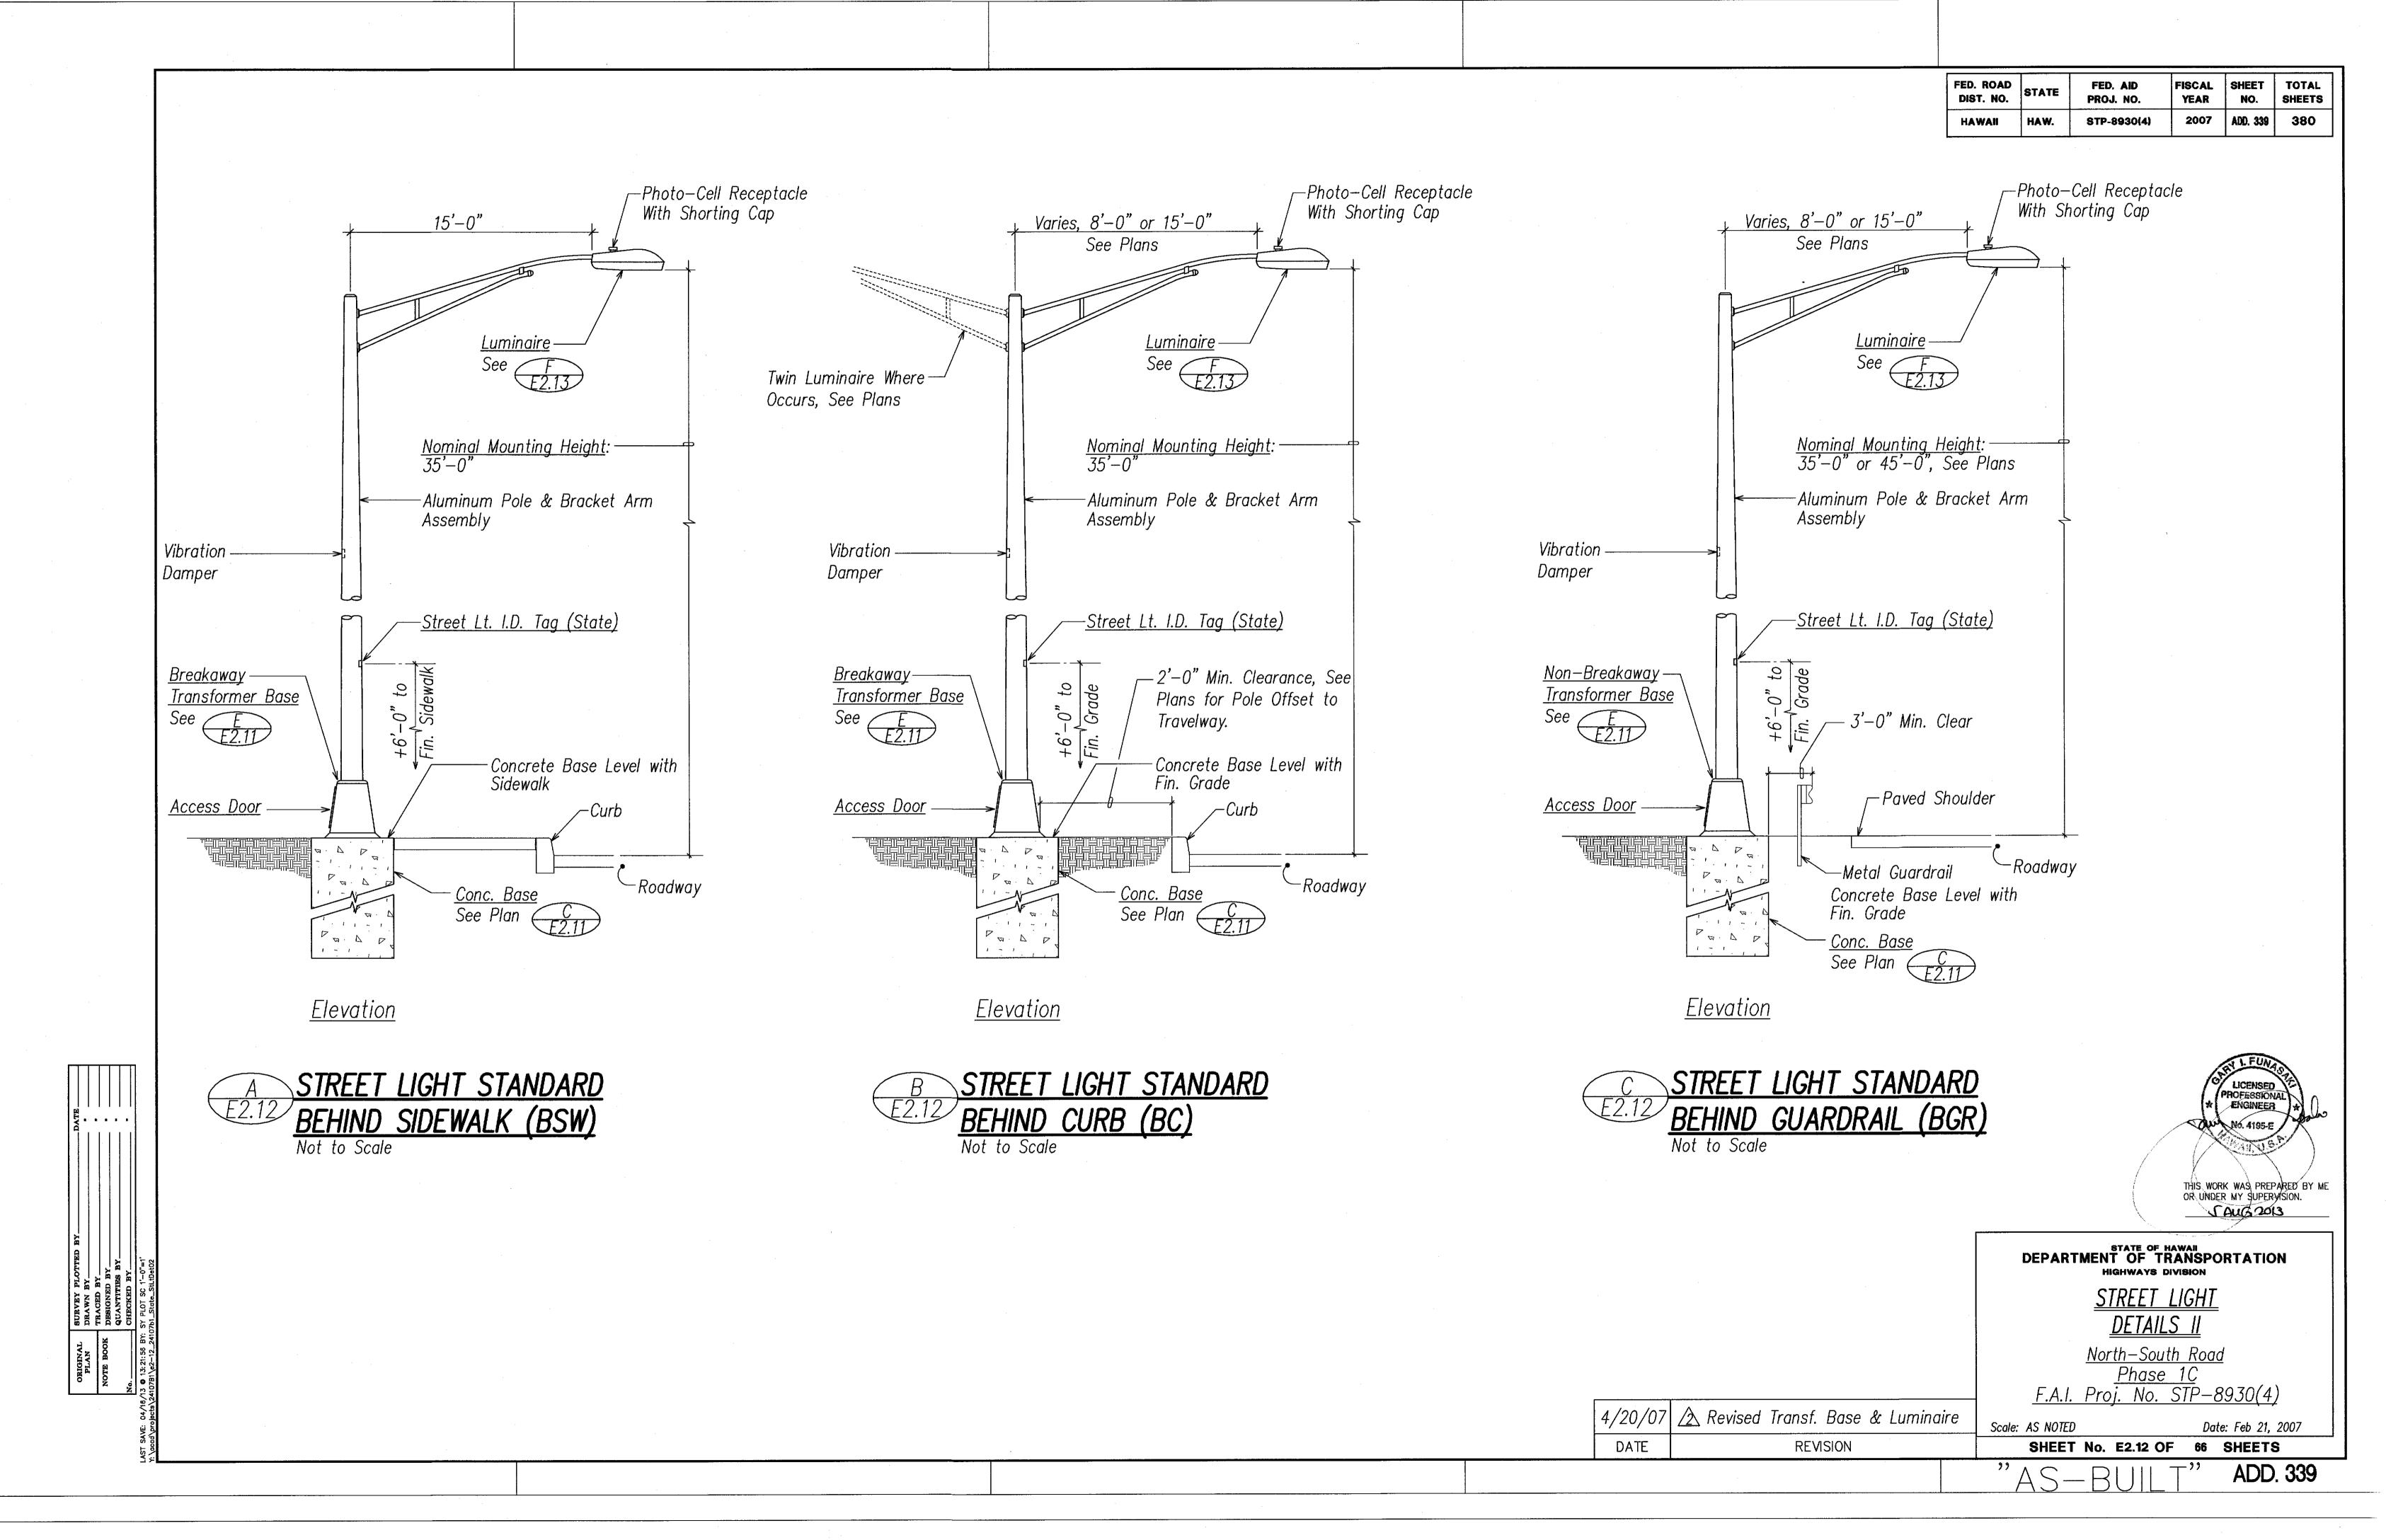

## NEW DESIGN REQUIREMENTS FOR LUMINAIRES, POLE STANDARDS AND TRAFFIC SIGNAL STANDARDS

Highway lighting luminaires, pole standards, bracket arms, traffic signal standards and mast arms being furnished for this project shall conform with the design requirements noted below. Design shall be in accordance with AASHTO Standard Specifications for Structural Supports for Highway Signs, Luminaires and Traffic Signals, 4th Edition, including the latest interim revisions, published by the American Association of State Highway and Transportation Officials with the following modifications:

- Basic Wind Speed [Article 3.8.2] to determine the design wind pressure shall be 105 mph.
- Wind Importance Factor [Article 3.8.3] noted in Table 3–2 used to determine the design wind pressure shall be based on the following recurrence intervals:


a. For traffic signal structures:

50 years

b. For luminaire support structures:

25 years


- Fatigue Importance Factors [Article 11.6] noted in Table 11–1 for traffic signal structures shall be based on Fatigue Category 1. Luminaire support structures with round cross sections under 50 feet do not need to be designed for fatigue.
- Galloping [Article 11.7.1]. Traffic signal support structures shall be designed for galloping—induced cyclic loads unless approved vibration mitigation devices are
- Vortex Shedding [Article 11.7.2]. Nontapered lighting structures shall be designed to resist vortex shedding—induced loads including cantilevered mast arms and lighting structures that have tapers less than 0.14 in/ft.
- 6. Natural Wind Gust [Article 11.7.3]. Traffic signal structures shall be designed to resist an equivalent static natural wind gust pressure.
- Truck—Induced Gust [Article 11.7.4]. Traffic signal support structures shall be designed to resist an equivalent static truck gust pressure range based on a truck speed of 20 mph over the posted speed.
- Equipment manufacturers providing structural supports for luminaires and traffic signals are responsible to provide the Engineer with any information that will impact the current foundation design.

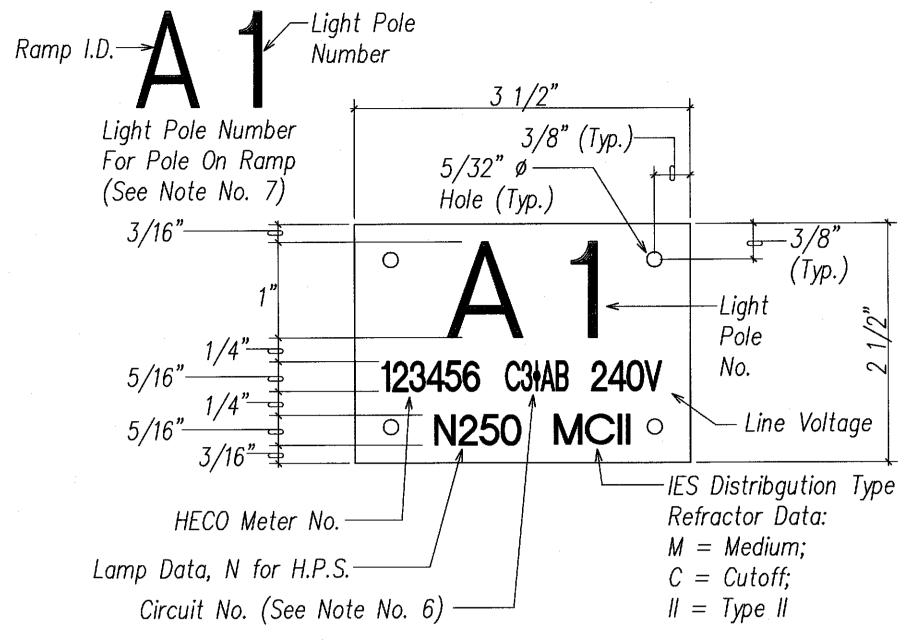


#### NOTES:

- Use 3 ply laminated flexible plastic, black-white-black. thickness: black cap sheet-0.010", white base sheet-0.052", black base sheet-0.010".
- 2. Light pole number size shall be 1" high and engraved 1/8" wide, white in color (number as required).
- 3. Nomenclature size shall be 5/16" high and engraved 1/32" wide, white in color (meter number, circuit number, line voltage, lamp data and refractor data as required).
- 4. Attach to aluminum pole with no. 8 stainless steel, 1/2" long drive screws in 1/8" drill hole.
- 5. Numbers and letters are inscribed by cutting through "black cap sheet" to expose "white letters".
- 6. Assign circuit number (letter indicates panelboard, number indicates circuit; ØAB indicates connection to Phases "A" & "B".
- 7. For light poles installed on ramp, assign numbers to include ramp I.D. and pole number. legend may be less than one (1) inch in height.
- 8. Contractor to verify all items of I.D. tag with State D.O.T. prior to fabrication.



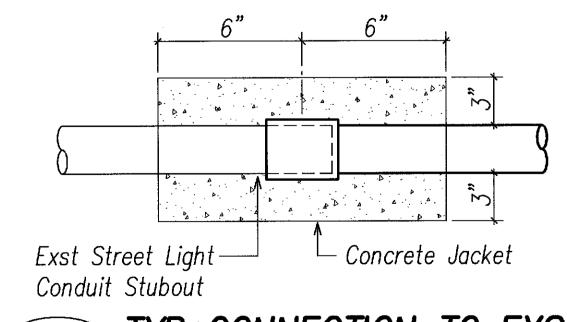





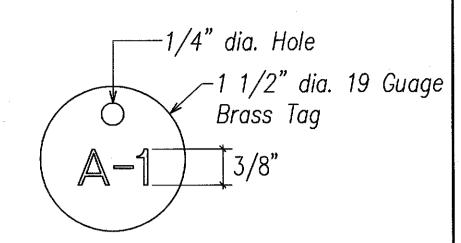

- Number Size shall be 3/8" high and Punched on Brass Tag.
- Attach to Circuit Cables with Nylon Weather Resistant Locking Cable Ties, 3/16" wide.



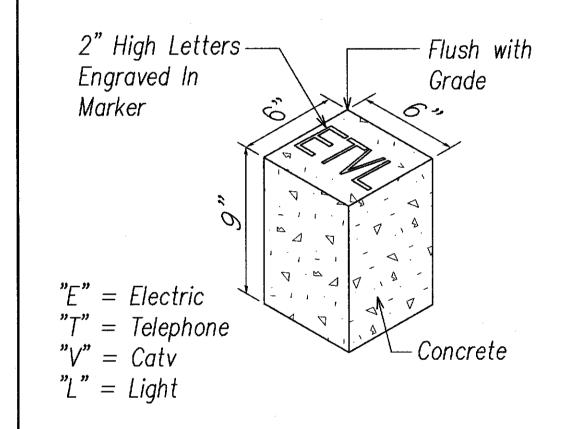


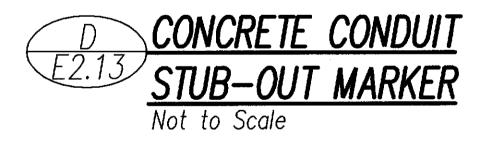

4/20/07 🛕 Added Luminaire Detail

REVISION

DATE

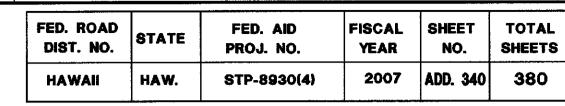



250W HPS, Unless Otherwise Noted Lamp:

Voltage:

Medium, Cutoff, Type III, IES Distrib.: Unless Otherwise Noted

EPA: 1.1 Sq. Ft. (Max.)

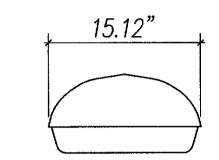


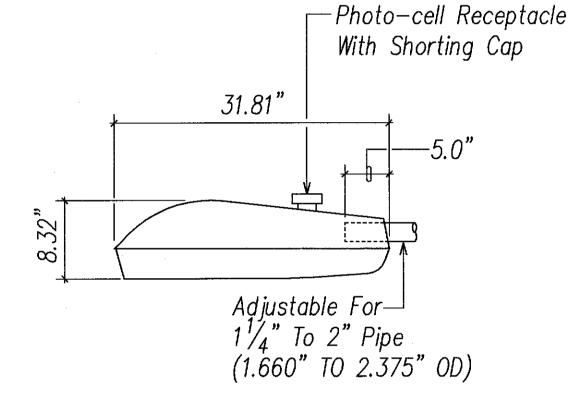

#### NOTES:

1. All Dimensions Shown Are Nominal.



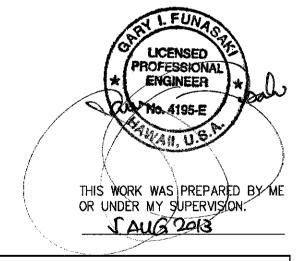


DEPARTMENT OF TRANSPORTATION

STREET LIGHT DETAILS III


North-South Road Phase 1C F.A.I. Proj. No. STP-8930(4)

Scale: AS NOTED


Date: Feb 21, 2007 SHEET No. E2.13 OF 66 SHEETS

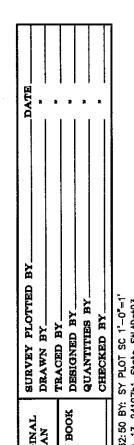

ADD. 340

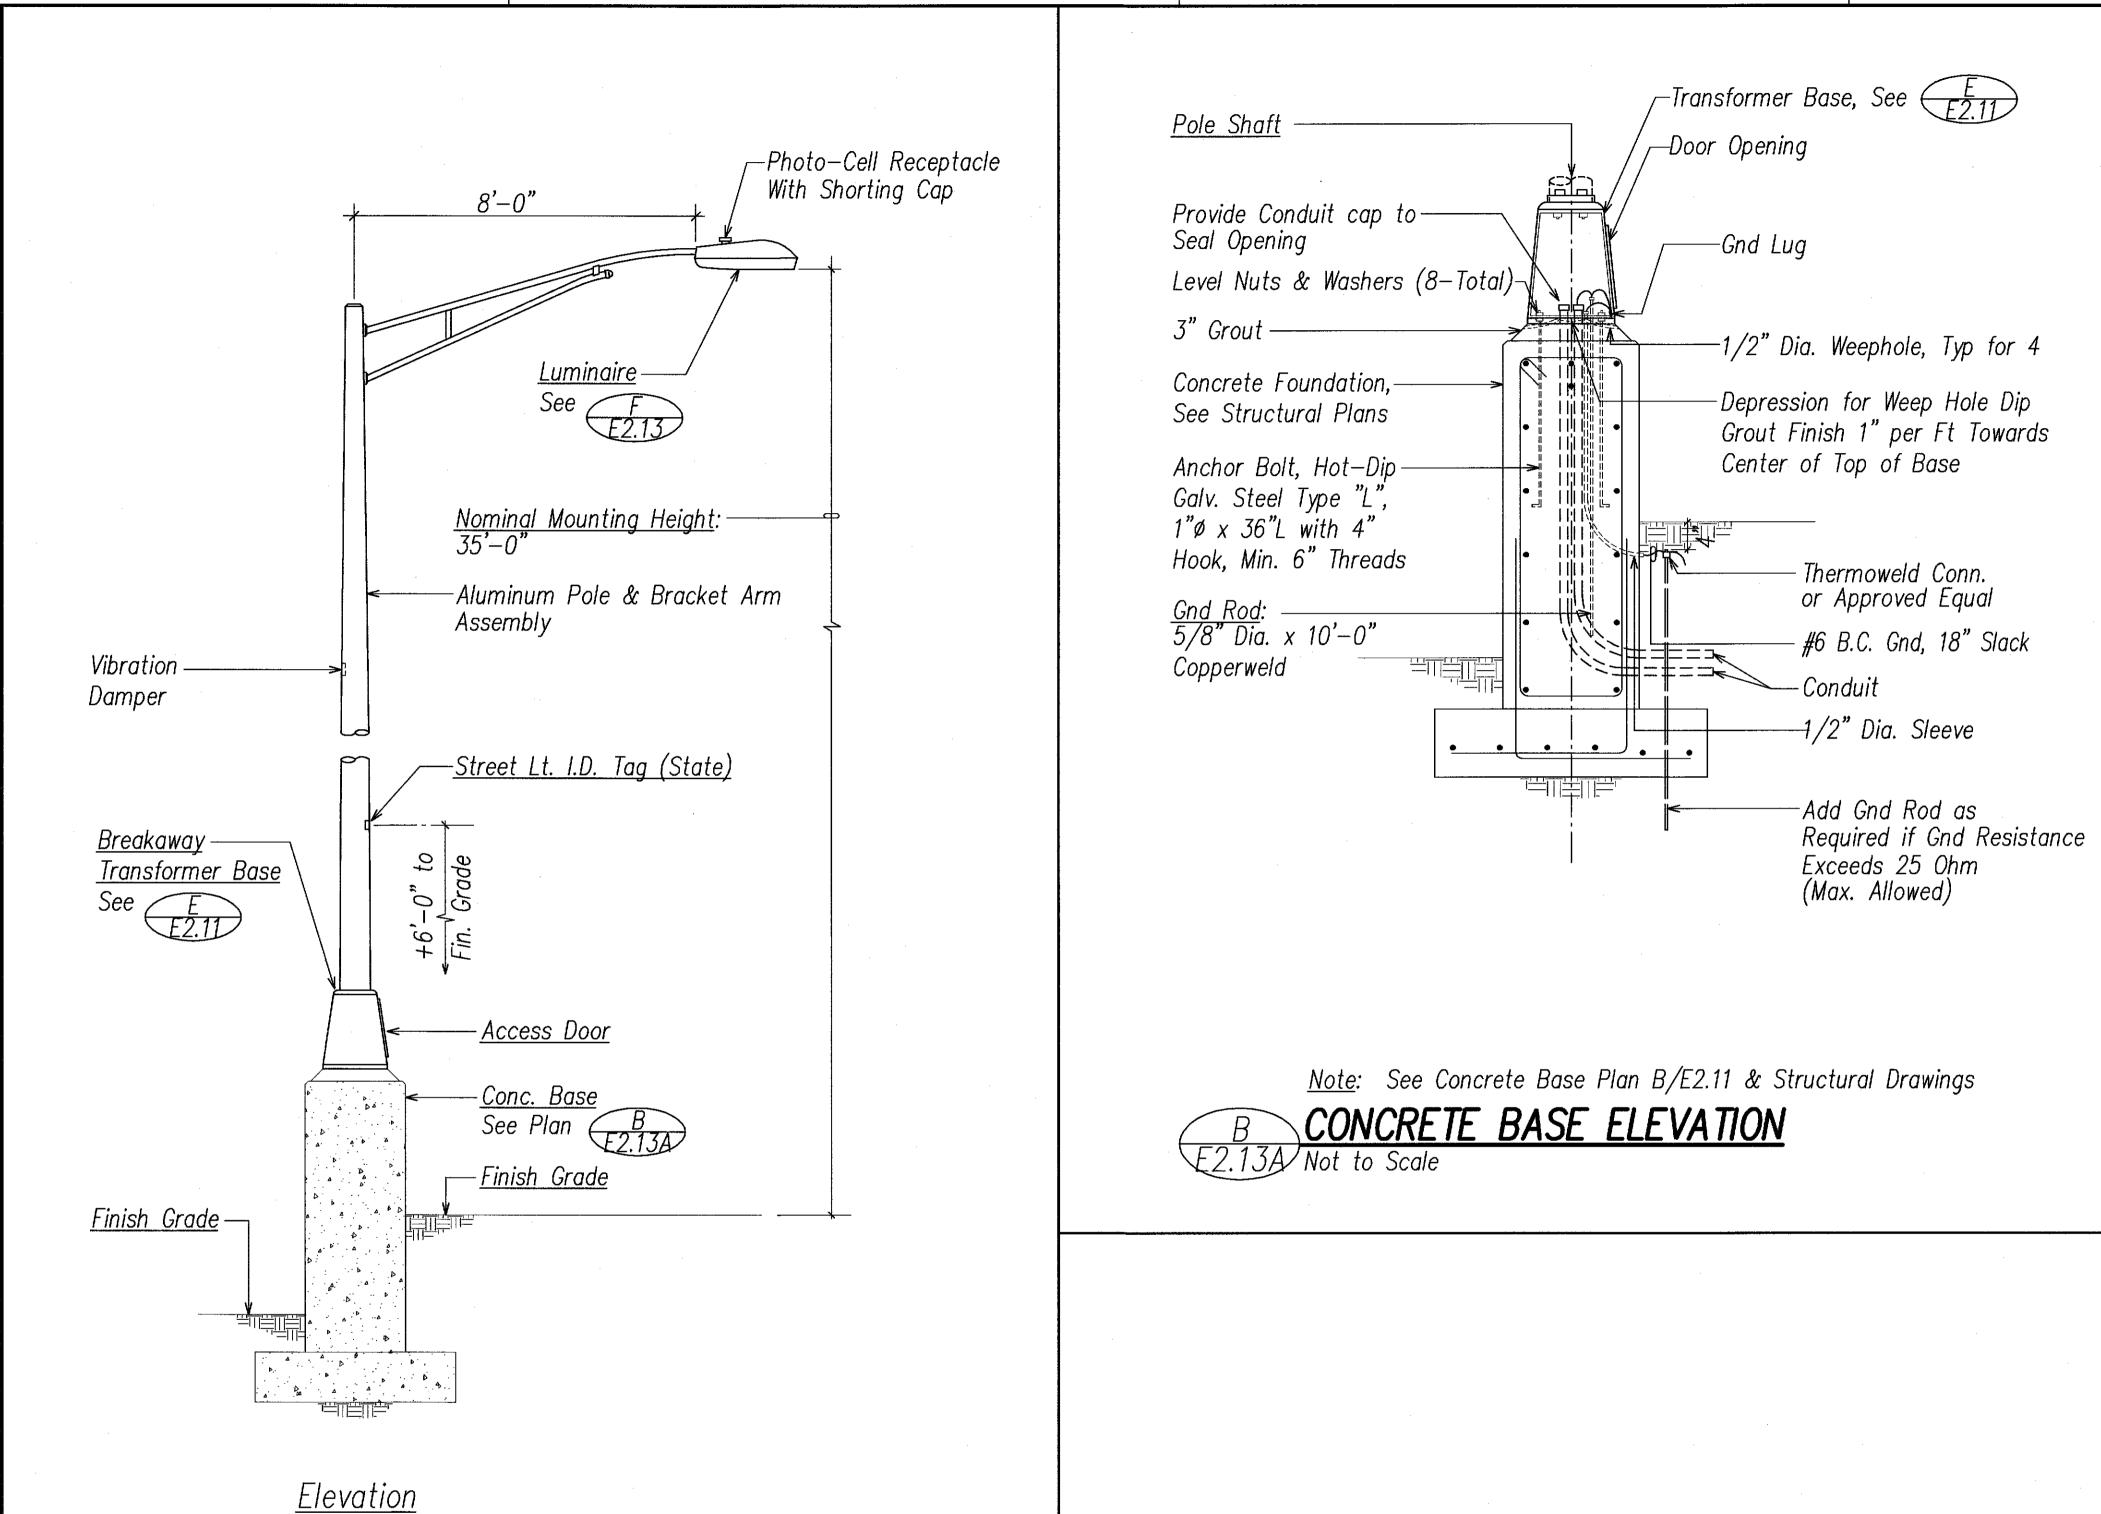

FISCAL SHEET TOTAL YEAR NO. SHEETS FED. ROAD DIST. NO. FED. AID PROJ. NO. 2007 | CO 3408-1 | 380 HAWAII STP-8930(4)

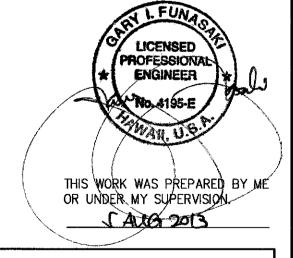

DEPARTMENT OF TRANSPORTATION
HIGHWAYS DIVISION

STREET LIGHT DETAILS IIIA

North-South Road <u>Phase 1C</u> F.A.I. Proj. No. STP-8930(4)

Scale: AS NOTED

7/16/08 Added Barrier Lights


DATE


REVISION

Date: Feb 21, 2007

SHEET No. E2.13AOF 66 SHEETS CO 340S-1


STREET LIGHT STANDARD ON MEDIAN BARRIER Not to Scale

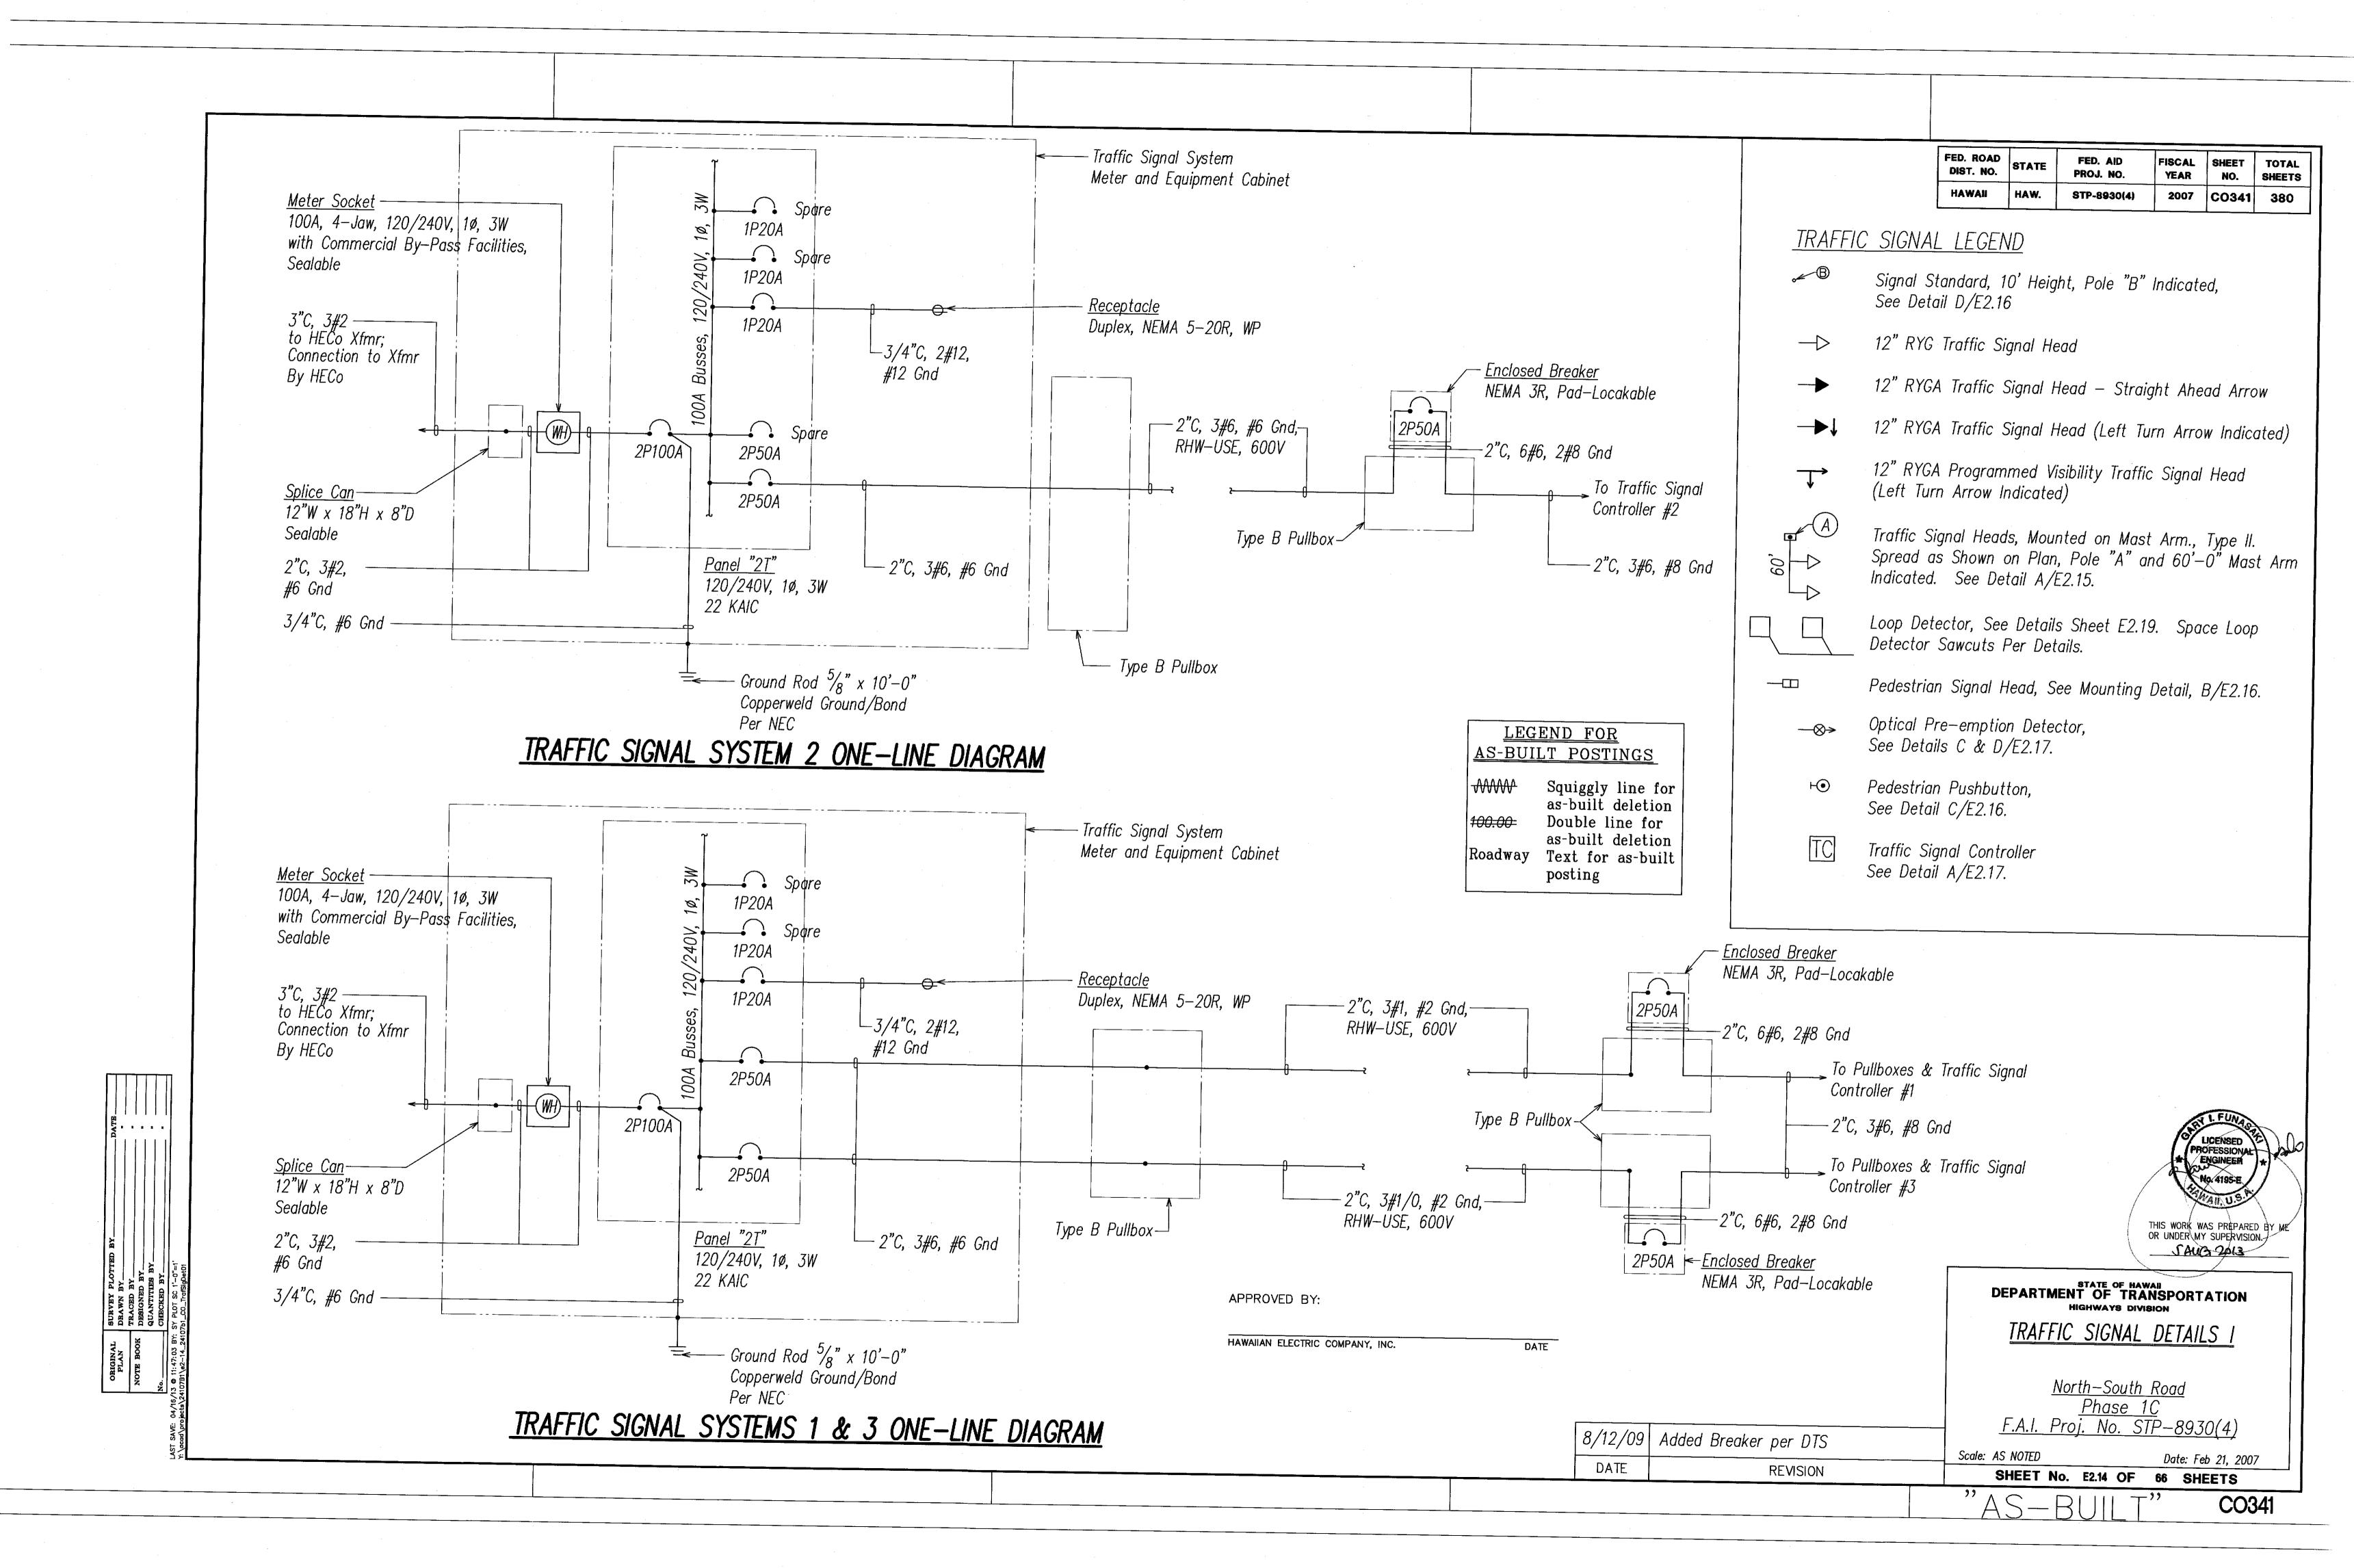


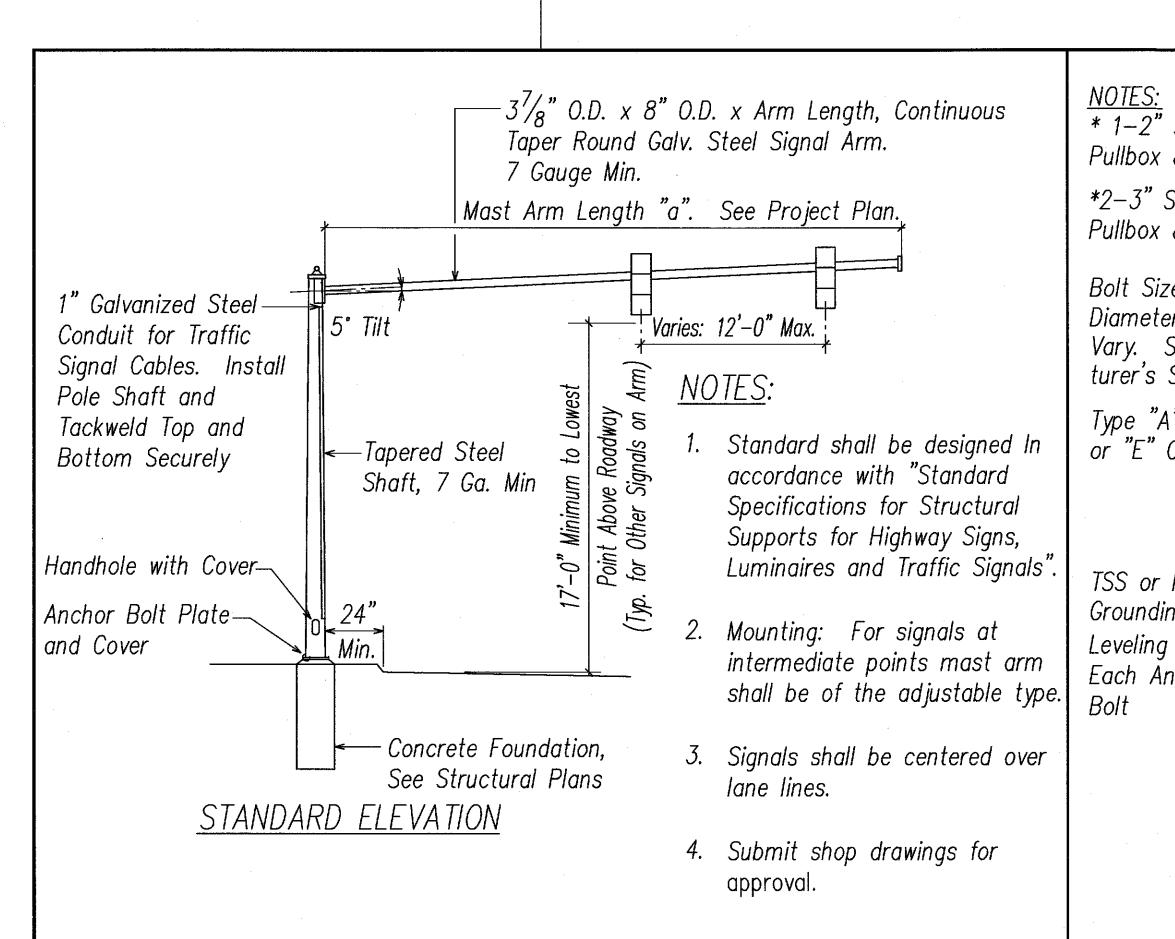



TYPE II TRAFFIC SIGNAL STANDARD

E2.15 N.T.S.

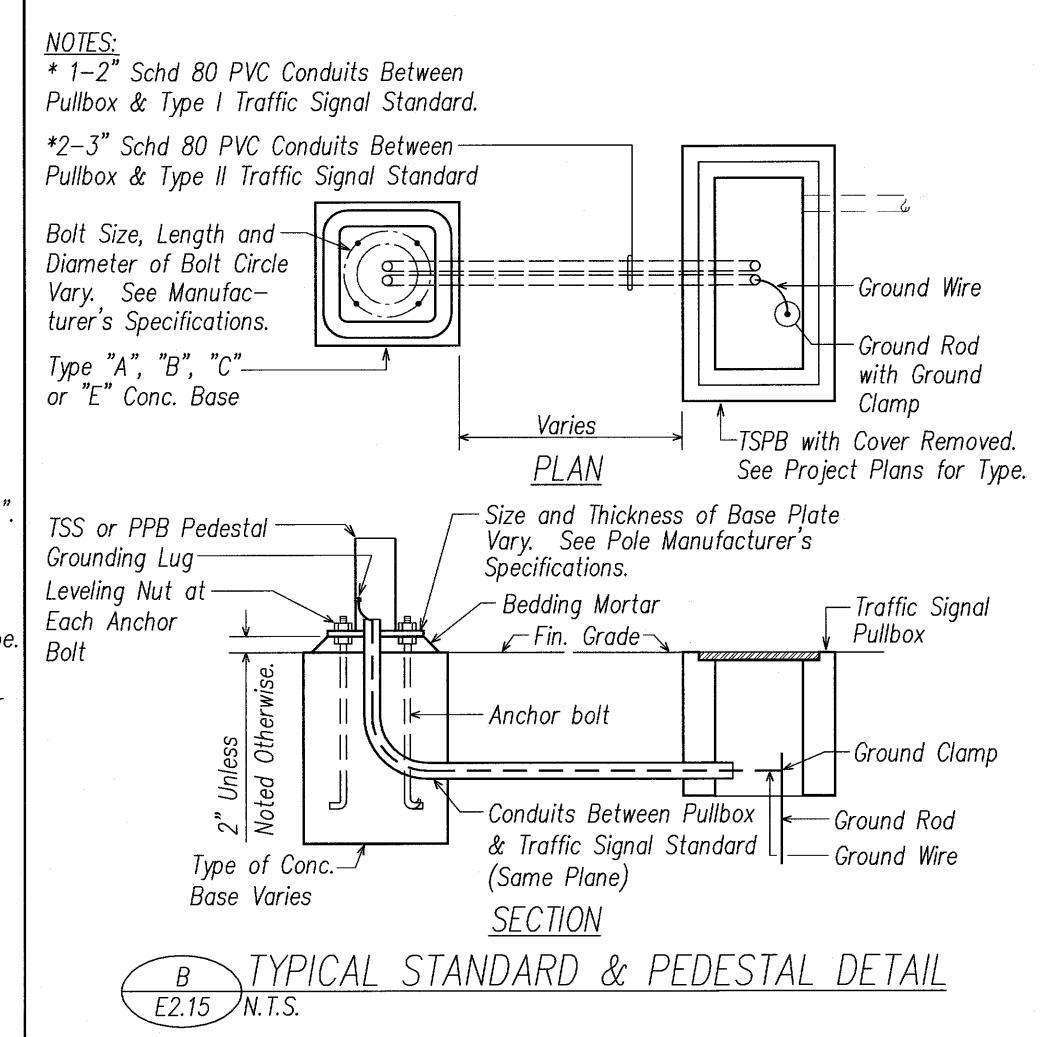

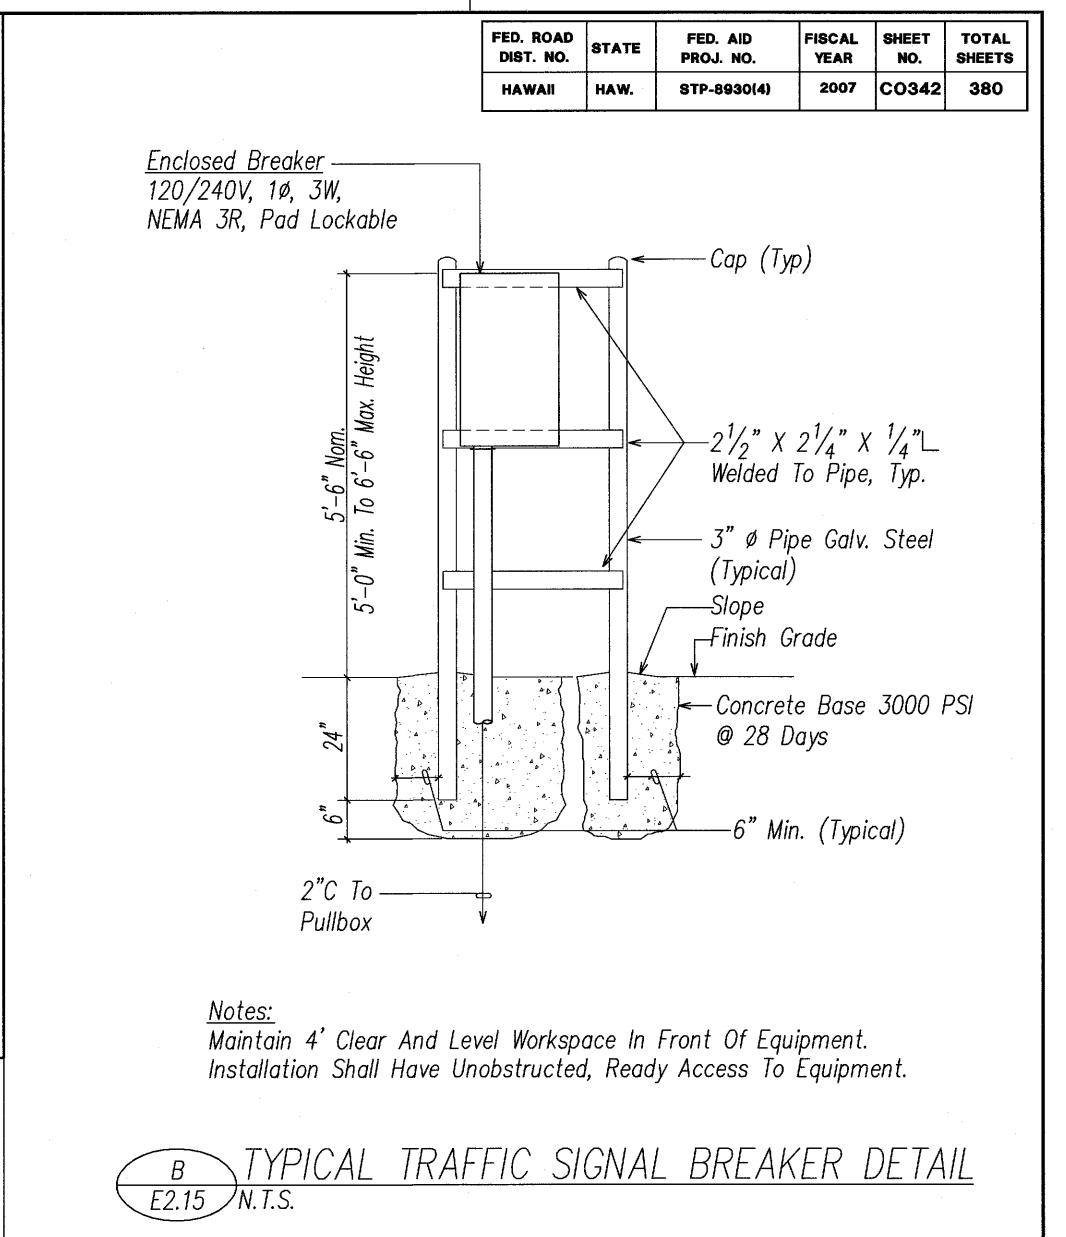

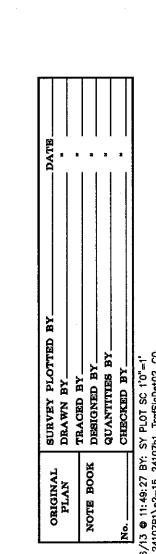

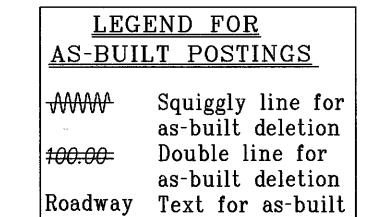

posting

TRAFFIC SIGNAL DETAILS II

DEPARTMENT OF TRANSPORTATION
HIGHWAYS DIVISION

North-South Road
Phase 1C
F.A.I. Proj. No. STP-8930(4)

7/15/09 Added Breaker Detail per DTS

DATE REVISION

SHEET No. E2.15 OF 66 SHEETS

Scale: AS NOTED

"AS-BUILT"


CO342

Date: Feb 21, 2007


LICENSED PROFESSIONAL ENGINEER


THIS WORK WAS PREPARED BY ME OR UNDER MY SUPERVISION.


JAUG 2013

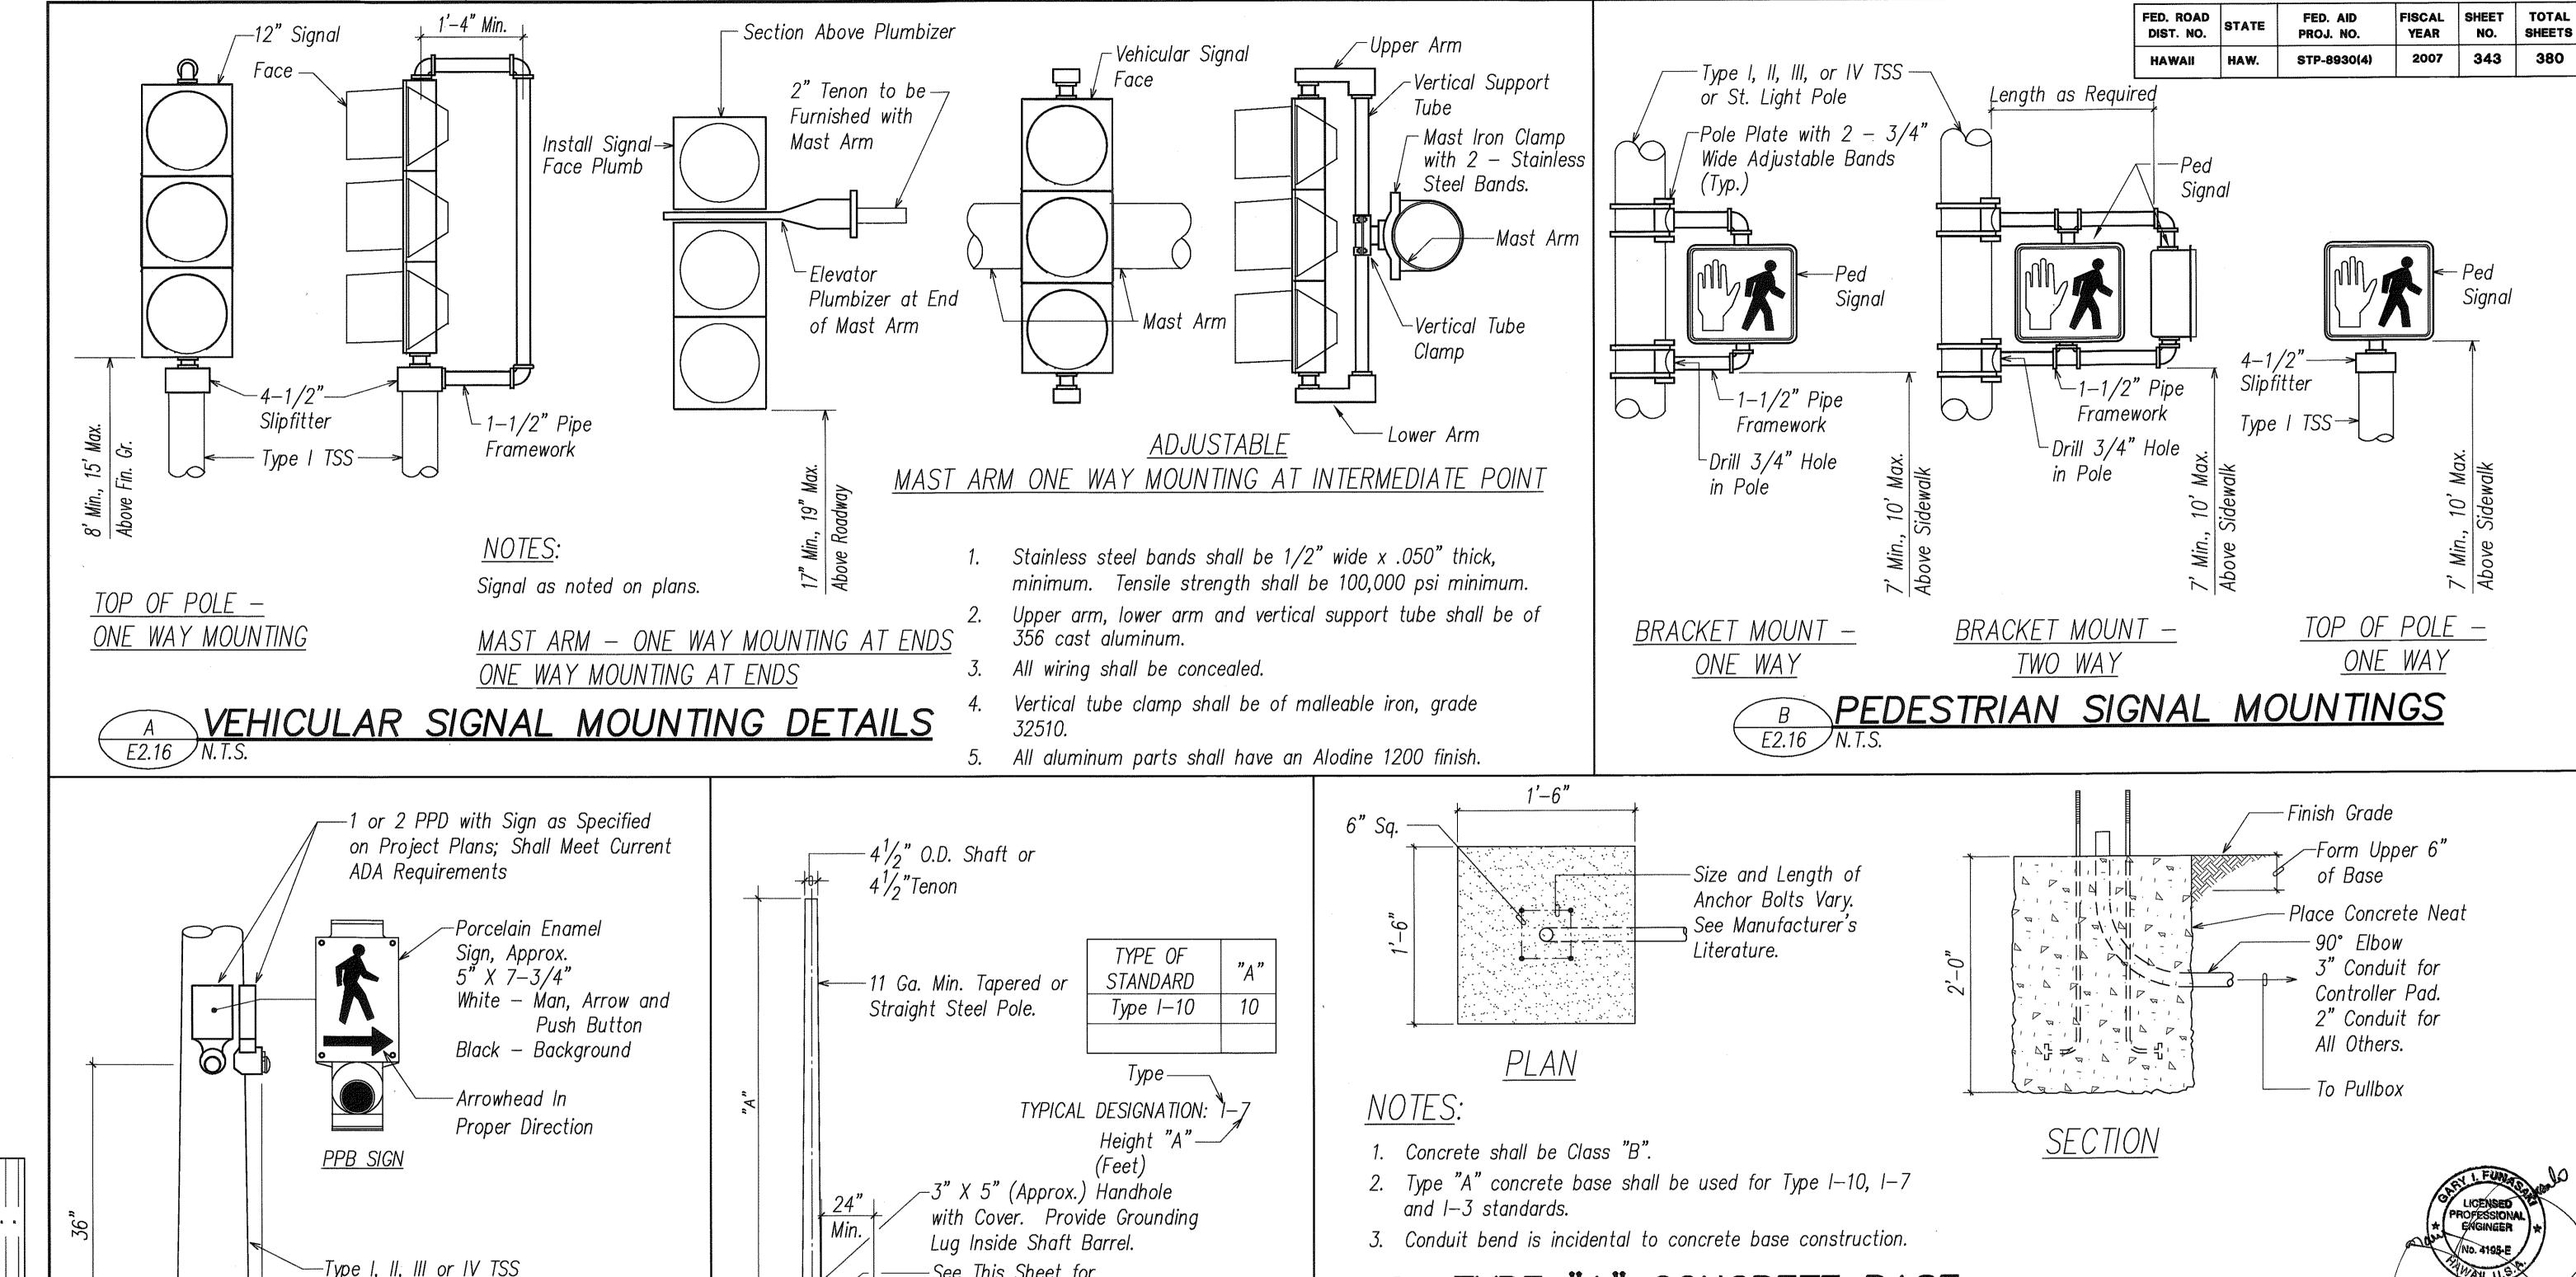


E2.16 N.T.S.

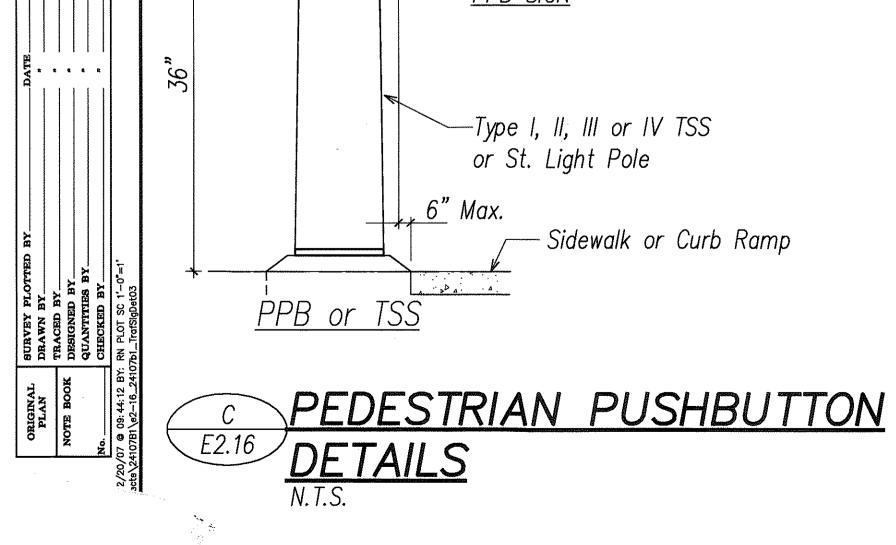

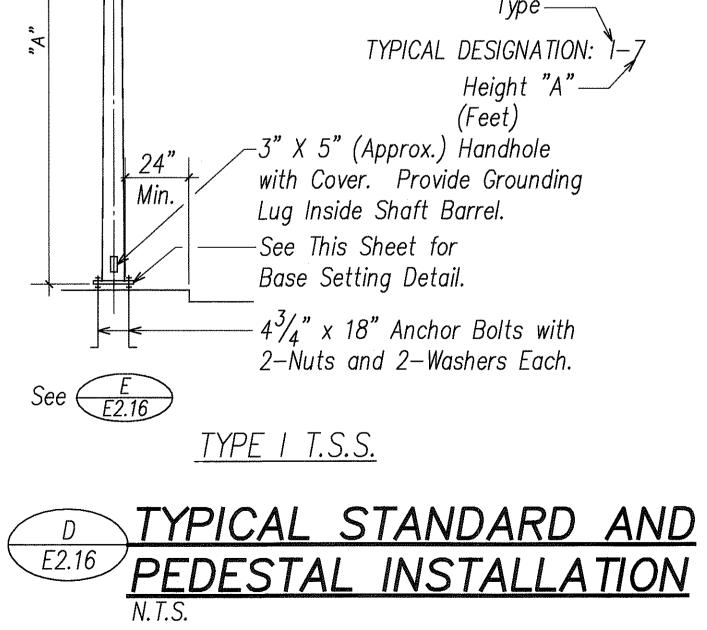


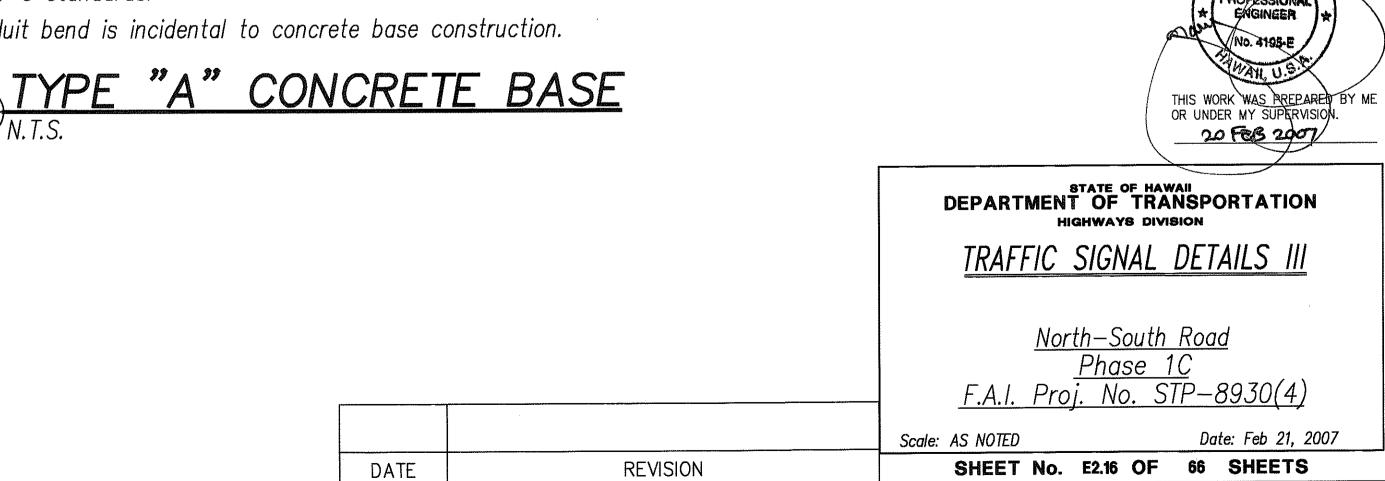


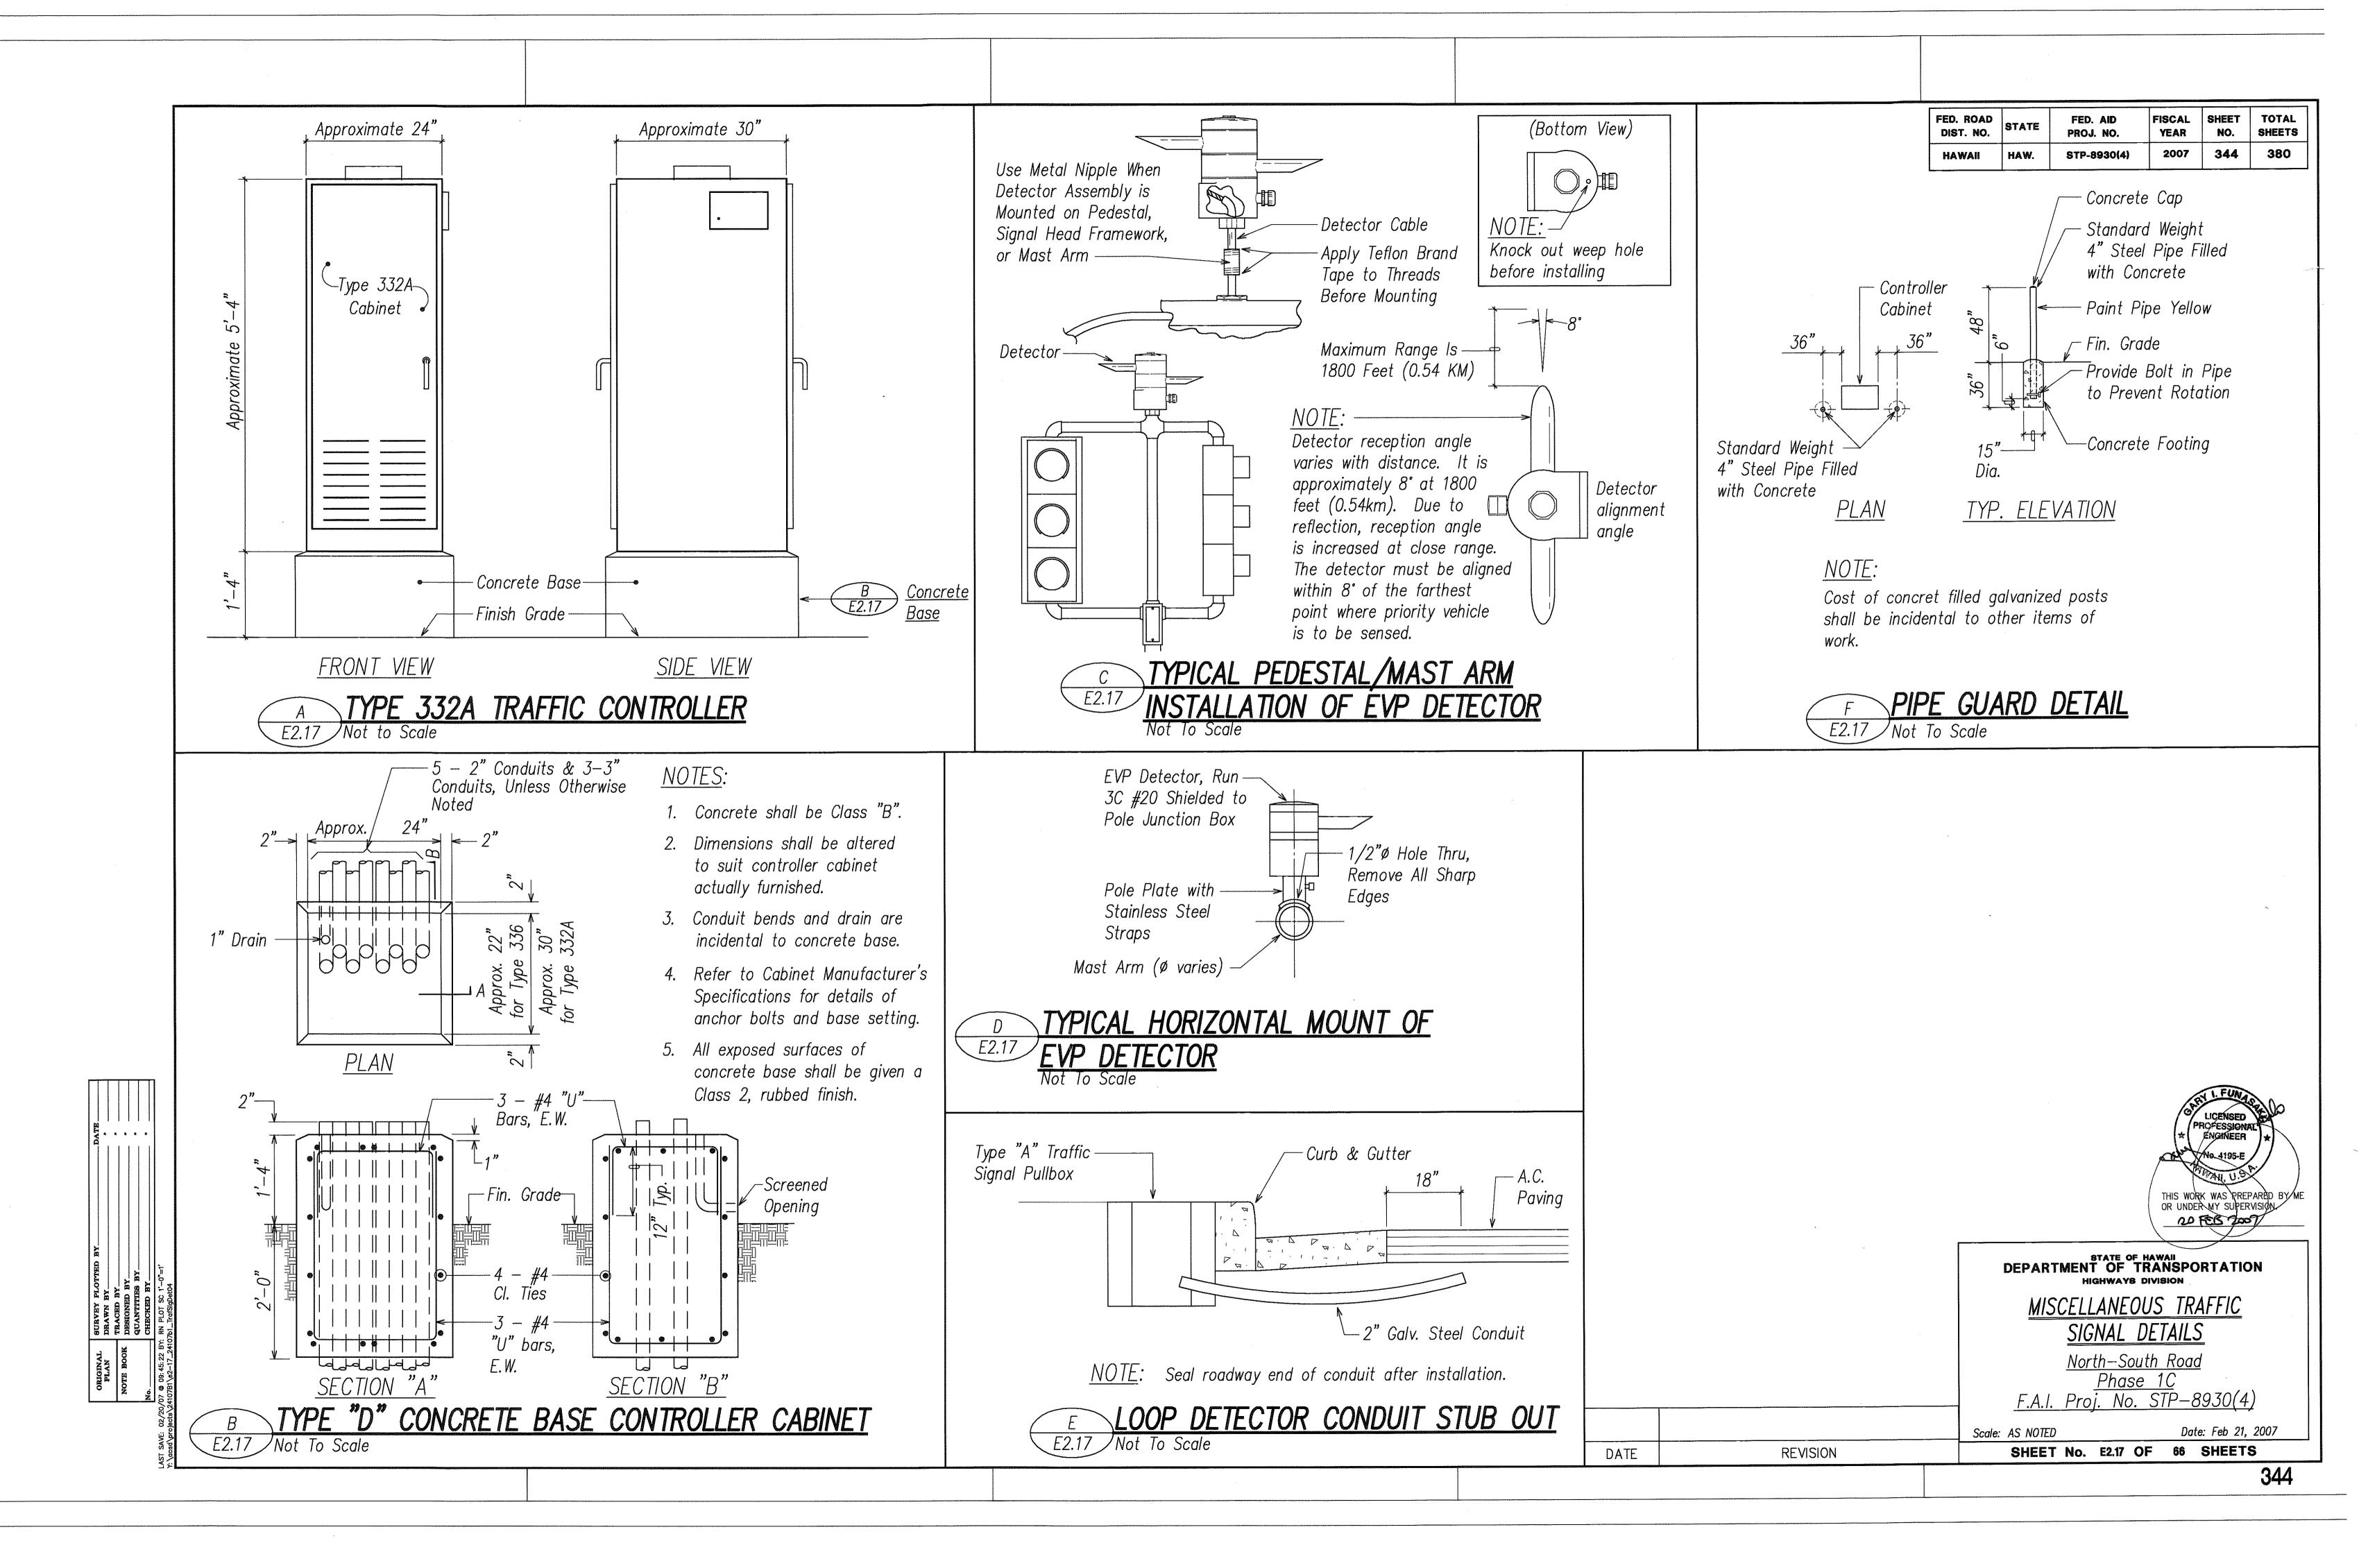

the state of the s

FED. ROAD DIST. NO.	STATE	FED. AID PROJ. NO.	FISCAL YEAR	SHEET NO.	TOTAL SHEETS
HAWAII	HAW.	STP-8930(4)	2007	345	380

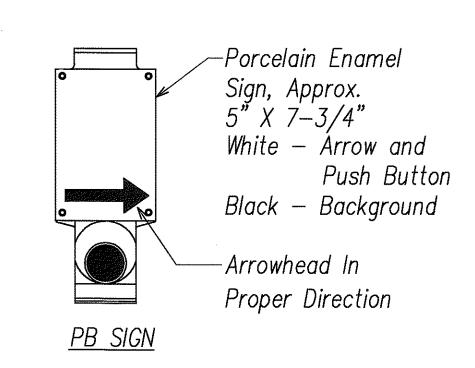

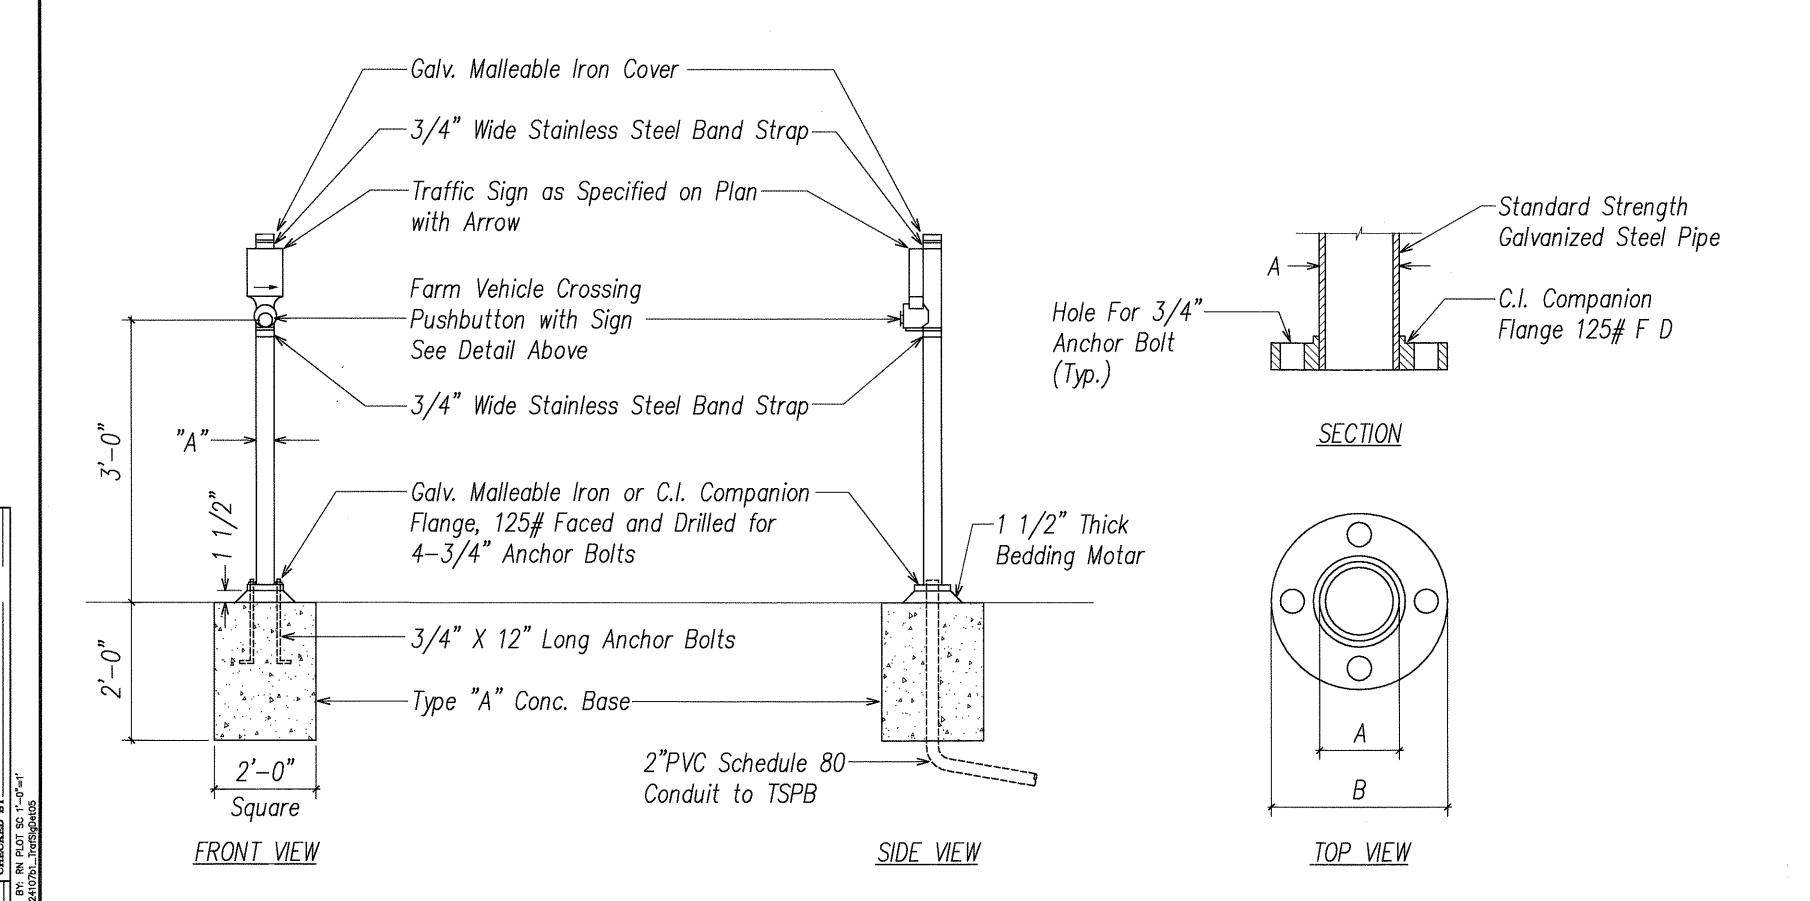

FLANGE DETAIL

FARM VEHICLE CROSSING PUSHBUTTON


POST AND FOOTING DETAIL

NOT TO SCALE

#### <u>NOTE</u>:

- 1. Conduits shall Protrude 2" Max above Finished Surface of Foundation.
- 2. Conduits Shall slope away from Post Foundation.

DATA	TABLE FOR PB	POST			
AMOUNT	DIMENSIONS				
OF PB	Α	В			
1	3 1/2"	8"			
2–3	4 1/2"	9"			

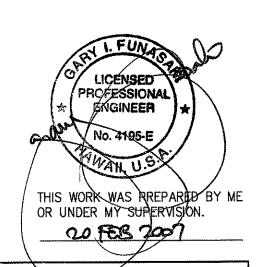

DEPARTMENT OF TRANSPORTATION
HIGHWAYS DIVISION


TO A CELC CLONAL DETAILS V


TRAFFIC SIGNAL DETAILS V


<u>North-South Road</u> <u>Phase 1C</u> F.A.I. Proj. No. STP-8930(4)

 Scale: AS NOTED
 Date: Feb 21, 2007

 DATE
 REVISION
 SHEET No. E2.18 OF 66 SHEETS

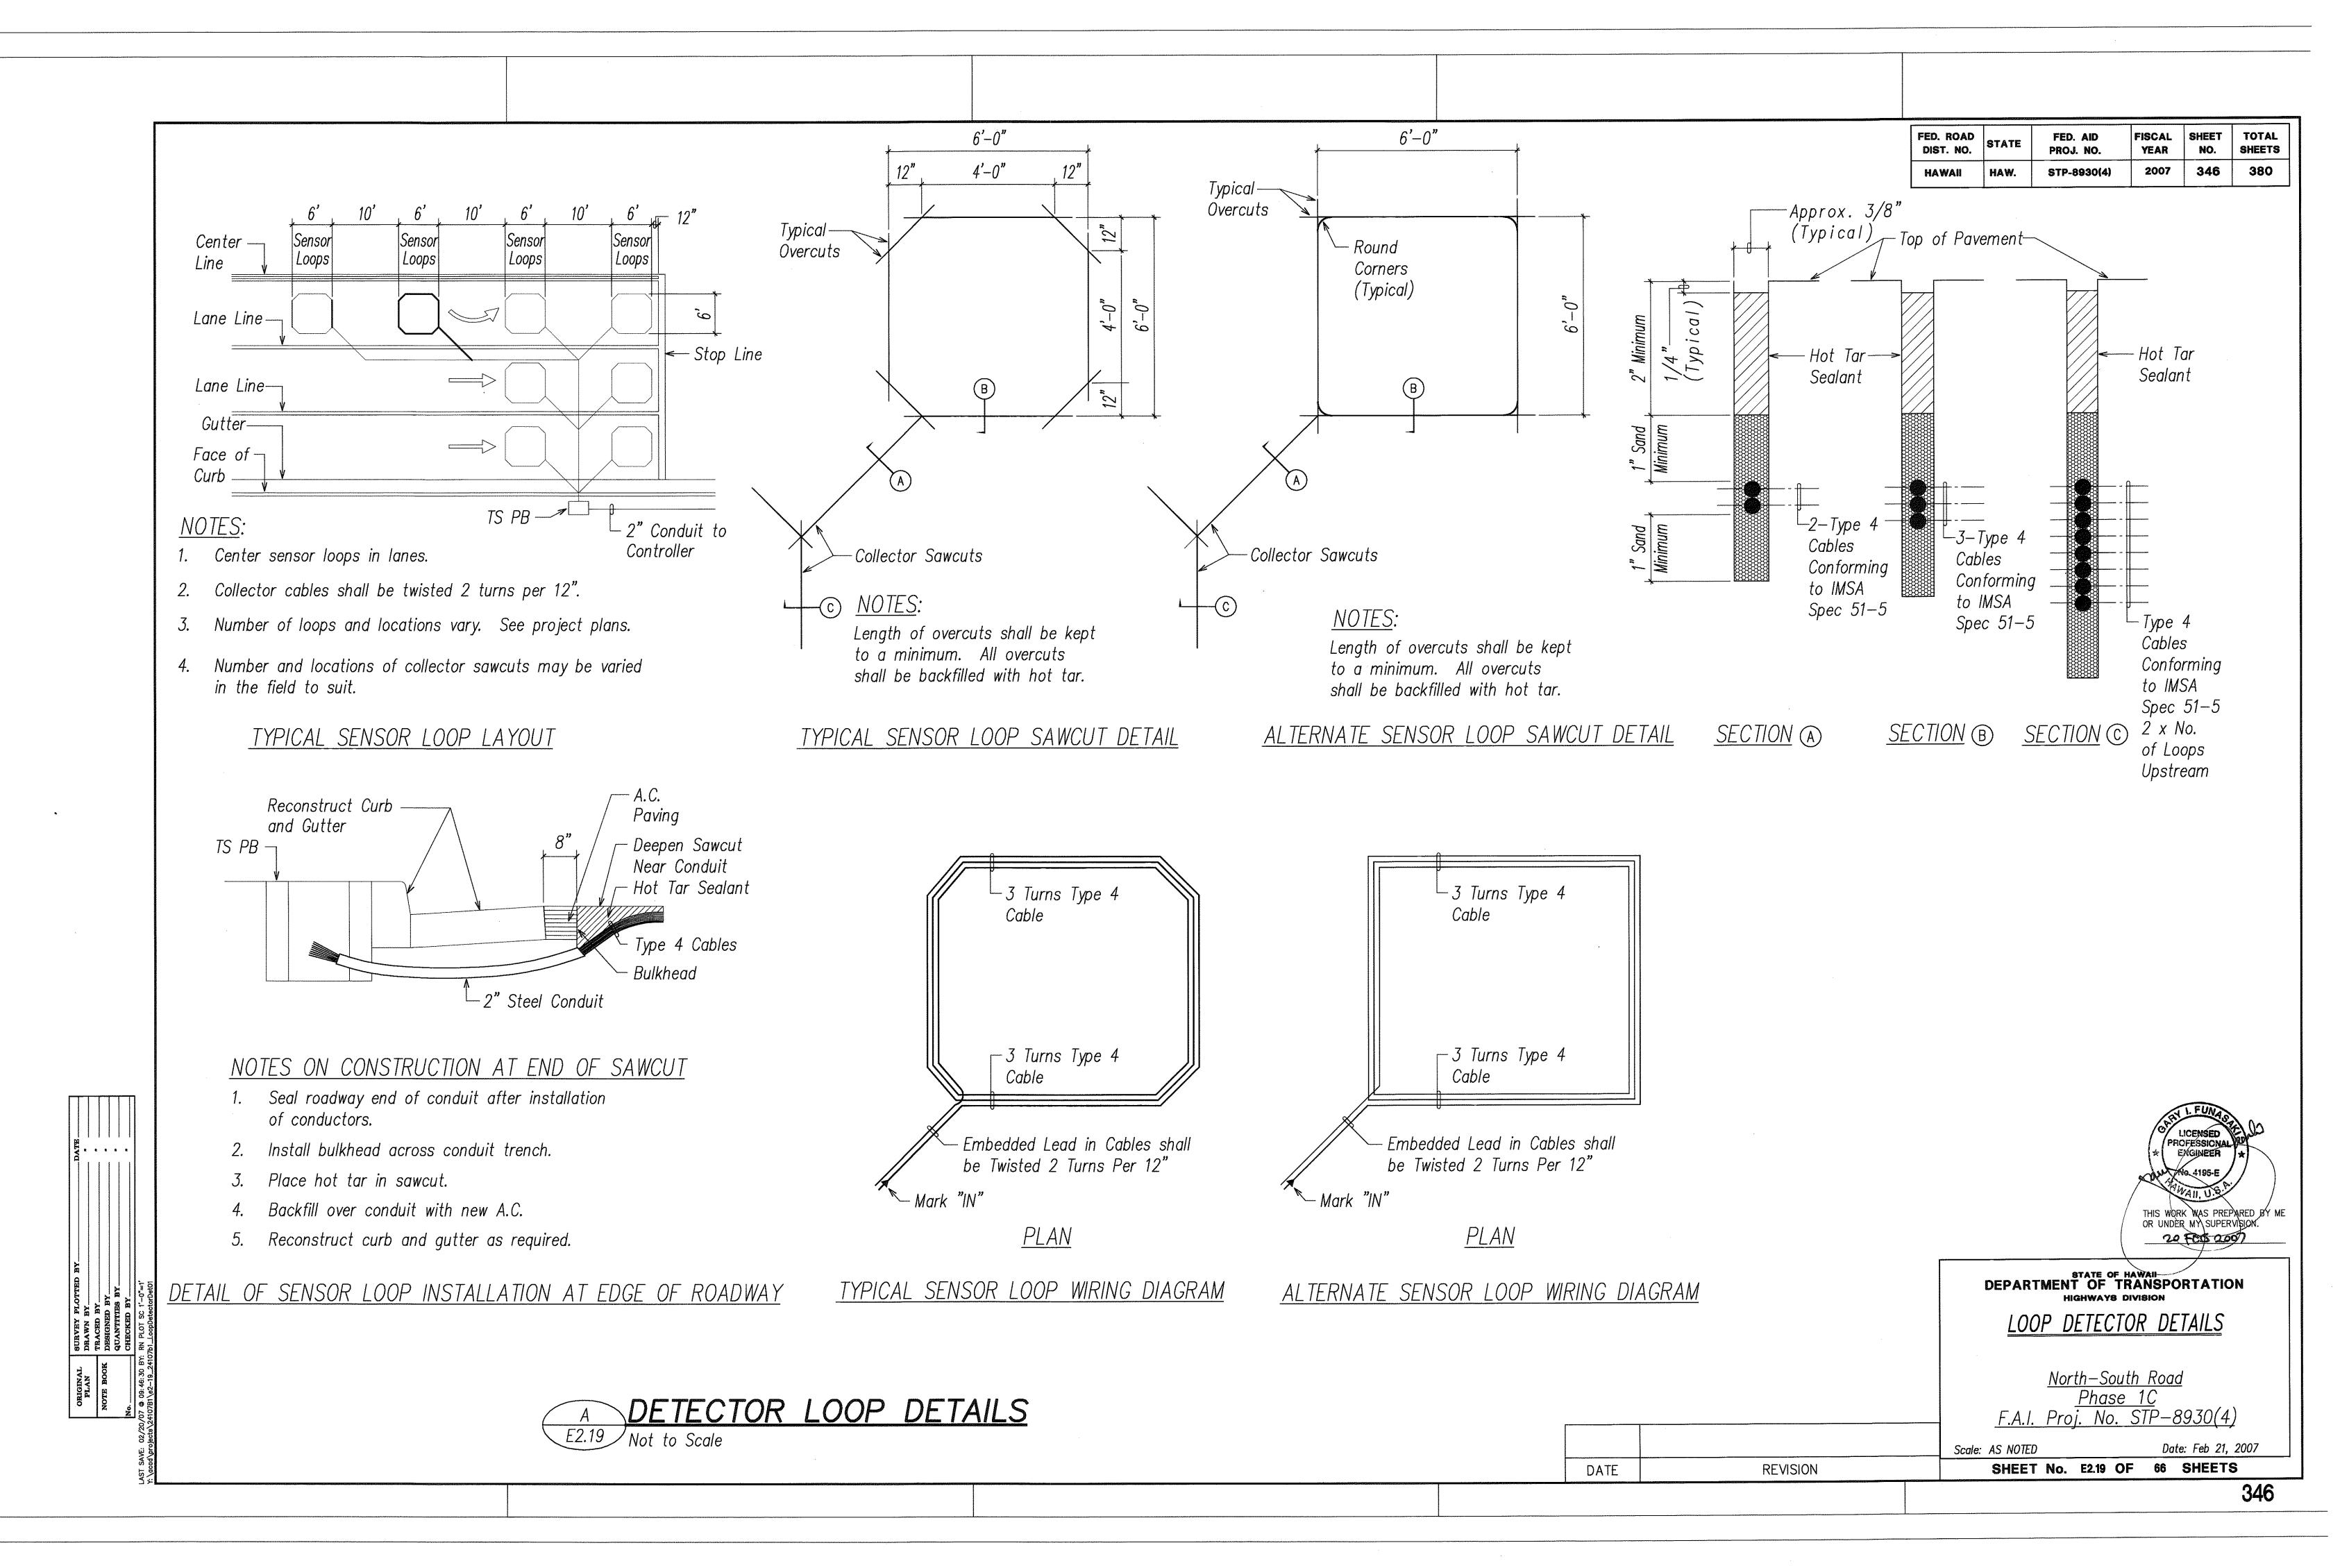


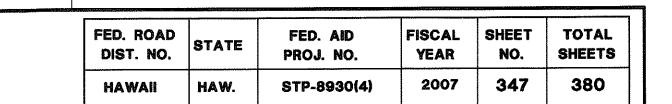

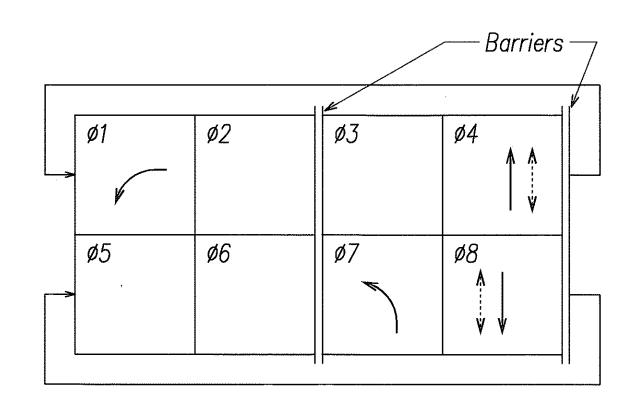


PHASE DIAGRAM

## H-1 WB RAMP/NORTH-SOUTH ROAD INTERSECTION INTERCHANGE TRAFFIC SIGNAL PLAN I

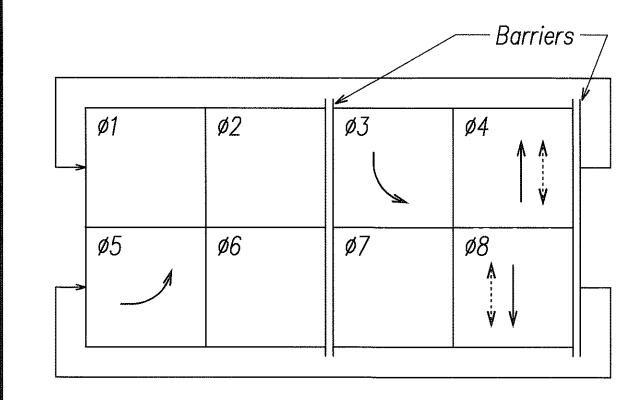

PHASE DIAGRAM

H-1 EB RAMP/NORTH-SOUTH ROAD INTERSECTION INTERCHANGE TRAFFIC SIGNAL PLAN II

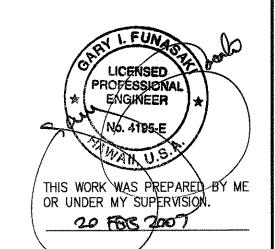

DEPARTMENT OF TRANSPORTATION
HIGHWAYS DIVISION

TRAFFIC SIGNAL PHASING DIAGRAMS


<u>North-South Road</u> <u>Phase 1C</u> F.A.I. Proj. No. STP-8930(4)


DATE REVISION

 1.A.I. FTOJ. NO. STI -0950(+)

 Scale: AS NOTED
 Date: Feb 21, 2007

SHEET No. E2.20 OF 66 SHEETS

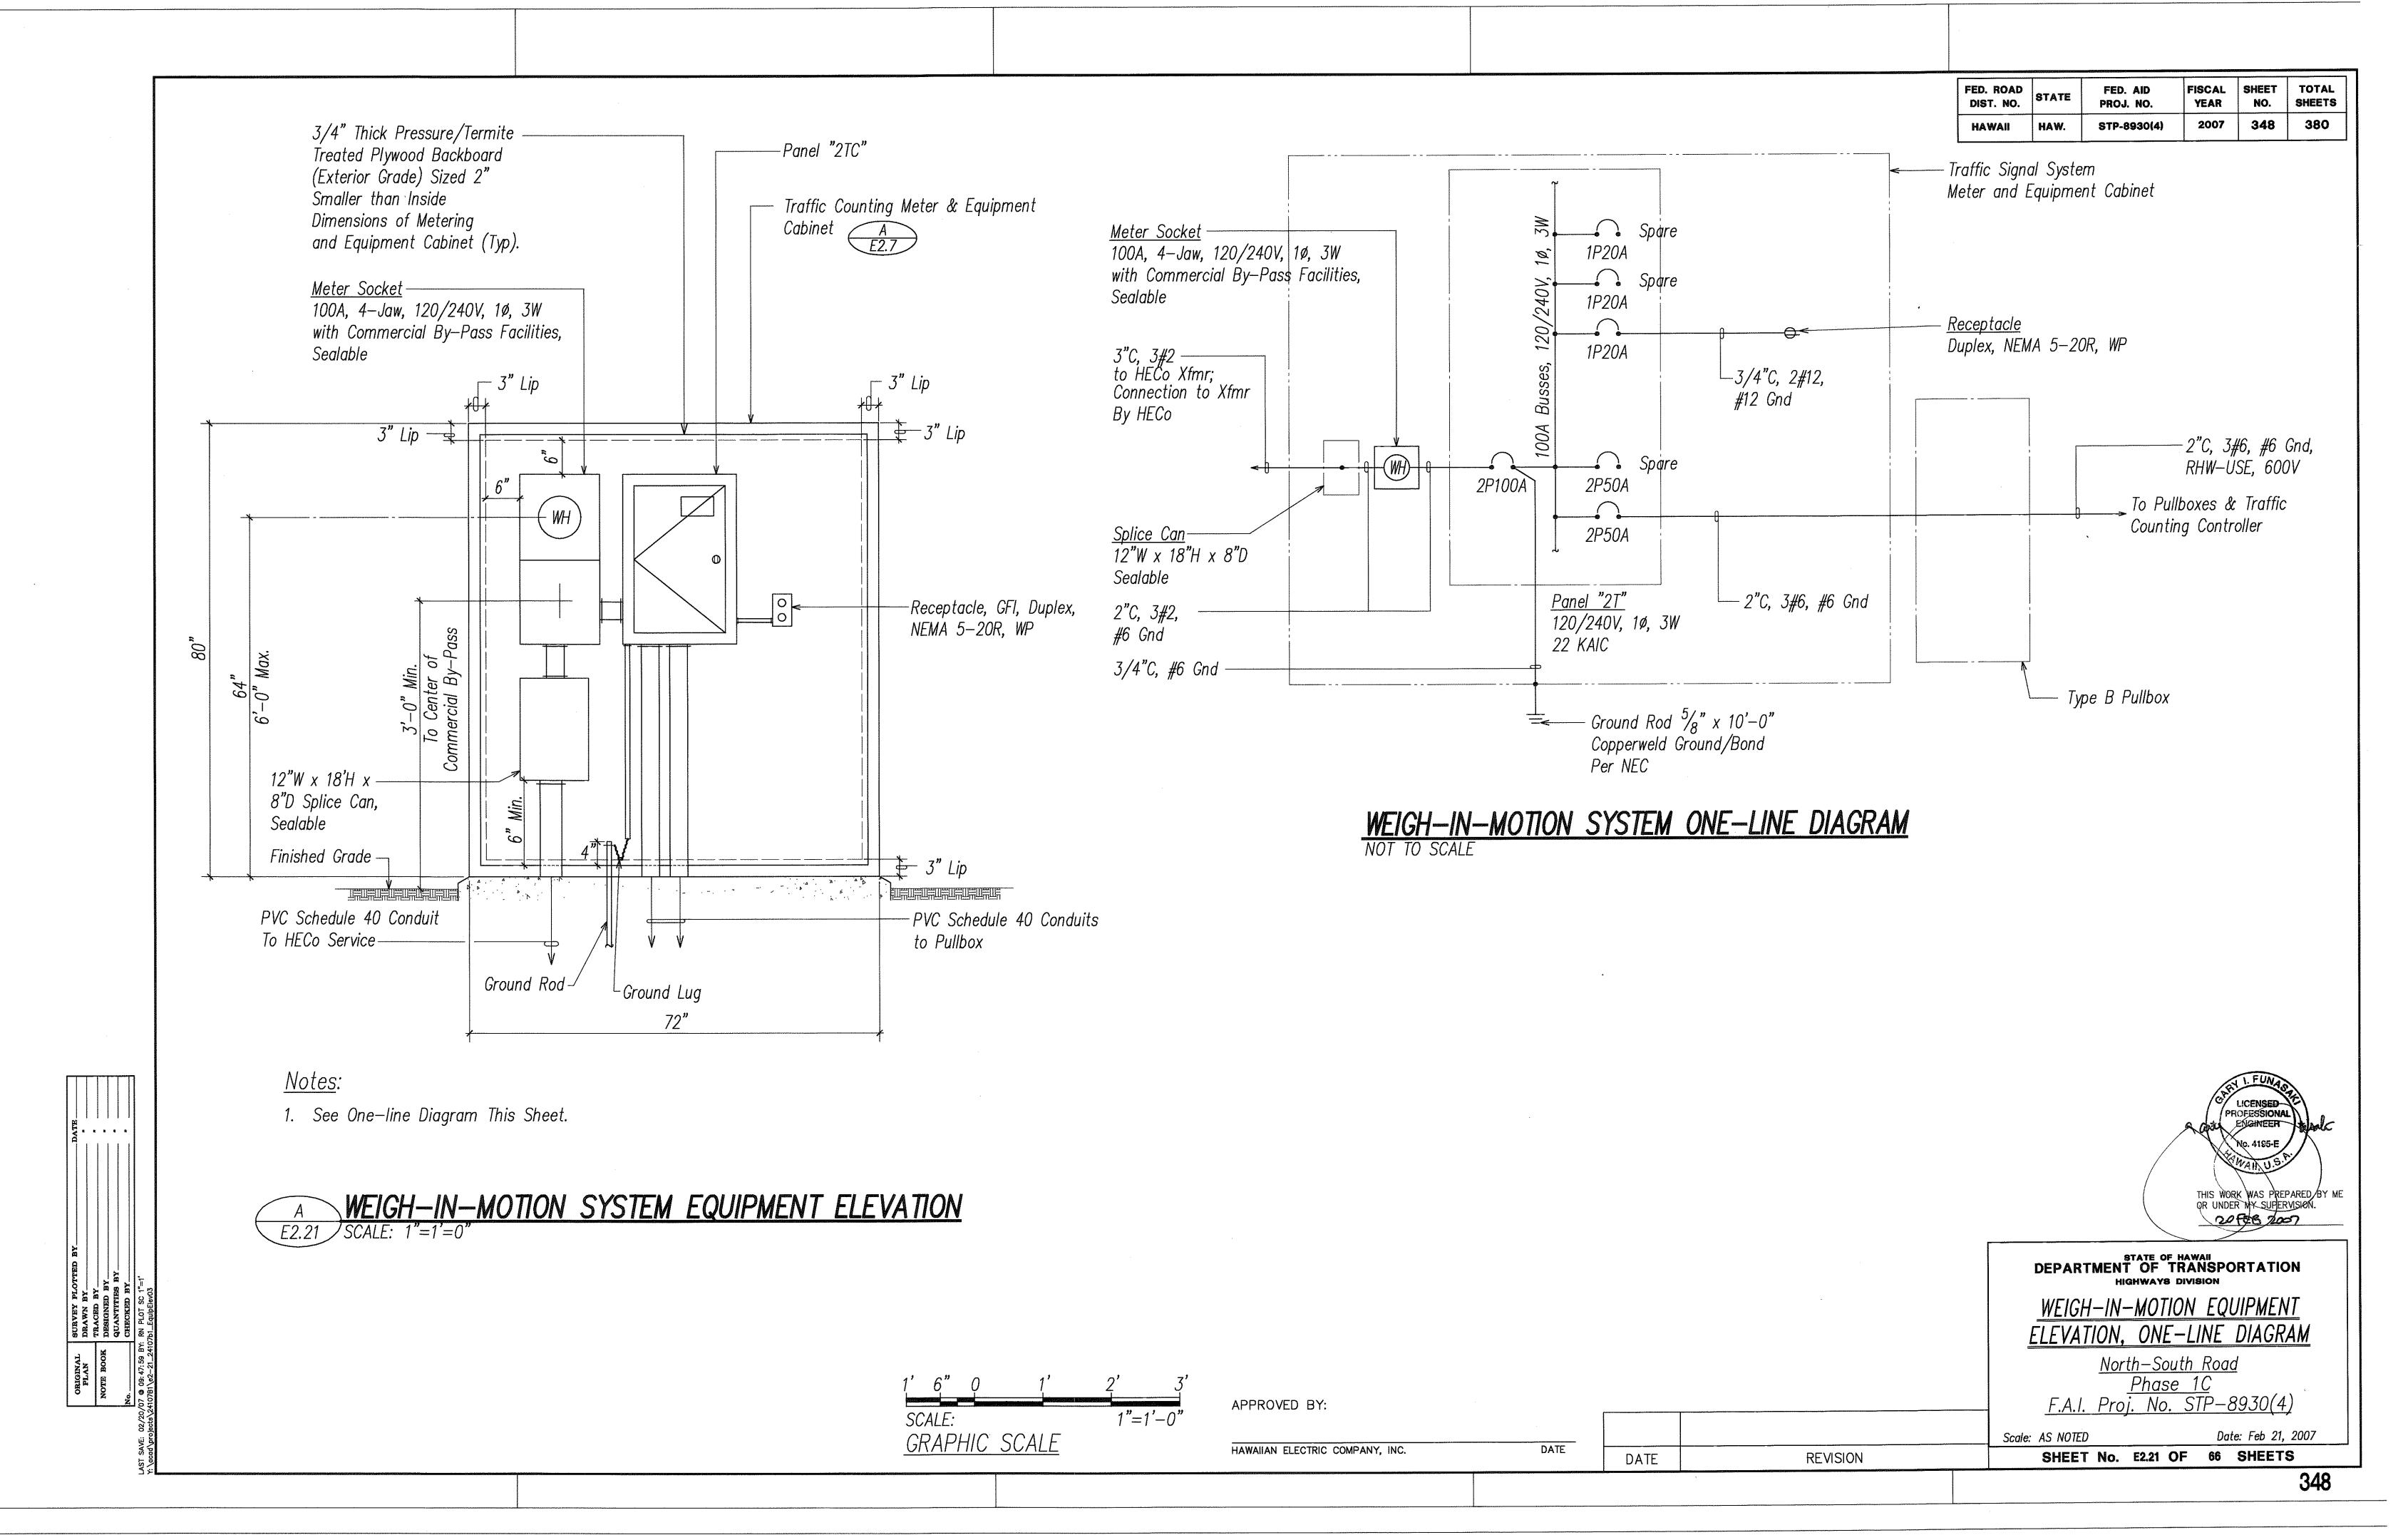

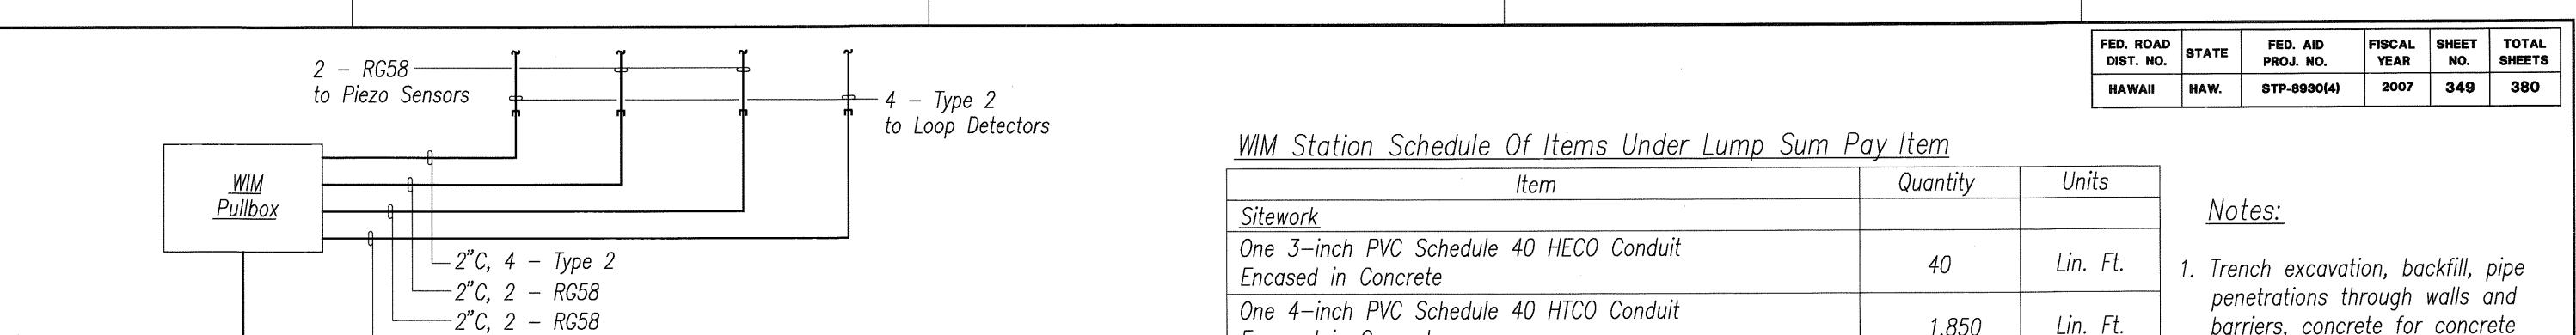

Furnish & Install Controller Cabinet, including: structure

foundation (Class B); and furnishing & installing WIM Evaluation & Data Collection Unit

Testing, including Calibration and Systems Integration

Testing and Piezoelectric Sensor Testing (Each)


excavation & backfill for foundation; concrete for

Furnish & Install Portable Terminal

Train State Personnel (10 Each)

Item	Quantity	Units
Sitework		
One 3—inch PVC Schedule 40 HECO Conduit Encased in Concrete	40	Lin. Ft.
One 4—inch PVC Schedule 40 HTCO Conduit Encased in Concrete	1,850	Lin. Ft.
One 2—inch PVC Schedule 40 HTCO Conduit Encased in Concrete for Controller	1,230	Lin. Ft.
One 3—inch PVC Schedule 40 Power Conduit Encased in Concrete with 3#4/0, #2 Ground for Controller	1,600	Lin. Ft.
One 2—inch PVC Schedule 40 Power Conduit Encased in Concrete with 3#6, #8 Ground for Controller	10	Lin. Ft.
Two 2—inch PVC Schedule 40 WIM Conduits Encased in Concrete for Controller	85	Lin. Ft.
Four 2—inch PVC Schedule 40 WIM Conduits Encased in Concrete for Controller	100	Lin. Ft.
2—Feet x 4—Feet HTCO Handhole	11	Each
Power Pullbox, Type "B", including Frame & Cover	8	Each
Furnish & Install Metering Cabinet and Service Equipment	1	Each
WIM Pullbox, Type "C", including Frame & Cover	2	Each
WIM Traffic Bearing Pullbox, including Frame & Cover	2	Each
WIM System		
Furnish & Install Piezoelectric Sensor	18	Each
Furnish & Install Vehicle Detector Loops	18	Each
Furnish & Install Loop Detector Cable (1 Each)	L.S.	L.S.
Furnish & Install Piezoelectric Sensor Cable (1 Each)	L.S.	L.S.
·····	Í.	i

ers, concrete for concrete et, and pavement sawcutting atching shall be considered ental to the cost of the us Conduit items.

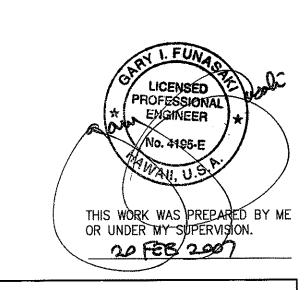

STATE OF HAWAII
DEPARTMENT OF TRANSPORTATION
HIGHWAYS DIVISION WEIGH-IN-MOTION STATION

WIRING DIAGRAM North—South Road

<u>Phase 1C</u> F.A.I. Proj. No. STP-8930(4)

Date: Feb 21, 2007 Scale: AS NOTED SHEET No. E-2.22 OF 66 SHEETS

Each

Each

L.S.

L.S.

L.S.

REVISION

DATE

	1	WIM villbox  3 - RG58 to Piezo Sensors	-2"C Stubout (Typ.)
	2"C, 10 — Type 1————————————————————————————————————	2"C, 6 - Type 2 -2"C, 3 - RG58 -2"C, 3 - RG58 -2"C, 6 - Type 2	to Loop Detectors
	2"C, 10 - Type 1 2"C, 10 - RG58 2"C, 6 - Type 1 2"C, 6 - RG58	1 - RG58 - T	-6 — Type 2 to Loop Detectors -2 — Type 2
BYBY	2"C, 10 — Type 1————————————————————————————————————	WIM    Jillbox   -2"C, 2 - Type 2   -2"C, 1 - RG58   -2"C, 1 - RG58   -2"C, 2 - Type 2	to Loop Detectors
ORIGINAL BURVEY PLOTTED PLAN TRACED BY TRACED BY DESIGNED BY QUANTITIES BY  O2/20/07 © 09: 48: 25 BY; RN PLOT SC 1'-0"=1'	2"C, Tel————————————————————————————————————	2"C, 10 - Type 1 2"C, 10 - RG58 2"C, 8 - Type 1 2"C, 8 - RG58  WM STATION WIRING DIAGRAM NOT TO SCALE	
LAST SAVE: Y:\pr			

−2"C, 4 − Type 2


−2"C, 6 − Type 2

−2"C, 3 − RG58

*□ 2"C, 6 - Type 2* 

\_\_\_\_2"C, 3 - RG58

2"C, 4 - Type 1 2"C, 4 - RG58

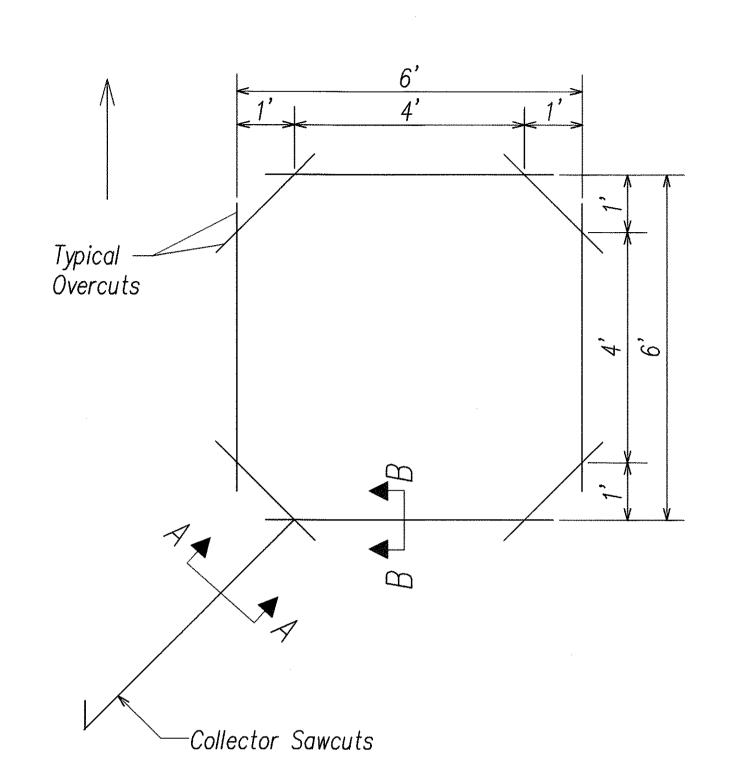


Notes: 1. Length of overcuts shall be kept to a minimum.


All overcuts shall be backfilled with hot tar.

2. The Contractor shall lay out the loop detectors so that the cutting of the pavement will not cut the existing dowels.

### TYPICAL WIM SENSOR LOOP SAWCUT DETAIL

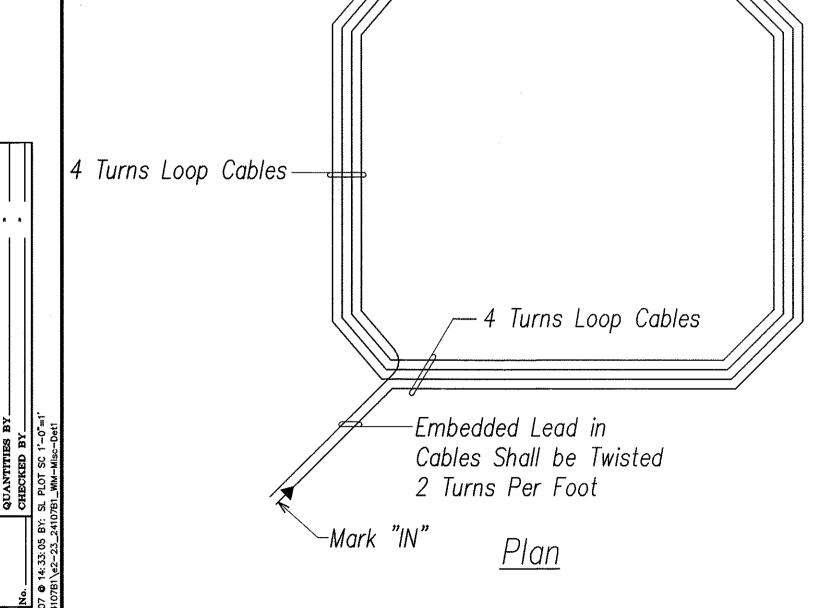


TYPICAL WIM SENSOR LOOP WIRING DIAGRAM

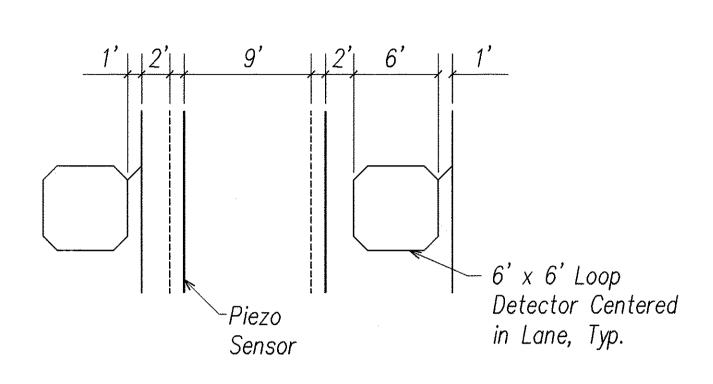

#### <u>Notes:</u>

- 1. The Contractor shall submit layout of loop detectors and piezo sensors for approval by the Engineer.
- 2. The Contractor shall lay out the loop detectors so that the cutting of the pavement will not cut the existing dowels.


TYPICAL WEIGH-IN-MOTION (WIM) SYSTEM LAYOUT

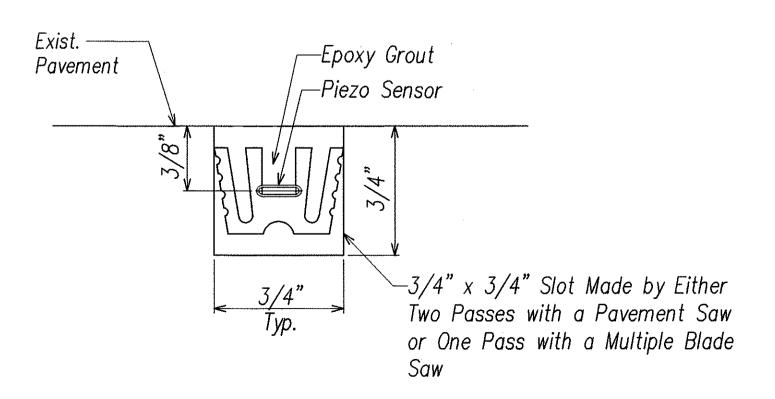

WIM PIEZO SENSOR DETAIL
NOT TO SCALE

FED. ROAD DIST. NO. STATE FED. AID PROJ. NO. FISCAL SHEET NO. SHEETS

HAWAII HAW. STP-8930(4) 2007 ADD. 350 380

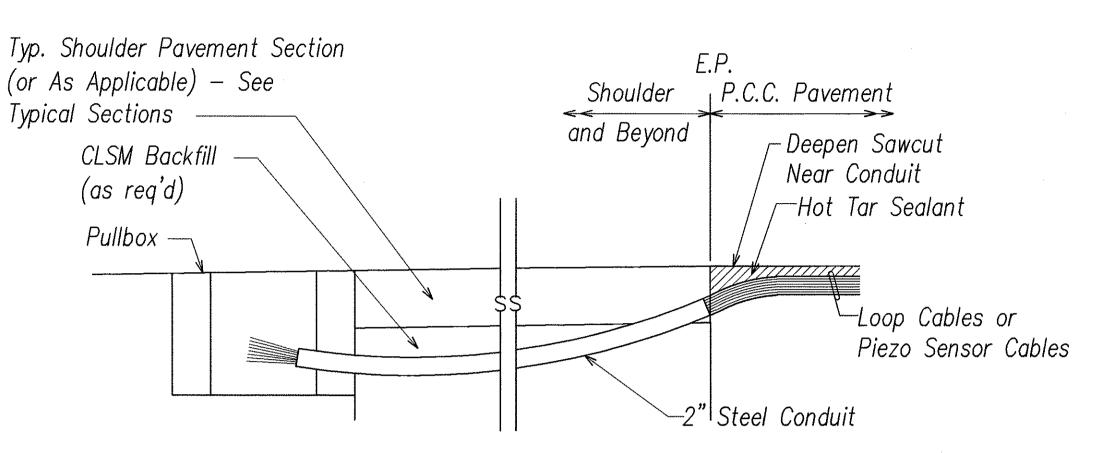

#### Notes On Construction At End Of Sawcut

- 1. Seal roadway end of conduit after installation of conductors
- 2. Place hot tar in sawcut.


4/20/07 \( \frac{1}{2} \) Revised Titles

REVISION


DATE


3. Backfill over conduit with new CLSM and reconstruct pavement as required.


# DETAIL OF CONDUIT TO SAWCUT TRANSITION FOR WIM LOOP DETECTION AND PIEZO SENSORS

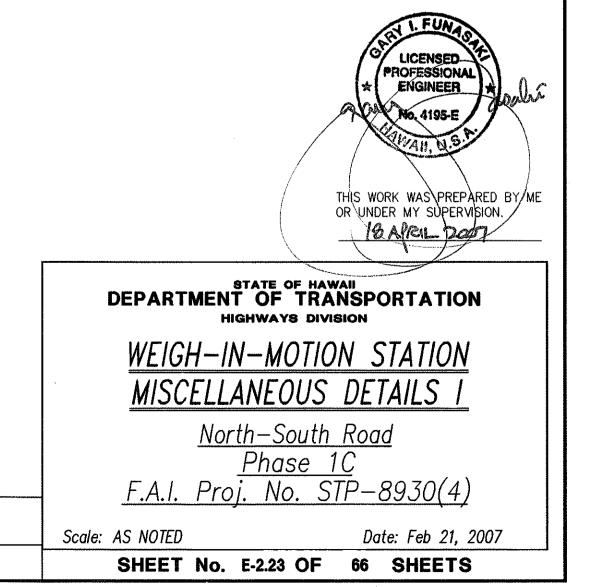



ADD. 350

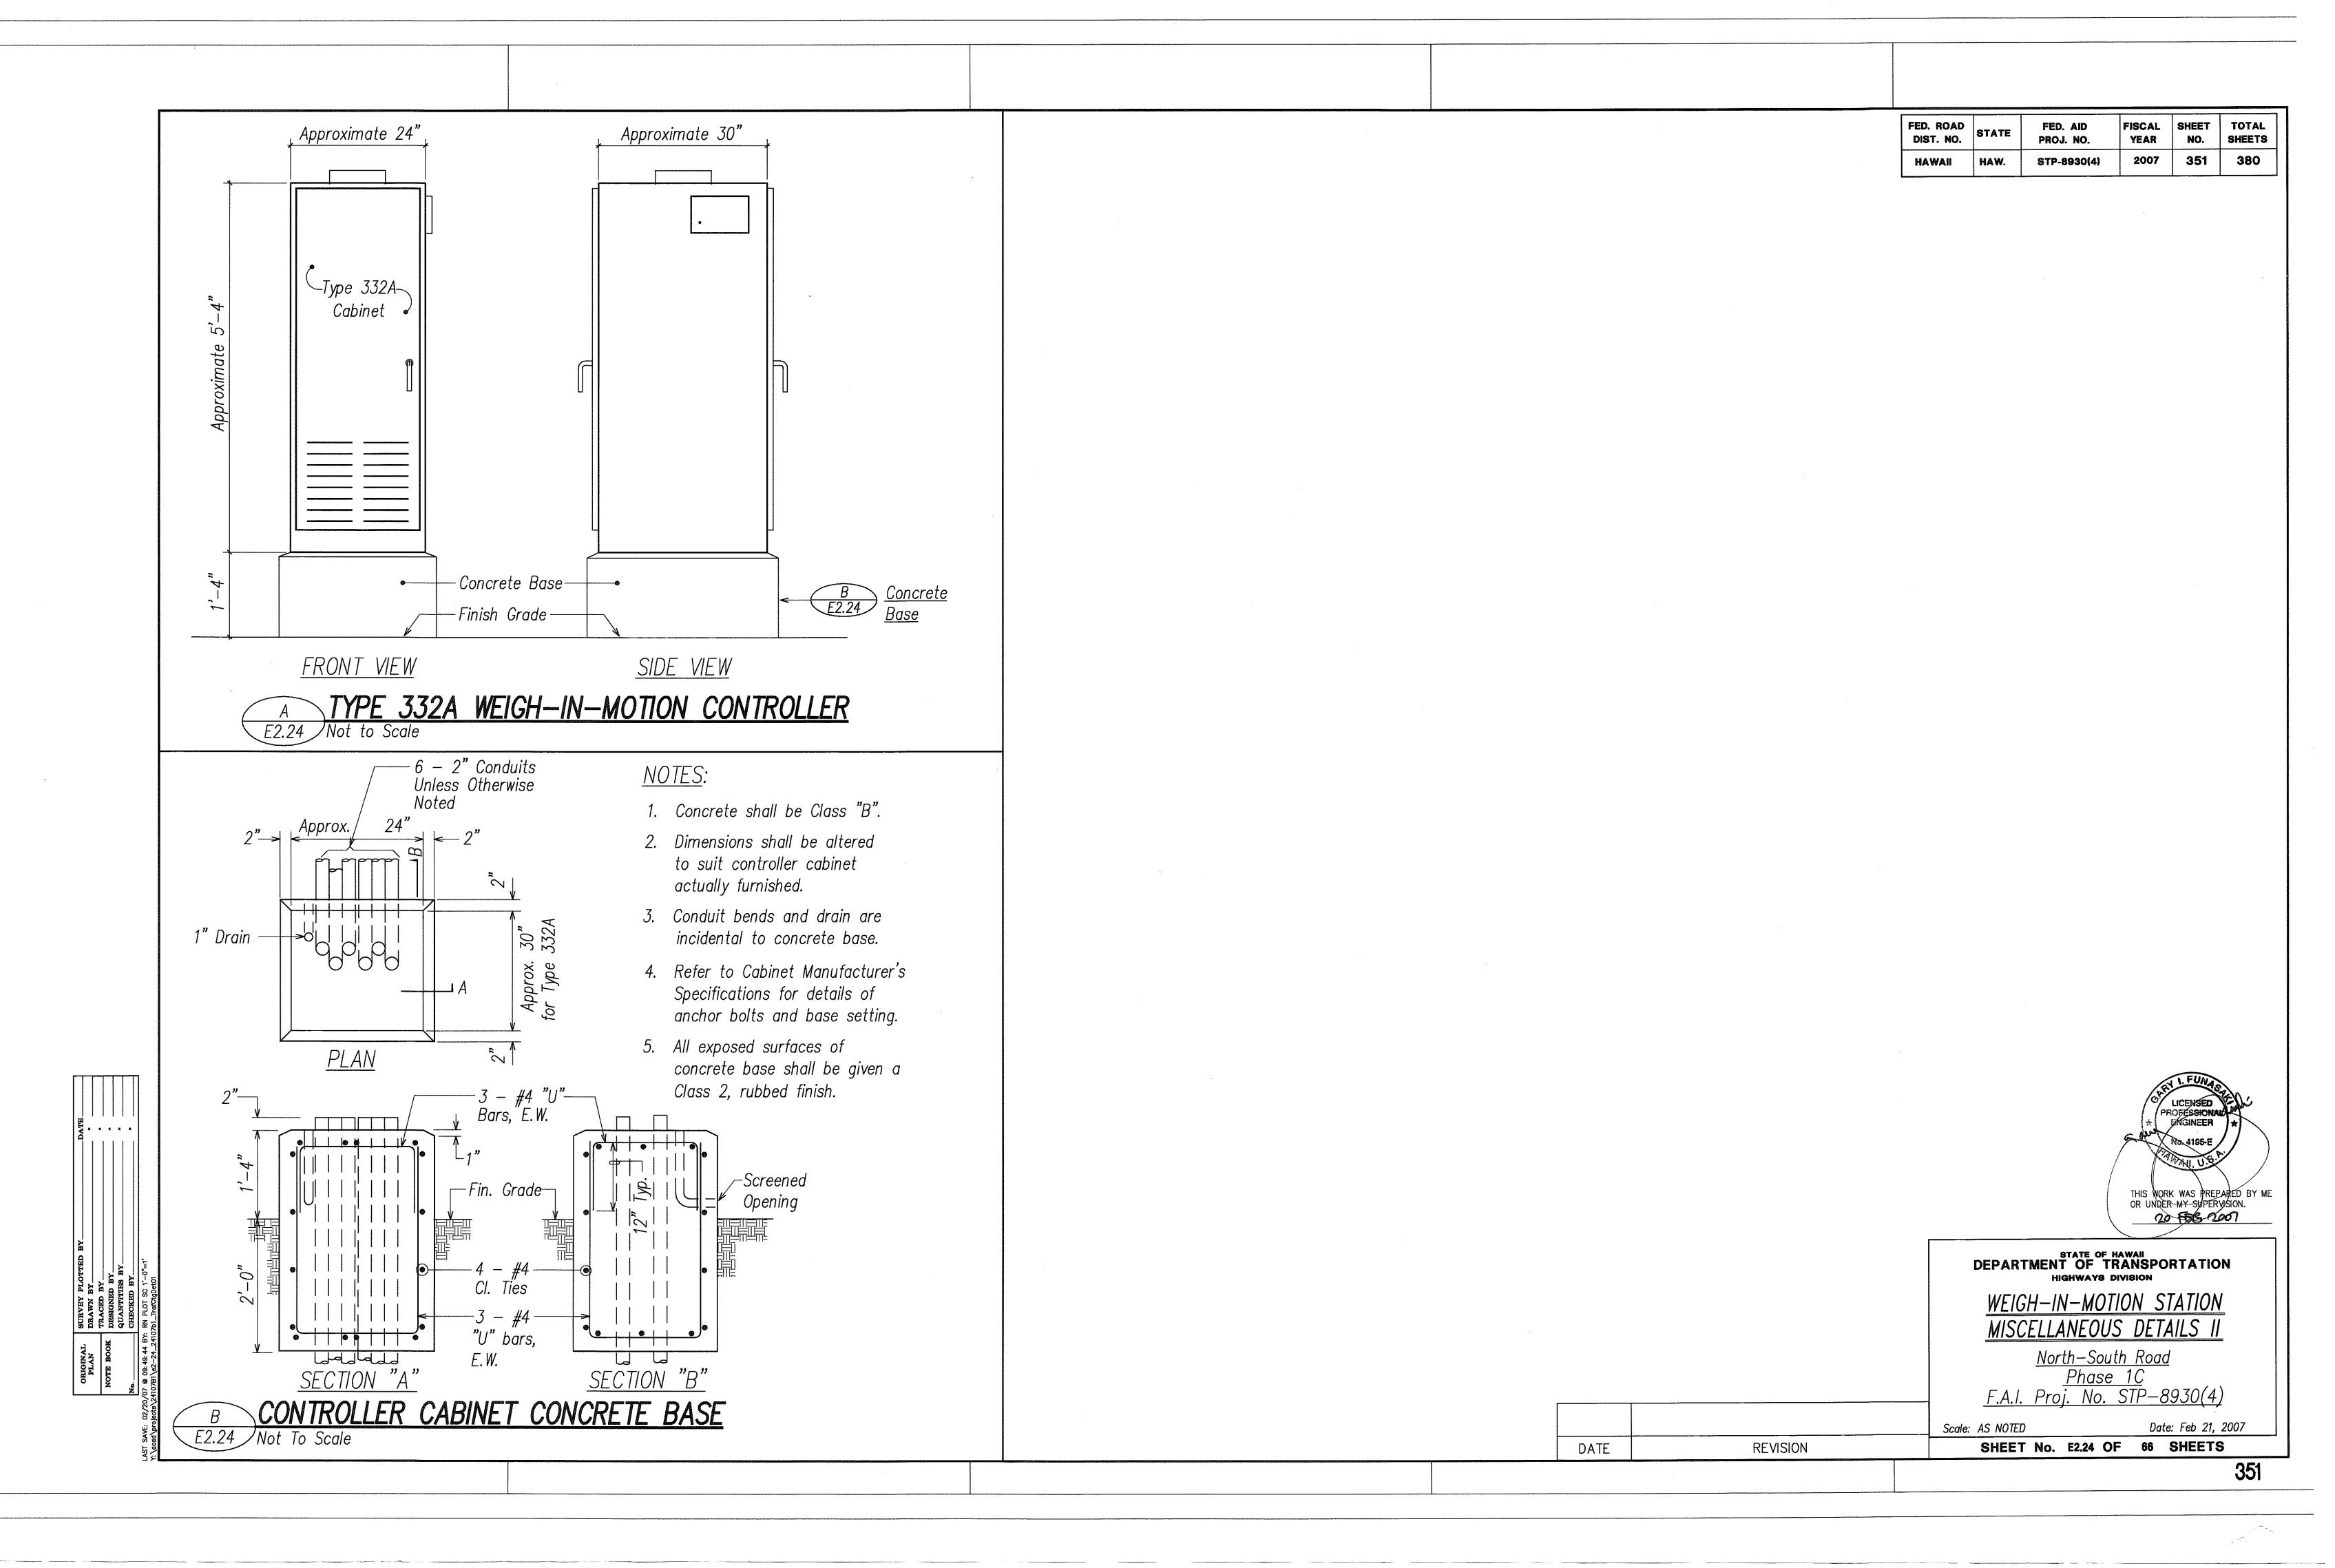


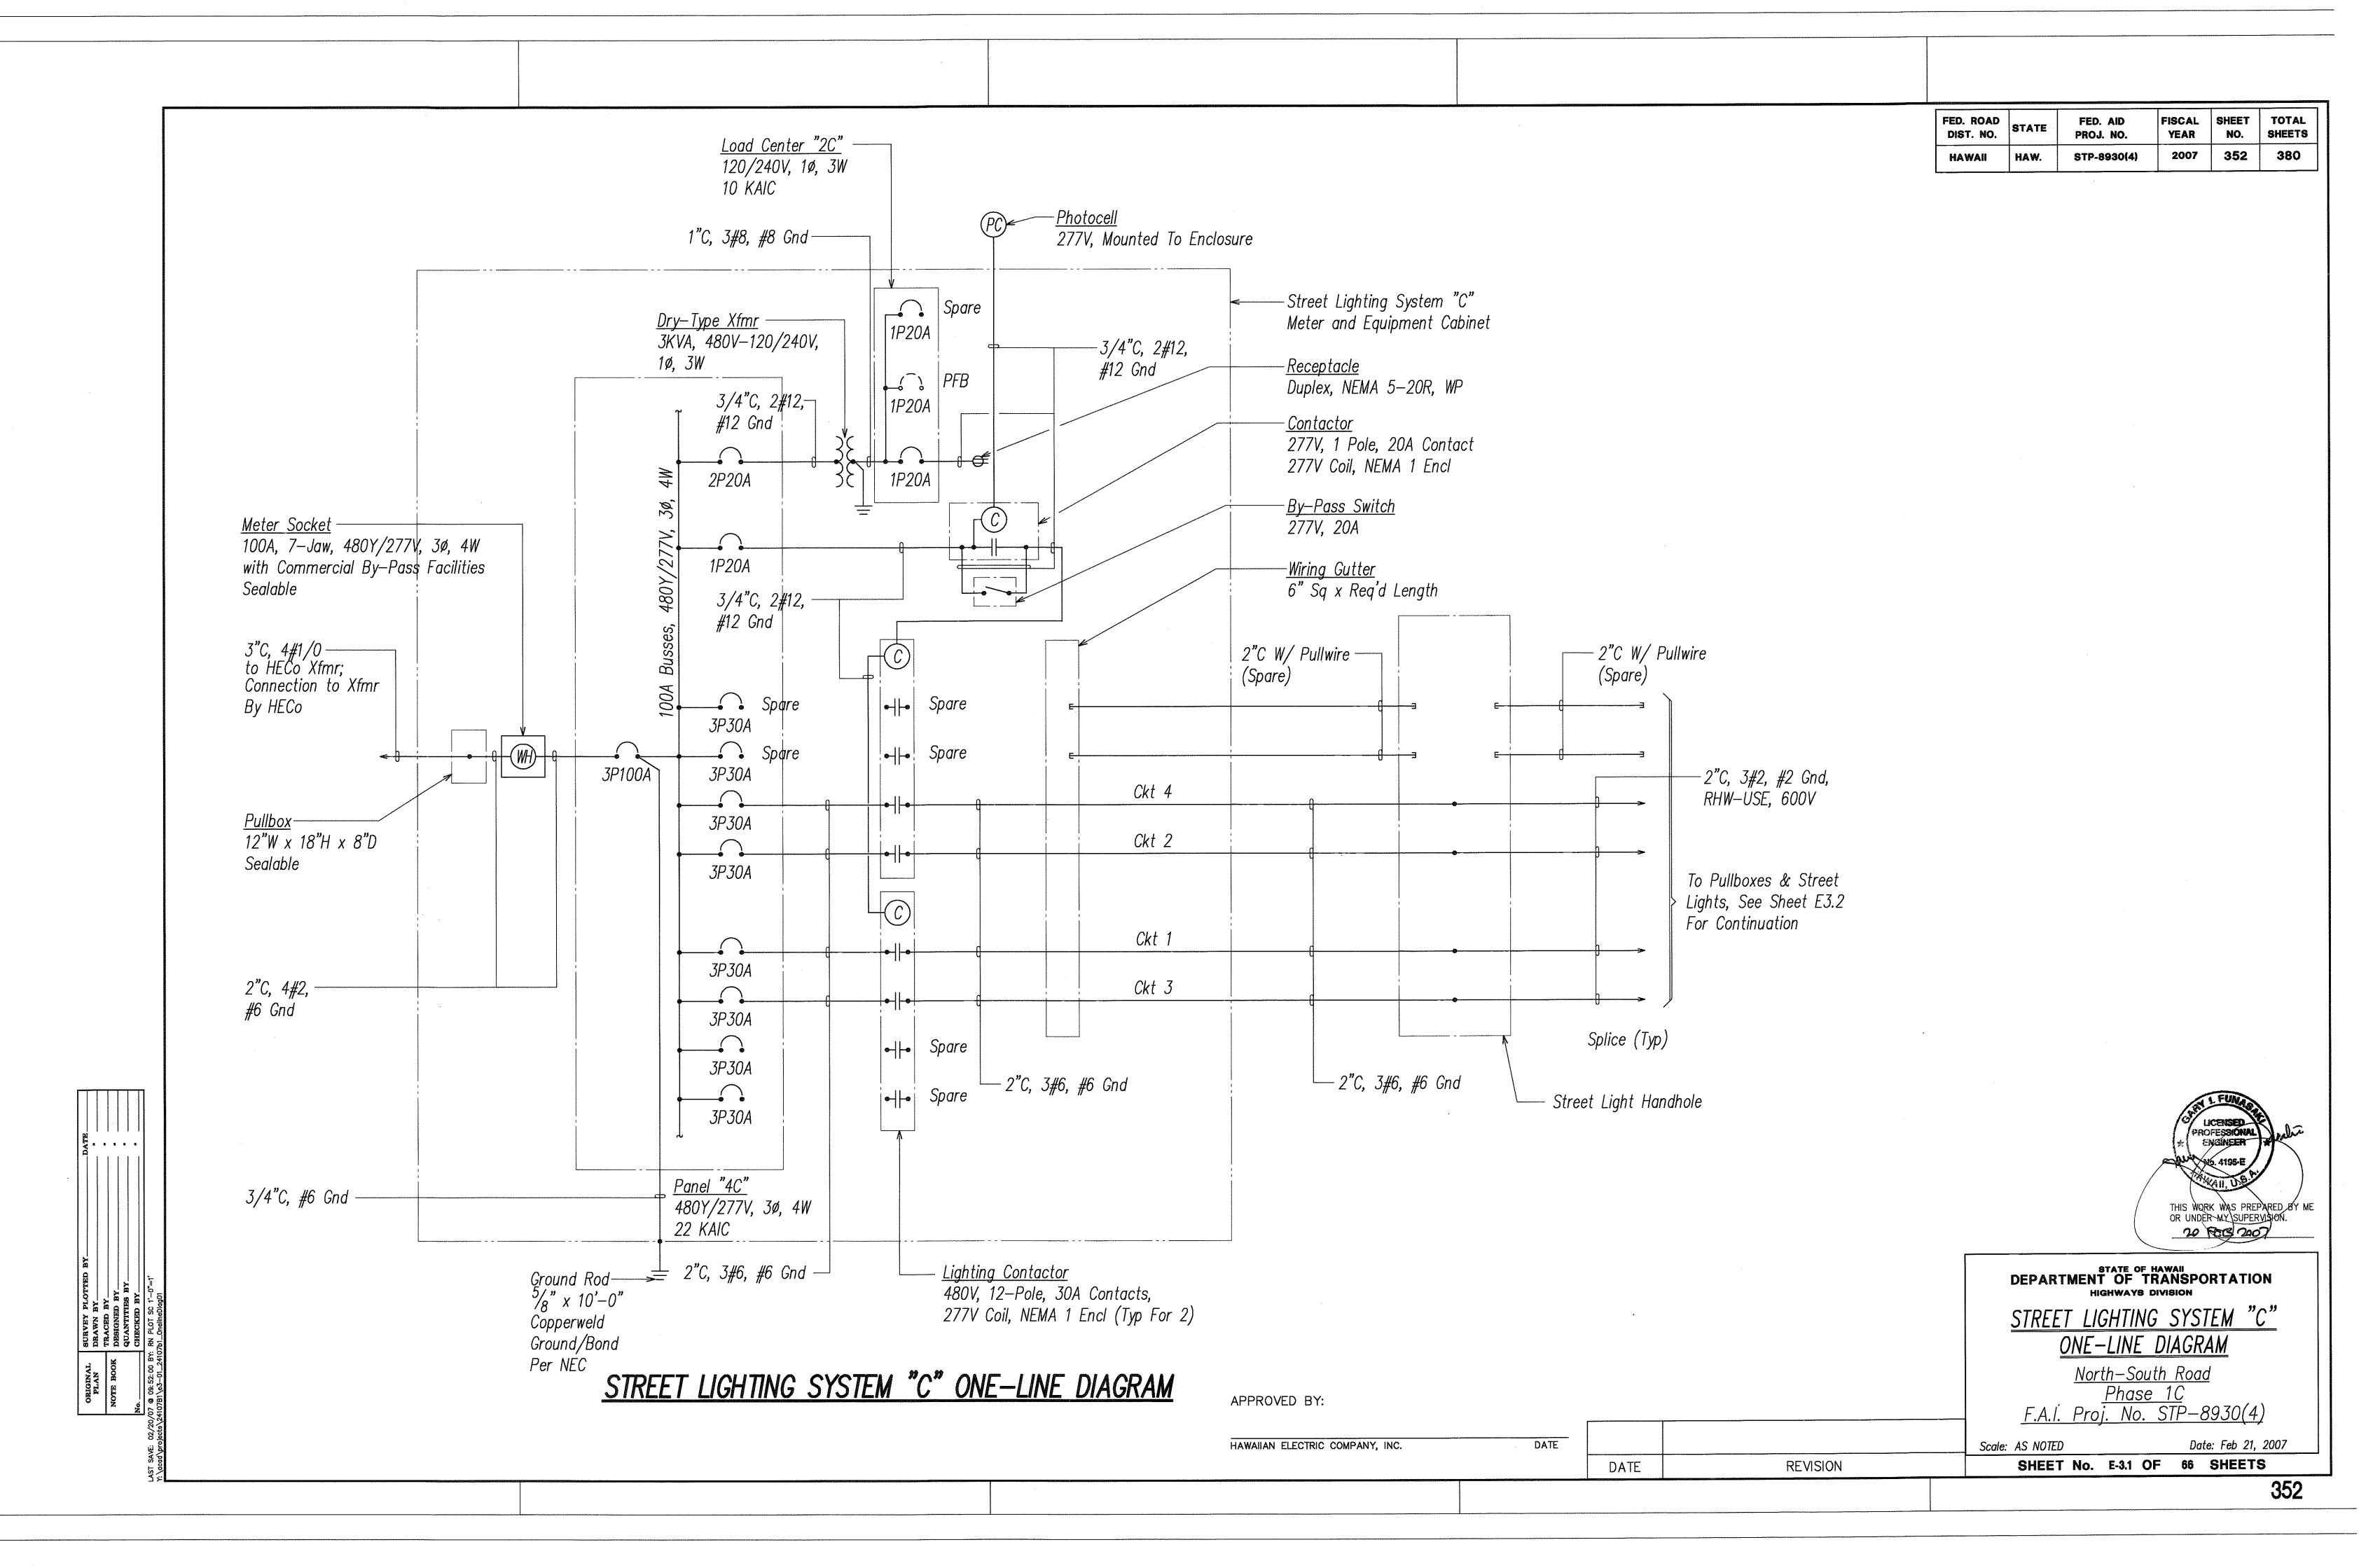


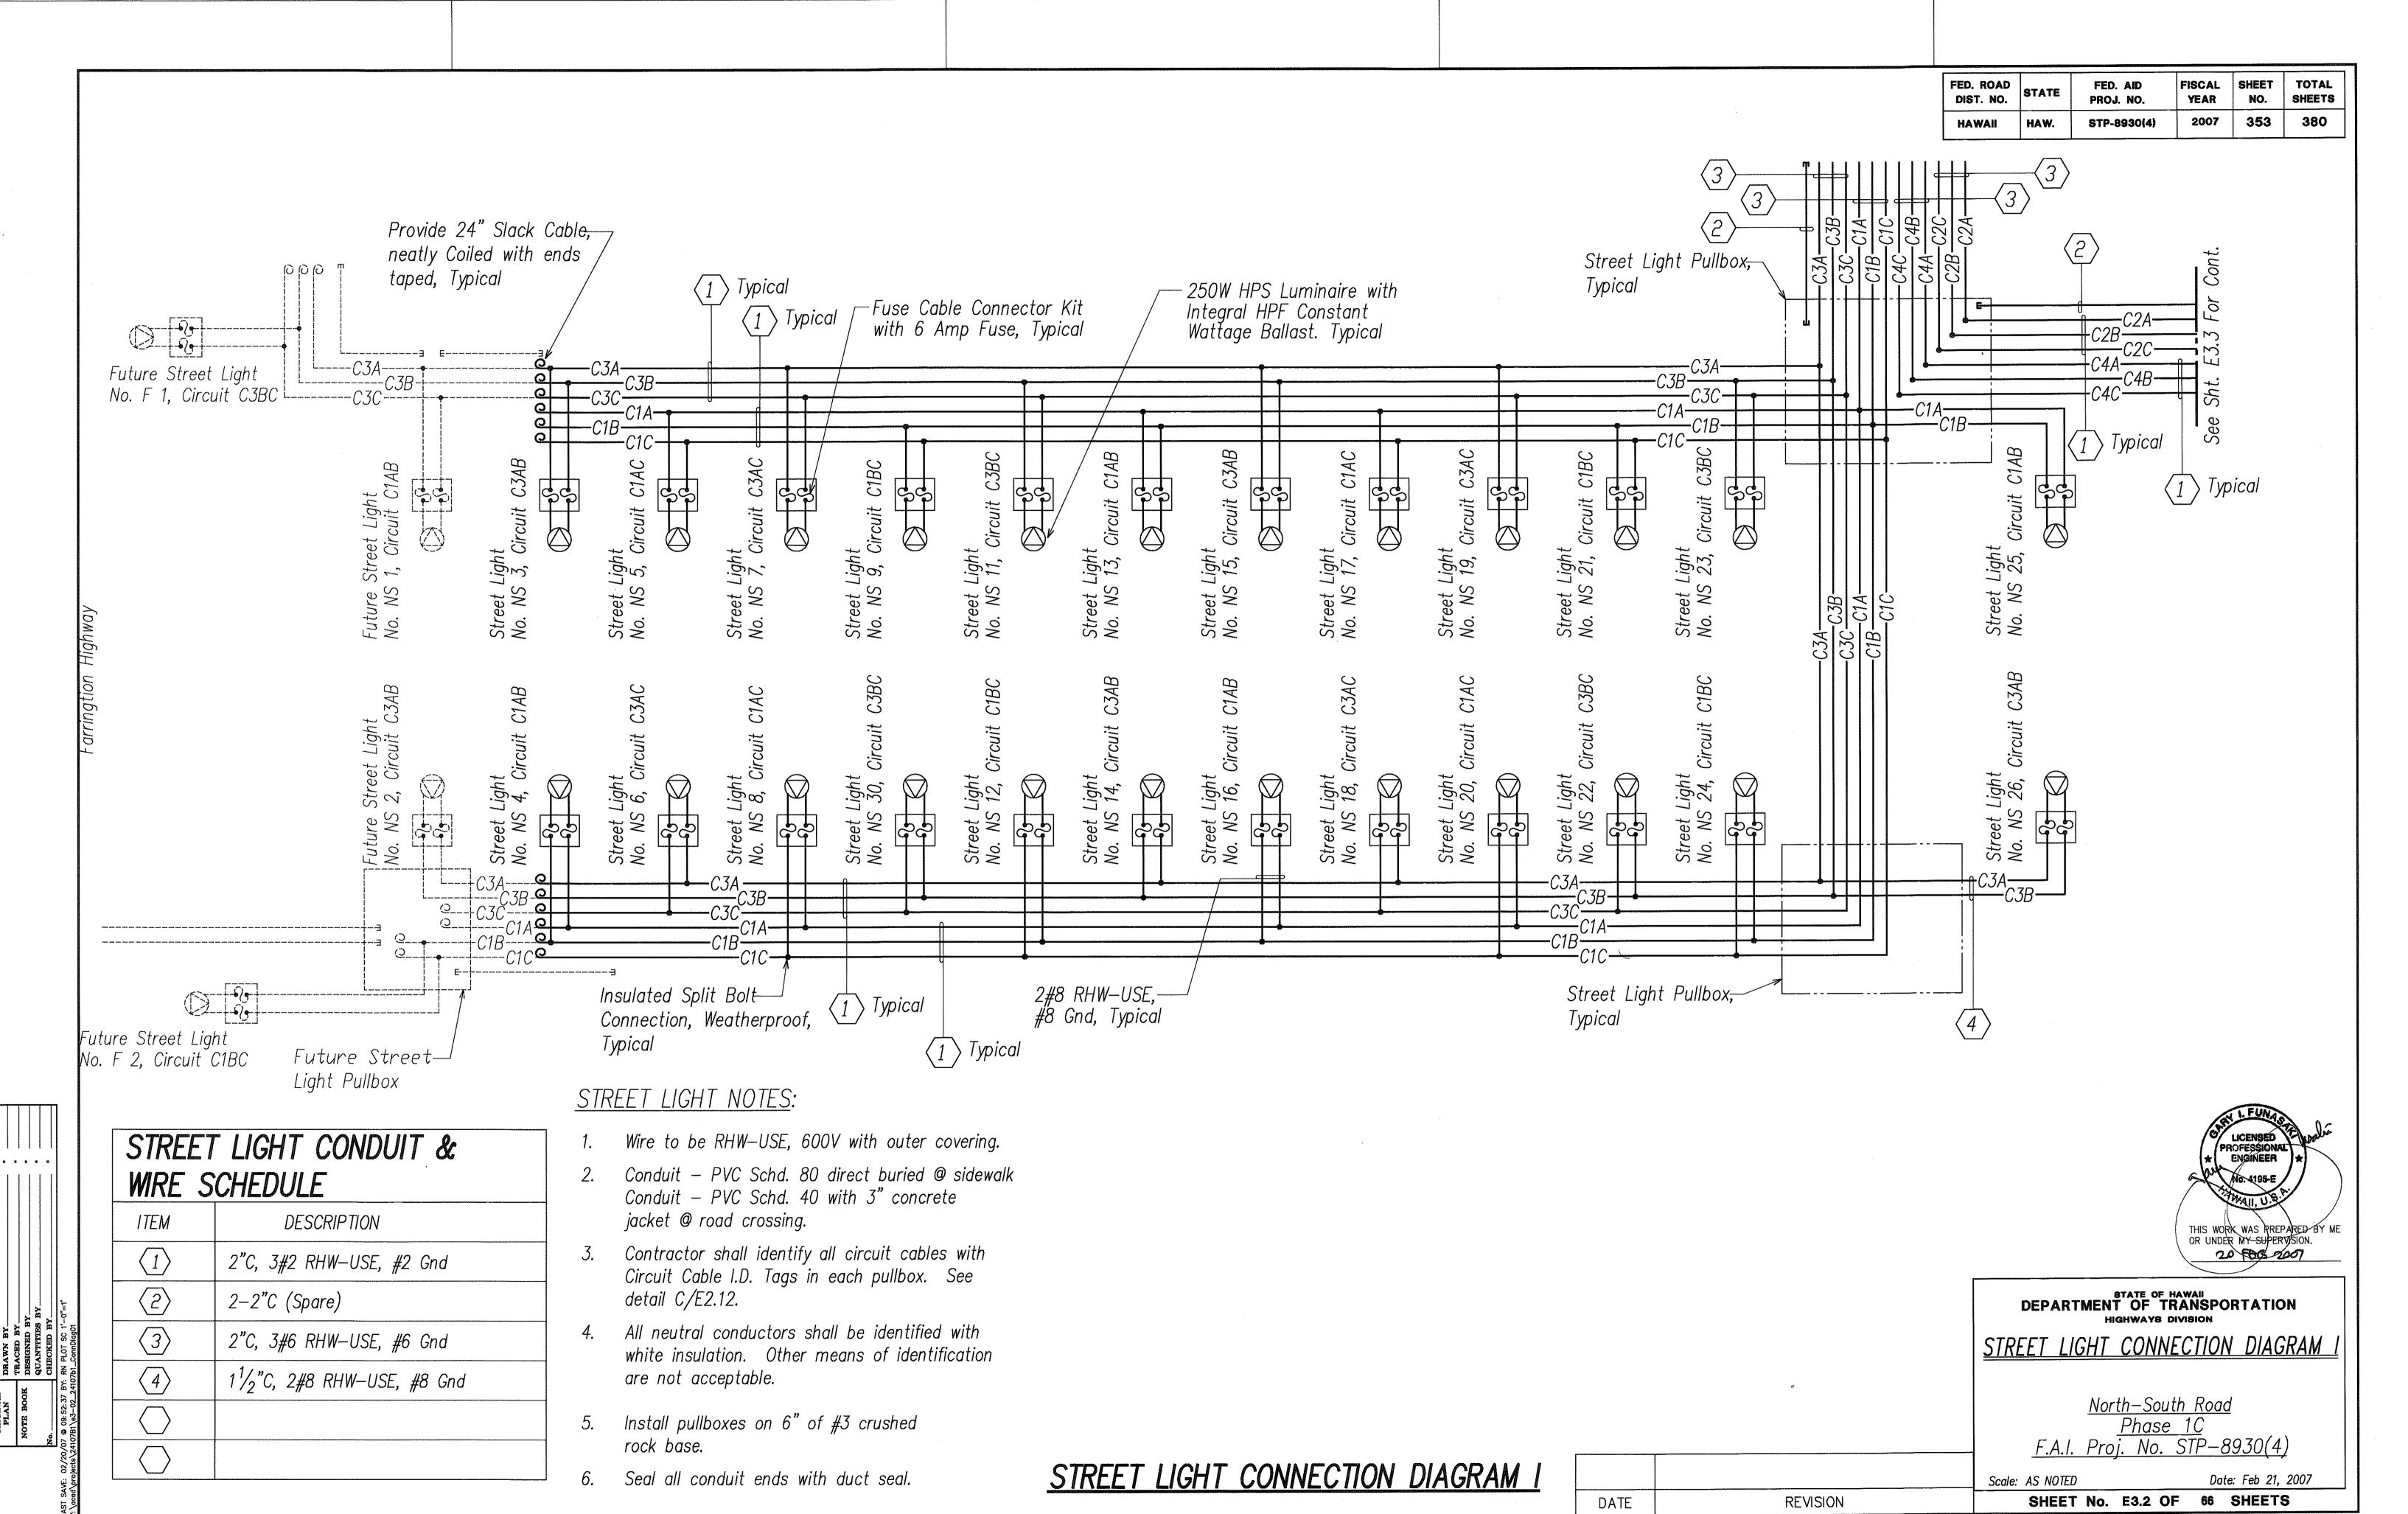

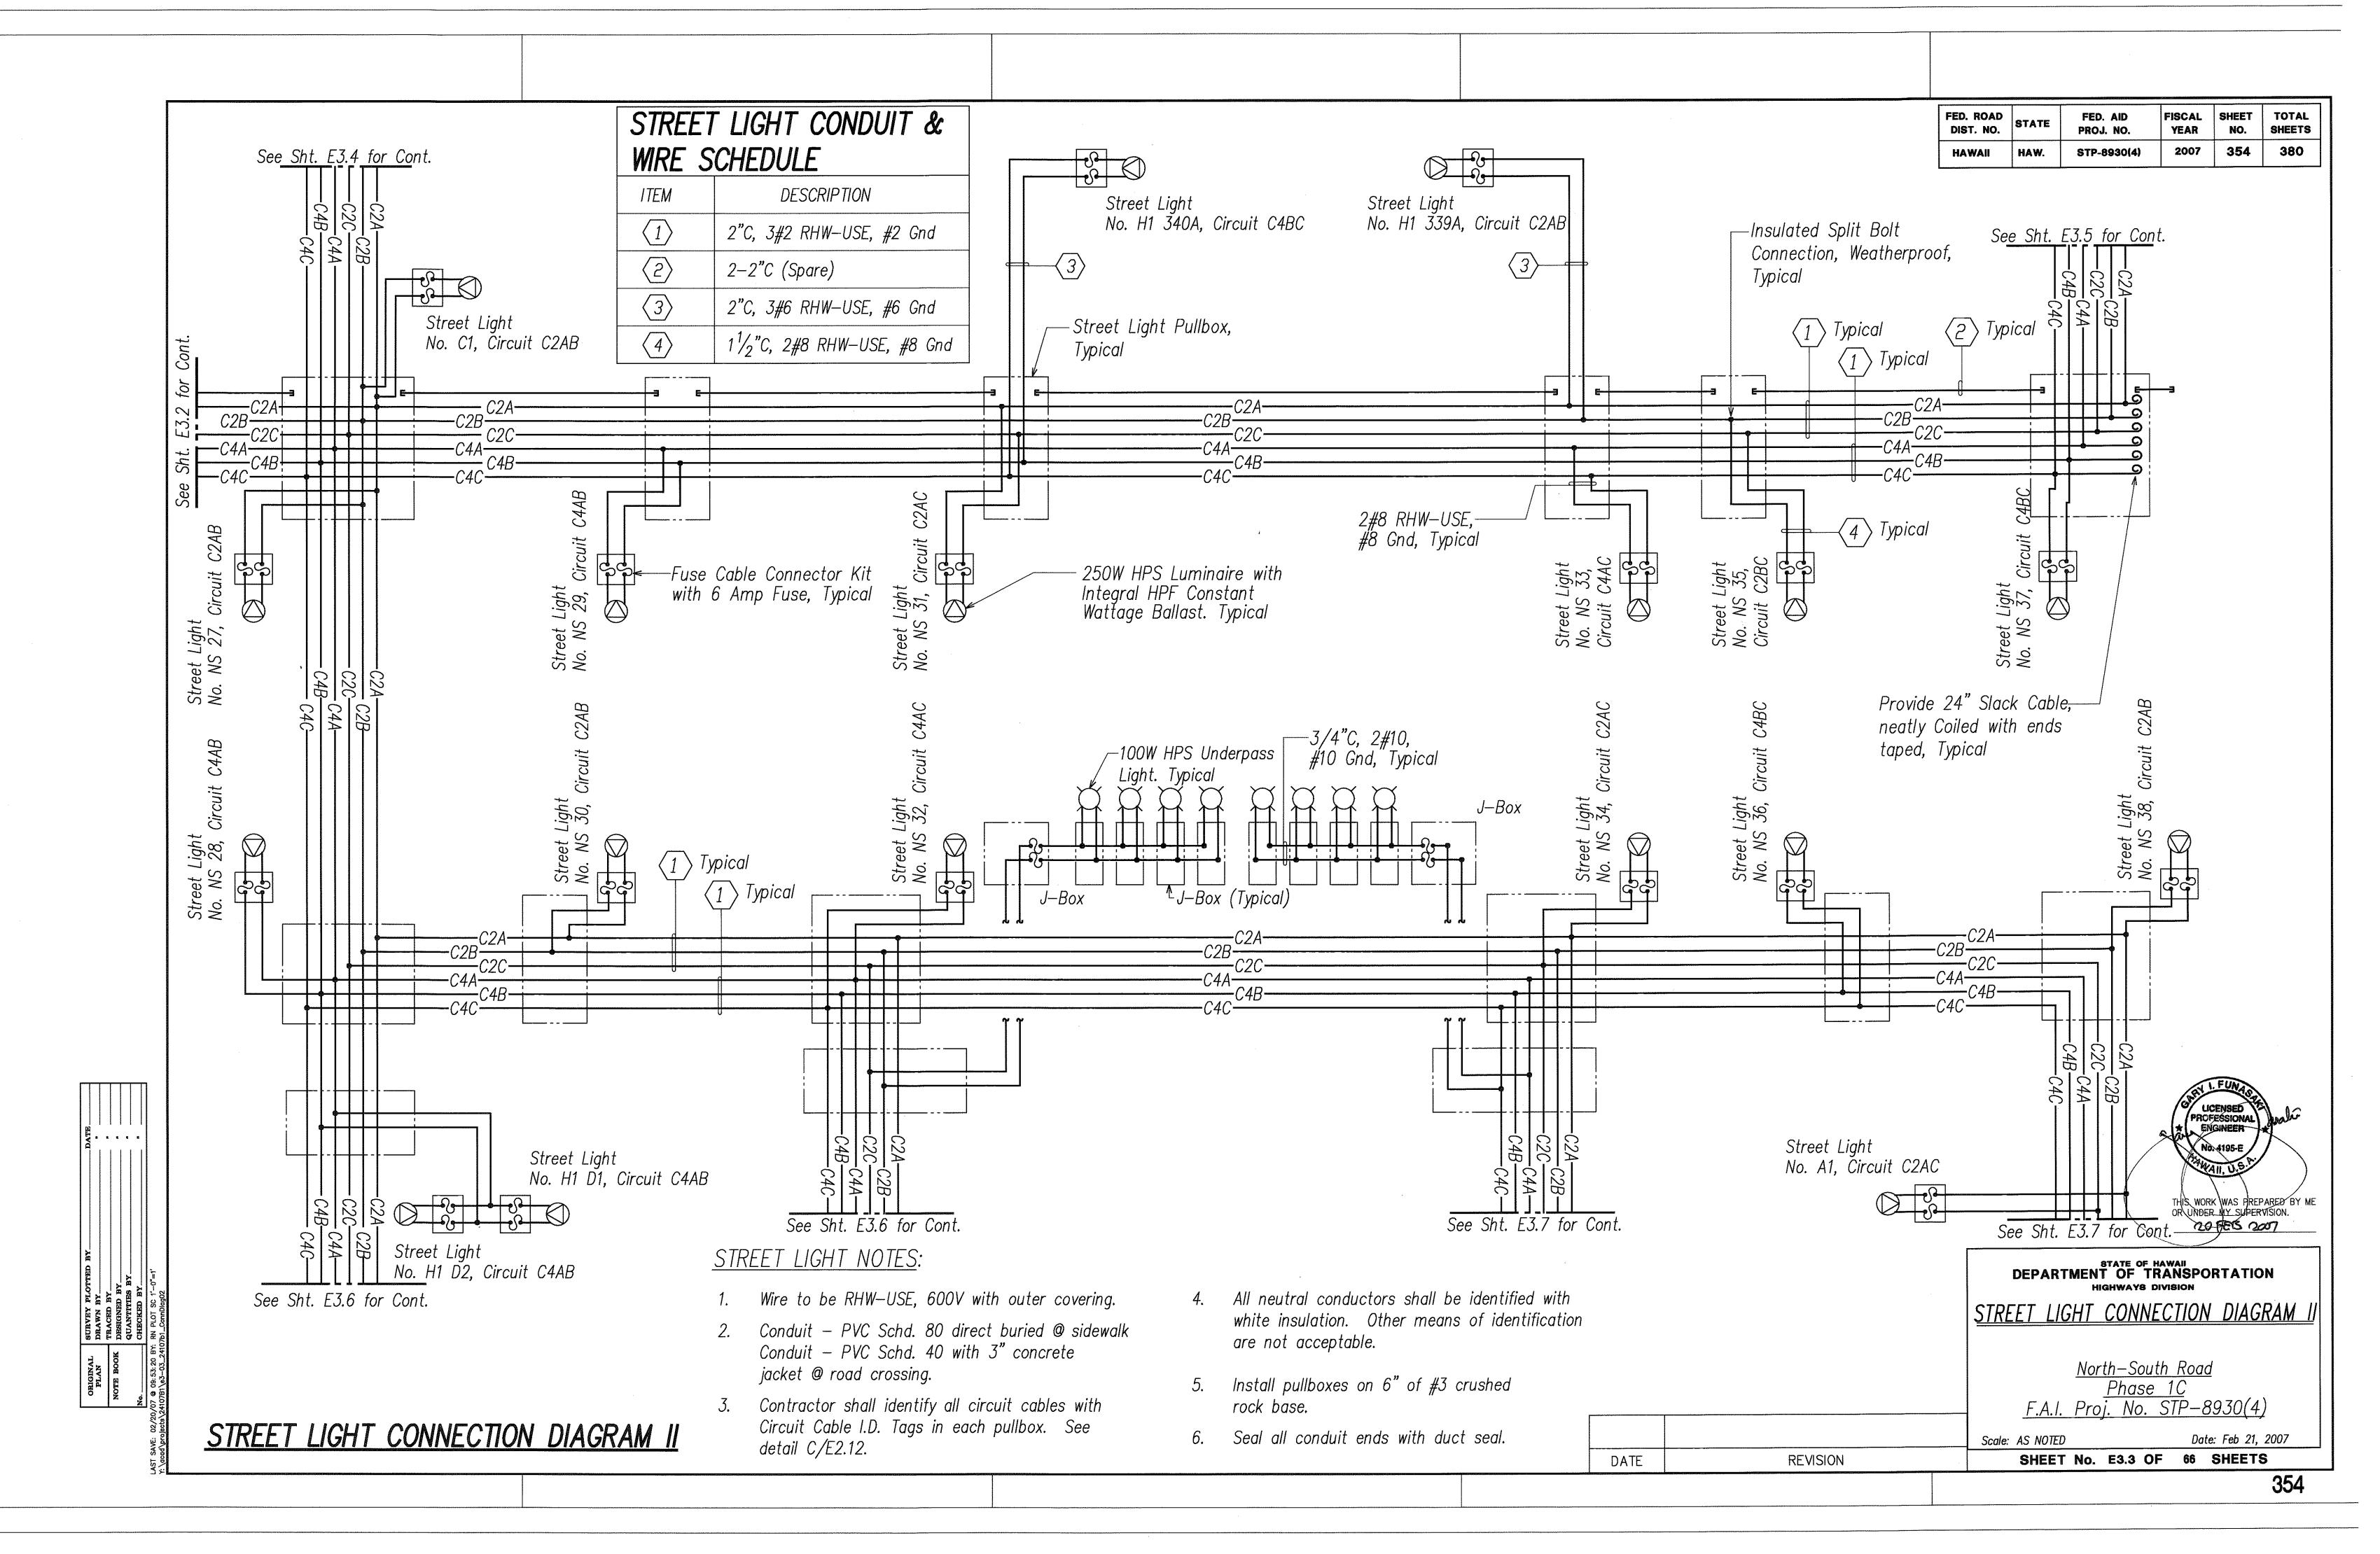

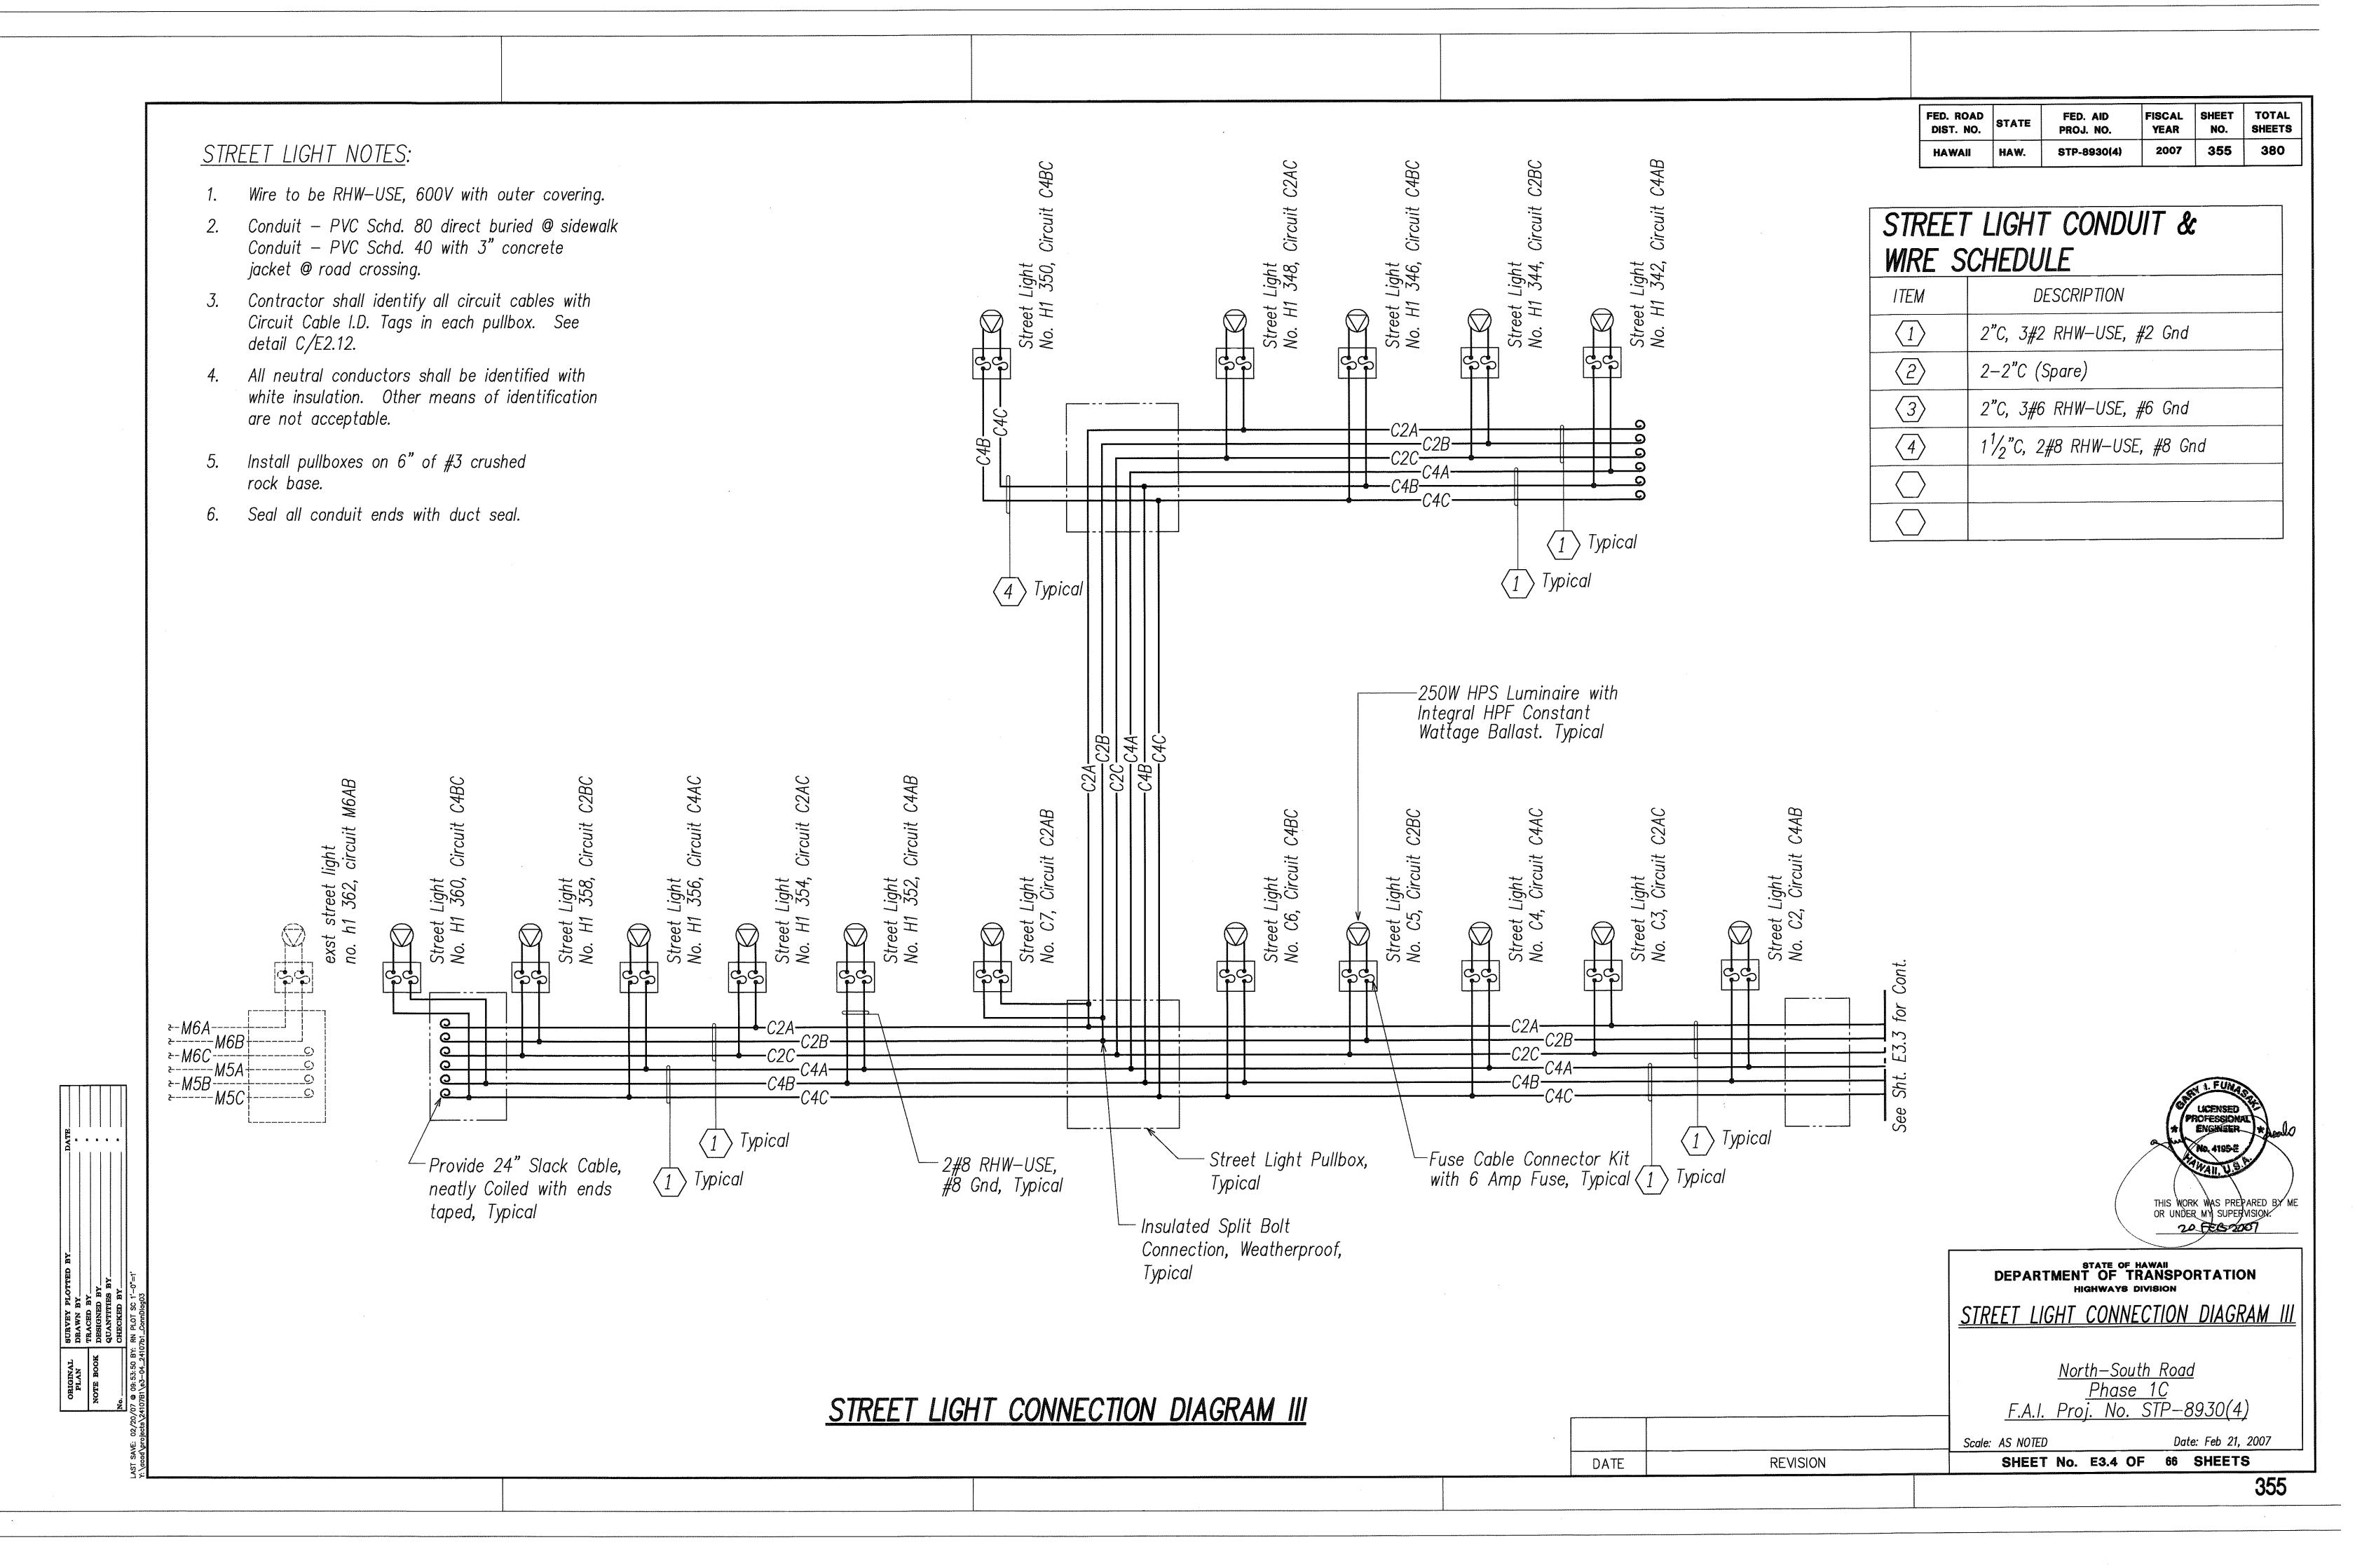

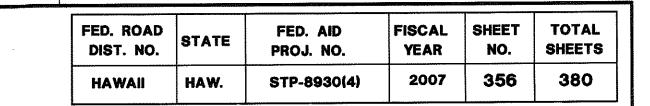


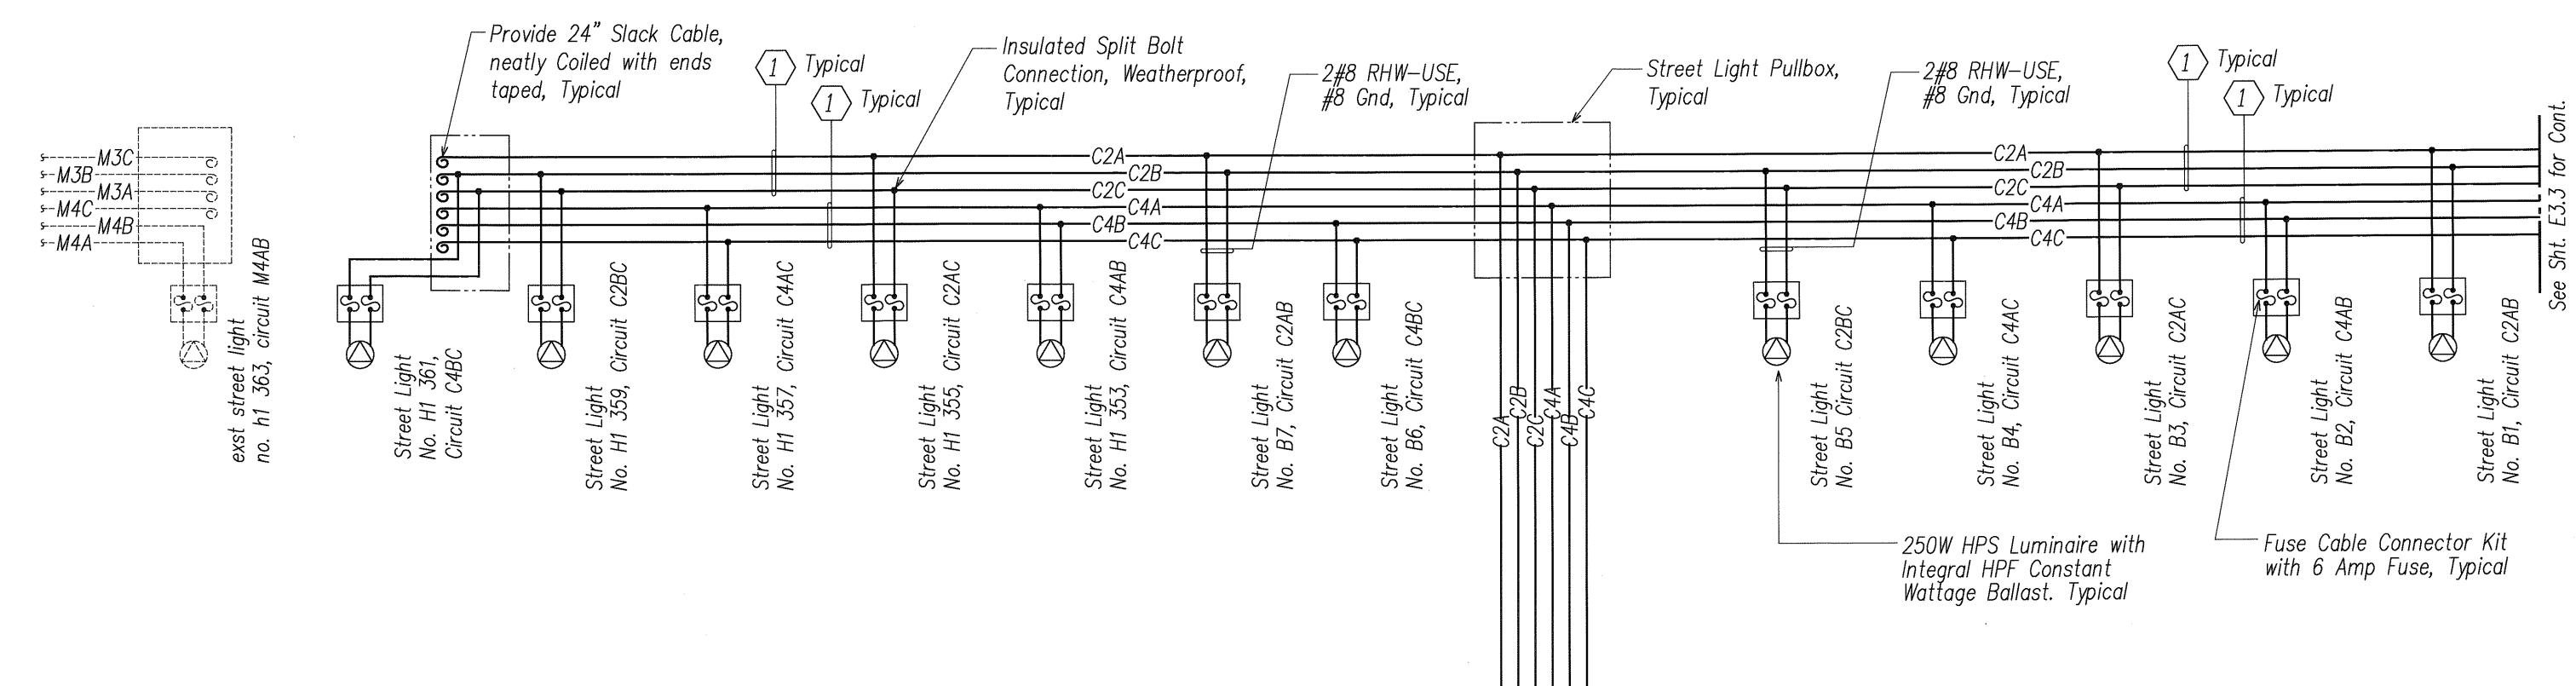


# STREET LIGHT CONDUIT & WIRE SCHEDULE ITEM DESCRIPTION 1 2"C, 3#2 RHW-USE, #2 Gnd 2 2-2"C (Spare) 3 2"C, 3#6 RHW-USE, #6 Gnd 4 1½"C, 2#8 RHW-USE, #8 Gnd □ □

#### STREET LIGHT NOTES:

- 1. Wire to be RHW-USE, 600V with outer covering.
- 2. Conduit PVC Schd. 80 direct buried @ sidewalk Conduit — PVC Schd. 40 with 3" concrete jacket @ road crossing.
- 3. Contractor shall identify all circuit cables with Circuit Cable I.D. Tags in each pullbox. See detail C/E2.12.
- 4. All neutral conductors shall be identified with white insulation. Other means of identification are not acceptable.
- 5. Install pullboxes on 6" of #3 crushed rock base.
- 6. Seal all conduit ends with duct seal.

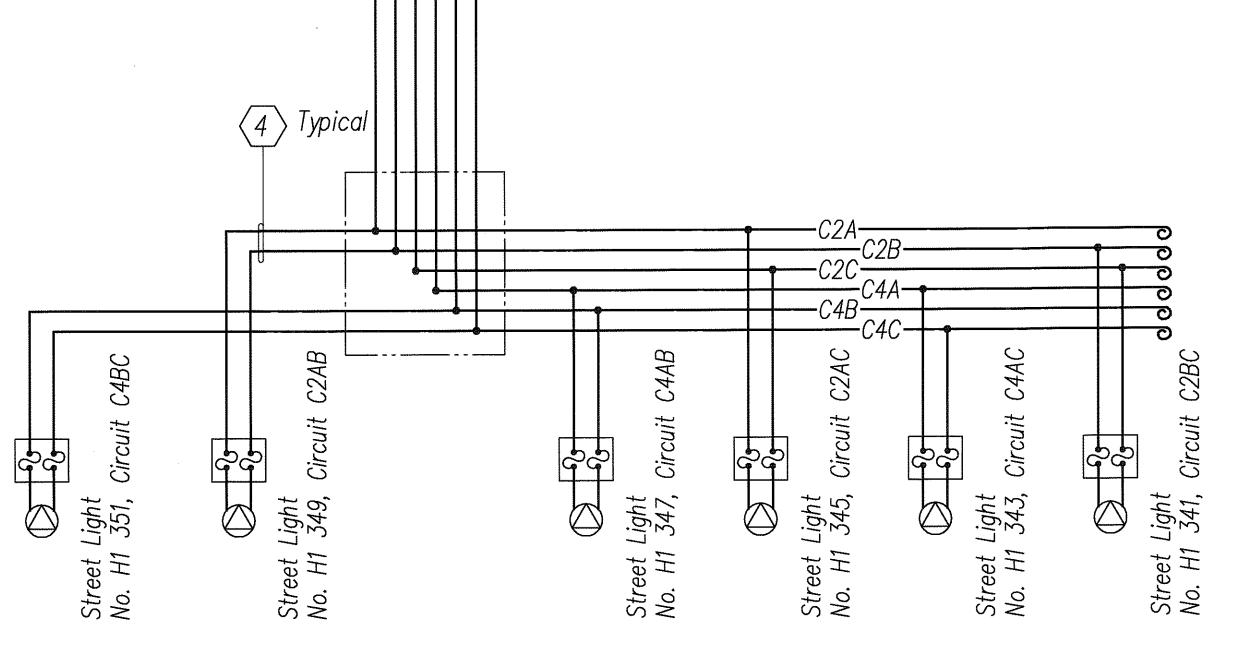

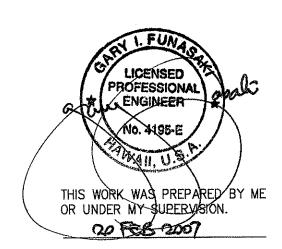

STREET LIGHT CONNECTION DIAGRAM IV

DEPARTMENT OF TRANSPORTATION
HIGHWAYS DIVISION

STREET LIGHT CONNECTION DIAGRAM IV

North—South Road
Phase 1C
F.A.I. Proj. No. STP—8930(4)


Scale: AS NOTED


Date: Feb 21, 2007


DATE REVISION


SHEET No. E3.5 OF 66 SHEETS


BOOK DESIGNED BY QUANTITIES BY CHECKED BY

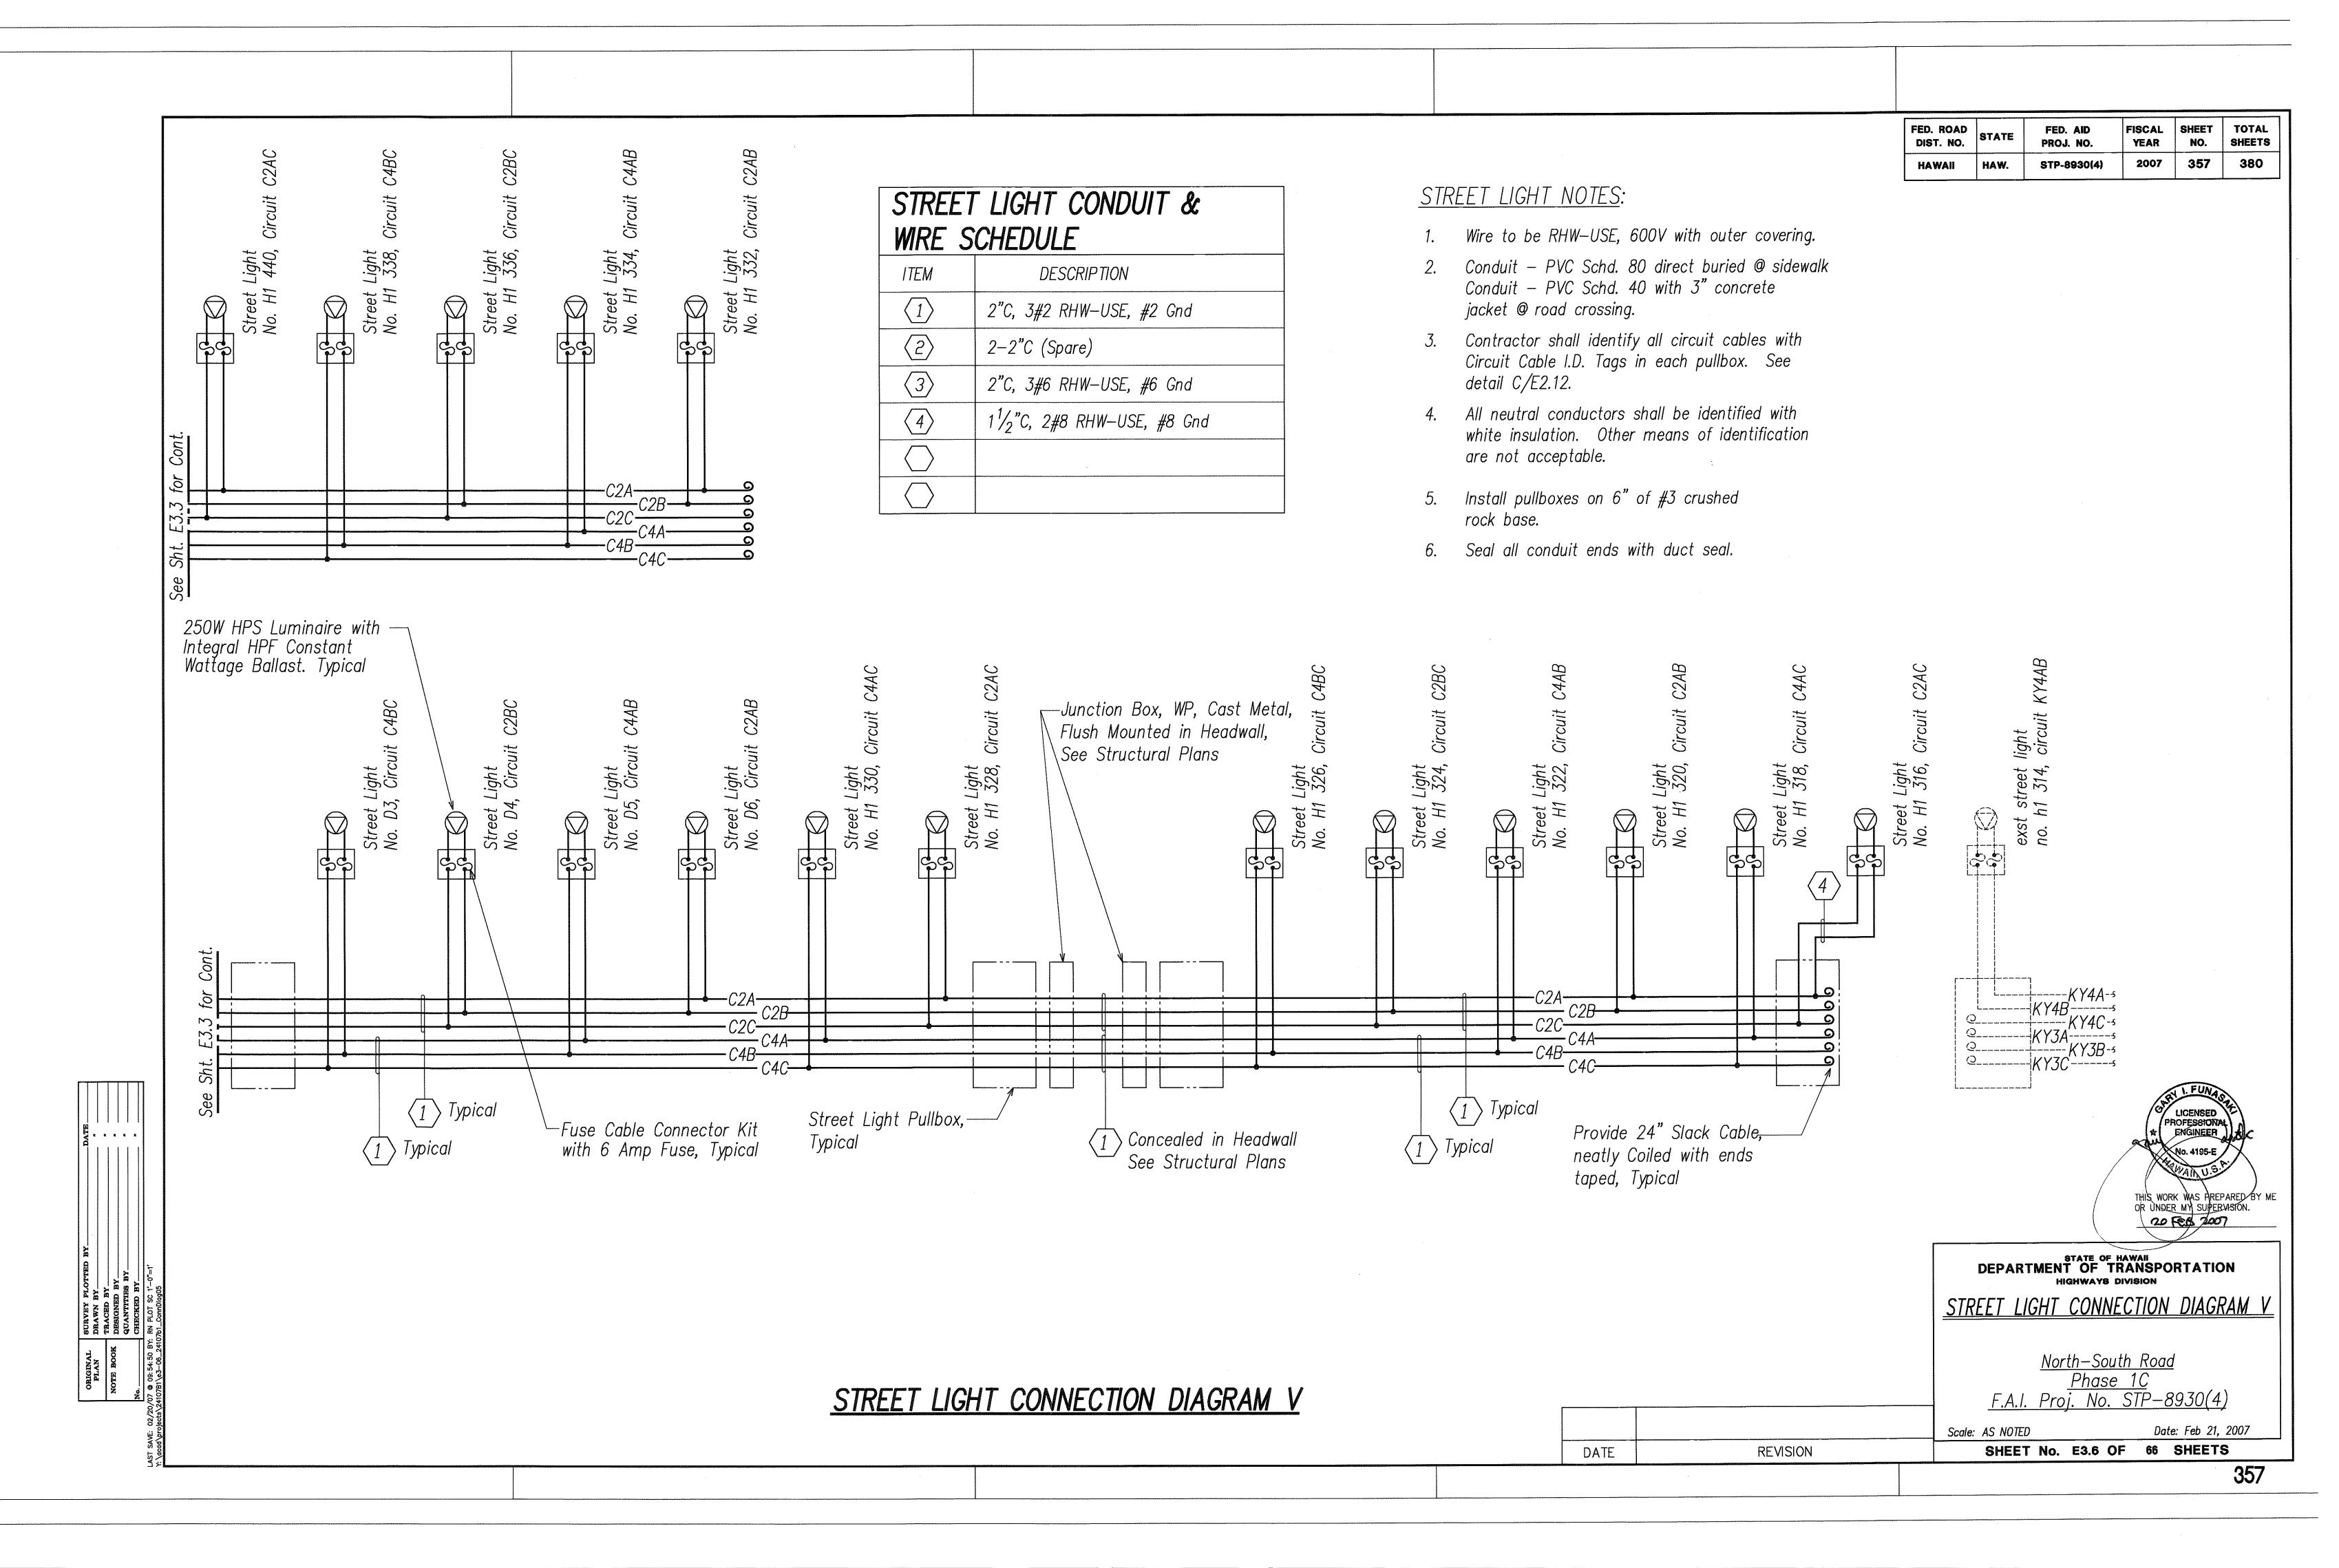


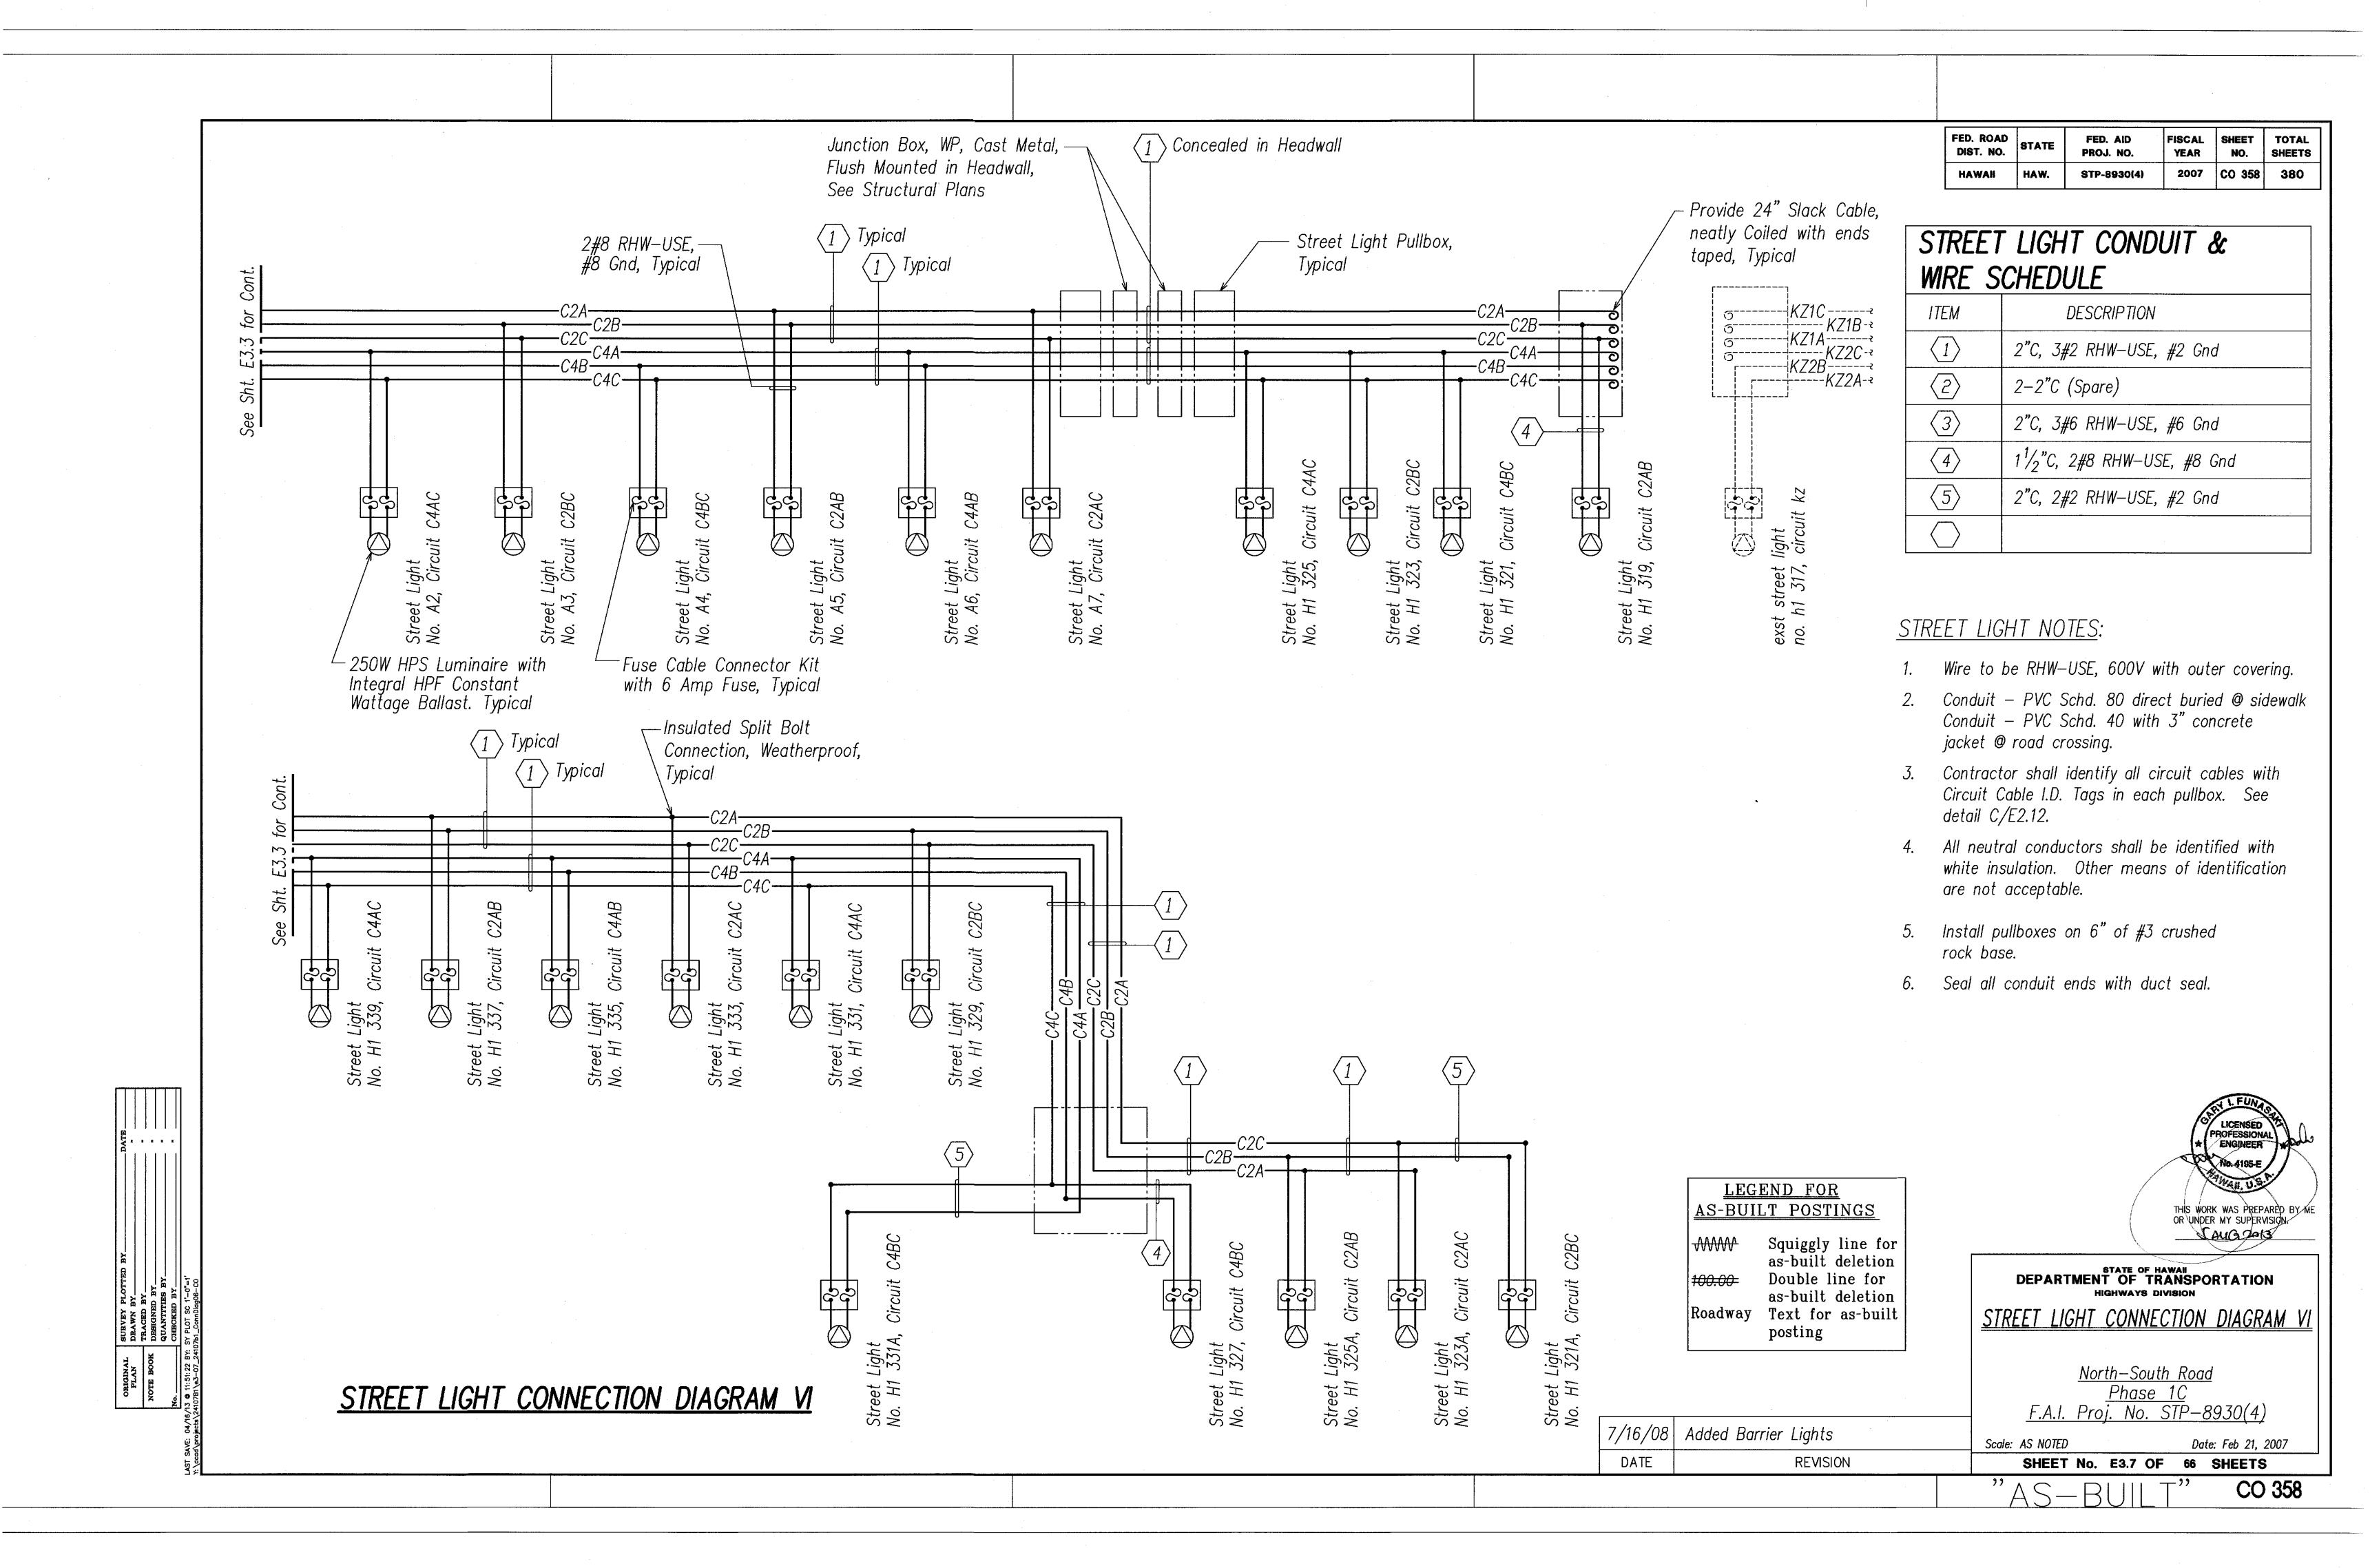


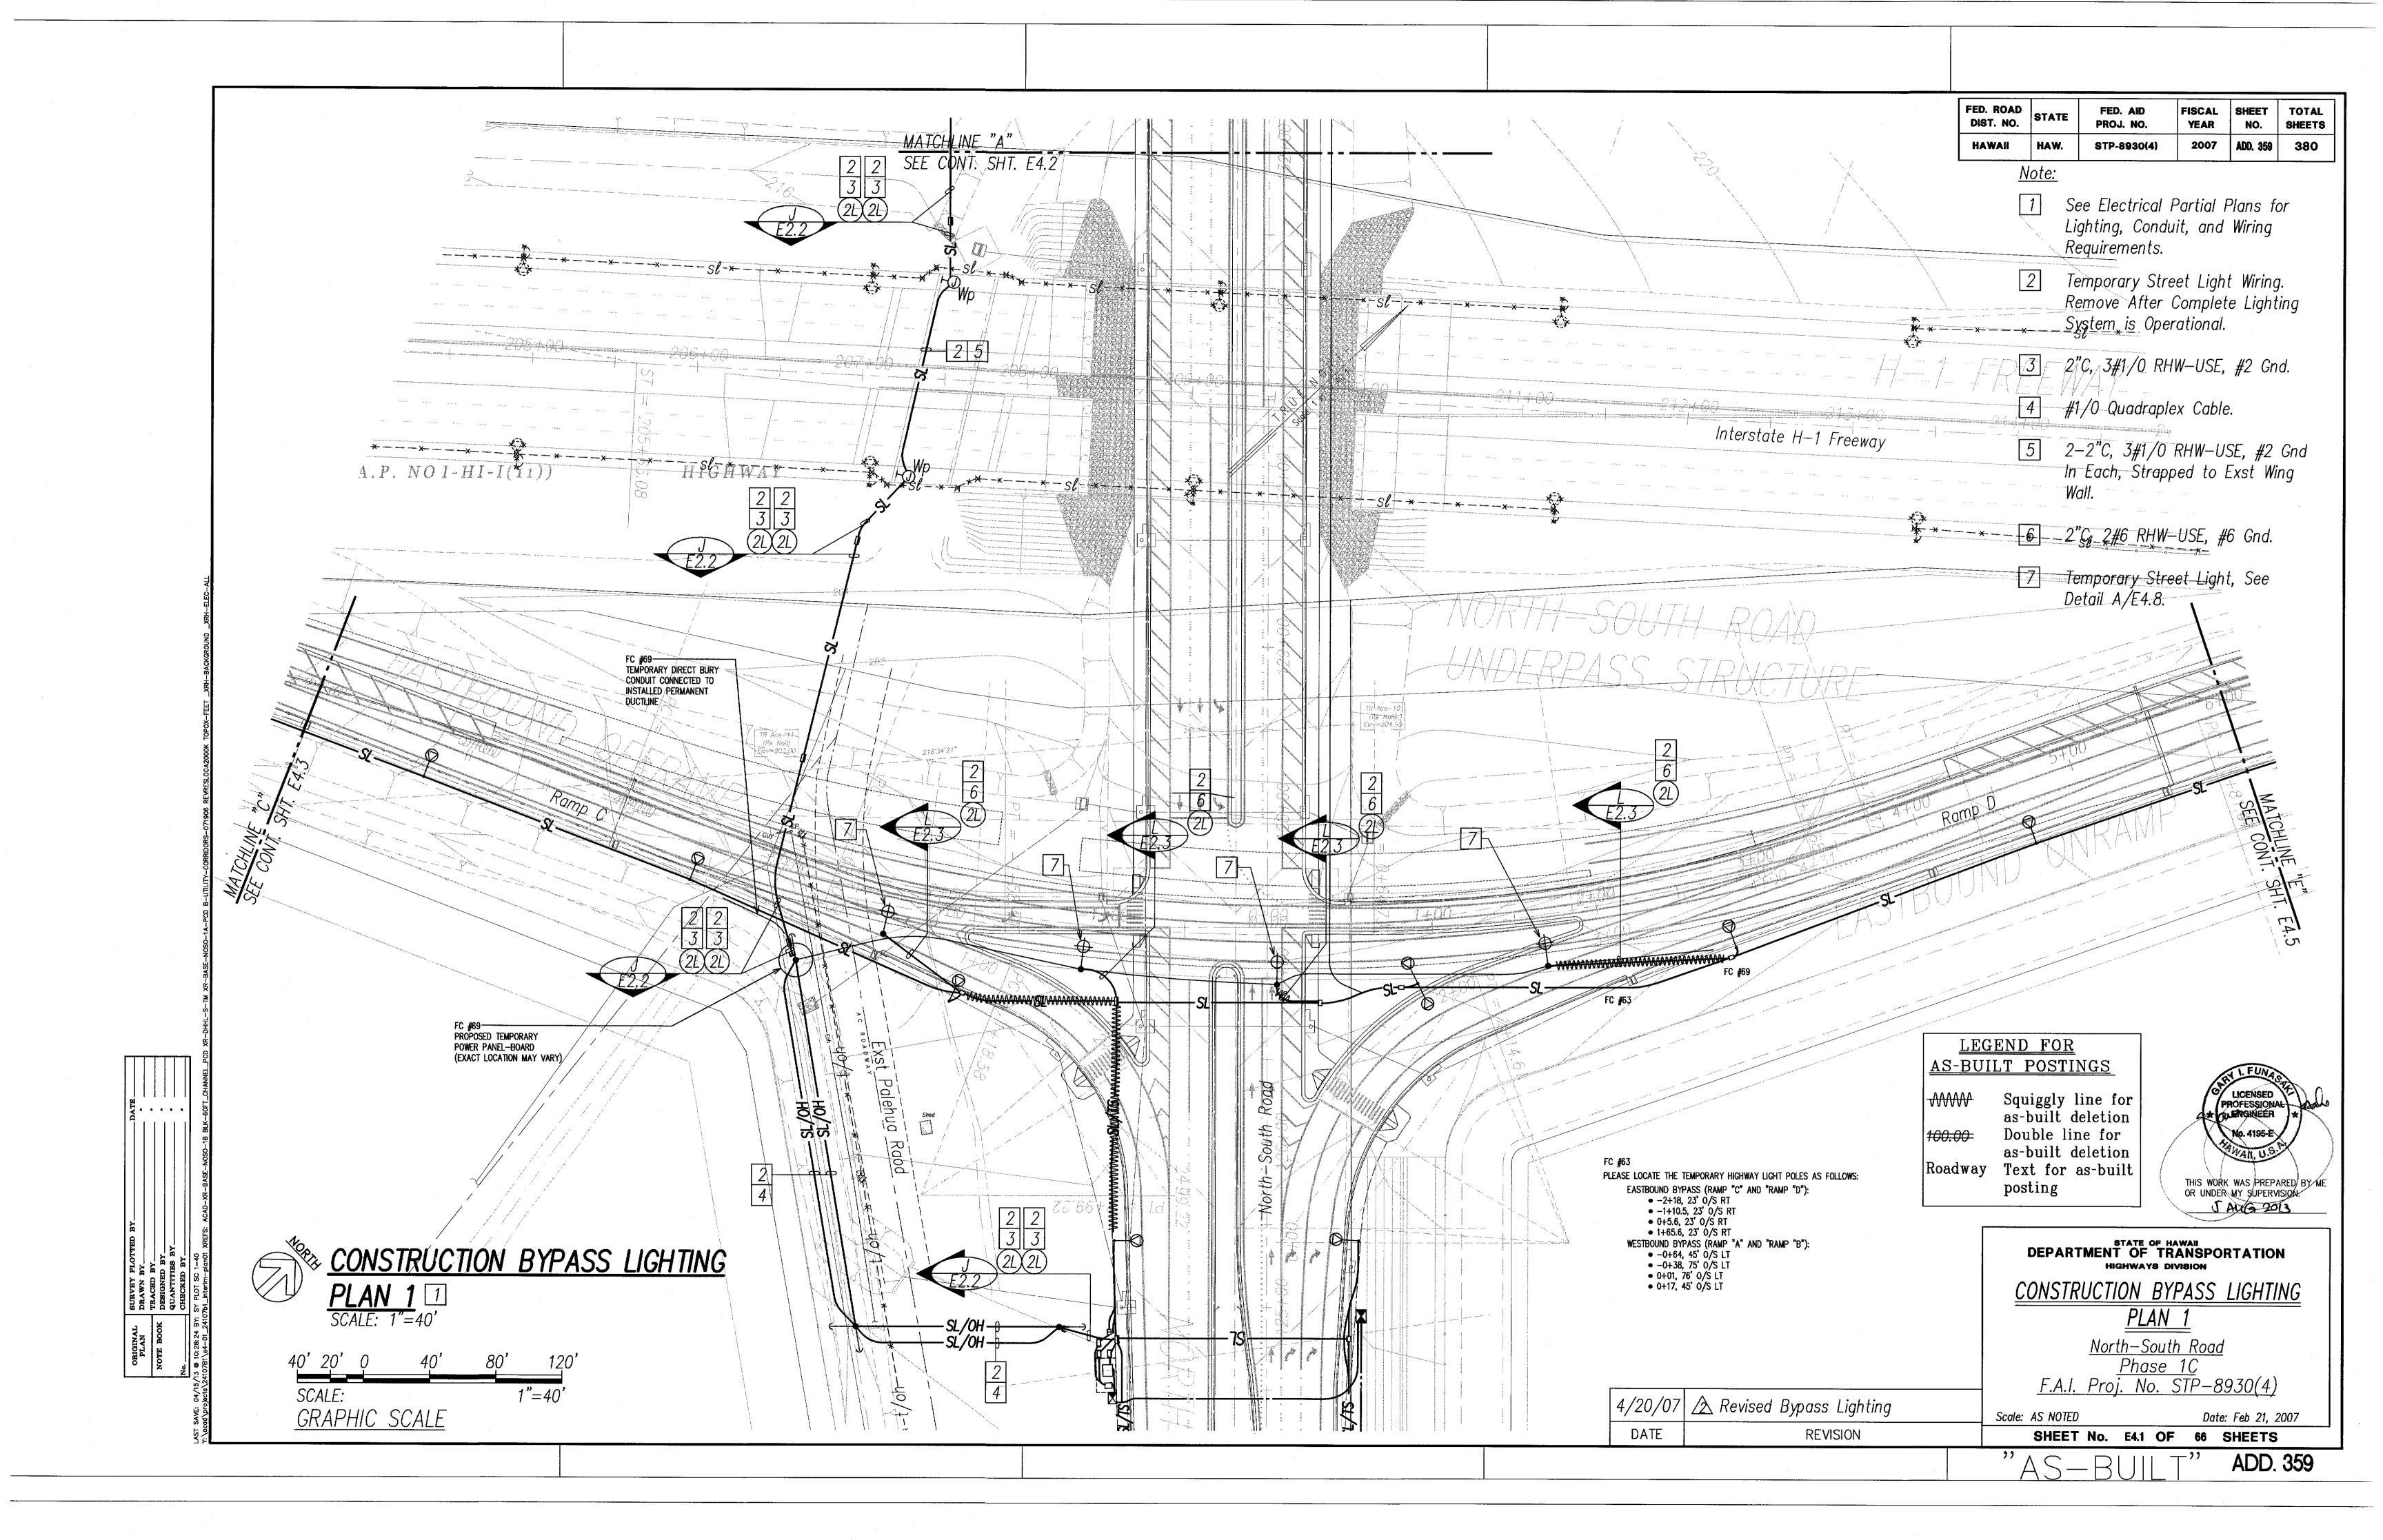


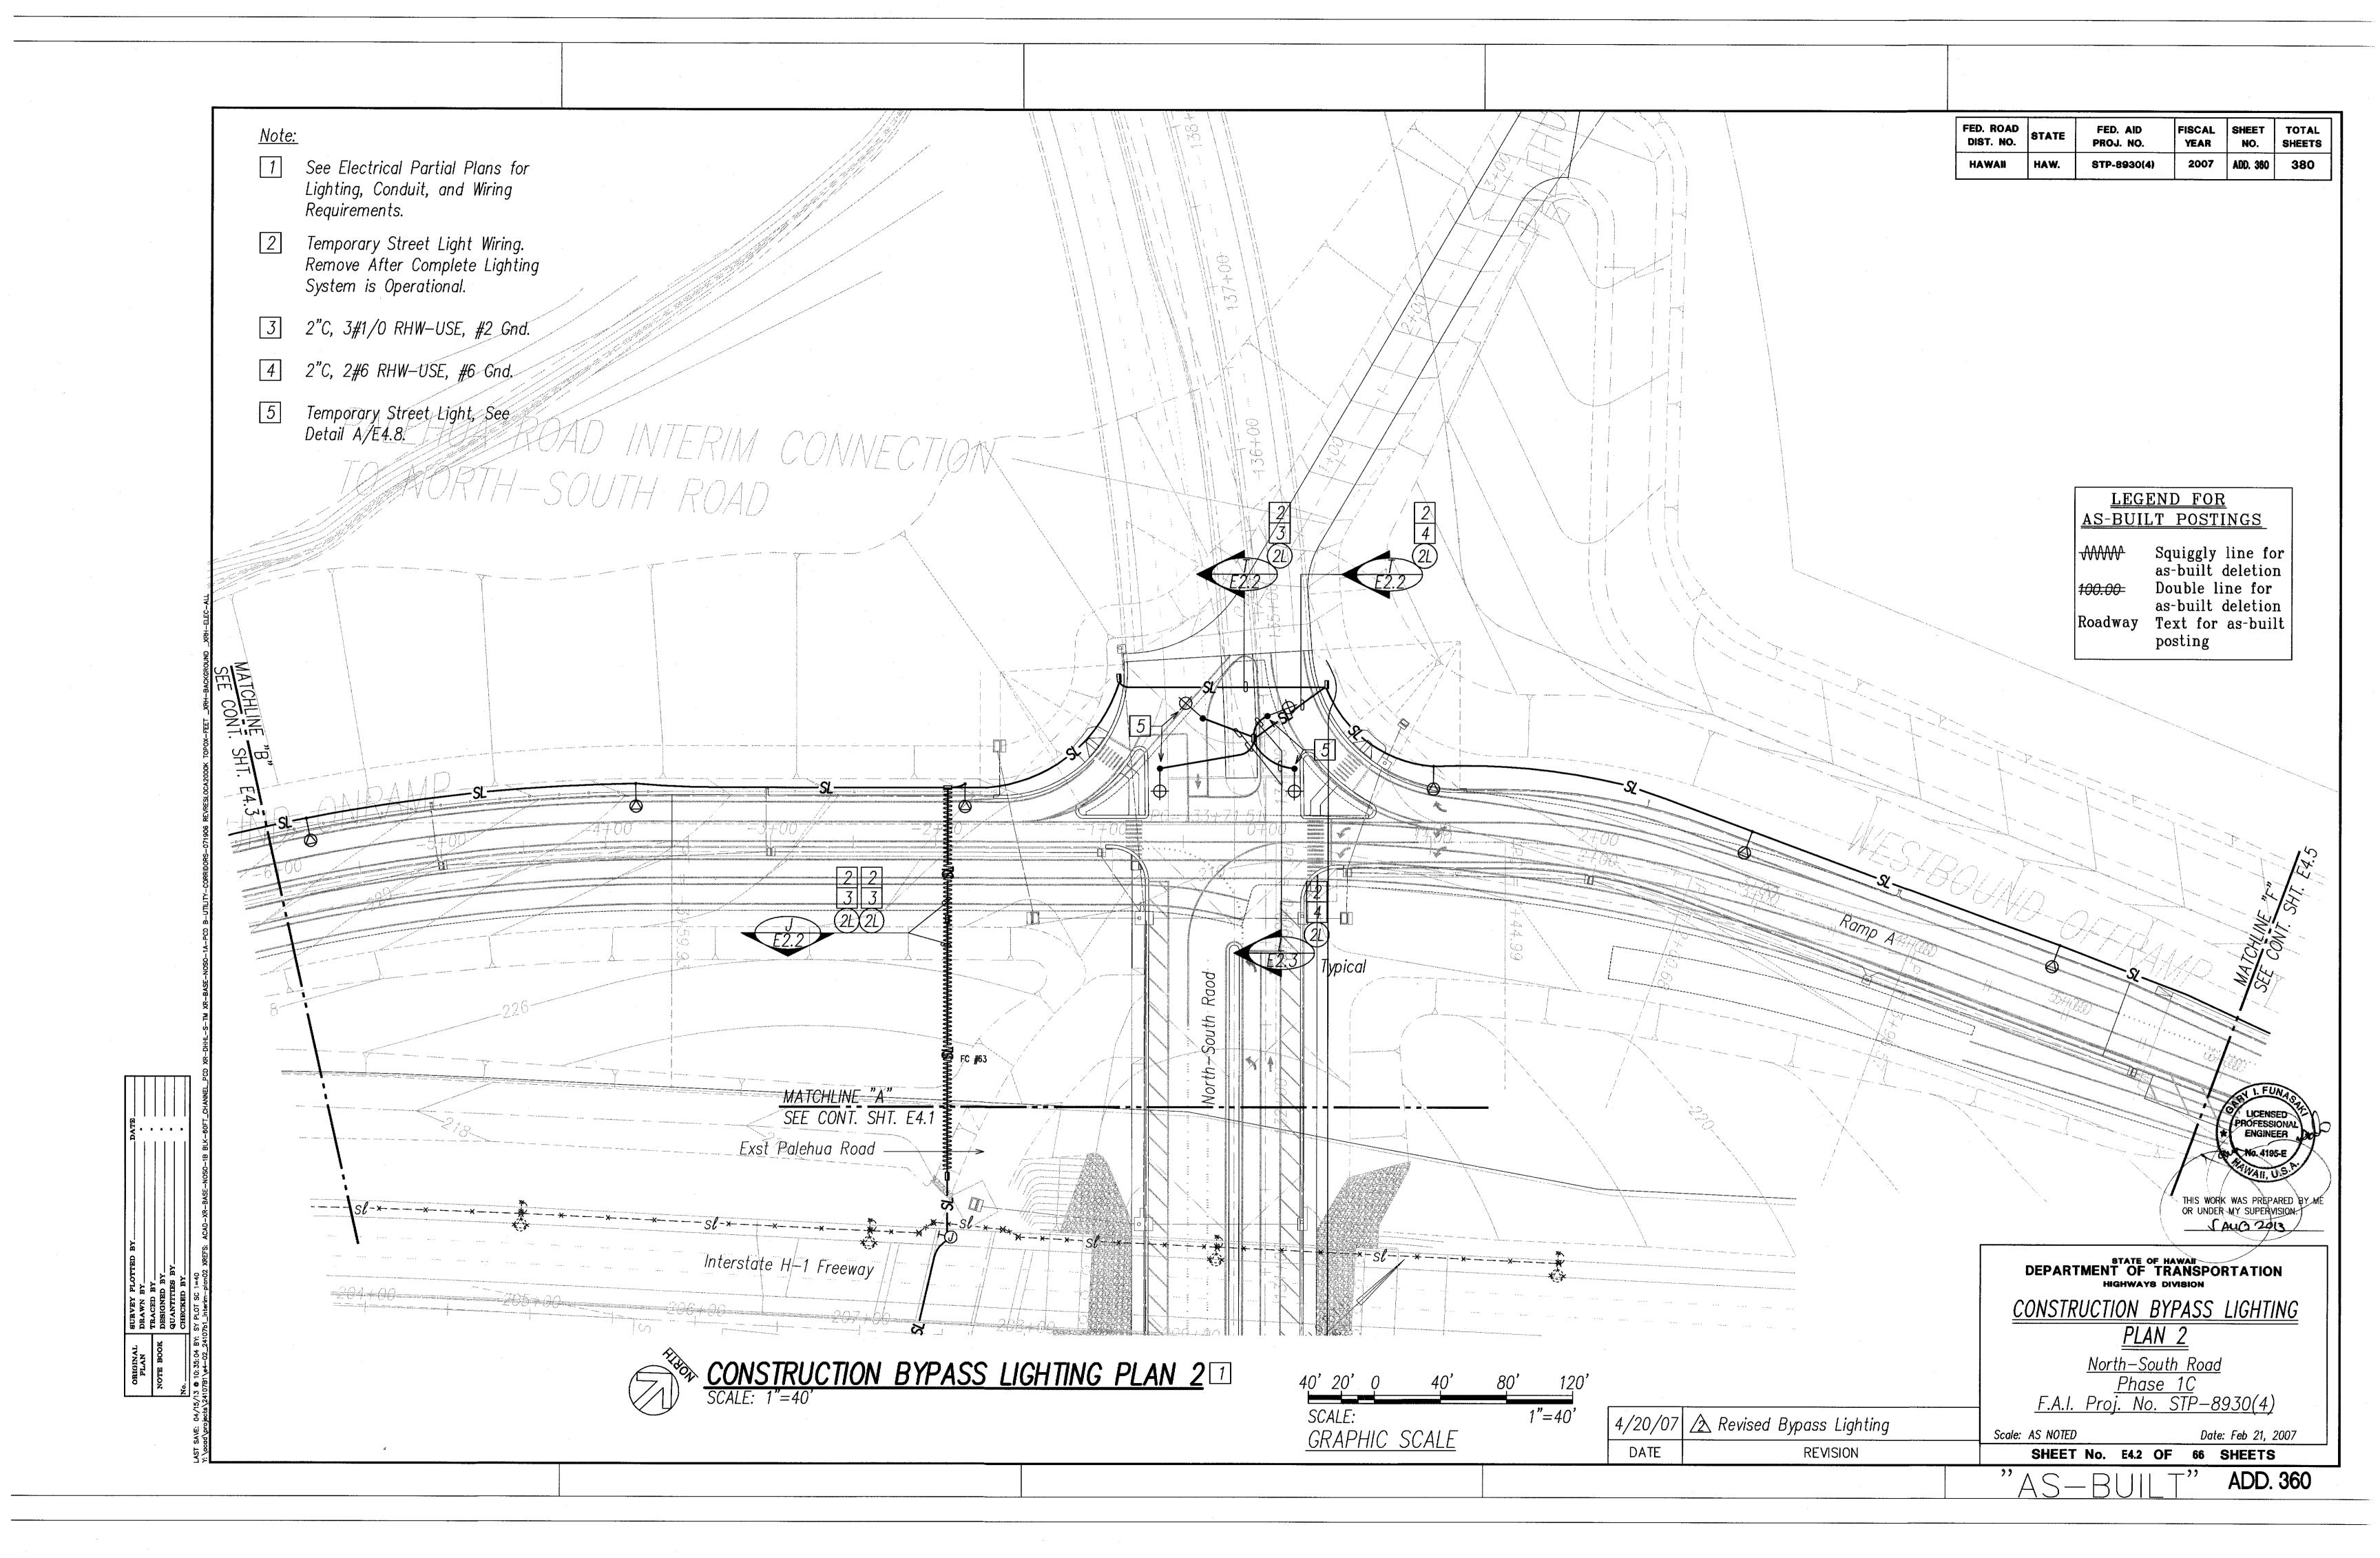


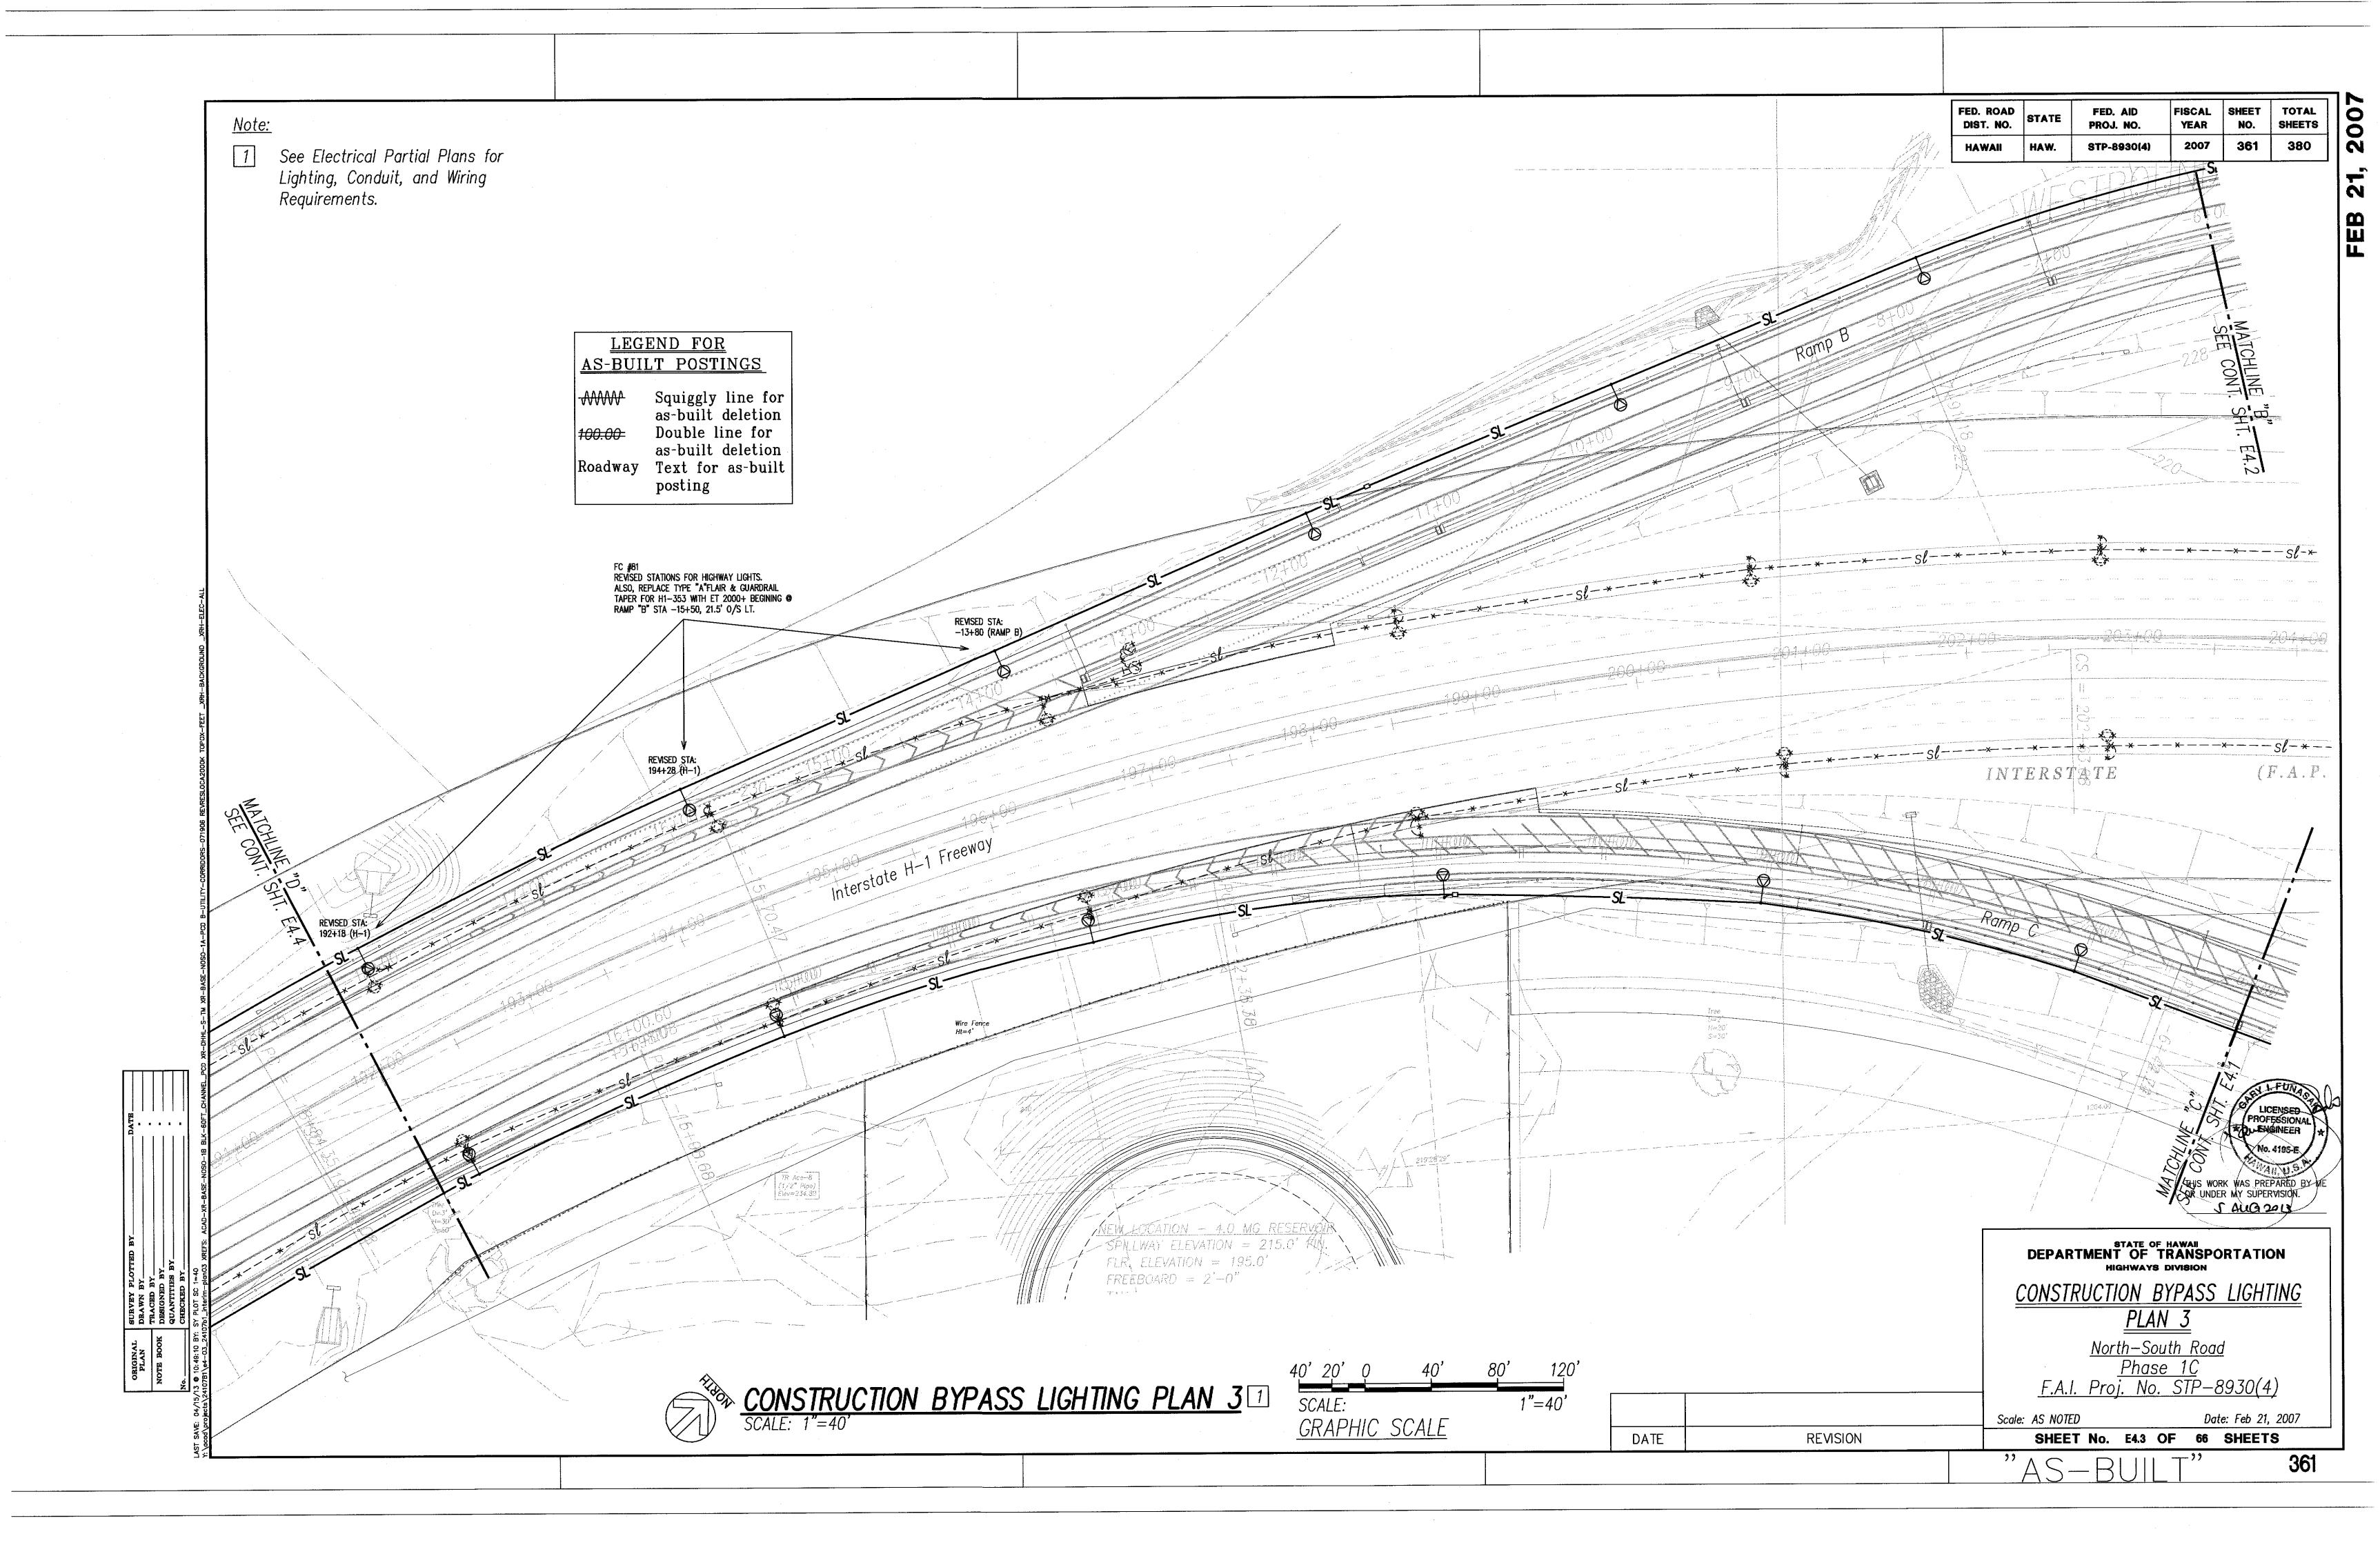

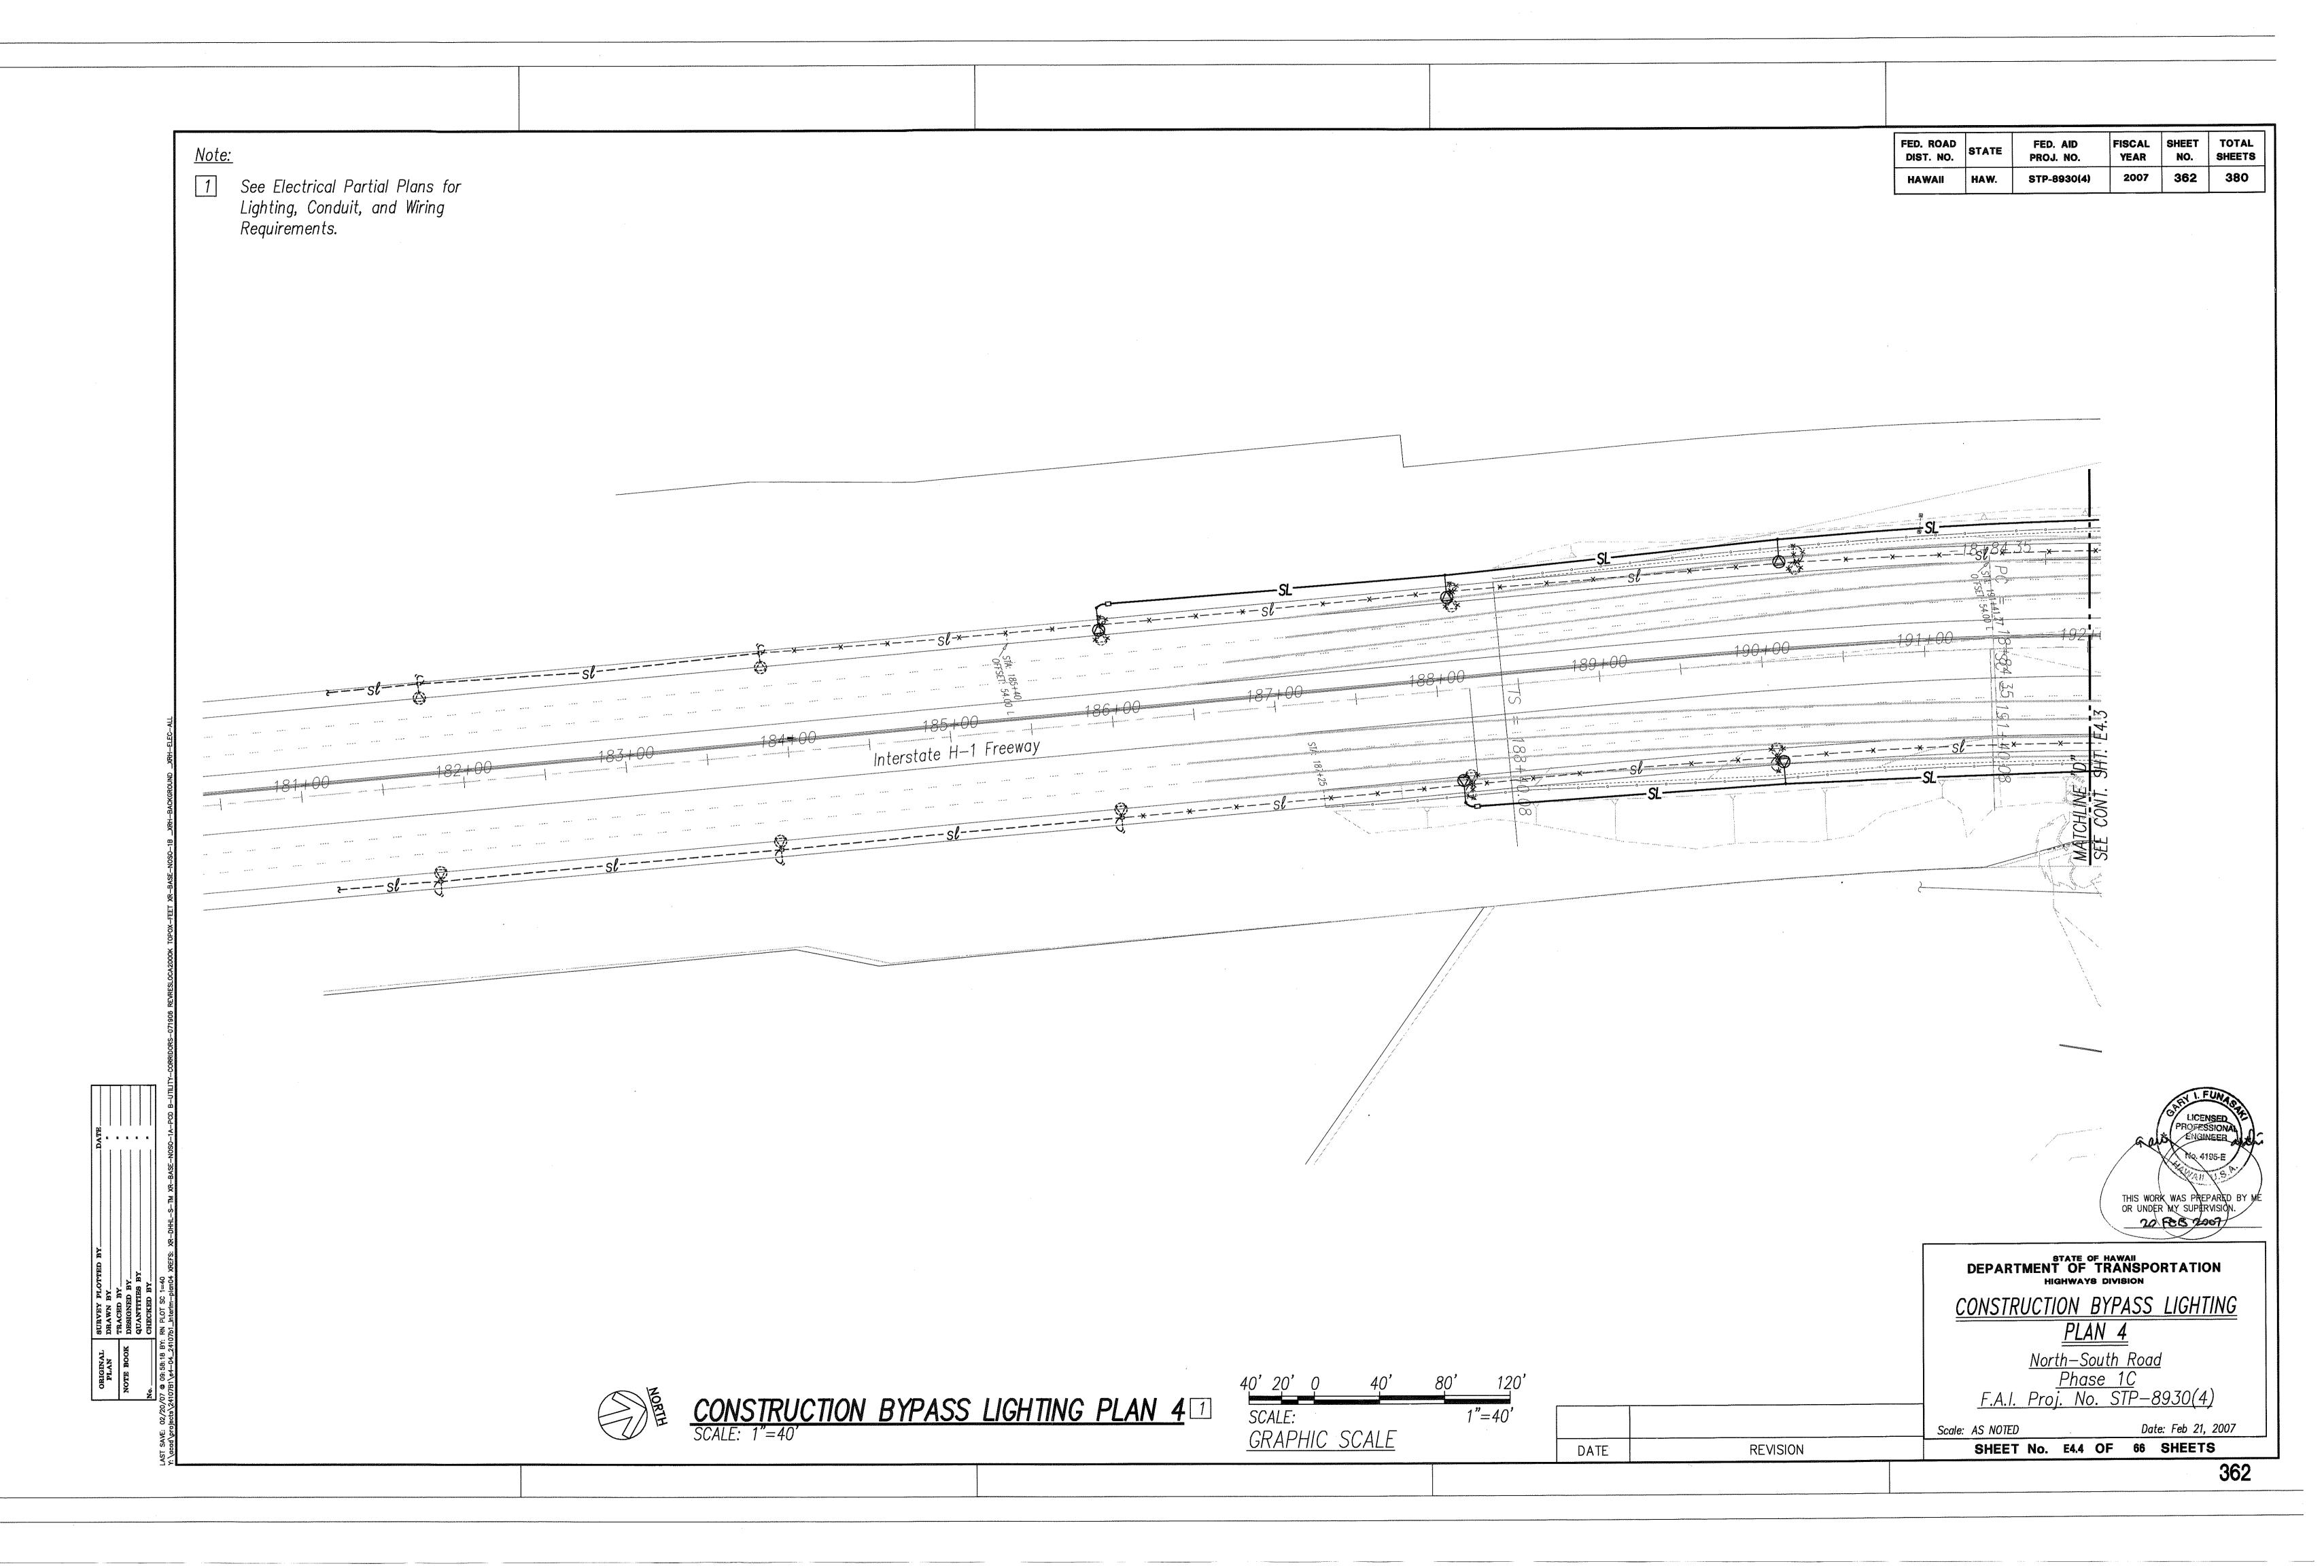

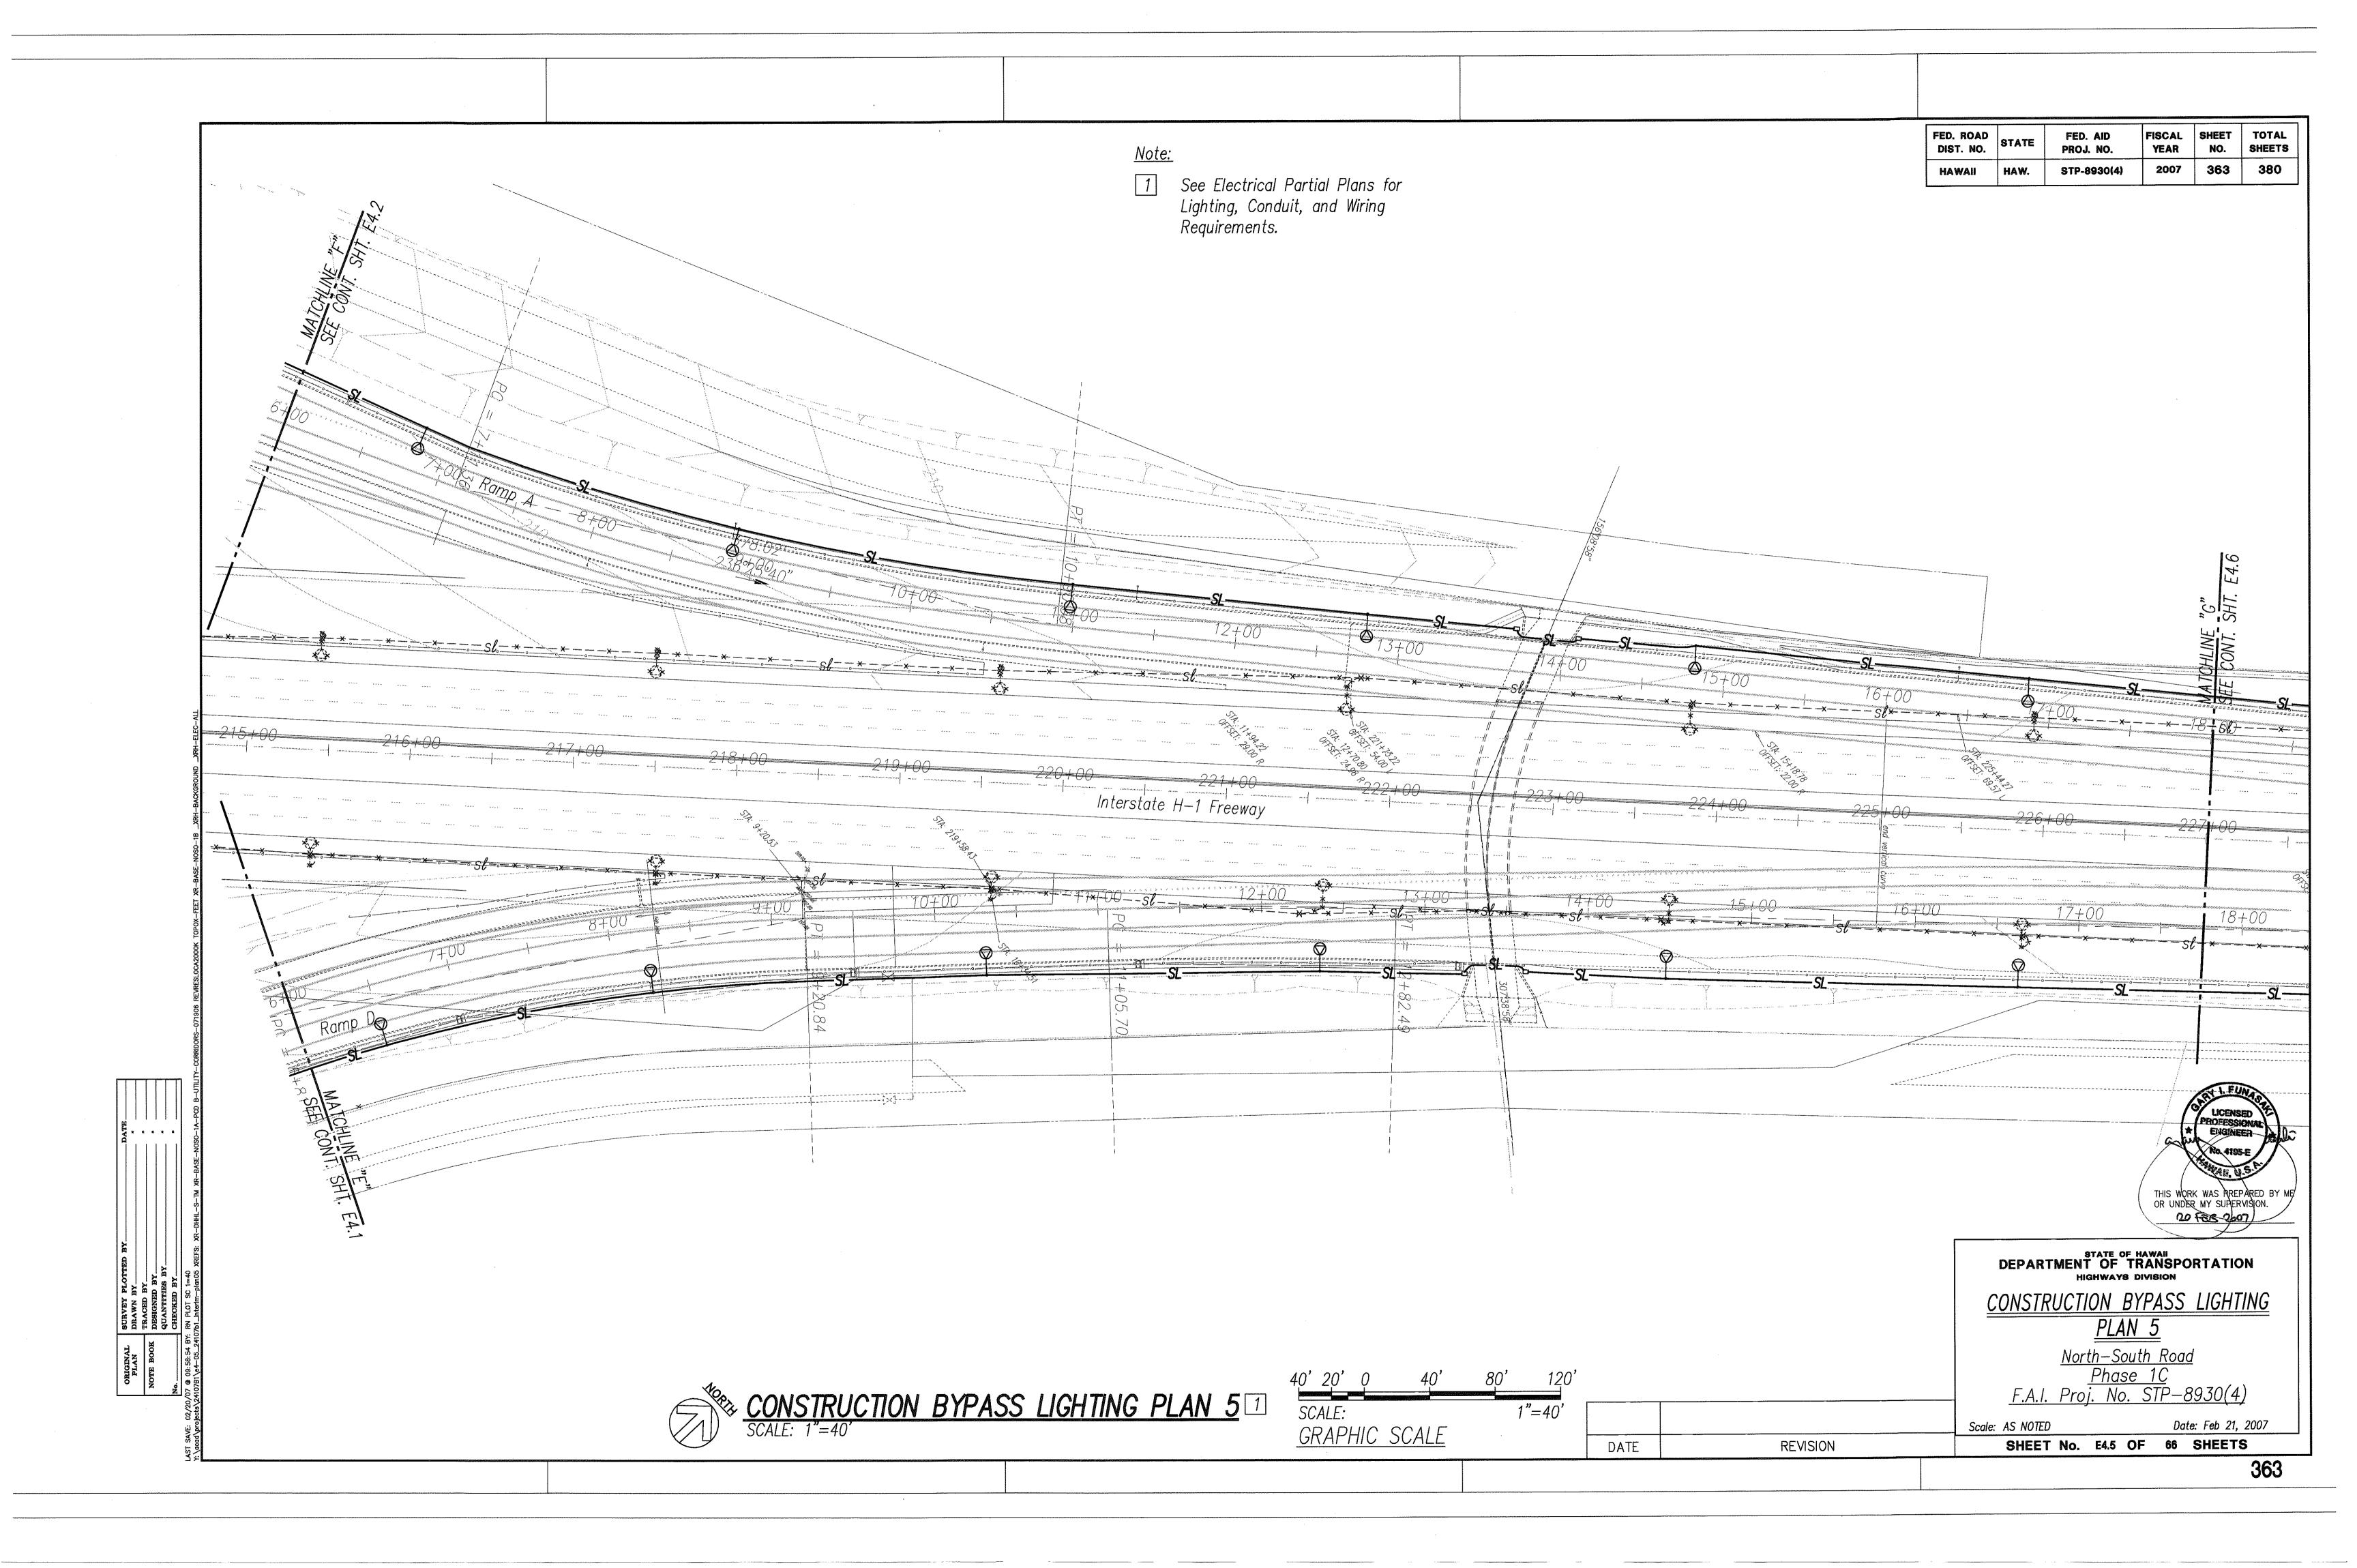


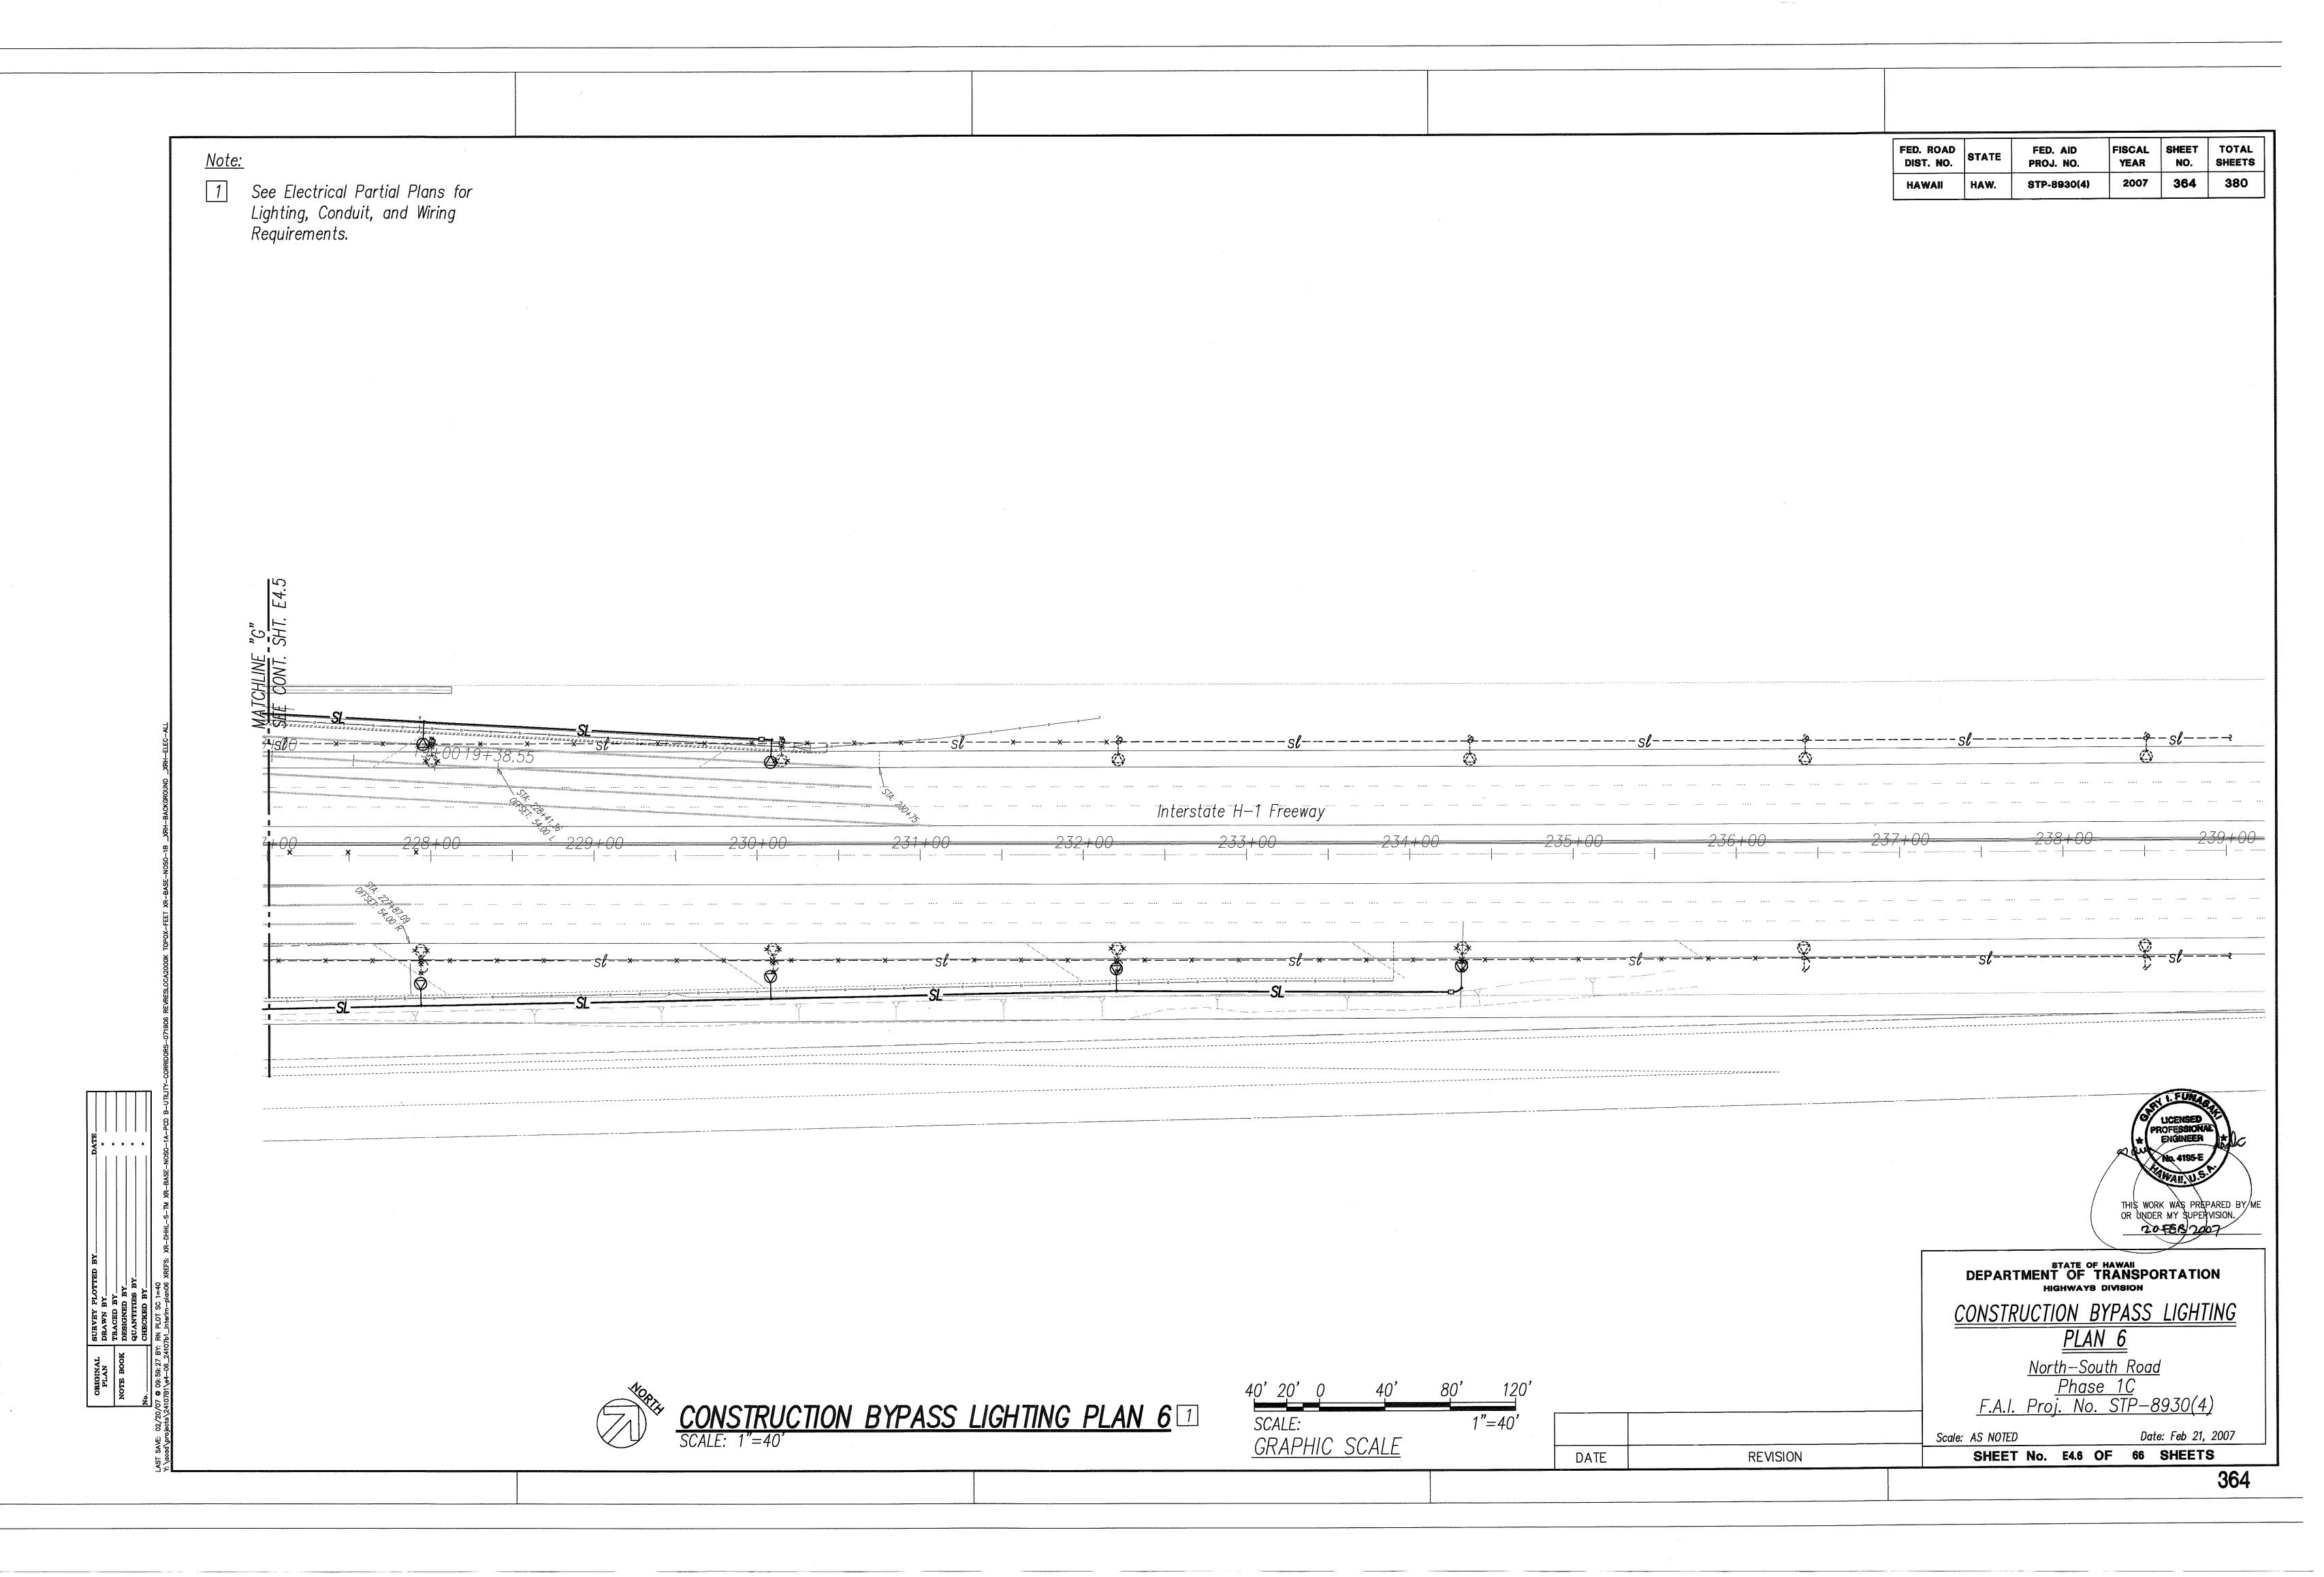


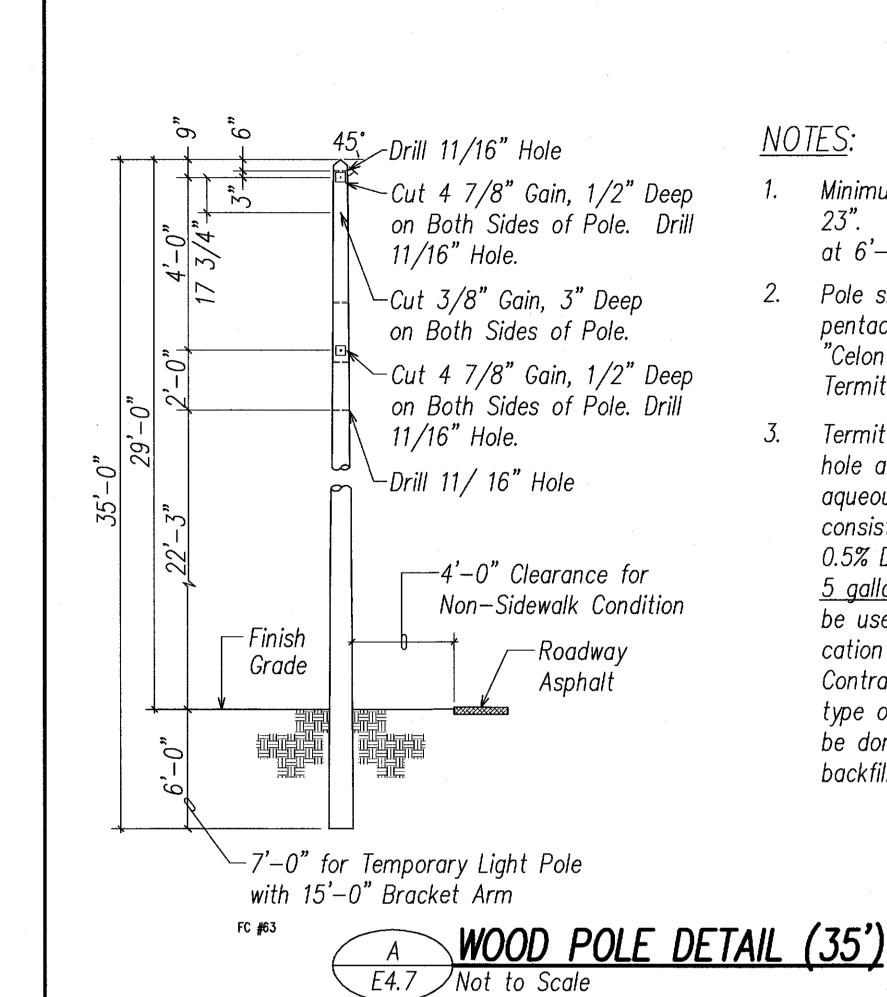

#### NOTES:

- 1. Minimum top circumference is 23". Minimum circumference at 6'-0" from butt is 35".
- 2. Pole shall be treated with pentachlorophenol using the "Celon" Process, by licensed Termite Treatment Company.
- 3. Termite treat the bottom of hole and backfill material with aqueous chemical solution consisting of 0.5% Aldrin or 0.5% Dursban. Minimum 5 gallons of the solution shall be used for each pole. Application shall be performed by Contractor licensed for this type of work. Treatment shall be done as the hole is being backfilled.

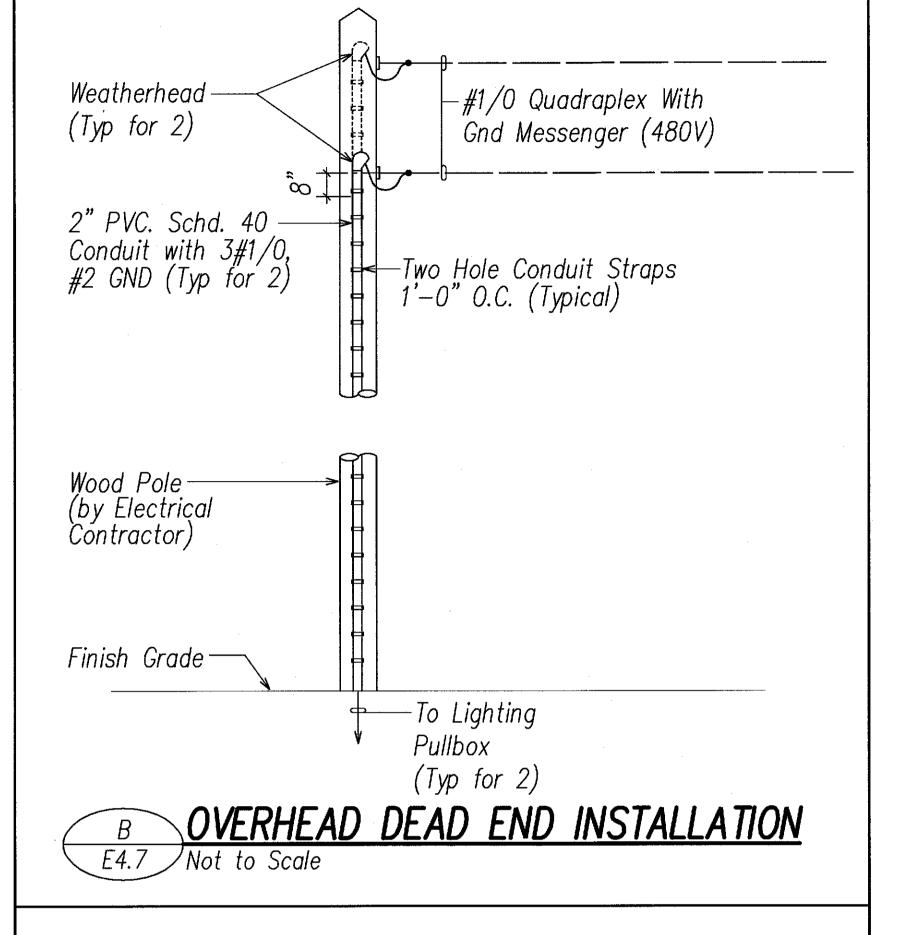

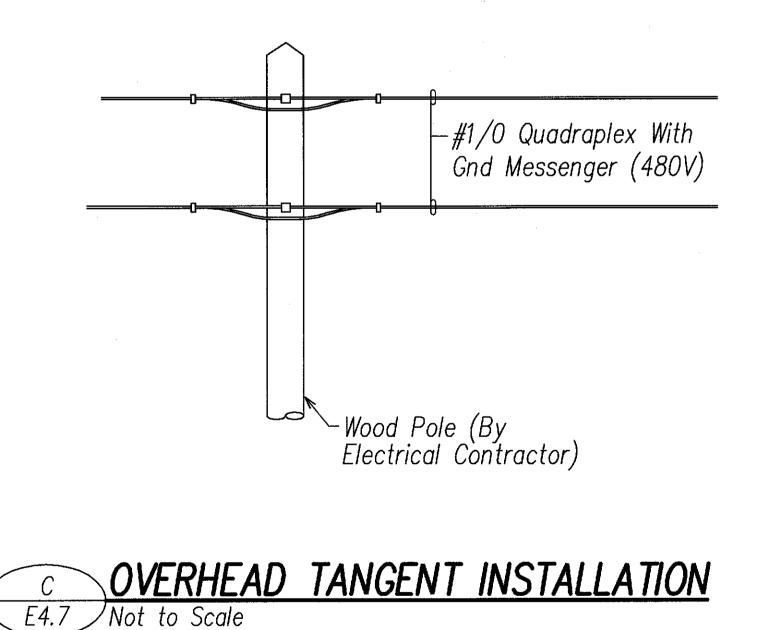

FED. ROAD DIST. NO. FISCAL SHEET TOTAL FED. AID YEAR PROJ. NO. NO. SHEETS 2007 CO 365 380 STP-8930(4)

#### LEGEND FOR AS-BUILT POSTINGS

Squiggly line for as-built deletion Double line for as-built deletion

Roadway Text for as-built posting

DEPARTMENT OF TRANSPORTATION
HIGHWAYS DIVISION OVERHEAD DETAILS

North-South Road

<u>Phase 1C</u> F.A.I. Proj. No. STP-8930(4)


Date: Feb 21, 2007 Scale: AS NOTED SHEET No. E4.7 OF 66 SHEETS

3/26/08 Revised Bypass Ltg (RFI 95) DATE REVISION

CO 365

LICENSED PROFESSIONAL ENGINEER

THIS WORK WAS PREPARED BY ME OR UNDER MY SUPERVISION.

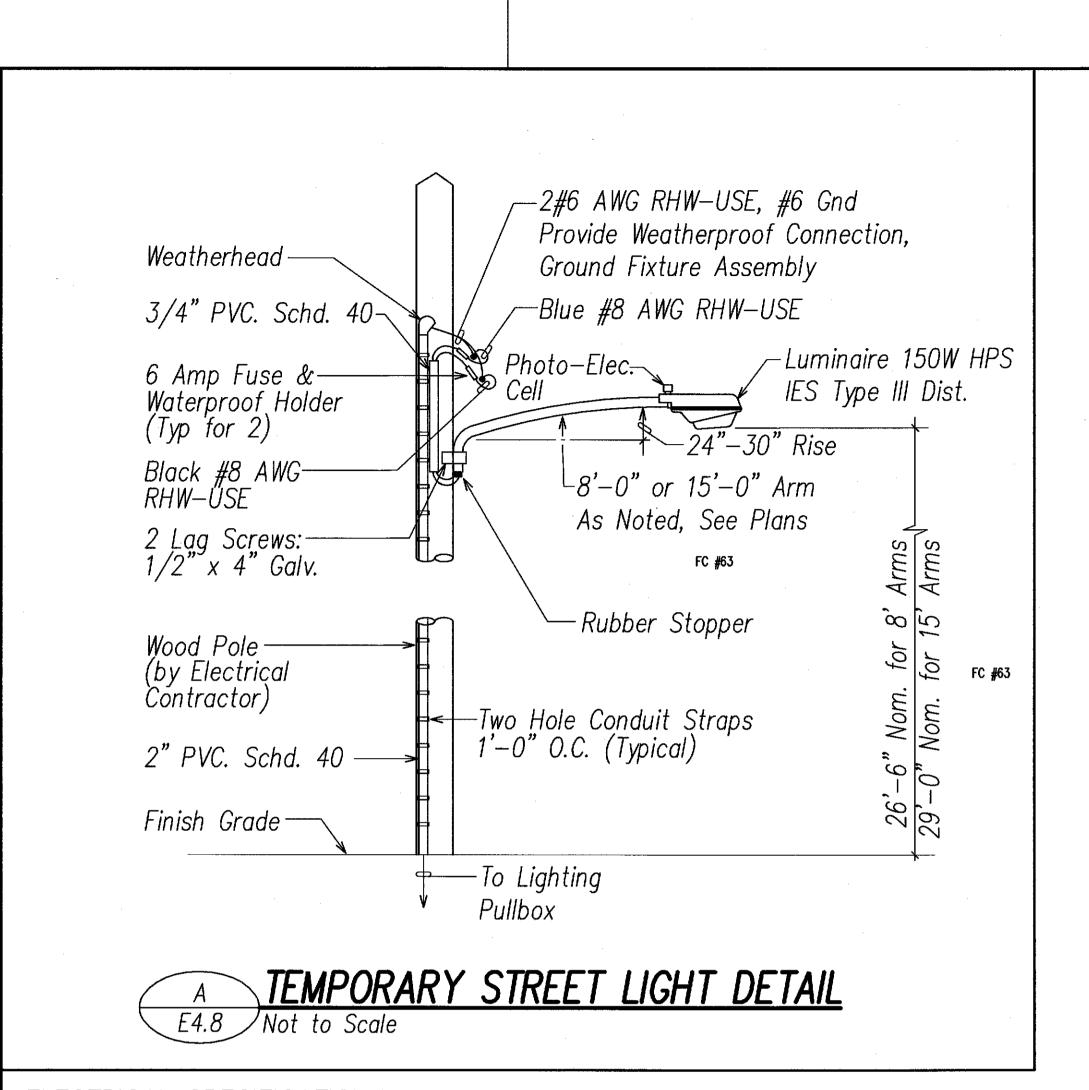

#### ELECTRICAL SPECIFICATION

Mounting Height.

A. All mounting heights are nominal and indicate distance from top of curb or grade to center of luminaire support at point of luminaire attachment.

B. For 150 Watt HPS Luminaire -- 26'-0".

2. Bracket Arm.

A. Bracket arm assembly shall consist of 2" I.P.S. steel pipe.

- B. Pole end shall have steel fitting welded to it, which will permit positioning of arm on plate held only by gravity while arm is secured to pole with cap screws providing weather-resistant connection & smooth wiring raceway.
- C. Face plate shall be designed for wood pole mounting and connecting bolts must be capable of resisting the same moment at yield strength as arm member.

Luminaire.

- A. Luminaires shall be standard make and manufactured by a Manufacturer of recognized experience and ability, who is now regularly engaged in the manufacture of street lighting luminaires.
- B. The luminaire shall have a slip-fitter suitable to accept a minimum 4 1/2" straight tenon, 1 5/8" O.D. to 2 3/8" O.D., without the need of rearrangement of any of the mounting components. Mast arm shall be secured by means of two locking bolts. All hardware shall be stainless steel, hot-dipped galvanized, or cadmium plated.

- C. The luminaire housing shall be provided with an EEI-NEMA Standard three terminal twist locking type mounting receptacle for individual photo control. the receptacle shall be pre-wired to the terminal board for the same operating voltage as the ballast.
- D. The terminal strip shall have protective barriers between each terminal. The terminal board shall accommodate wire sizes up to No. 8 AWG.
- E. All luminaire components shall be securely mounted against horizontal and vertical movement.
- F. The new weight of the luminaire, including ballast, designed to operate the high pressure sodium lamp, shall not exceed 25 pounds.
- G. The luminaire light distribution shall be IES Type III, semi-cutoff with glass refractor.
- H. The luminaire shall be supplied without terminal board cover plate.

- A. Rated for 480V input of multiple circuit, 60 Hz distribution system. Unit shall consist of a core and coil assembly impregnated with Class "F" Varnish.
- B. Ballast shall be for single HPS lamp, wattages as shown on Drawings, regulated output type, high power factor, capable of maintaining rated output with  $\pm 10\%$ variation of input voltage, and conforming to applicable NEMA standards.

5. Photo-Electric Cell.

- A. Photo-electric cell shall be for plug connection on *luminaire with weatherproof twist lock receptacle &* control of normally closed contacts. Voltage shall be 480V. Turn on range at 0.5 to 2.5 footcandles, turn off range at 6 footcandles maximum, minimum 200 milli-seconds time delay. Expulsion type lightning arrester, full wave rectifier & combination resistor capacitor.
- B. In the event of electronic circuit failure, load shall remain on.
- C. Cadmium sulfide photocell shall be of average sensitivity, hermetically sealed and tested to 100%.

D. Relay shall have double pole, single throw, double contacts, with contacts normally closed.

- E. Individual components mounted on Bakelite chassis with three locking blades and removable neoprene sealing gasket on bottom side, so designed that the unit may be mounted directly on luminaire heads and adapters that meet EEI-NEMA Standards. Bakelite chasis protected by weatherproof acrylic plastic housing, with aperture for limited field of seeing by photocell and adjustable shutter to control On-Off
- F. Control unit shall be designed for minimum of 5000 *On-Off operations at full rated load conditions.*

6. Fused Connector.

A. Fused connector shall be rubber body, watertight, two—section (line side receptacle, load side plug) metallic fuseholder with wire terminal and lead—in wires.

FED. ROAD

DIST. NO.

HAWAII

FED. AID PROJ. NO.

STP-8930(4)

FISCAL YEAR

2007 CO 366

TOTAL

SHEETS

B. Fuse shall be midget type six ampere cartridge fuse.

7. Galvanized Finish. Bracket arm and all accessories and hardware such as nuts, washers, bolts, and shims shall be hot-dipped galvanized.

8. Connectors. All Connectors shall be AL-CU approved type.


9. Poles. All poles shall be 35 Feet, Class 3, penta in oil treated with pentachlorophenol in hydro carbon solvent, Type A per APWA C1 & C4 Specifications by licensed Termite Treating Co.

#### LEGEND FOR AS-BUILT POSTINGS

Squiggly line for as-built deletion Double line for <del>100.00</del>

as-built deletion Roadway Text for as-built posting

3/26/08 Revised Bypass Ltg (RFI 95) DATE REVISION

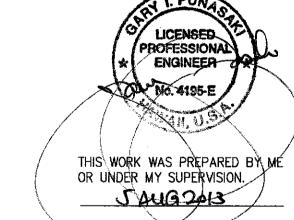

DEPARTMENT OF TRANSPORTATION


TEMPORARY STREET LIGHT <u>DETAILS</u>


North-South Road <u>Phase 1C</u> F.A.I. Proj. No. STP-8930(4)

Scale: AS NOTED


Date: Feb 21, 2007 SHEET No. E4.8 OF 66 SHEETS

CO 366

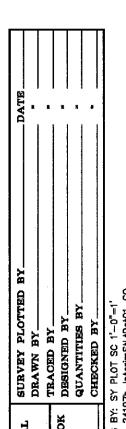

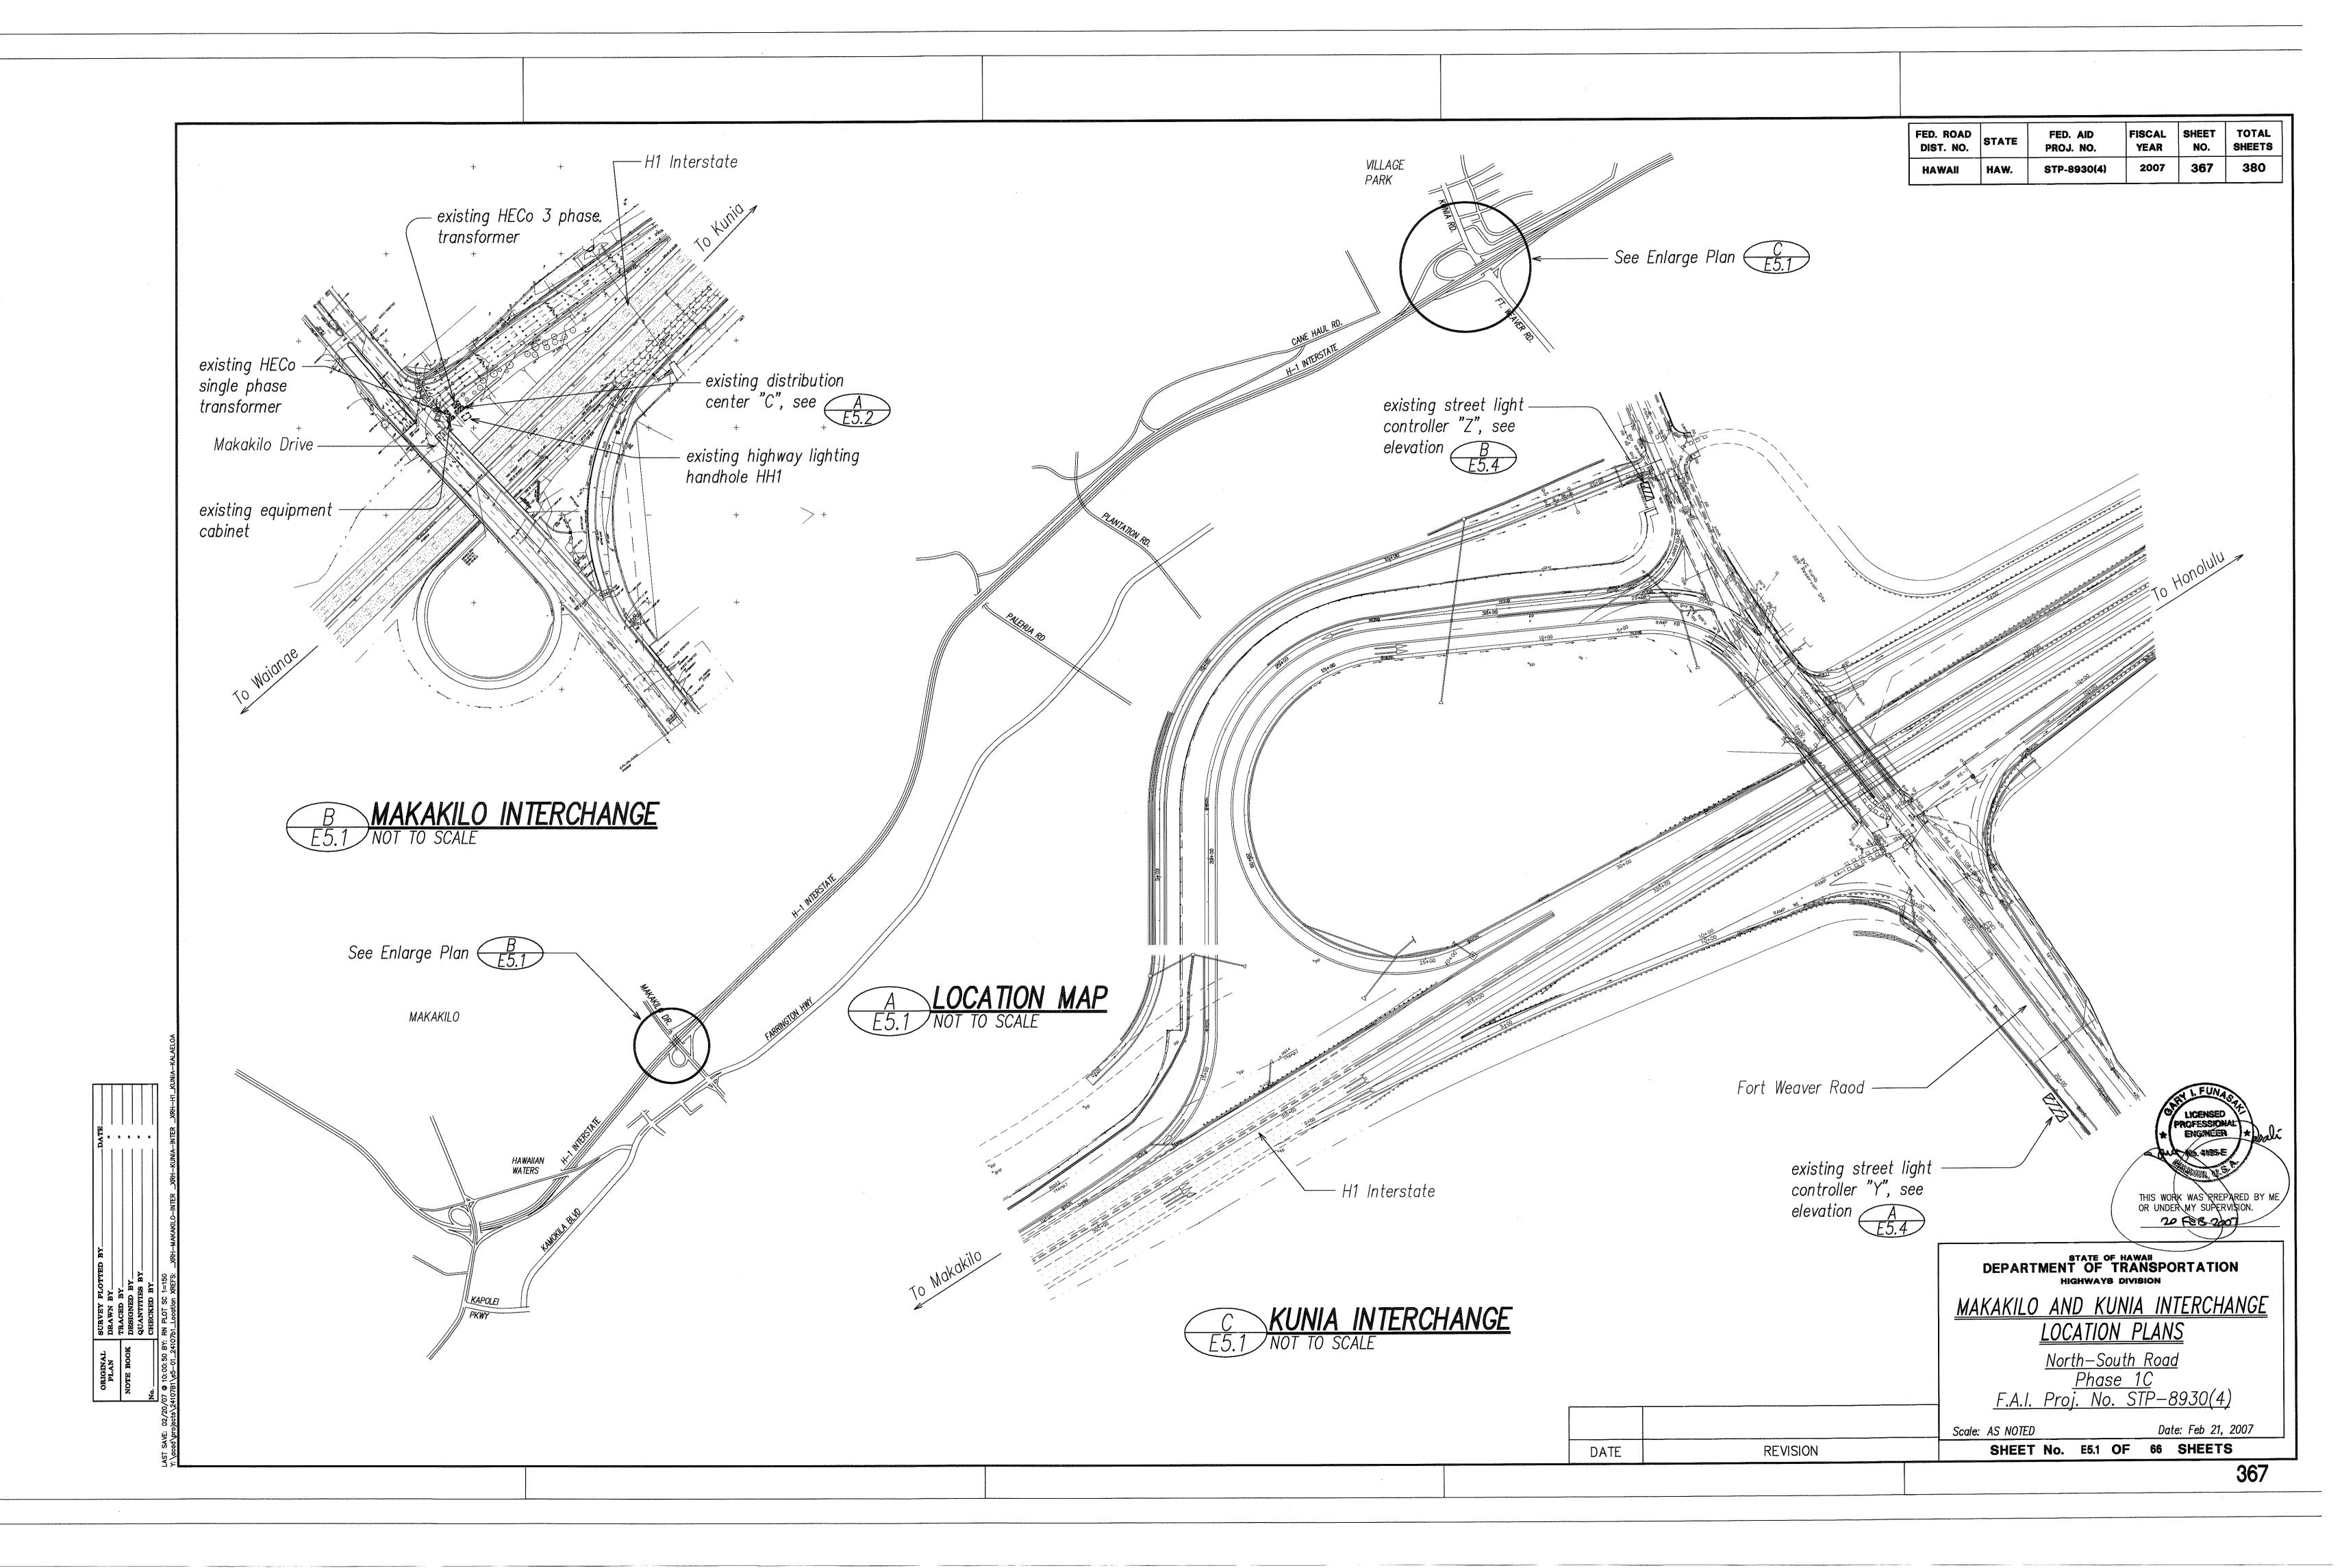


FED. ROAD DIST. NO.	STATE	FED. AID PROJ. NO.	FISCAL YEAR	SHEET NO.	TOTAL SHEETS
HAWAII	HAW.	STP-8930(4)	2007	368	380

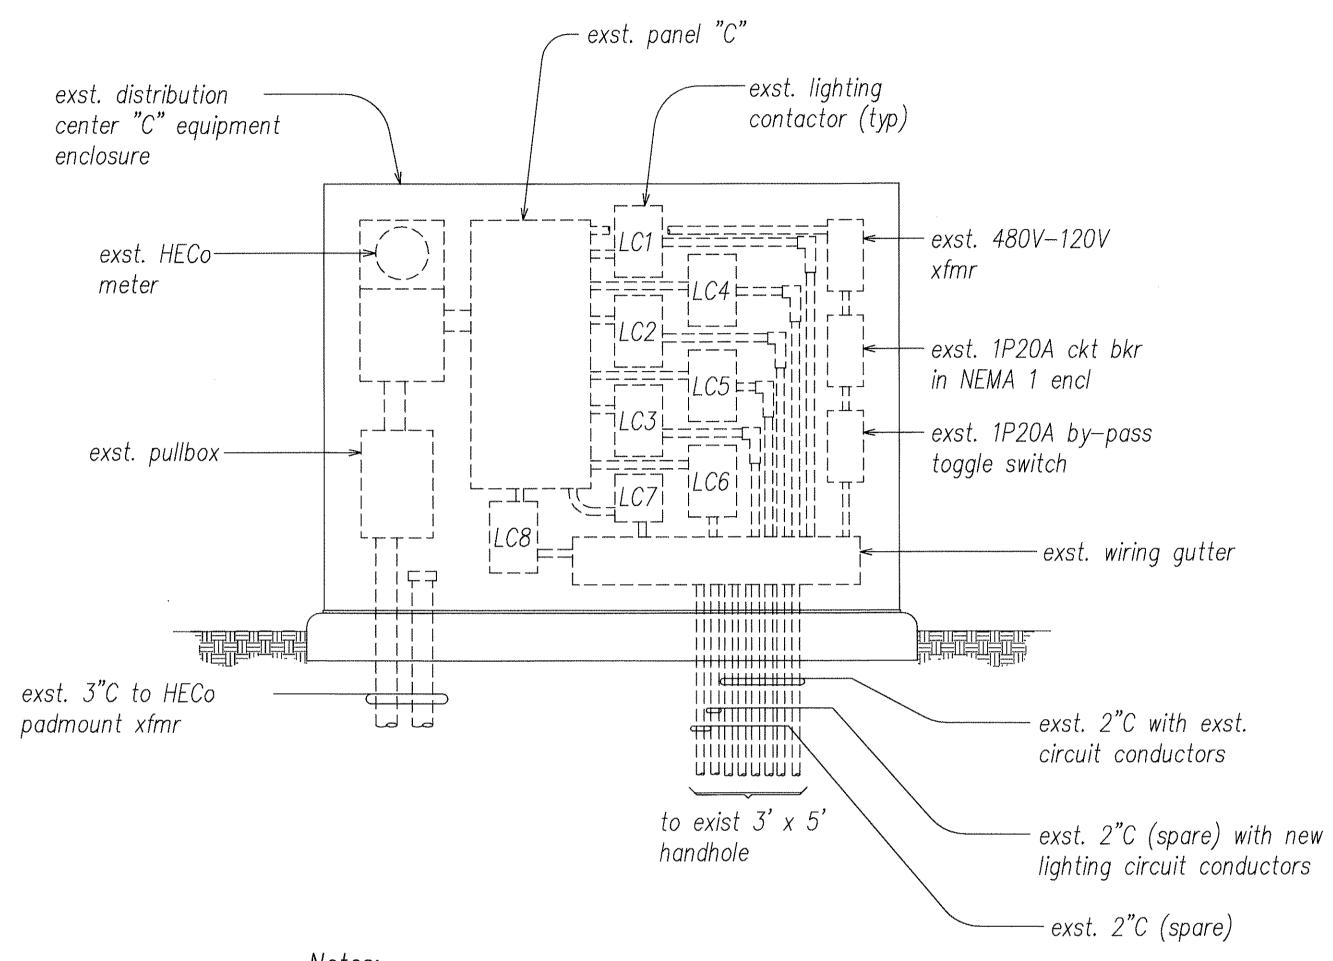

- <u>Notes:</u>
- 1. Contractor Shall Verify Existing Conditions in the Field Prior to Construction.
- 2. See Existing One-line Diagram Sheet E5.3.



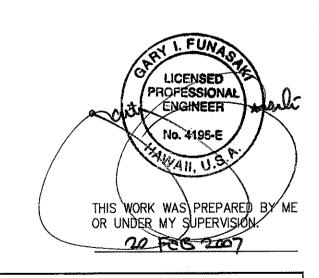

DEPARTMENT OF TRANSPORTATION
HIGHWAYS DIVISION

<u>MAKAKILO INTERCHANGE</u> EXST EQUIPMENT ELEVATION

<u>North-South Road</u> <u>Phase 1C</u> F.A.I. Proj. No. STP-8930(4)


Scale: AS NOTED

AS NOTED Date: Feb 21, 2007


SHEET No. E5.2 OF 66 SHEETS

FOR REFERENCE ONLY

DATE REVISION

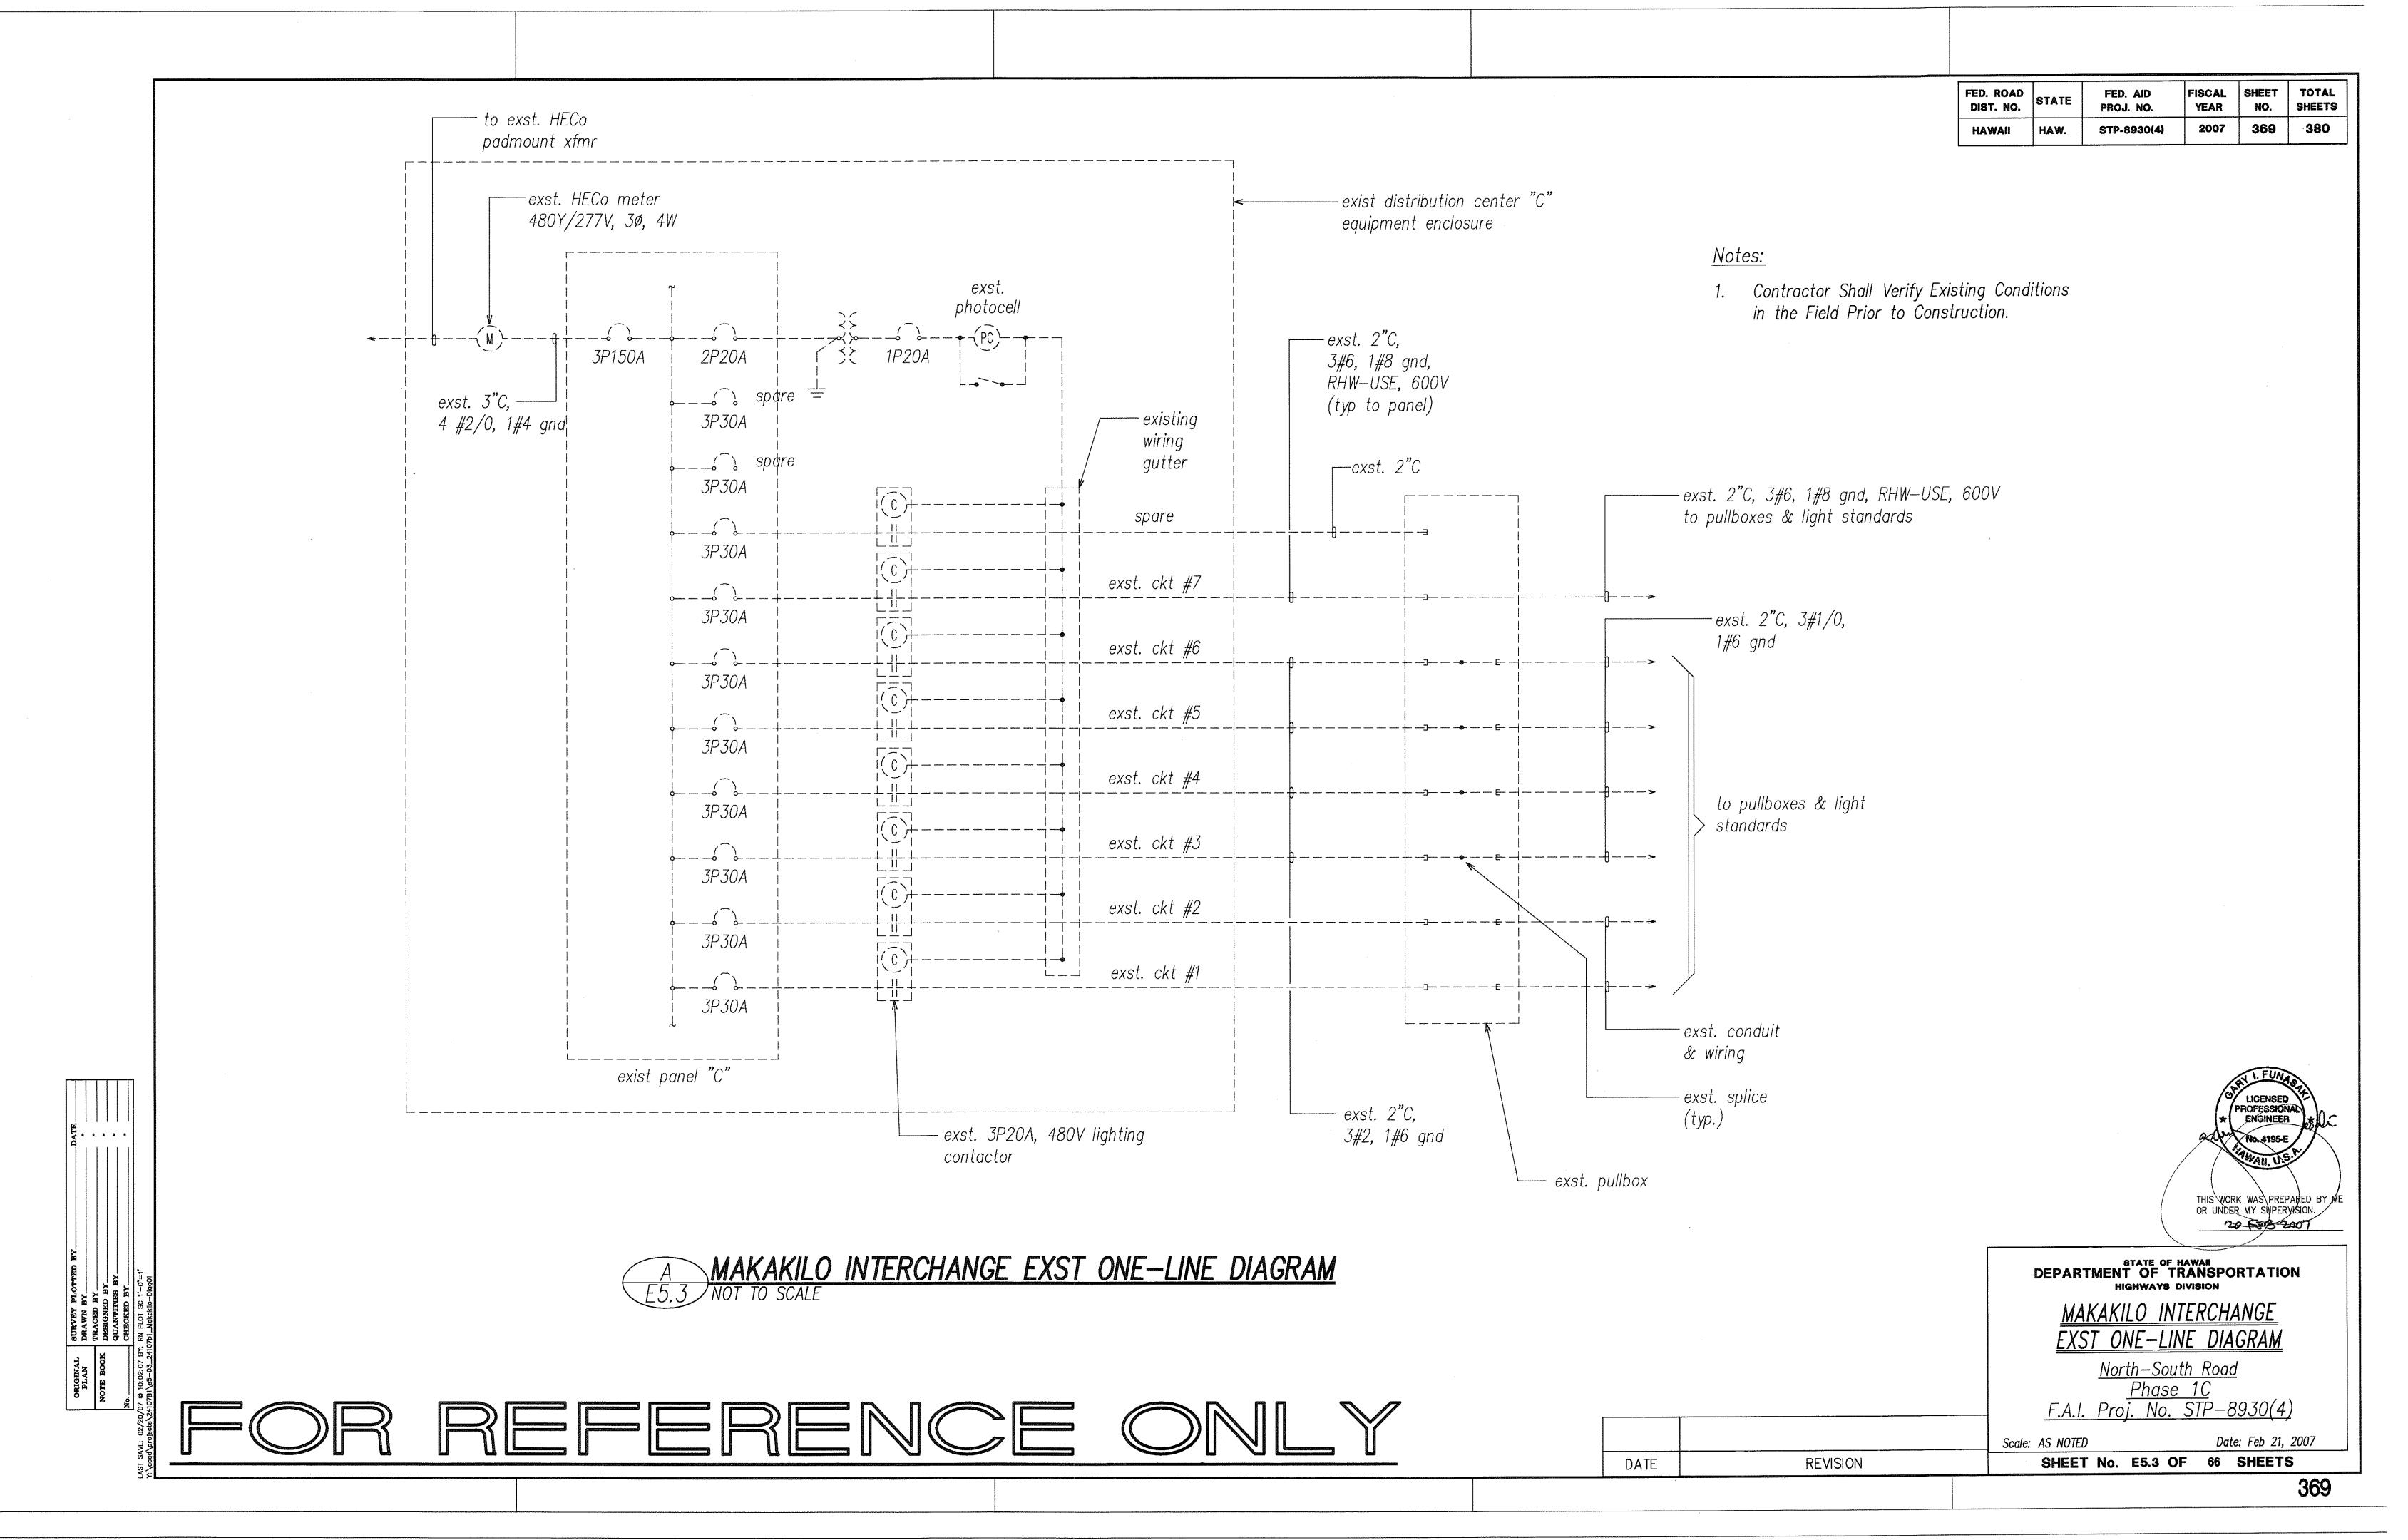


FED. ROAD DIST. NO.	STATE	FED. AID PROJ. NO.	FISCAL YEAR	SHEET NO.	TOTAL SHEETS
HAWAII	HAW.	STP-8930(4)	2007	370	380

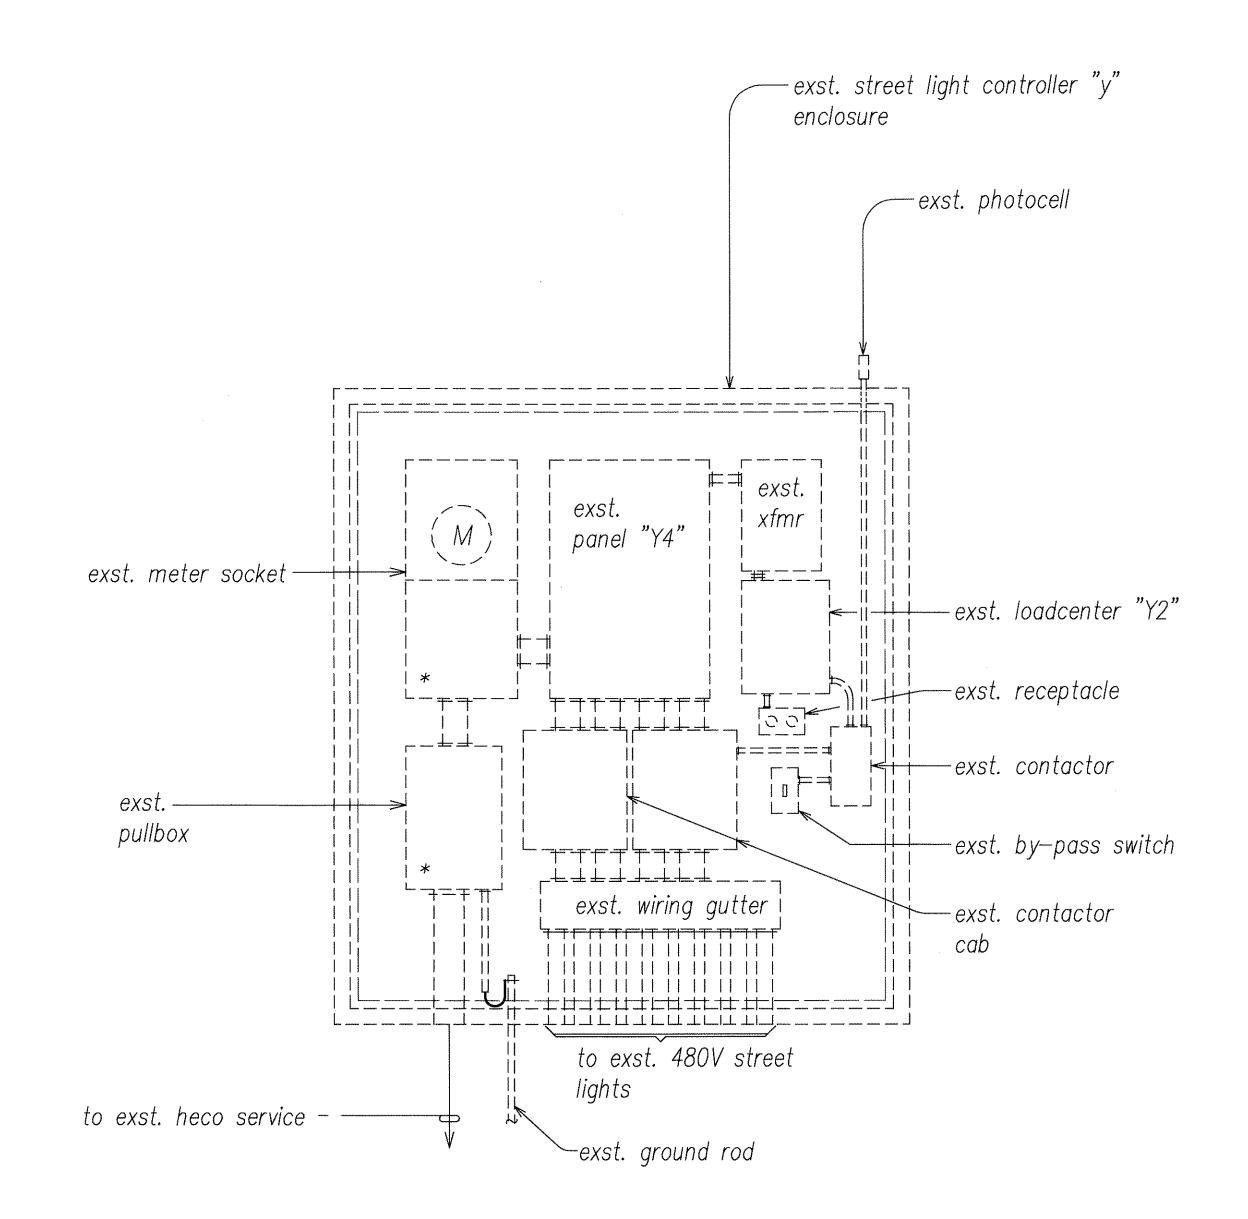




- Contractor Shall Verify Existing Conditions in the Field Prior to Construction.
- 2. See Existing One-line Diagram Sheet E5.5.

## KUNIA INTERCHANGE EXST EQUIPMENT ELEVATION Y NOT TO SCALE

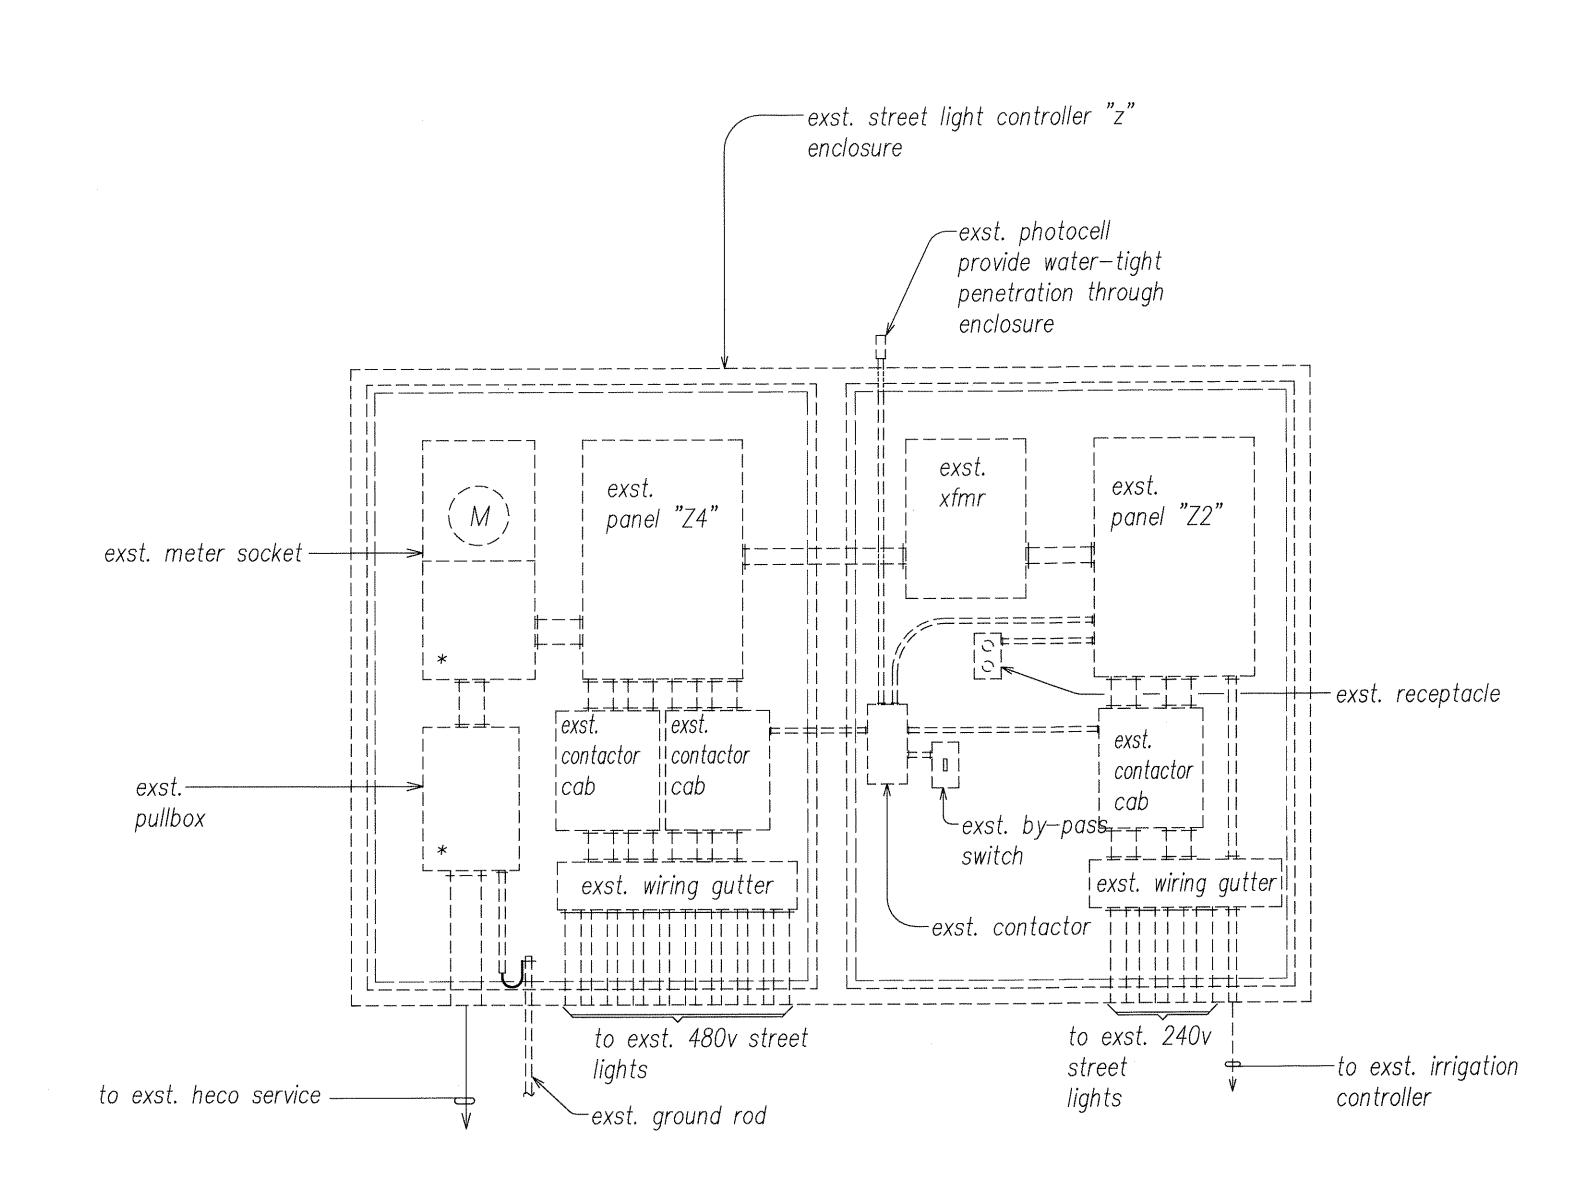

#### <u>Notes:</u>

- Contractor Shall Verify Existing Conditions in the Field Prior to Construction.
- 2. See Existing One-line Diagram Sheet E5.6.

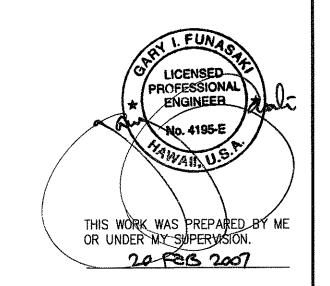

## KUNIA INTERCHANGE EXST EQUIPMENT ELEVATION Z NOT TO SCALE

DEPARTMENT OF TRANSPORTATION
HIGHWAYS DIVISION KUNIA INTERCHANGE EXST EQUIPMENT ELEVATIONS

<u>North—South Road</u> Phase 1C

F.A.I. Proj. No. STP-8930(4)

Scale: AS NOTED

Date: Feb 21, 2007 SHEET No. E5.4 OF 66 SHEETS

REFERENCE

REVISION DATE

