

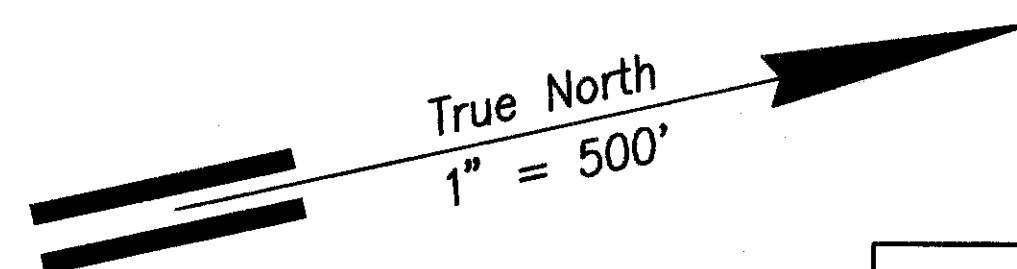


FED. ROAD DIST. NO.	STATE	FED. AID PROJ. NO.	FISCAL YEAR	SHEET NO.	TOTAL SHEETS
HAWAII	HAW.	STP-8930(4)	2007	14	380

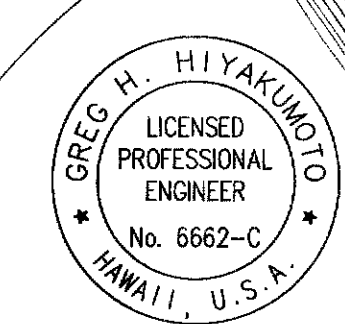

ADTs for Year 2025	
Ramp "A"	12,400 vehicles per day
Ramp "B"	4,470 vehicles per day
Ramp "C"	3,850 vehicles per day
Ramp "D"	15,690 vehicles per day

LEGEND FOR AS-BUILT POSTINGS	
	Squiggly line for as-built deletion
	Double line for as-built deletion
	Text for as-built posting

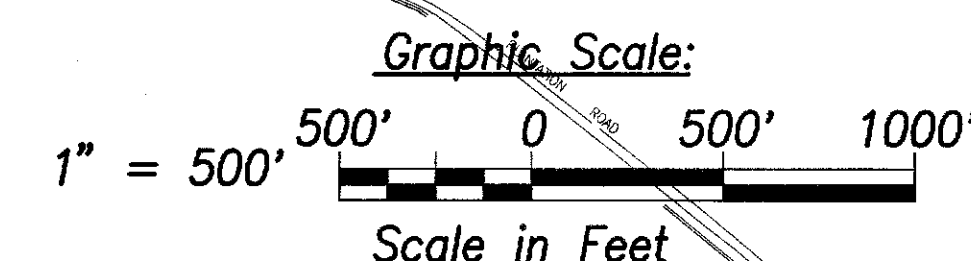

THIS WORK WAS PREPARED BY ME OR UNDER MY SUPERVISION.

SIGNATURE: *[Signature]* April 30, 2008
EXPIRATION DATE OF THE LICENSE

DATE	REVISION
	FC#184
STATE OF HAWAII DEPARTMENT OF TRANSPORTATION HIGHWAYS DIVISION	
GENERAL PLAN	
North-South Road Phase 1C	
F.A.I. Proj. No. STP-8930(4)	
Scale: 1" = 500'	Date: Feb 21, 2007
SHEET No. C0.13 OF 179 SHEETS	