

INDEX TO DRAWINGS	
SHEET NO.	DESCRIPTION
1	TITLE SHEET
2-6	INDEX
7	STANDARD PLANS SUMMARY
8	LEGEND & ABBREVIATIONS
9-13	CONSTRUCTION NOTES
14	GENERAL PLAN ①
15-179	CIVIL PLANS ②
180-207	GEOTECH PLANS
208-306	STRUCTURAL PLANS ③
307-372	ELECTRICAL PLANS ④
373-380	LANDSCAPE PLANS

Plan Sht. Nos. ① 13S-1, 13S-2, ② 79S-1, 90S-1, 97S-1, 97S-2, 97S-3, 102S-1, 121S-1, 156S-1, 156S-2, 156S-3, 156S-4, 179S-1, 179S-2, 179S-3, 179S-4, 179S-5, 179S-6, 179S-7, 179S-8, 179S-9, 179S-10, 179S-11, 179S-12, 179S-13, 179S-14, 179S-15, ③ 248S-1, 269S-1, 269S-2, 269S-3, 269S-4, 269S-5, 272S-1, 272S-2, 272S-3, 289S-1, 289S-2, 289S-3, 292S-1, 297S-1, 300S-1, 302S-1, 303S-1, 305S-1, 306S-1, 306S-2, 306S-3, 306S-4, 306S-5, 306S-6, and ④ 340S-1 are supplementary sheets to this project, added during Addendum & "AS-BUILT" postings.

TOTAL SHEET COUNT after Addendum & "AS-BUILT" postings is 433 sheets.

STATE OF HAWAII

DEPARTMENT OF TRANSPORTATION

HIGHWAYS DIVISION

HONOLULU, HAWAII

"AS-BUILT"

PLANS FOR



NORTH-SOUTH ROAD

PHASE 1C


FEDERAL AID PROJECT NO. STP-8930(4)

DISTRICT OF EWA

ISLAND OF OAHU


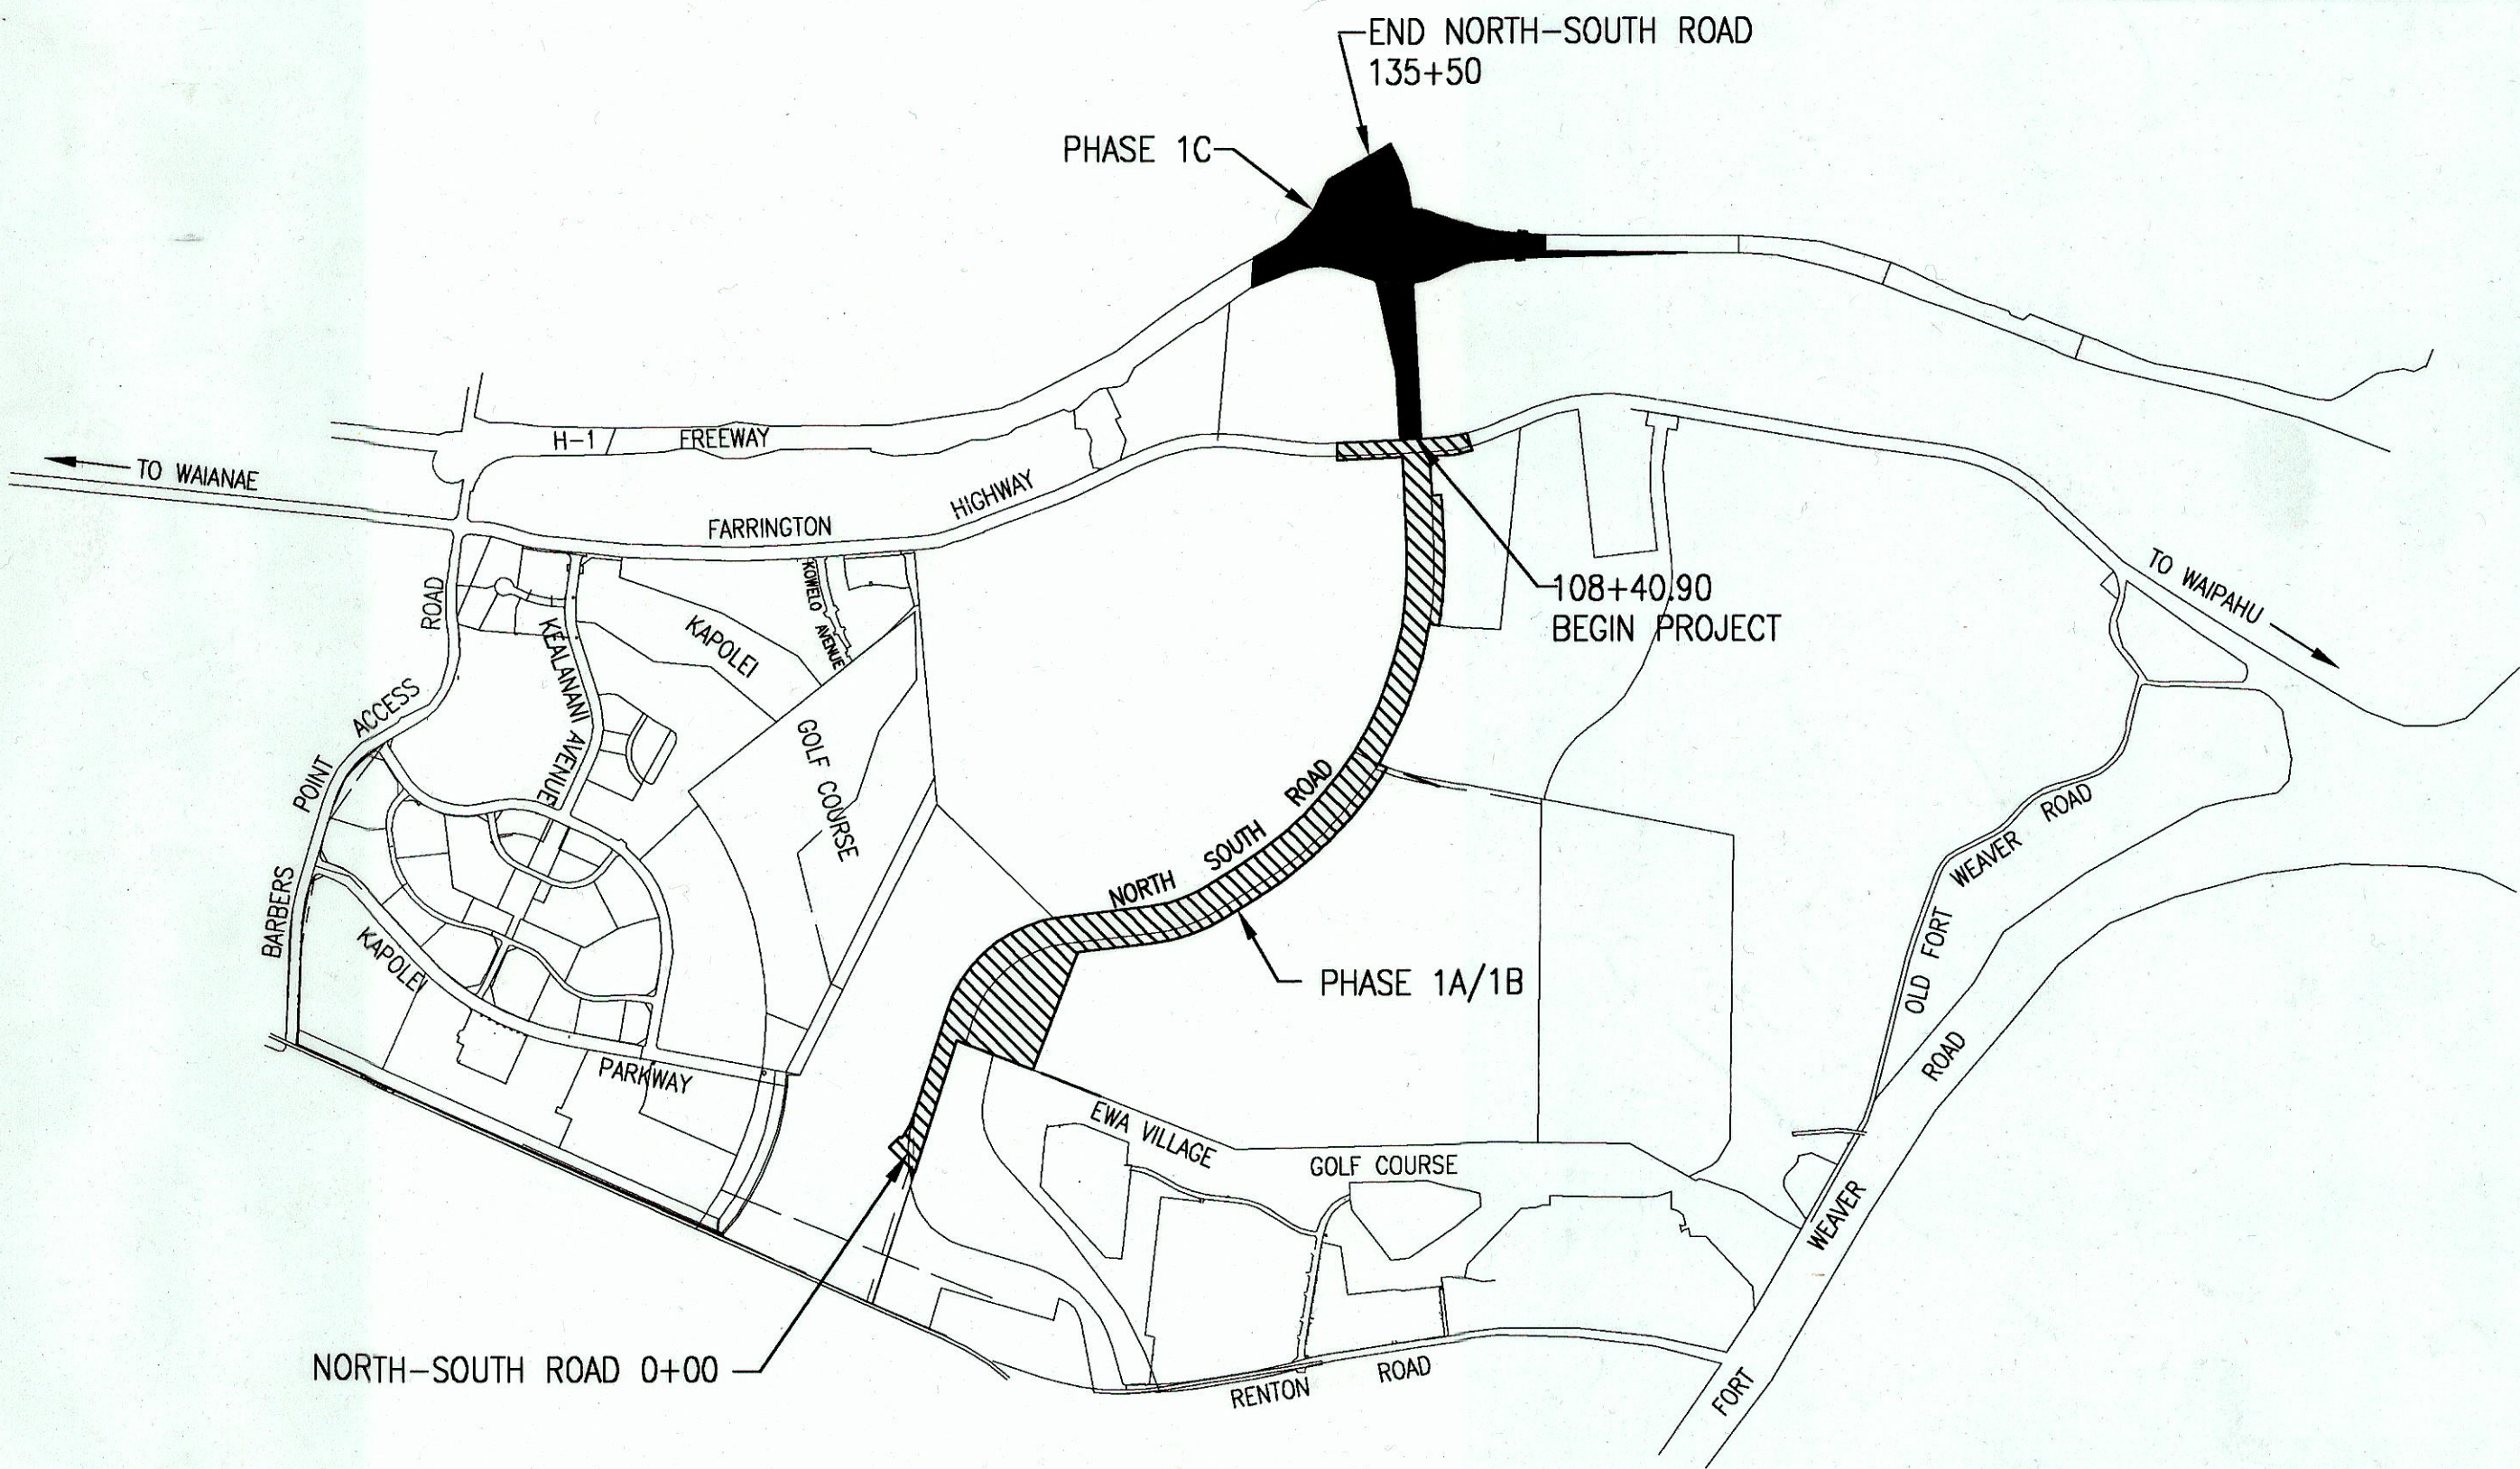
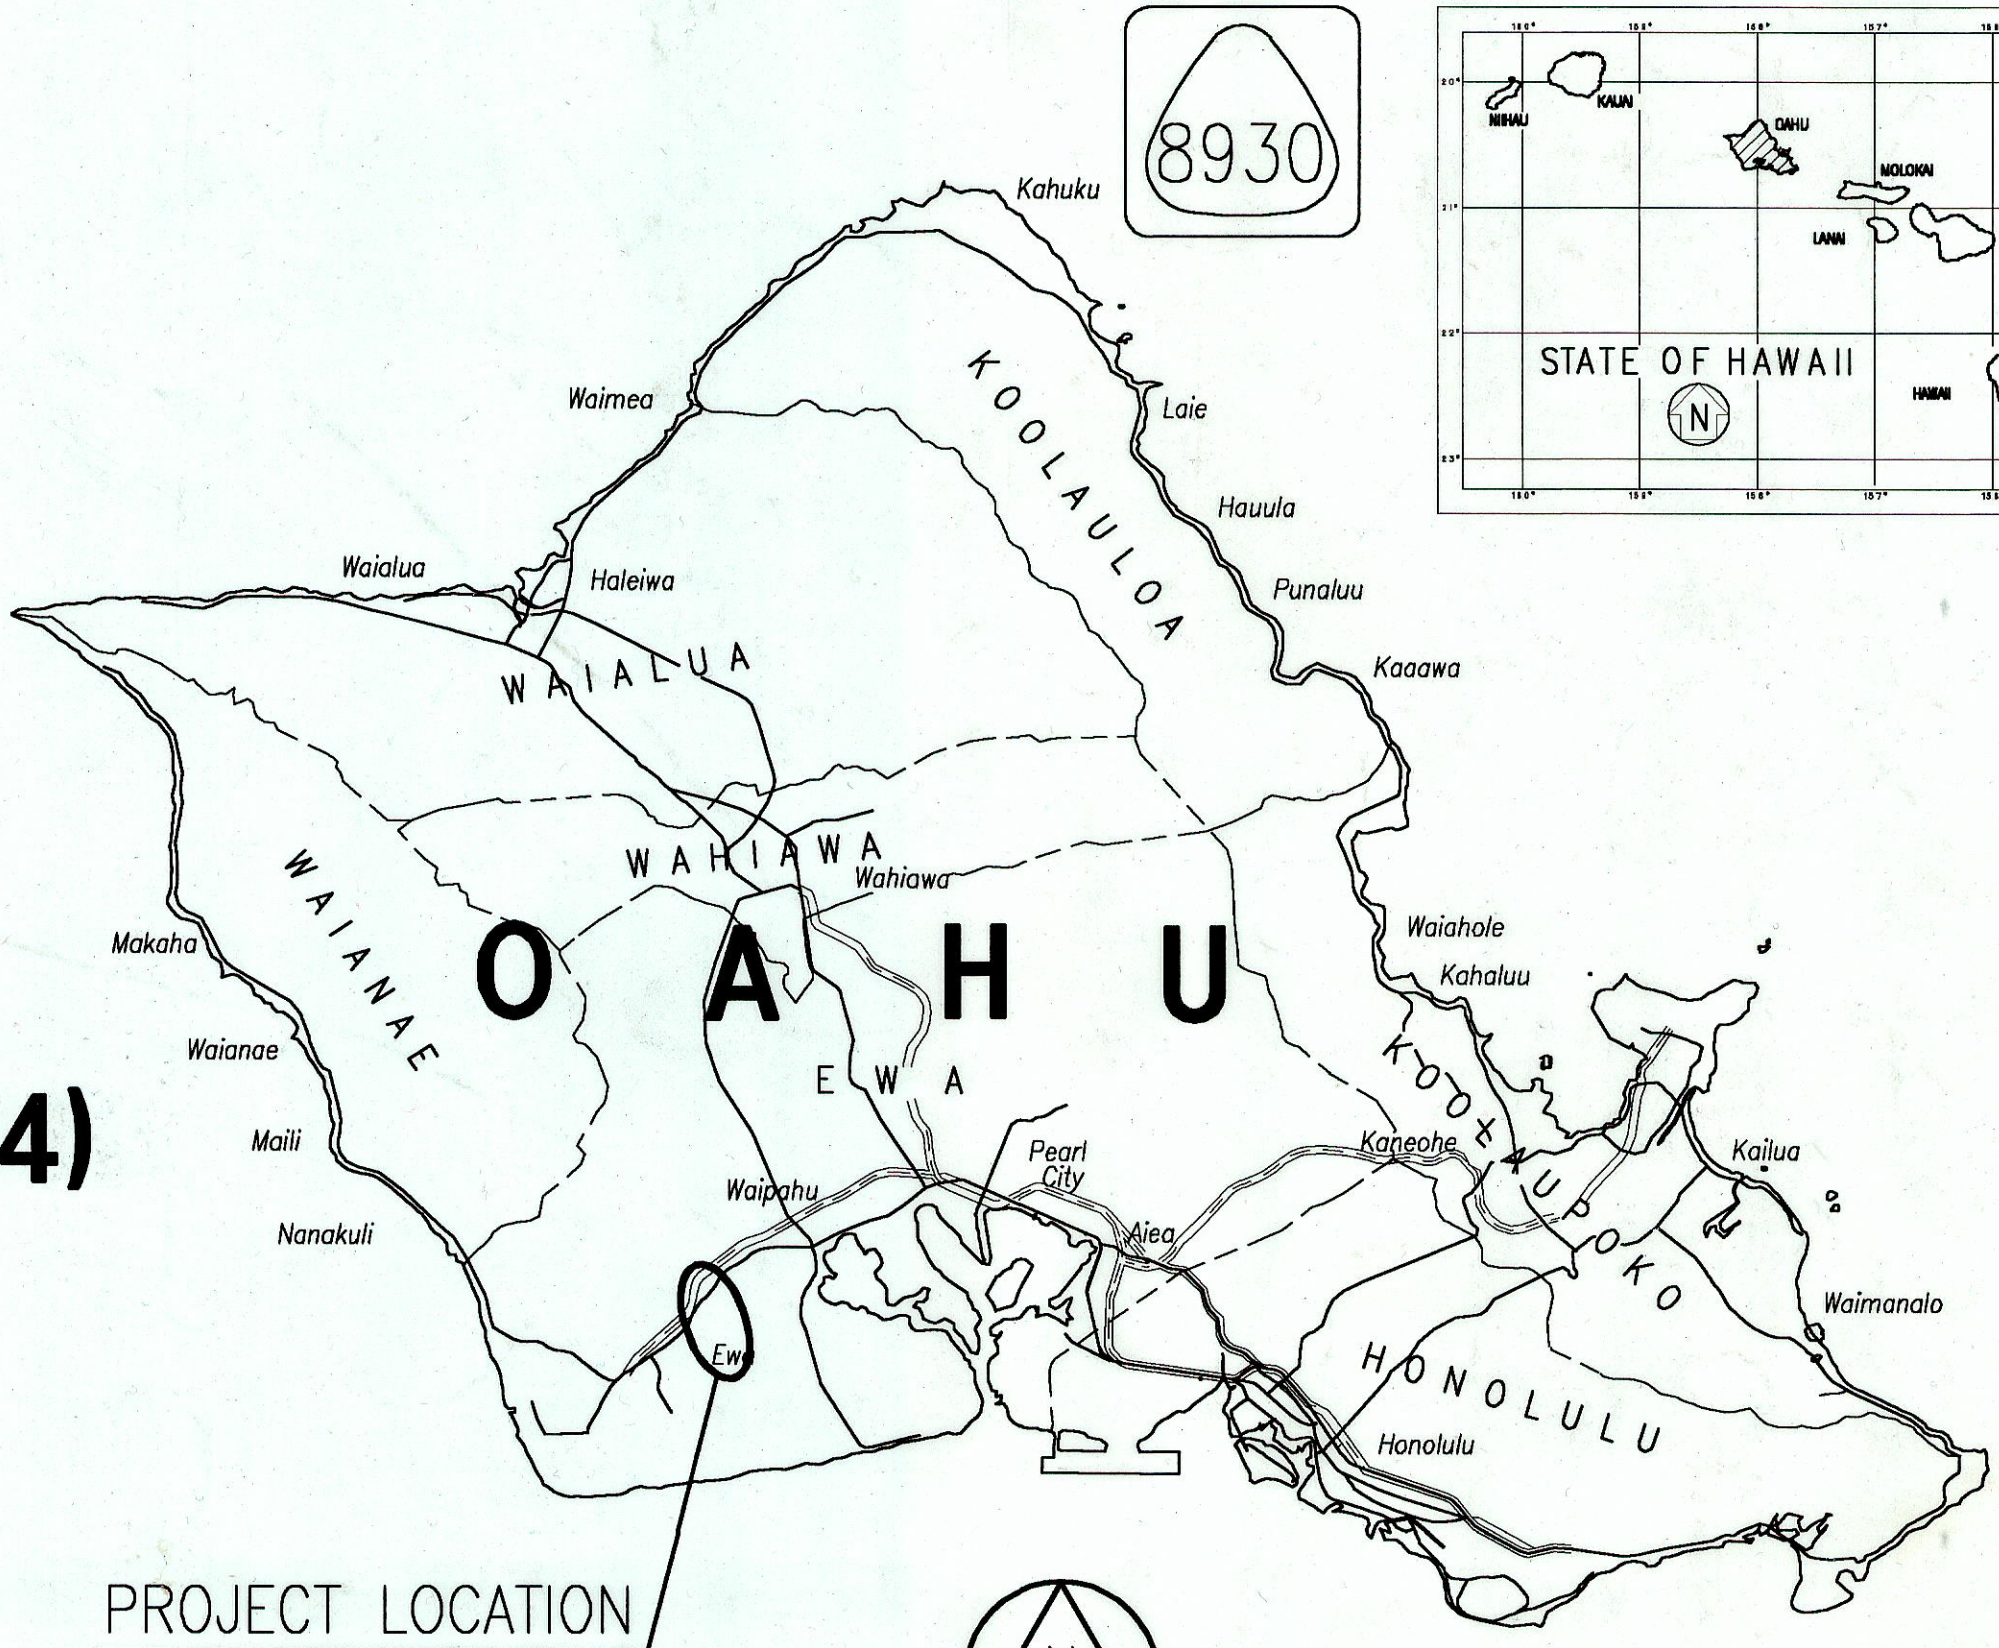


NET LENGTH OF PROJECT - 0.51 MILES
GROSS LENGTH OF PROJECT - 0.51 MILES

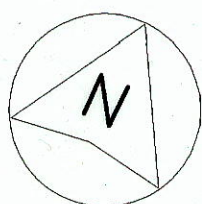

LOCATION PLAN
NOT TO SCALE

FED. ROAD DIST. NO.	STATE	FED. AID PROJ. NO.	FISCAL YEAR	SHEET NO.	TOTAL SHEETS
HAWAII	HAW.	STP-8930(4)	2007	1	380

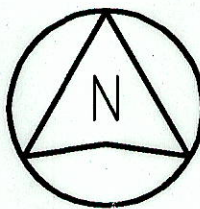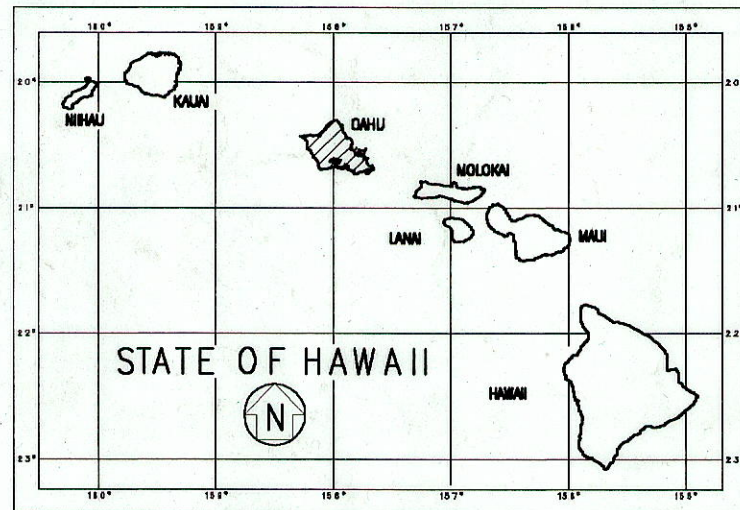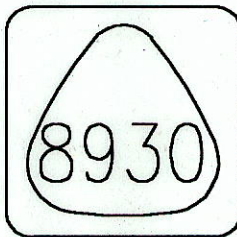

SCALE IN MILES

FEDERAL AID INTERSTATE PROJECTS PREVIOUSLY
CONSTRUCTED OR UNDER CONSTRUCTION

DESIGN DESIGNATION

DESIGN ADT (2022)	43,500
DHV	4,400
D (DESIGN)	54/46
T (DESIGN)	2.7%
T 24	9.3%
V	45 MPH

CHANGES MADE DURING CONSTRUCTION HAVE BEEN
INCORPORATED ON THESE PLANS EXCEPT CHANGES
IN THE ORIGINAL THEORETICAL QUANTITIES. FOR
ACTUAL QUANTITIES, REFER TO PROJECT LEDGER
AND/OR COMPUTATION BOOK.

DEPARTMENT OF TRANSPORTATION
STATE OF HAWAII

APPROVED:

S. J. M. J. M. J. M.
S. DIR. OF TRANSPORTATION

3-14-07
DATE

ORIGINAL PLAN	DATE
NO. 1	
NO. 2	
NO. 3	
NO. 4	
NO. 5	
NO. 6	
NO. 7	
NO. 8	
NO. 9	
NO. 10	

R.M. TOWILL CORP. C. WATANABE 692-7551 FEB, 2007
DESIGNED BY MANAGED BY DATE