
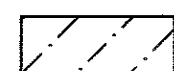
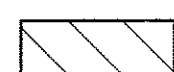


FED. ROAD DIST. NO.	STATE	FED. AID PROJ. NO.	FISCAL YEAR	SHEET NO.	TOTAL SHEETS
HAWAII	HAW.	STP-8930(2)	2007	ADD. 188	331

LEGEND:

-  Structure excavation pay limits
-  Aggregate subbase

NOTE:
The cost of aggregate subbase shall be incidental to the cost of excavation of the structure.

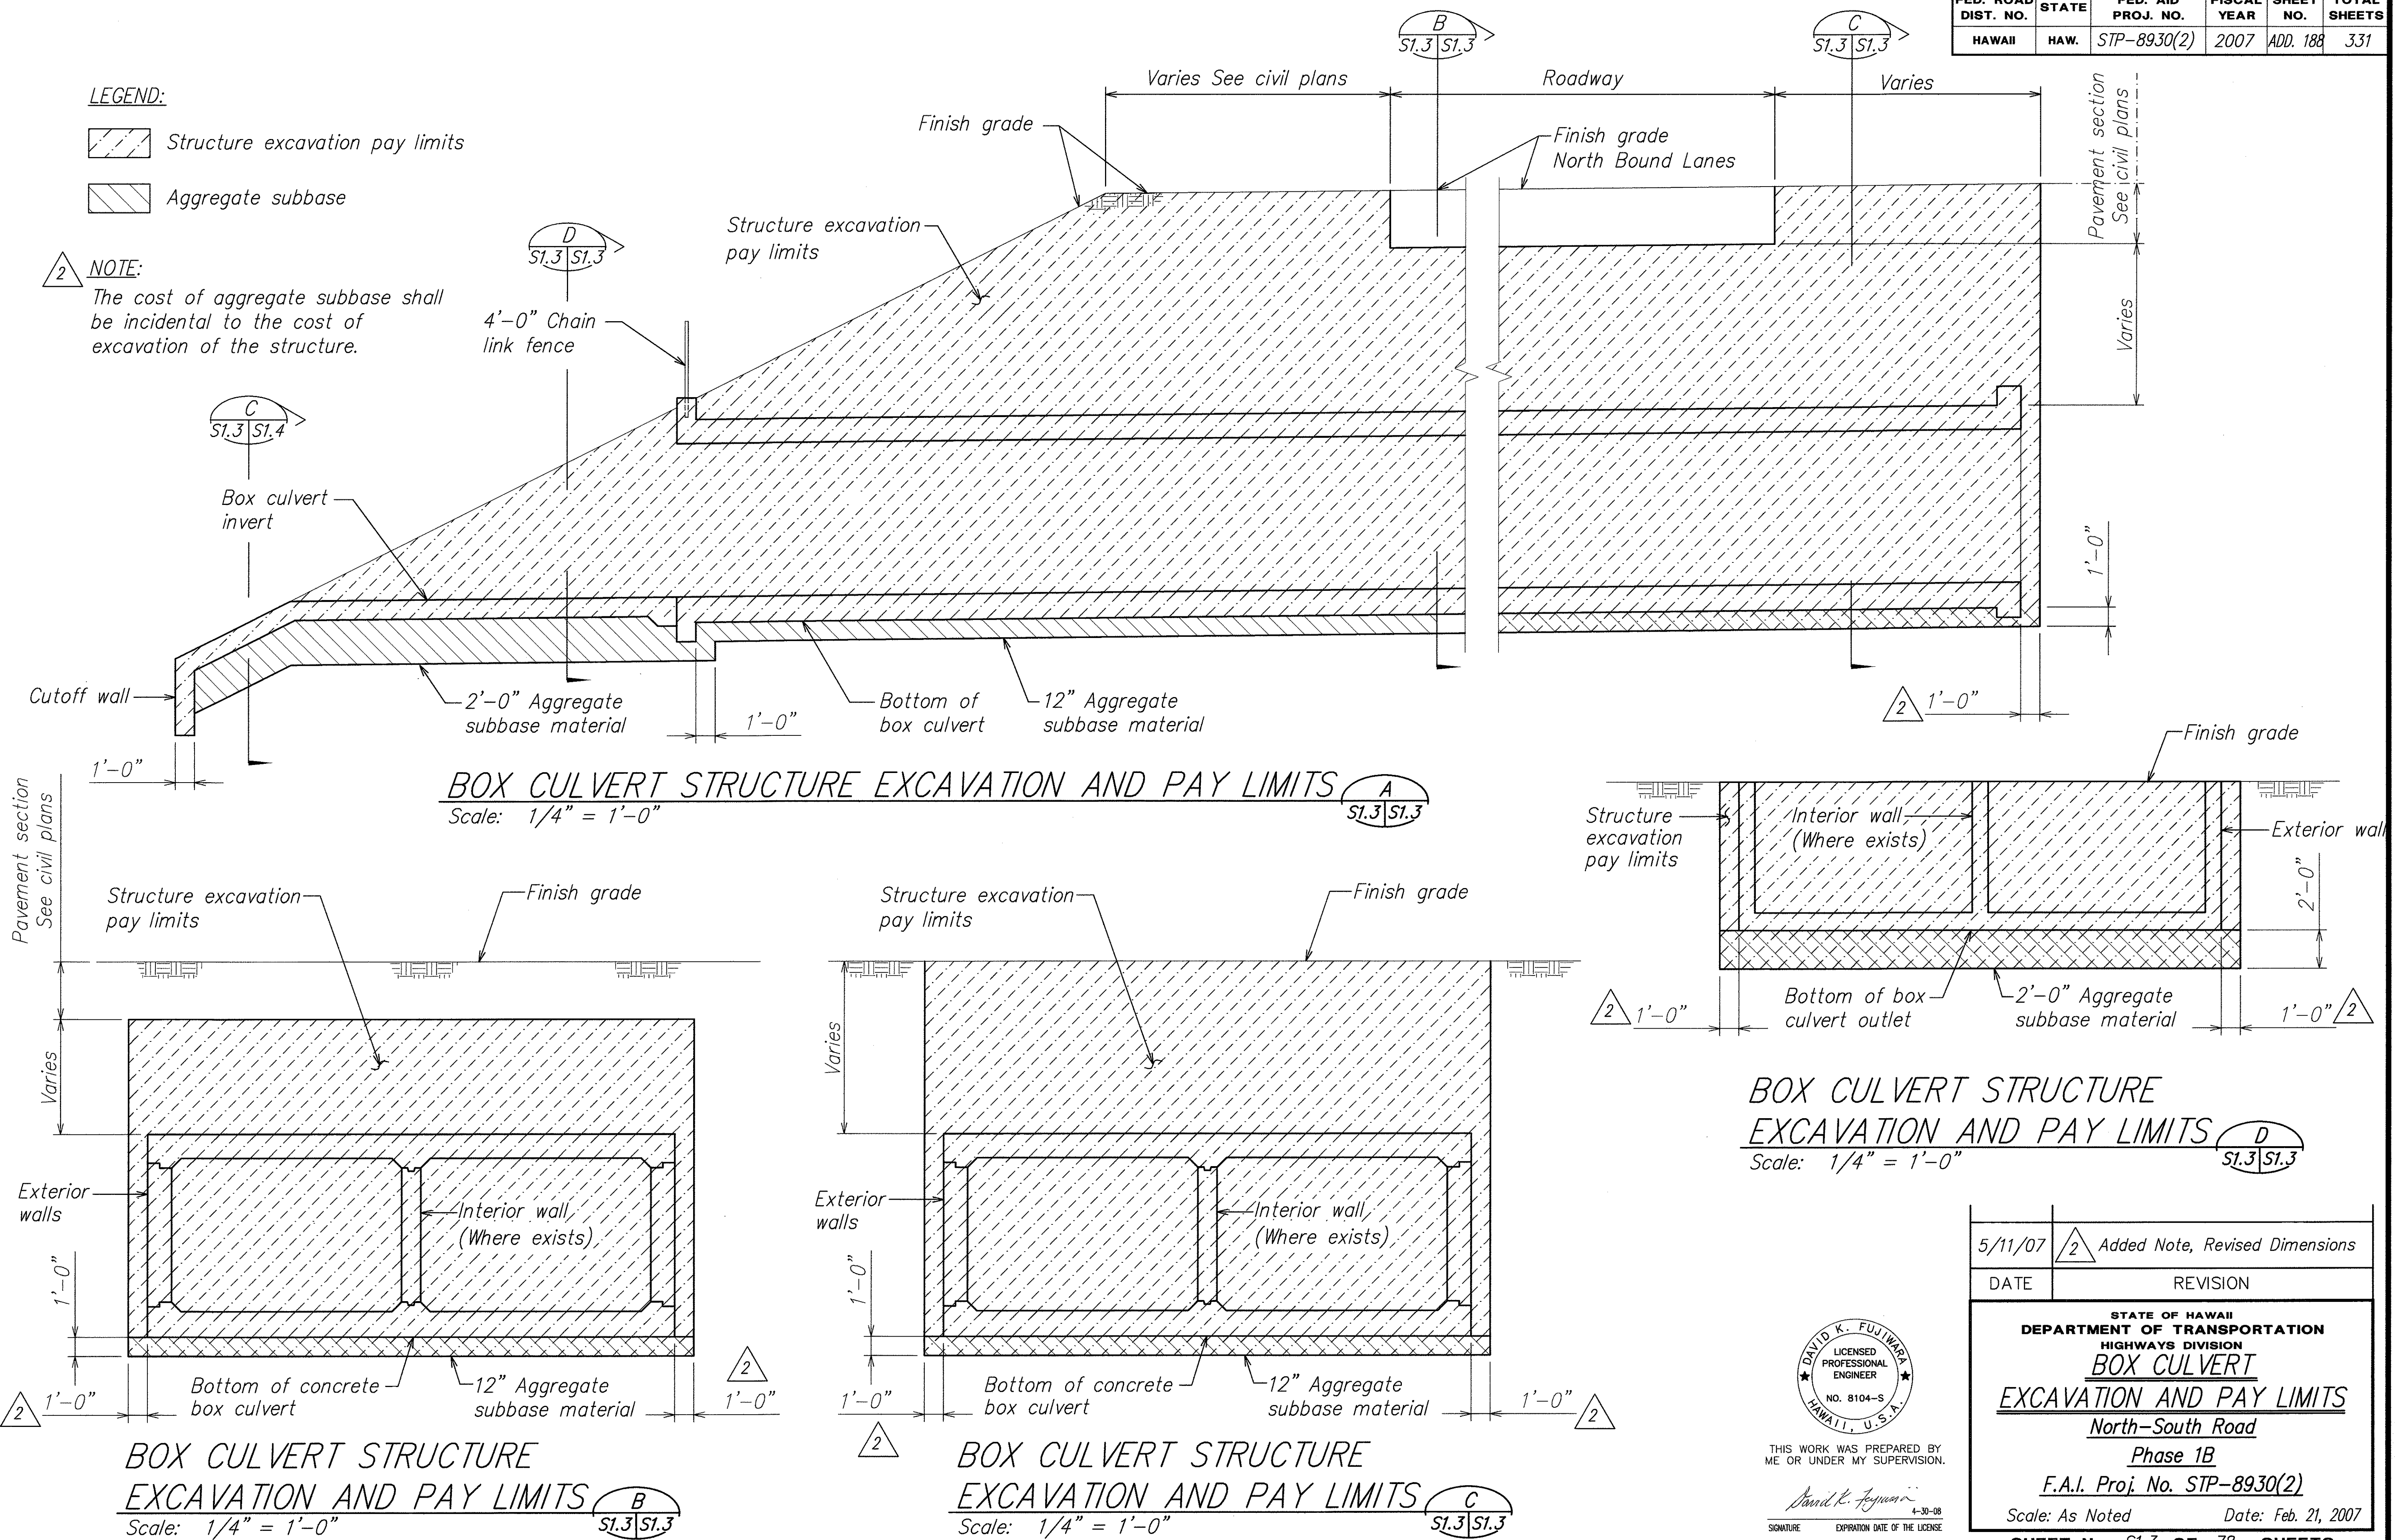

ORIGINAL PLAN	DATE
DRAWN BY	DESIGNED BY
NOTED BY	CHECKED BY
NO.	

DAVID K. FUJIMURA
LICENSED PROFESSIONAL ENGINEER
NO. 8104-S
HAWAII, U.S.A.

THIS WORK WAS PREPARED BY ME OR UNDER MY SUPERVISION.

SIGNATURE: *David K. Fujimura* EXPIRATION DATE OF THE LICENSE: 4-30-08

5/11/07	2	Added Note, Revised Dimensions
DATE	REVISION	
STATE OF HAWAII DEPARTMENT OF TRANSPORTATION HIGHWAYS DIVISION <u>BOX CULVERT</u> <u>EXCAVATION AND PAY LIMITS</u> <u>North-South Road</u> <u>Phase 1B</u> <u>F.A.I. Proj. No. STP-8930(2)</u> Scale: As Noted Date: Feb. 21, 2007		
SHEET No. S1.3 OF 78 SHEETS		