


SECTION — CATCH BASIN CURB AND GUTTER

Scale: 1" = 1'-0"

Seale: 1" = 1'-0"

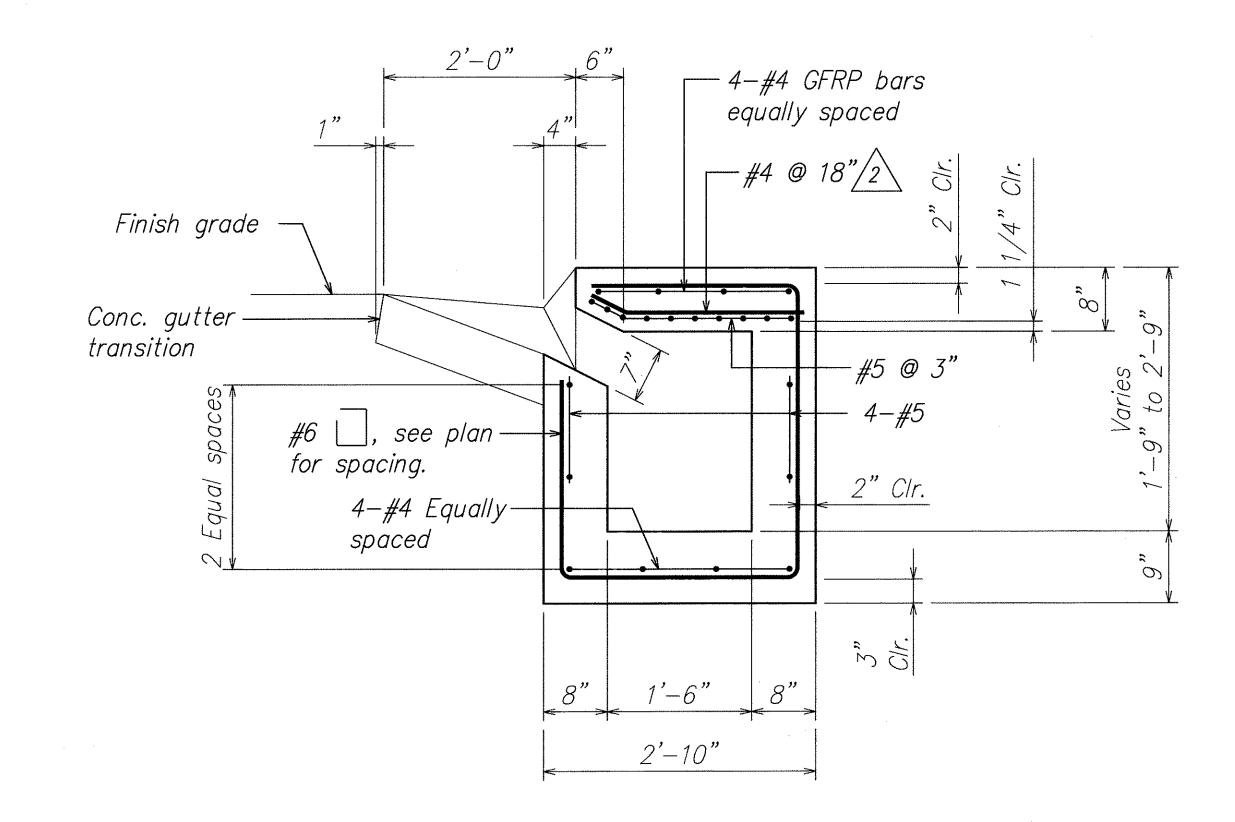

<u>SECTION — 2AG CURB AND GUTTER 2</u> Scale: 1" = 1'-0" <u>\$6.1</u> S6.12

LICENSED
PROFESSIONAL
ENGINEER

Jand K. Feynuas 4-30-08
TURE EXPIRATION DATE OF THE LICENSE

5/11/07 2 Revised Reinforcing REVISION DATE DEPARTMENT OF TRANSPORTATION
HIGHWAYS DIVISION
DRAINAGE STRUCTURE TYPICAL DETAILS North-South Road Phase 1B F.A.I. Proj. No. STP-8930(2) Scale: As Noted Date: Feb. 21, 2007 SHEET No. S6.12 OF 78 SHEETS

FED. AID PROJ. NO.

HAW. STP-8930(2) 2007 ADD. 247 331

ADD. 247

THIS WORK WAS PREPARED BY ME OR UNDER MY SUPERVISION.