

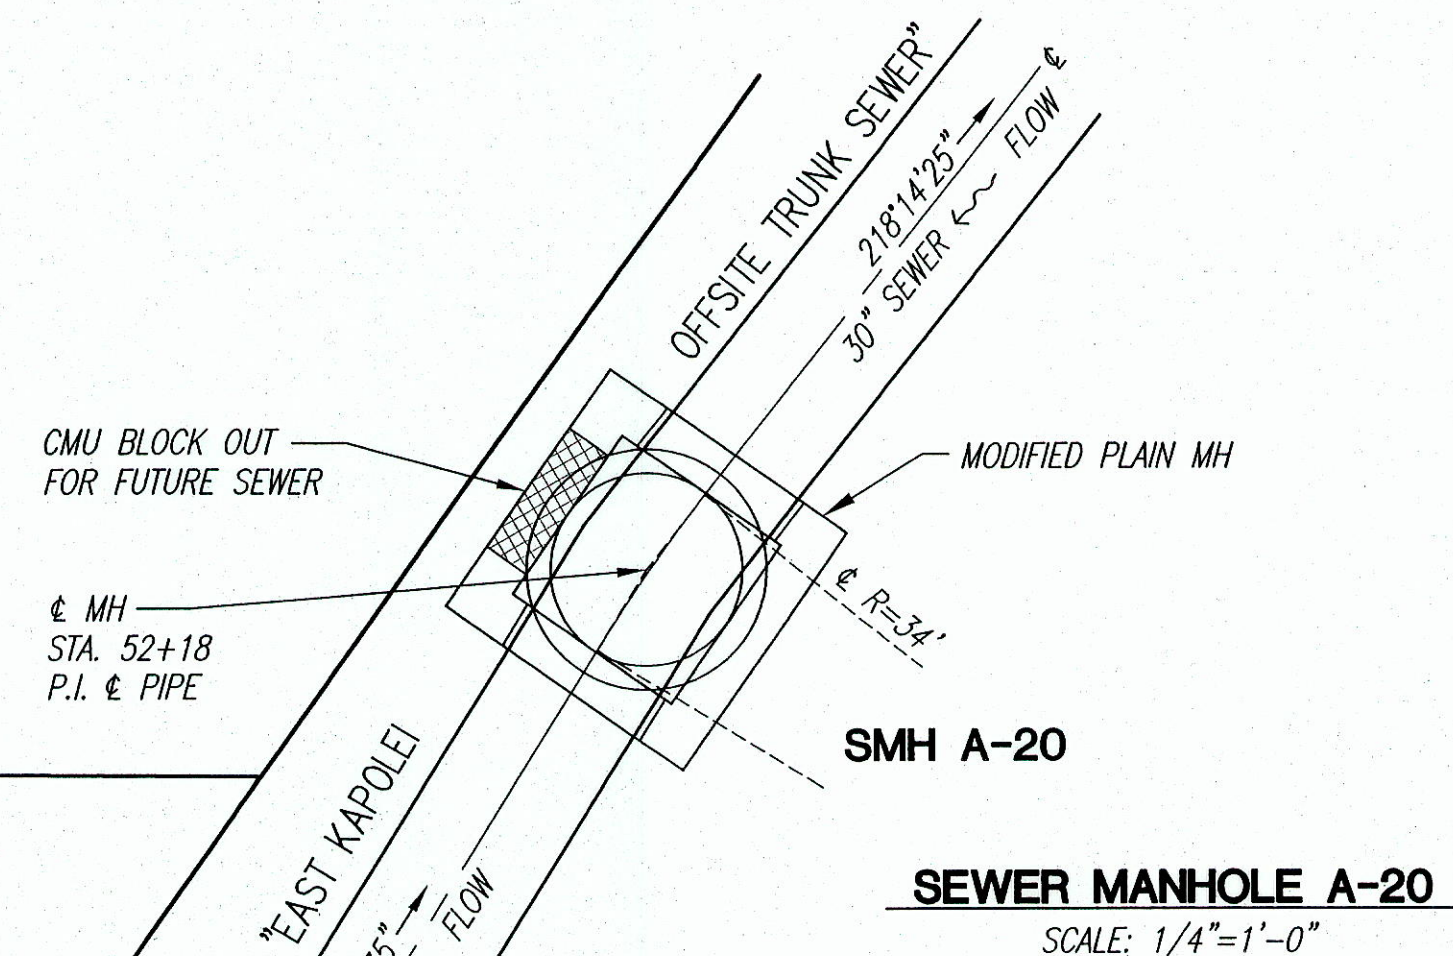
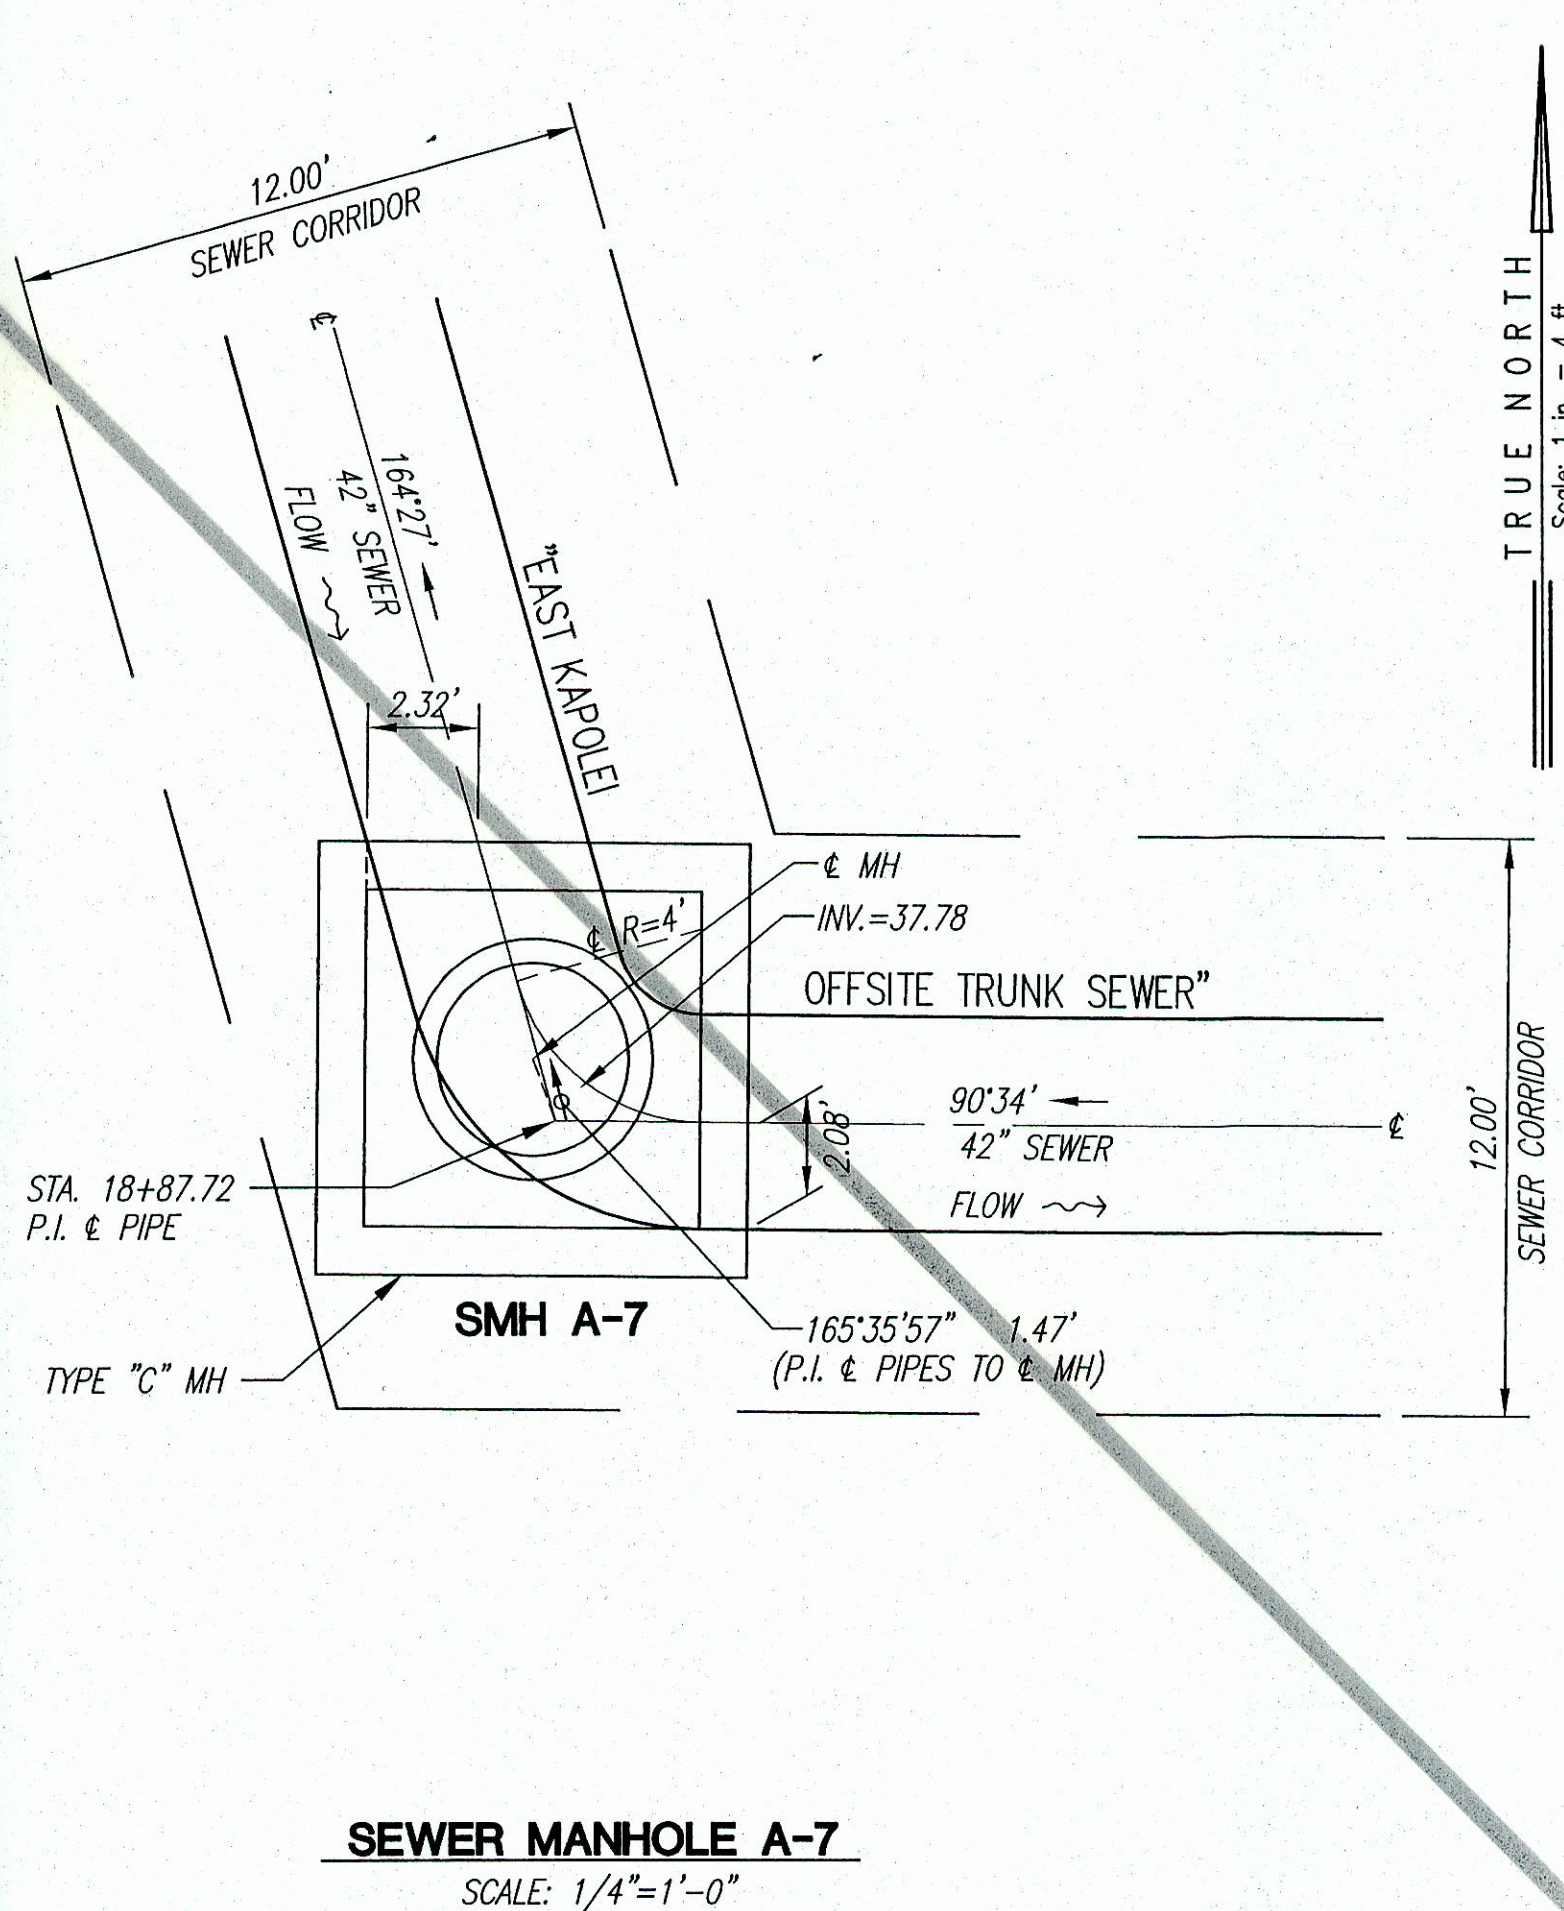
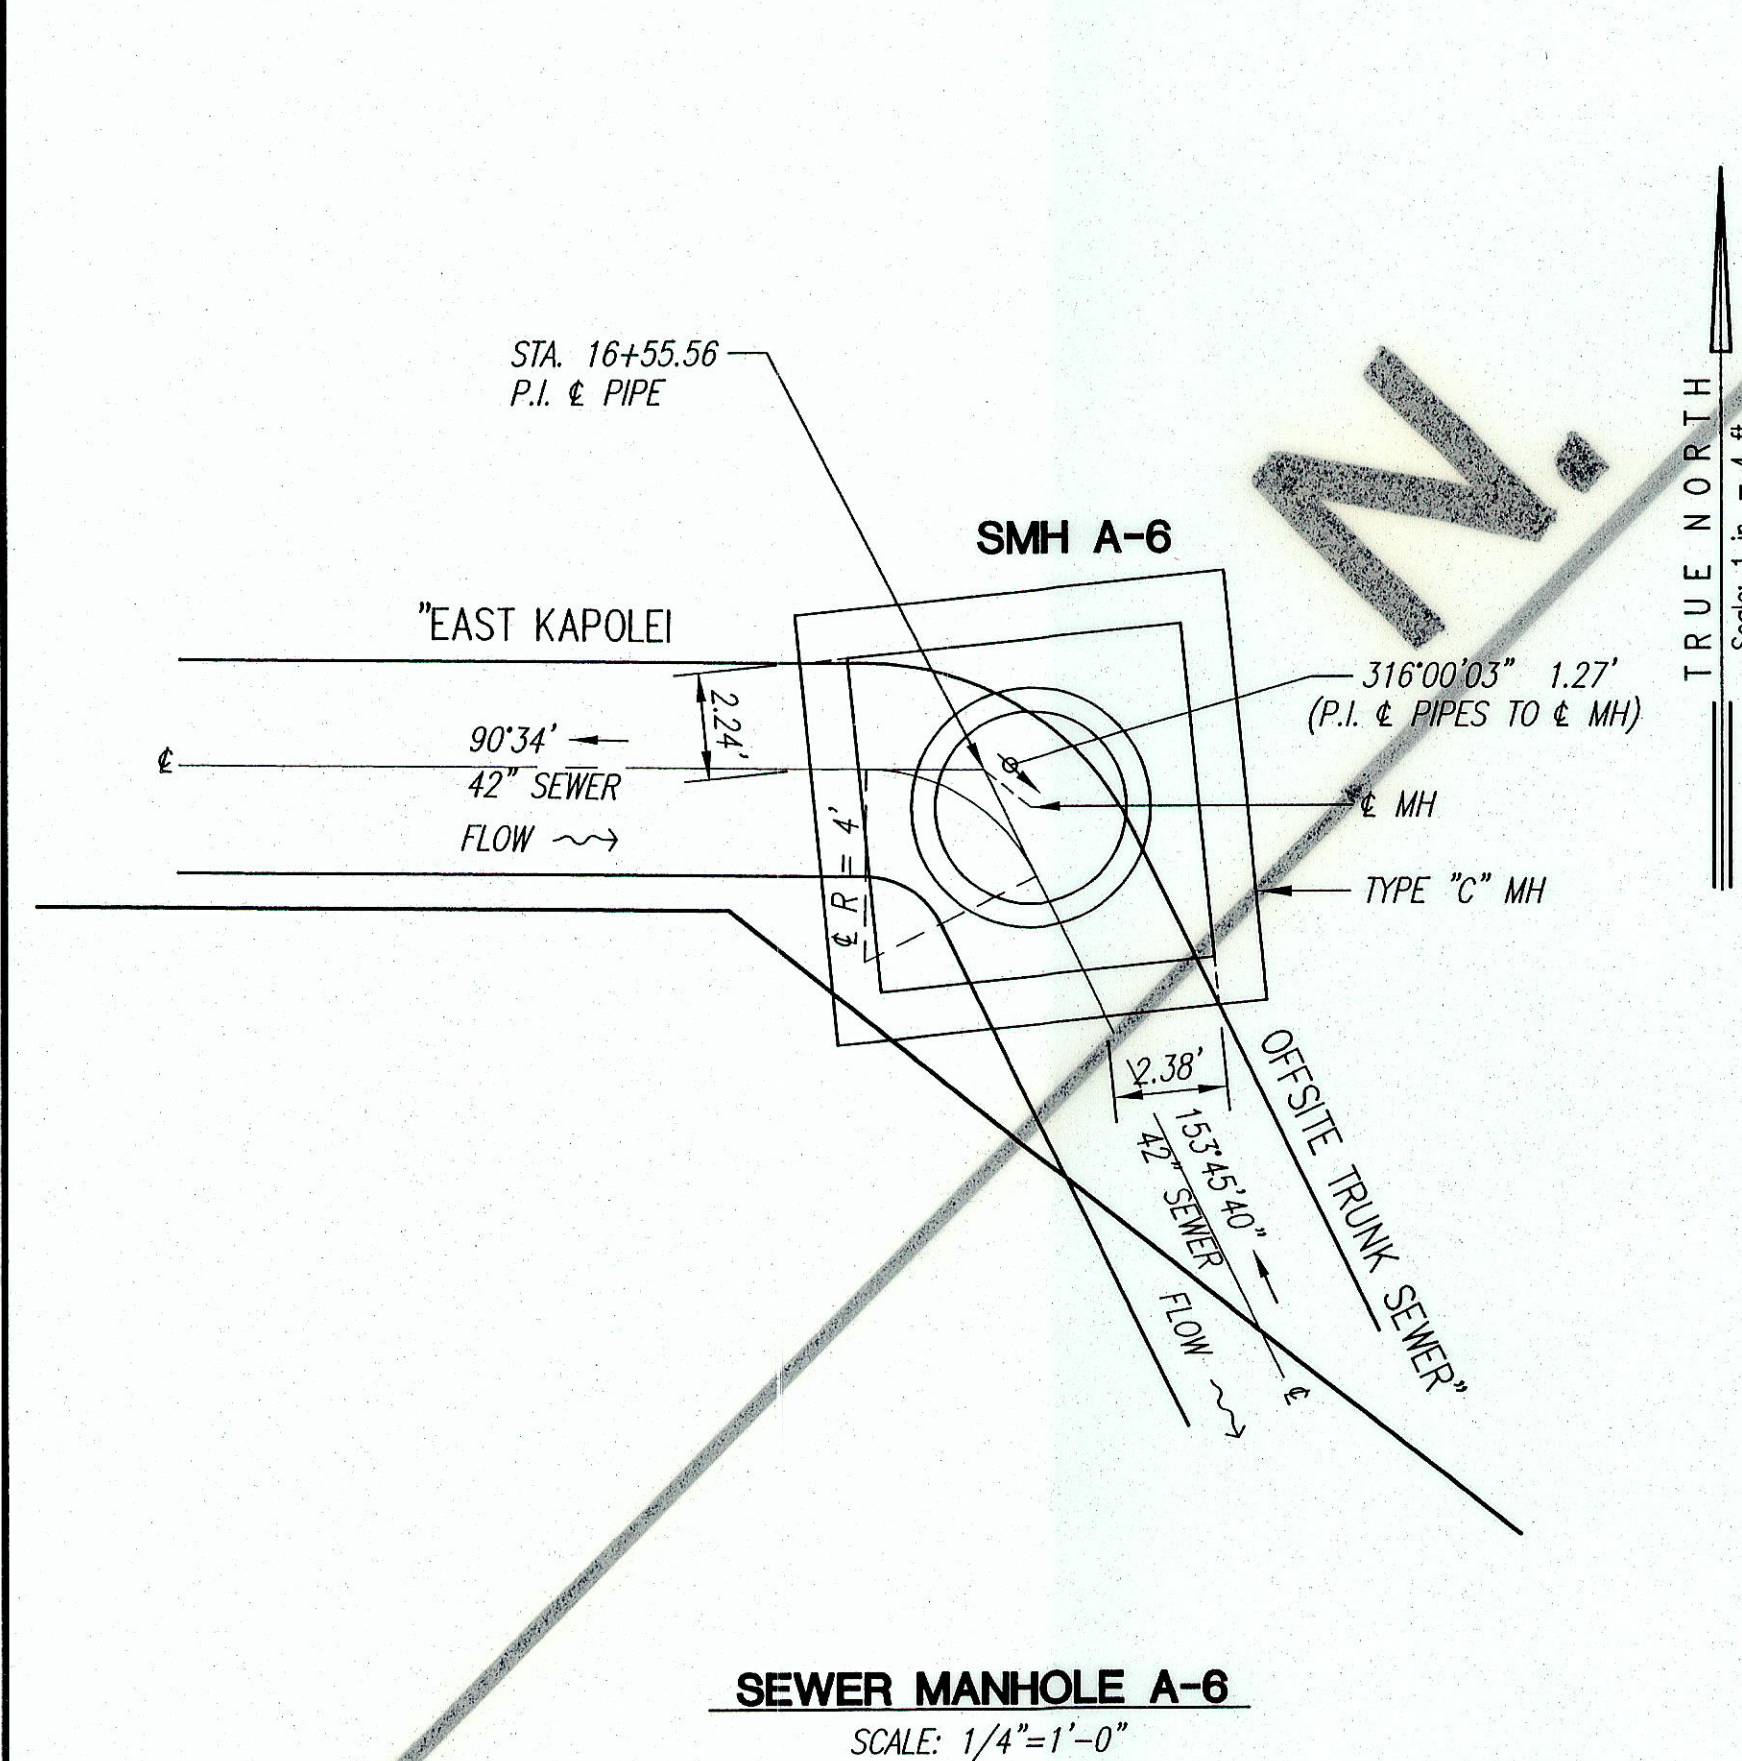
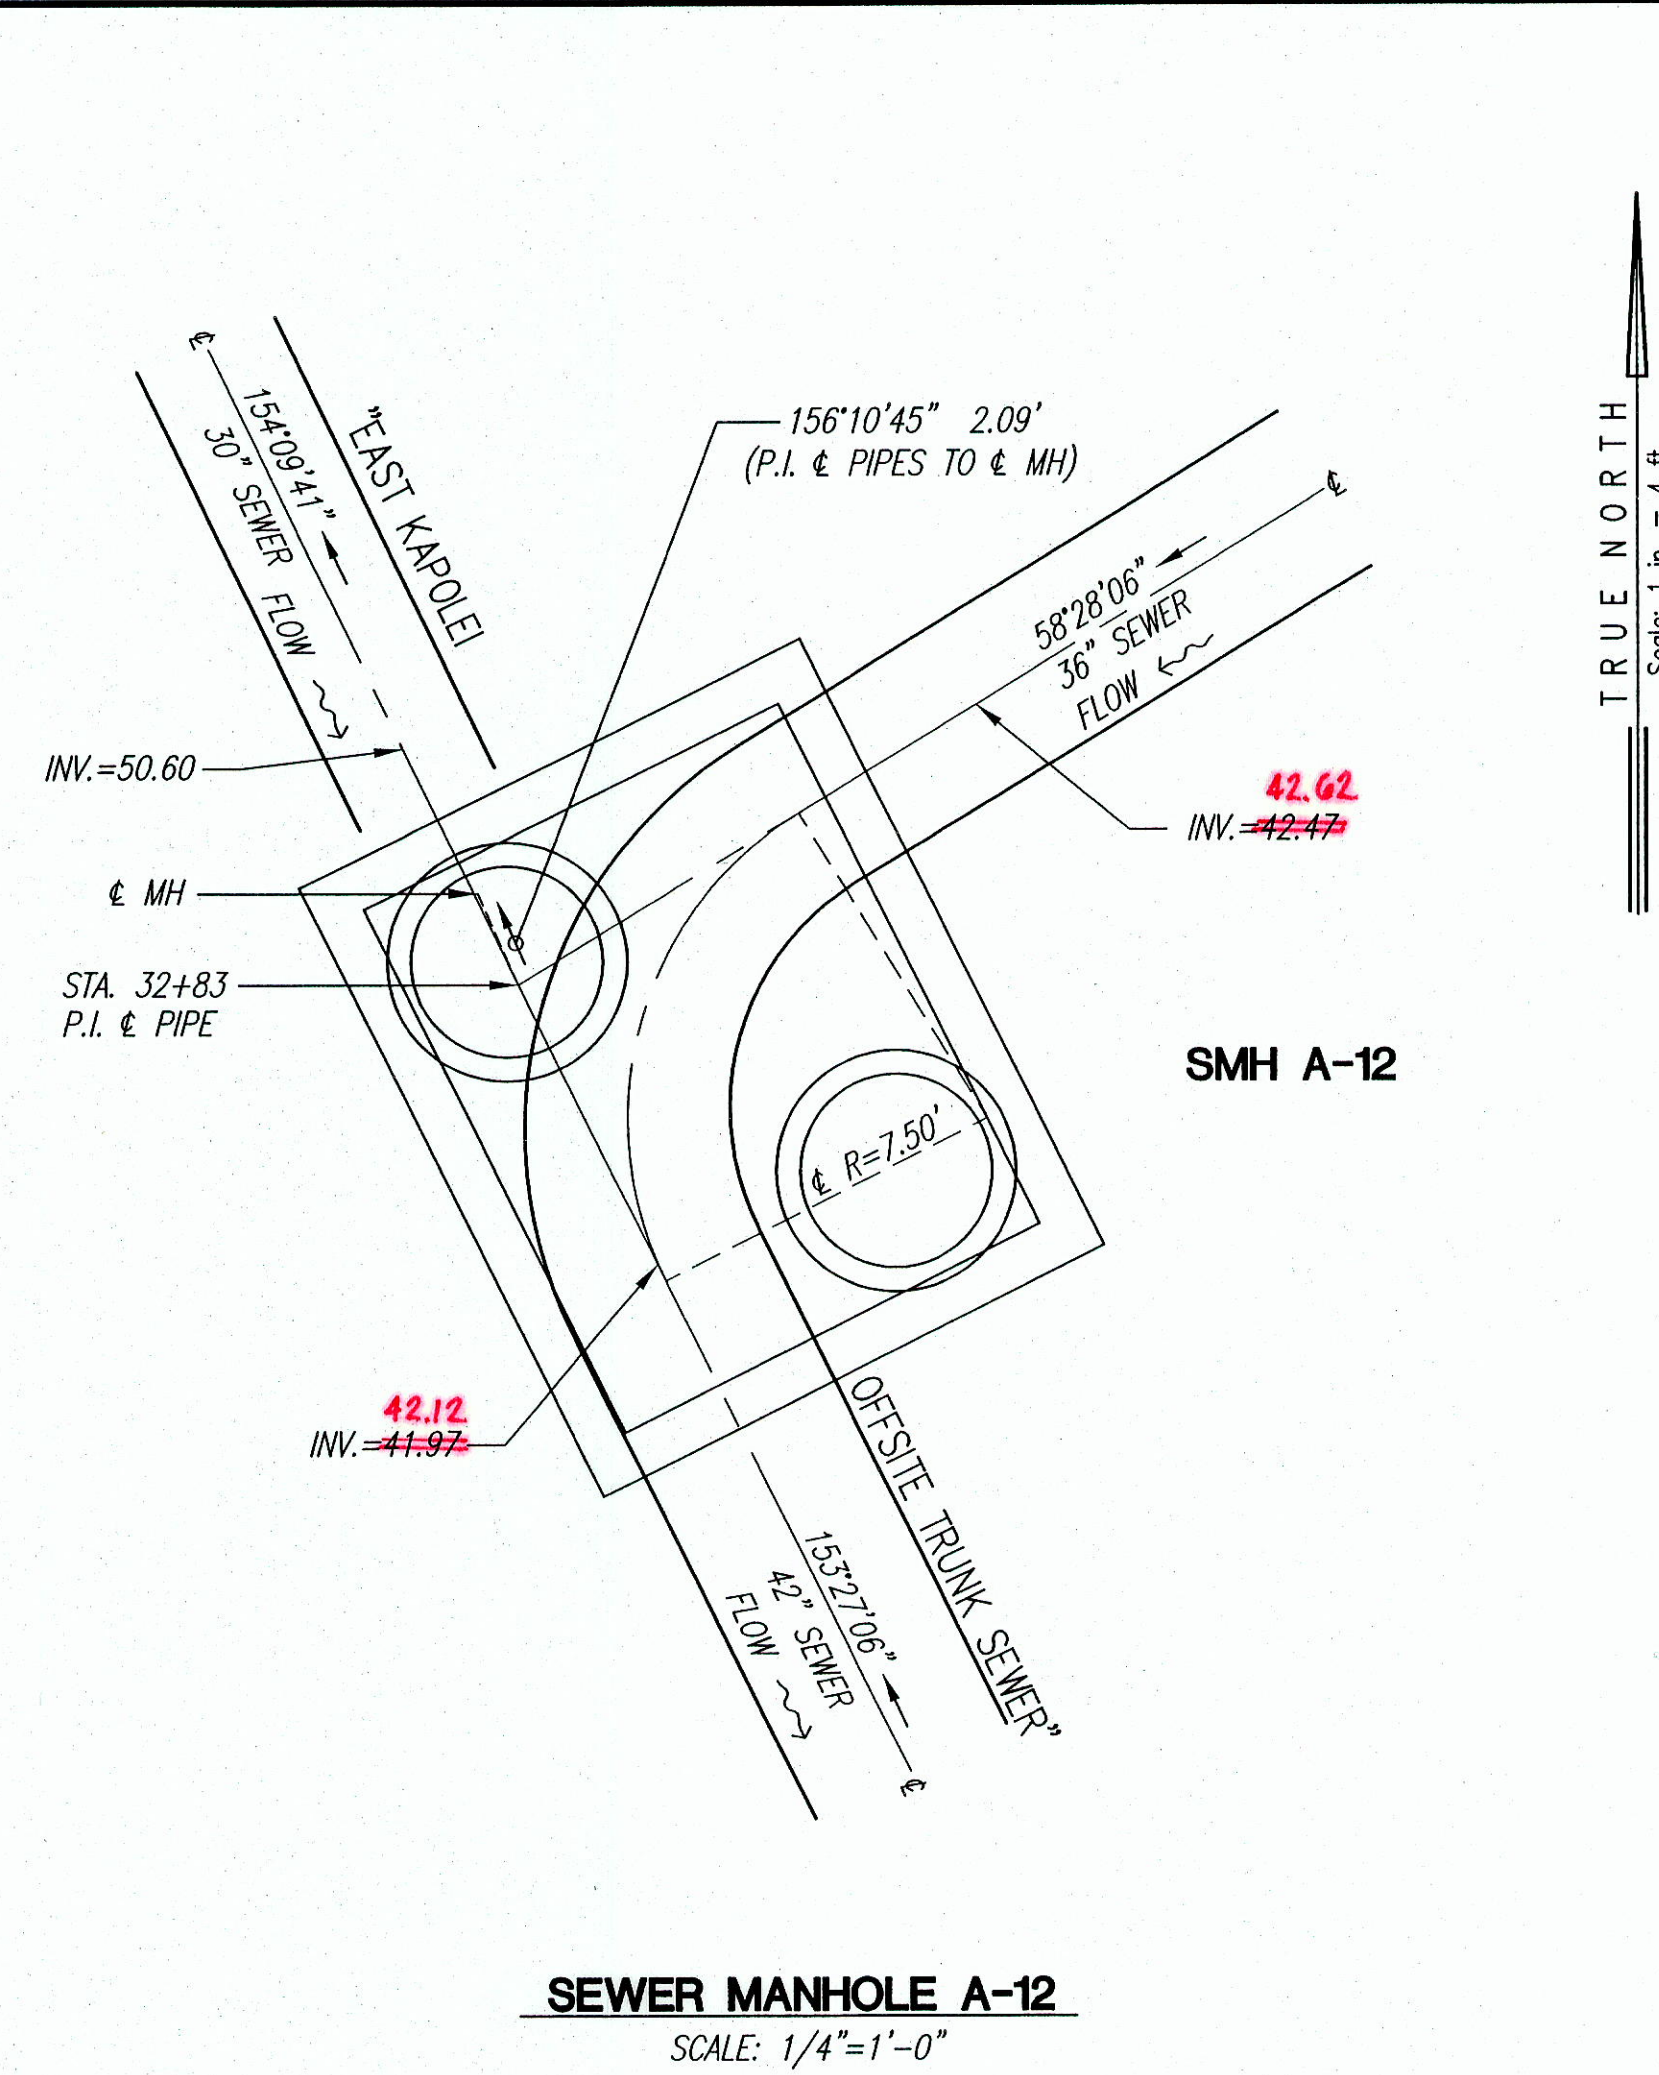
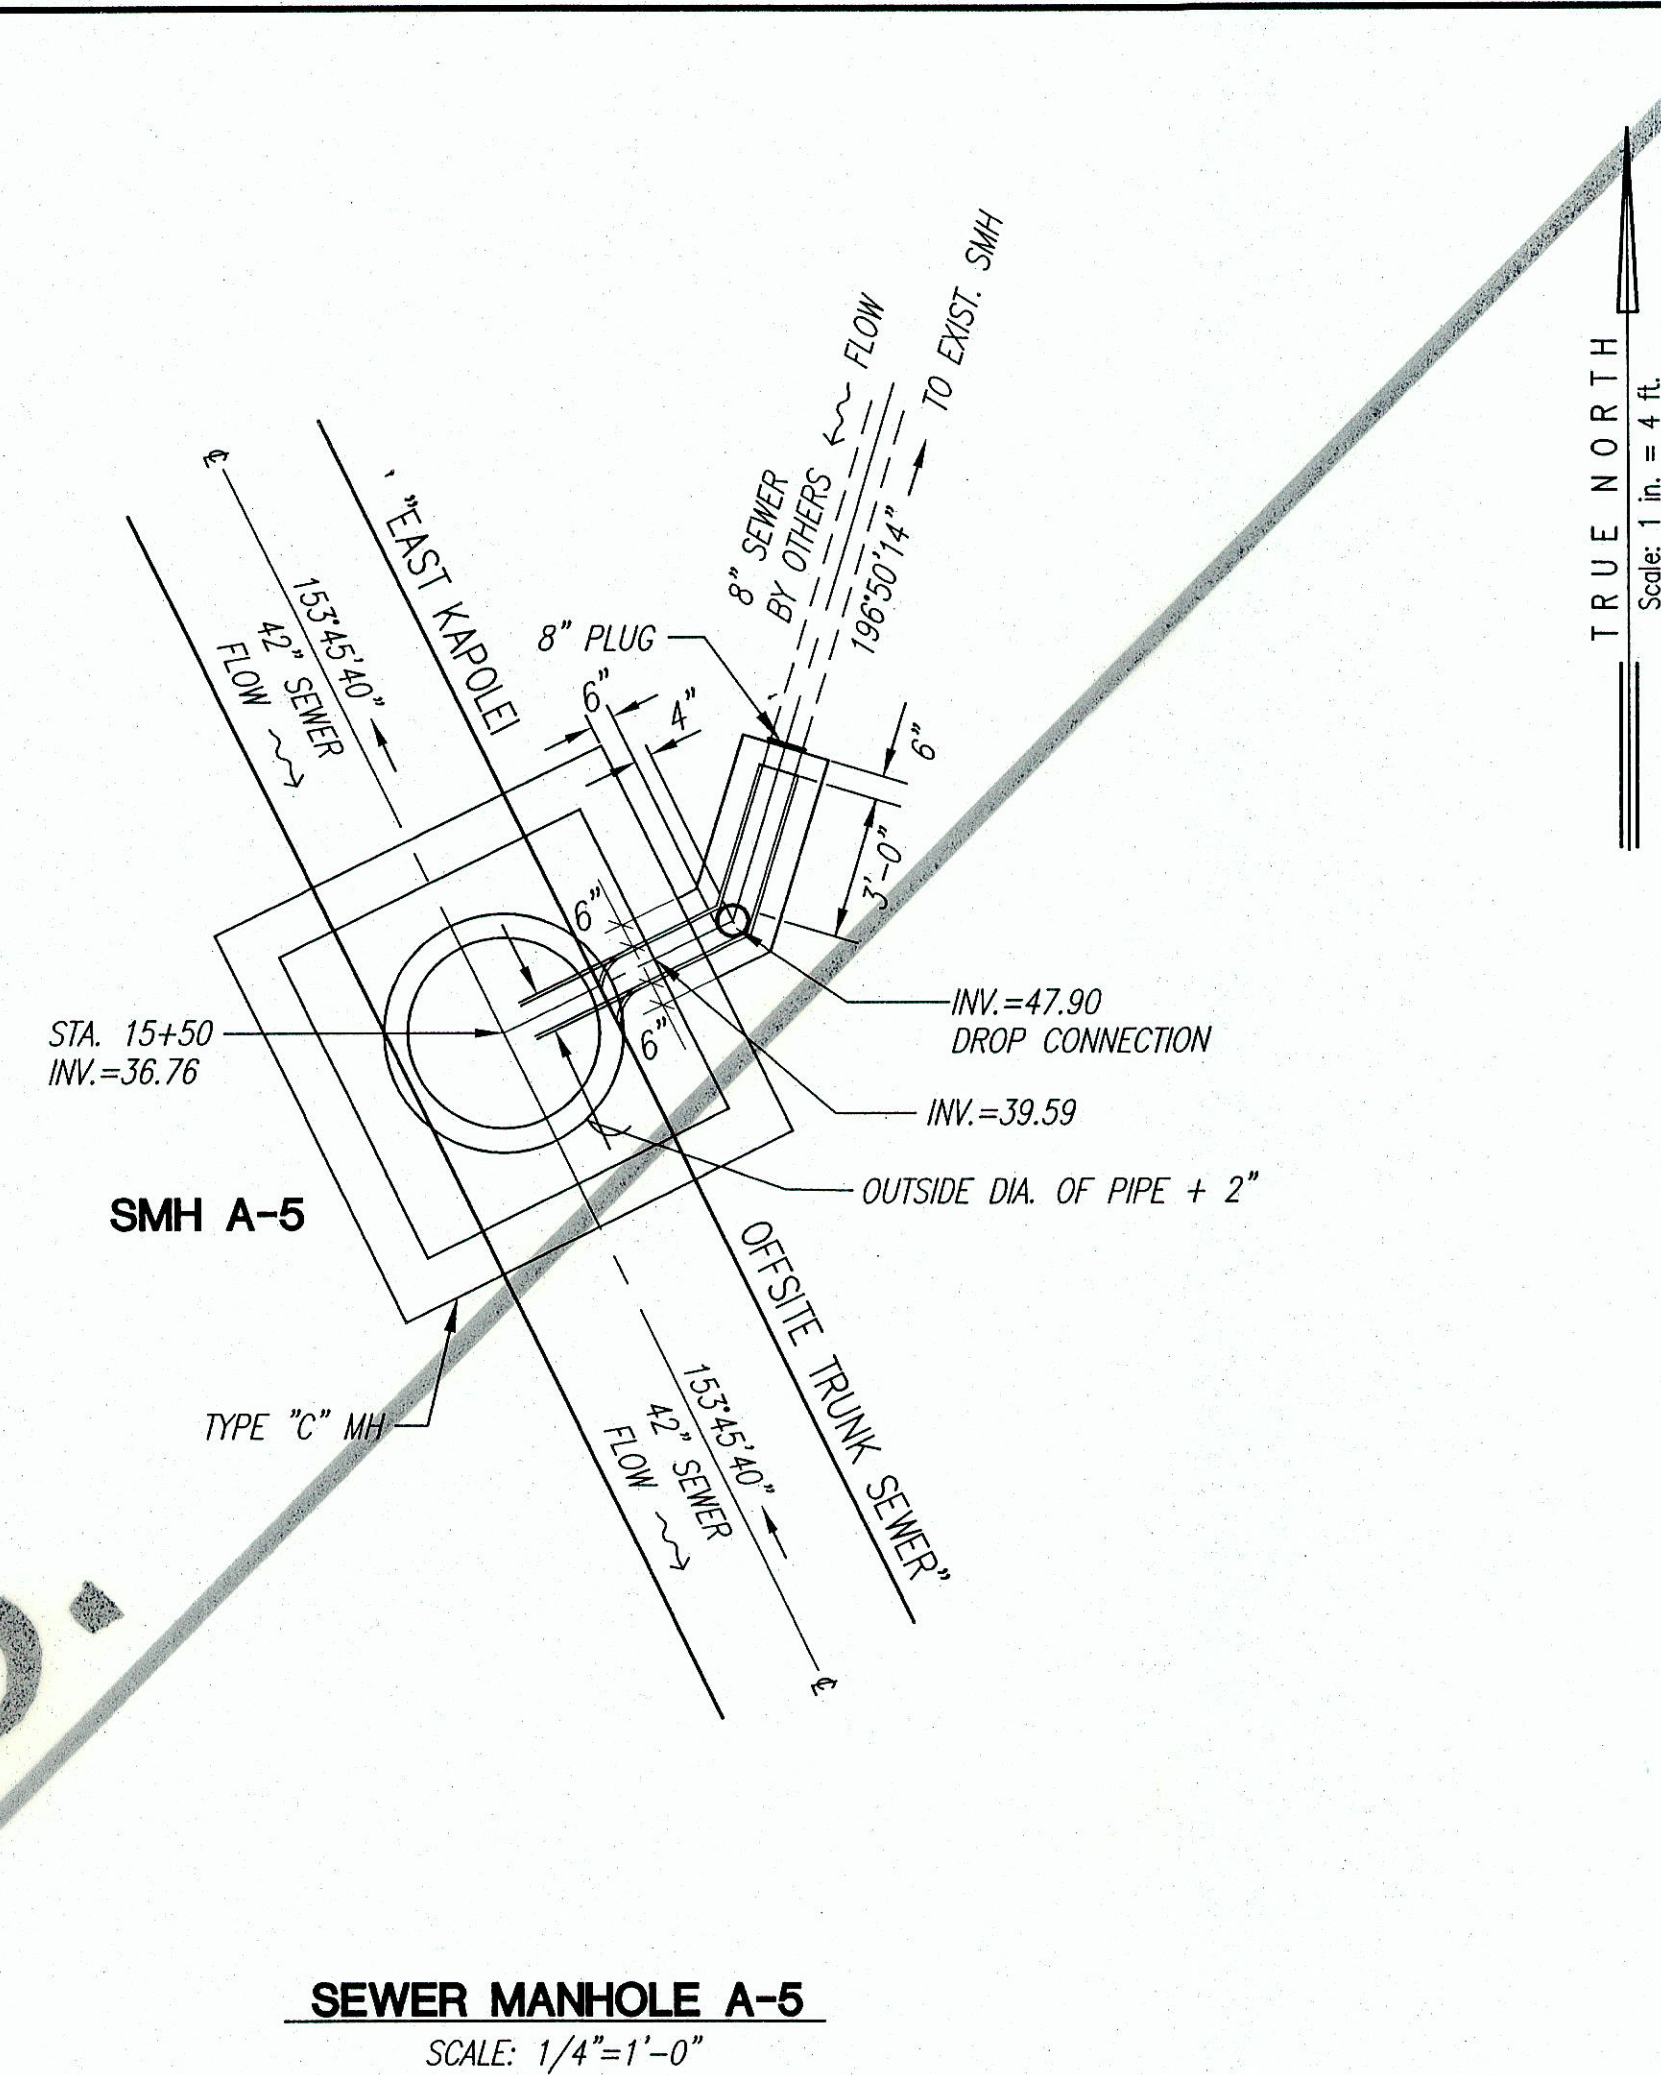


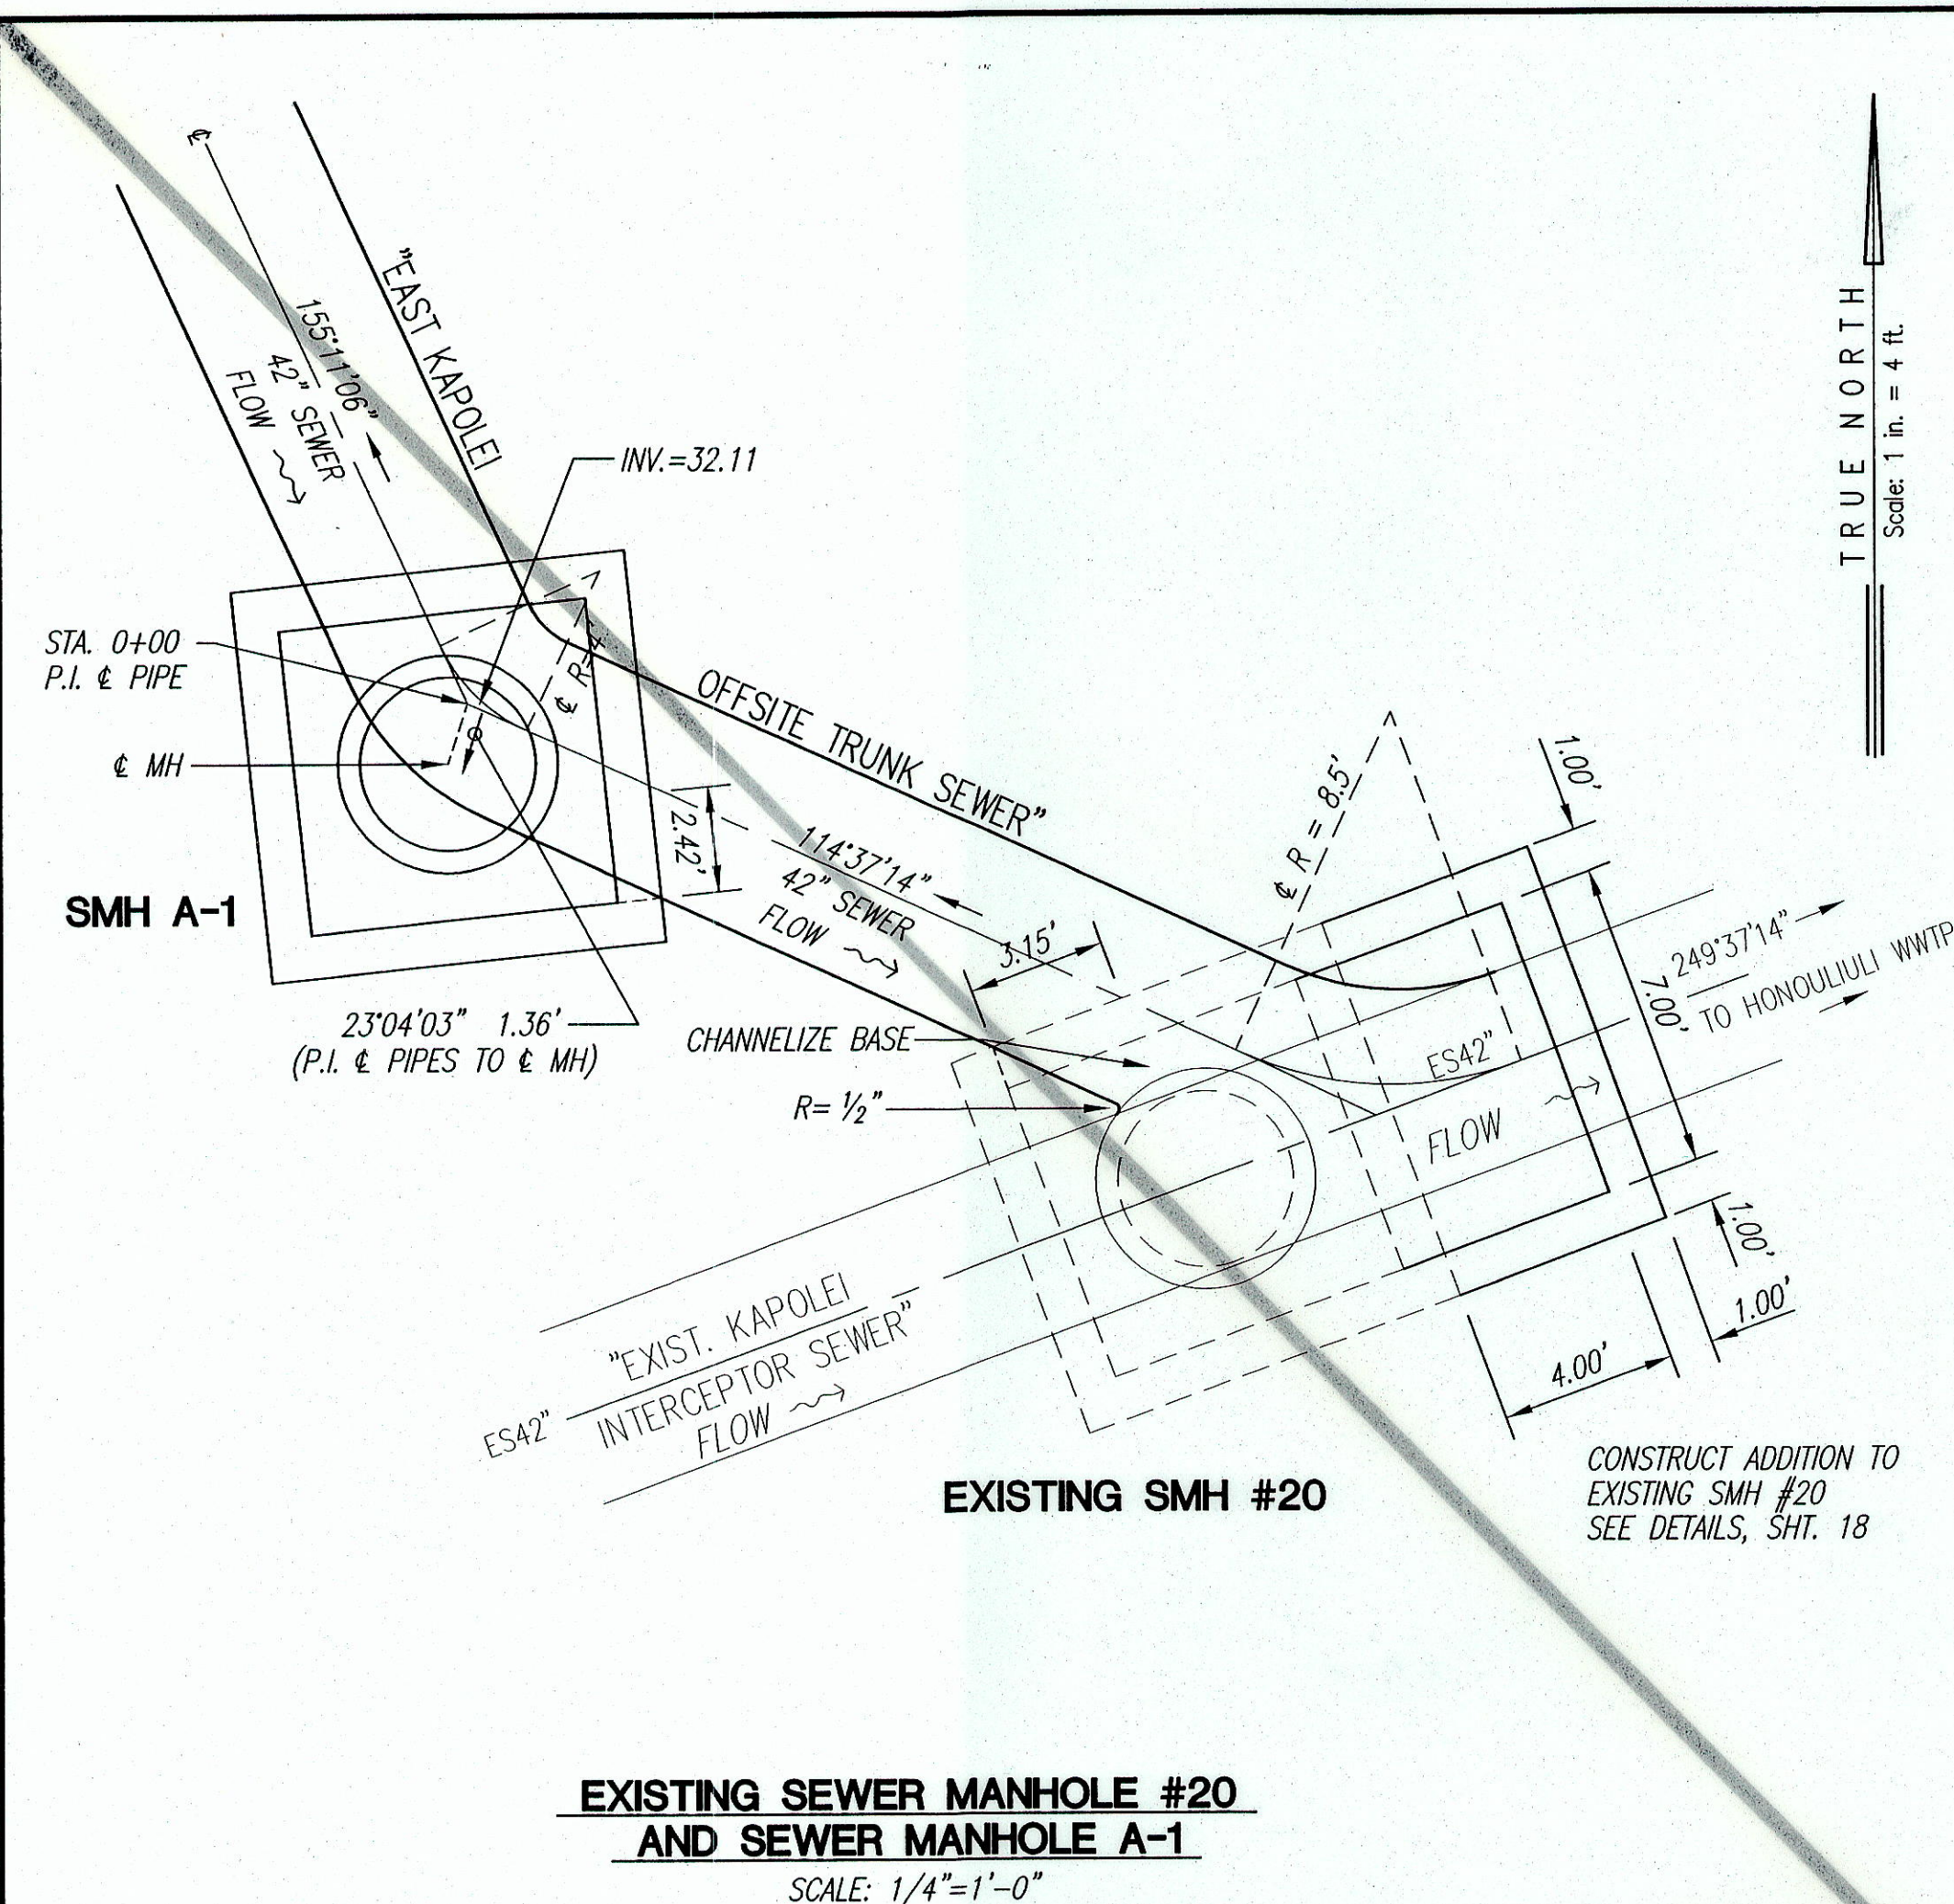

THIS WORK WAS PREPARED BY ME OR UNDER MY SUPERVISION. CONSTRUCTION OF THIS PROJECT WILL BE UNDER MY OBSERVATION. LICENSE EXPIRATION DATE: 04/30/08

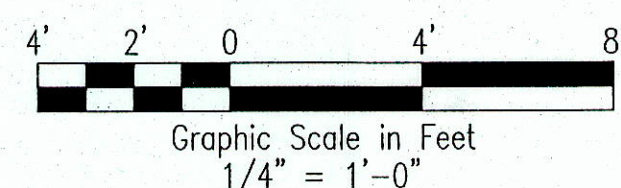

5/11/07	APPVD. DWG.		
REVISION DATE	DESCRIPTION	MADE BY	APPROVED
Community Planning and Engineering, Inc. Engineering Design Construction Management Infrastructure Planning 1100 Alakea Street, Sixth Floor Honolulu, Hawaii			
EAST KAPOLEI OFFSITE TRUNK SEWER (DPP SUBD. FILE NO. 2006/SUB-308) HONOLULU, EWA, OAHU, HAWAII OWNER & DEVELOPER: DEPARTMENT OF HAWAIIAN HOME LANDS TAX MAP KEYS: 9-1-16 : Por. 27, 31, Por. 108, 109 9-1-69 : Por. 1			
SEWER MANHOLE PIPE CONNECTIONS			
DRAWN BY: SWE	ENGINEER: SES	CHECKED BY: CMS	
APPROVED:			
Dennis M. Nuhonim CHIEF, WASTEWATER BRANCH, D.P.P.			4/9/07 DATE