


FED. ROAD DIST. NO.	STATE	FED. AID PROJ. NO.	FISCAL YEAR	SHEET NO.	TOTAL SHEETS
HAWAII	HAW.	STP-8930(2)	2007	ADD. 91	331




- Notes:**
- All Striping Shall be Tape, Type I, Type III or Thermoplastic Extrusion
  - For Typical Crosswalk Layout Detail, See Sht. C7.15

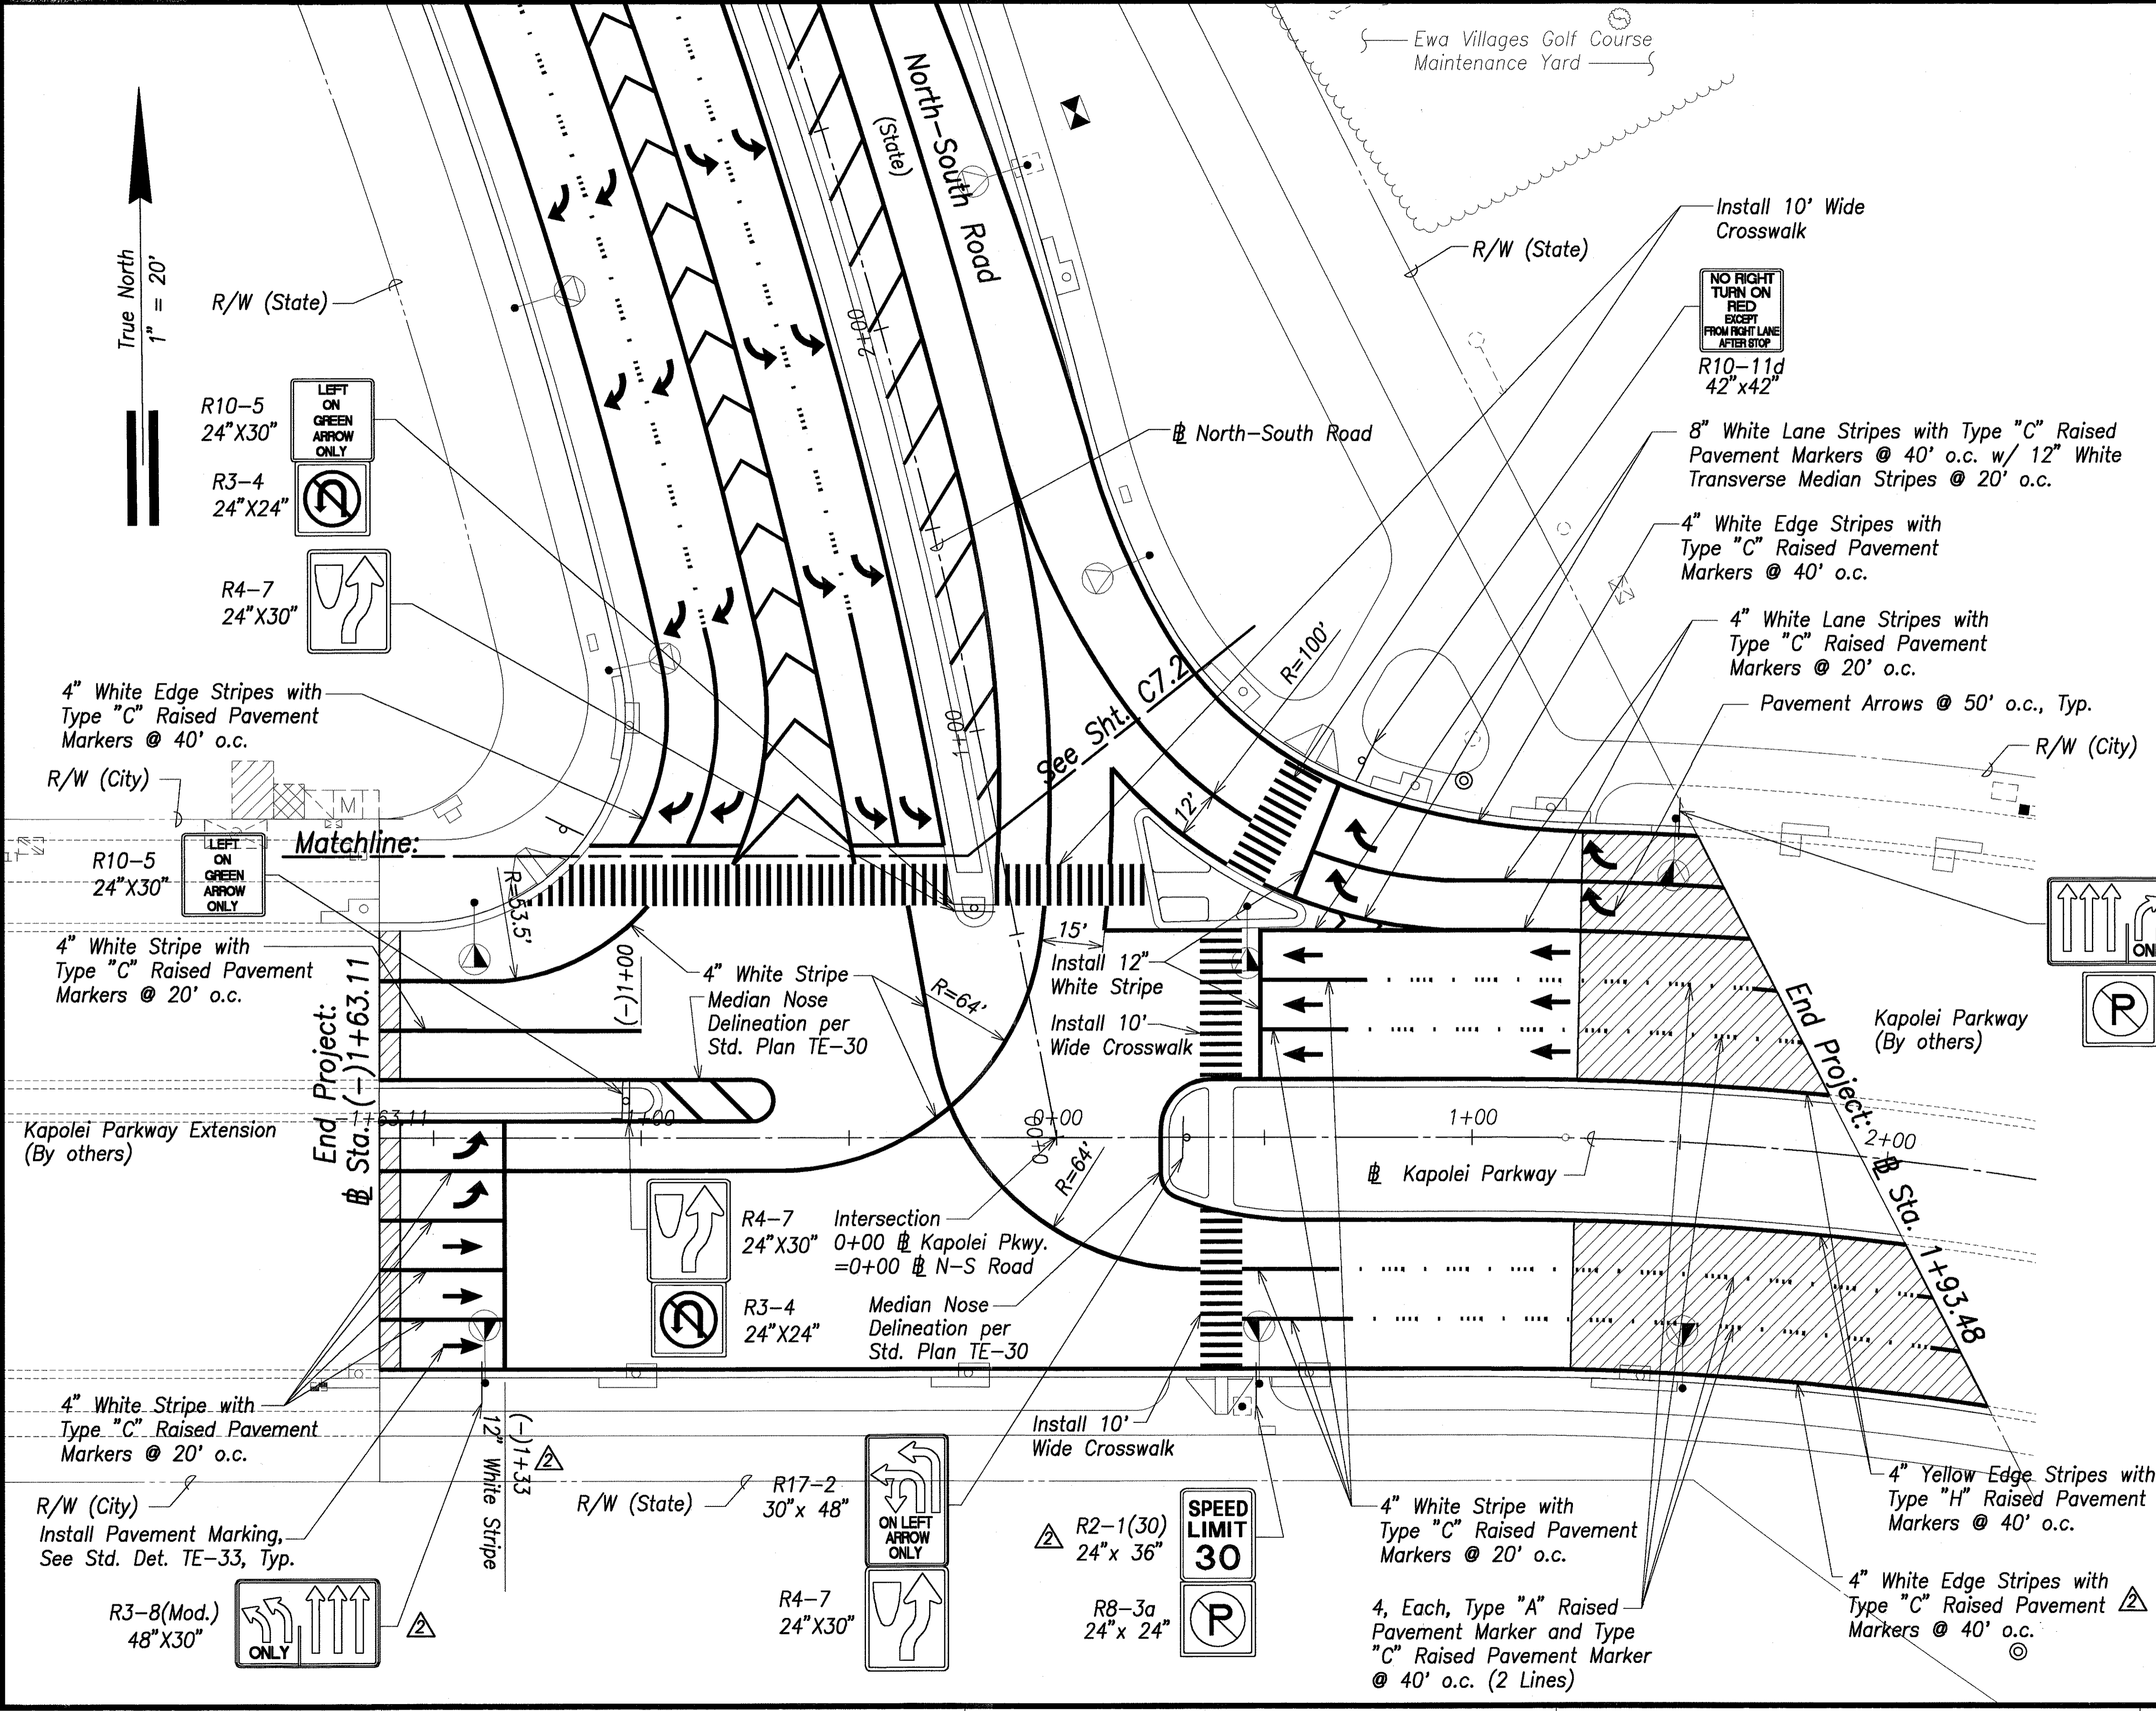

THIS WORK WAS PREPARED BY ME OR UNDER MY SUPERVISION.

Signature: Greg A. Hiyaokunio, APR 30, 2008, DATE OF LICENSE EXPIRY

Graphic Scale:

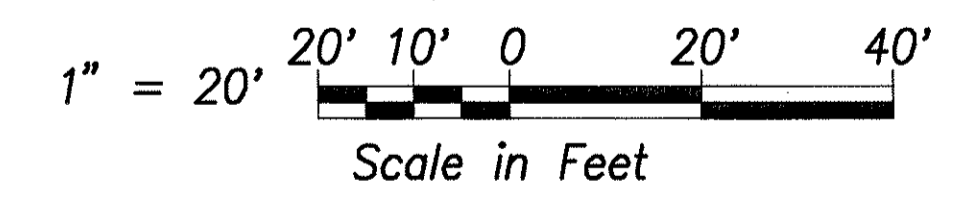

5/11/07	2	Added or Revised Signs & Markings
DATE		REVISION
STATE OF HAWAII DEPARTMENT OF TRANSPORTATION HIGHWAYS DIVISION <b>KAPOLEI PARKWAY INTERSECTION</b> <b>SIGNING &amp; STRIPING PLAN</b> North-South Road Phase 1B F.A.I. Proj. No. STP-8930(2)		
Scale: As Shown		Date: Feb 21, 2007
SHEET No. C7.1 OF 150 SHEETS		

DATE	
SURVEY PLOTTED BY	
DRAWN BY	
TRACED BY	
DESIGNED BY	
QUANTITIES BY	
CHECKED BY	
ORIGINAL PLAN	
NOTE BOOK	
No.	