



FED. ROAD DIST. NO.	STATE	FED. AID PROJ. NO.	FISCAL YEAR	SHEET NO.	TOTAL SHEETS
HAWAII	HAW.	STP-8930(2)	2007	256	331

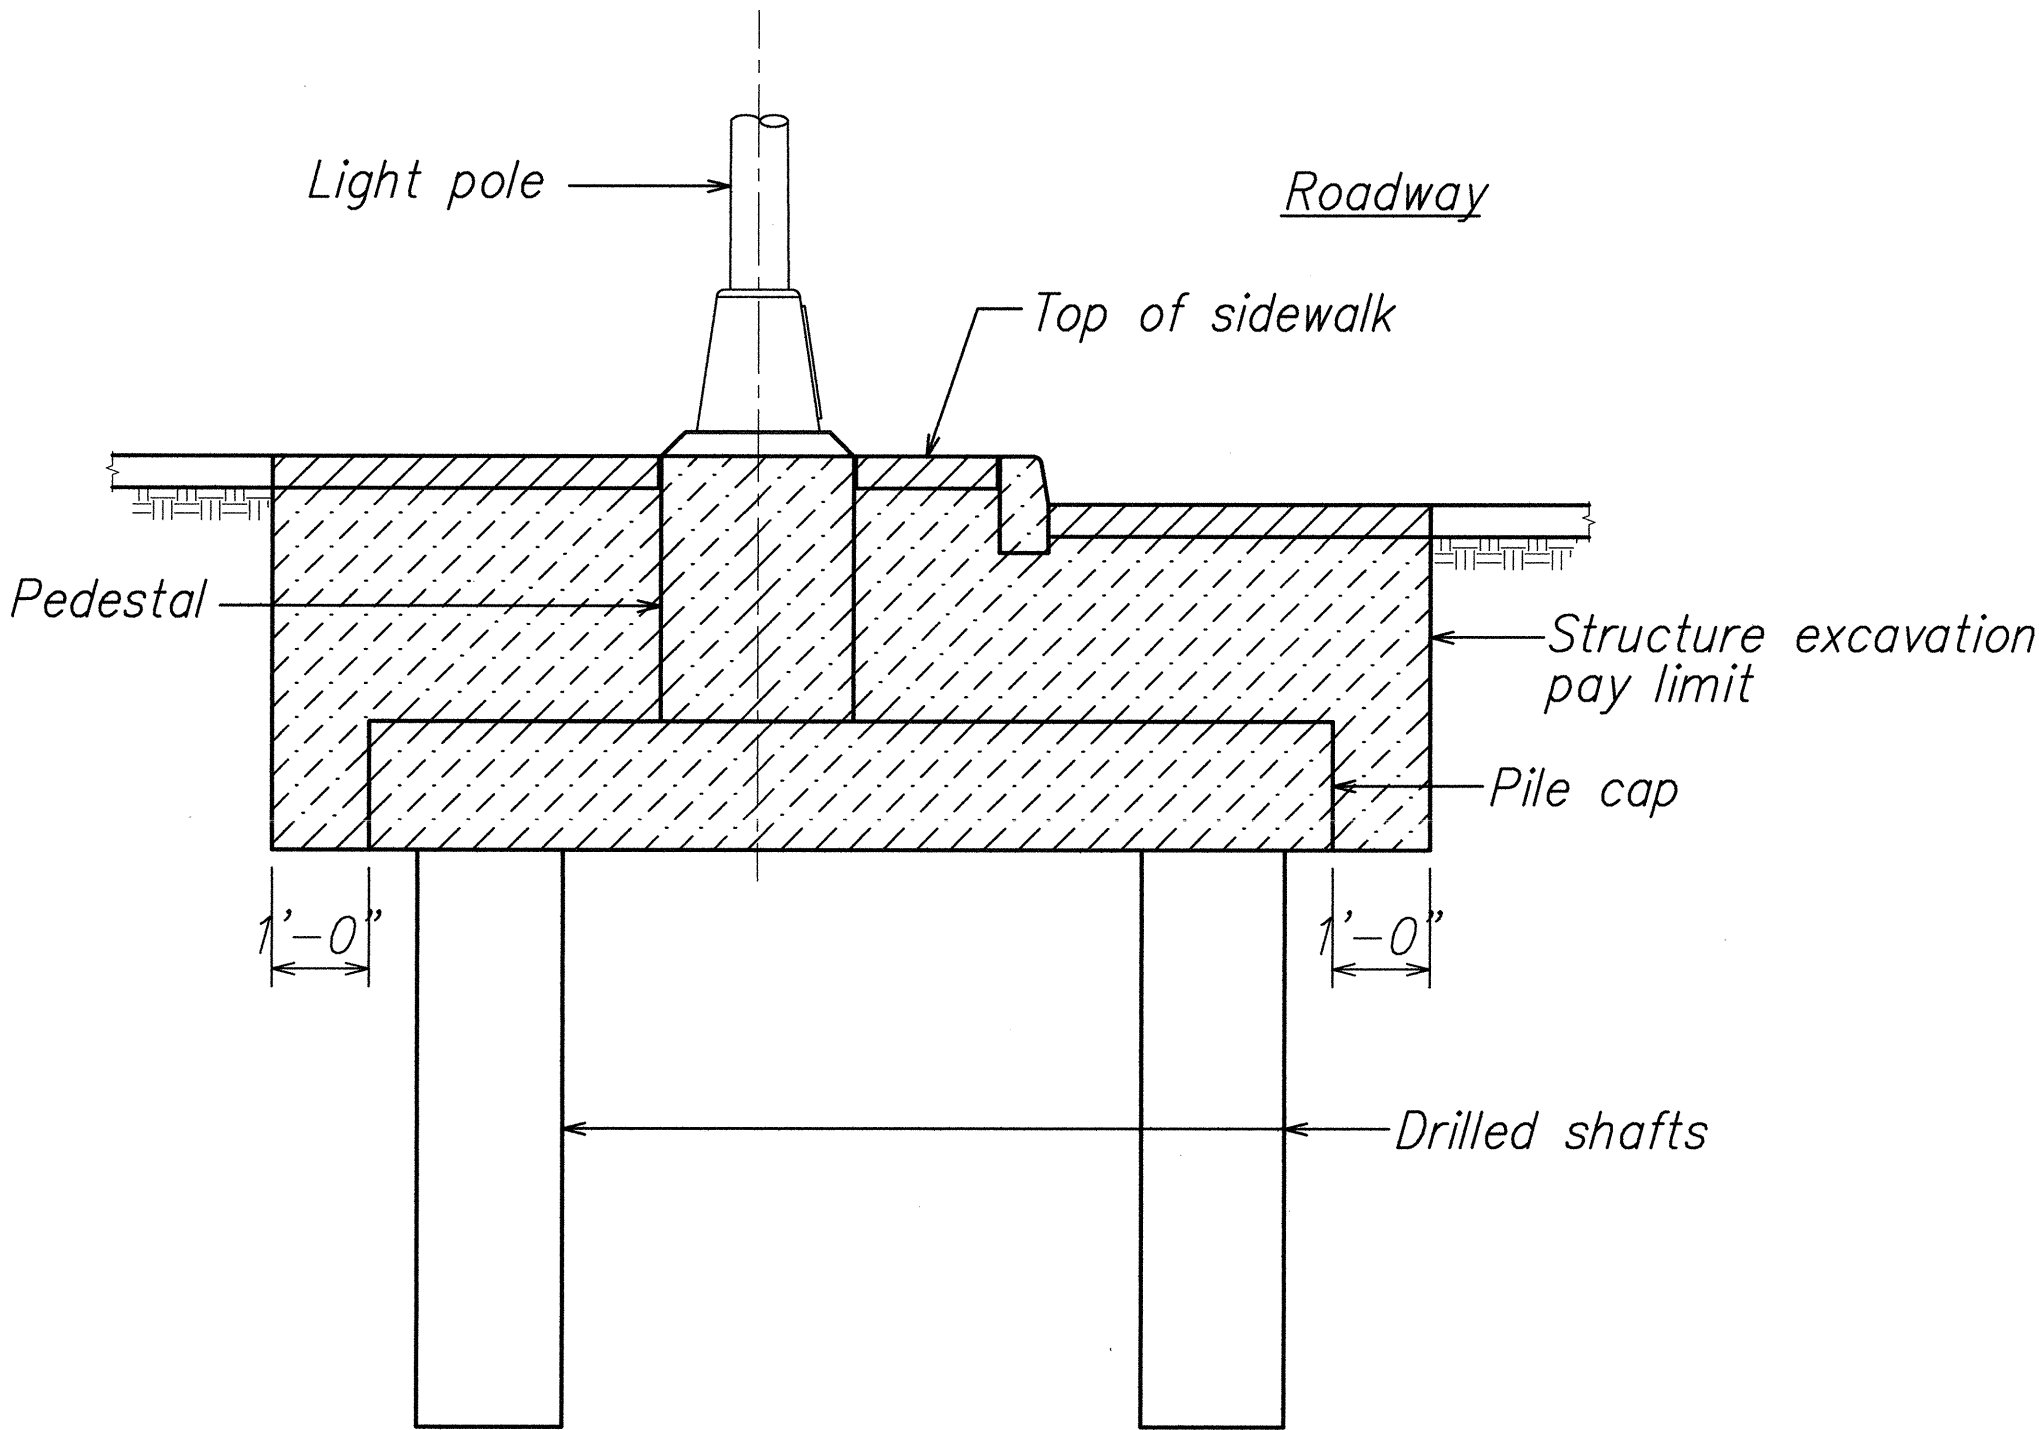


SECTION A
Scale: 1/2" = 1'-0" S8.3 S8.3

Note:
Drilled shafts excavation shall be paid under Section 511.

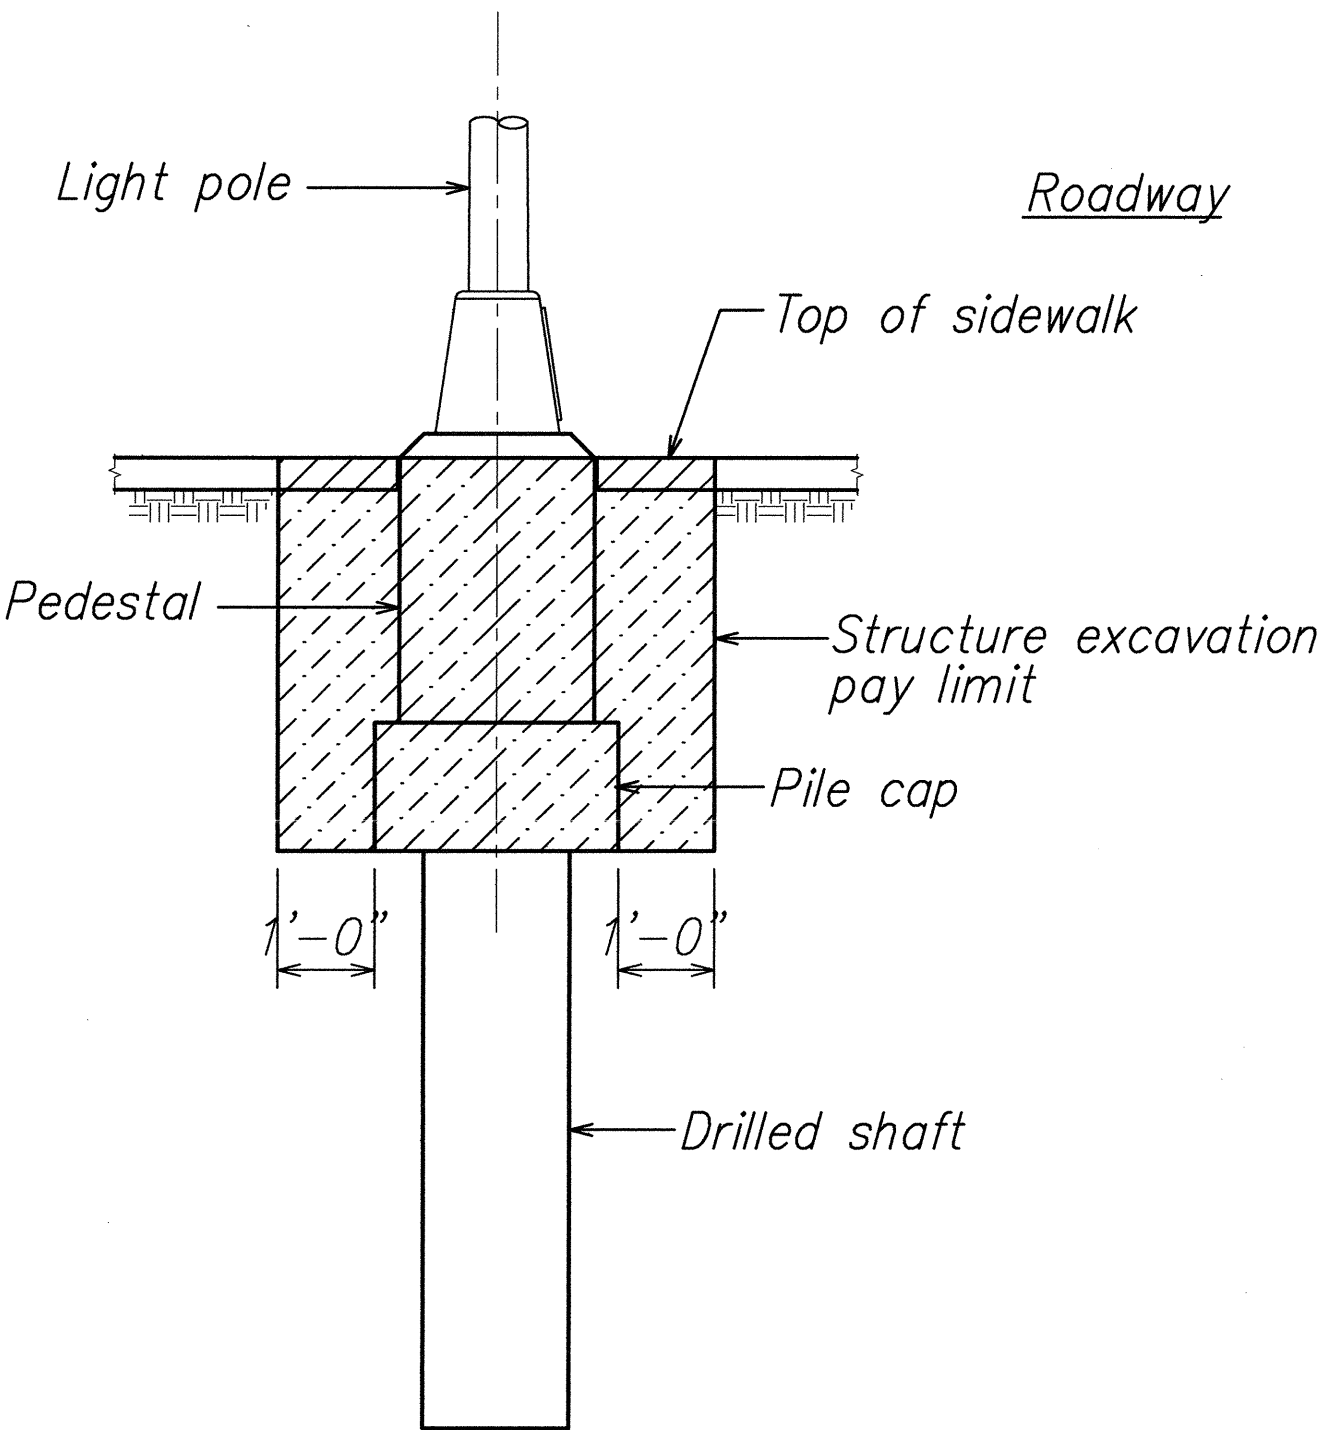

SECTION B
Scale: 1/2" = 1'-0" S8.3 S8.3

SURVEY PLOTTED BY	DATE
DRAWN BY	
DESIGNED BY	
QUANTITIES BY	
CHECKED BY	
ORIGINAL PLAN	
NOTE BOOK	
No.	

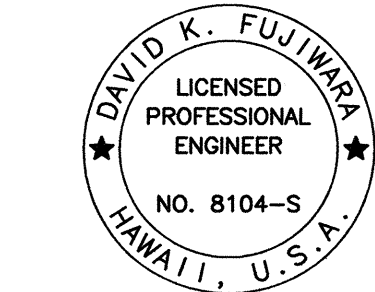


THIS WORK WAS PREPARED BY ME OR UNDER MY SUPERVISION.

Signature: *David K. Fujiwara* 4-30-08
SIGNATURE EXPIRATION DATE OF THE LICENSE


STATE OF HAWAII
DEPARTMENT OF TRANSPORTATION
HIGHWAYS DIVISION
LIGHT POLE STRUCTURE
EXCAVATION PAY LIMITS
North-South Road
Phase 1B
F.A.I. Proj. No. STP-8930(2)
Scale: As Noted Date: Feb. 21, 2007
SHEET No. S8.3 OF 78 SHEETS

FED. ROAD DIST. NO.	STATE	FED. AID PROJ. NO.	FISCAL YEAR	SHEET NO.	TOTAL SHEETS
HAWAII	HAW.	STP-8930(2)	2007	ADD. 256	331

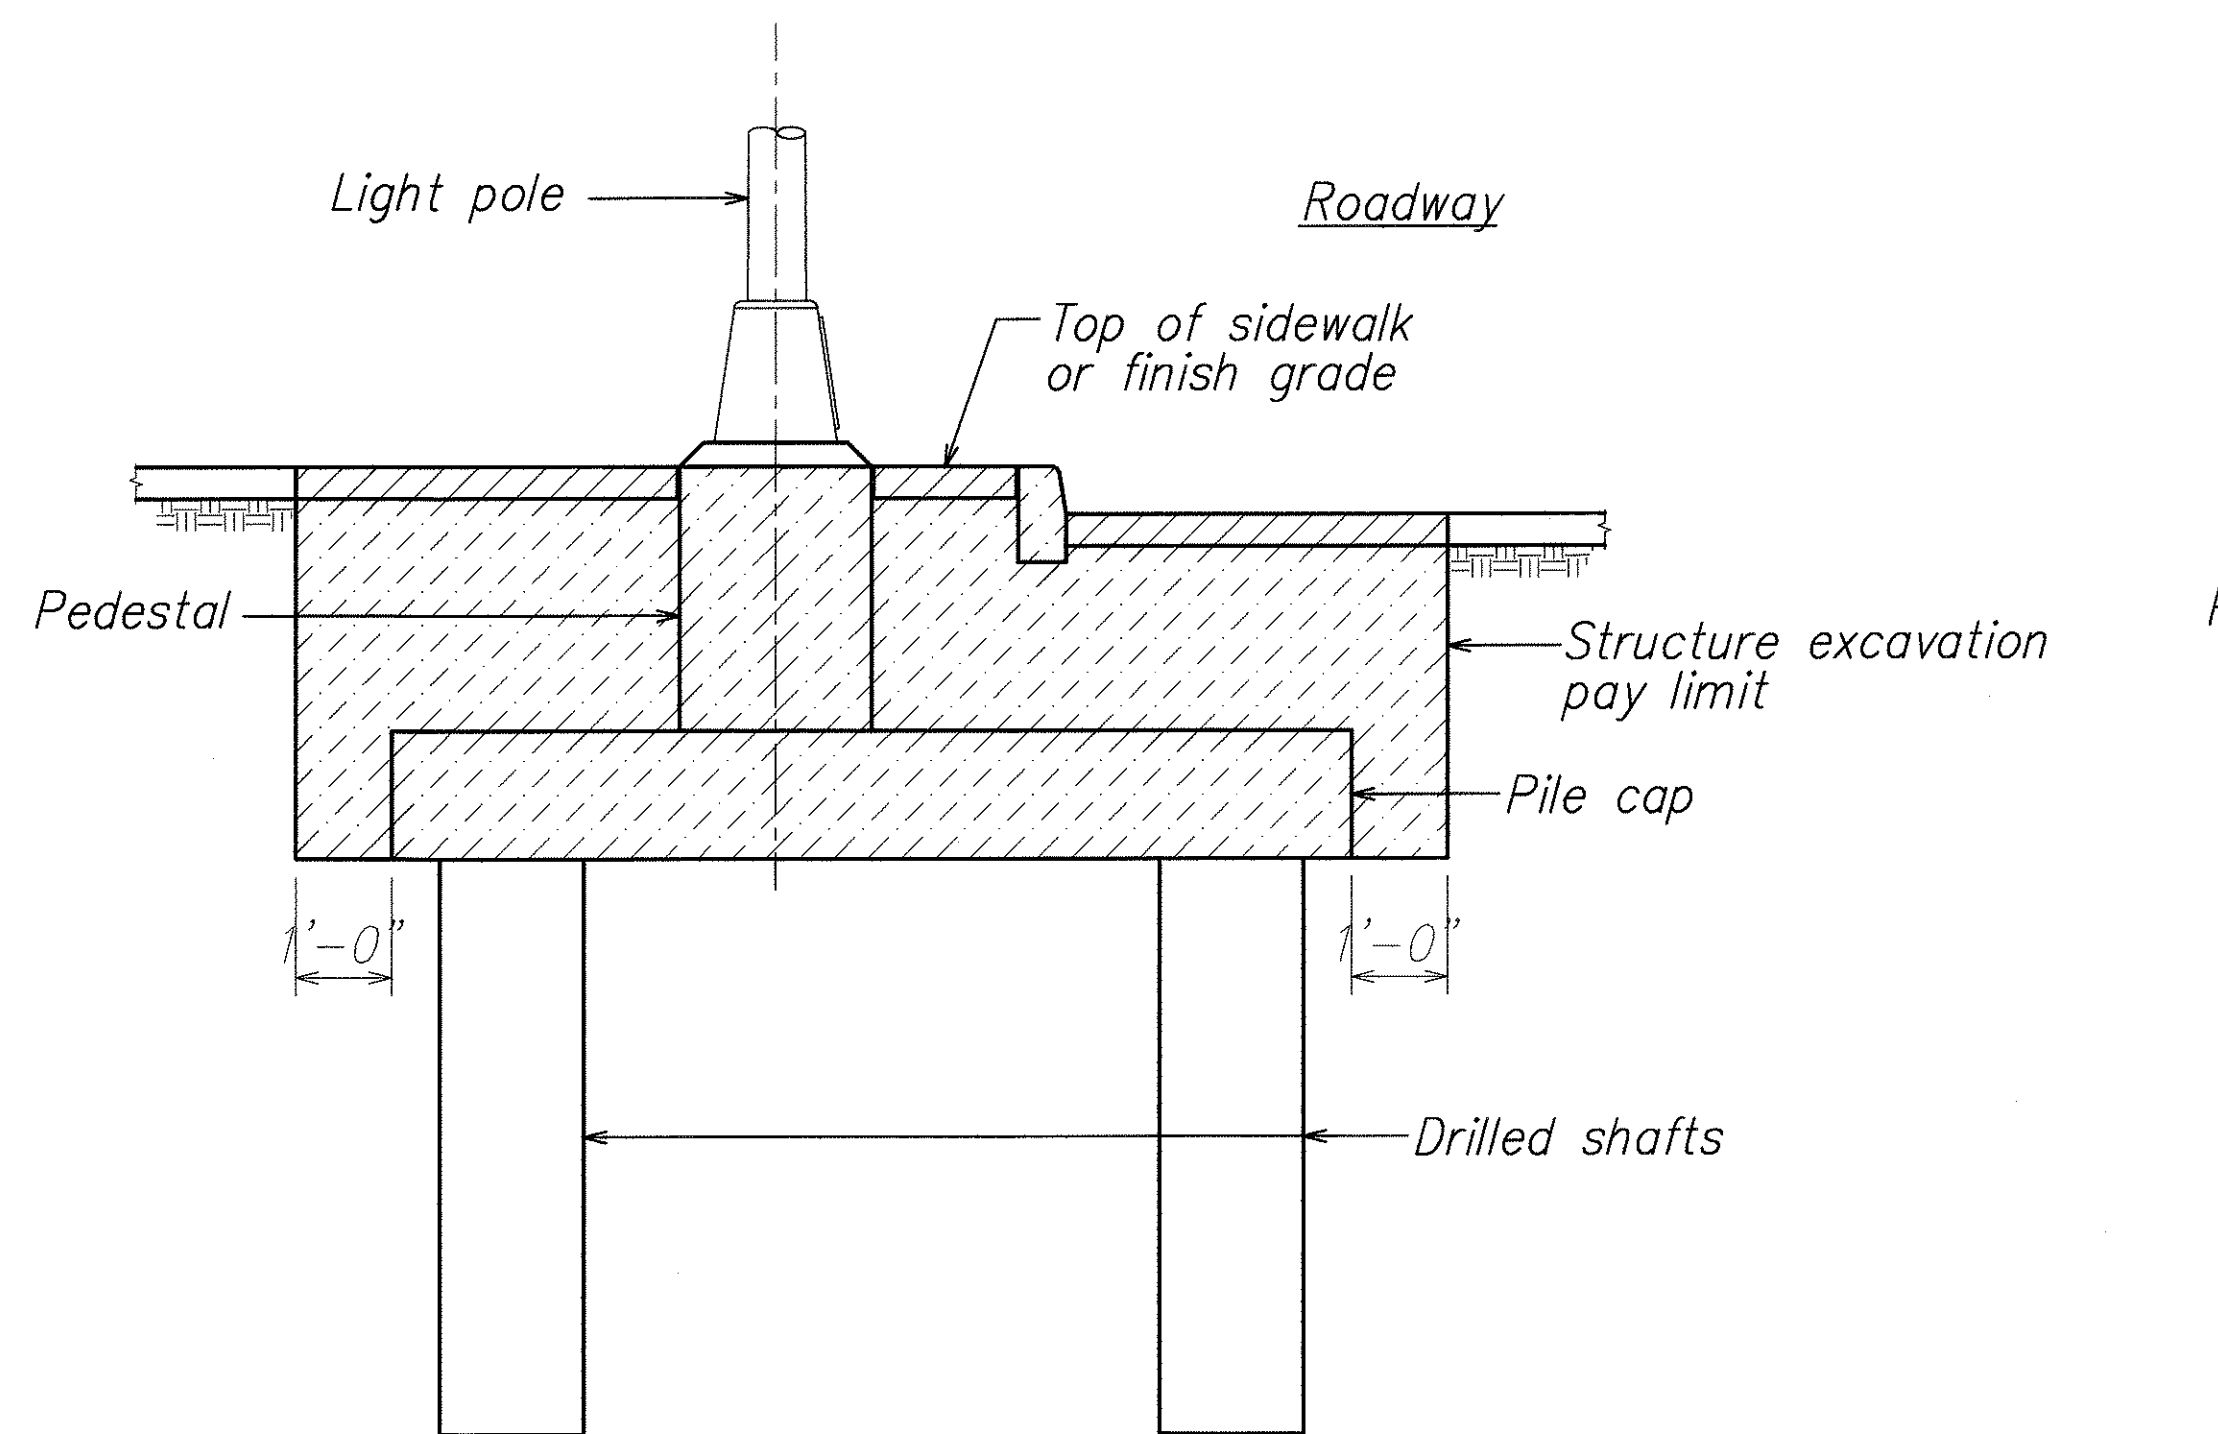

Note:
Drilled shafts excavation shall be paid under Section 511.

SECTION A
Scale: 1/2" = 1'-0" S8.3 S8.3

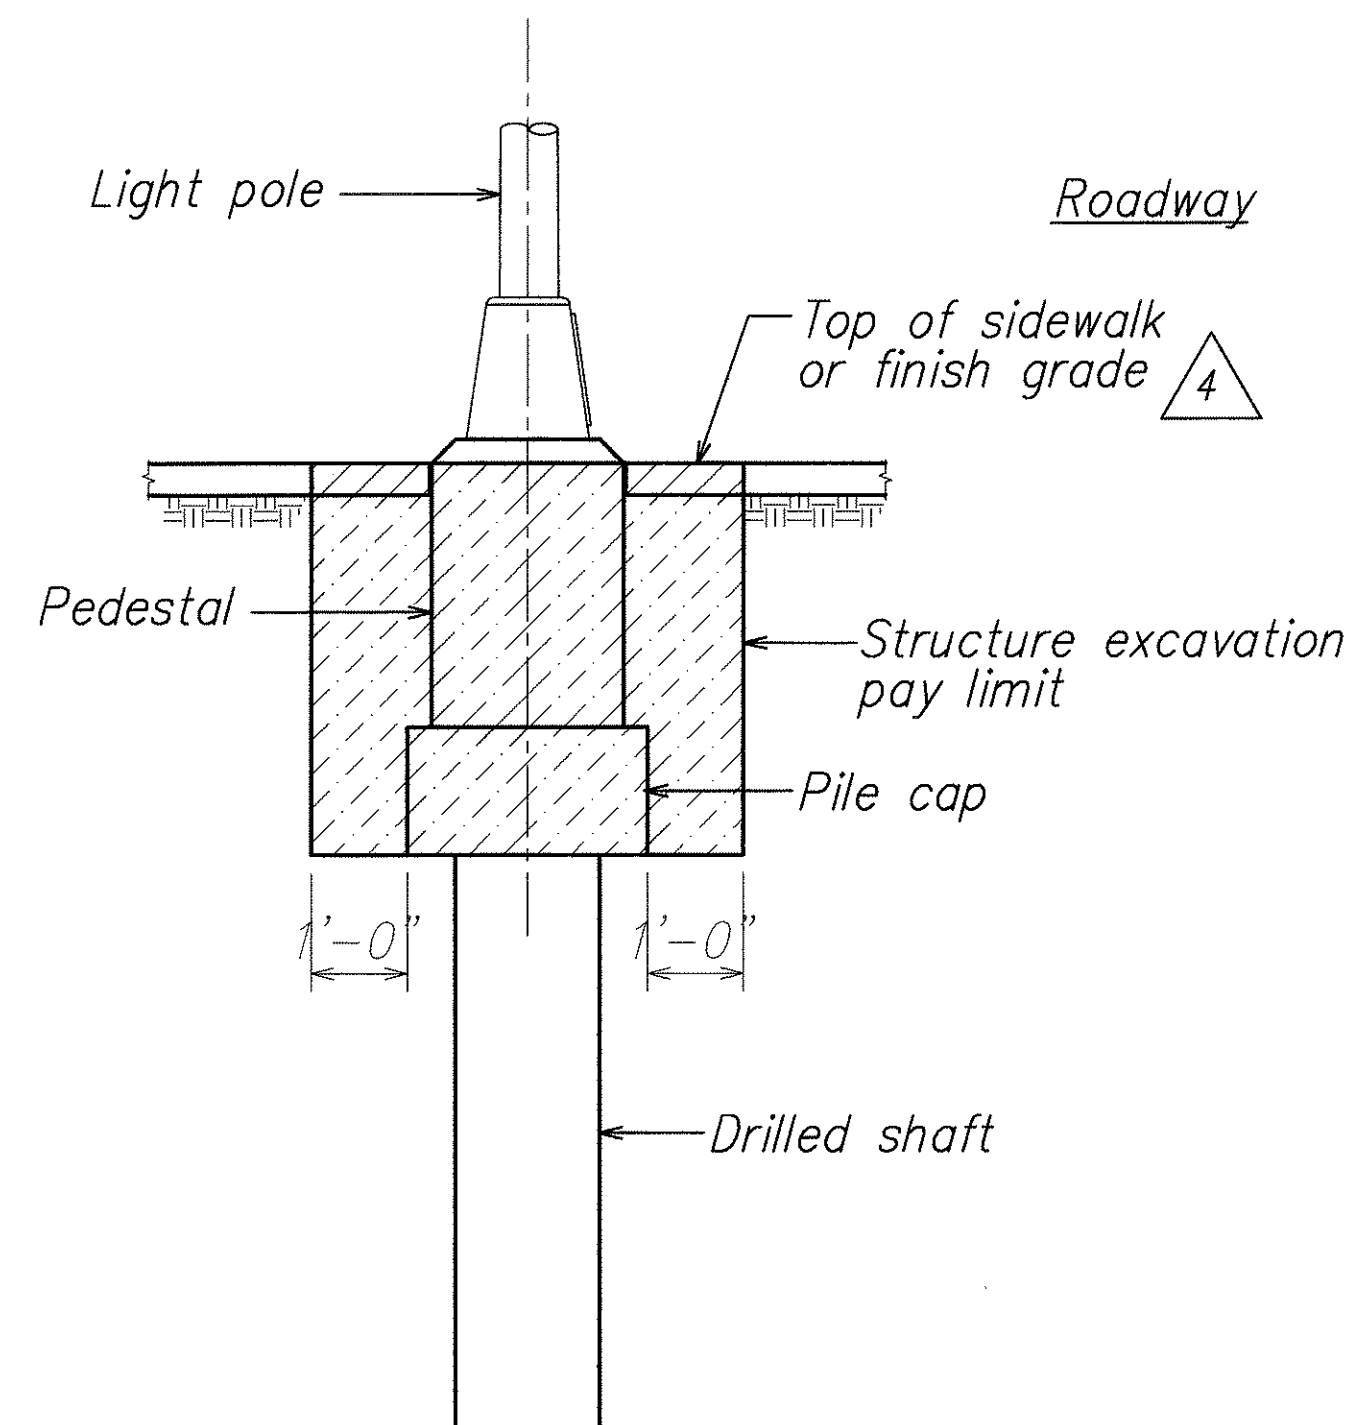

SECTION B
Scale: 1/2" = 1'-0" S8.3 S8.3

ORIGINAL PLAN	SURVEY PLOTTED BY	DATE
NOTE BOOK	DRAWN BY	
No.	DESIGNED BY	
	CHECKED BY	

DAVID K. FUJIMORI
LICENSED PROFESSIONAL ENGINEER
NO. 8104-S
HAWAII, U.S.A.


THIS WORK WAS PREPARED BY ME OR UNDER MY SUPERVISION.

David K. Fujimori
SIGNATURE
4-30-08
EXPIRATION DATE OF THE LICENSE

5/31/07	4 Revised Notes
DATE	REVISION
STATE OF HAWAII DEPARTMENT OF TRANSPORTATION HIGHWAYS DIVISION LIGHT POLE STRUCTURE EXCAVATION PAY LIMITS North-South Road Phase 1B F.A.I. Proj. No. STP-8930(2) Scale: As Noted Date: Feb. 21, 2007 SHEET No. S8.3 OF 78 SHEETS	

ADD. 256

FED. ROAD DIST. NO.	STATE	FED. AID PROJ. NO.	FISCAL YEAR	SHEET NO.	TOTAL SHEETS
HAWAII	HAW.	STP-8930(2)	2007	ADD. 256S-2	331

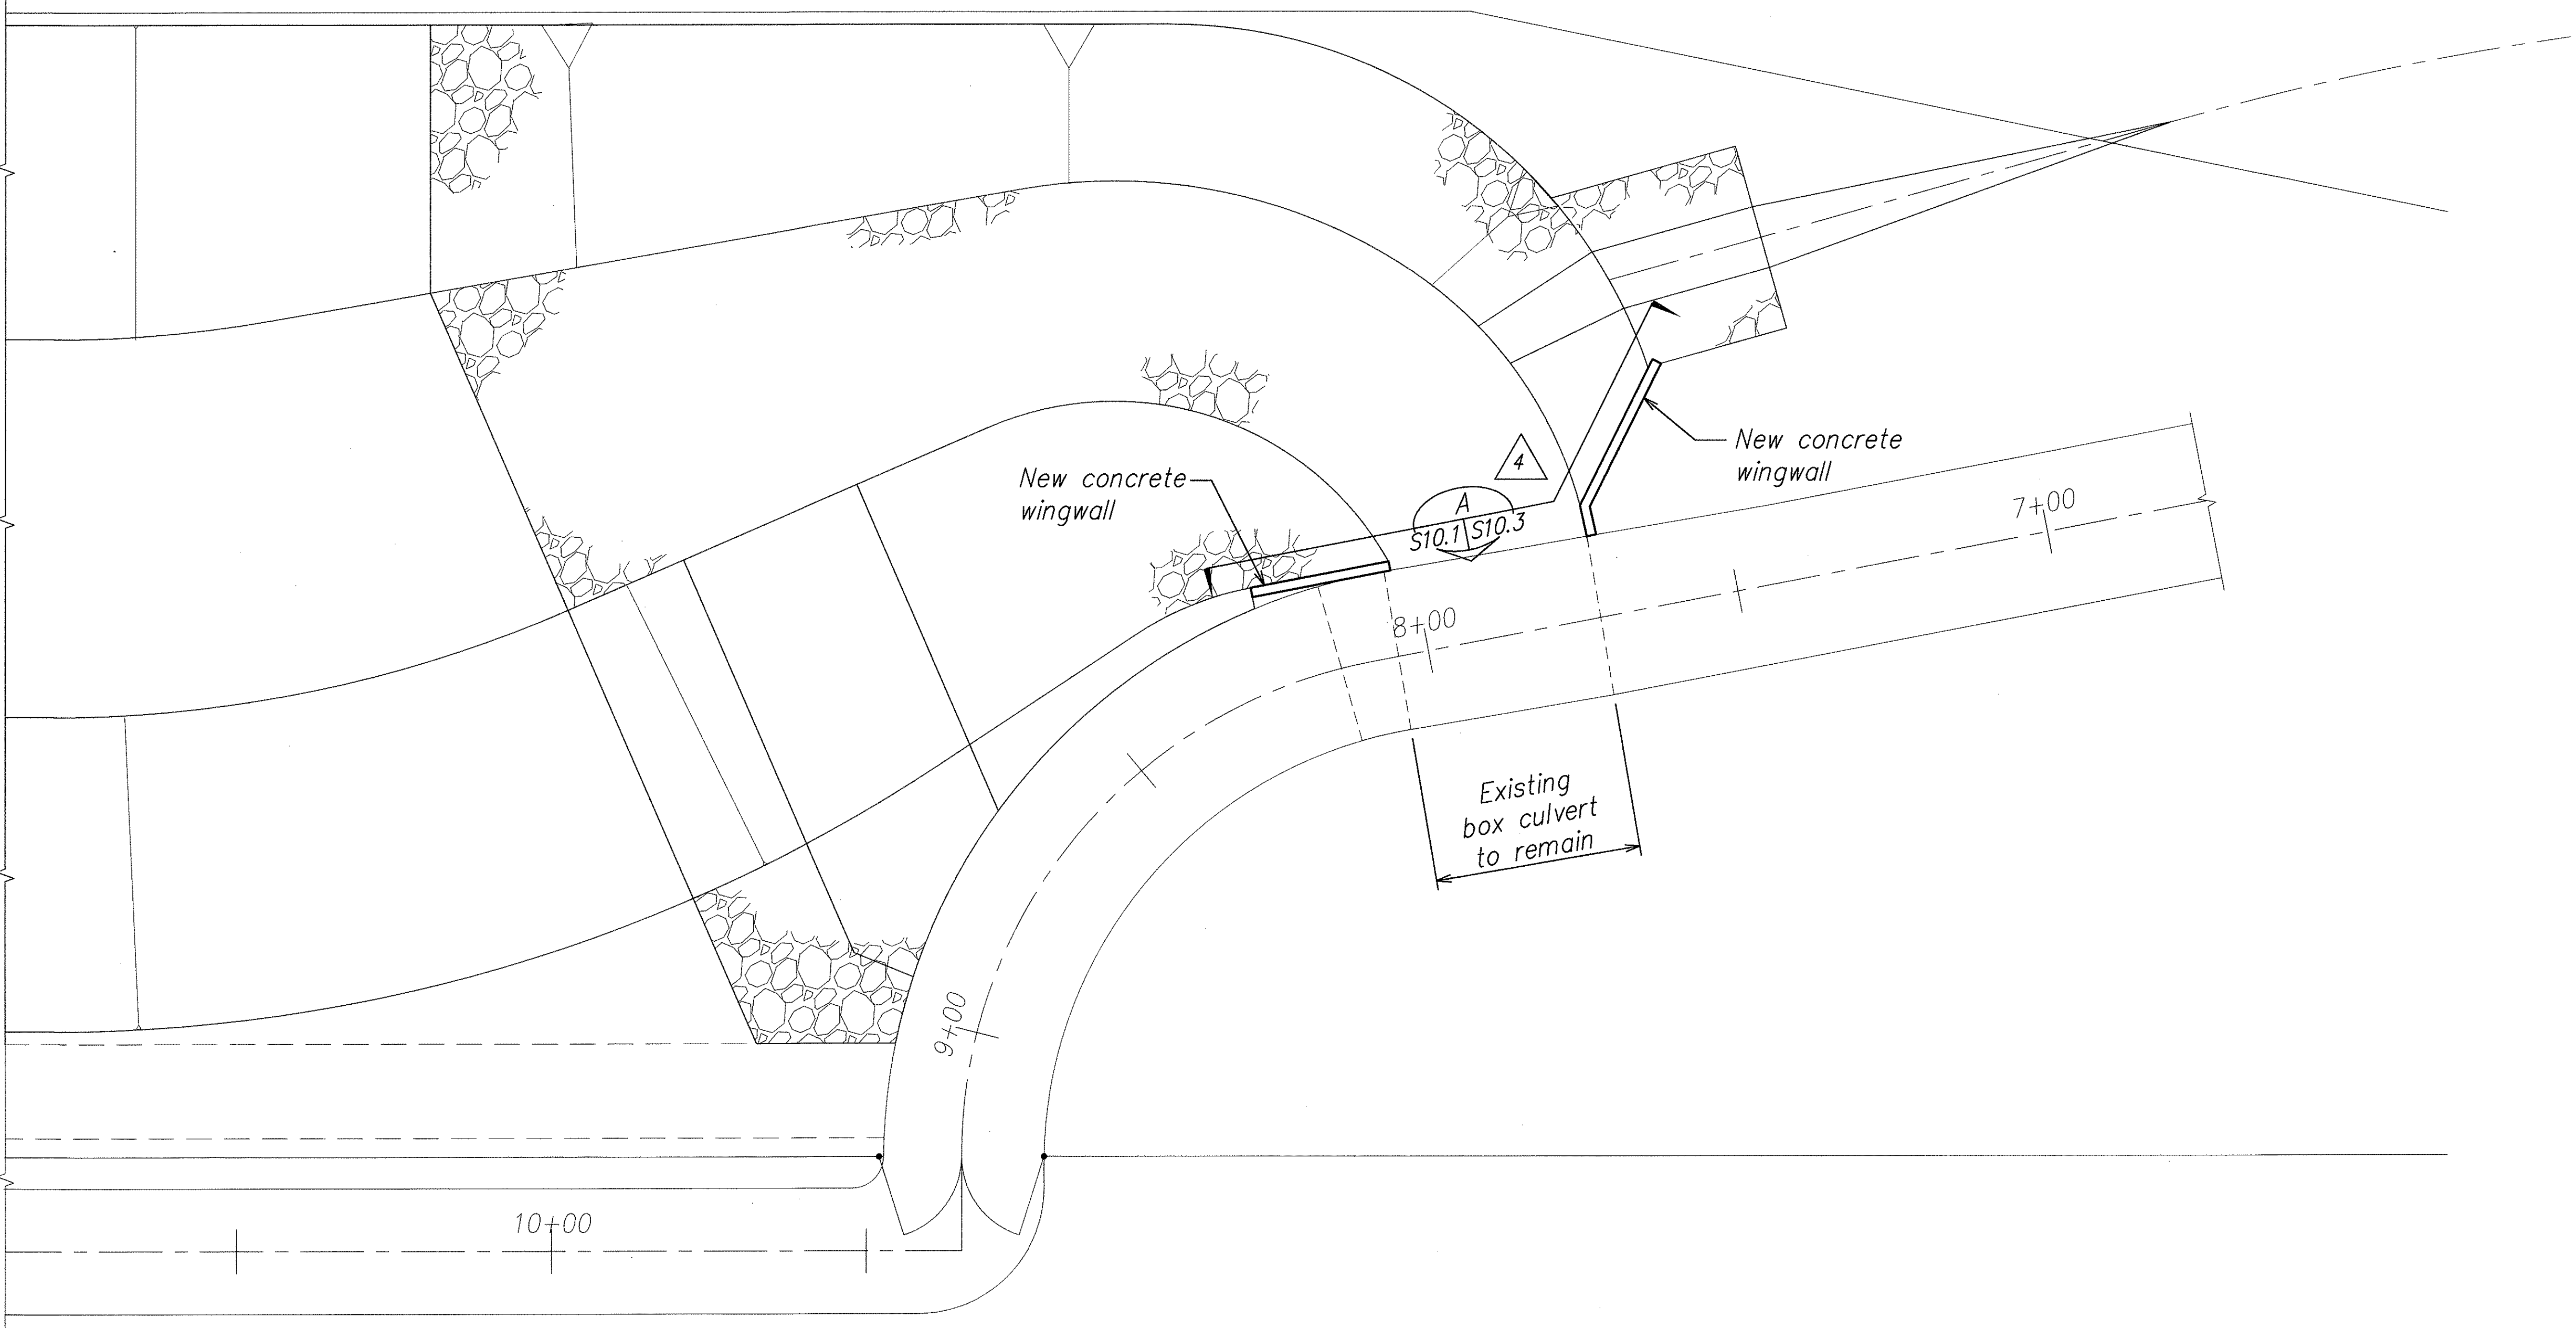

PALEHUA ROAD - LAYOUT PLAN
Scale: 1/16" = 1'-0"
A
S10.1 S10.1

ORIGINAL PLAN	SURVEY PLOTTED BY	DATE
NOTE BOOK	DRAWN BY	
No.	DESIGNED BY	
	CHECKED BY	

DAVID K. FUJIMURA
LICENSED PROFESSIONAL ENGINEER
NO. 8104-S
HAWAII, U.S.A.

THIS WORK WAS PREPARED BY ME OR UNDER MY SUPERVISION.


David K. Fujimura
SIGNATURE
4-30-08
EXPIRATION DATE OF THE LICENSE

5/31/07	4	Added Reference
5/11/07	2	New Sheet
DATE	REVISION	

STATE OF HAWAII
DEPARTMENT OF TRANSPORTATION
HIGHWAYS DIVISION
PALEHUA ROAD
LAYOUT PLAN
North-South Road
Phase 1B
F.A.I. Proj. No. STP-8930(2)
Scale: As Noted Date: Feb. 21, 2007


SHEET No. S10.1 OF 78 SHEETS

FED. ROAD DIST. NO.	STATE	FED. AID PROJ. NO.	FISCAL YEAR	SHEET NO.	TOTAL SHEETS
HAWAII	HAW.	STP-8930(2)	2007	ADD. 256S-4	331

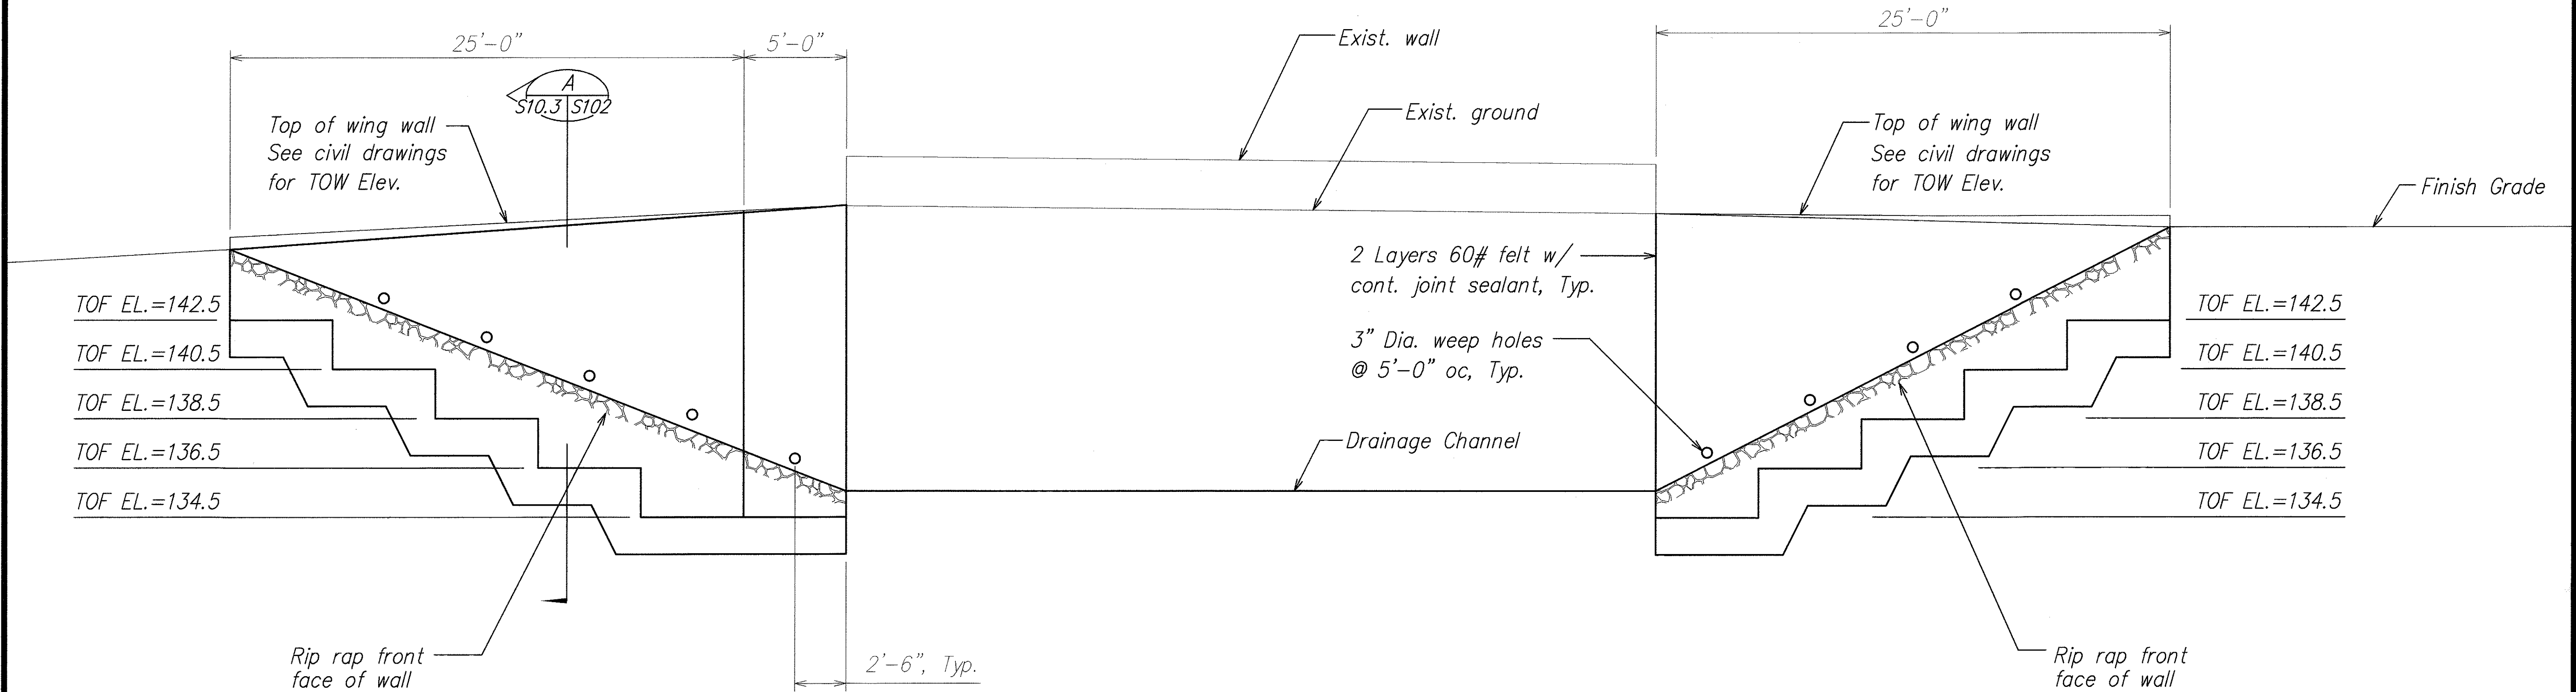

PALEHUA ROAD WING WALL ELEVATION A
 Scale: 1/4" = 1'-0" S10.1 S10.3

ORIGINAL PLAN	SURVEY PLOTTED BY	DATE
NOTE BOOK	DESIGNED BY	
No.	QUANTITIES BY	
	CHECKED BY	

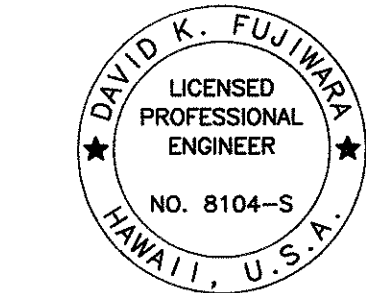

THIS WORK WAS PREPARED BY
ME OR UNDER MY SUPERVISION.

David K. Fujiwara 4-30-08
SIGNATURE EXPIRATION DATE OF THE LICENSE

5/31/07	4 New Sheet
DATE	REVISION
STATE OF HAWAII DEPARTMENT OF TRANSPORTATION HIGHWAYS DIVISION PALEHUA ROAD WING WALL ELEVATION North-South Road Phase 1B F.A.I. Proj. No. STP-8930(2) Scale: As Noted Date: Feb. 21, 2007	
SHEET No. S10.3 OF 78 SHEETS	