


FED. ROAD DIST. NO.	STATE	FED. AID PROJ. NO.	FISCAL YEAR	SHEET NO.	TOTAL SHEETS
HAWAII	HAW.	STP-8930(2)	2007	31	331

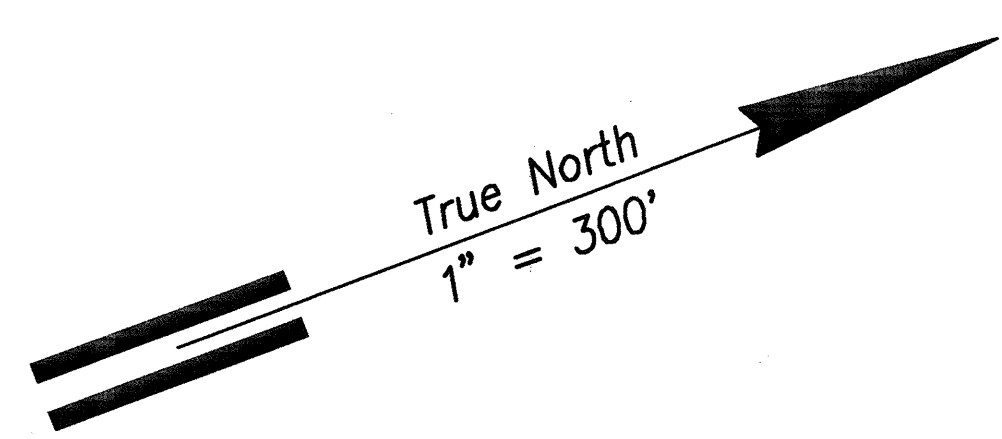

TMK: 9-2-002:001
(University of Hawaii)

Benchmark
"NS-MON1"
Alum. Disk
N -5430.67
E 5791.76
Elev.=154.35

286°42'10",
968.60'
TMK: 9-1-017:086
(State of Hawaii)

Benchmark
"NS-MON2"
Alum. Disk
N -5709.05
E 6719.49
Elev.=148.32

Benchmark
"NS-MON4"
Alum. Disk
N -7727.98
E 7500.15
Elev.=121.64

Benchmark
"NS-MON5"
Alum. Disk
N -9036.03
E 7693.99
Elev.=101.74

Benchmark
"NS-MON6"
Alum. Disk
N -10309.69
E 7469.84
Elev.=85.25

Benchmark
"NS-MON7"
Alum. Disk
N -11220.74
E 6821.33
Elev.=78.17

Benchmark
"NS-MON8"
Alum. Disk
N -12269.27
E 6233.58
Elev.=74.03

Benchmark
"NS-MON9"
Alum. Disk
N -12888.01
E 6299.34
Elev.=72.15

Benchmark
"NS-MON10"
Alum. Disk
N -14042.99
E 6673.22
Elev.=63.50

162°03'44",
1213.98'

Benchmark
"NS-MON11"
Alum. Disk
N -14957.57
E 7153.14
Elev.=54.07


Benchmark
"NS-MON3"
Alum. Disk
N -6532.15
E 7403.96
Elev.=134.82

TMK: 9-1-017:004
(Campbell Estate)

SURVEY PLOTTED BY	DATE
DESIGNED BY	
NOTED BY	
CHECKED BY	
ORIGINAL PLAN	
NOTE BOOK	
No.	



THIS WORK WAS PREPARED BY
ME OR UNDER MY SUPERVISION.
DATE OF LICENSE EXPIRY
APR 30, 2009

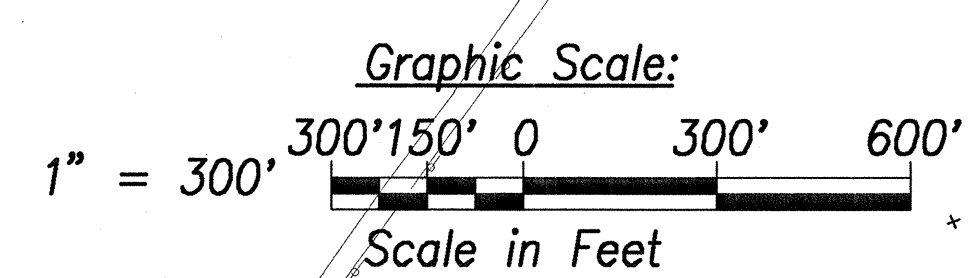

STATE OF HAWAII
DEPARTMENT OF TRANSPORTATION
HIGHWAYS DIVISION

ROADWAY KEY PLAN

North-South Road
Phase 1B
F.A.I. Proj. No. STP-8930(2)

Scale: As Shown Date: Feb 21, 2007
SHEET No. C2.1 OF 150 SHEETS