

INDEX TO DRAWINGS	
SHEET NO.	DESCRIPTION
1	TITLE SHEET
2-331	NORTH-SOUTH ROAD PHASE 1B
332-359	EAST KAPOLEI OFFSITE TRUNK SEWER
360-380	EAST KAPOLEI WATER TRANSMISSION MAIN

STATE OF HAWAII

DEPARTMENT OF TRANSPORTATION

HIGHWAYS DIVISION

HONOLULU, HAWAII

"AS-BUILT" PLANS FOR

PART A

NORTH-SOUTH ROAD

PHASE 1B

FEDERAL AID PROJECT NO. STP-8930(2)

PART B


EAST KAPOLEI OFFSITE TRUNK SEWER

PART C



EAST KAPOLEI WATER TRANSMISSION MAIN

DISTRICT OF EWA


ISLAND OF OAHU

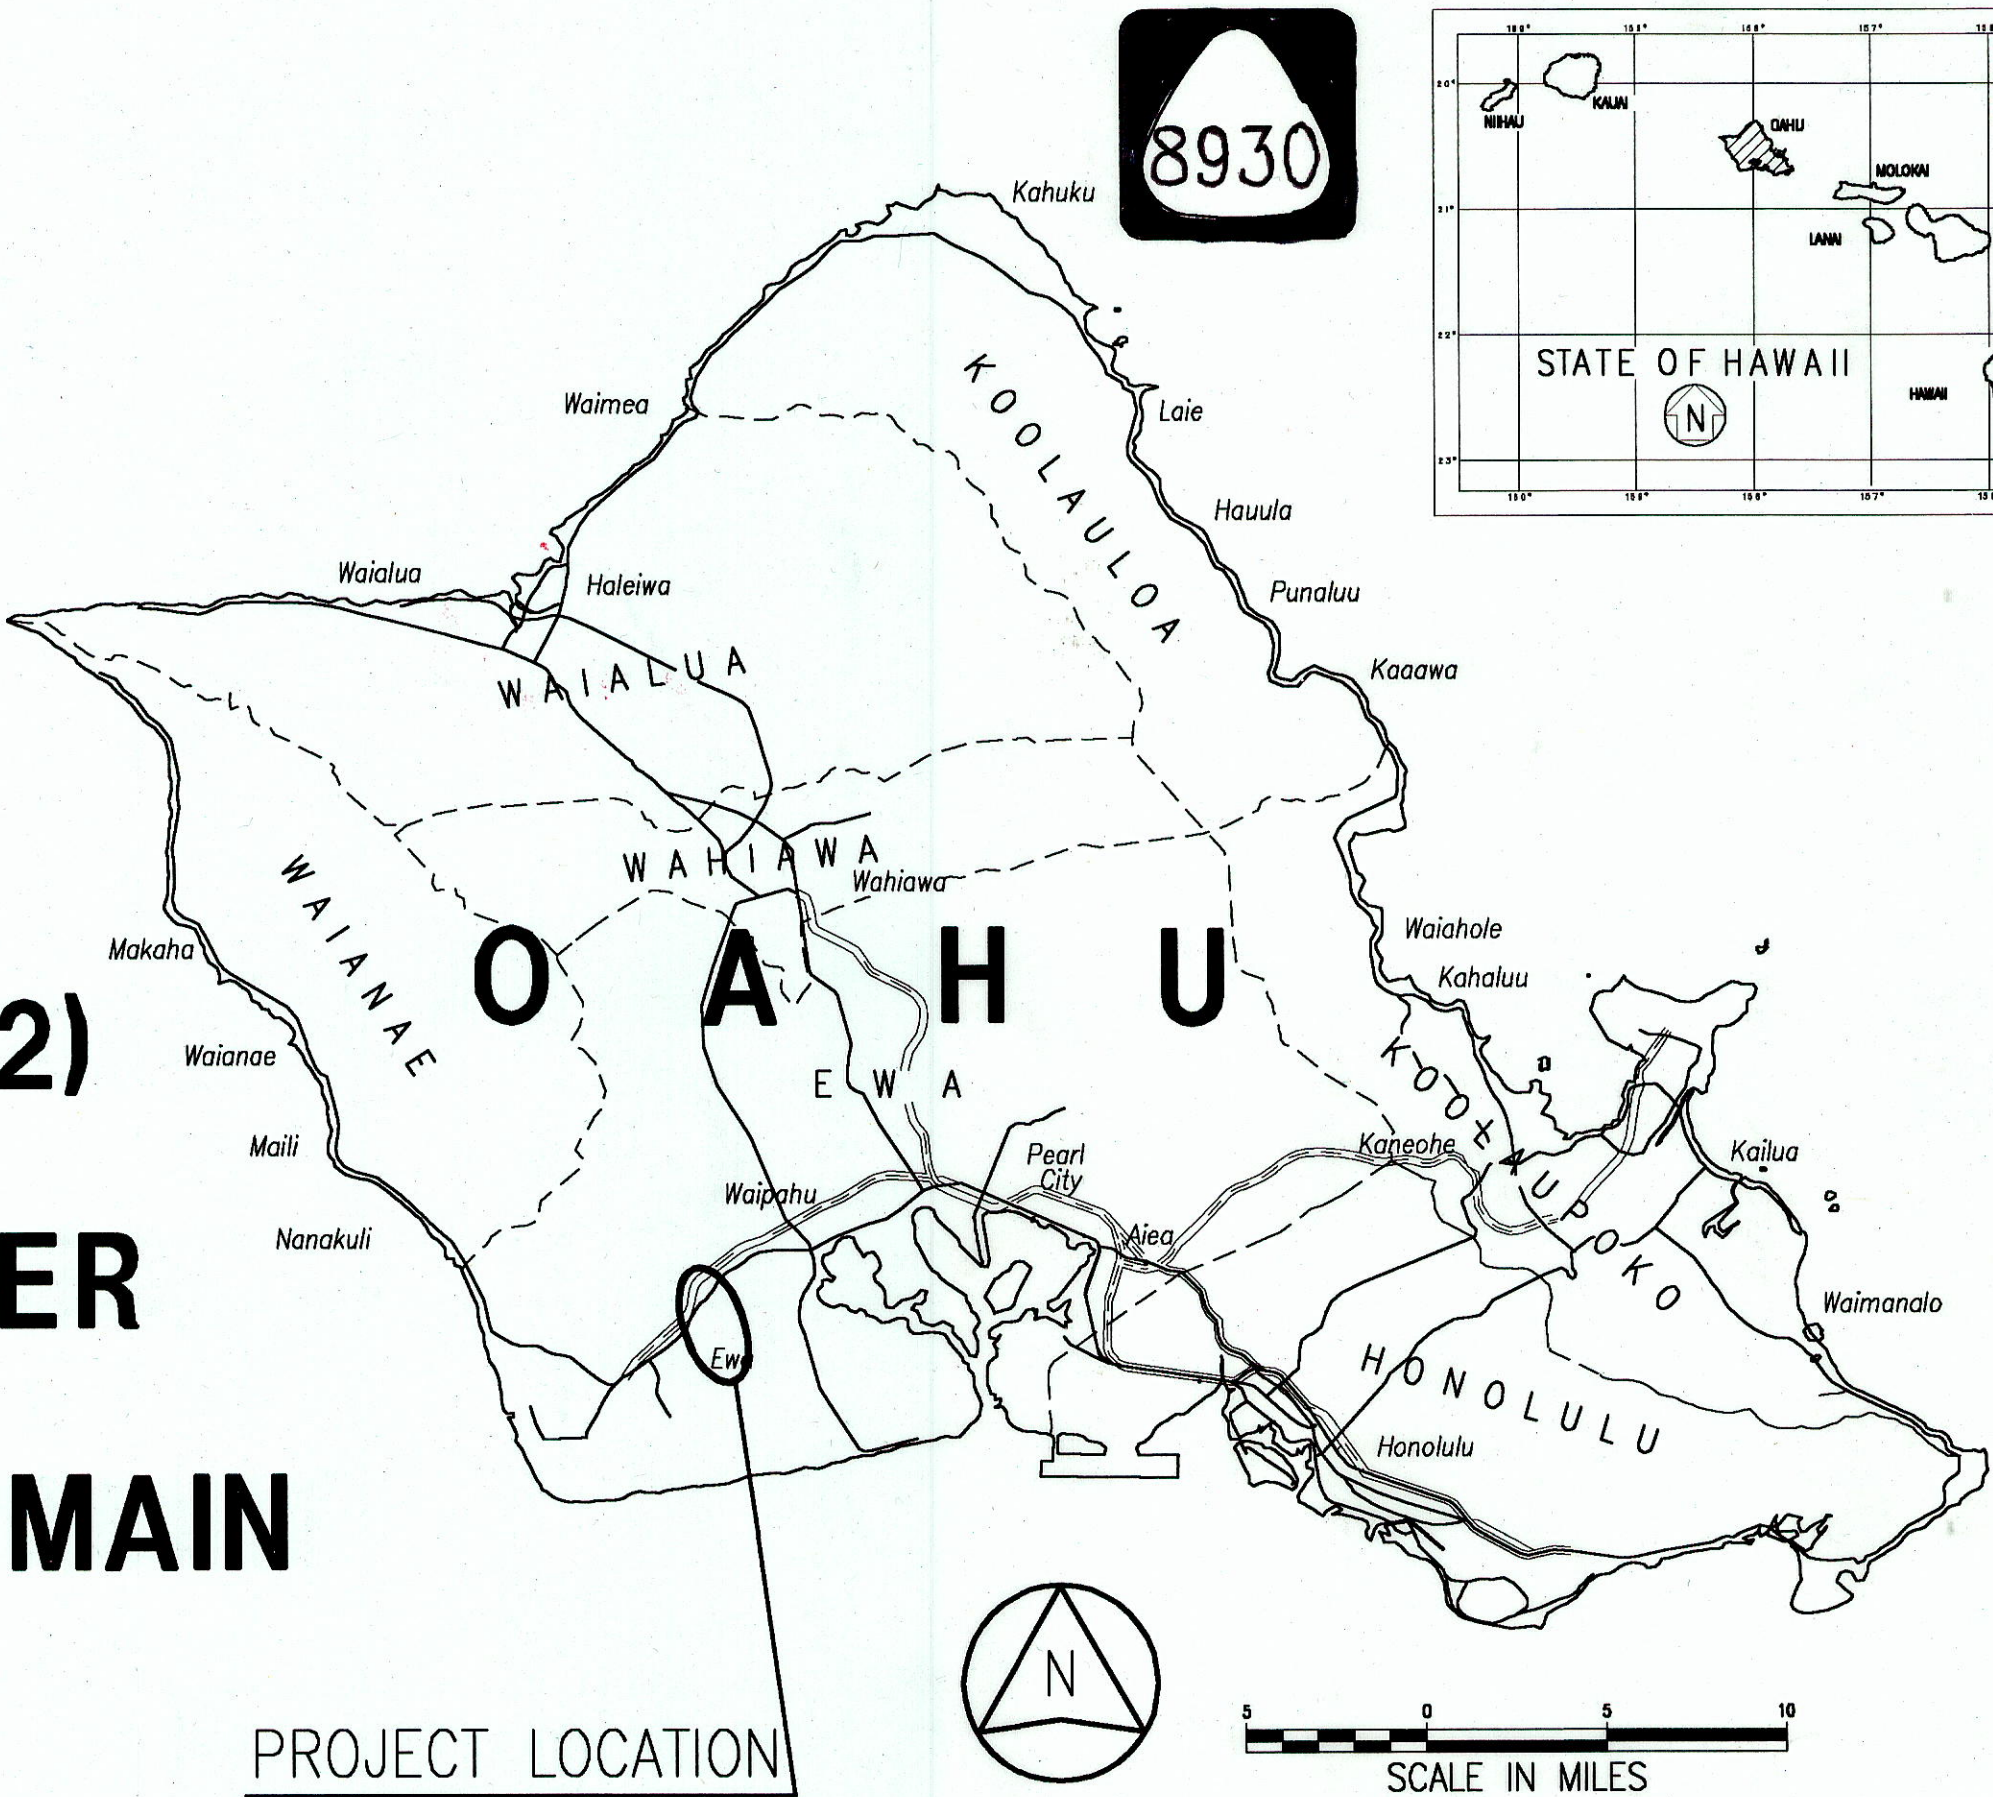

FED. ROAD DIST. NO.	STATE	FED. AID PROJ. NO.	FISCAL YEAR	SHEET NO.	TOTAL SHEETS
HAWAII	HAW.	STP-8930(2)	2007	1	380

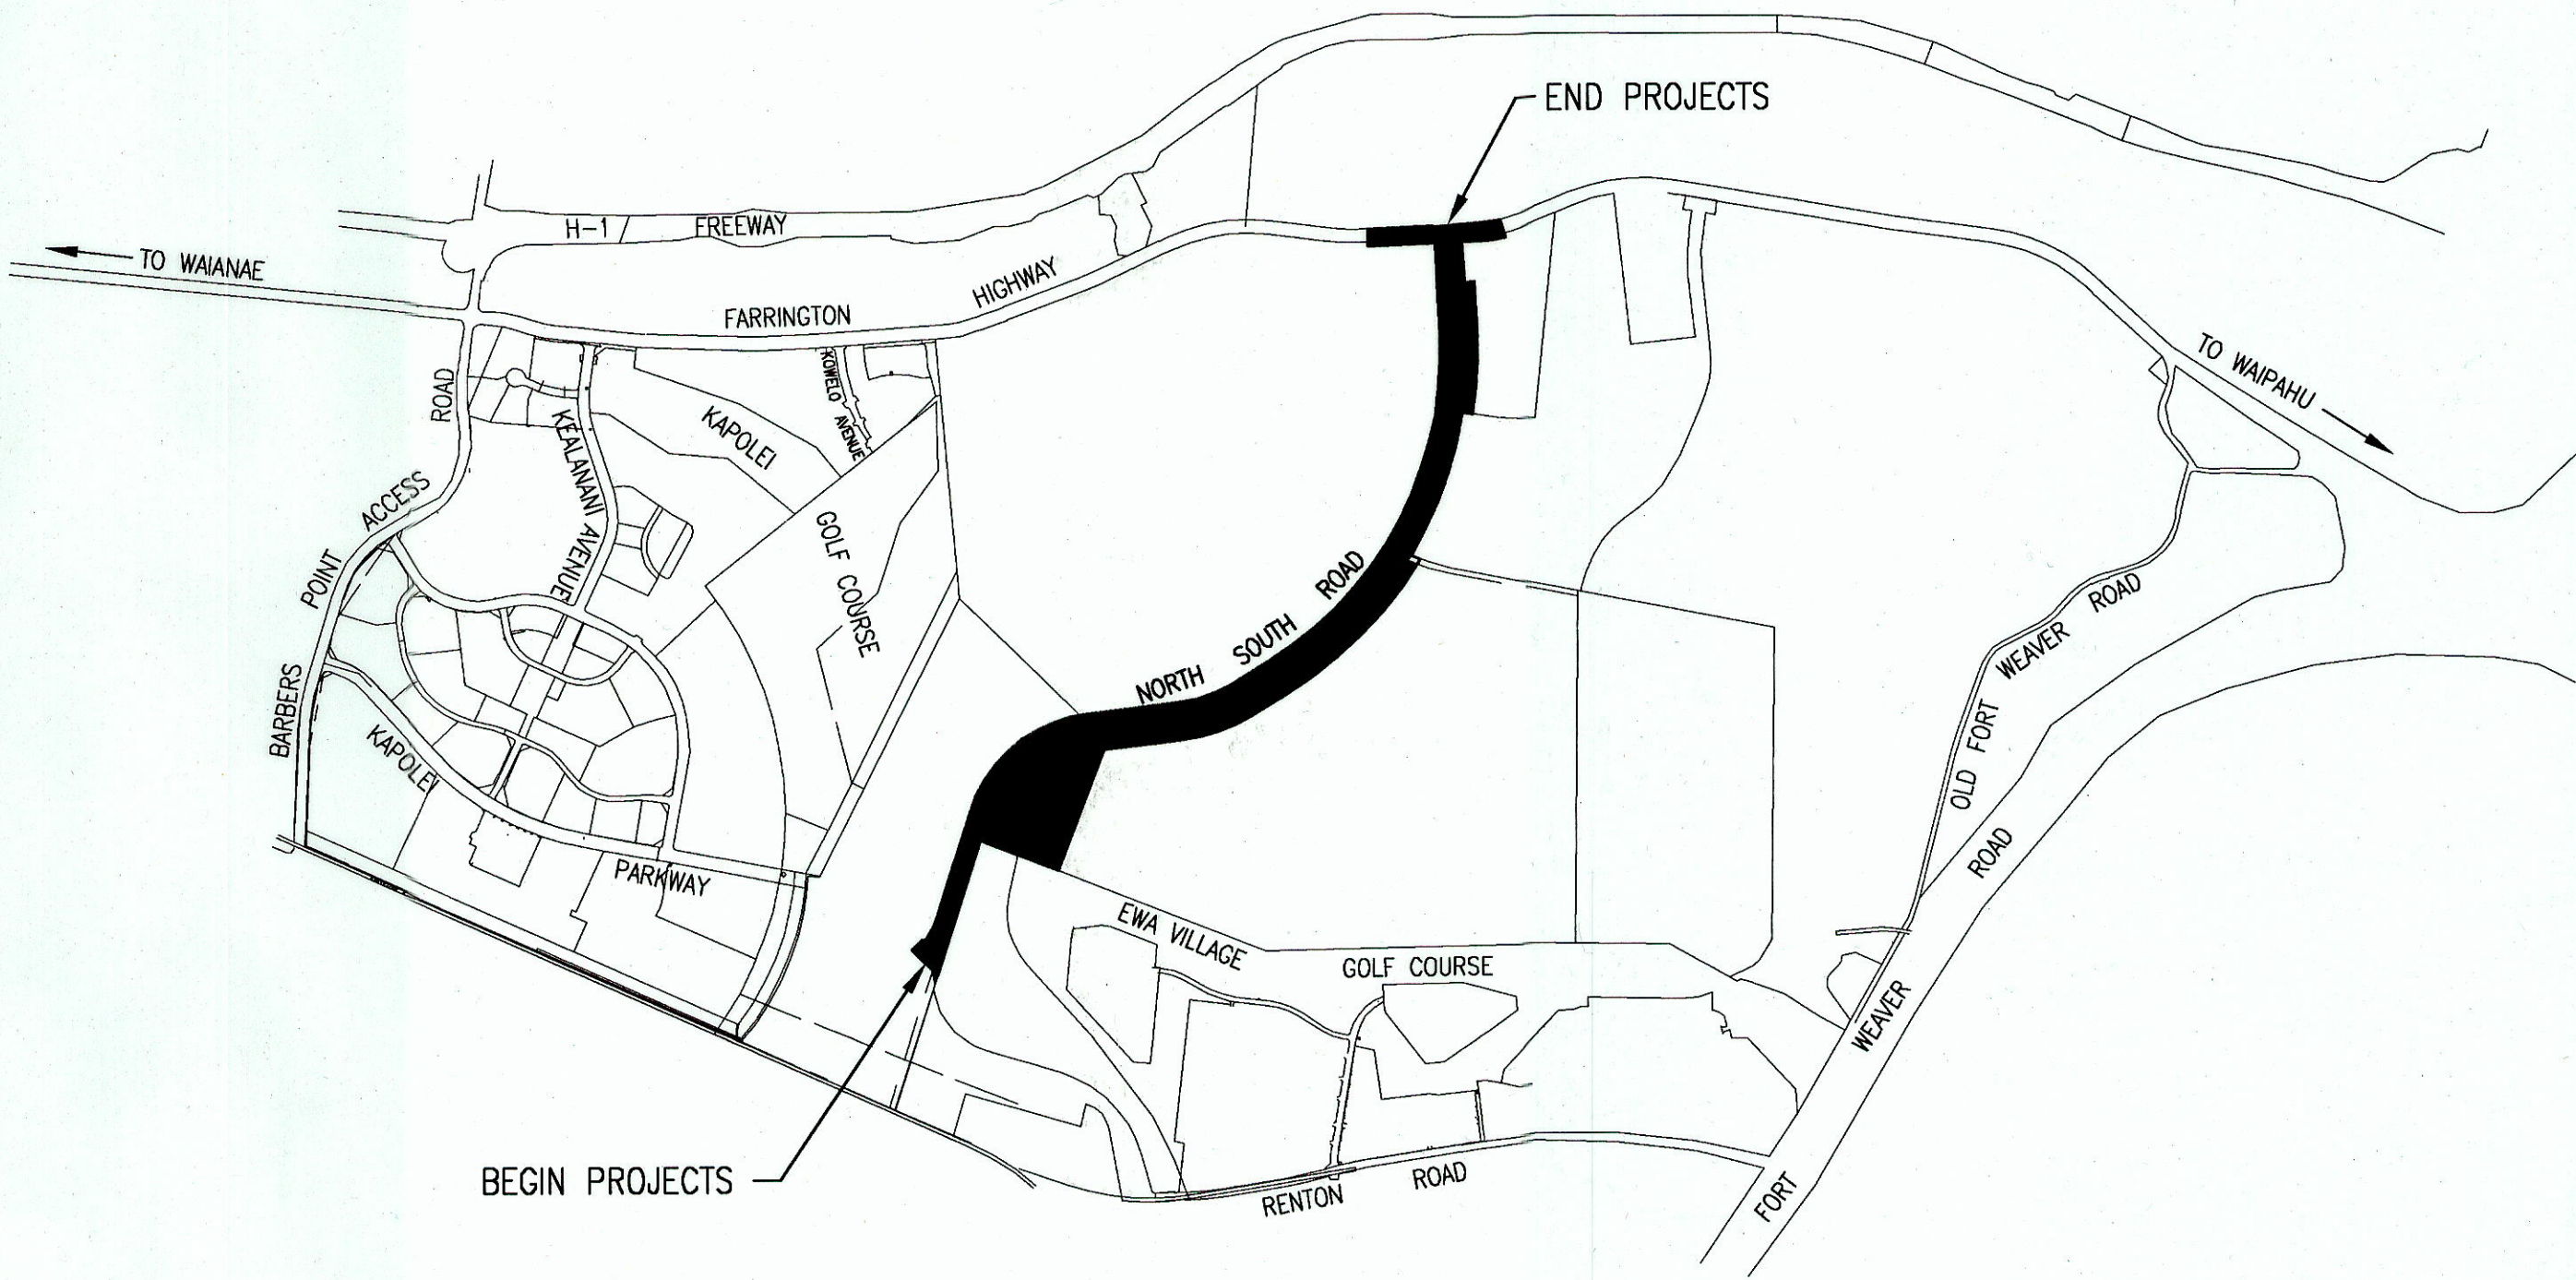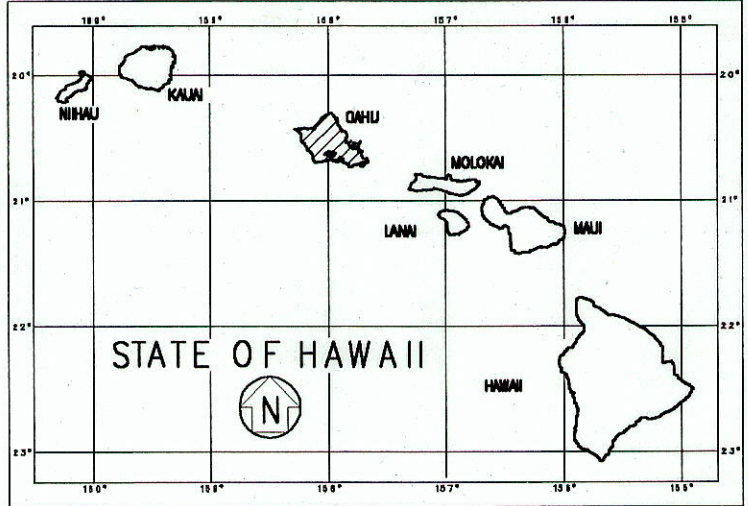

NET LENGTH OF PROJECT - 2.05 MILES
GROSS LENGTH OF PROJECT - 2.05 MILES

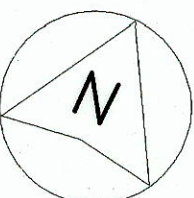

LOCATION PLAN
NOT TO SCALE

DESIGN DESIGNATION

DESIGN ADT (2022)	43,500
DHV	4,400
D (DESIGN)	54/46
T (DESIGN)	2.7%
T 24	9.3%
V	45 MPH

CHANGES MADE DURING CONSTRUCTION HAVE BEEN INCORPORATED ON THESE PLANS EXCEPT CHANGES IN THE ORIGINAL THEORETICAL QUANTITIES. FOR ACTUAL QUANTITIES, REFER TO PROJECT LEDGER AND/OR COMPUTATION BOOK.

DEPARTMENT OF TRANSPORTATION STATE OF HAWAII	
APPROVED:	
<i>for [Signature]</i>	3/14/07
DIR. OF TRANSPORTATION	DATE

SURVEY PLOTTED BY	DATE
DRAWN BY	
DESIGNED BY	
CHECKED BY	
ORIGINAL PLAN	
NOTE BOOK	
No.	