



FED. ROAD DIST. NO.	STATE	FED. AID PROJ. NO.	FISCAL YEAR	SHEET NO.	TOTAL SHEETS
HAWAII	HAW.	STP-8930(2)	2007	ADD. 187	331

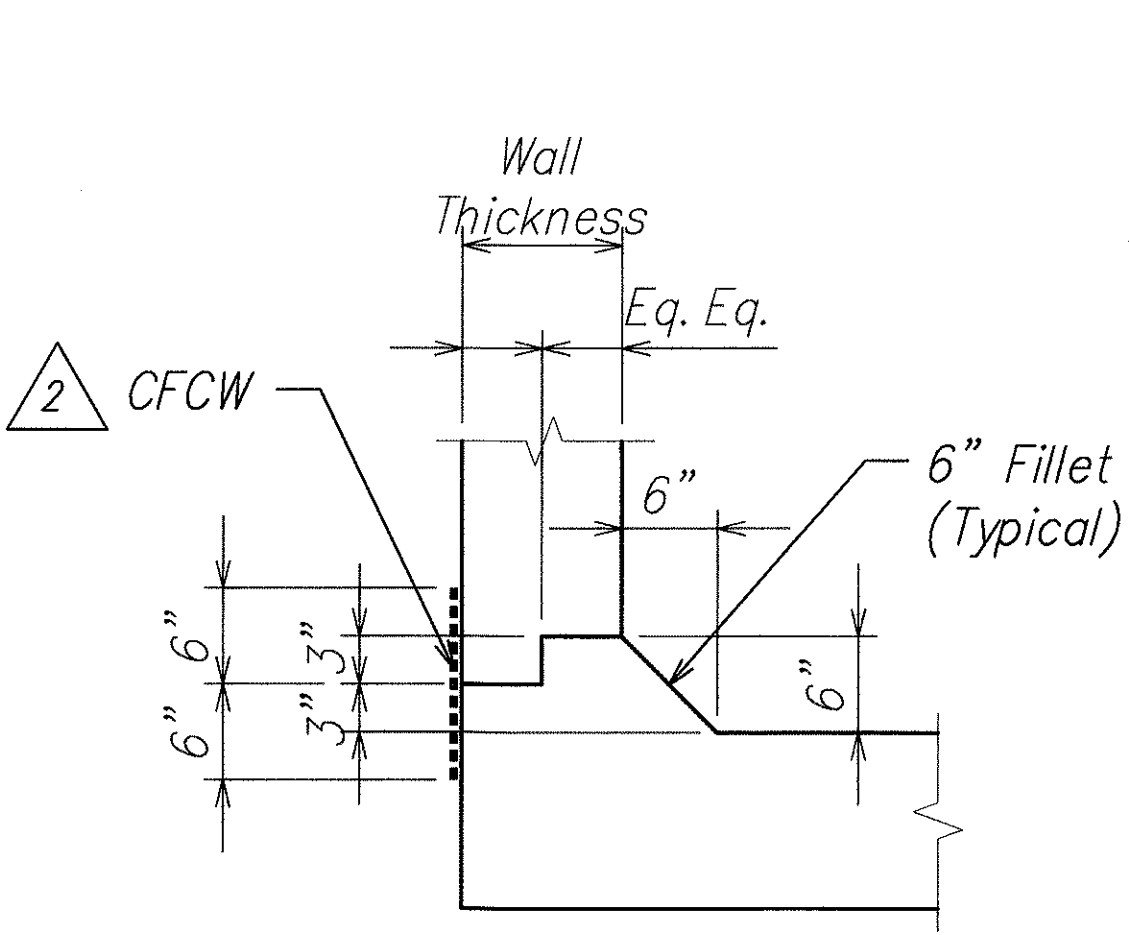

TYPICAL FILLET
KEY DETAIL

Scale: 1" = 1'-0"


S3.1, S4.2

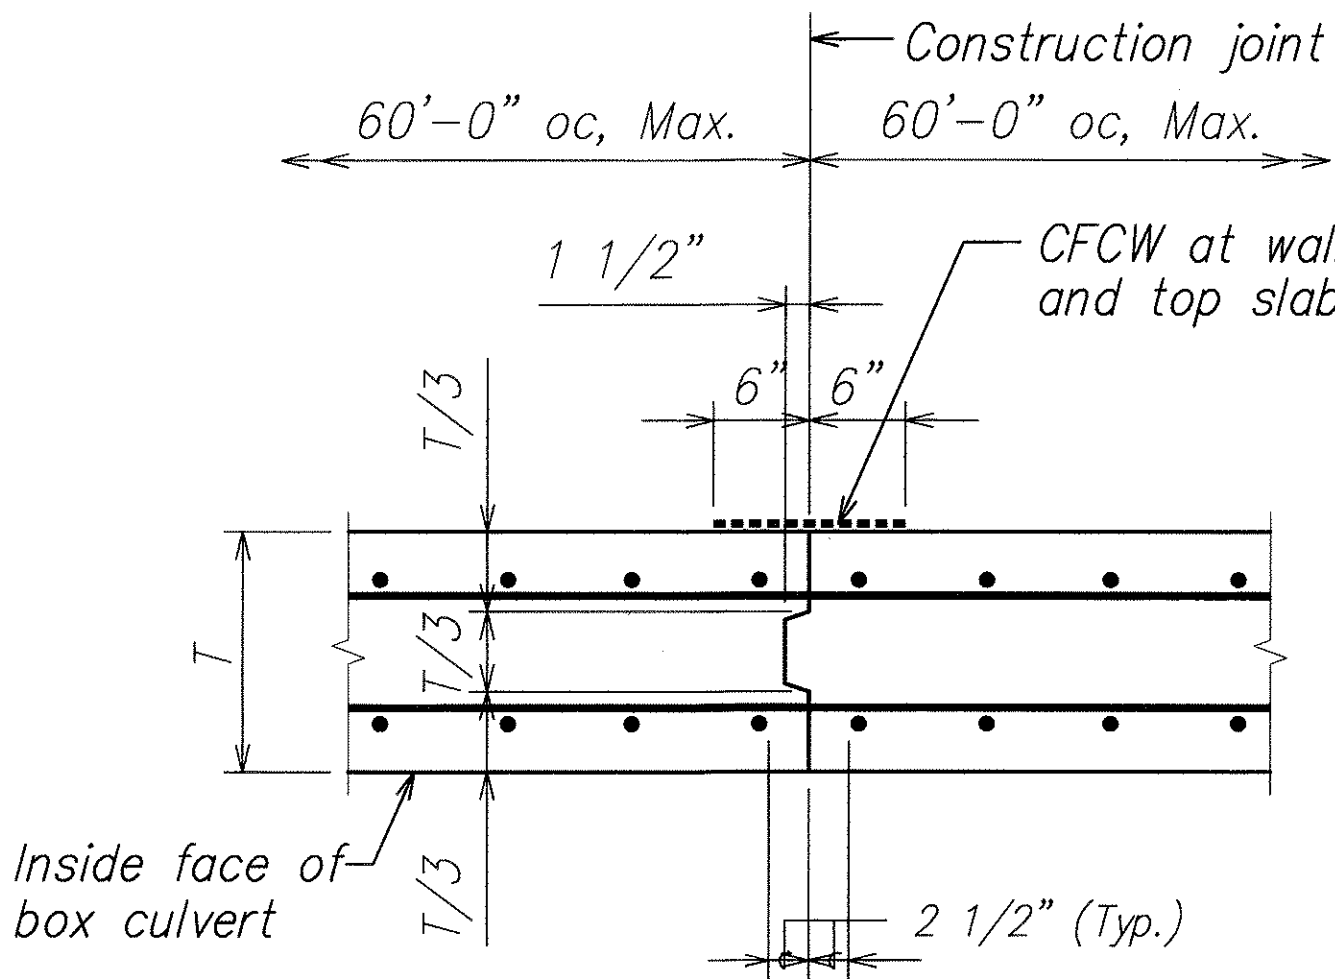

CONSTRUCTION
JOINT DETAIL

Scale: 1" = 1'-0"


S1.2 | S1.2

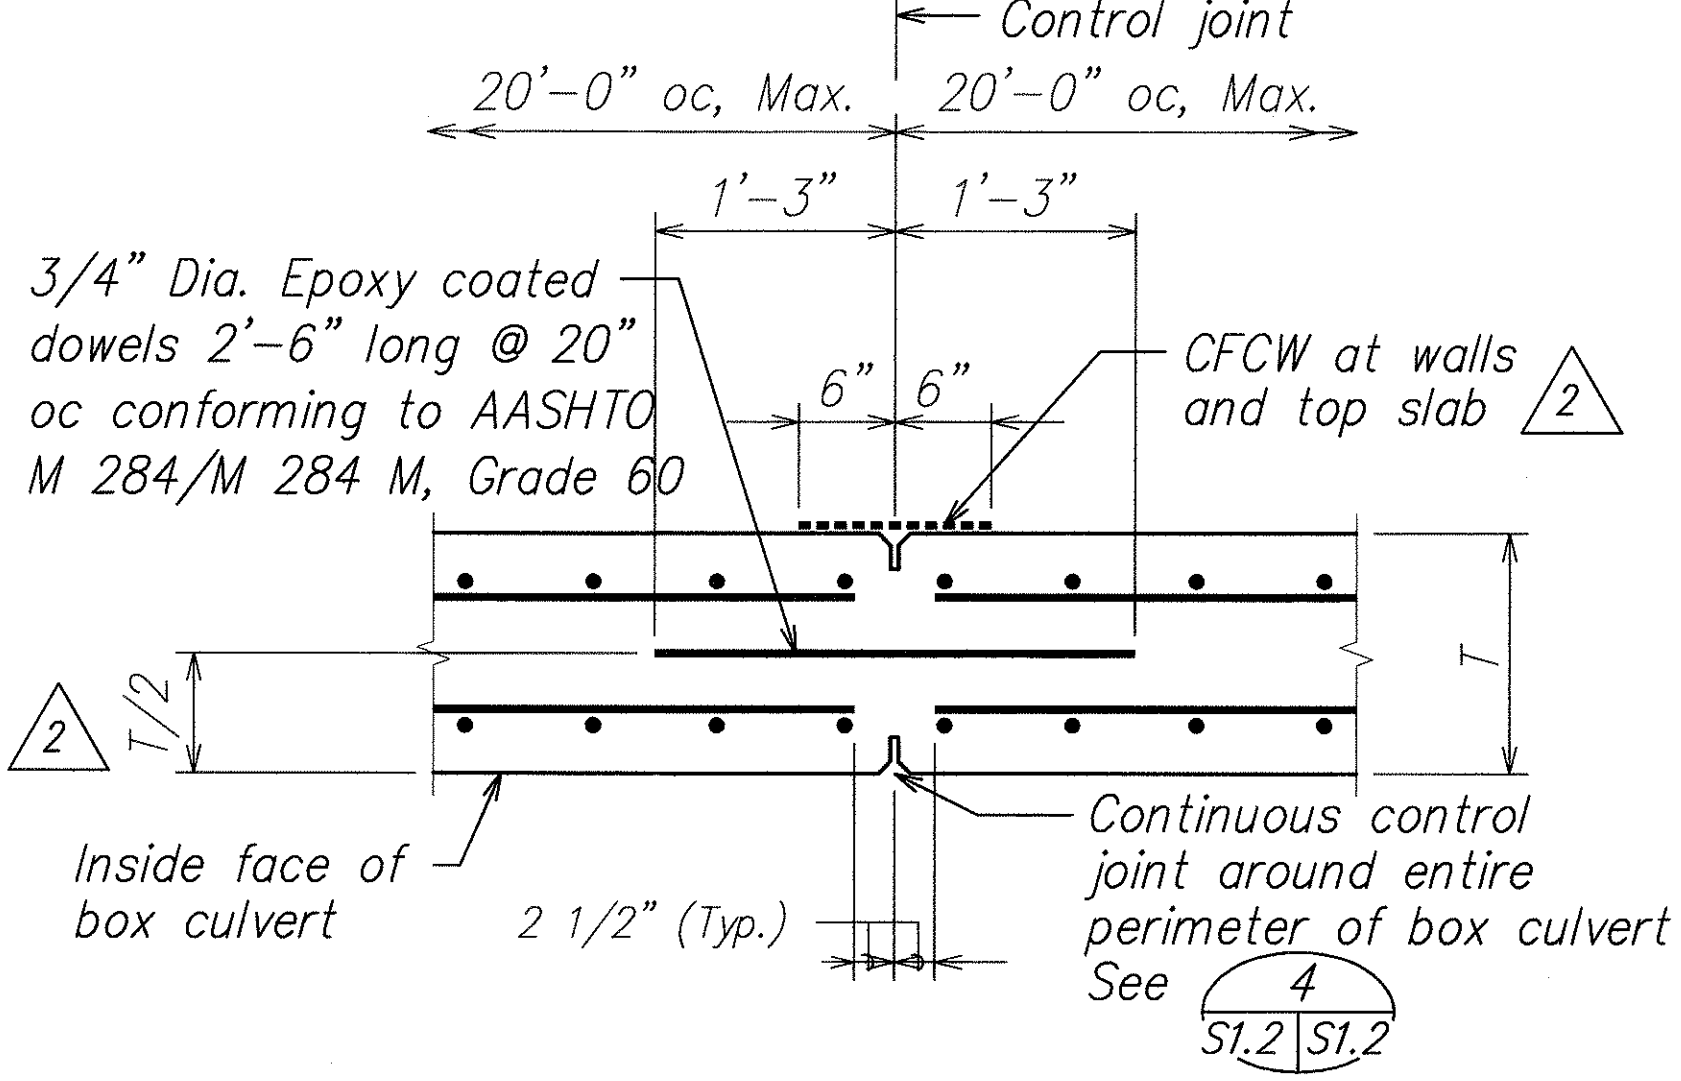

ALTERNATE
CONTROL JOINT DETAIL

Scale: 1" = 1'-0"


S1.2 | S1.2

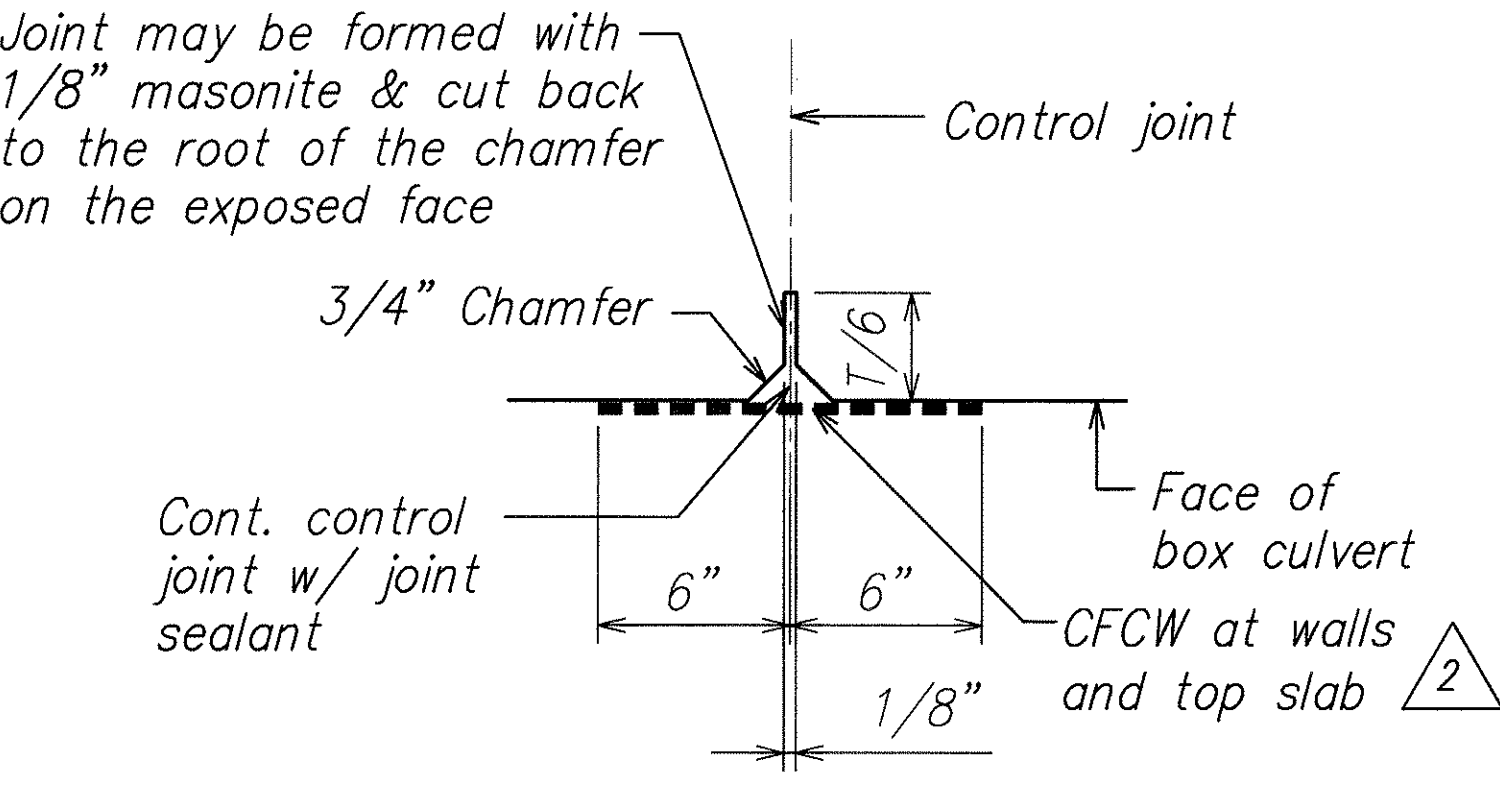

CONTROL JOINT DETAIL

Scale: 3" = 1'-0"

S1.2 | S1.2

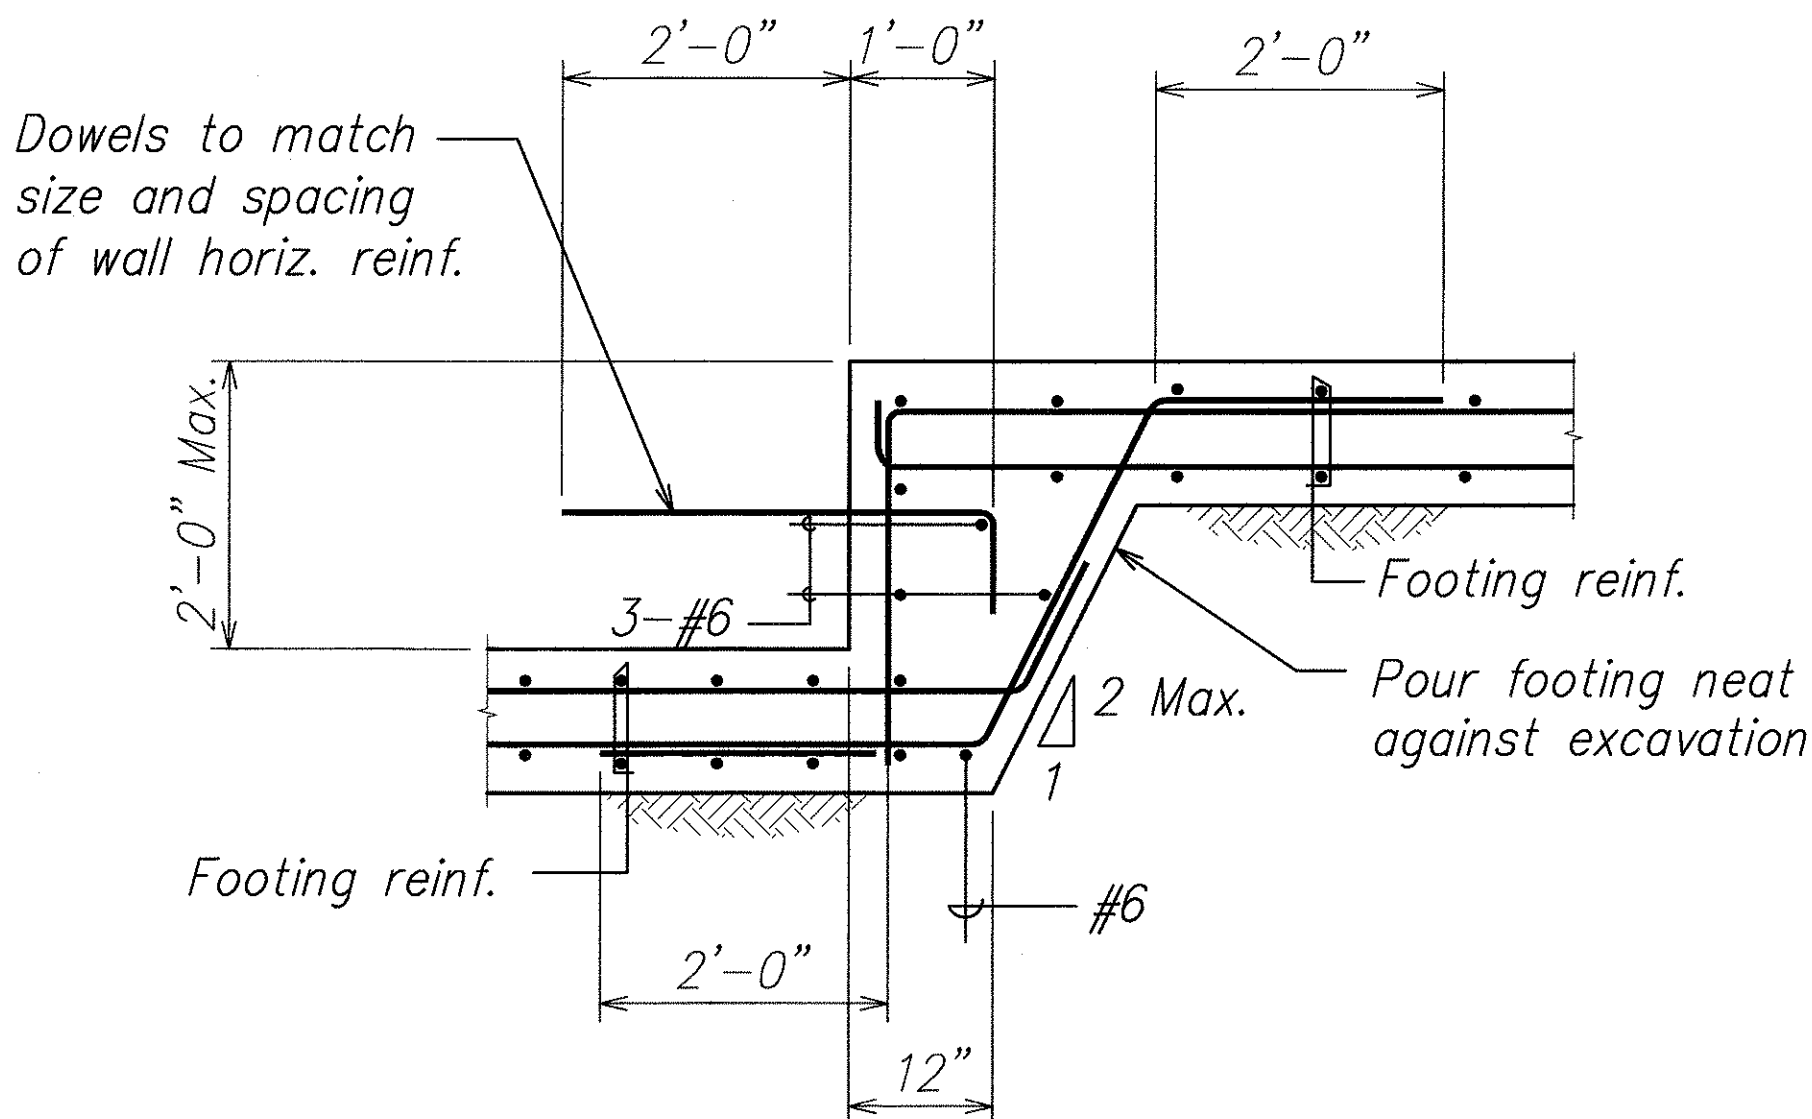


TYPICAL FOOTING STEP DETAIL

Scale: 3/4" = 1'-0"

S3.12 | S1.2

S4.4

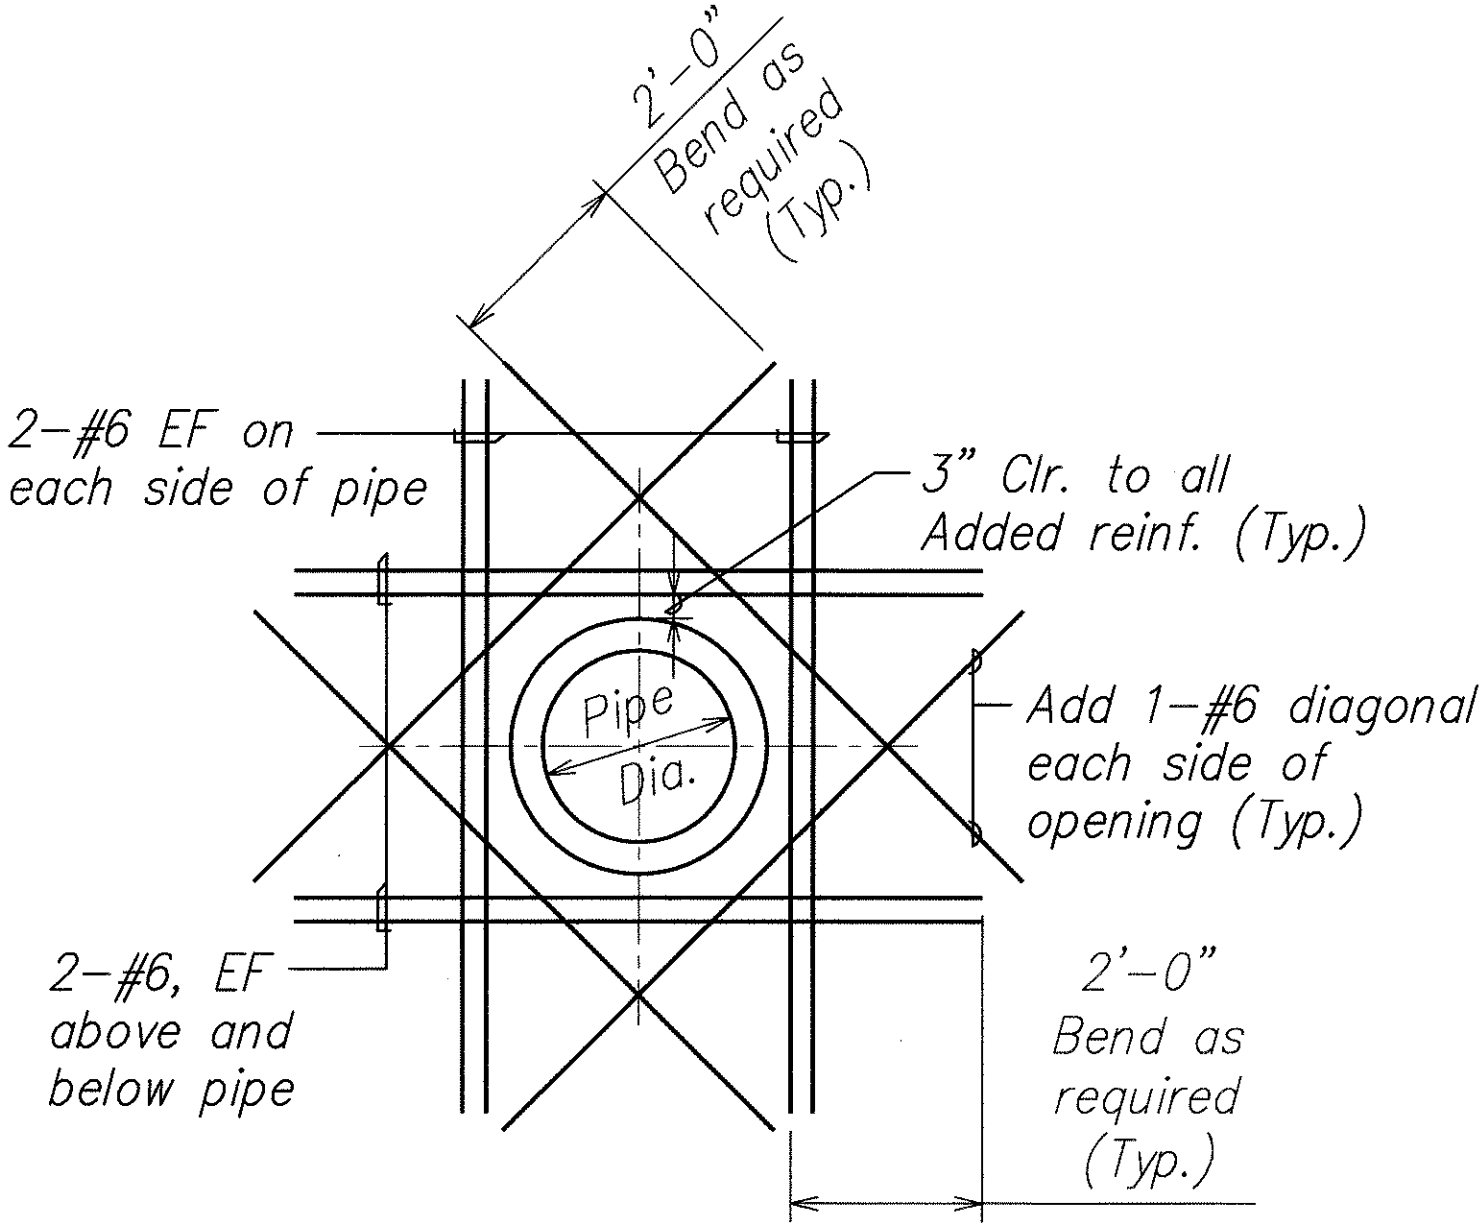


ADDED REINFORCING AT
PIPE OPENING

SCALE: 1/2" = 1'-0"

S1.2 | S1.2

S3.5, S3.8, S6.3, S6.6, S6.8, S6.10, S7.1, S7.2, S7.3, S7.4

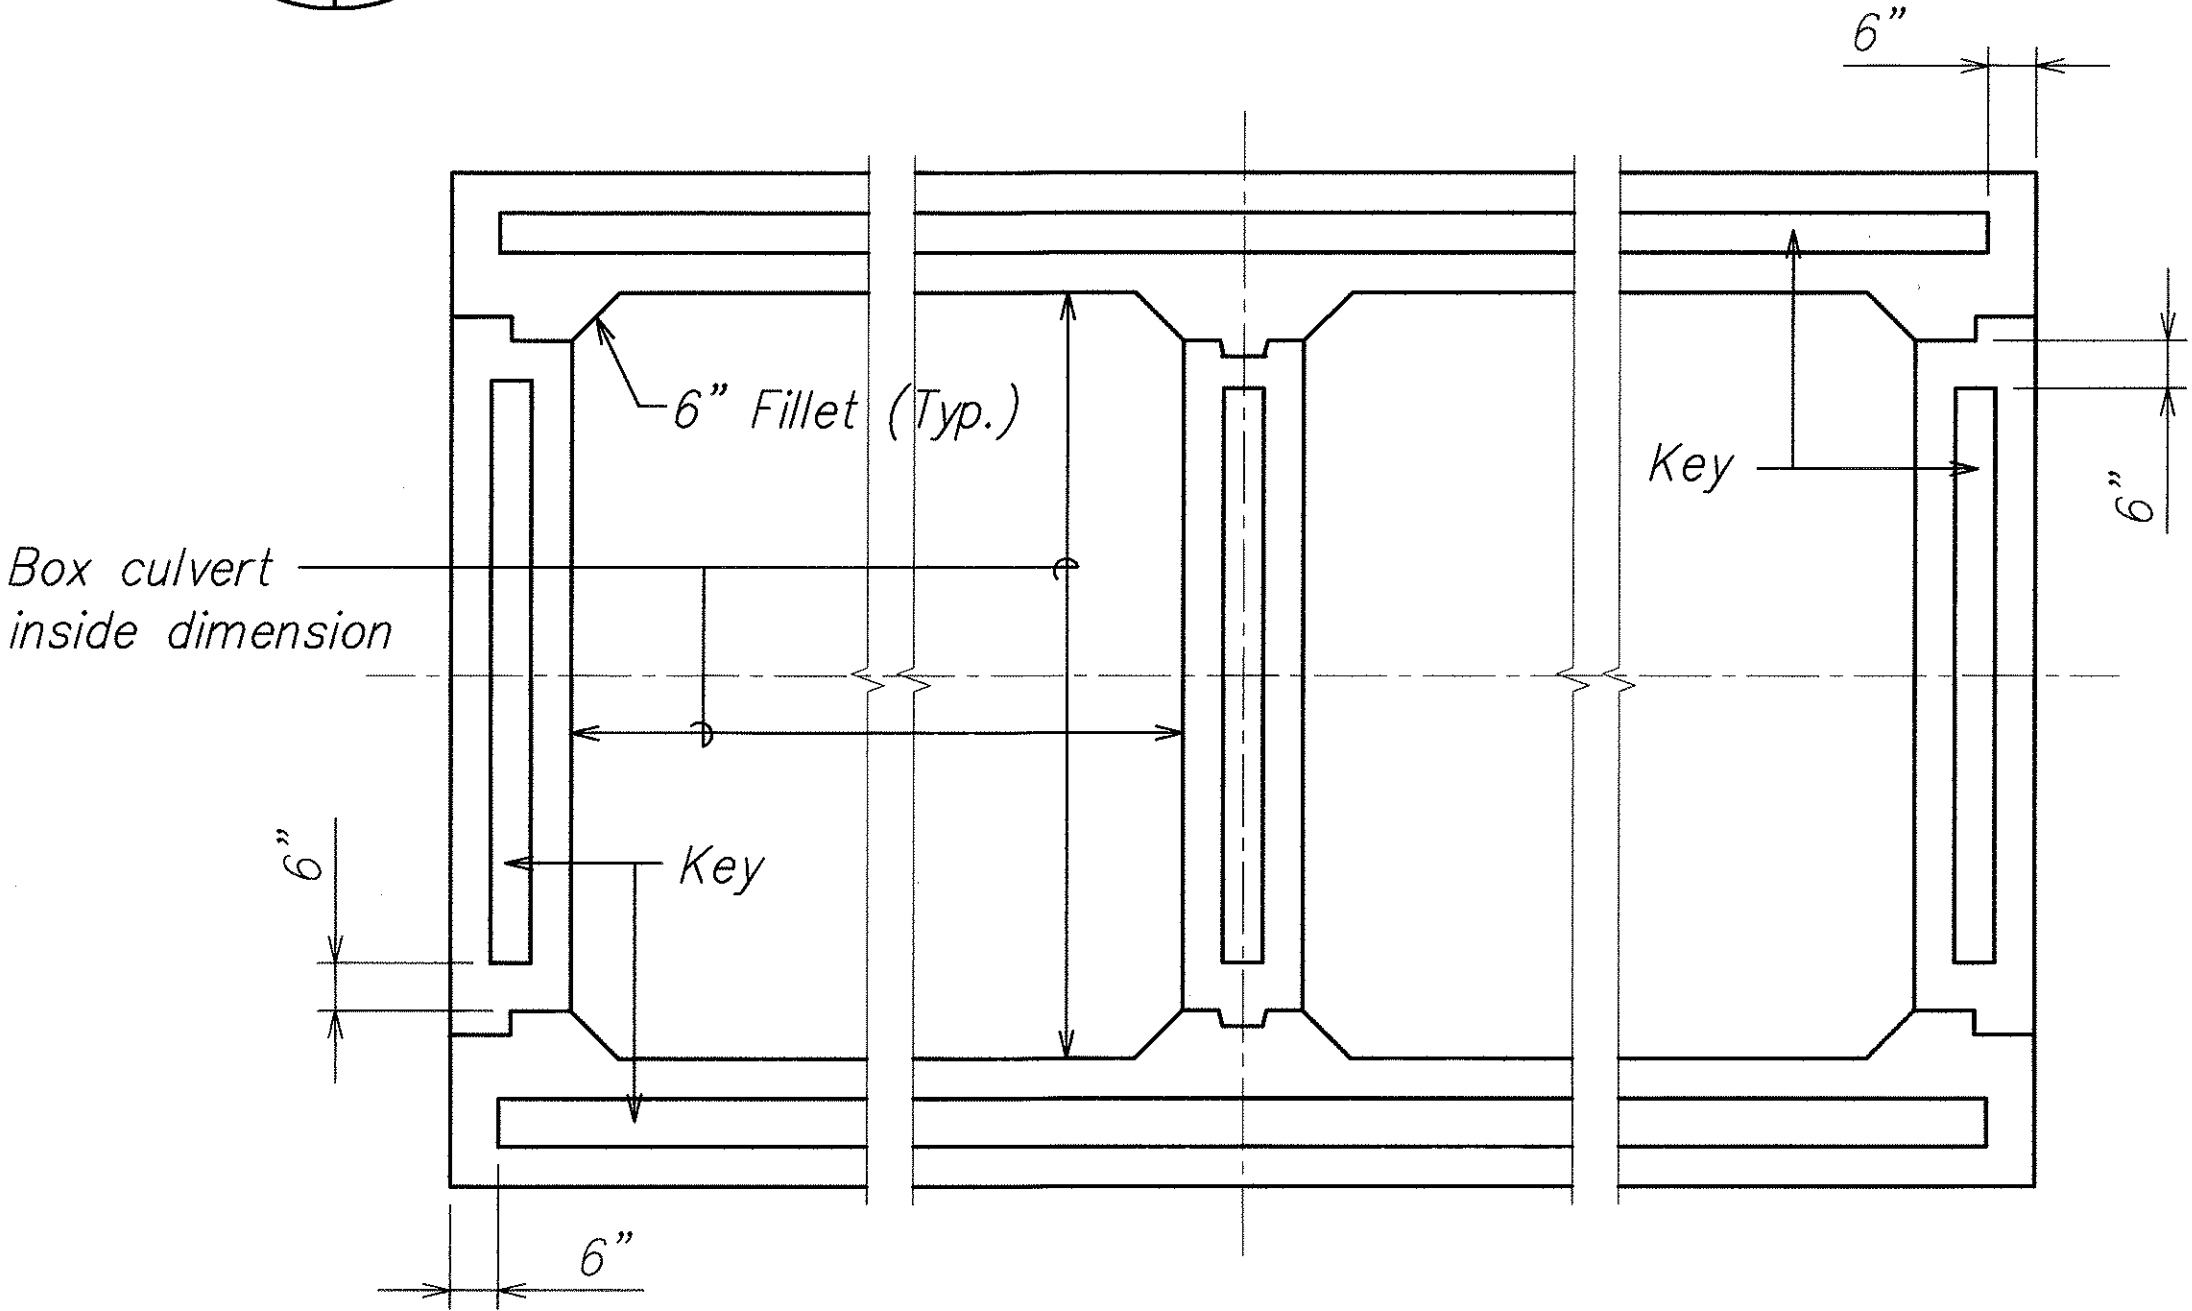

CONSTRUCTION JOINT KEY SCHEMATIC

Scale: 1/2" = 1'-0"

S1.2 | S1.2

5/11/07	2	Revised Notes
DATE	REVISION	
STATE OF HAWAII DEPARTMENT OF TRANSPORTATION HIGHWAYS DIVISION		
<u>TYPICAL DETAILS</u>		
<u>North-South Road</u>		
<u>Phase 1B</u>		
<u>F.A.I. Proj. No. STP-8930(2)</u>		
Scale: As Noted		Date: Feb. 21, 2007
SHEET No. S1.2 OF 78 SHEETS		



THIS WORK WAS PREPARED BY
ME OR UNDER MY SUPERVISION.

Signature: David K. Fujiwara
EXPIRATION DATE OF THE LICENSE: 4-30-08