



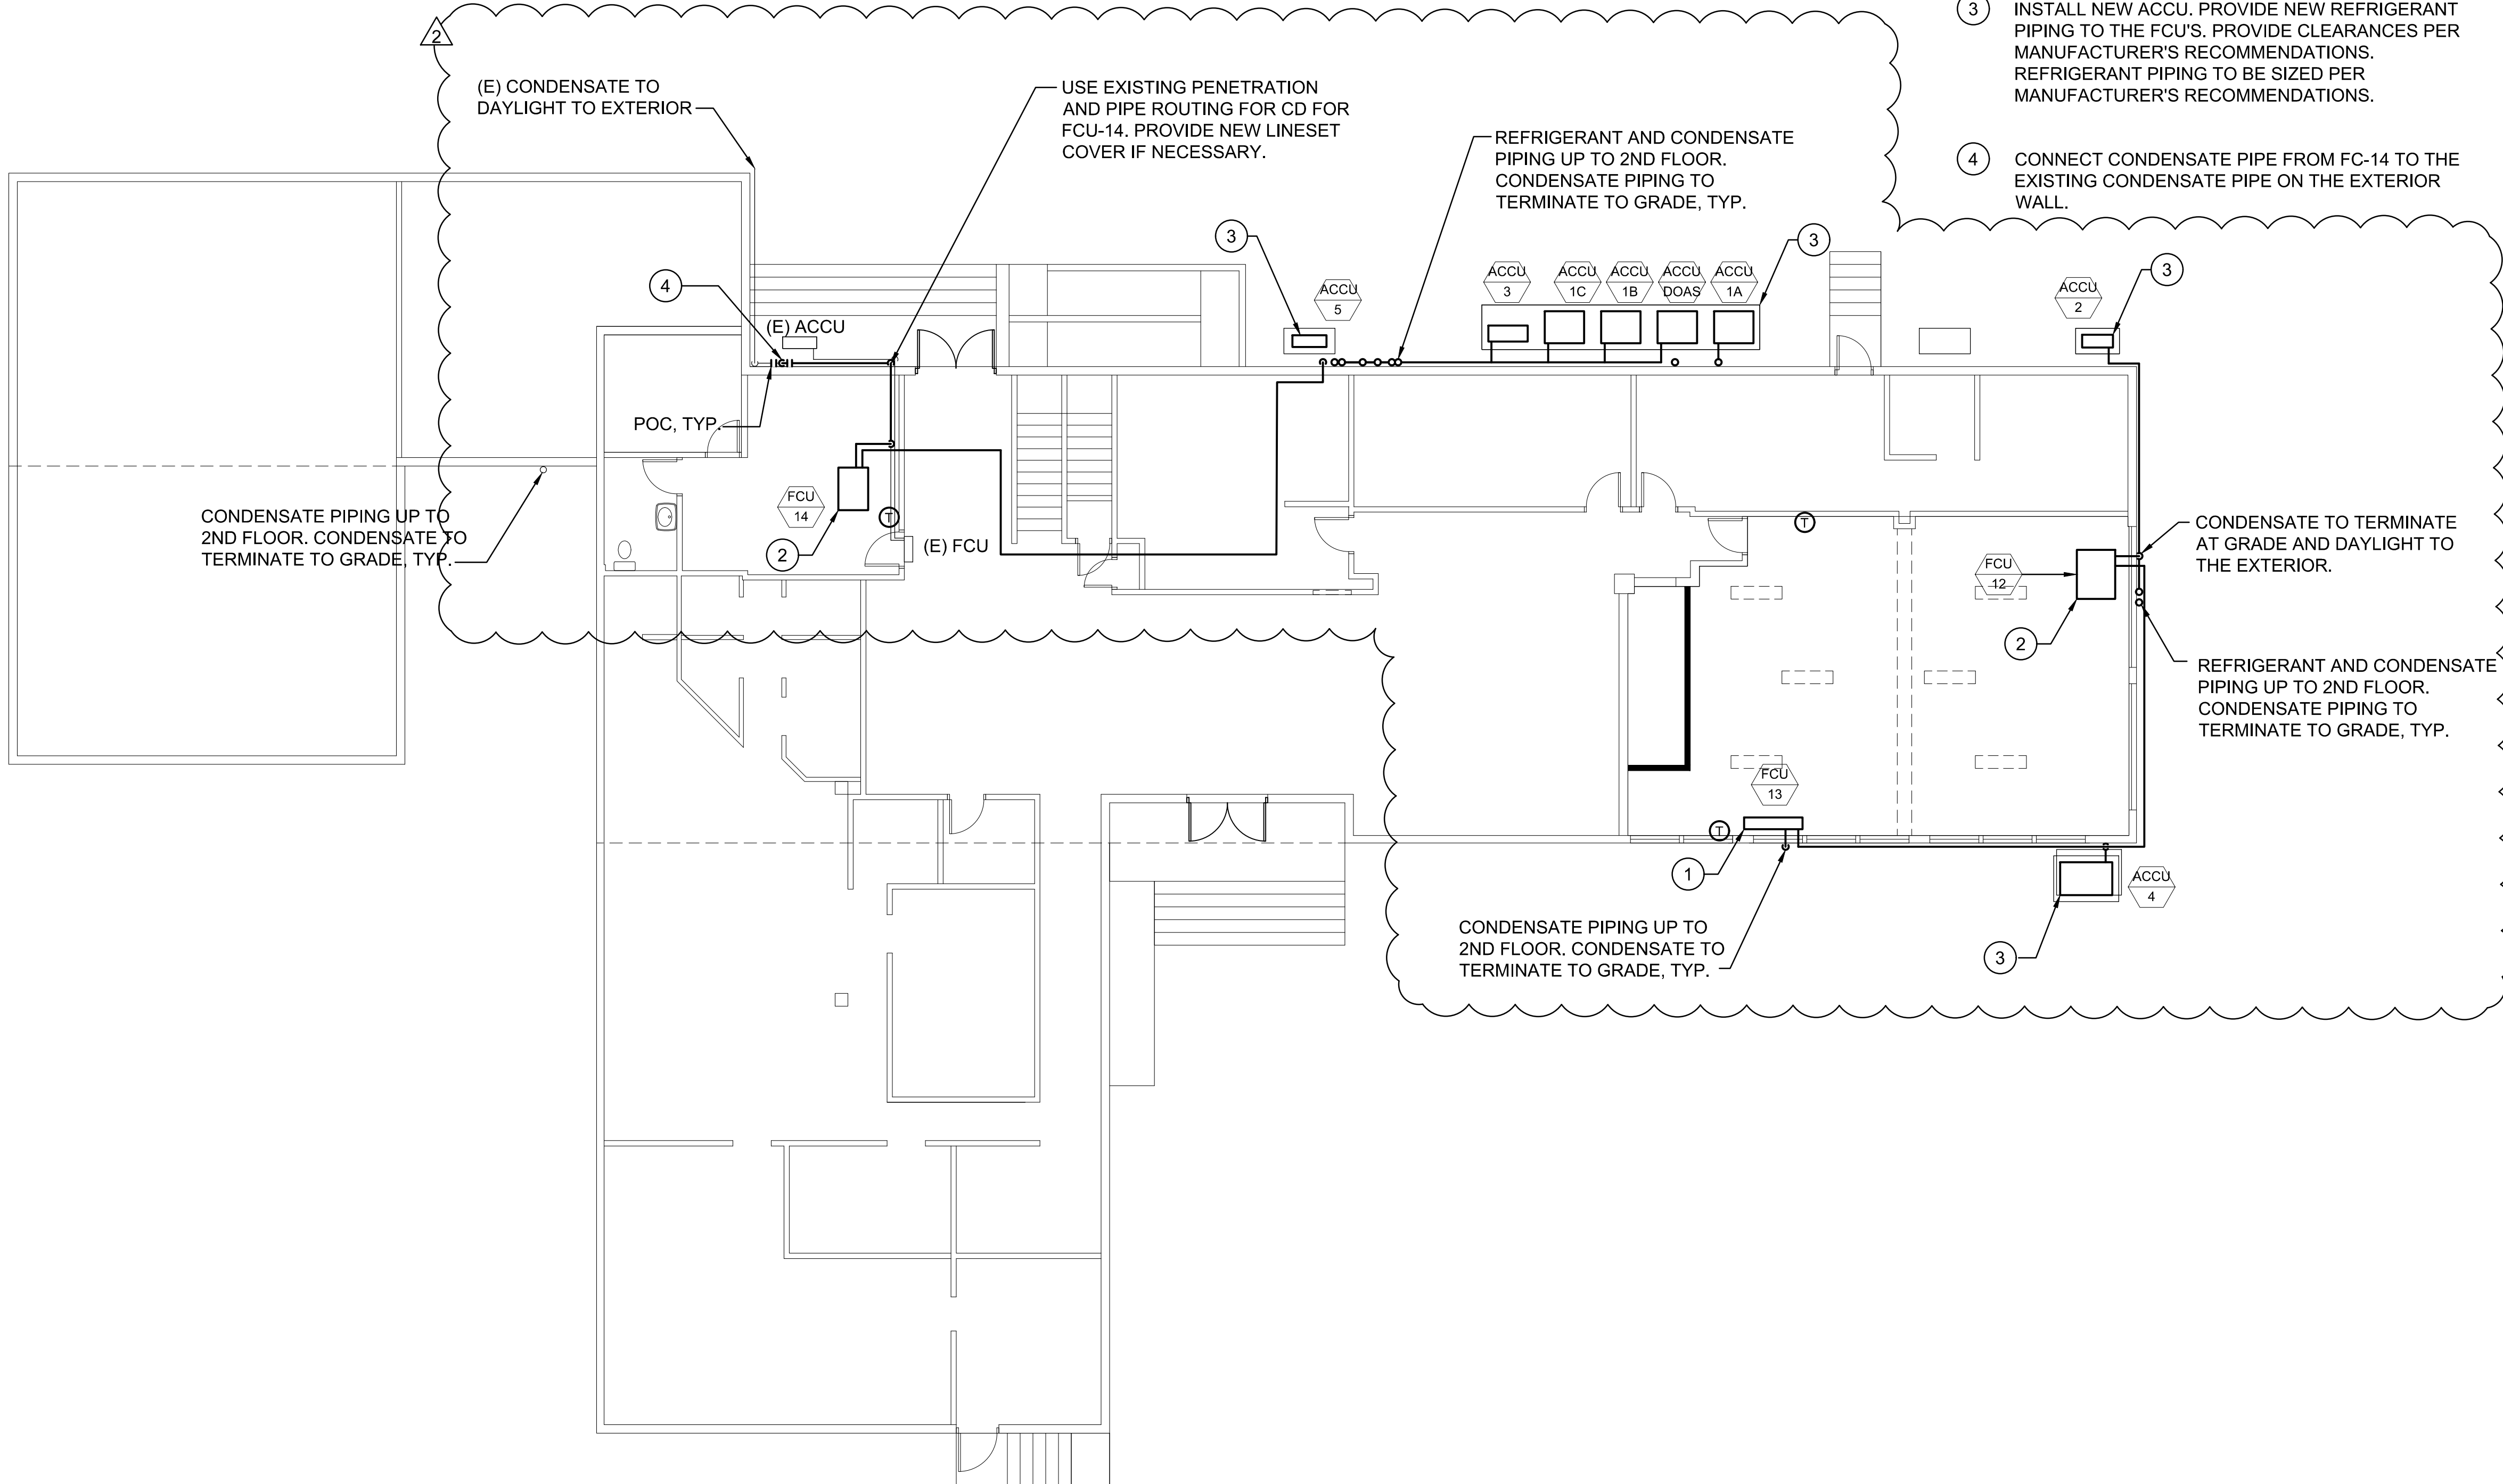


MECHANICAL NEW WORK NOTES

- 1 INSTALL NEW WALL MOUNTED FCU, T-STAT, REFRIGERANT PIPING, AND CONDENSATE PIPING.
- 2 INSTALL NEW FCU, T-STAT, REFRIGERANT PIPING, AND CONDENSATE PIPING.
- 3 INSTALL NEW ACCU. PROVIDE NEW REFRIGERANT PIPING TO THE FCU'S. PROVIDE CLEARANCES PER MANUFACTURER'S RECOMMENDATIONS. REFRIGERANT PIPING TO BE SIZED PER MANUFACTURER'S RECOMMENDATIONS.
- 4 CONNECT CONDENSATE PIPE FROM FC-14 TO THE EXISTING CONDENSATE PIPE ON THE EXTERIOR WALL.

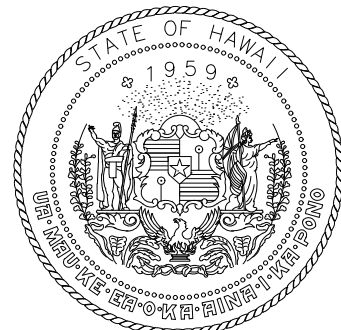

Airports Division
DEPARTMENT OF TRANSPORTATION
STATE OF HAWAII

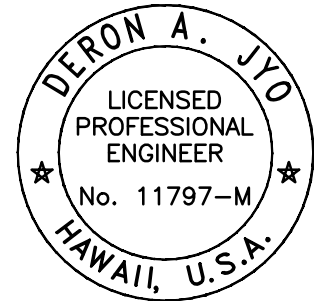

Deron A. Joo
This work was prepared by me or under my supervision.

DSGN.	DRWN.	CHKD.	APPD.

NO.	DATE	REVISIONS
2	11/18/22	ADDENDUM #2
1	11/03/22	ADDENDUM #1

FINAL
SUBMITTAL

09/30/22
DATE

PROJECT TITLE :

AIR TRAFFIC CONTROL
TOWER REPAIRS

AT
KALAELOA AIRPORT
BARBERS POINT, OAHU, HAWAII

PROJECT NO.:

AO5024-03

SHEET TITLE:

AIR TRAFFIC CONTROL
TOWER, 1ST LEVEL
MECHANICAL PIPING &
INSTRUMENTATION
PLAN

DATE :	DWG. NO.
9/30/22	M102
SHEET :	
28 OF 42 SHEET	

AIR TRAFFIC CONTROL TOWER 1ST LEVEL NEW PIPING AND INSTRUMENT PLAN

SCALE: 1/8" = 1'-0"

