



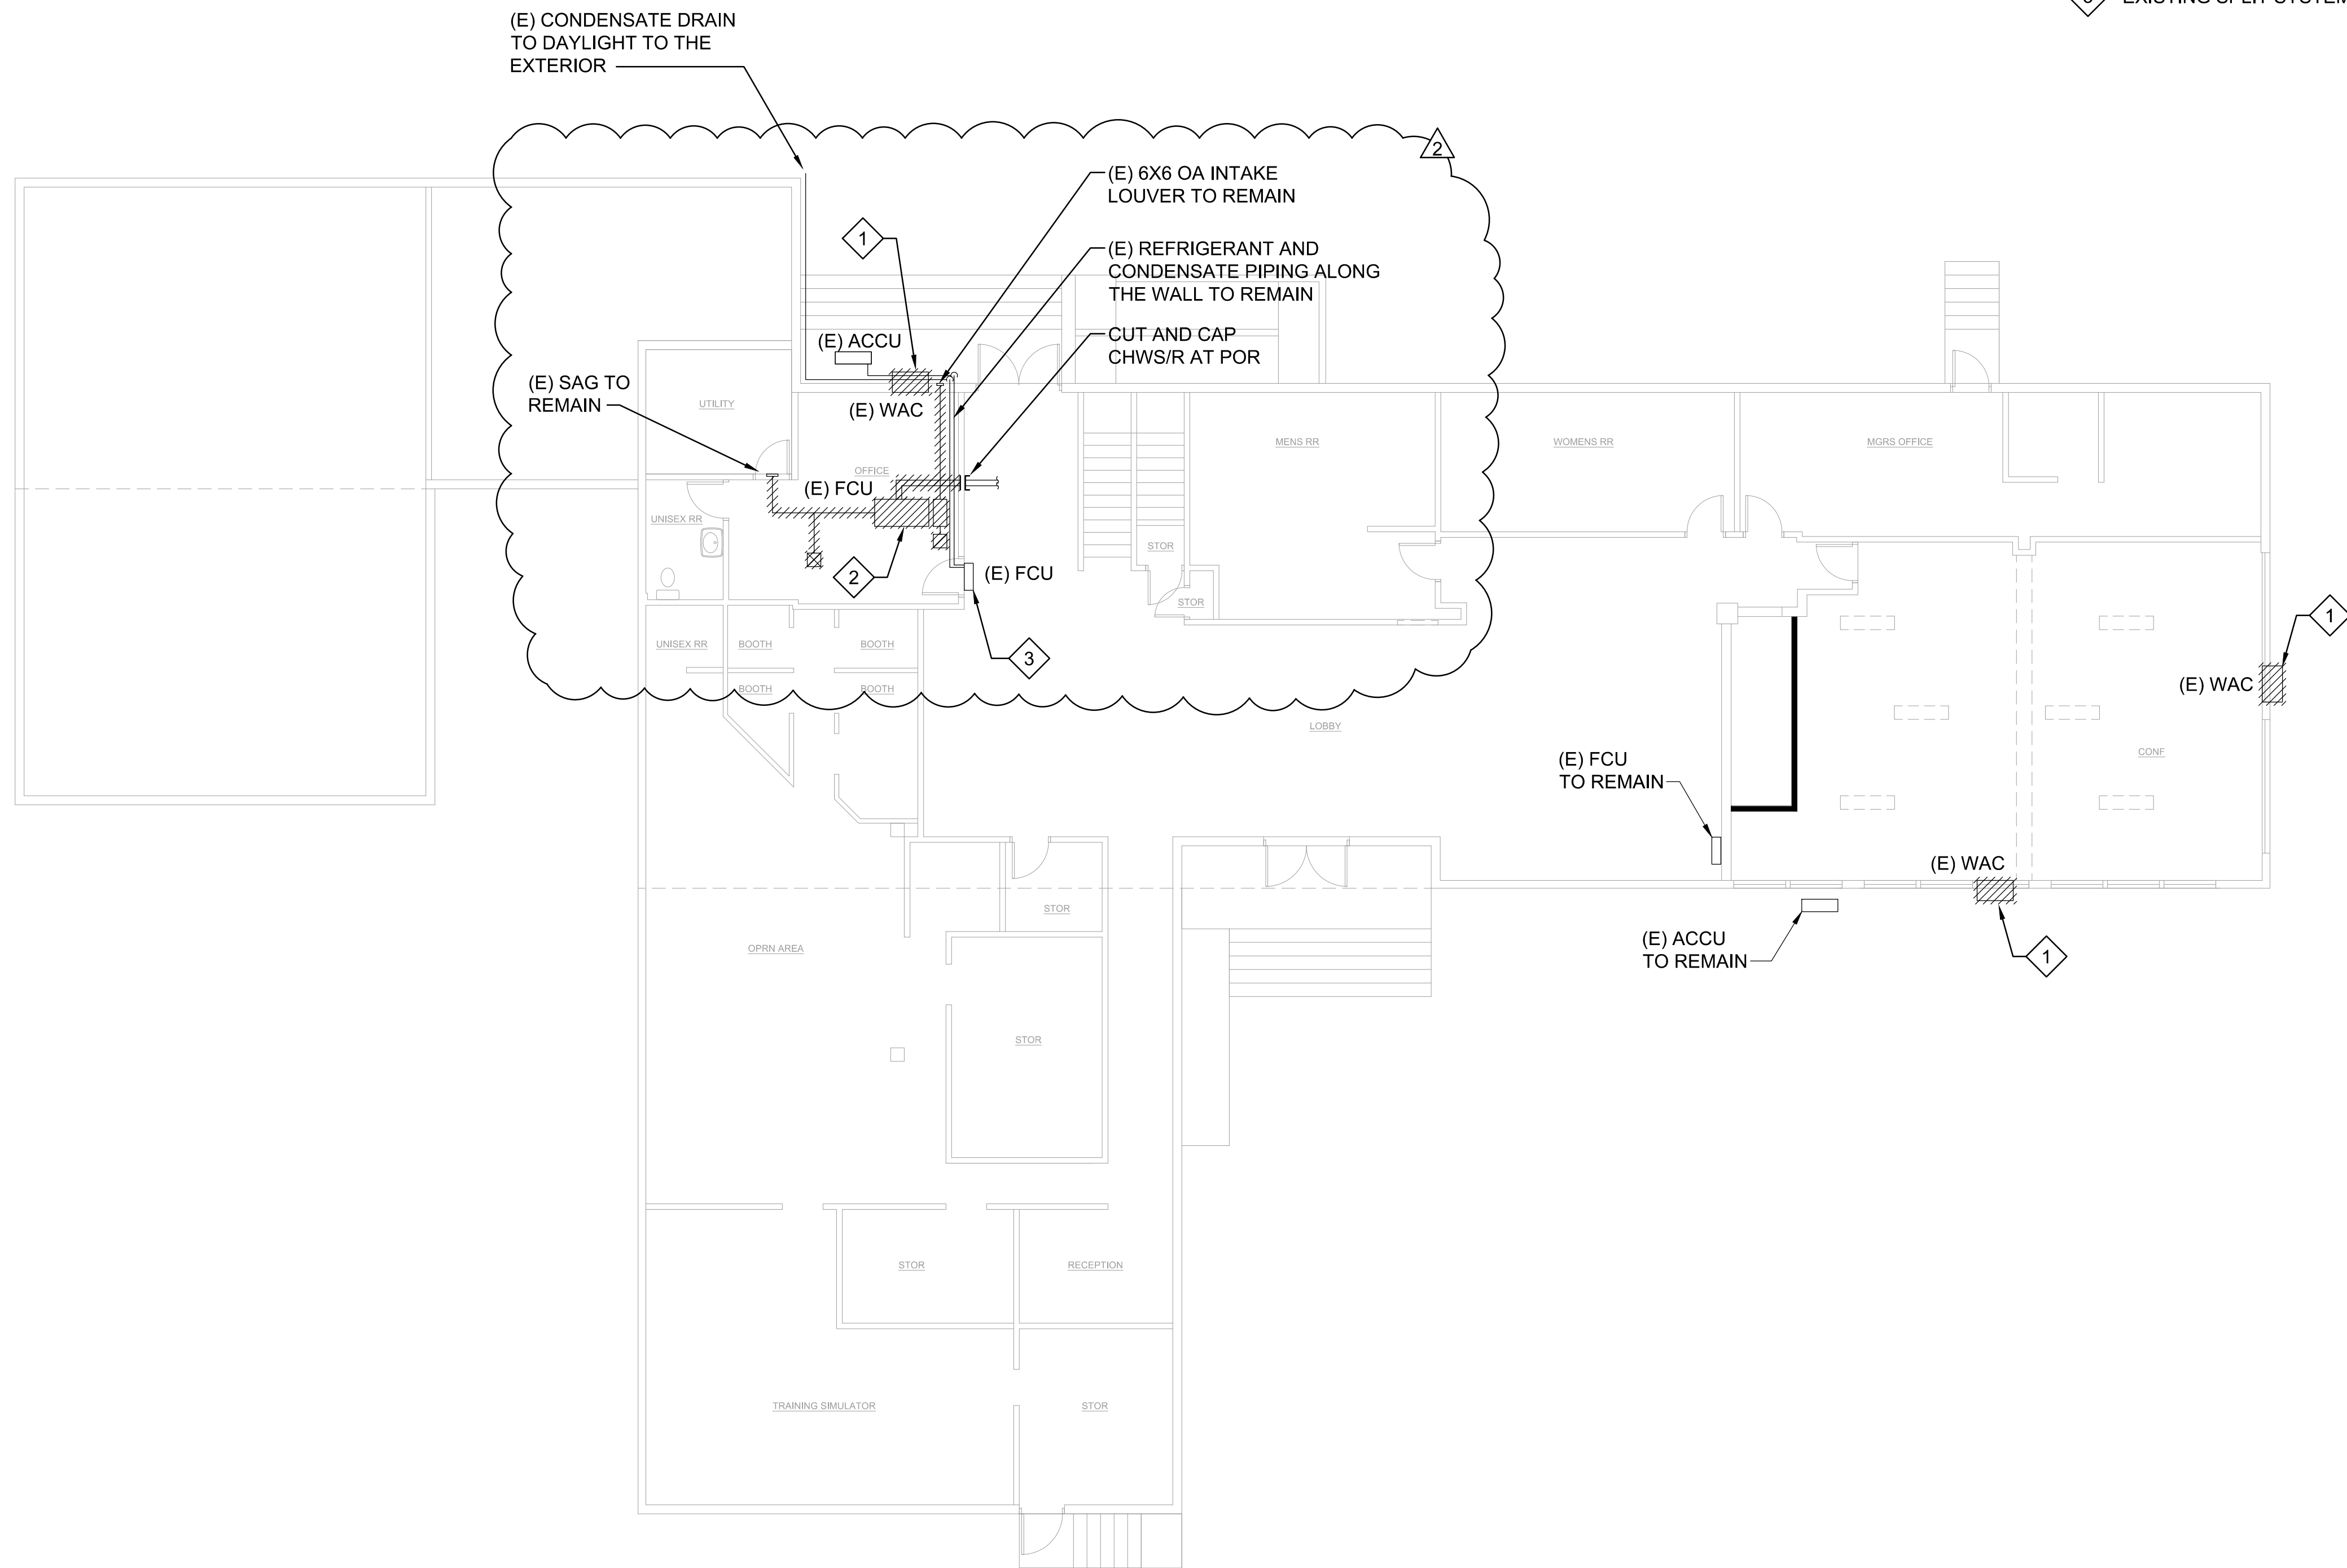


MECHANICAL DEMOLITION WORK NOTES

- 1 REMOVE EXISTING WAC UNIT.
- 2 REMOVE EXISTING FAN COIL UNIT, DUCTWORK, PIPING, AND AIR DEVICES UP TO POR.
- 3 EXISTING SPLIT SYSTEM UNIT TO REMAIN.

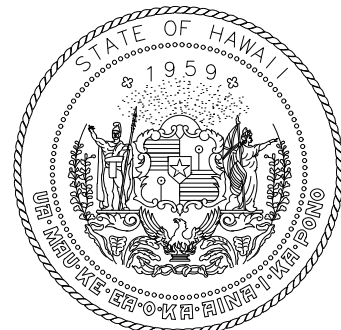

Airports Division
DEPARTMENT OF TRANSPORTATION
STATE OF HAWAII

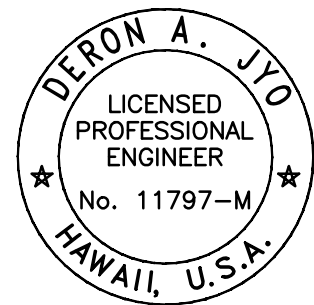

Deron A. Jyo
This work was prepared by me or under my supervision.

DSGN.	DRWN.	CHKD.	APPD.

NO.	DATE	REVISIONS
2	11/18/22	ADDENDUM #2
1	11/03/22	ADDENDUM #1

**FINAL
SUBMITTAL**
09/30/22
DATE

PROJECT TITLE :

**AIR TRAFFIC CONTROL
TOWER REPAIRS**
AT
KALAELOA AIRPORT
BARBERS POINT, OAHU, HAWAII

PROJECT NO.:

AO5024-03

SHEET TITLE:

**AIR TRAFFIC CONTROL
TOWER, 1ST LEVEL
MECHANICAL
REMOVAL PLAN**

DATE :	DWG. NO.
9/30/22	MD101
SHEET :	
26 OF 42 SHEET	

AIR TRAFFIC CONTROL TOWER 1ST LEVEL MECHANICAL REMOVAL PLAN

SCALE: 1/8" = 1'-0"

