



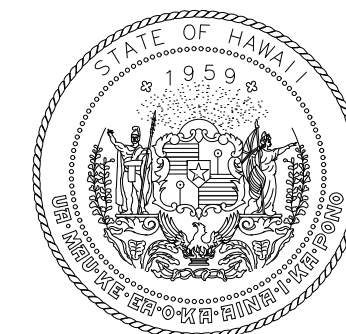

Airports Division
DEPARTMENT OF TRANSPORTATION
STATE OF HAWAII

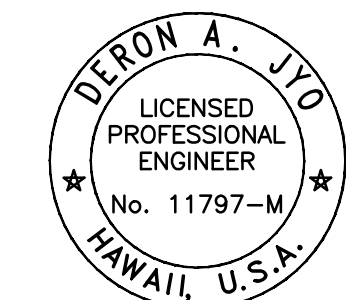

Deron A. Jyo
This work was prepared by me or under my supervision.

DSGN.	DRWN.	CHKD.	APPD.

NO.	DATE	REVISIONS
2	11/18/22	ADDENDUM #2
1	11/03/22	ADDENDUM #1

**FINAL
SUBMITTAL**
09/30/22
DATE

PROJECT TITLE :

**AIR TRAFFIC CONTROL
TOWER REPAIRS**
AT
KALAELOA AIRPORT
BARBERS POINT, OAHU, HAWAII

PROJECT NO.:

AO5024-03

SHEET TITLE:

**AIR TRAFFIC CONTROL
TOWER, 2ND LEVEL
MECHANICAL NEW
WORK PLAN**

DATE :	DWG. NO.
9/30/22	M103
SHEET :	
30 OF 42 SHEET	


MECHANICAL GENERAL NOTES

REFER TO M-103 FOR T-STAT LOCATIONS, AND REFRIGERANT AND CONDENSATE PIPE ROUTING.

PROVIDE CLEARANCES AROUND ALL HVAC EQUIPMENT PER MANUFACTURER'S RECOMMENDATION.

MECHANICAL NEW WORK NOTES

- 1 INSTALL NEW WALL MOUNTED FCU.
- 2 INSTALL NEW FCU'S, ACCESSORIES, T-STAT, DUCTWORK, DUCT ACCESSORIES, AND AIR DEVICES.
- 3 INSTALL NEW DOAS UNIT, ACCESSORIES, T-STAT, DUCTWORK, DUCT ACCESSORIES, AND AIR DEVICES.
- 4 INSTALL NEW ACCU AND ACCESORIES, TYP.

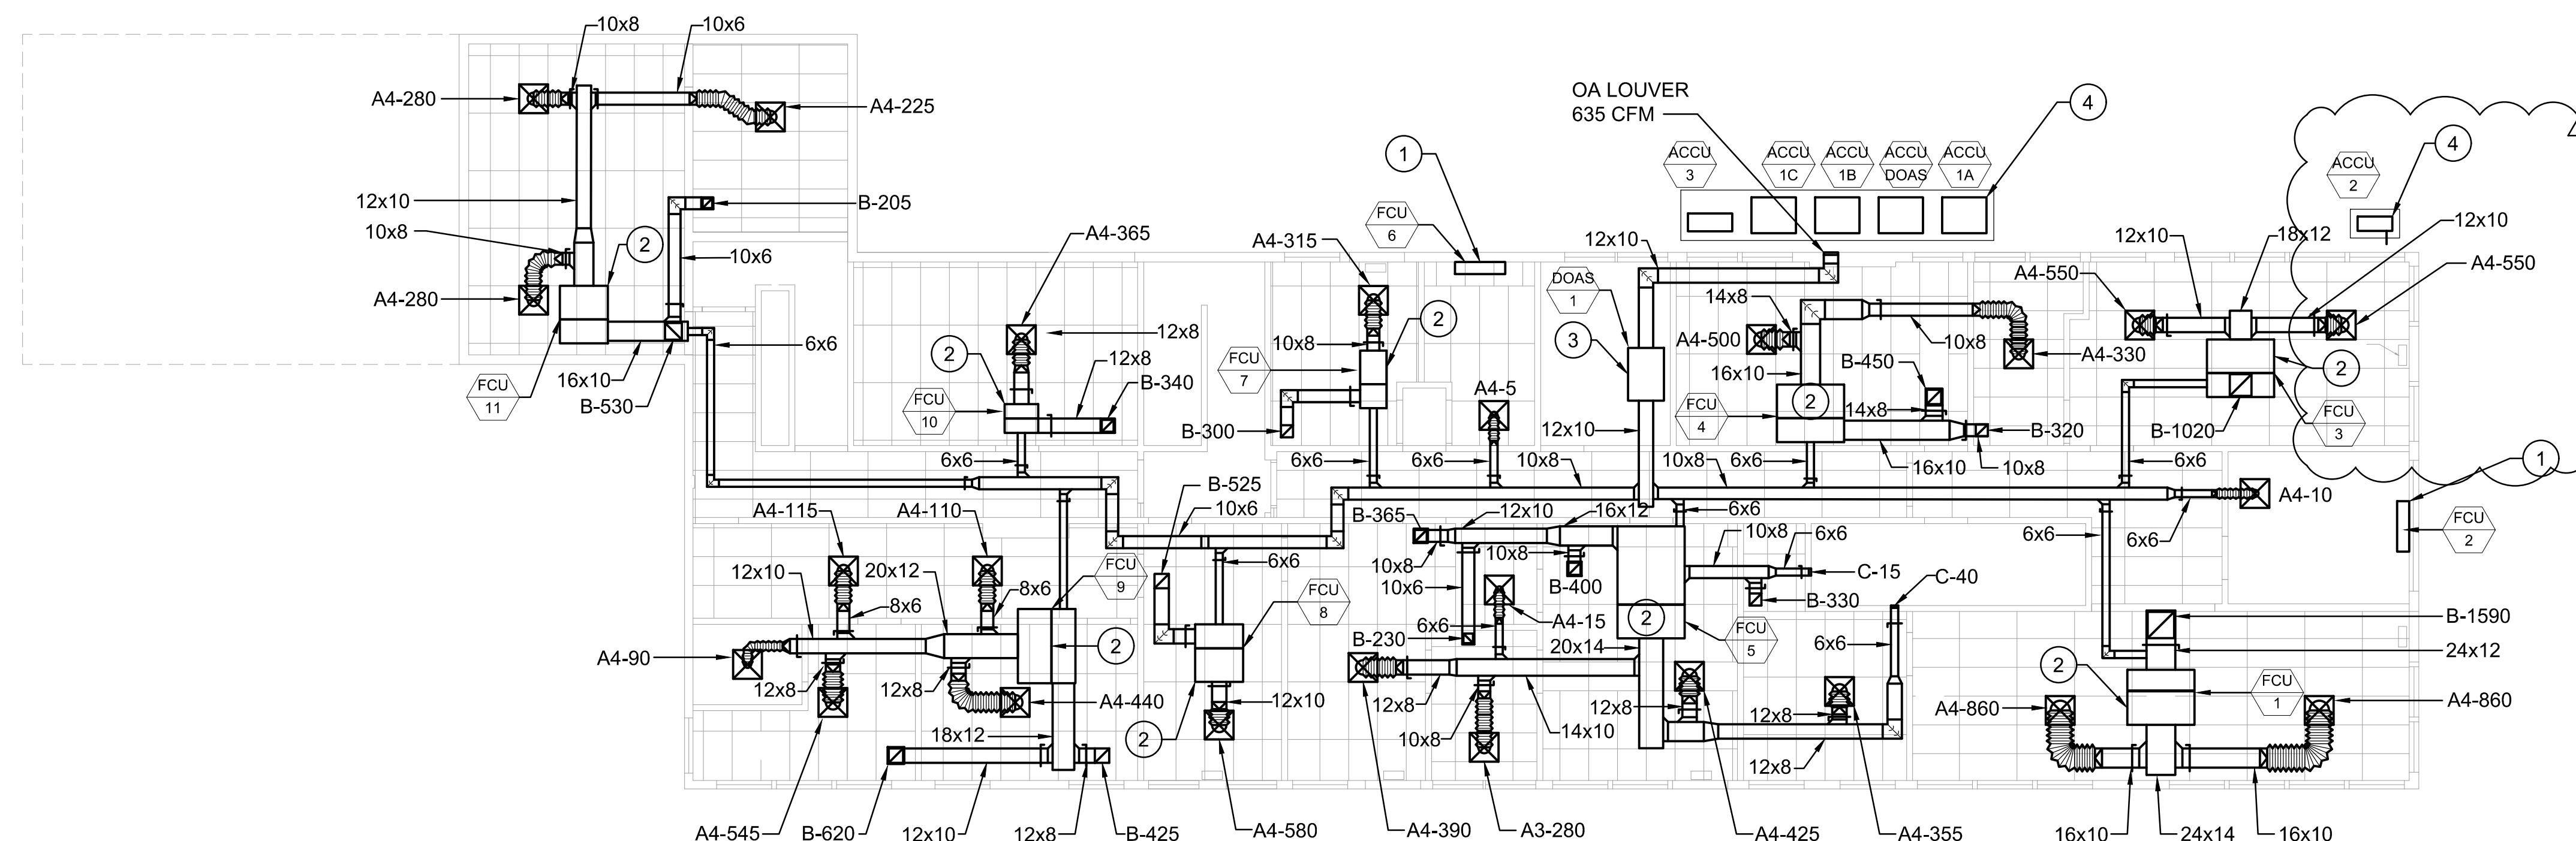

AIR TRAFFIC CONTROL TOWER 2ND LEVEL MECHANICAL NEW WORK PLAN

SCALE: 1/8" = 1'-0"

2' 0' 2' 4' 6' 10' 14'

