

Airports Division
DEPARTMENT OF TRANSPORTATION
STATE OF HAWAII



04/30/24

License Expiration Date

This work was prepared by me or under my supervision.

| DSGN. | DRWN. | CHKD. | APPD. |
|-------|-------|-------|-------|
| JY | JM | JY | - |

| NO. | DATE | REVISIONS |
|-----|------|-----------|
|-----|------|-----------|

FINAL SUBMITTAL

09/30/22

DATE

PROJECT TITLE :

AIR TRAFFIC CONTROL
TOWER REPAIRS

AT
KALAELOA AIRPORT
BARBERS POINT, OAHU, HAWAII


PROJECT NO.:

AO5024-03

SHEET TITLE:

CONTROL TOWER
ELECTRICAL
DEMOLITION PLAN

| DATE : | DWG. NO. |
|-----------------|----------|
| 09/30/22 | ED100 |
| SHEET : | |
| 21 OF 49 SHEETS | |

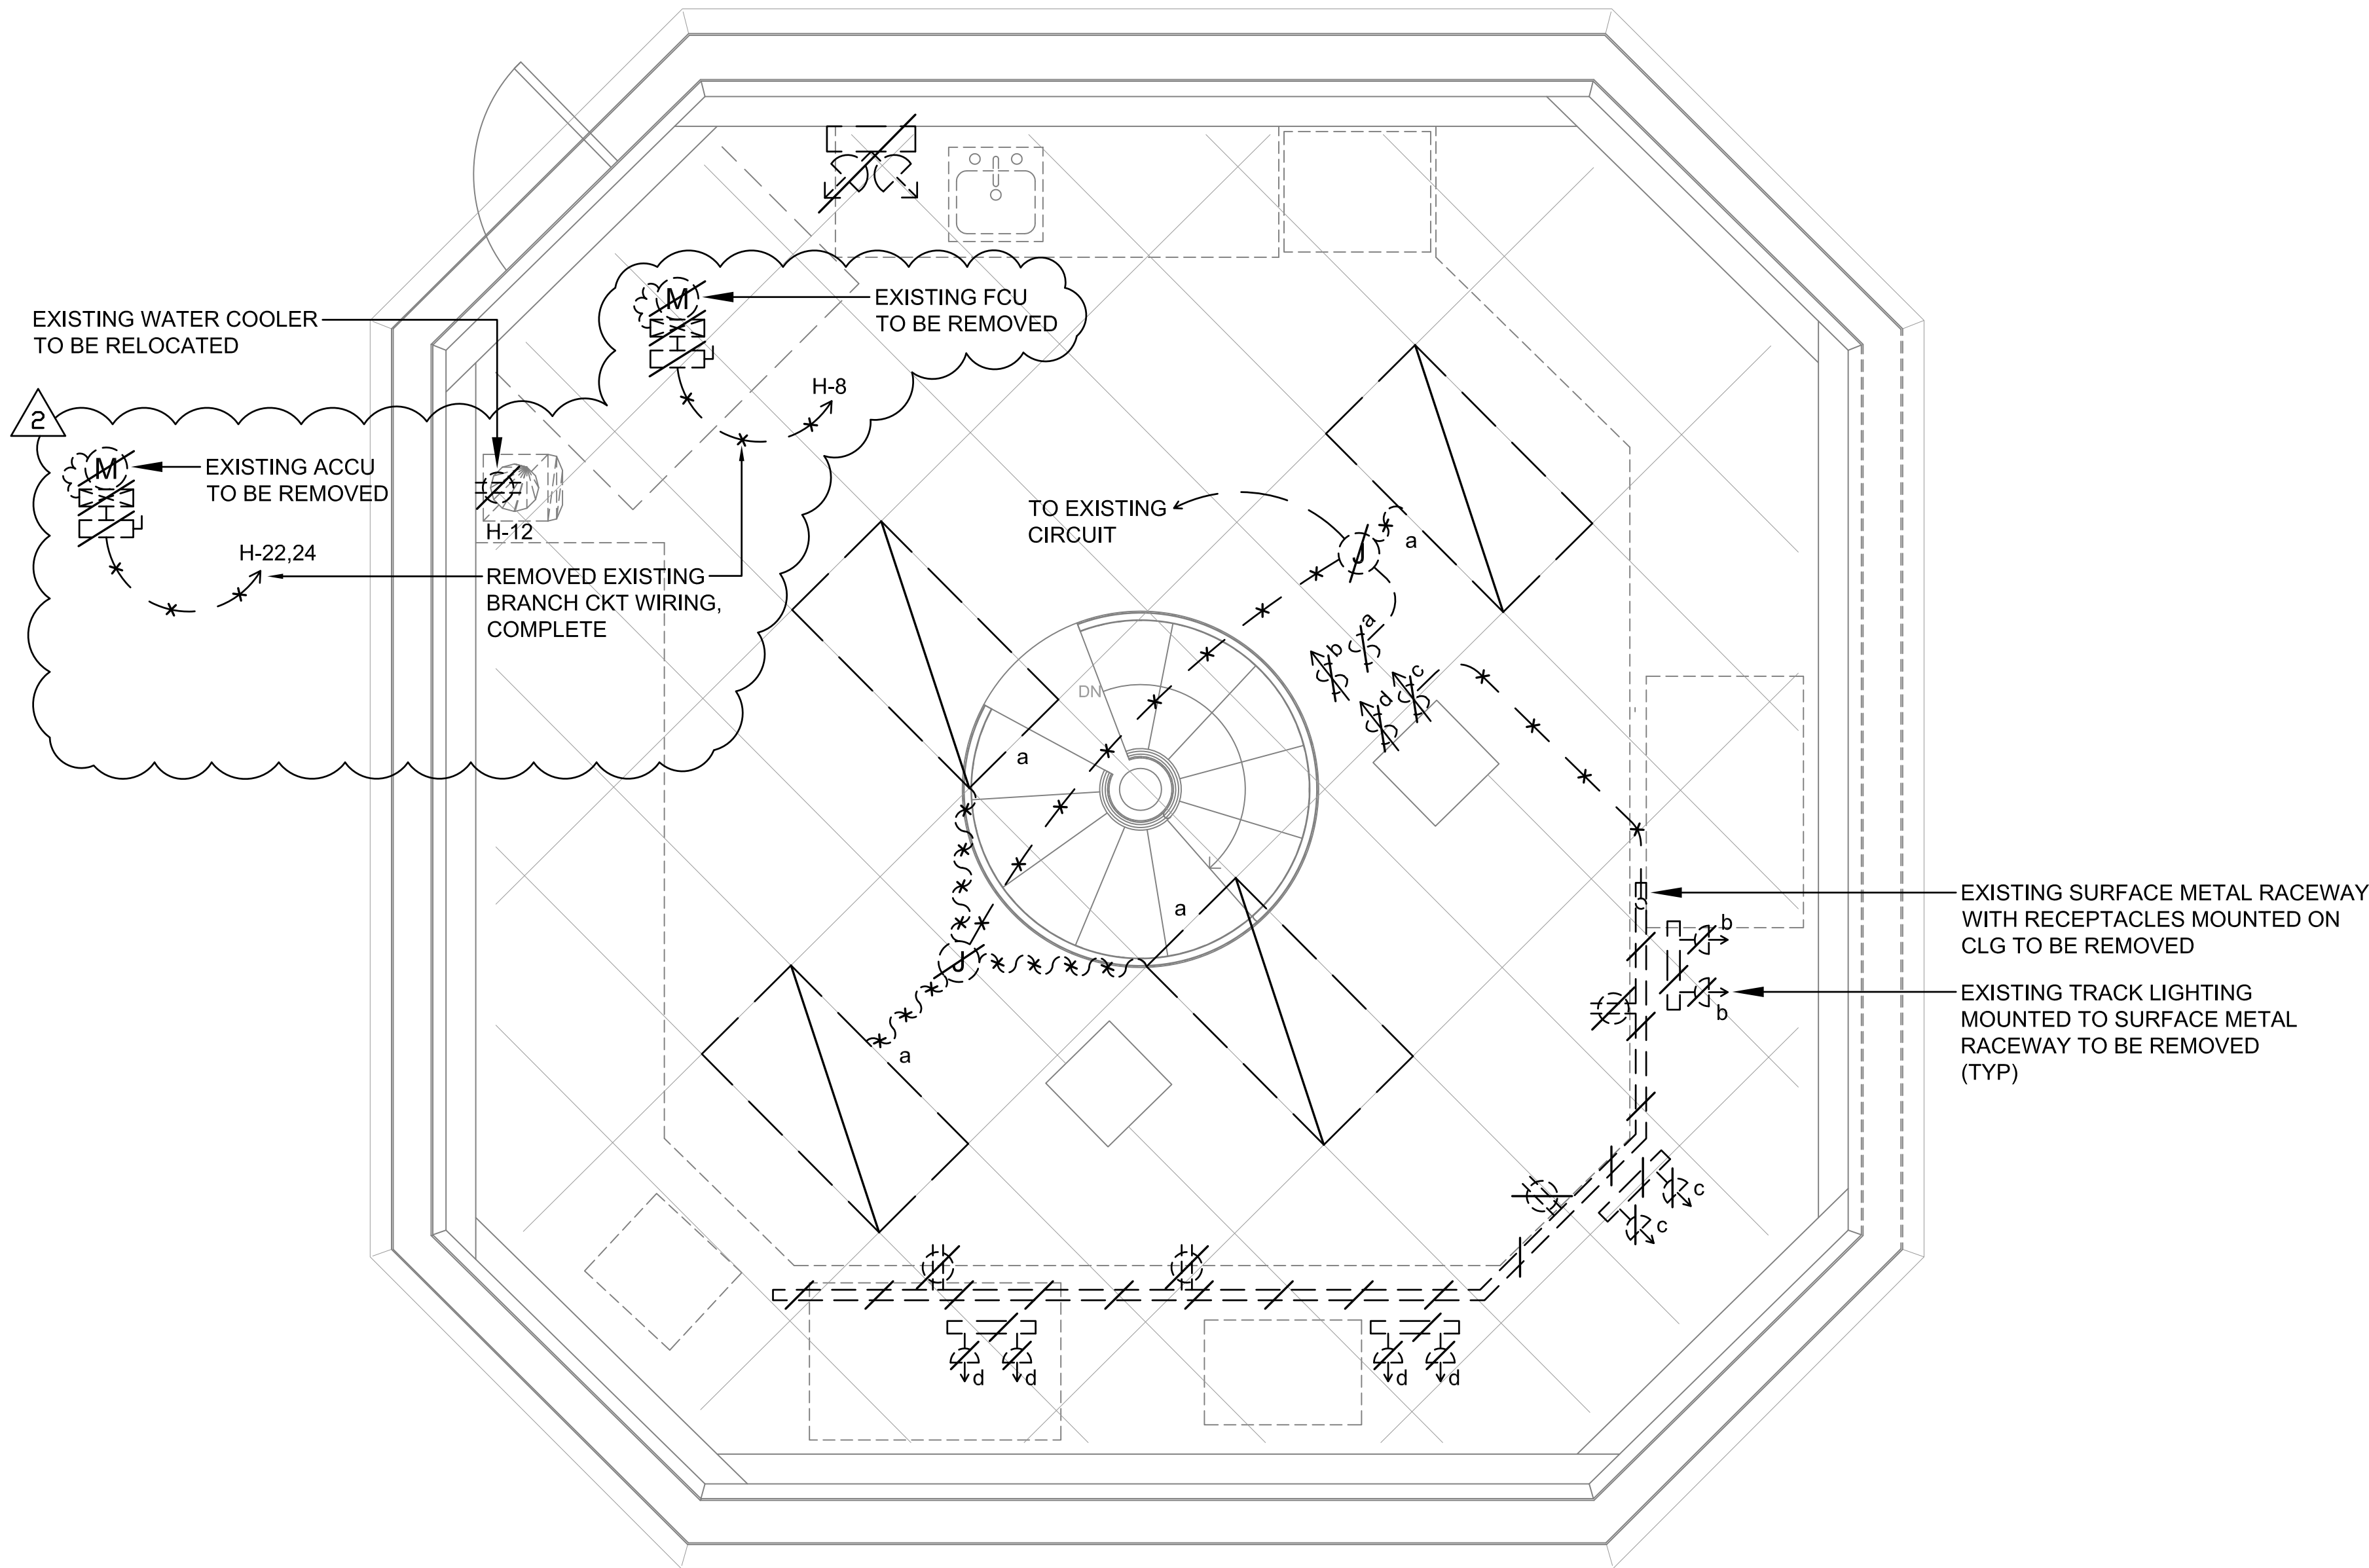

1
ED100

1
CONTROL TOWER ELECTRICAL DEMOLITION PLAN

SCALE : 1/2" = 1'-0"

