

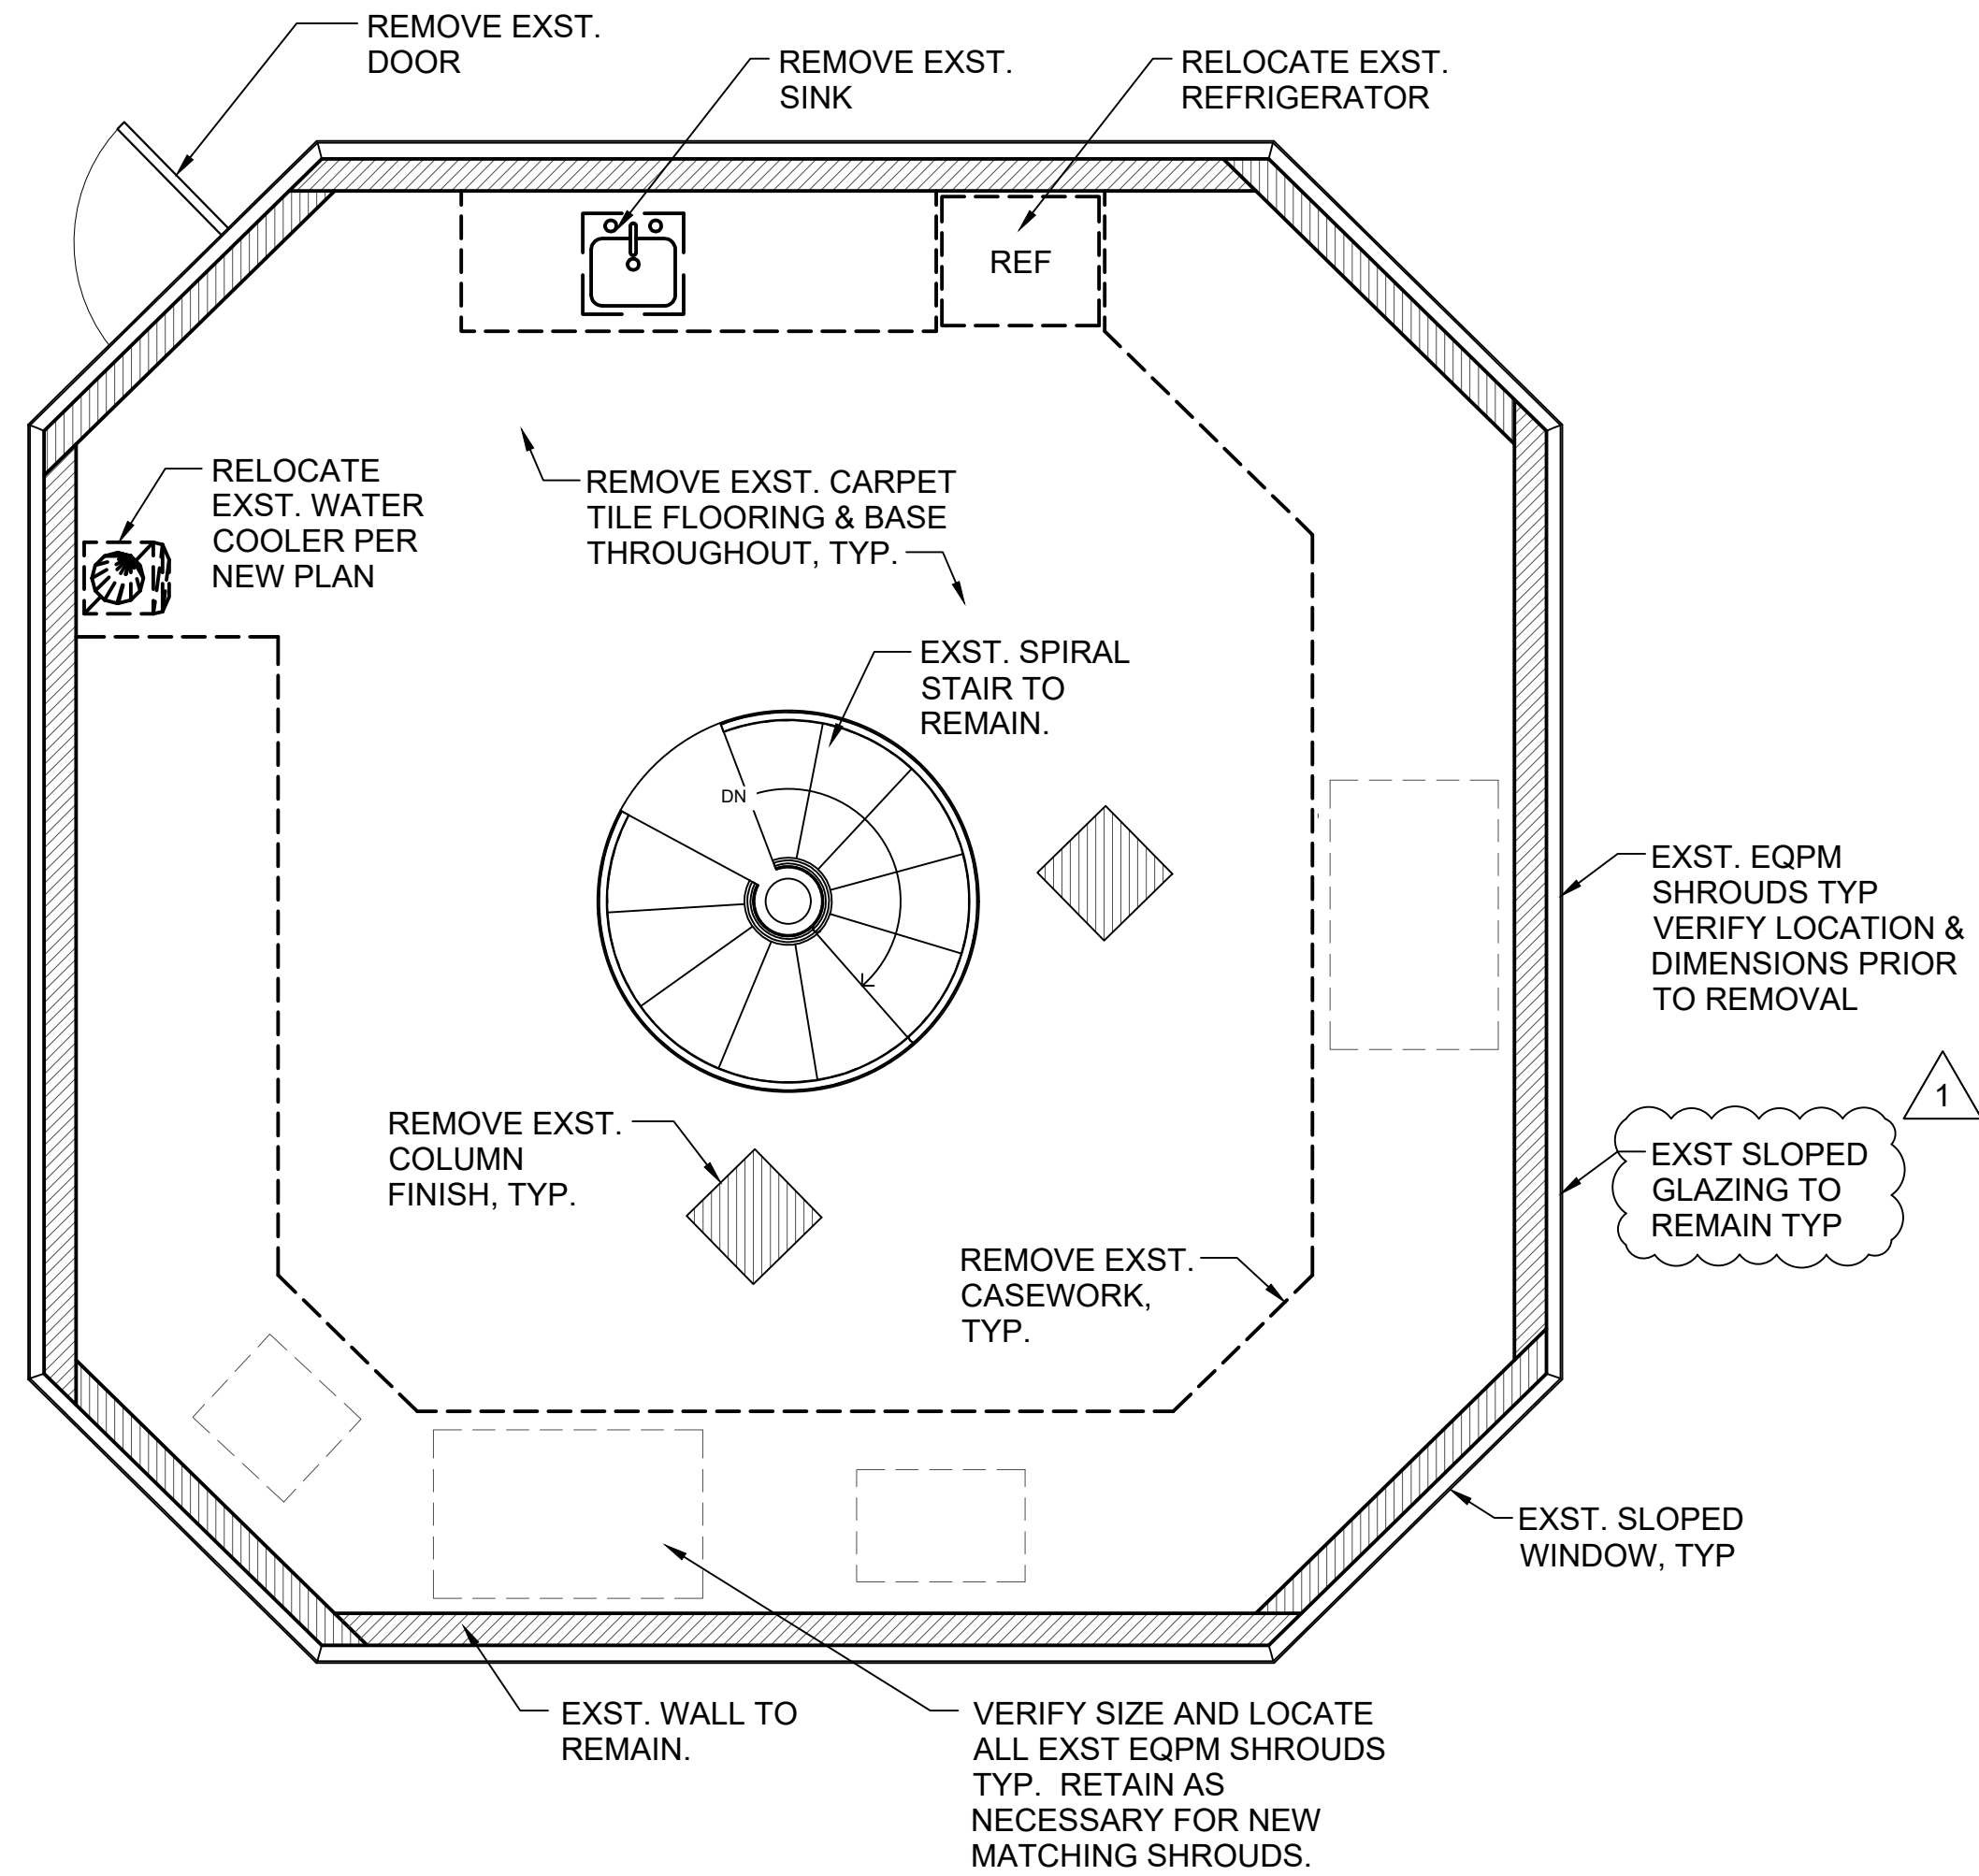
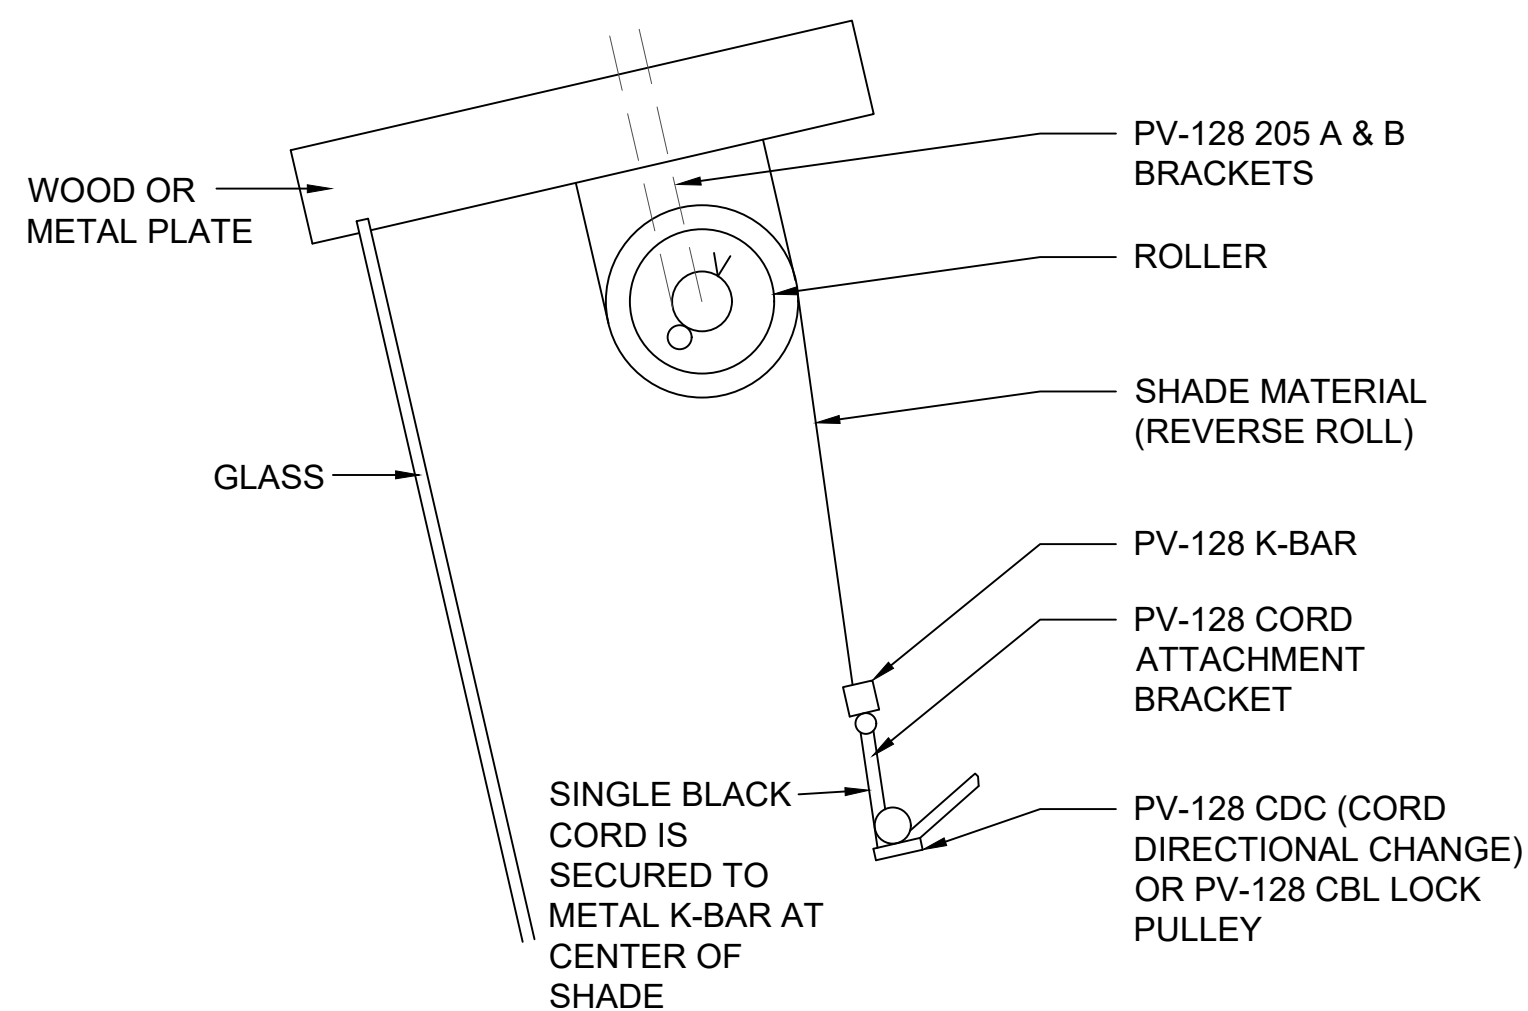


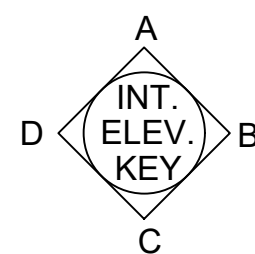



CONTROL TOWER DEMOLITION FLOOR PLAN

SCALE: 3/8" = 1'-0"

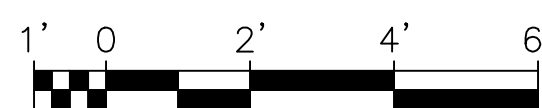


1 SHADE MOUNT DETAIL

SCALE: 3" = 1'-0"

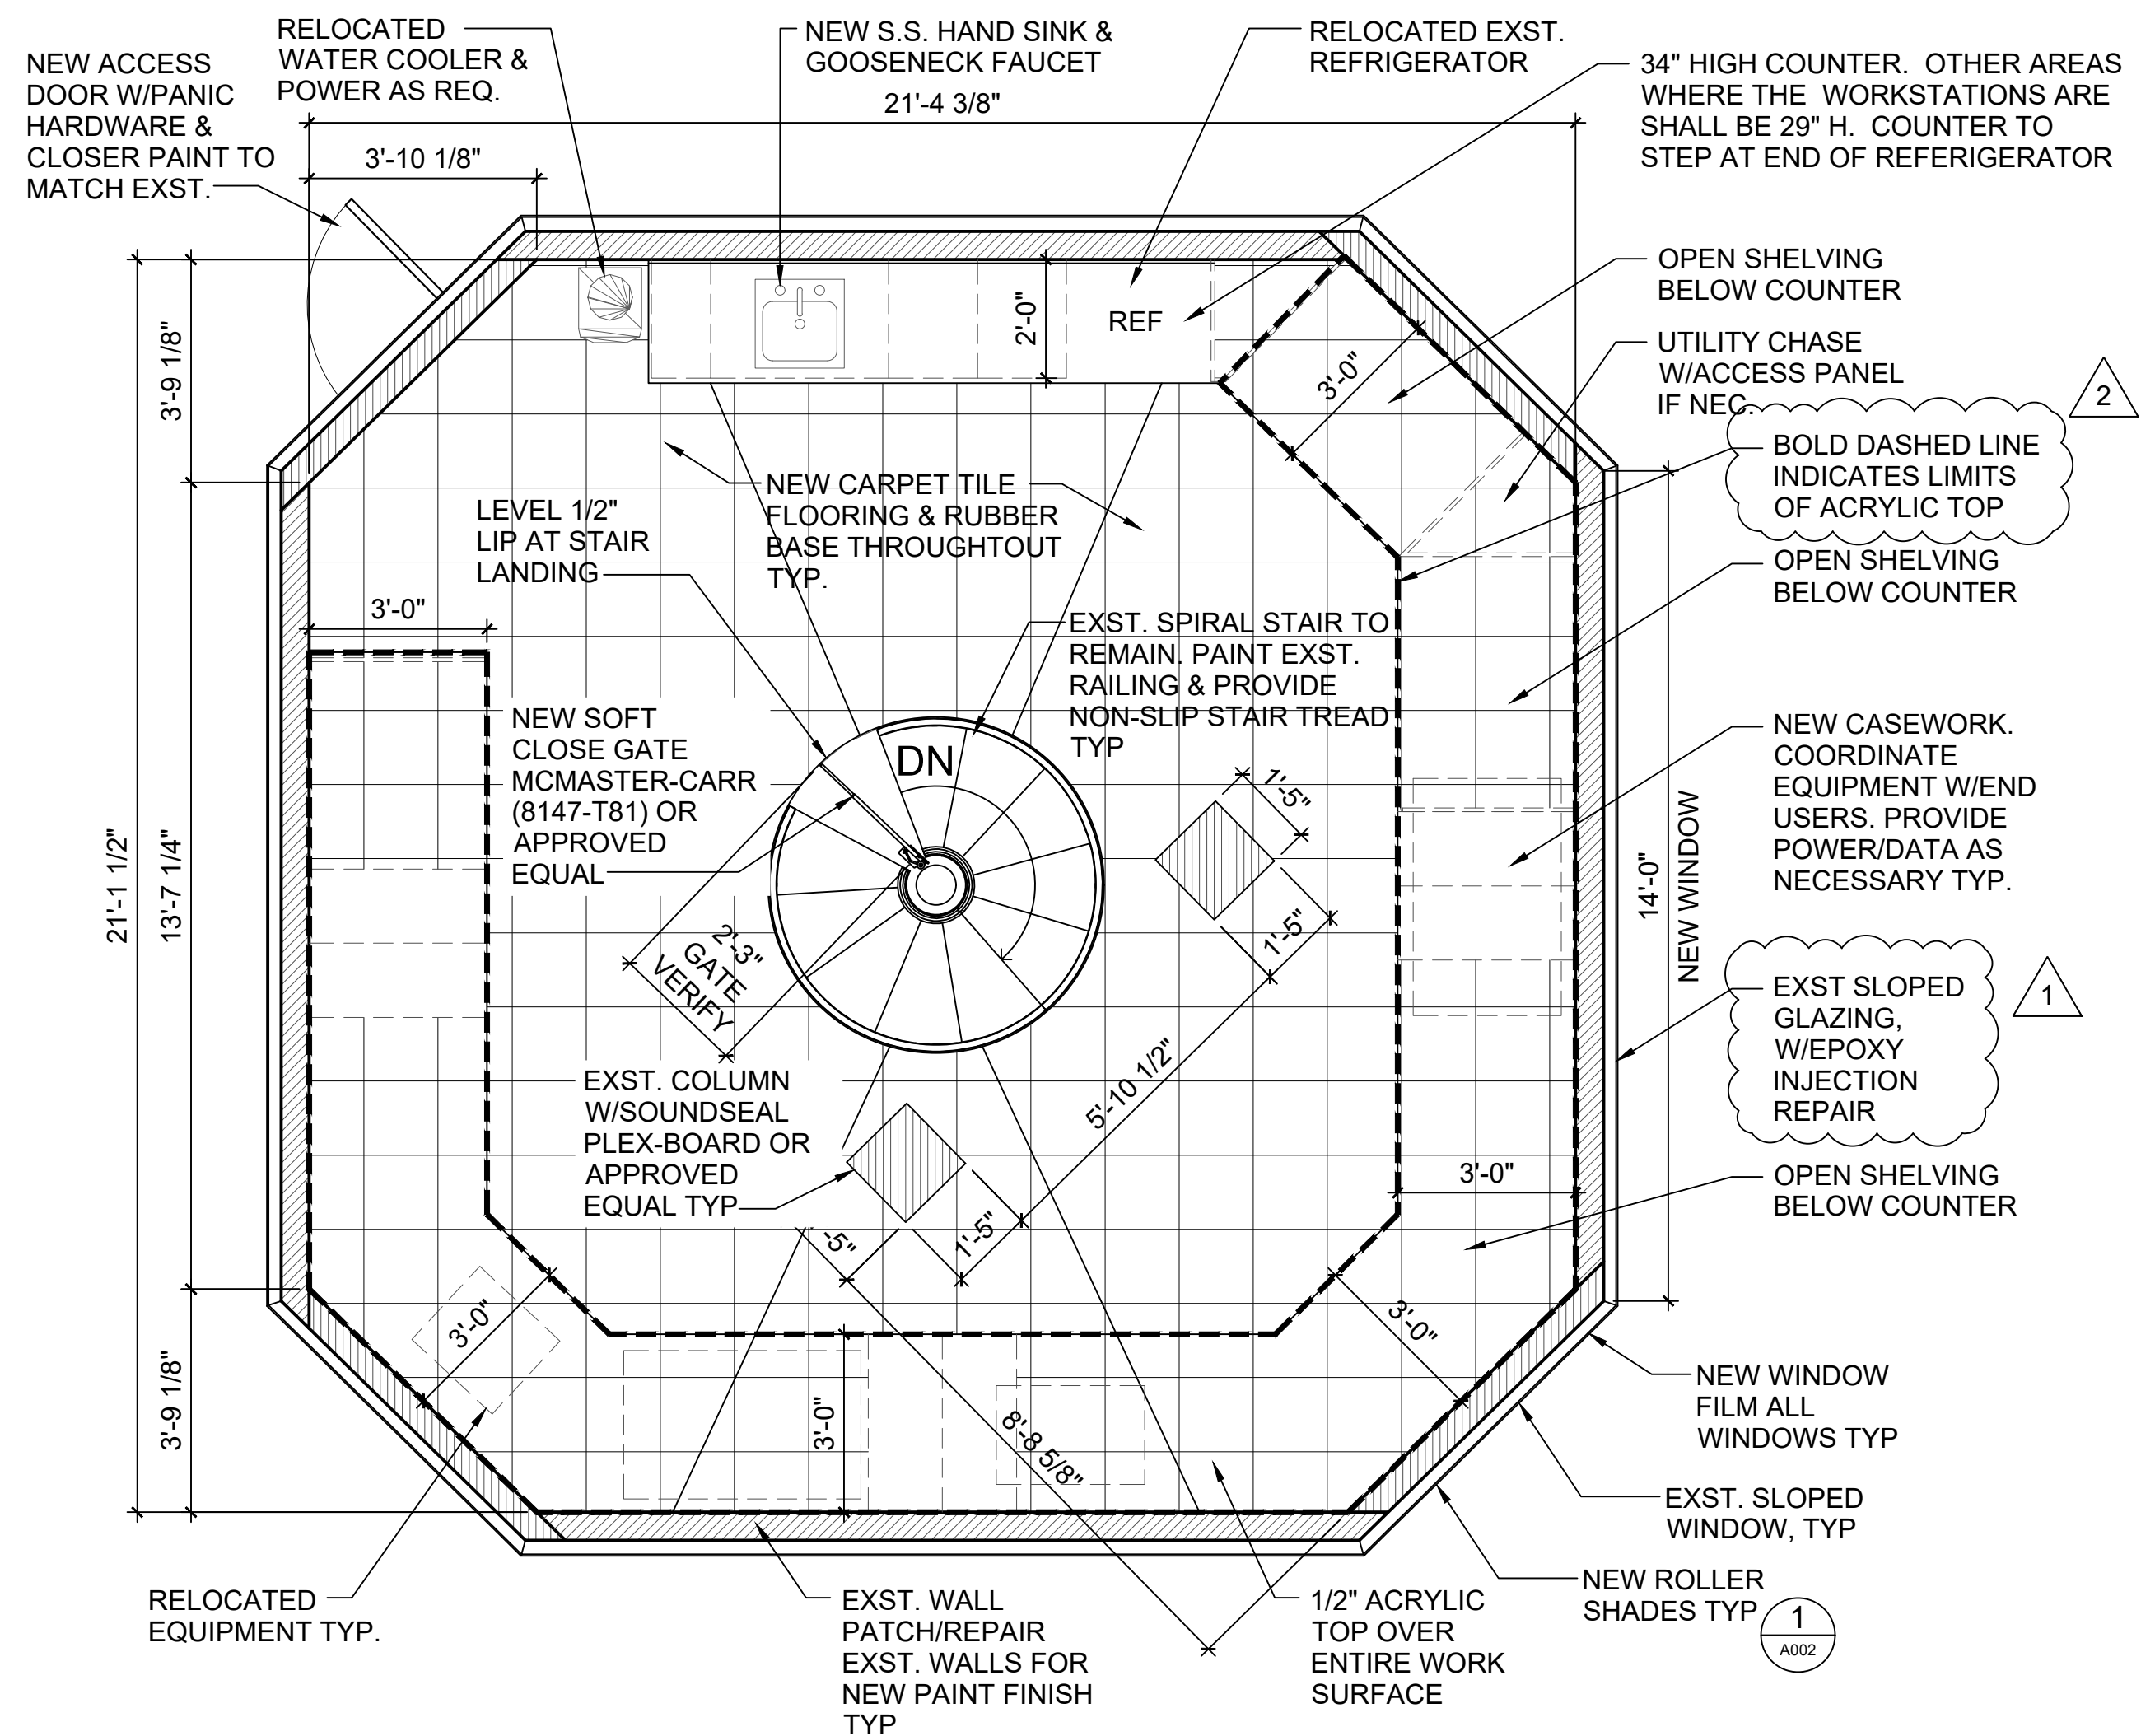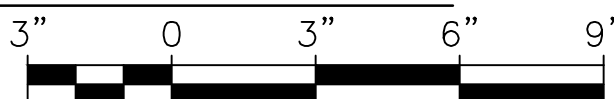

CONTROL TOWER RENOVATED FLOOR PLAN

SCALE: 3/8" = 1'-0"

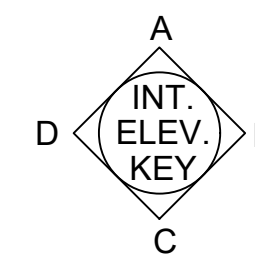

Airports Division
DEPARTMENT OF TRANSPORTATION
STATE OF HAWAII



04/30/24
Licensed Expiration Date

This work was prepared by me or under my supervision.

DSGN.	DRWN.	CHKD.	APPD.
LH/JM	KN/TK/JM	LH/JM	

NO.	DATE	REVISIONS
2	11/18/22	ADDENDUM #2
1	11/03/22	ADDENDUM #1

**FINAL
SUBMITTAL**

09/30/22
DATE

PROJECT TITLE :

**AIR TRAFFIC CONTROL
TOWER REPAIRS**

AT
KALAELOA AIRPORT
BARBERS POINT, OAHU, HAWAII

PROJECT NO.:

A05024-03

SHEET TITLE:

**DEMOLITION
FLOOR PLAN,
RENOVATED
FLOOR PLAN**

DATE :	DWG. NO.
09/30/22	A002
SHEET :	
5 OF 49 SHEETS	