


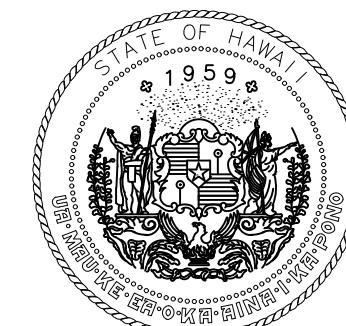

Airports Division
DEPARTMENT OF TRANSPORTATION
STATE OF HAWAII



04/30/24
Licensed Expiration Date

This work was prepared by me or under my supervision.

DSGN.	DRWN.	CHKD.	APPD.

NO.	DATE	REVISIONS
2	11/18/22	ADDENDUM #2
1	11/03/22	ADDENDUM #1

FINAL SUBMITTAL

09/30/22
DATE

PROJECT TITLE :

AIR TRAFFIC CONTROL
TOWER REPAIRS

AT
KALAELOA AIRPORT
BARBERS POINT, OAHU, HAWAII



PROJECT NO.:

A05024-03

SHEET TITLE:



RENOVATED
GROUND FLOOR
LOBBY PLAN

DATE :	DWG. NO.
09/30/22	A006
SHEET :	
9 OF 49 SHEETS	

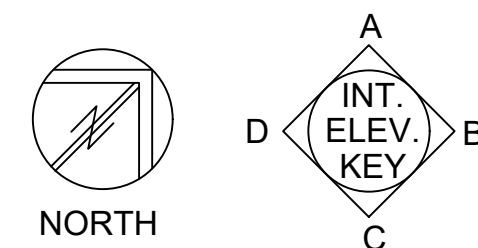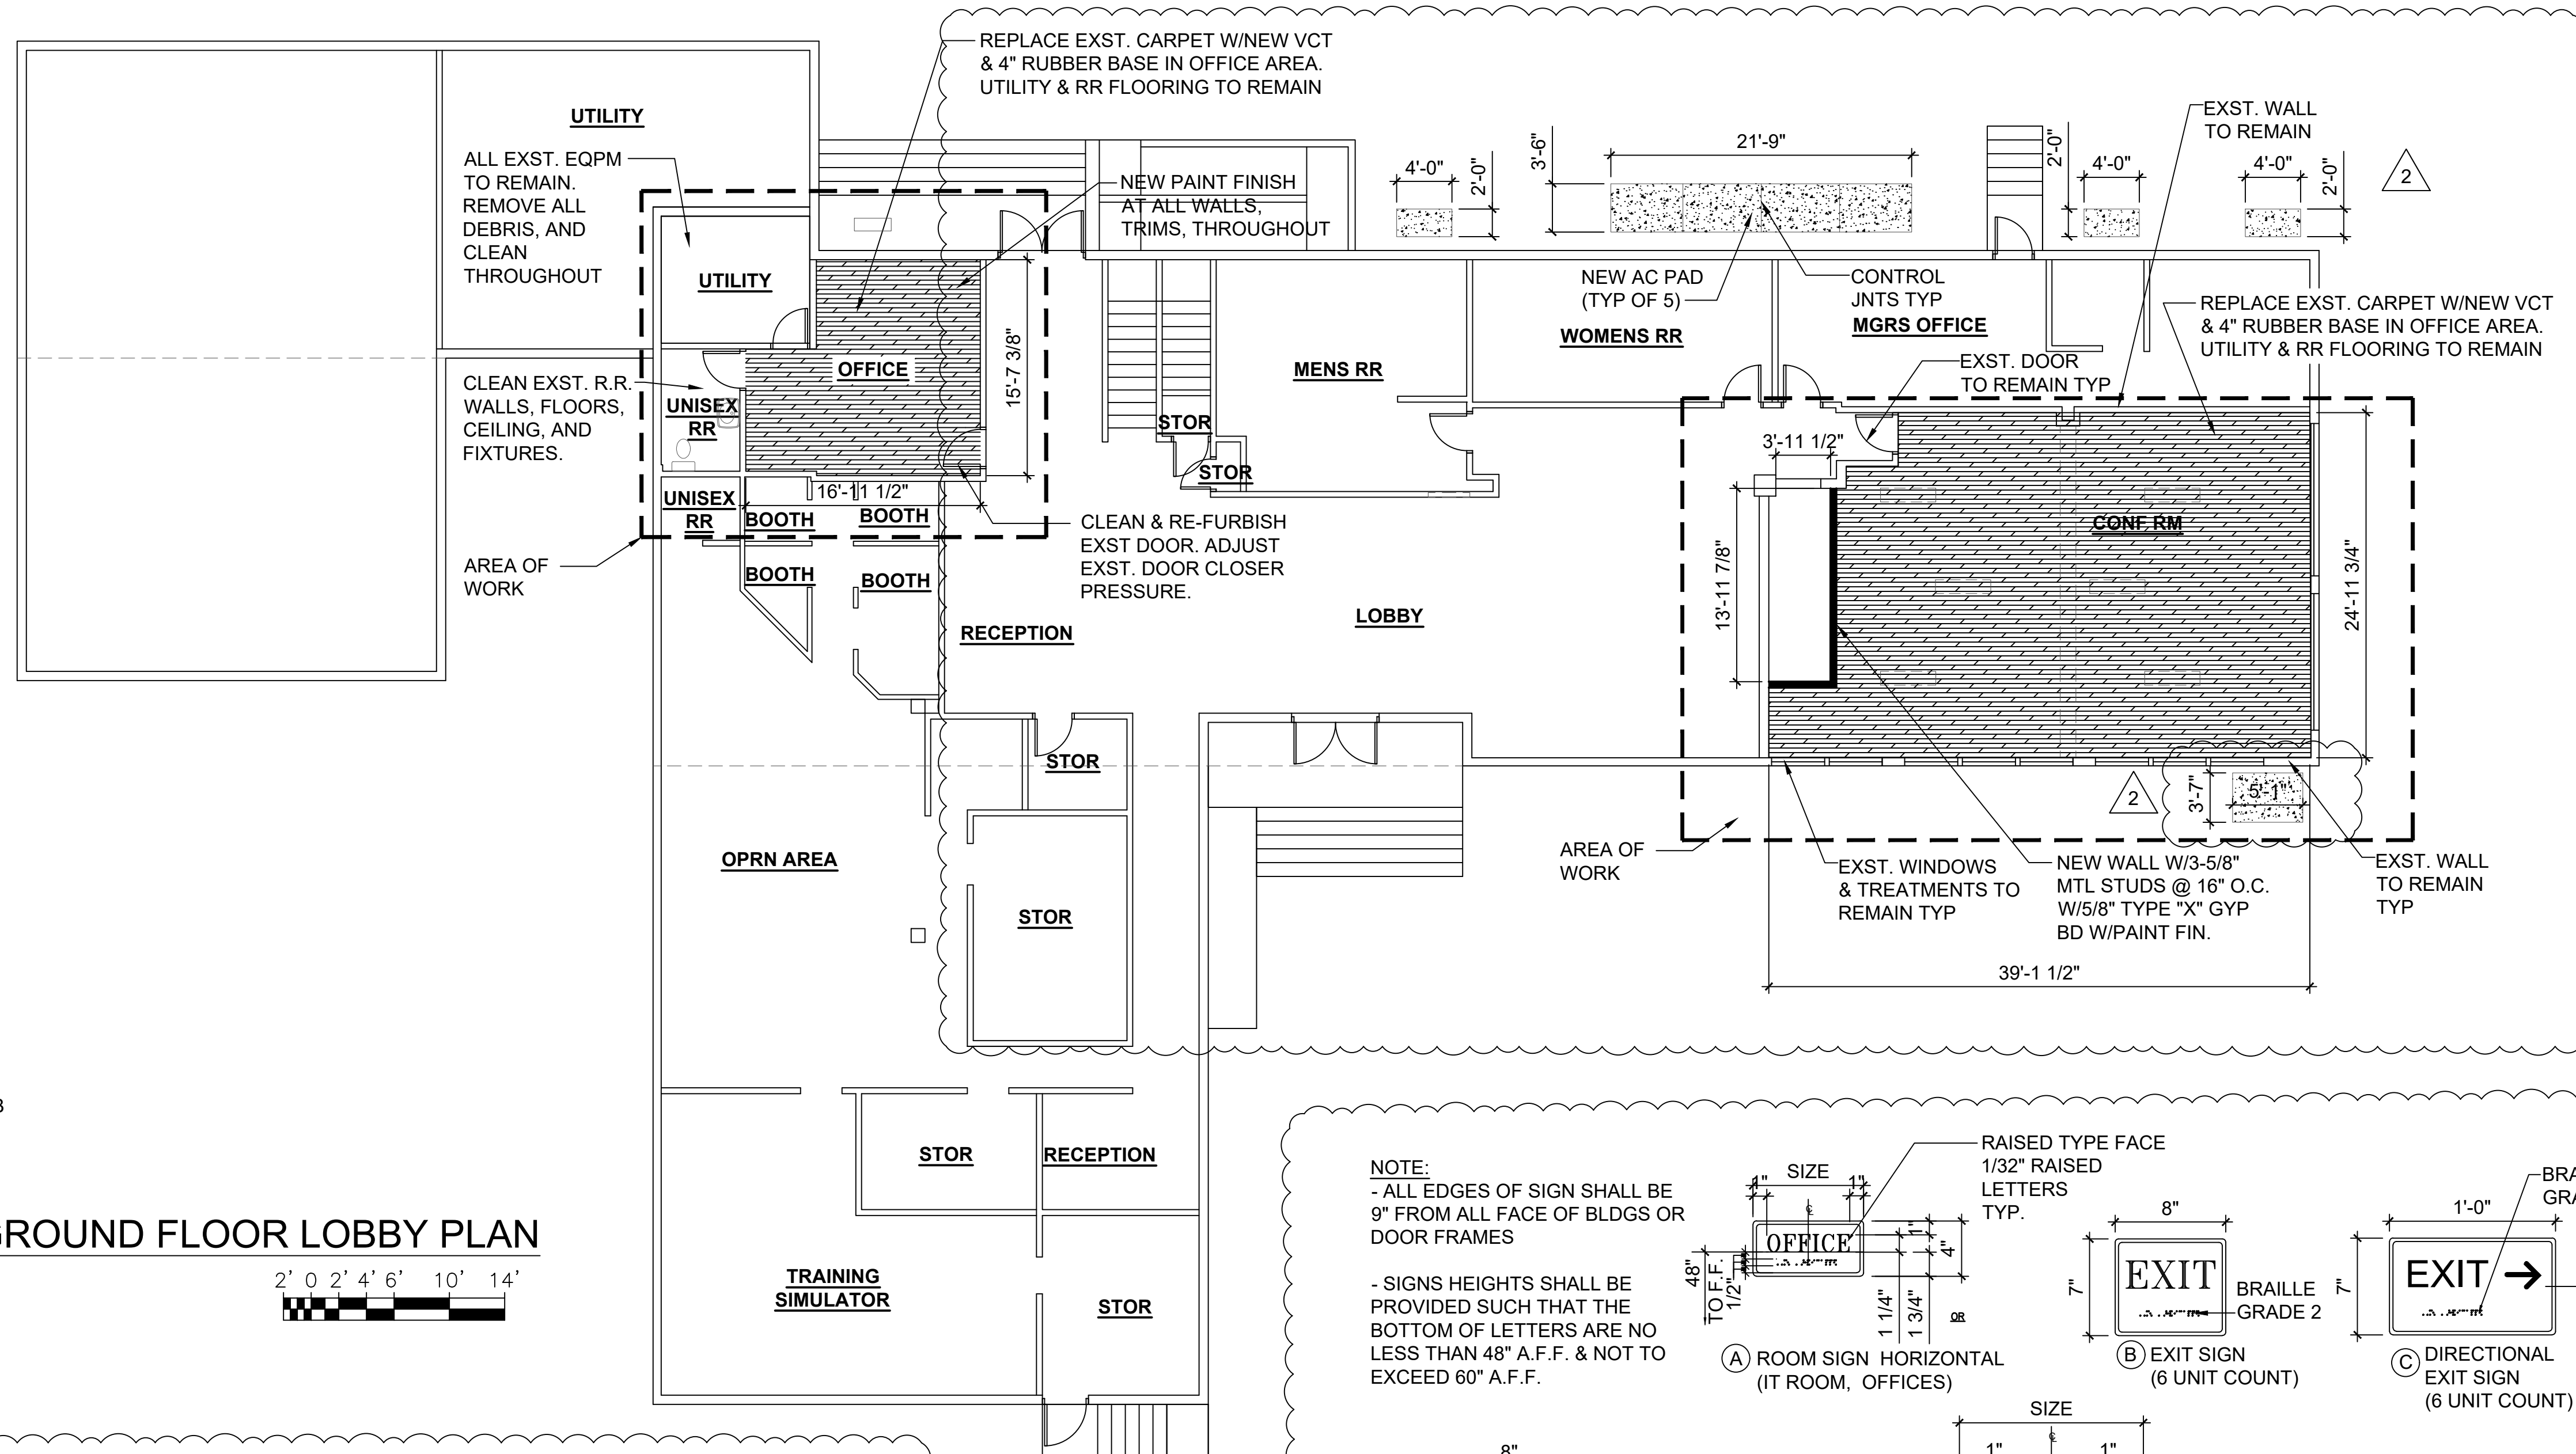

RENOVATED GROUND FLOOR LOBBY PLAN

SCALE: 1/8" = 1'-0"

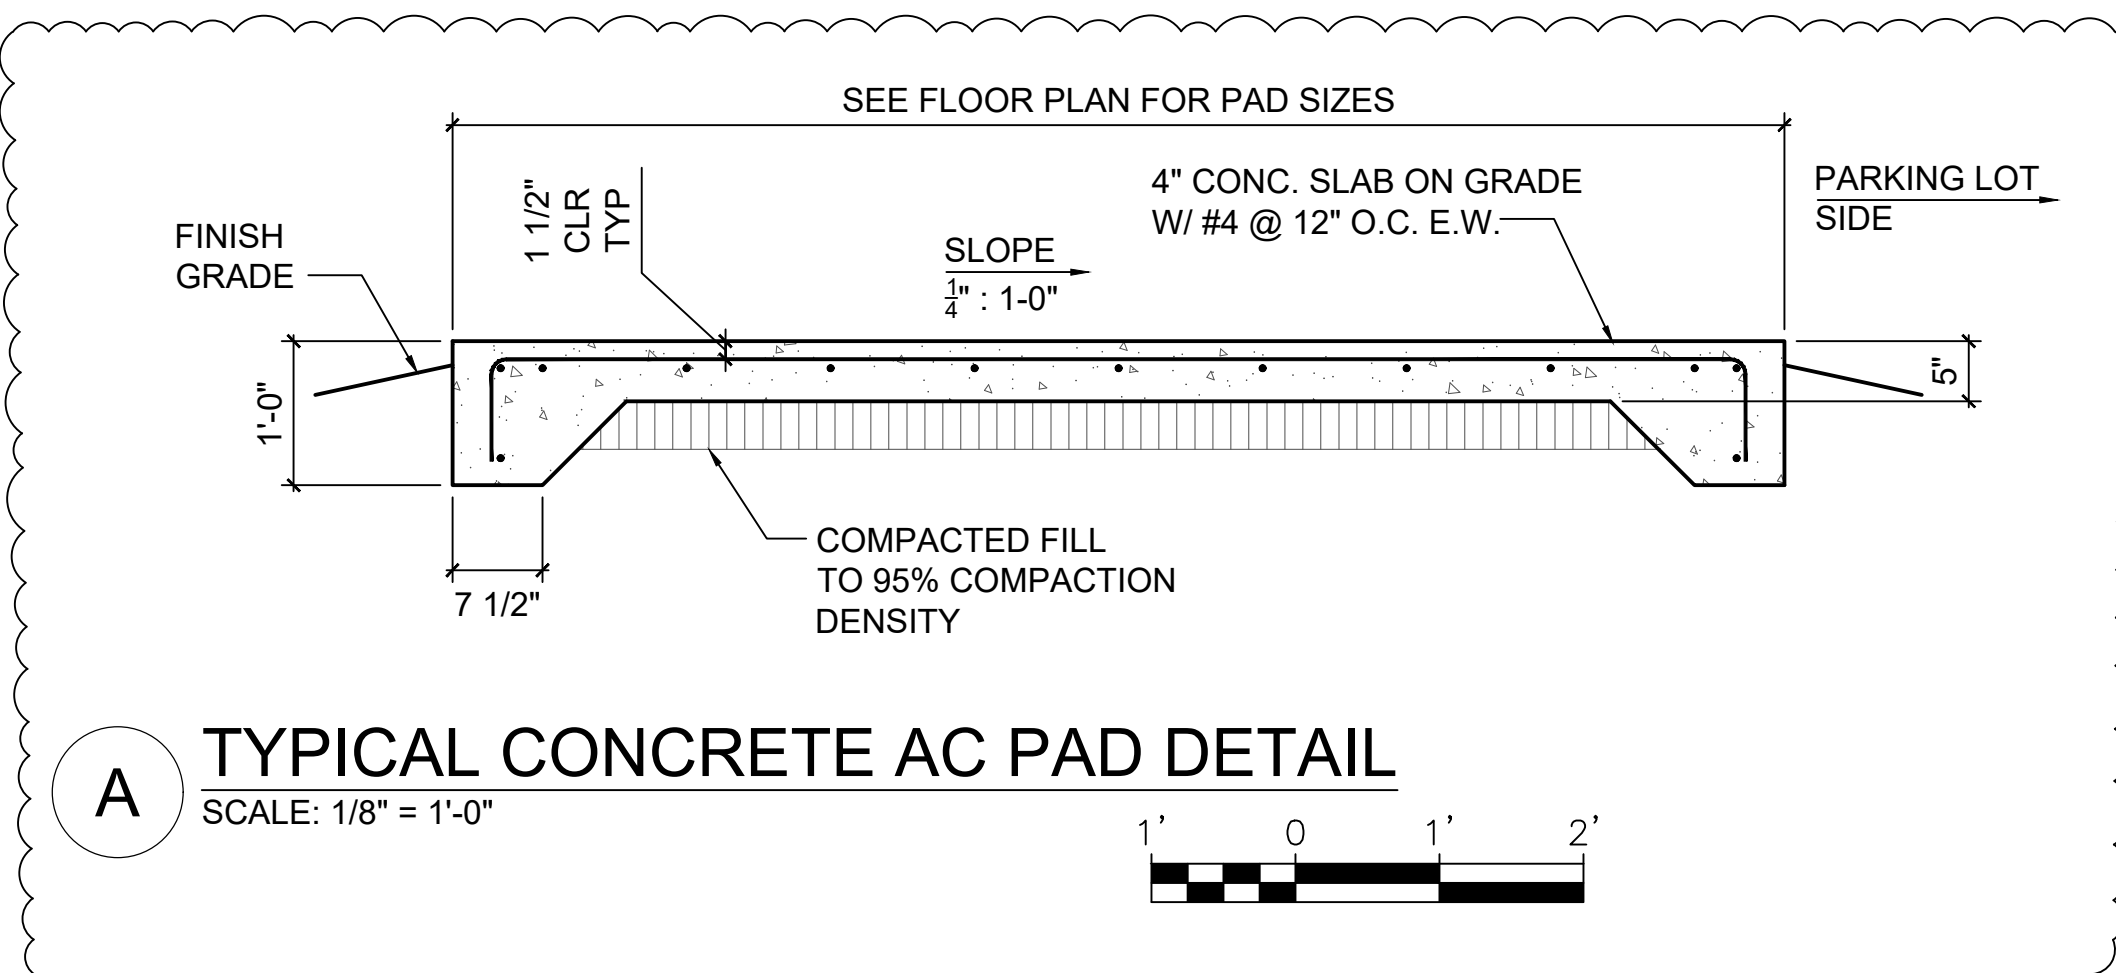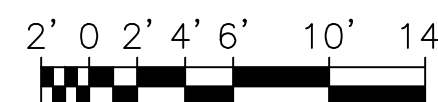

NOTE:
- ALL EDGES OF SIGN SHALL BE 9" FROM ALL FACE OF BLDGS OR DOOR FRAMES

- SIGNS HEIGHTS SHALL BE PROVIDED SUCH THAT THE BOTTOM OF LETTERS ARE NO LESS THAN 48" A.F.F. & NOT TO EXCEED 60" A.F.F.

