


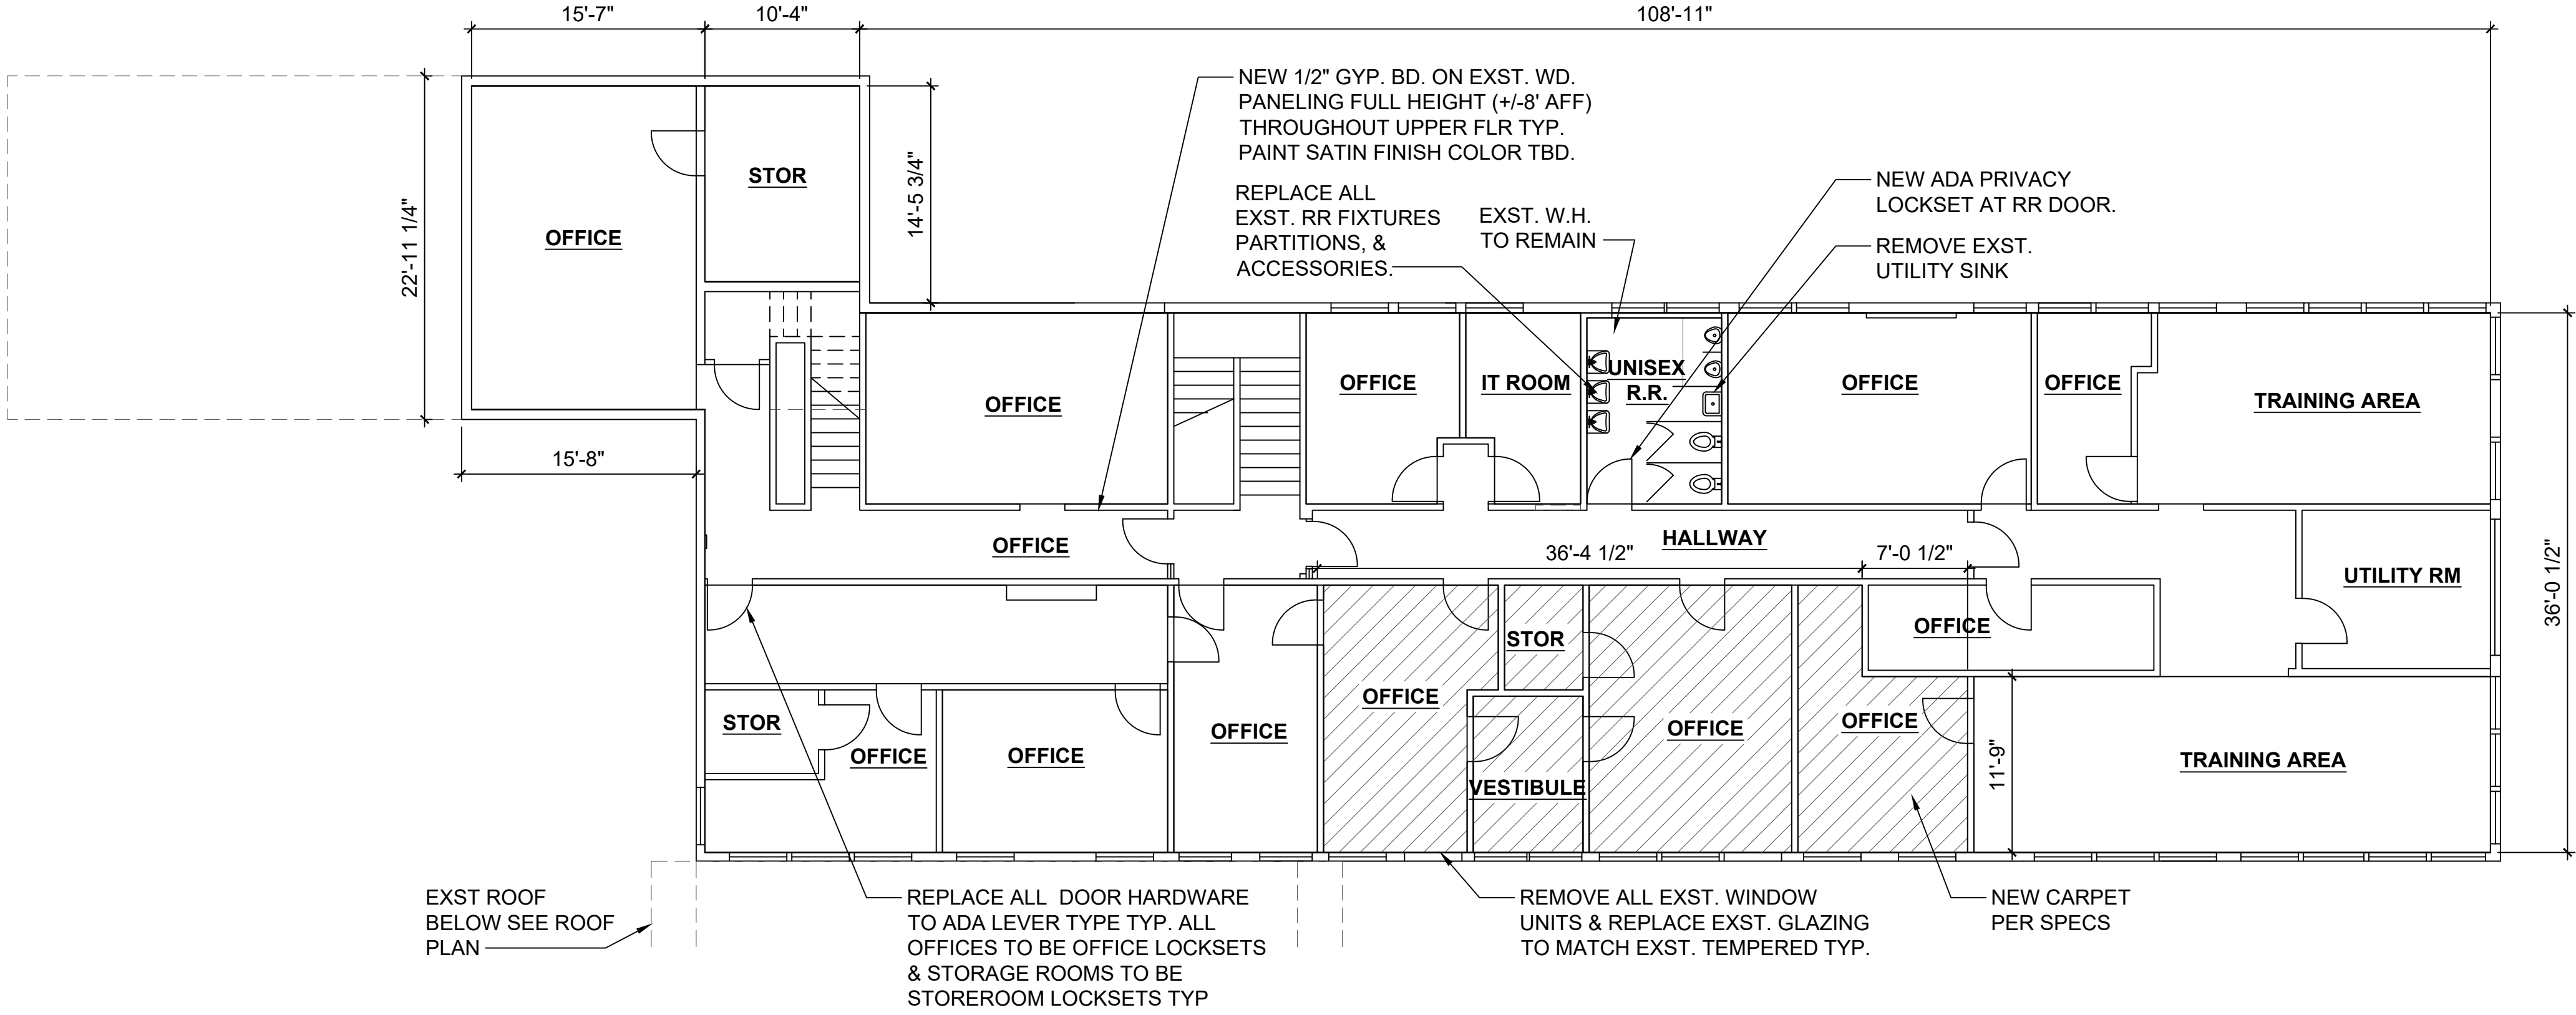
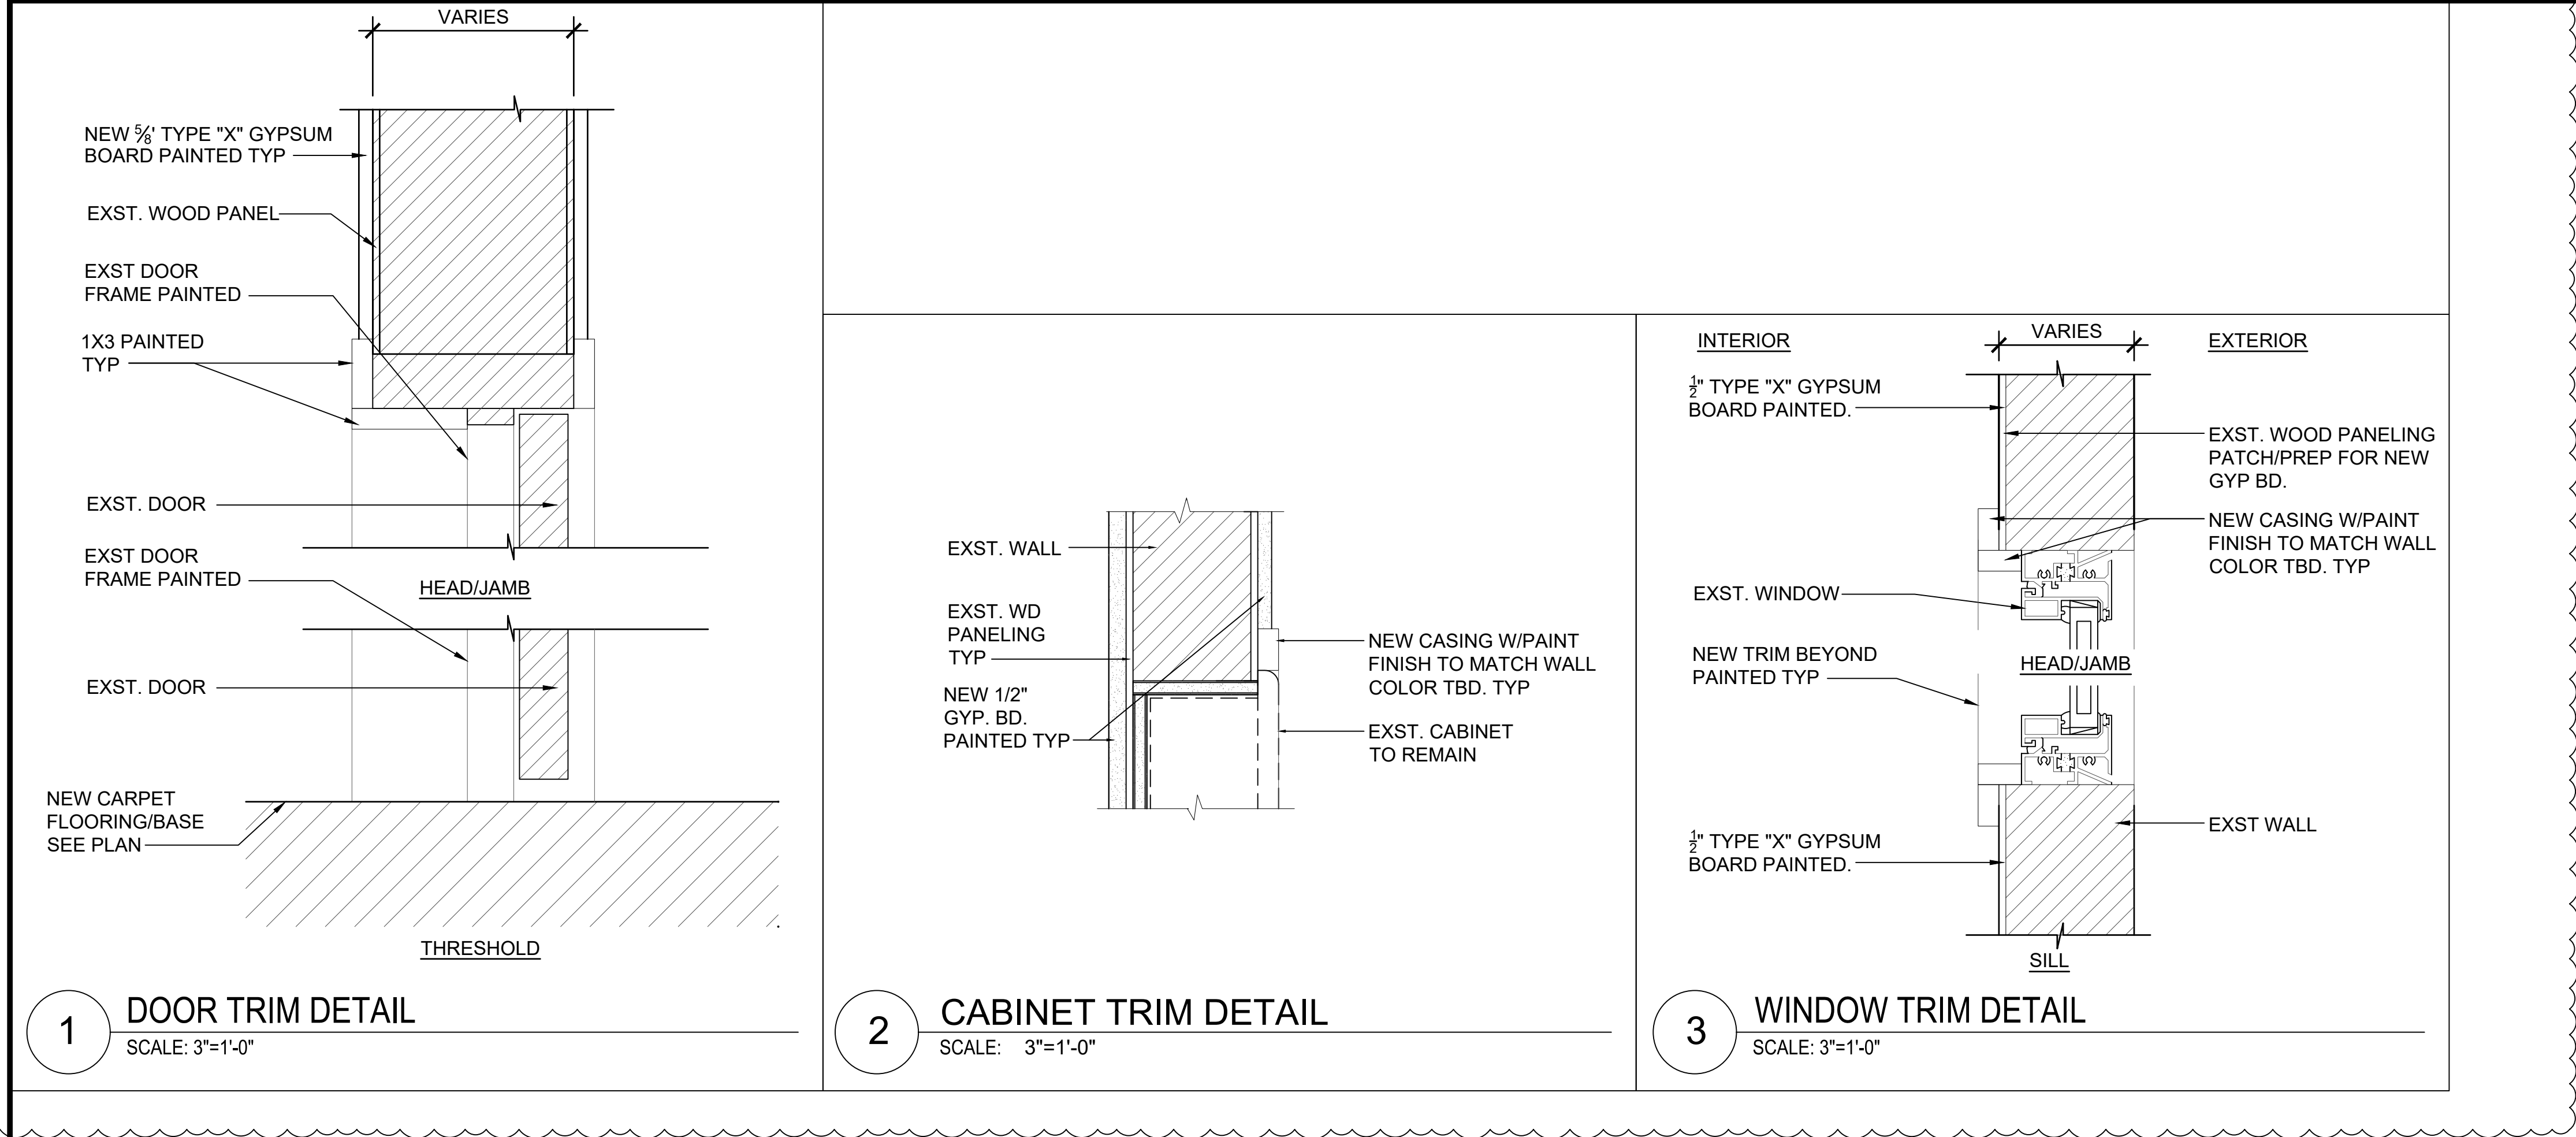


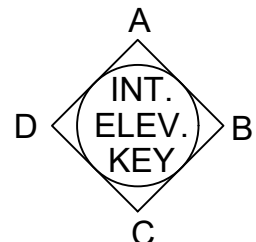

RENOVATED SECOND FLOOR PLAN
SCALE: 1/8" = 1'-0"

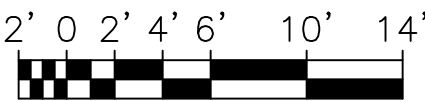

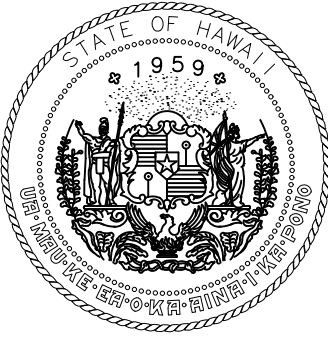

Airports Division
DEPARTMENT OF TRANSPORTATION
STATE OF HAWAII



LLOYD M. HIGGINS
LICENSED PROFESSIONAL ARCHITECT
No. AR-6093
HAWAII, U.S.A.
04/30/24
Licensed Expiration Date

This work was prepared by me or under my supervision.

DSGN.	DRWN.	CHKD.	APPD.

NO.	DATE	REVISIONS
1	11/03/22	ADDENDUM #1

FINAL SUBMITTAL
09/30/22
DATE

PROJECT TITLE :
AIR TRAFFIC CONTROL TOWER REPAIRS
AT
KALAELOA AIRPORT
BARBERS POINT, OAHU, HAWAII

PROJECT NO.:
A05024-03

SHEET TITLE:
RENOVATED SECOND FLOOR PLAN

DATE :	DWG. NO.
09/30/22	A006.1
SHEET :	
10 OF 49 SHEETS	