




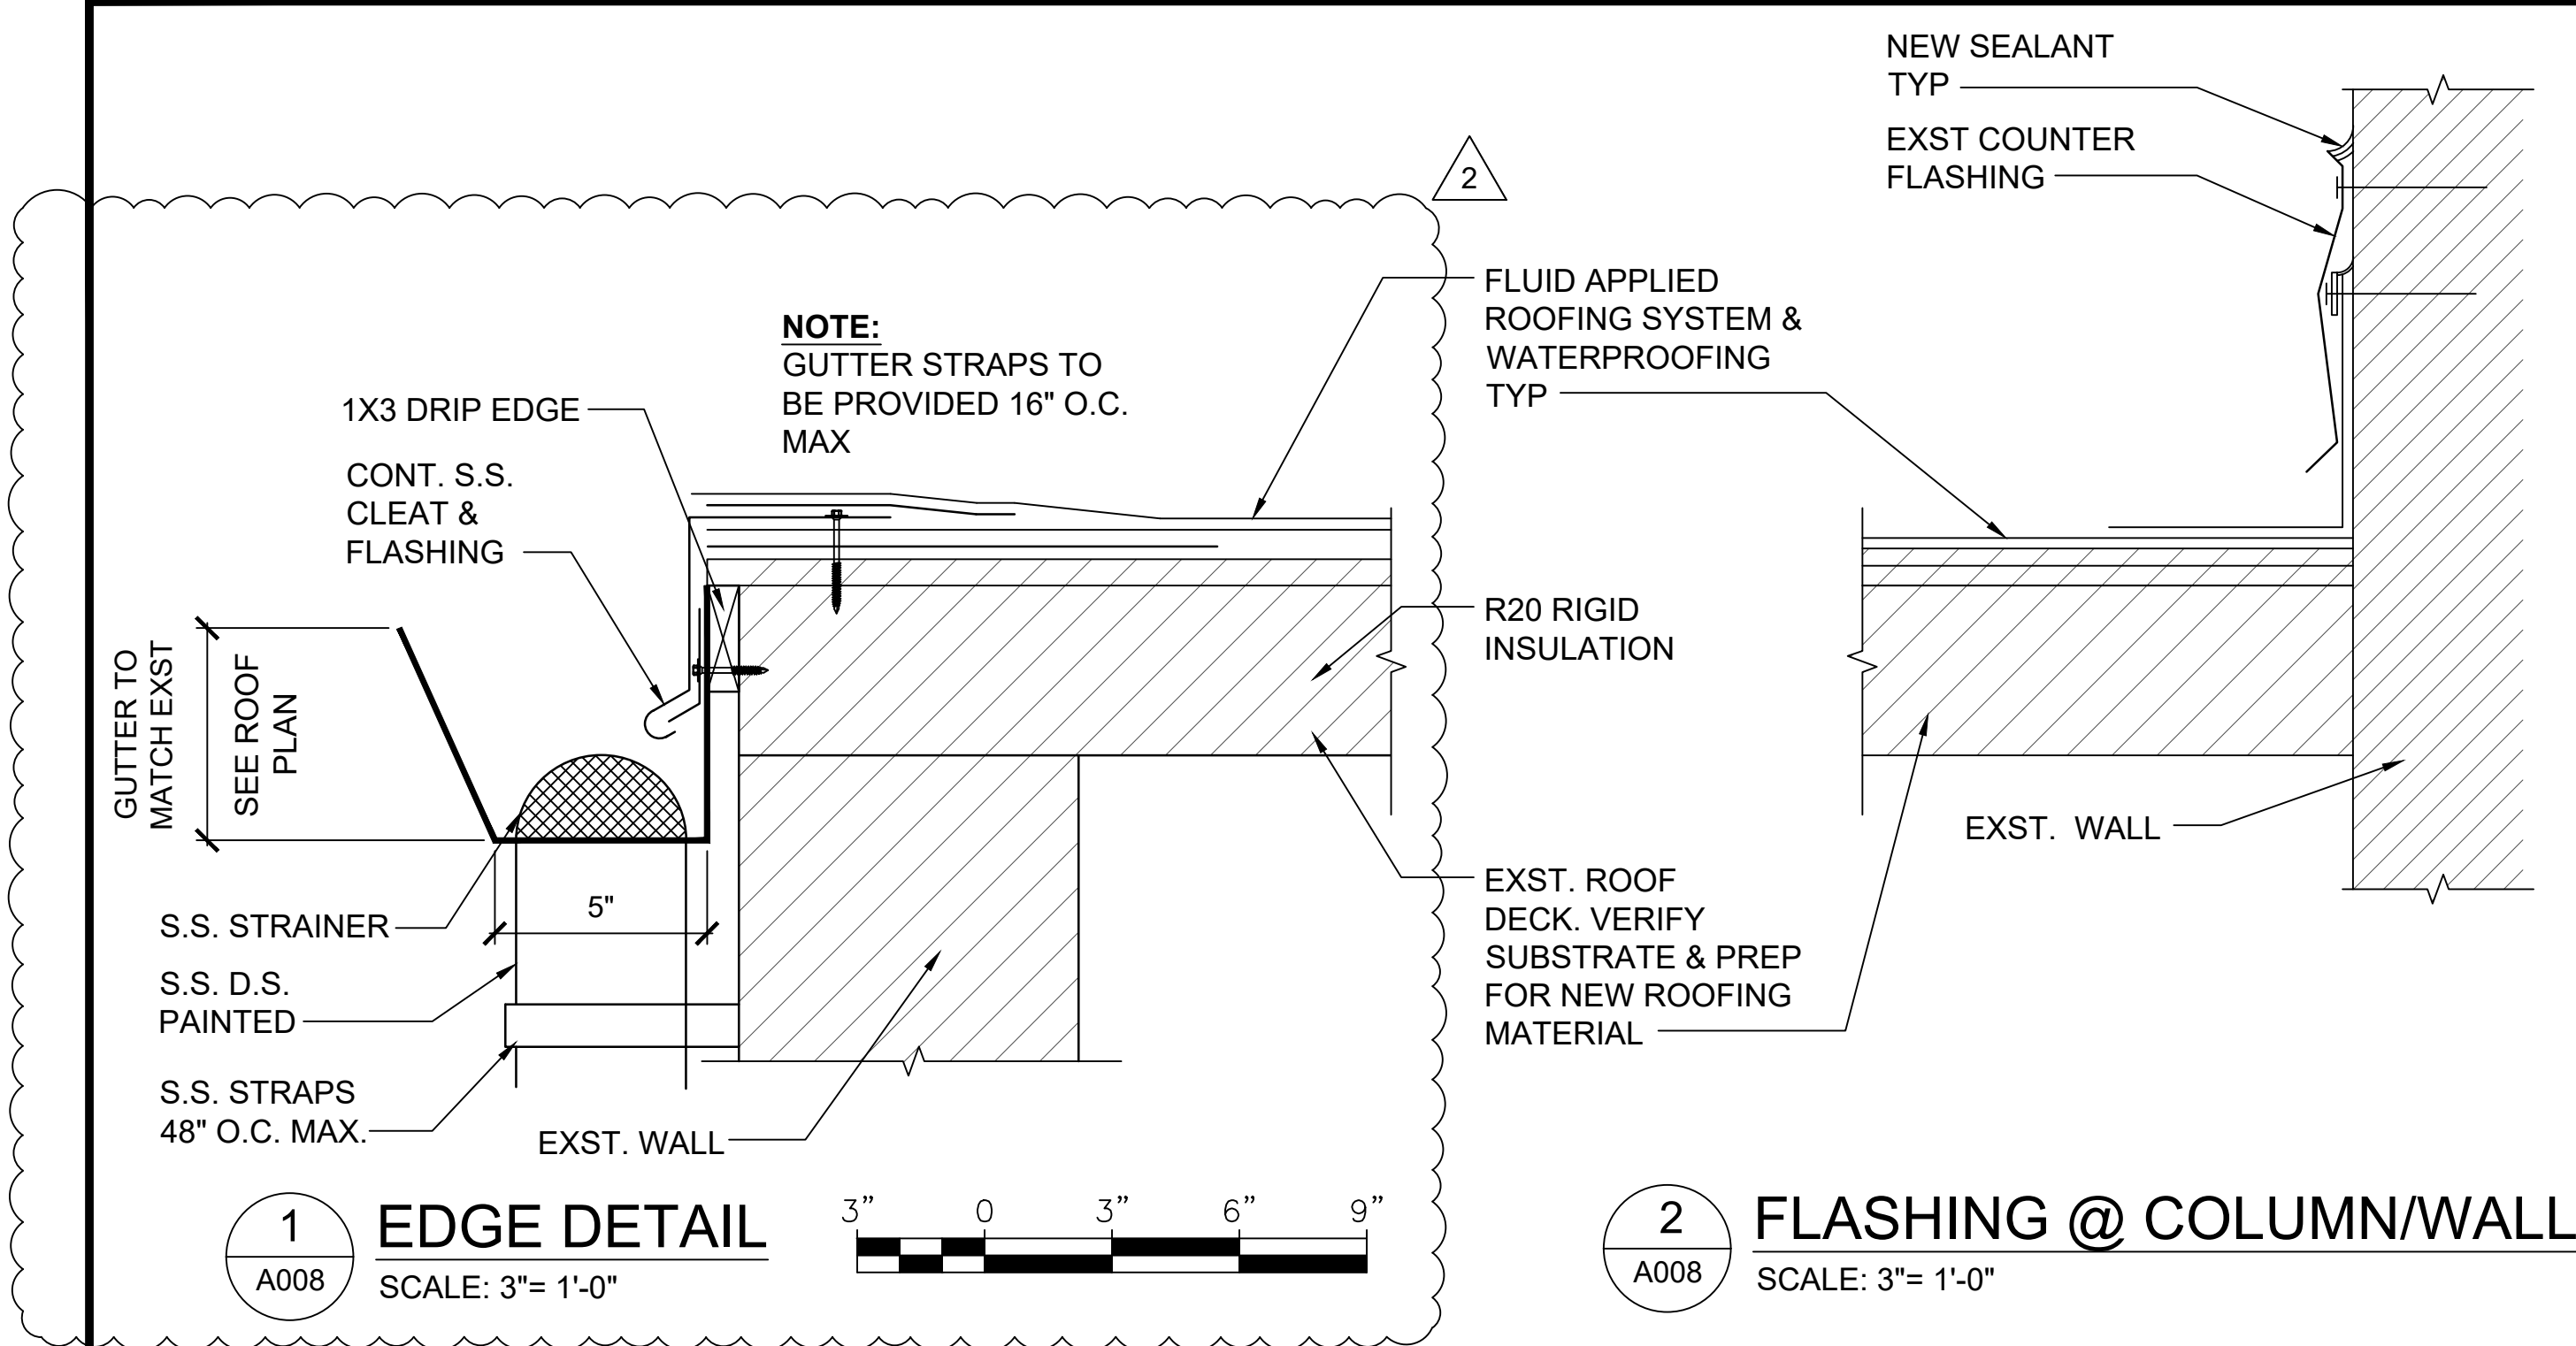

2 **FLASHING @ COLUMN/WALL**
A008 SCALE: 3"= 1'-0"

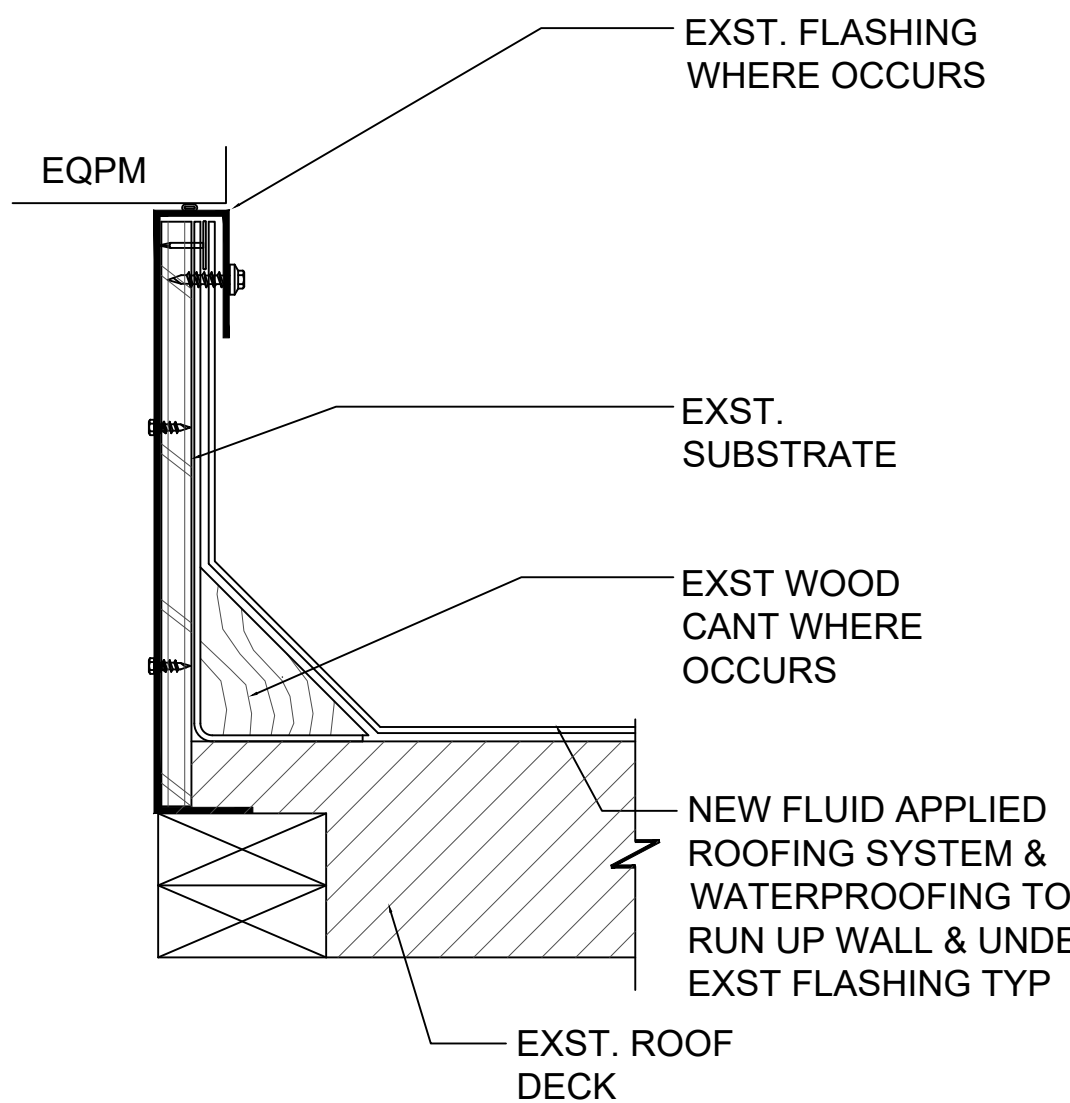

3 **FLASHING AT MECH CURB**
A008 SCALE: 3"= 1'-0"

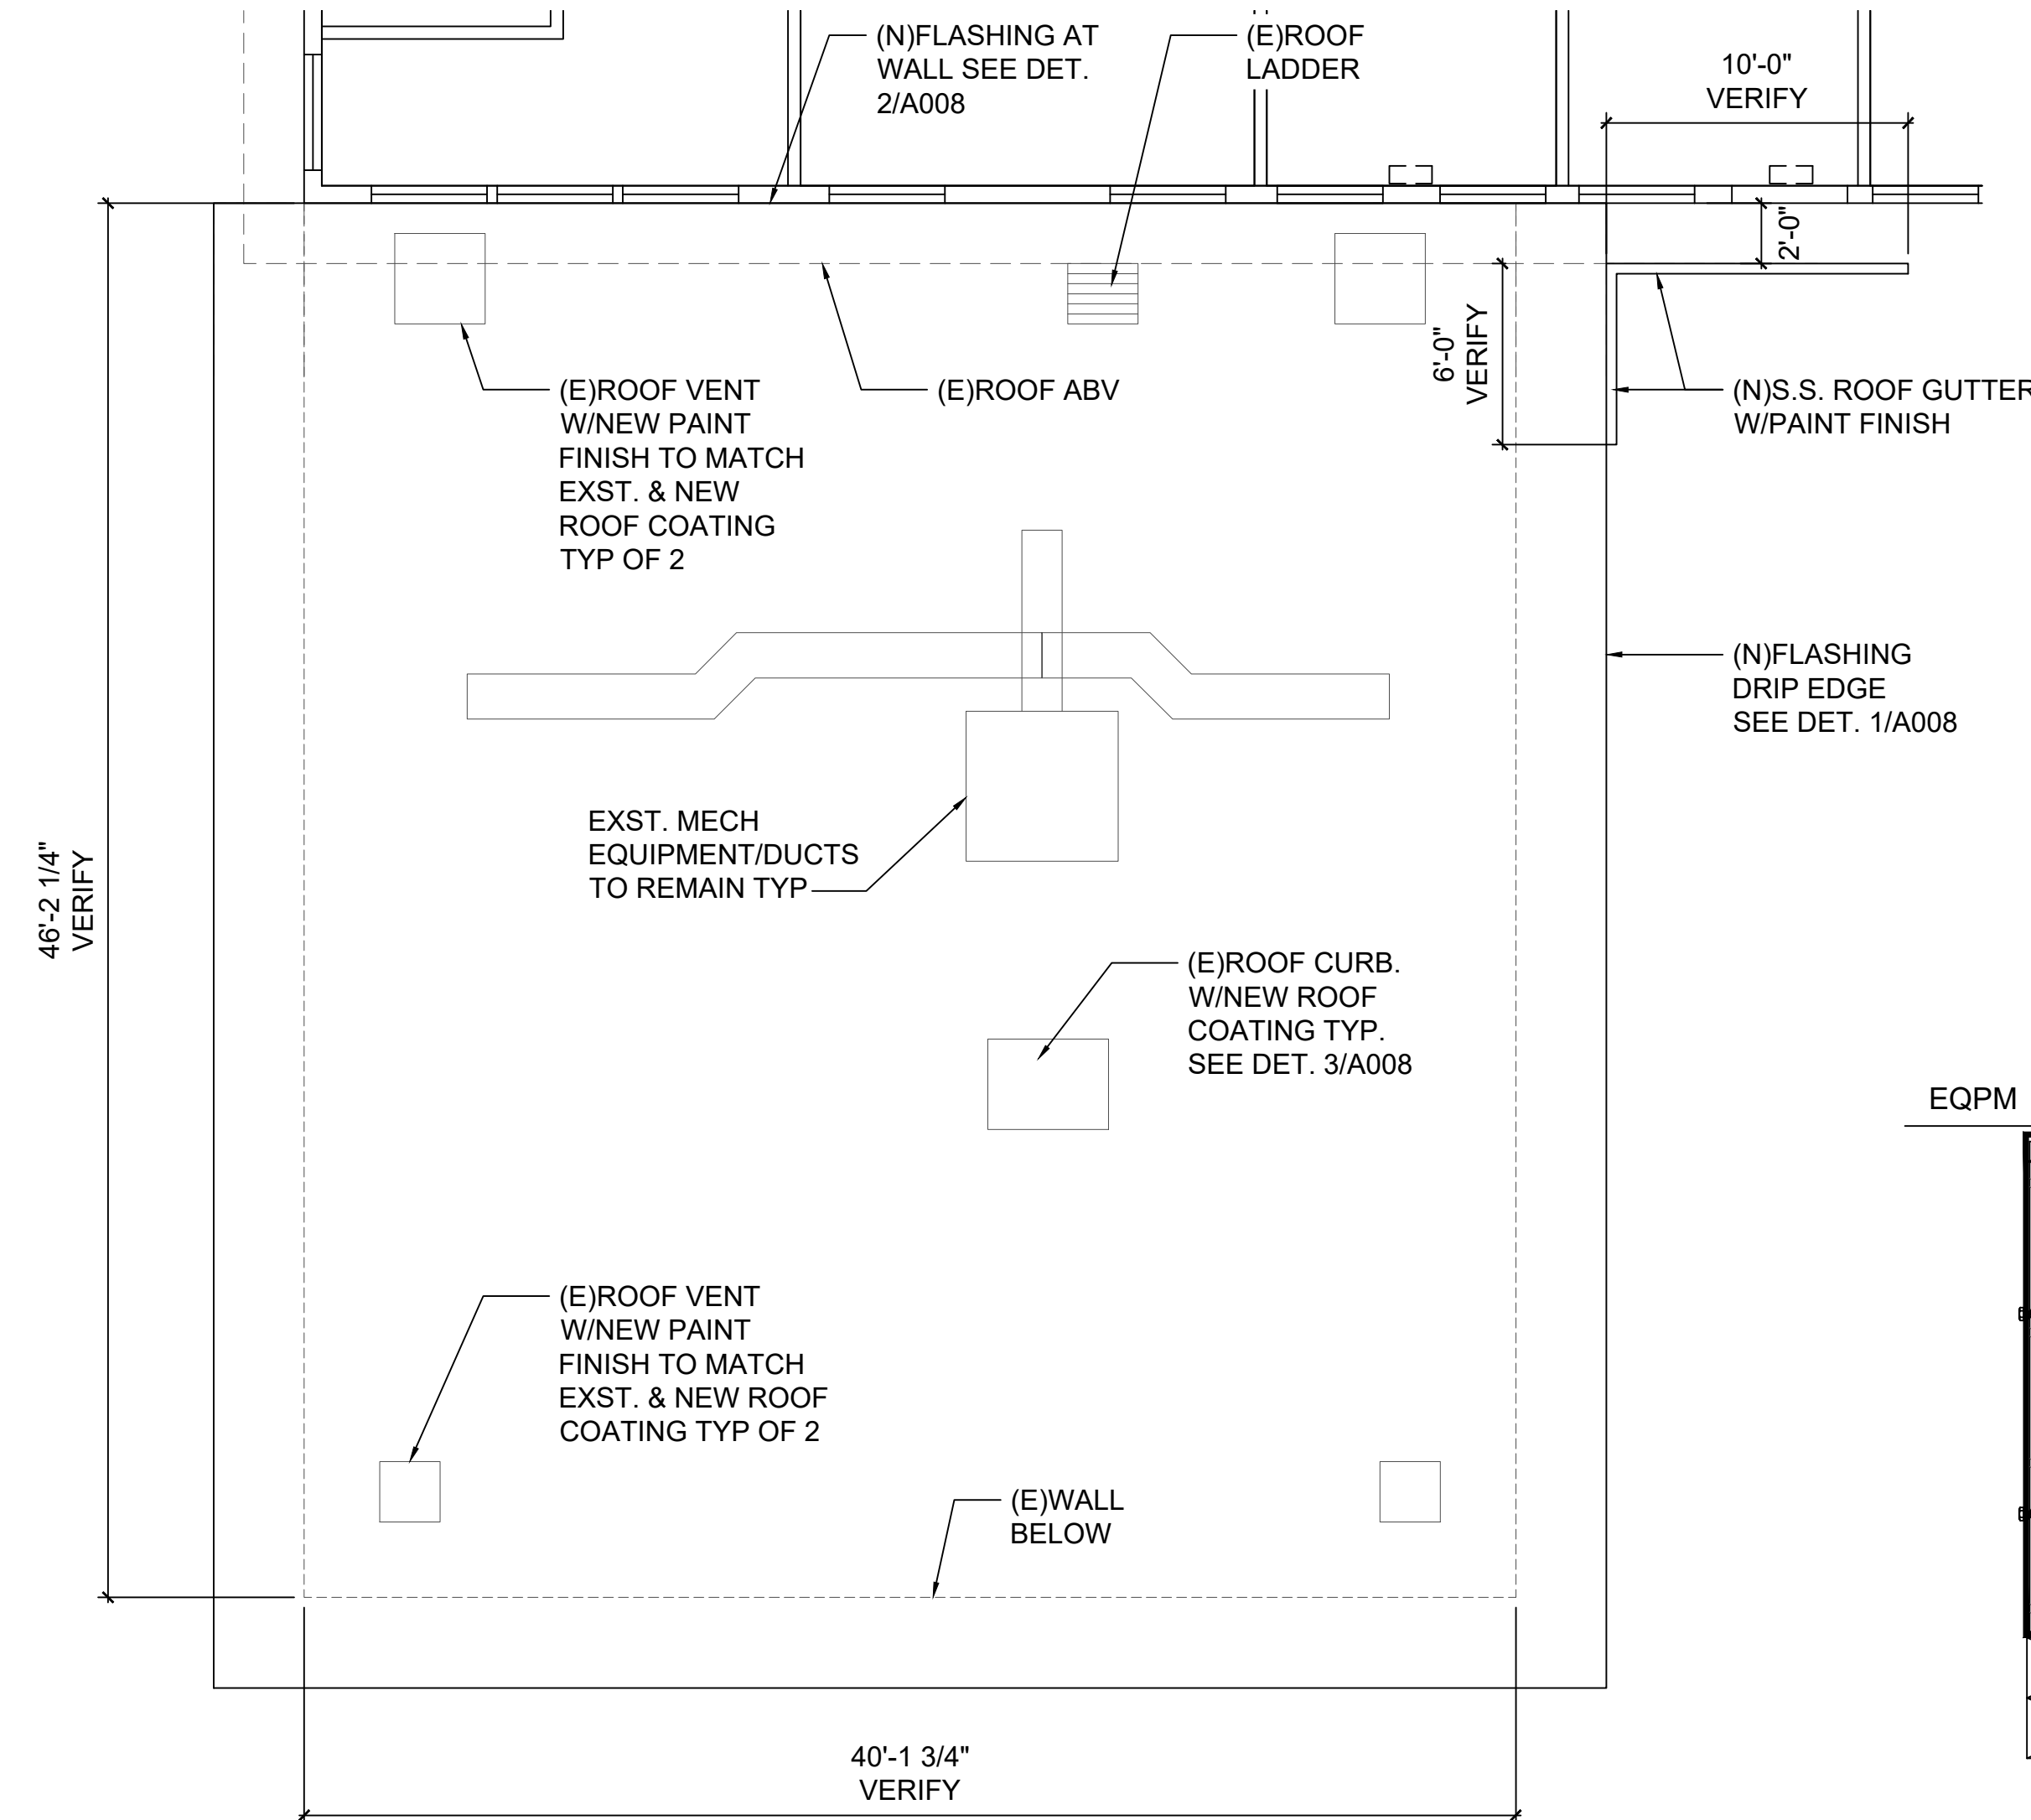

EXISTING ROOF PHOTOS

ROOF PLAN
SCALE: 3/16" = 1'-0"
NORTH



This work was prepared by me or under my supervision.

DSGN.	DRWN.	CHKD.	APPD.
LH/JM	KN/KT/JM	LH/JM	LH

NO.	DATE	REVISIONS
2	11/18/22	ADDENDUM #2
1	11/03/22	ADDENDUM #1

FINAL SUBMITTAL
09/30/22
DATE

PROJECT TITLE :

AIR TRAFFIC CONTROL TOWER REPAIRS
AT
KALAELOA AIRPORT
BARBERS POINT, OAHU, HAWAII

PROJECT NO.:

A05024-03

SHEET TITLE:

ROOF PLAN

DATE :

09/30/22

SHEET :

13 OF 49 SHEETS

DWG. NO.

A008