


FED. ROAD DIST. NO.	STATE	FED. AID PROJ. NO.	FISCAL YEAR	SHEET NO.	TOTAL SHEETS
HAWAII	HAW	F 59(4)	1952	12	56

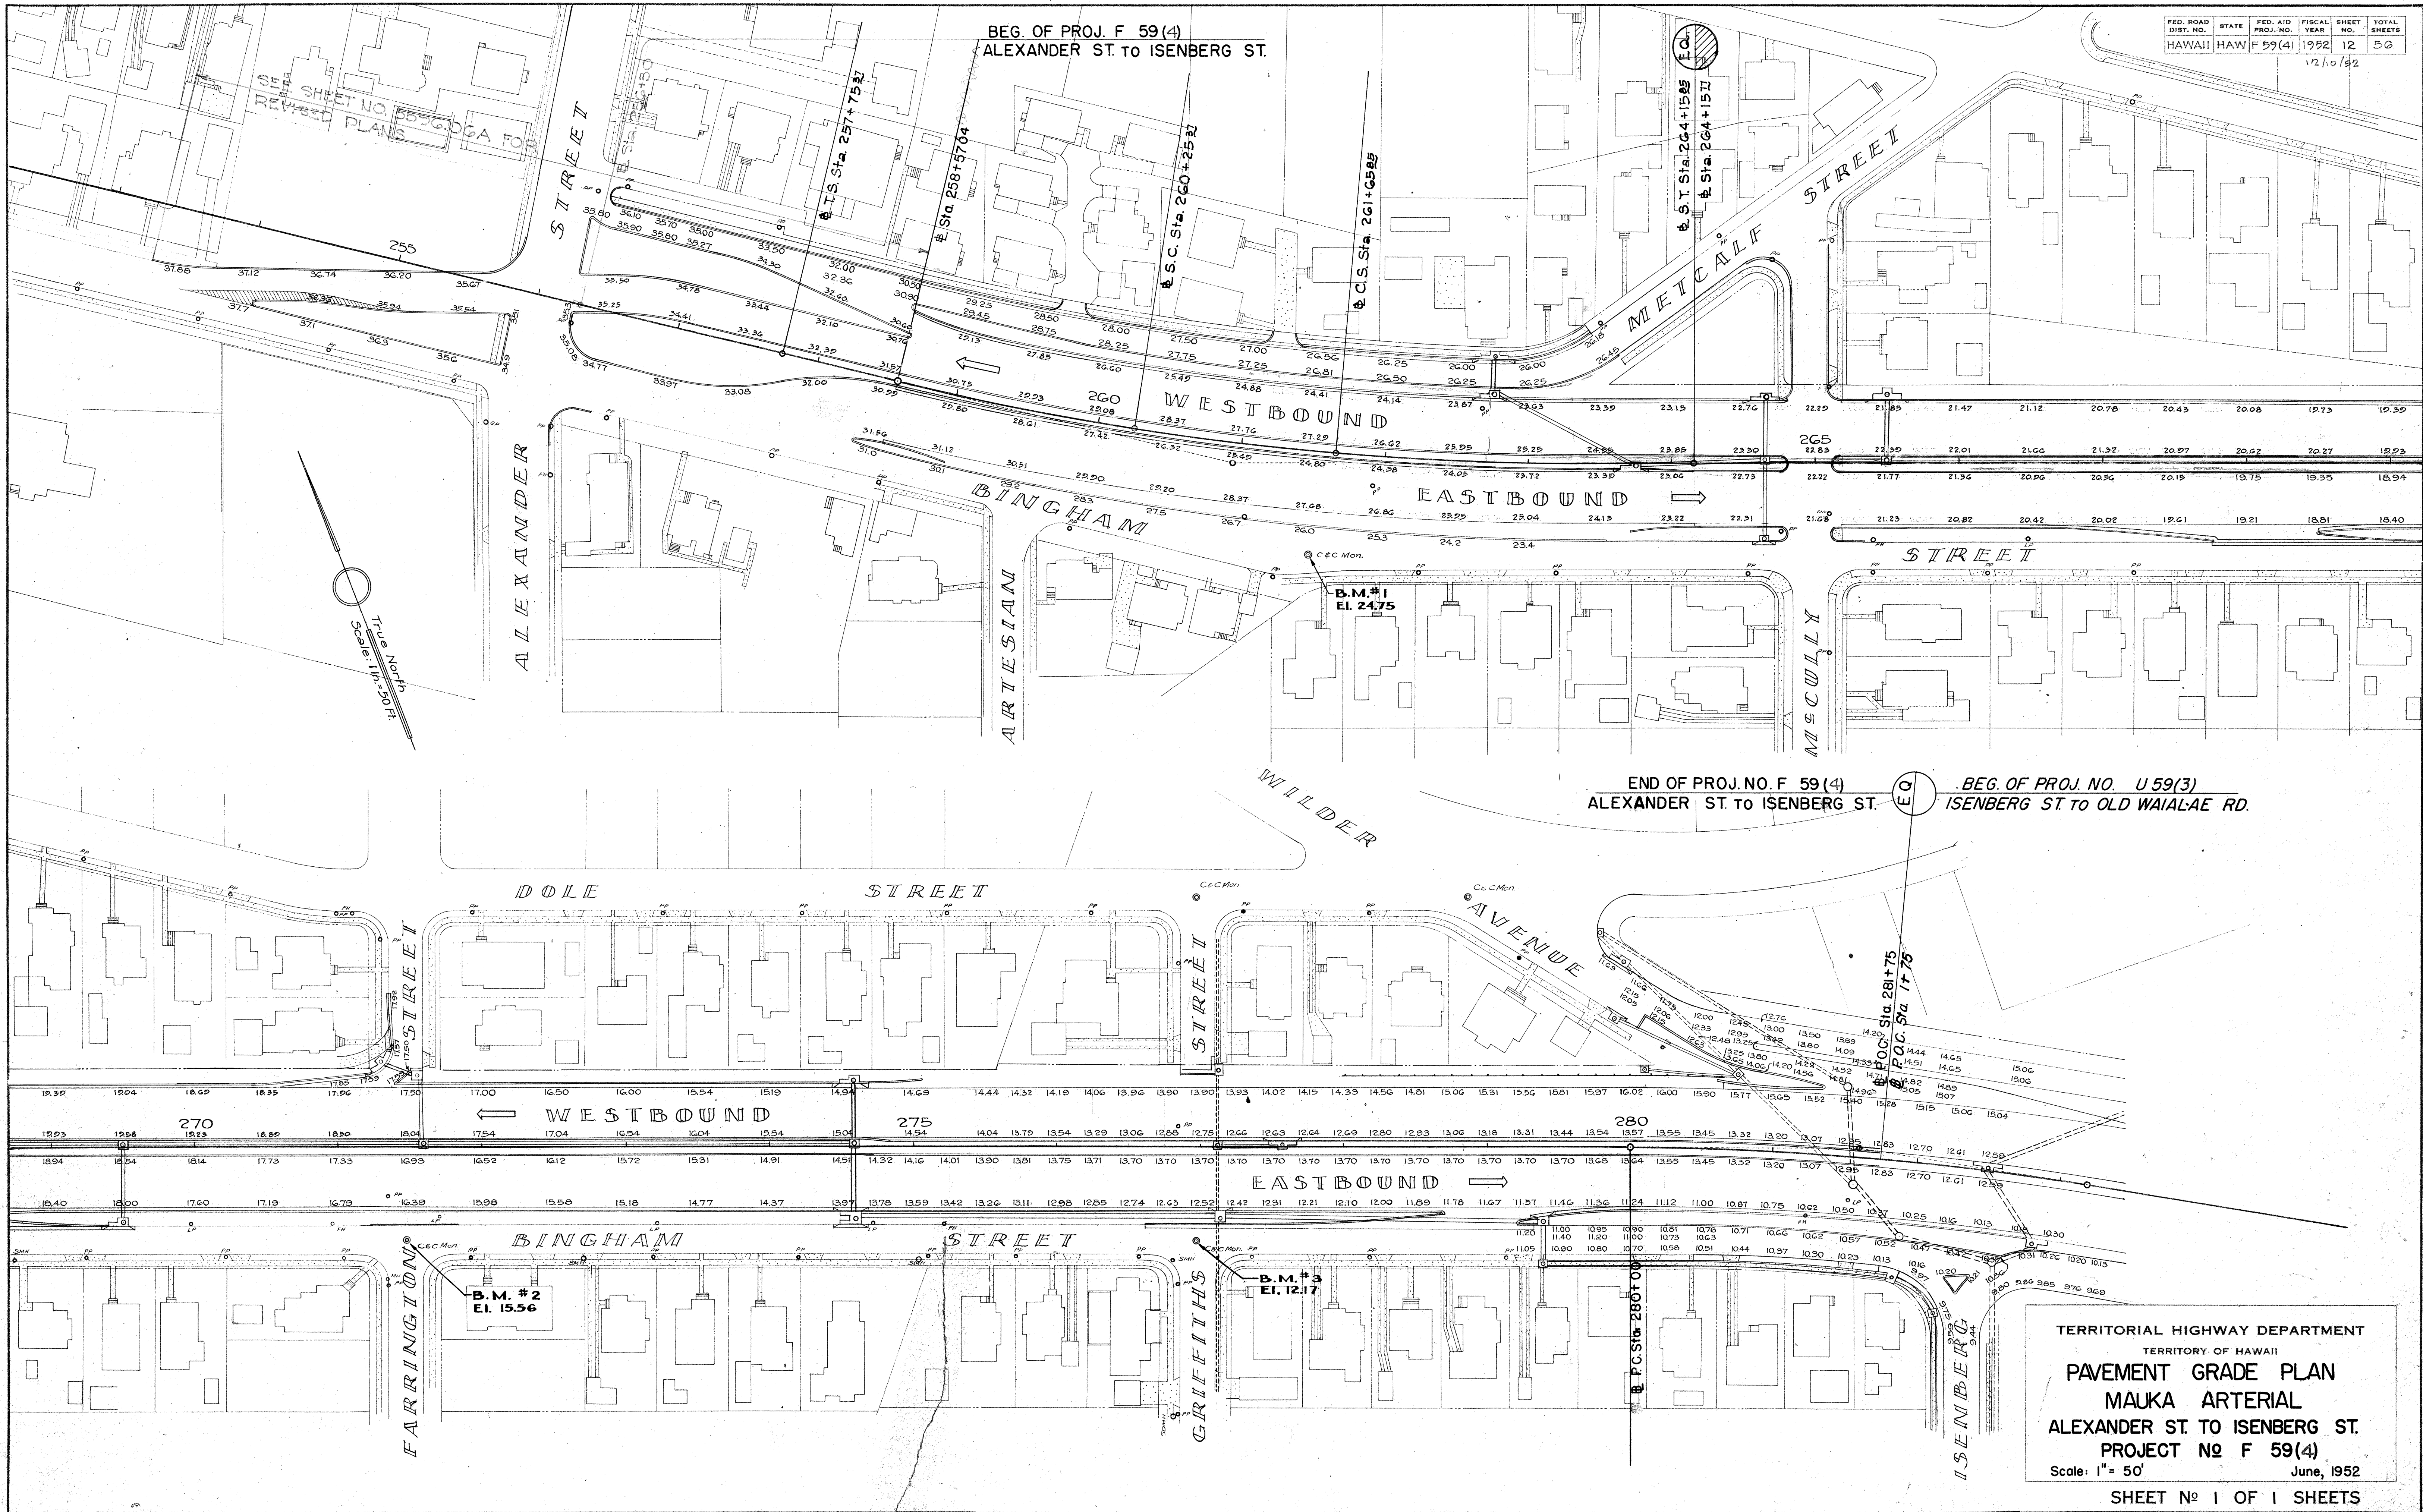

DATE: _____
 SURVEY PLOTTED BY: _____
 ORIGINAL PLAN: _____
 DRAWN BY: _____
 TRACED BY: _____
 QUANTITIES BY: _____
 CHECKED BY: _____
 NOTE BOOK: _____
 No. _____

TERRITORIAL HIGHWAY DEPARTMENT
 TERRITORY OF HAWAII
PAVEMENT GRADE PLAN
MAUKA ARTERIAL
ALEXANDER ST. TO ISENBERG ST.
PROJECT NO F 59(4)
 Scale: 1" = 50' June, 1952