

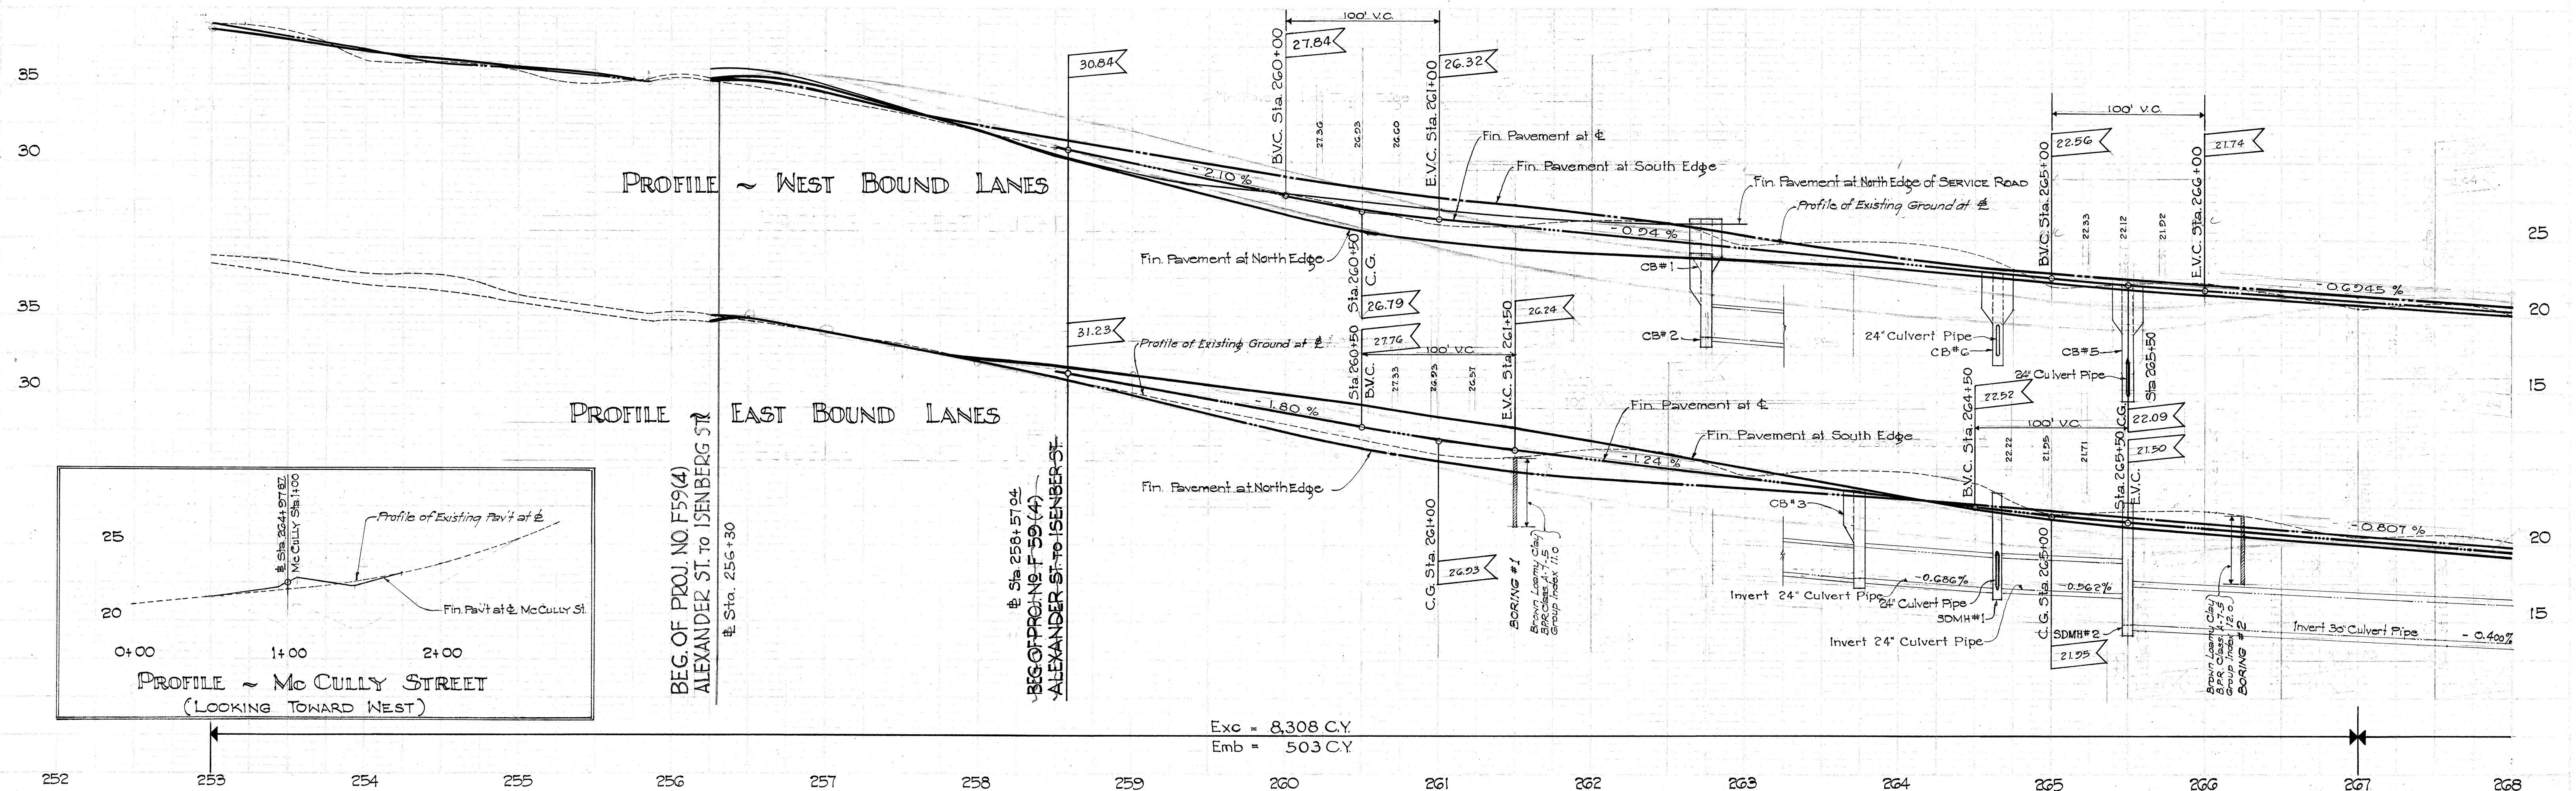
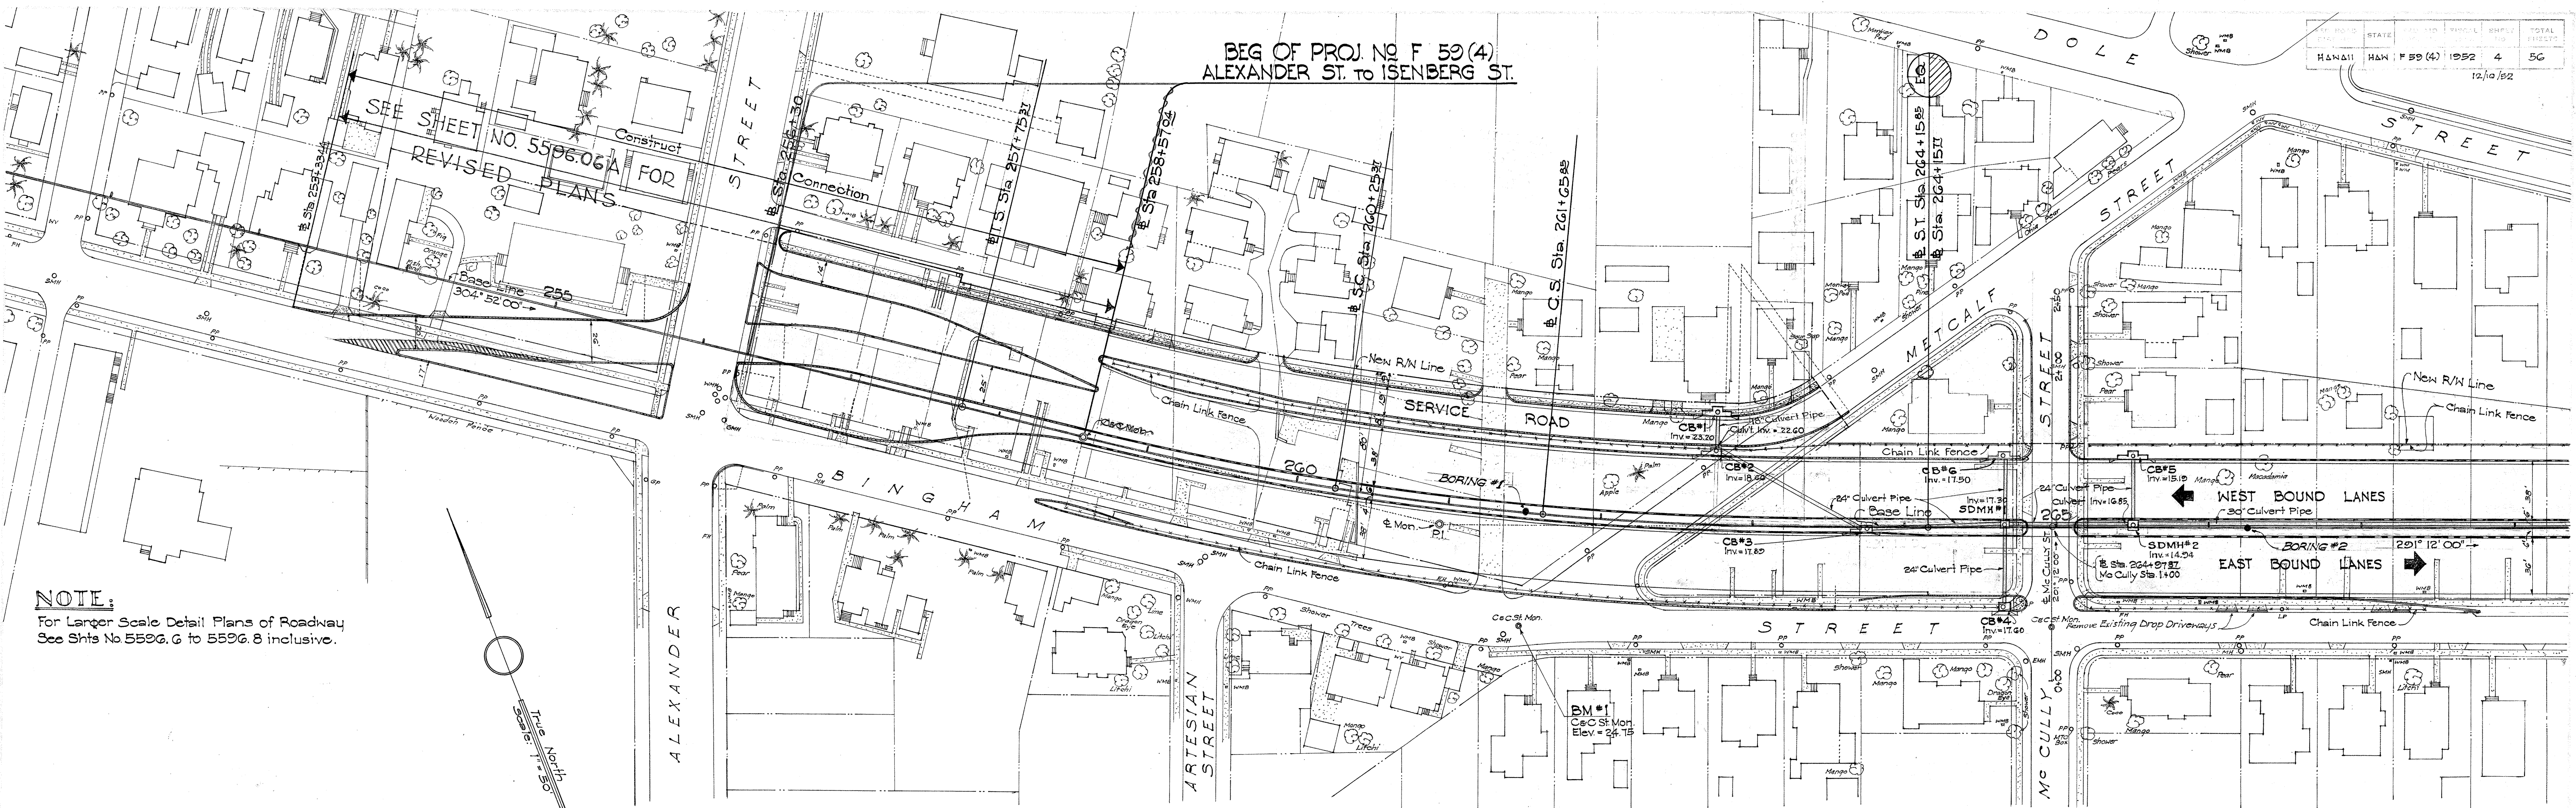


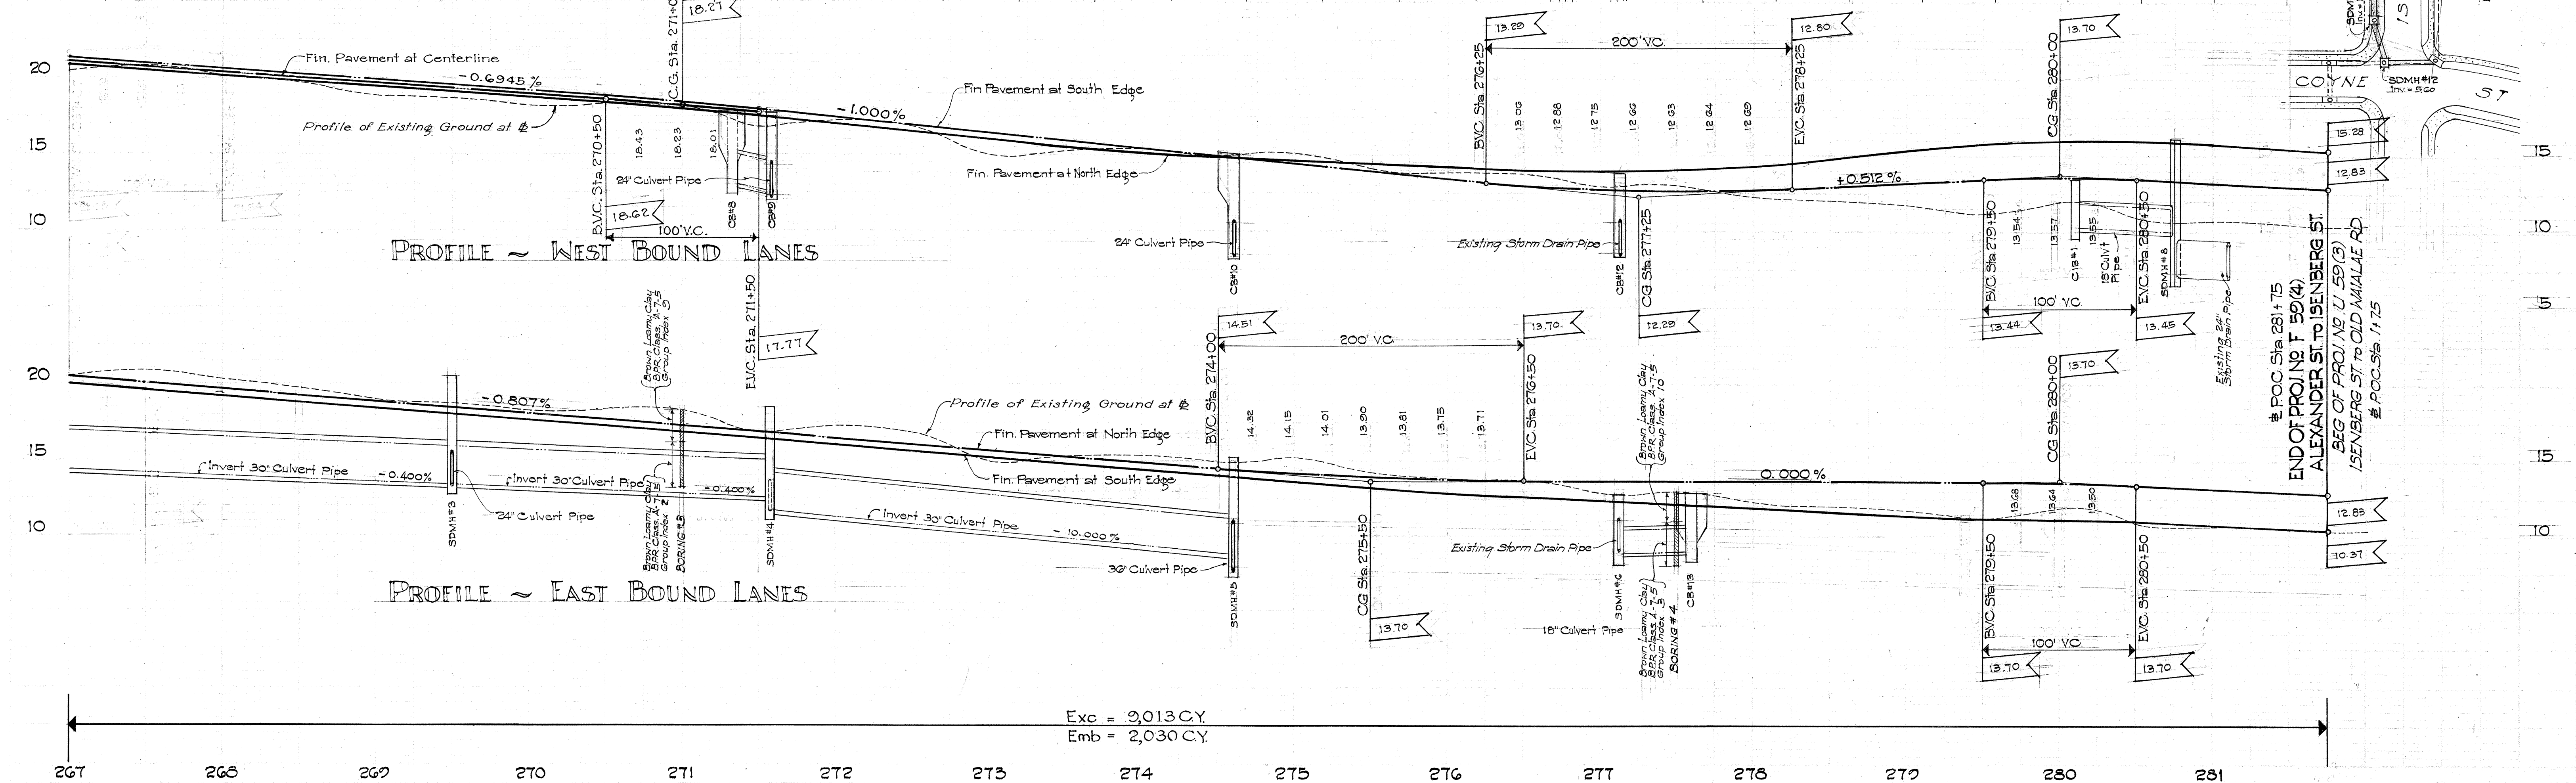

5596.04

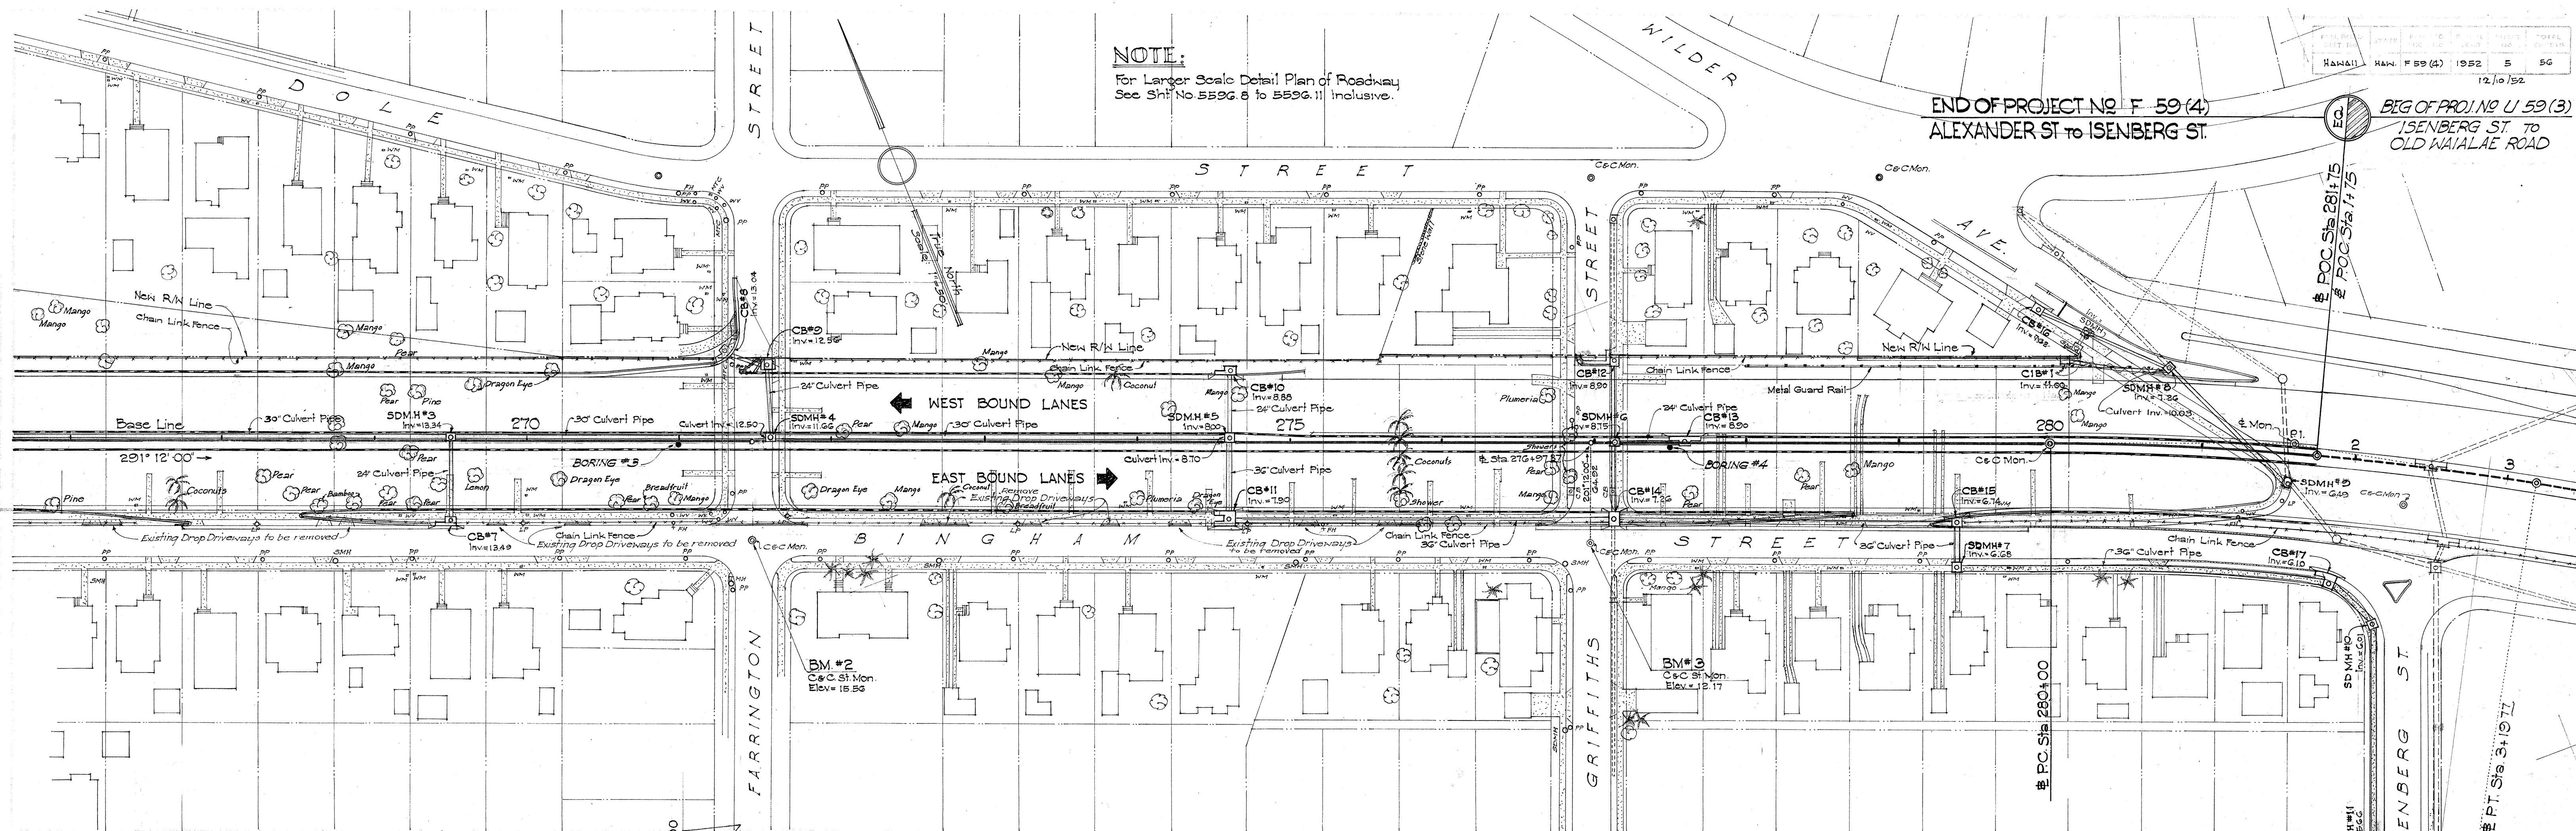

5596.05