



INDEX TO DRAWINGS	
SHEET NO.	DESCRIPTION
1	Title Sheet
2 - 3	Typical Sections
4 - 5	Plan and Profile
6 - 11	Detail Plan of Roadway
12	Pavement Grades
13 - 16	Utility Plan
17 - 19	Plan of Water System
20 - 21	Highway Lighting System
22 - 23	Traffic Signal System
24 - 26	Traffic Signs
27 - 32	Landscape Plans
33 - 38	Sprinkler System
39 - 46	Drainage Structures
47 - 50	Standard Details
51 - 56	Cross Sections

CONVENTIONAL SIGNS	
Base Line (B)-----	-----
Center Line (C)-----	-----
Right of Way (R/W) Line-----	----- or -----
Fences (Named)-----	-----
Existing Roadway-----	-----
Concrete Pipe Culvert-----	-----
Concrete Box Culvert-----	-----
Standard Catch Basin-----	-----
Concrete Intake Box-----	-----
Existing Pipe Culvert-----	-----
Manhole (Named)-----	-----
Telephone Pole-----	oTP
Electric Power Pole-----	ePP
Water Line (Size Noted)-----	W12 W16
Fire Hydrant-----	oFH
Gas Line (Size Noted)-----	oG1-1/2 oG2
Tree (Large Named)-----	oBanyan oCoconut
Overhead Electric Wire-----	lw 2w
Concrete Sidewalk & Concrete Pavement-----	-----

TERRITORY OF HAWAII
TERRITORIAL HIGHWAY DEPARTMENT
HONOLULU, OAHU, T. H.

PLANS OF
MAUKA ARTERIAL
ALEXANDER STREET TO ISENBERG STREET
FEDERAL AID PROJECT Nº F 59 (4)
DISTRICT OF HONOLULU
ISLAND OF OAHU

SCALES	
PLAN	HOR 1 INCH = 50 FEET
PROFILE	HOR 1 INCH = 50 FEET VERT 1 INCH = 5 FEET
CROSS SECTION	HOR 1 INCH = 10 FEET VERT 1 INCH = 5 FEET

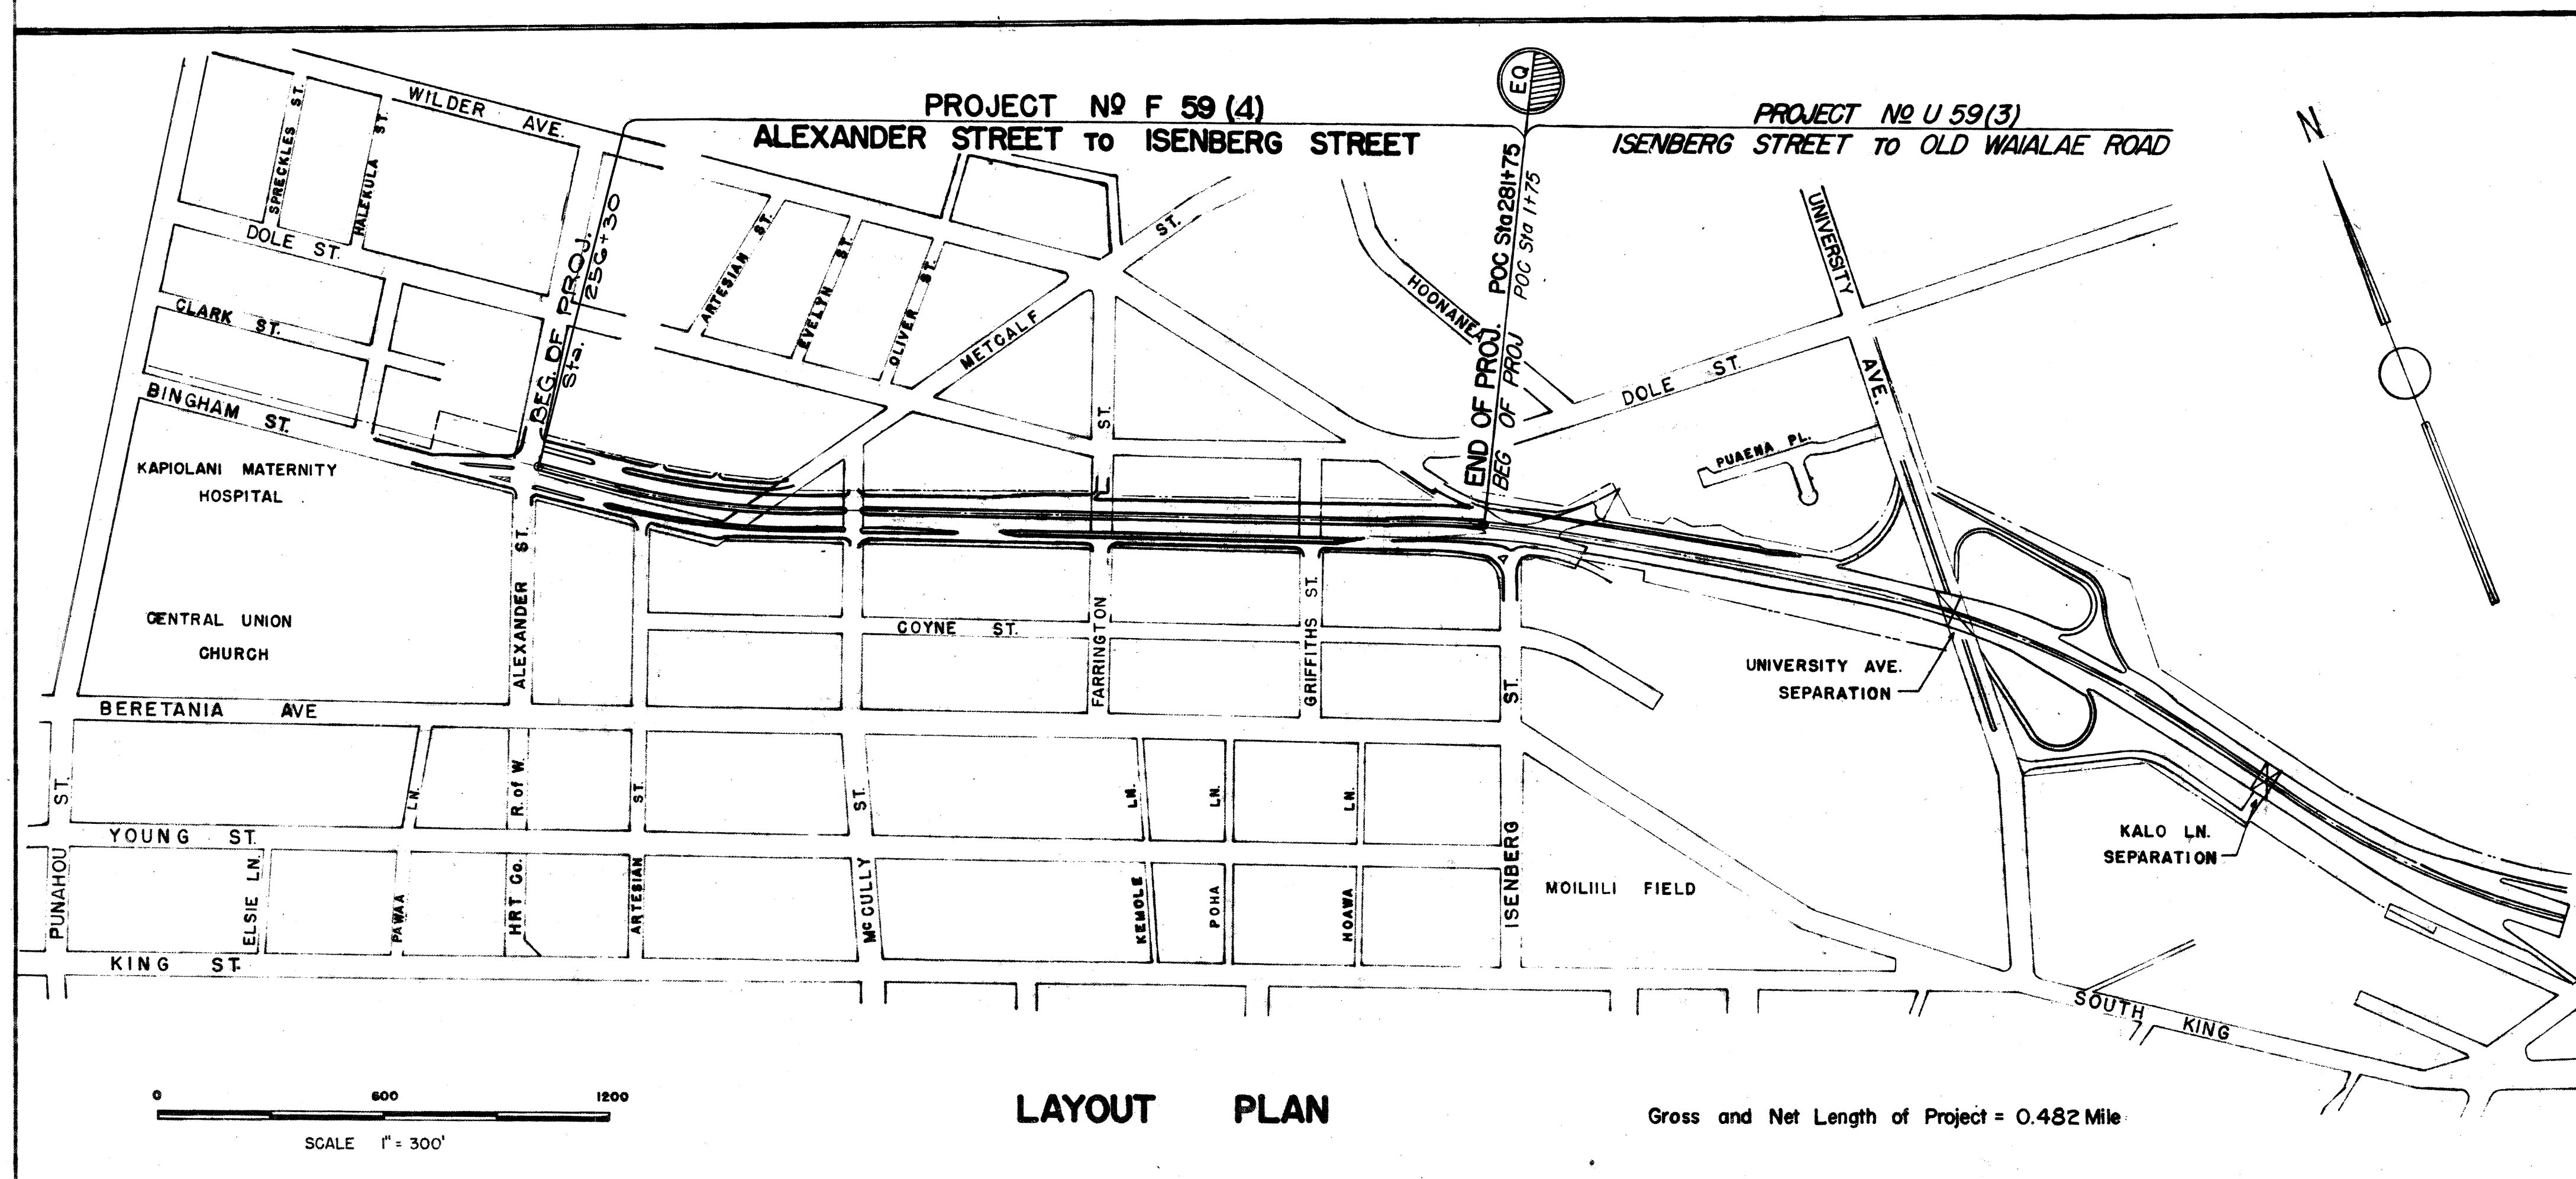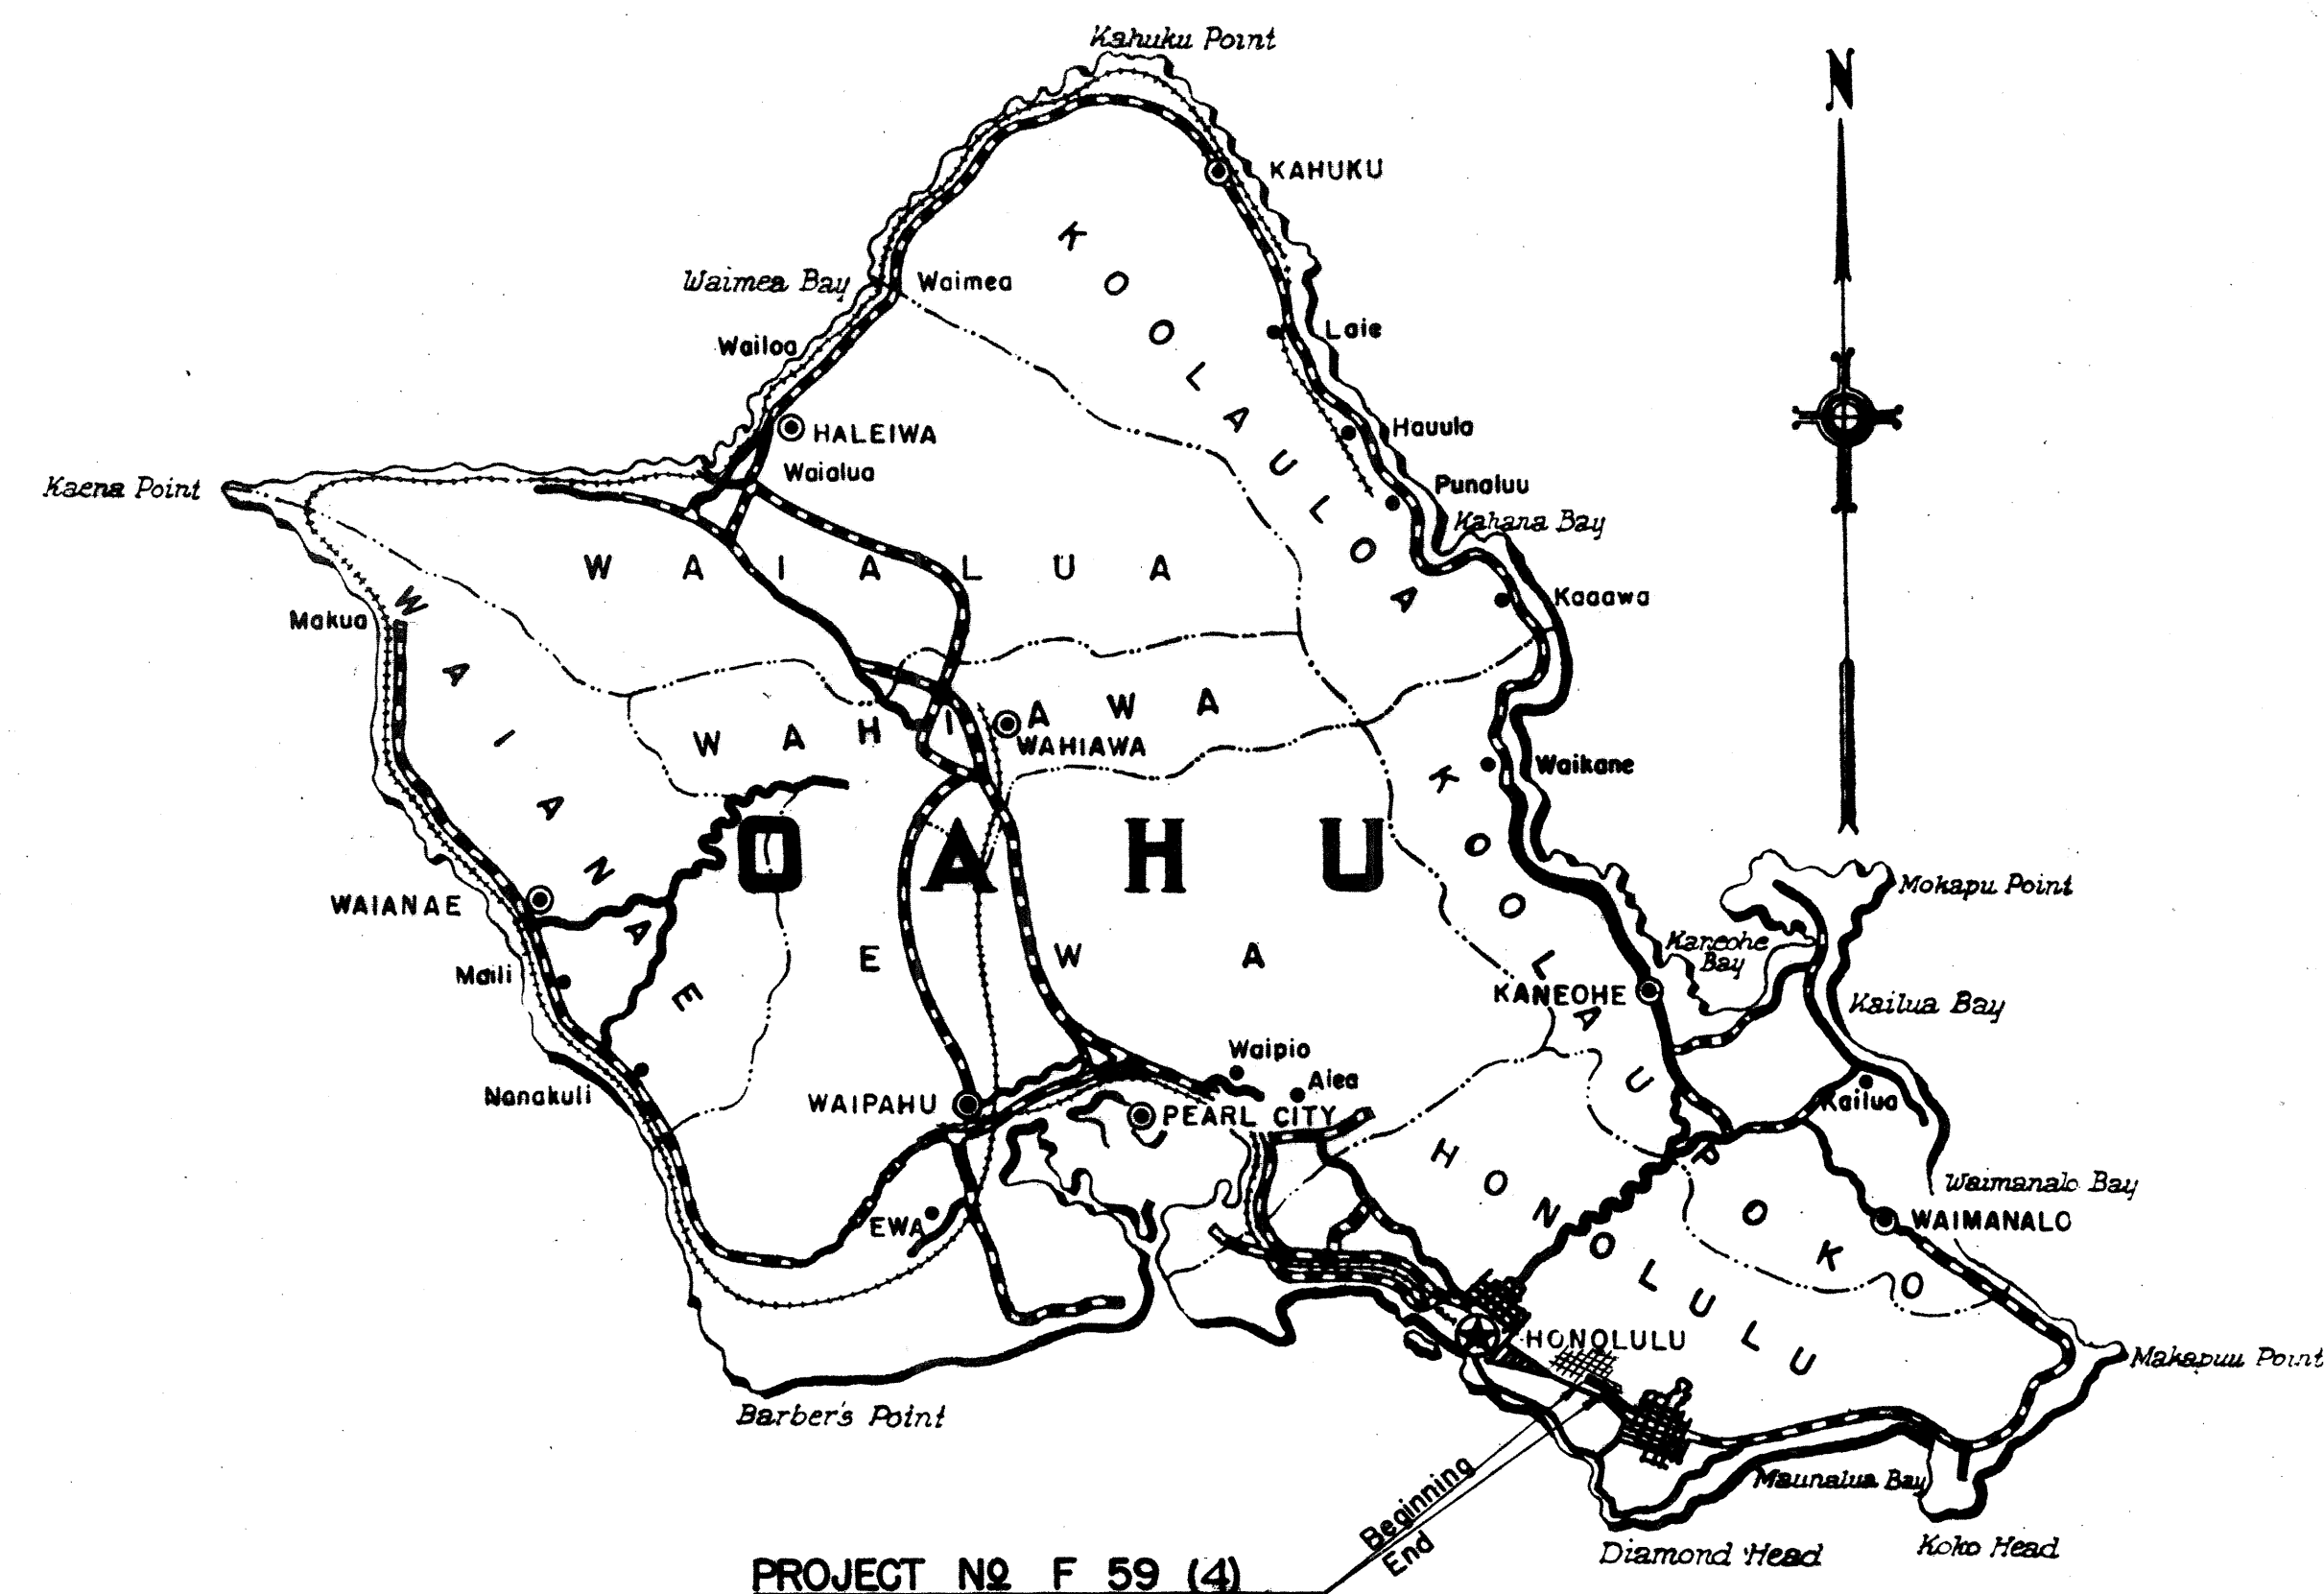

Federal Aid Projects Previously Constructed Or Under Construction

NOTE:
ALL CHANGES MADE DURING CONSTRUCTION
HAVE BEEN NOTED IN RED IN THESE TRACINGS
AND CHECKED BY:

[Signature]
PROJECT ENGINEER
DATE 12-21-53

THIS SHEET SUPERSEDES SHEET NO. 5596.01

APPROVED *[Signature]* DATE 11/10/52
TERRITORIAL HIGHWAY ENGINEER

DEPARTMENT OF COMMERCE
BUREAU OF PUBLIC ROADS
RECOMMENDED FOR APPROVAL:
DISTRICT ENGINEER DATE
APPROVED: DIVISION ENGINEER DATE

5596.01A