


ORIGINAL SURVEY NOTE BOOK NO.	SURVEYED PLOTTED TEMPLATE AREAS CHECKED	BY	DATE

FINAL SURVEY NOTE BOOK NO.	SURVEYED PLOTTED TEMPLATE AREAS CHECKED	BY	DATE

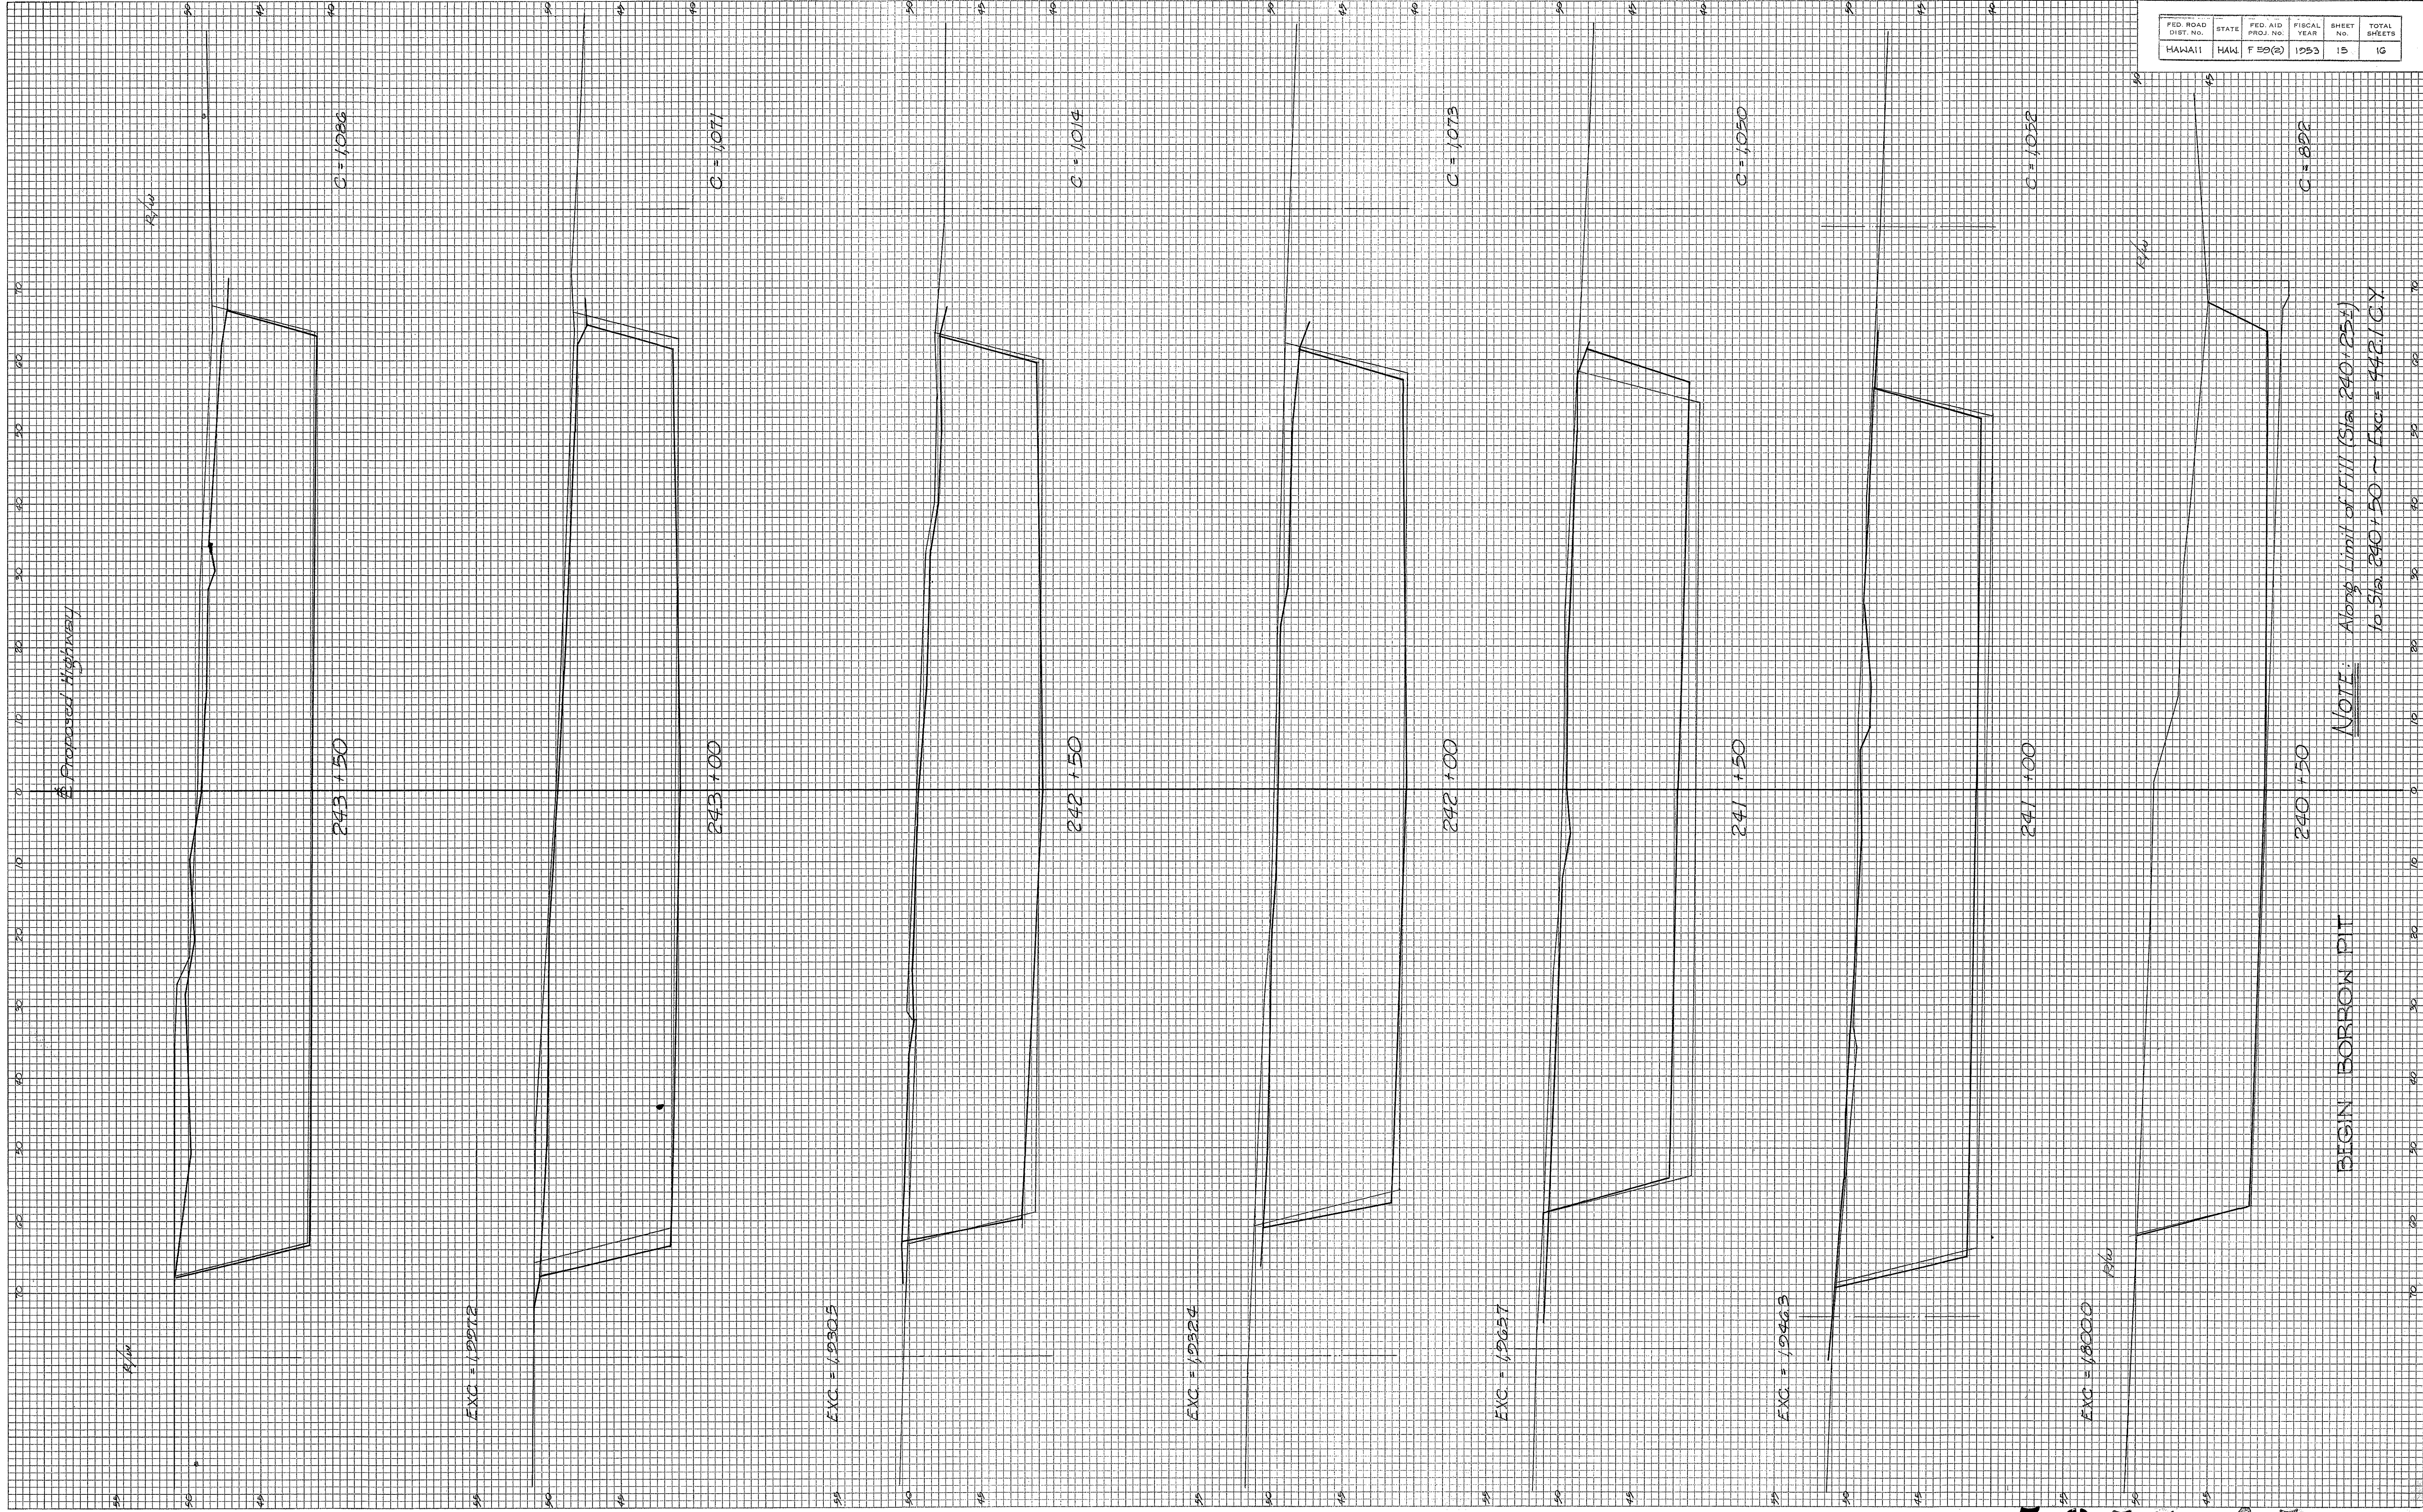

FED. ROAD DIST. NO.	STATE	FED. AID PROJ. NO.	FISCAL YEAR	SHEET NO.	TOTAL SHEETS
HAWAII	HAW.	F 59(2)	1953	15	16

ORIGINAL SURVEY NOTE BOOK NO.	SURVEYED DATE TEMPLATE AREAS CHECKED	BY	DATE

FINAL SURVEY NOTE BOOK NO.	SURVEYED DATE TEMPLATE AREAS CHECKED	BY	DATE

