


FED. ROAD DIST. NO.	STATE	FED. AID PROJ. NO.	FISCAL YEAR	SHEET NO.	TOTAL SHEETS
HAWAII	HAW	FED(2)	1953	9	10

FINAL SURVEY	BY	DATE
NOTE BOOK		
NO.		

ORIGINAL SURVEY	BY	DATE
NOTE BOOK		
NO.		

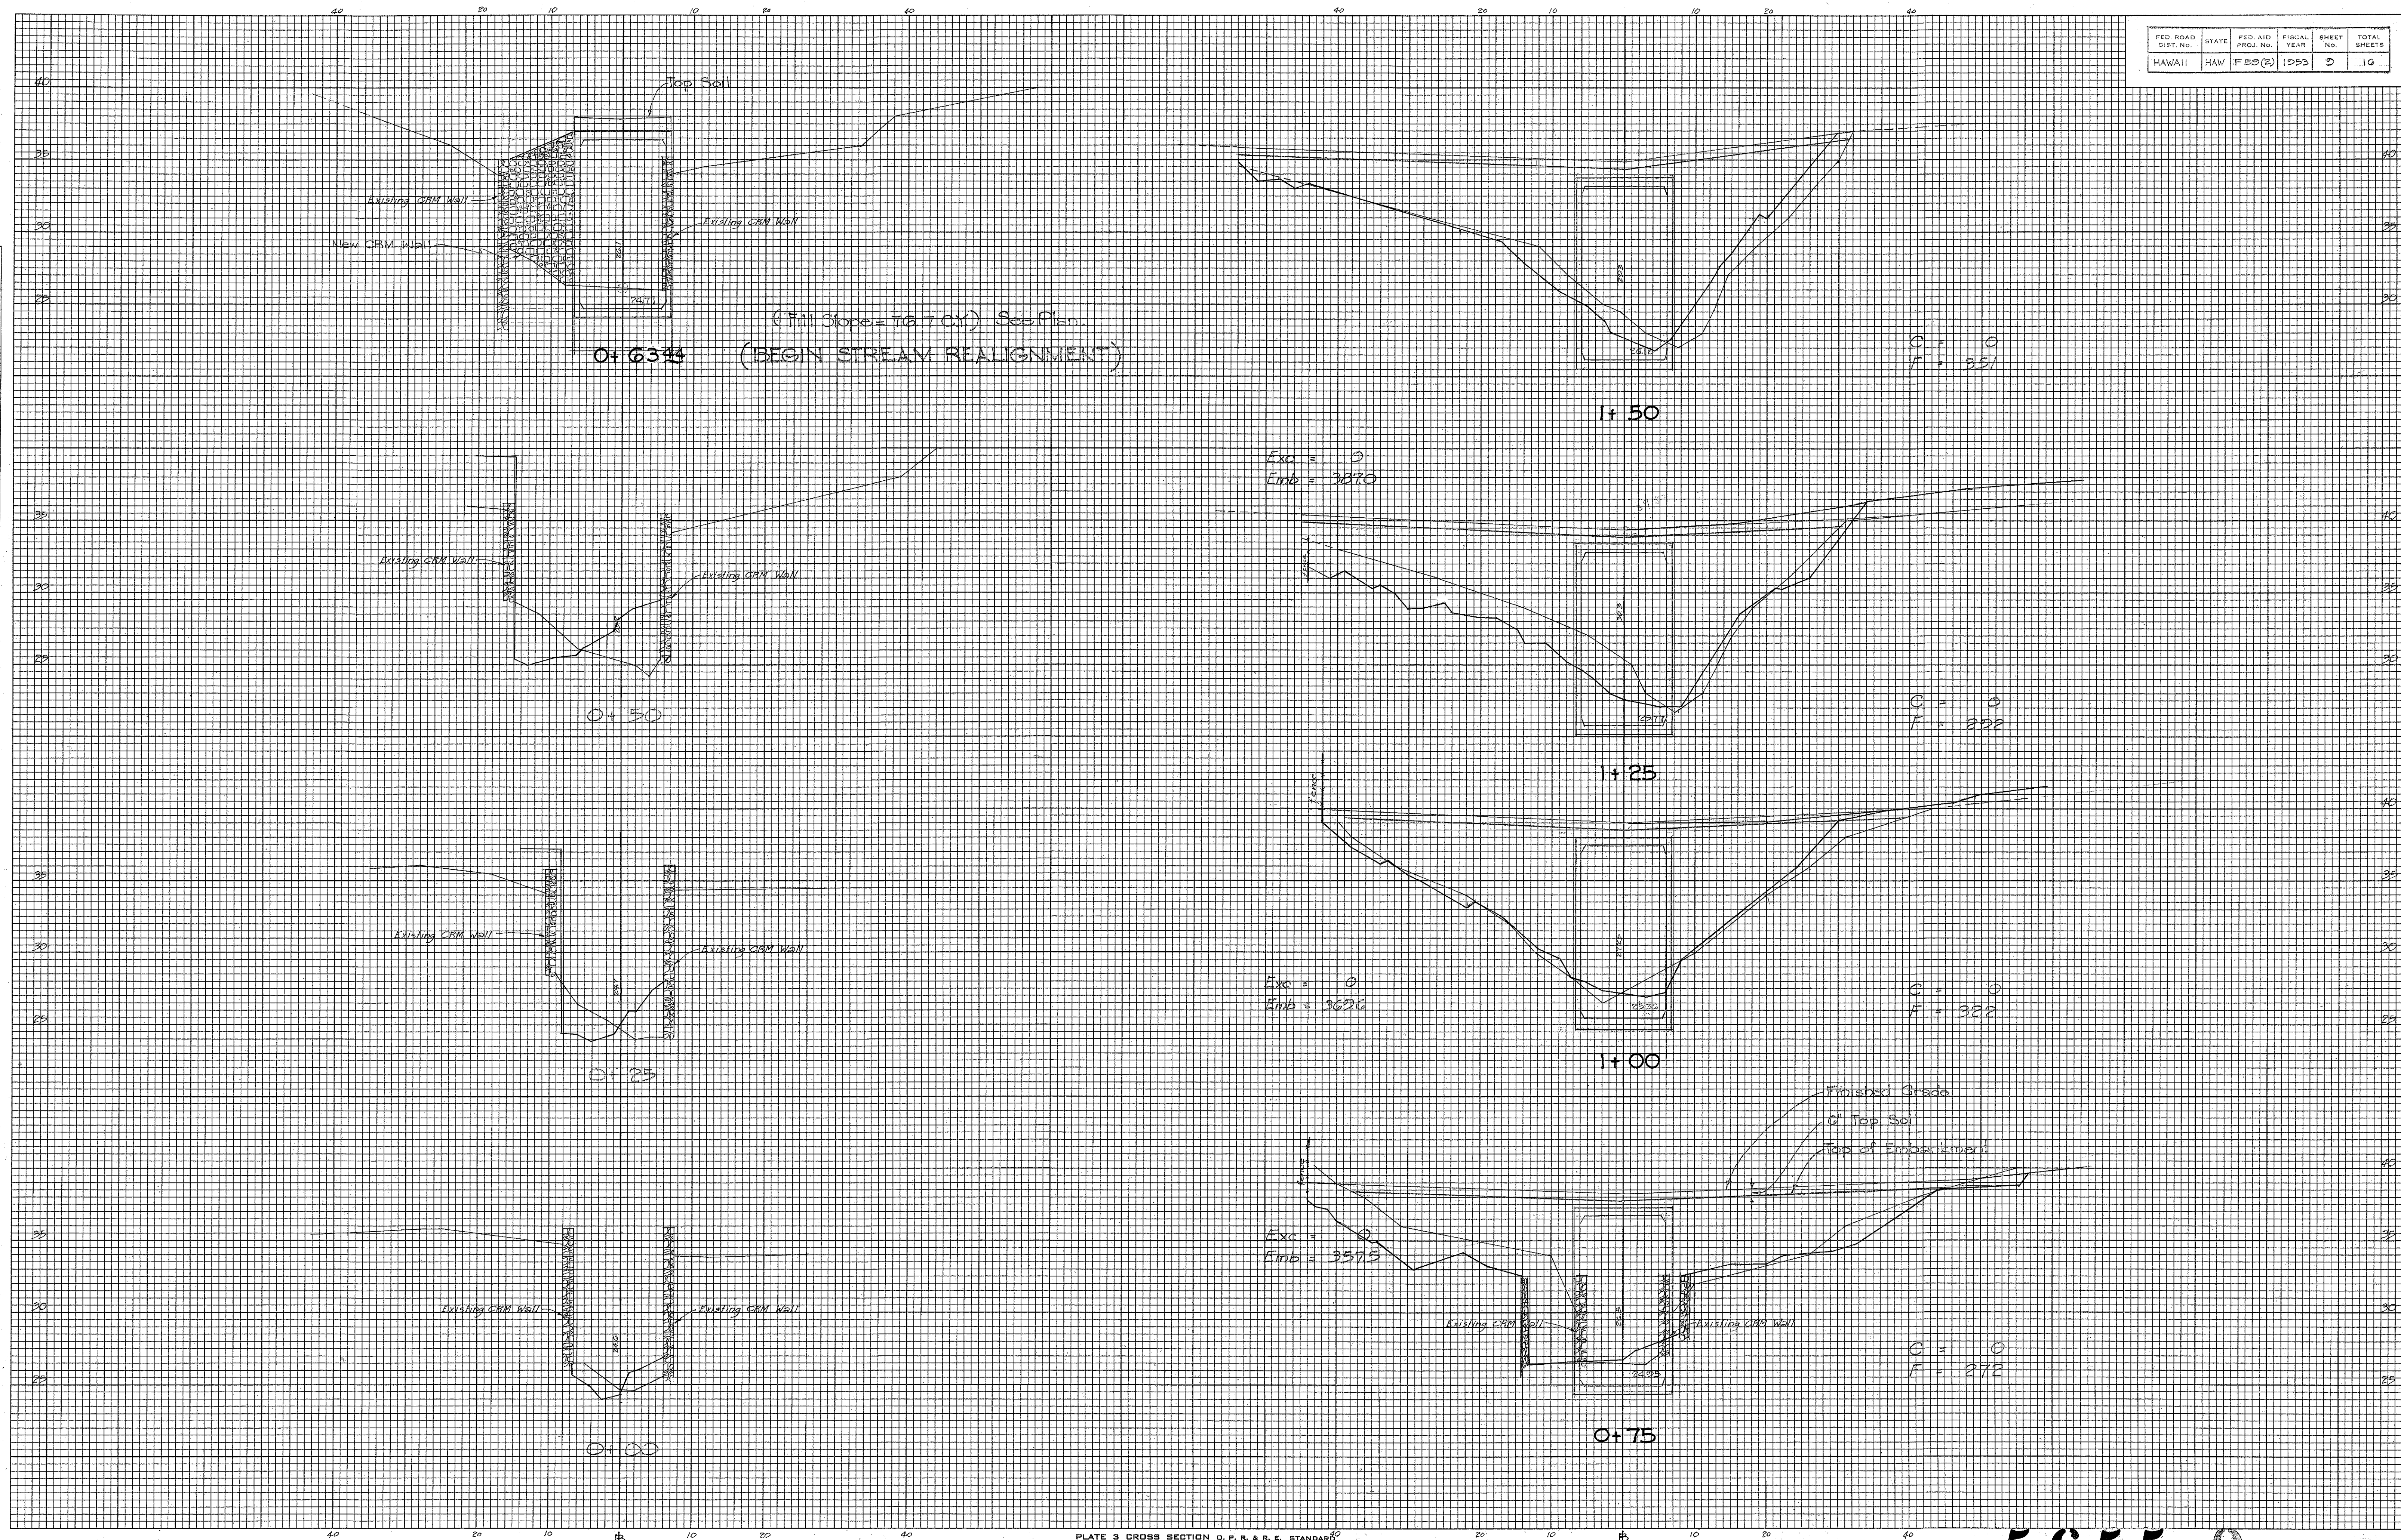


5655.9

FINAL SURVEY	DATE	
	BY	
	SURVEYED	
	NOTE BOOK	
	NO.	

ORIGINAL SURVEY	DATE	
	BY	
	SURVEYED	
	NOTE BOOK	
	NO.	


FED. ROAD DIST. NO.	STATE	FED. AID PROJ. NO.	FISCAL YEAR	SHEET NO.	TOTAL SHEETS
HAWAII	HAW	F 59(2)	1953	10	16

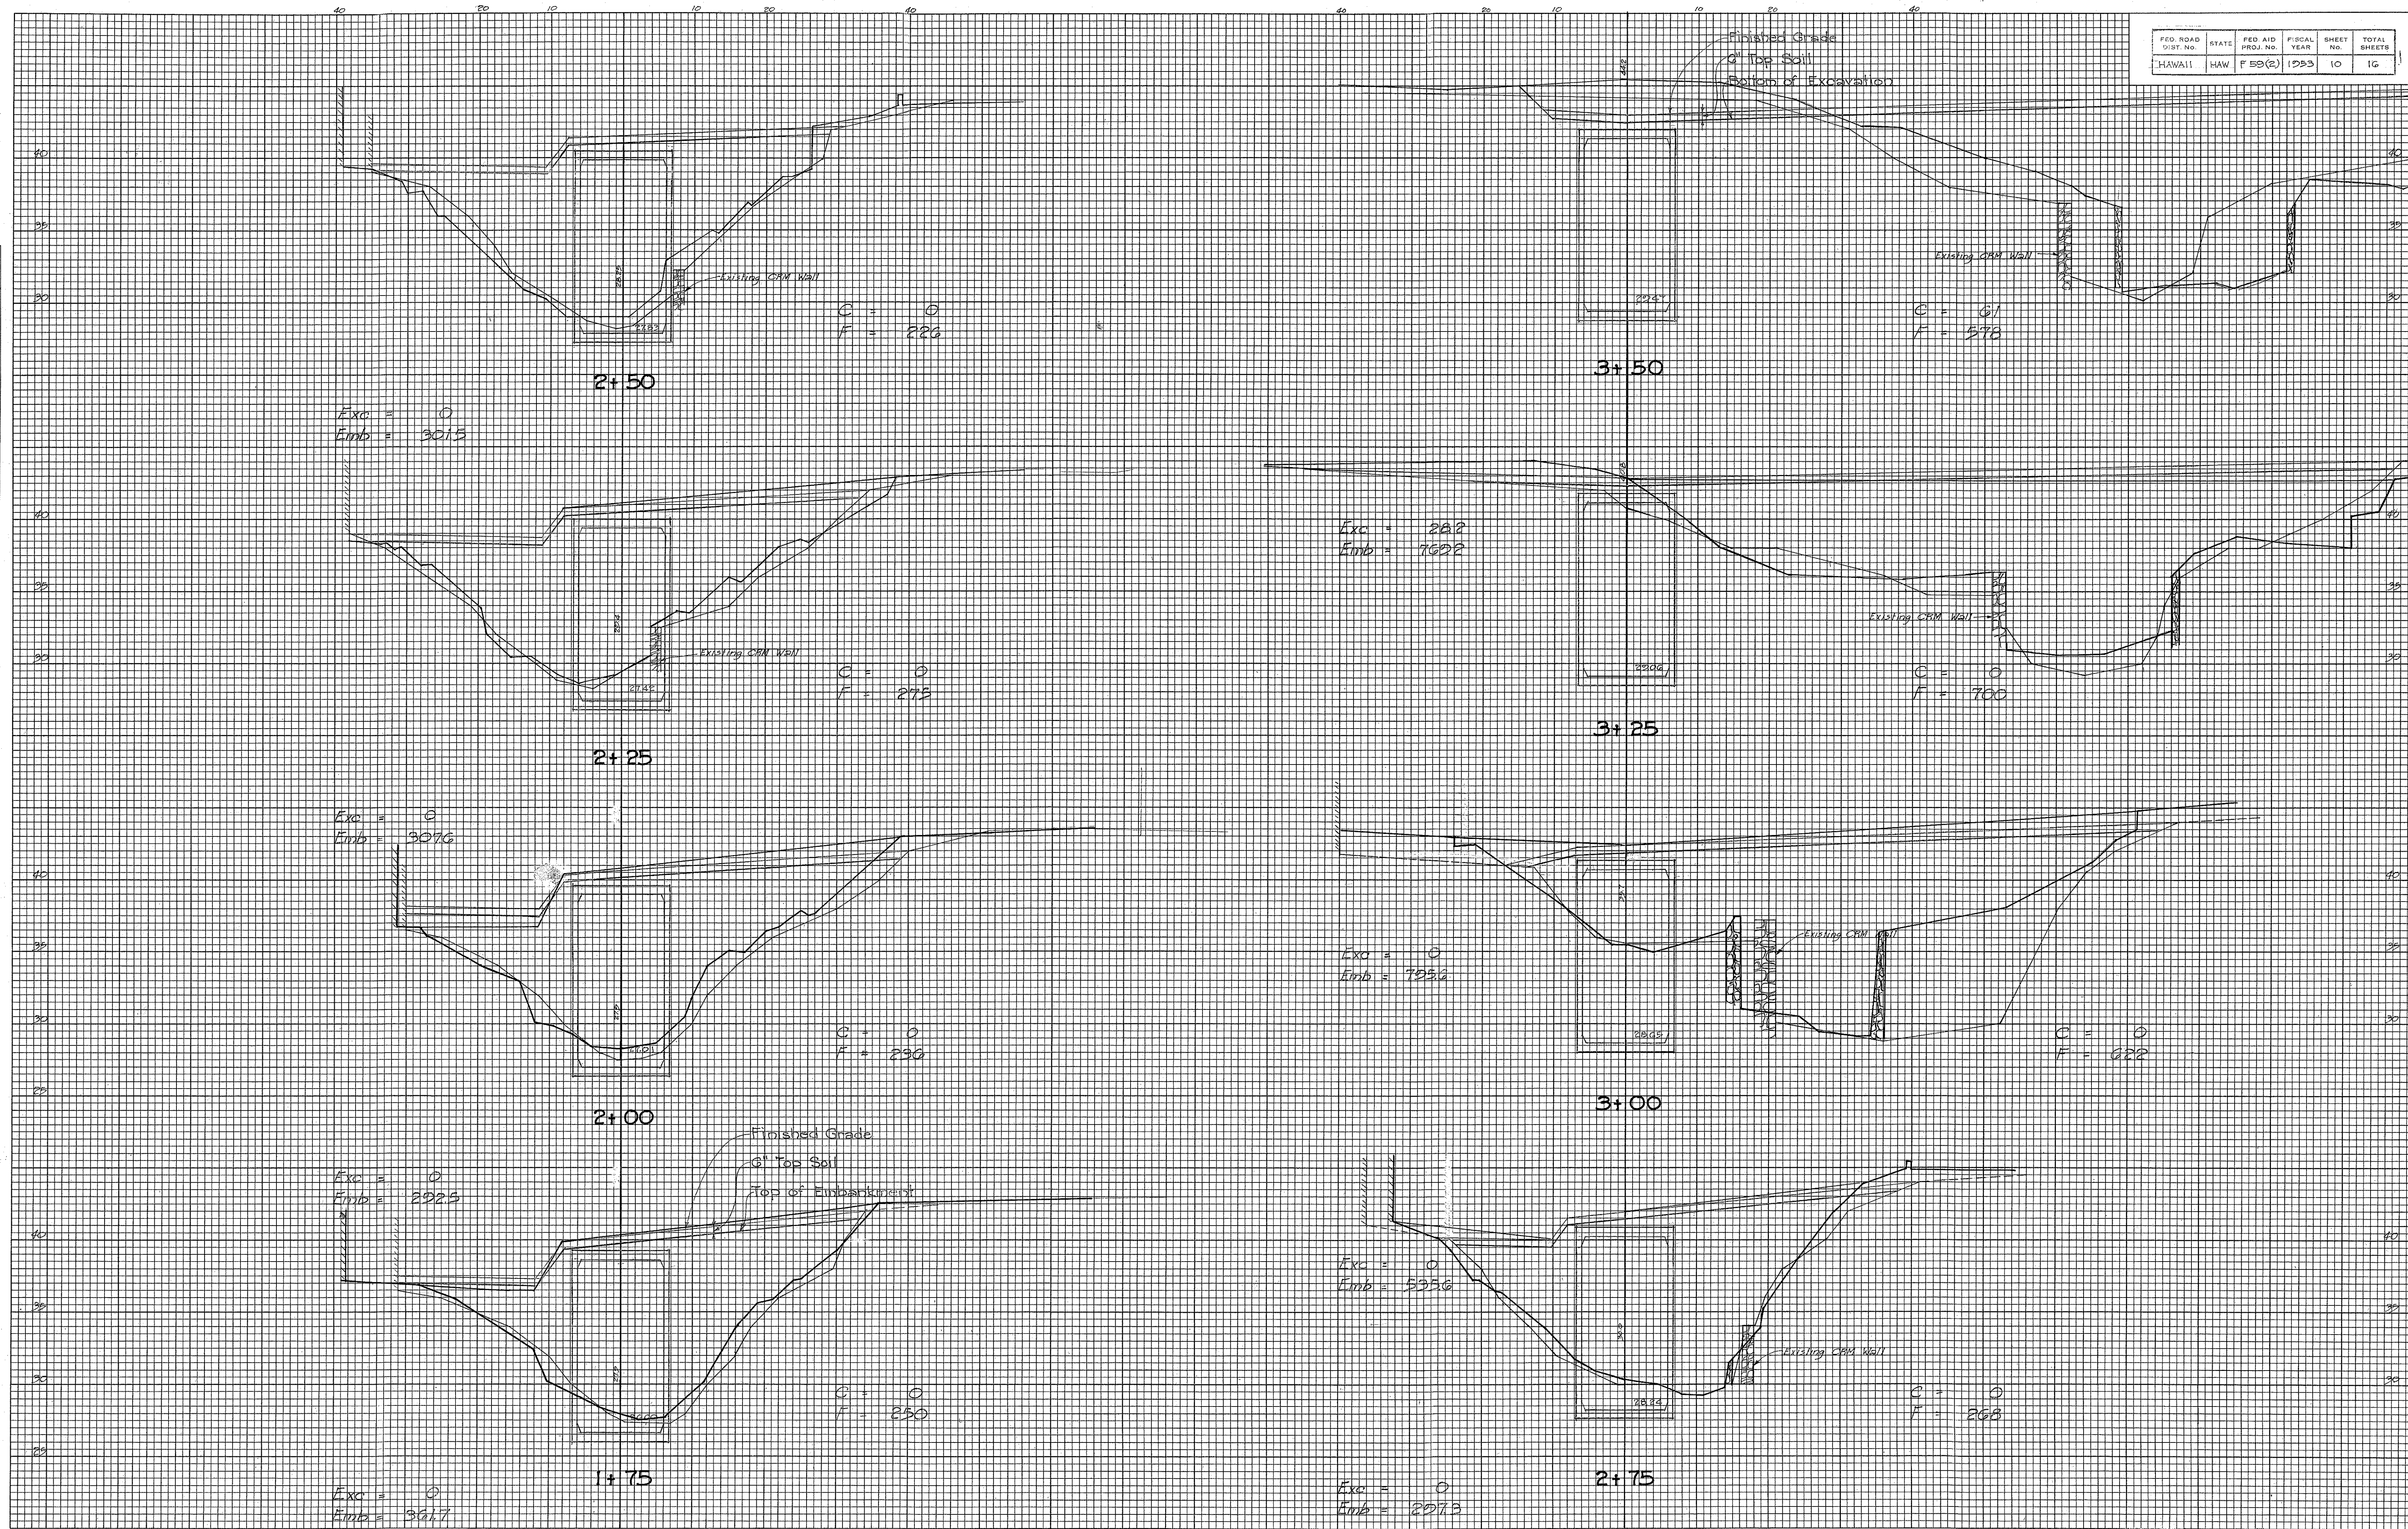

FINAL SURVEY	DATE	BY
	SURVEYED	BY
	NOTED	BY
	NO.	NO.

ORIGINAL SURVEY	DATE	BY
	SURVEYED	BY
	NOTED	BY
	NO.	NO.


FED. ROAD DIST. NO.	STATE	FED. AID DIST. NO.	FISCAL YEAR	SHEET NO.	TOTAL SHEETS
HAWAII	HAW	F 50(2)	1953	12	16

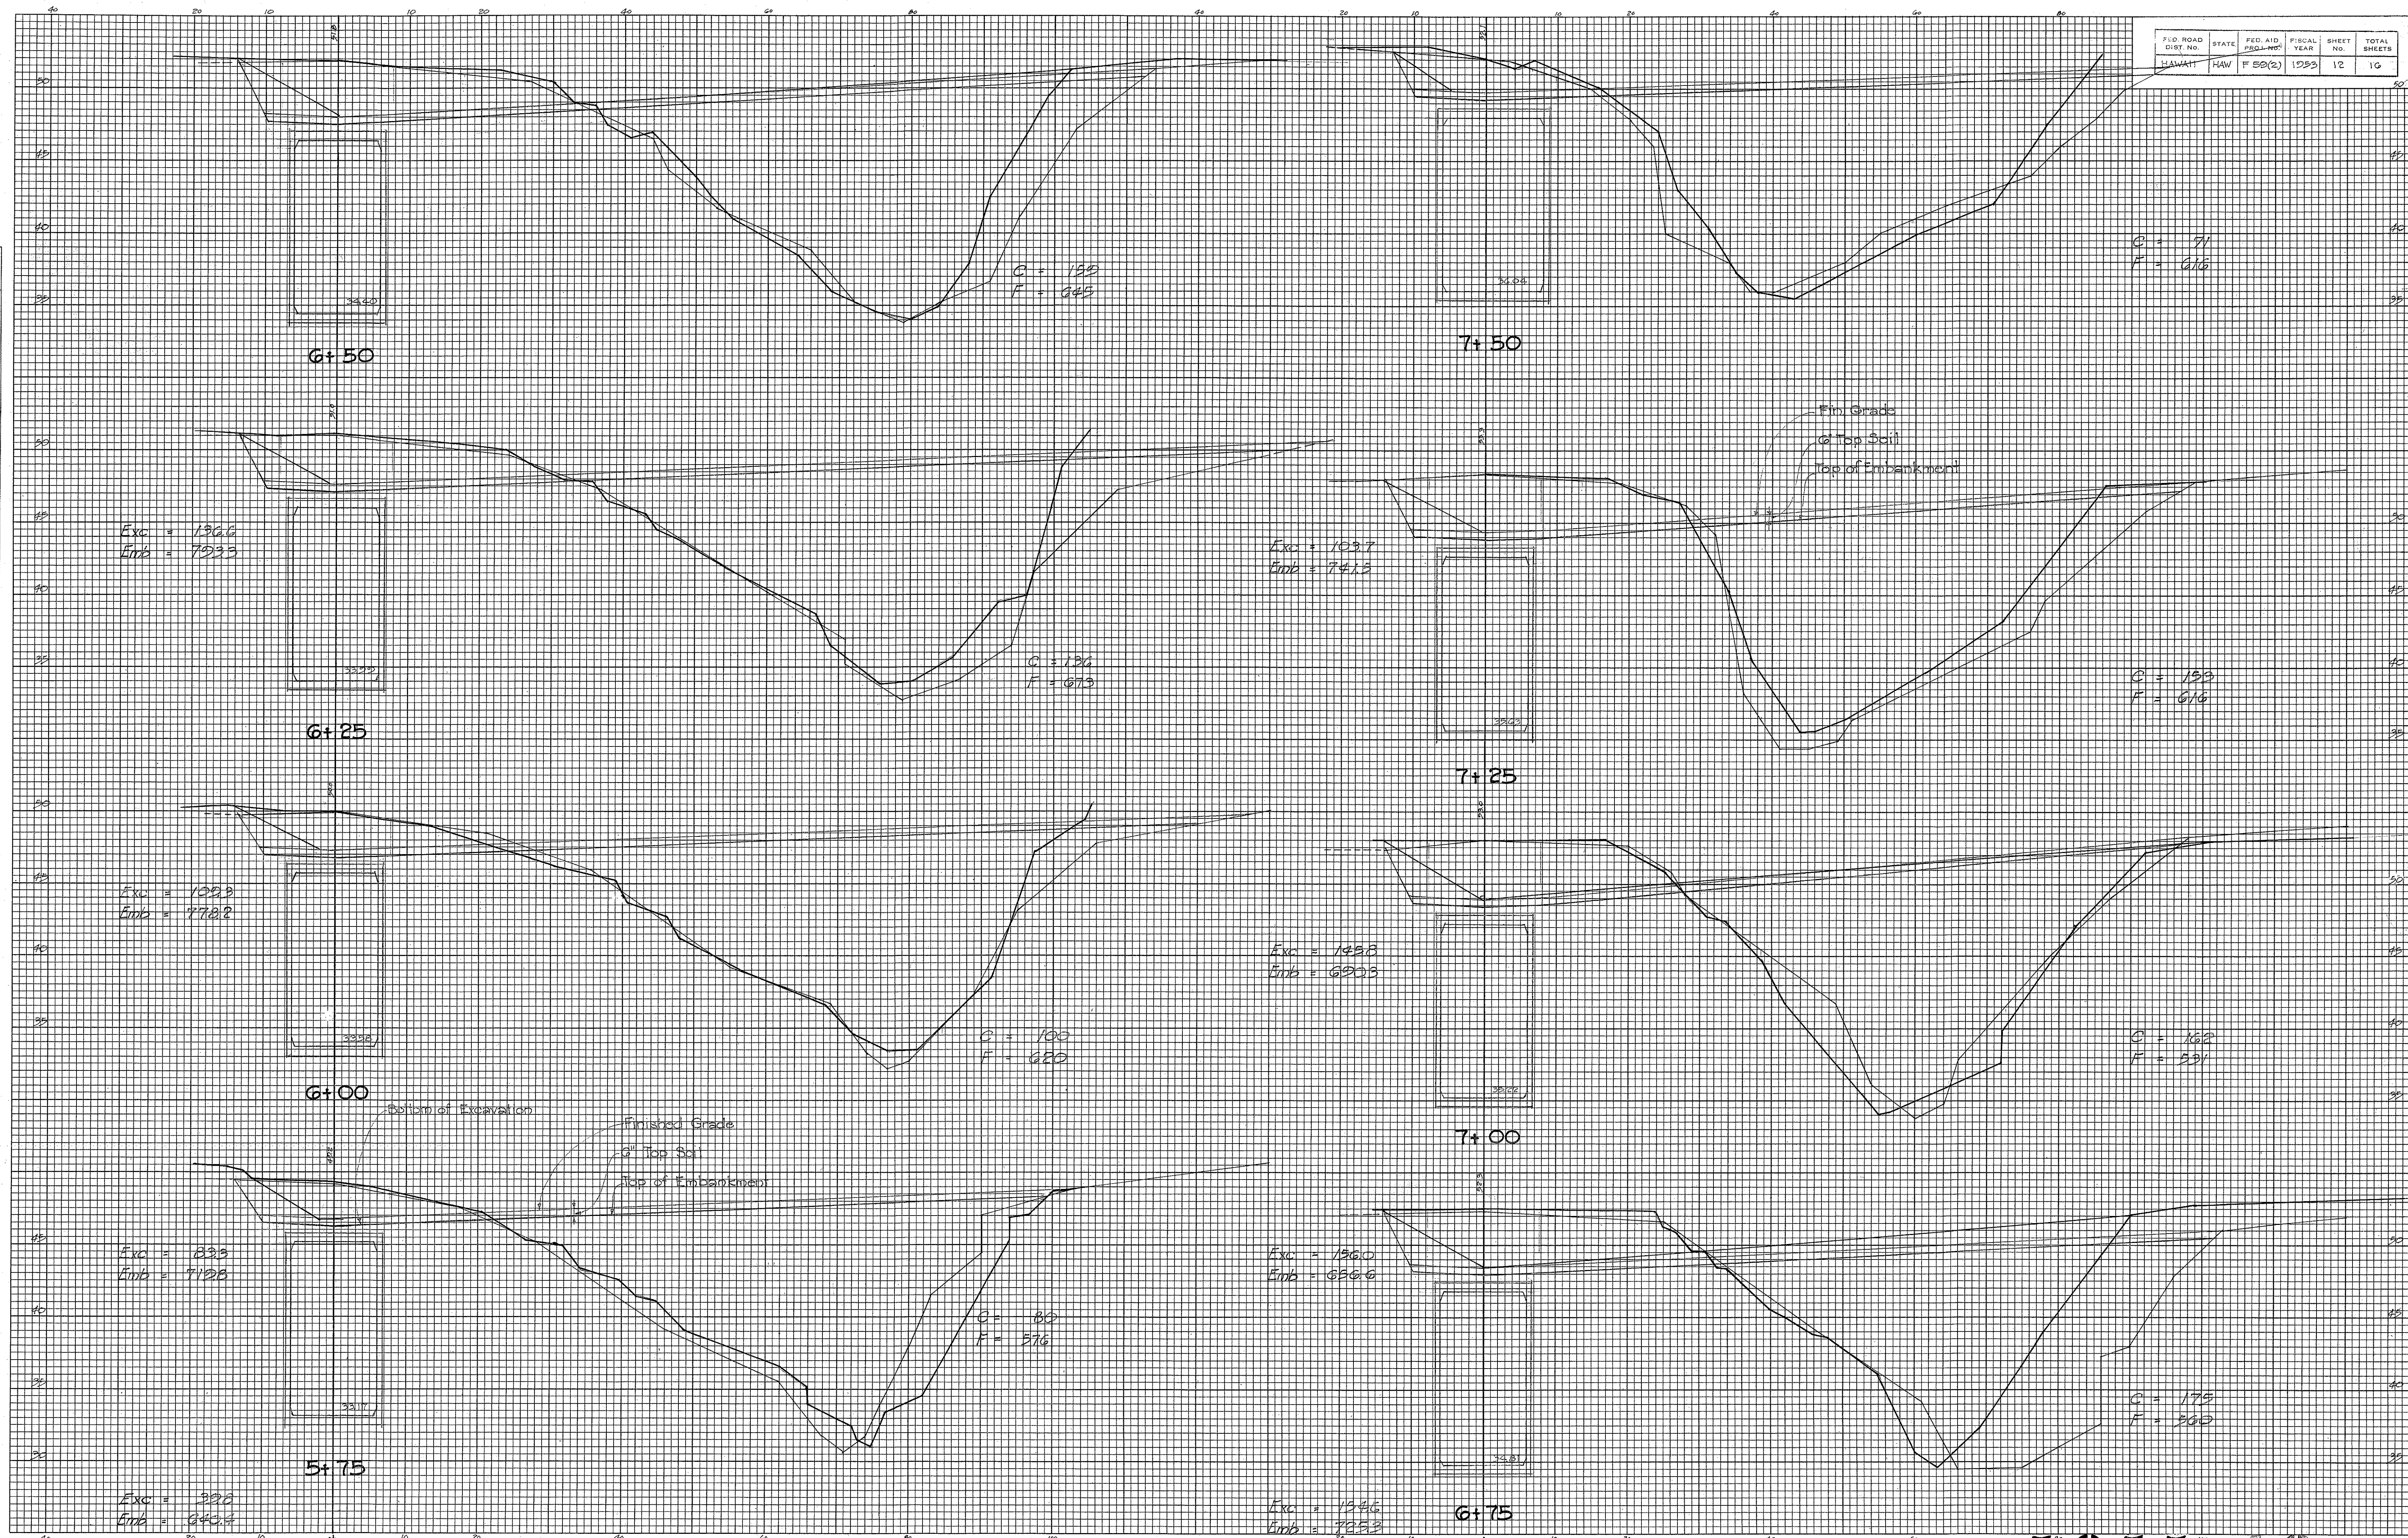

FINAL SURVEY	DATE	BY
	SURVEYED	
	PLOTTED	
	CHECKED	
NO.		

ORIGINAL SURVEY	DATE	BY
	SURVEYED	
	PLOTTED	
	CHECKED	
NO.		

FED. ROAD DIST. NO.	STATE	FED. AID PROJ. NO.	FISCAL YEAR	SHEET NO.	TOTAL SHEETS
HAWAII	HAW	F 50(2)	1953	13	16

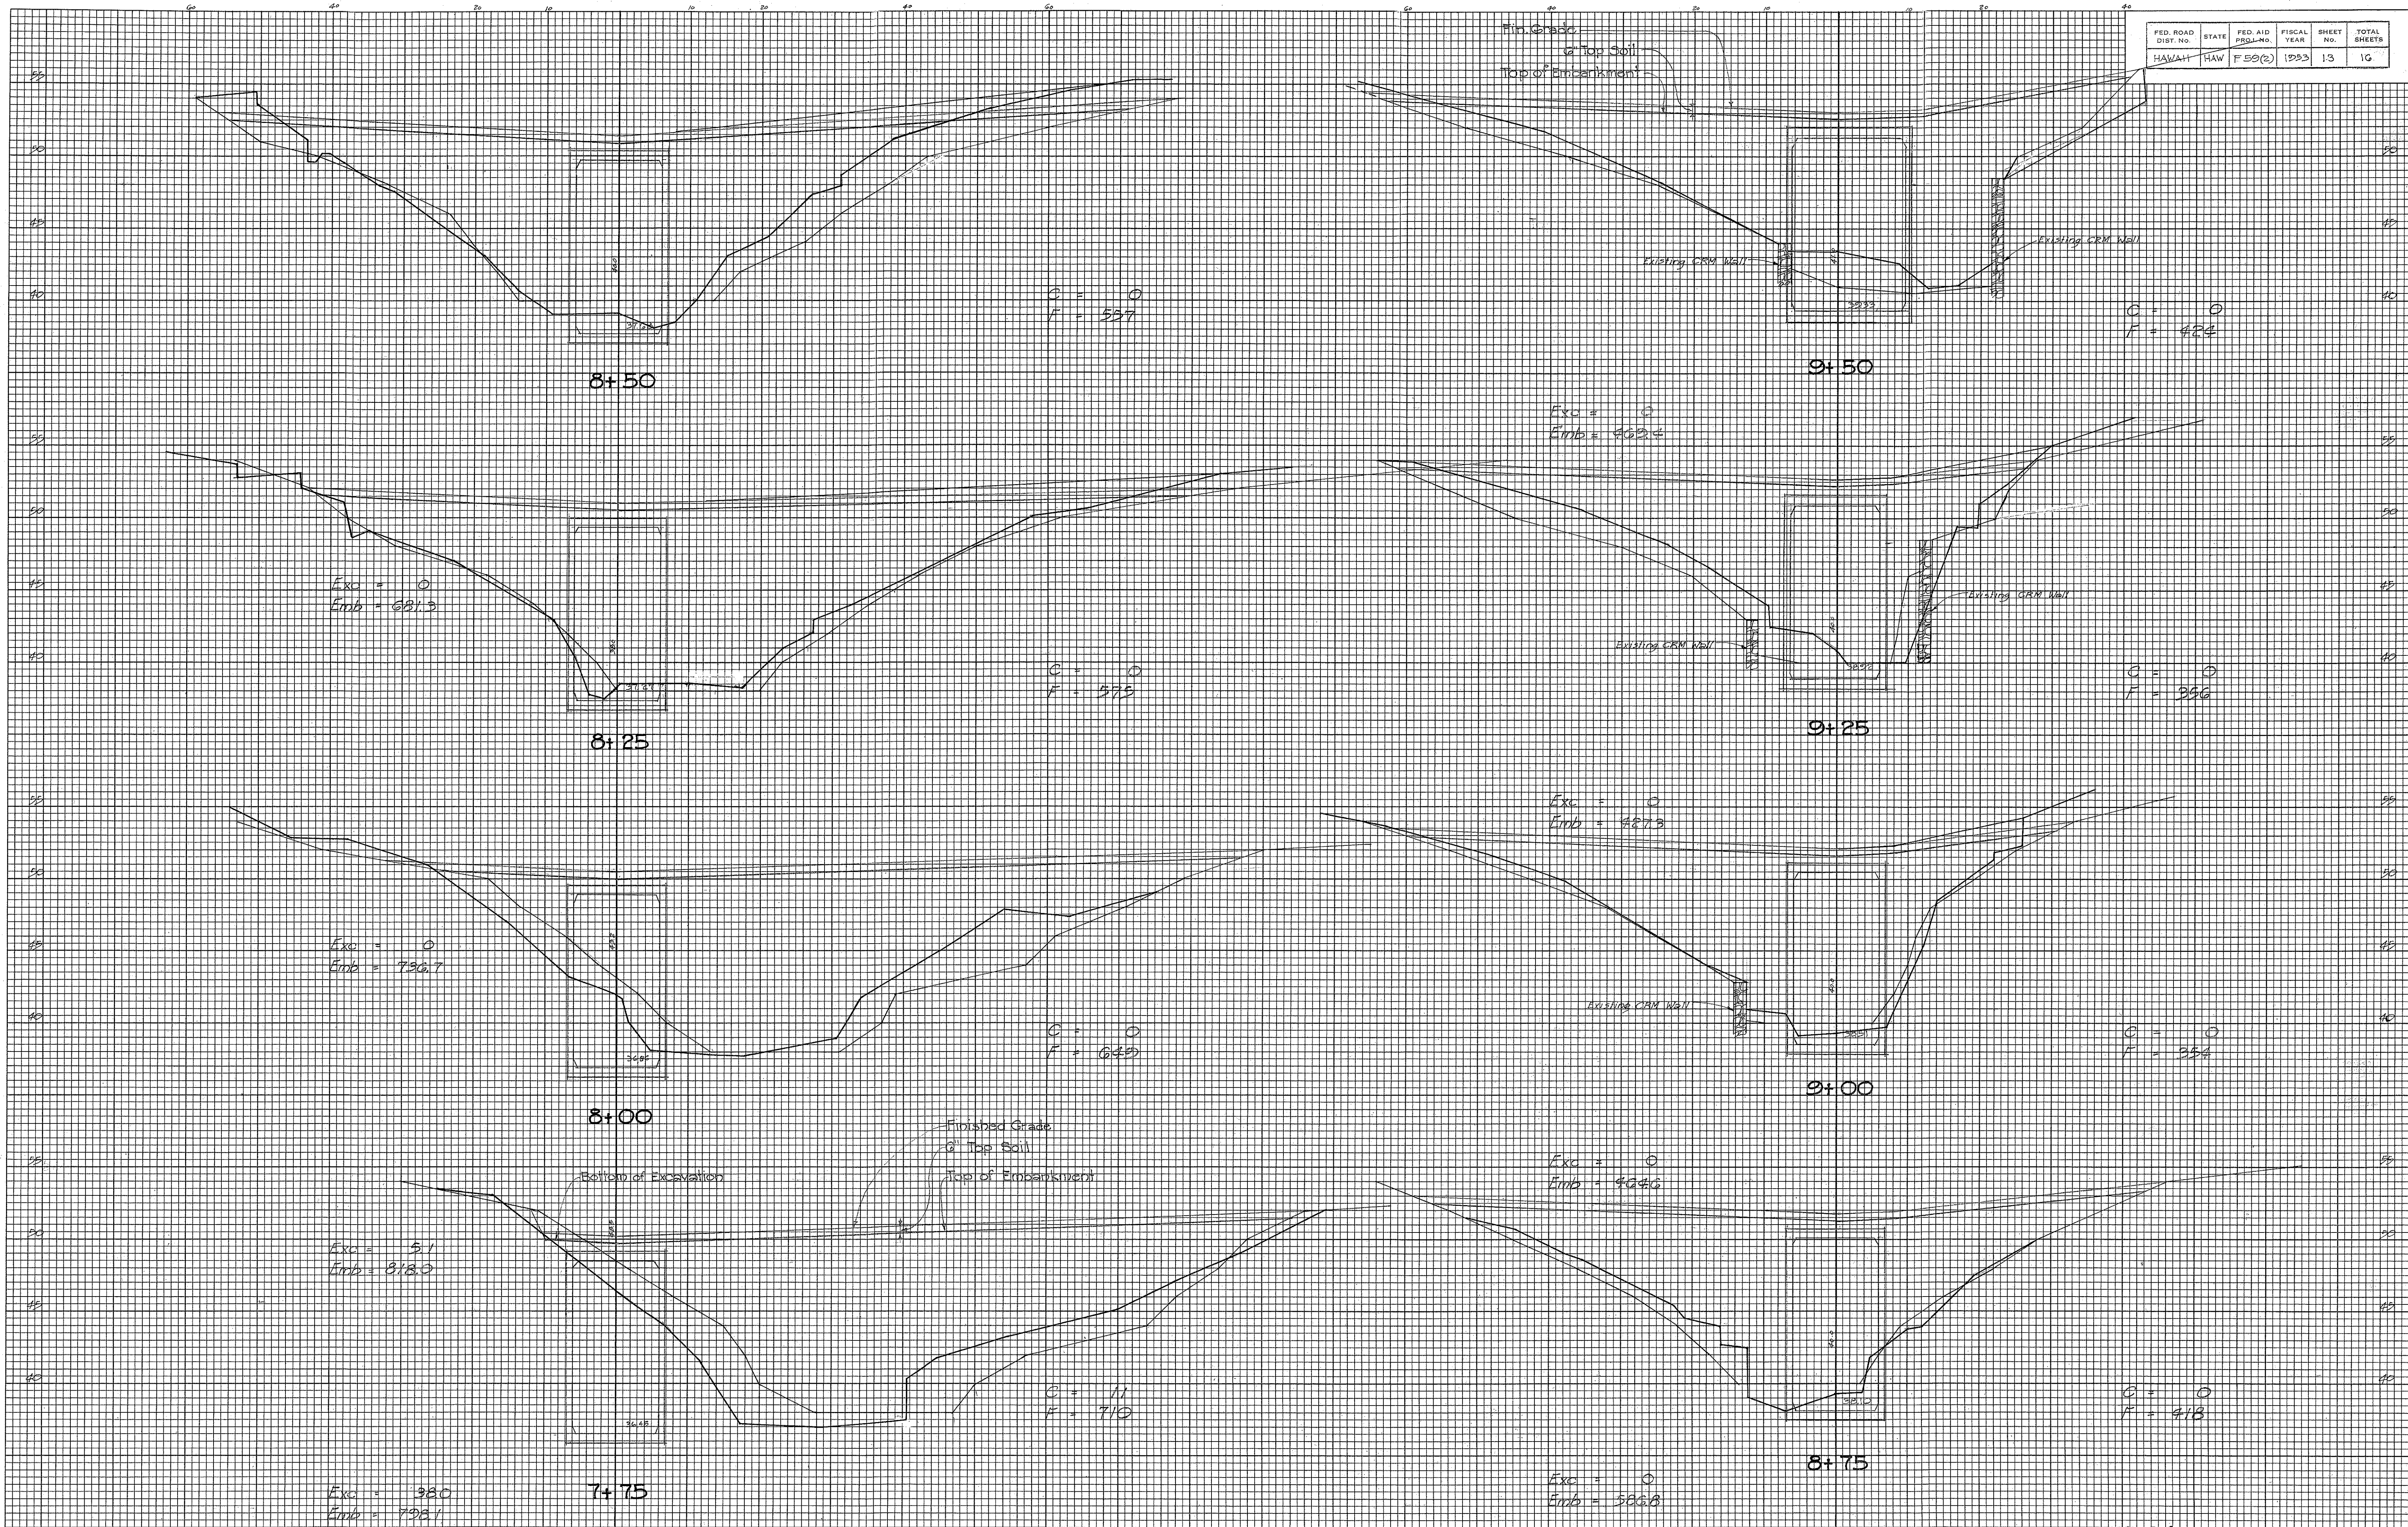

FED. ROAD DIST. NO.	STATE	FED. AID PROJ. NO.	FISCAL YEAR	SHEET NO.	TOTAL SHEETS
HAWAII	HAW	F 59(2)	1953	14	16

FINAL SURVEY	BY _____		DATE _____
NOTE BOOK	SURVEYED _____ PLOTTED _____ TEMPLATE _____ AREAS _____ AREAS CHECKED _____		
NO. _____			

ORIGINAL SURVEY NOTE BOOK NO. _____	SURVEYED _____	BY _____	DATE _____
	PLOTTED _____		
	TEMPLATE _____		
	AREAS _____		
	AREAS CHECKED _____		

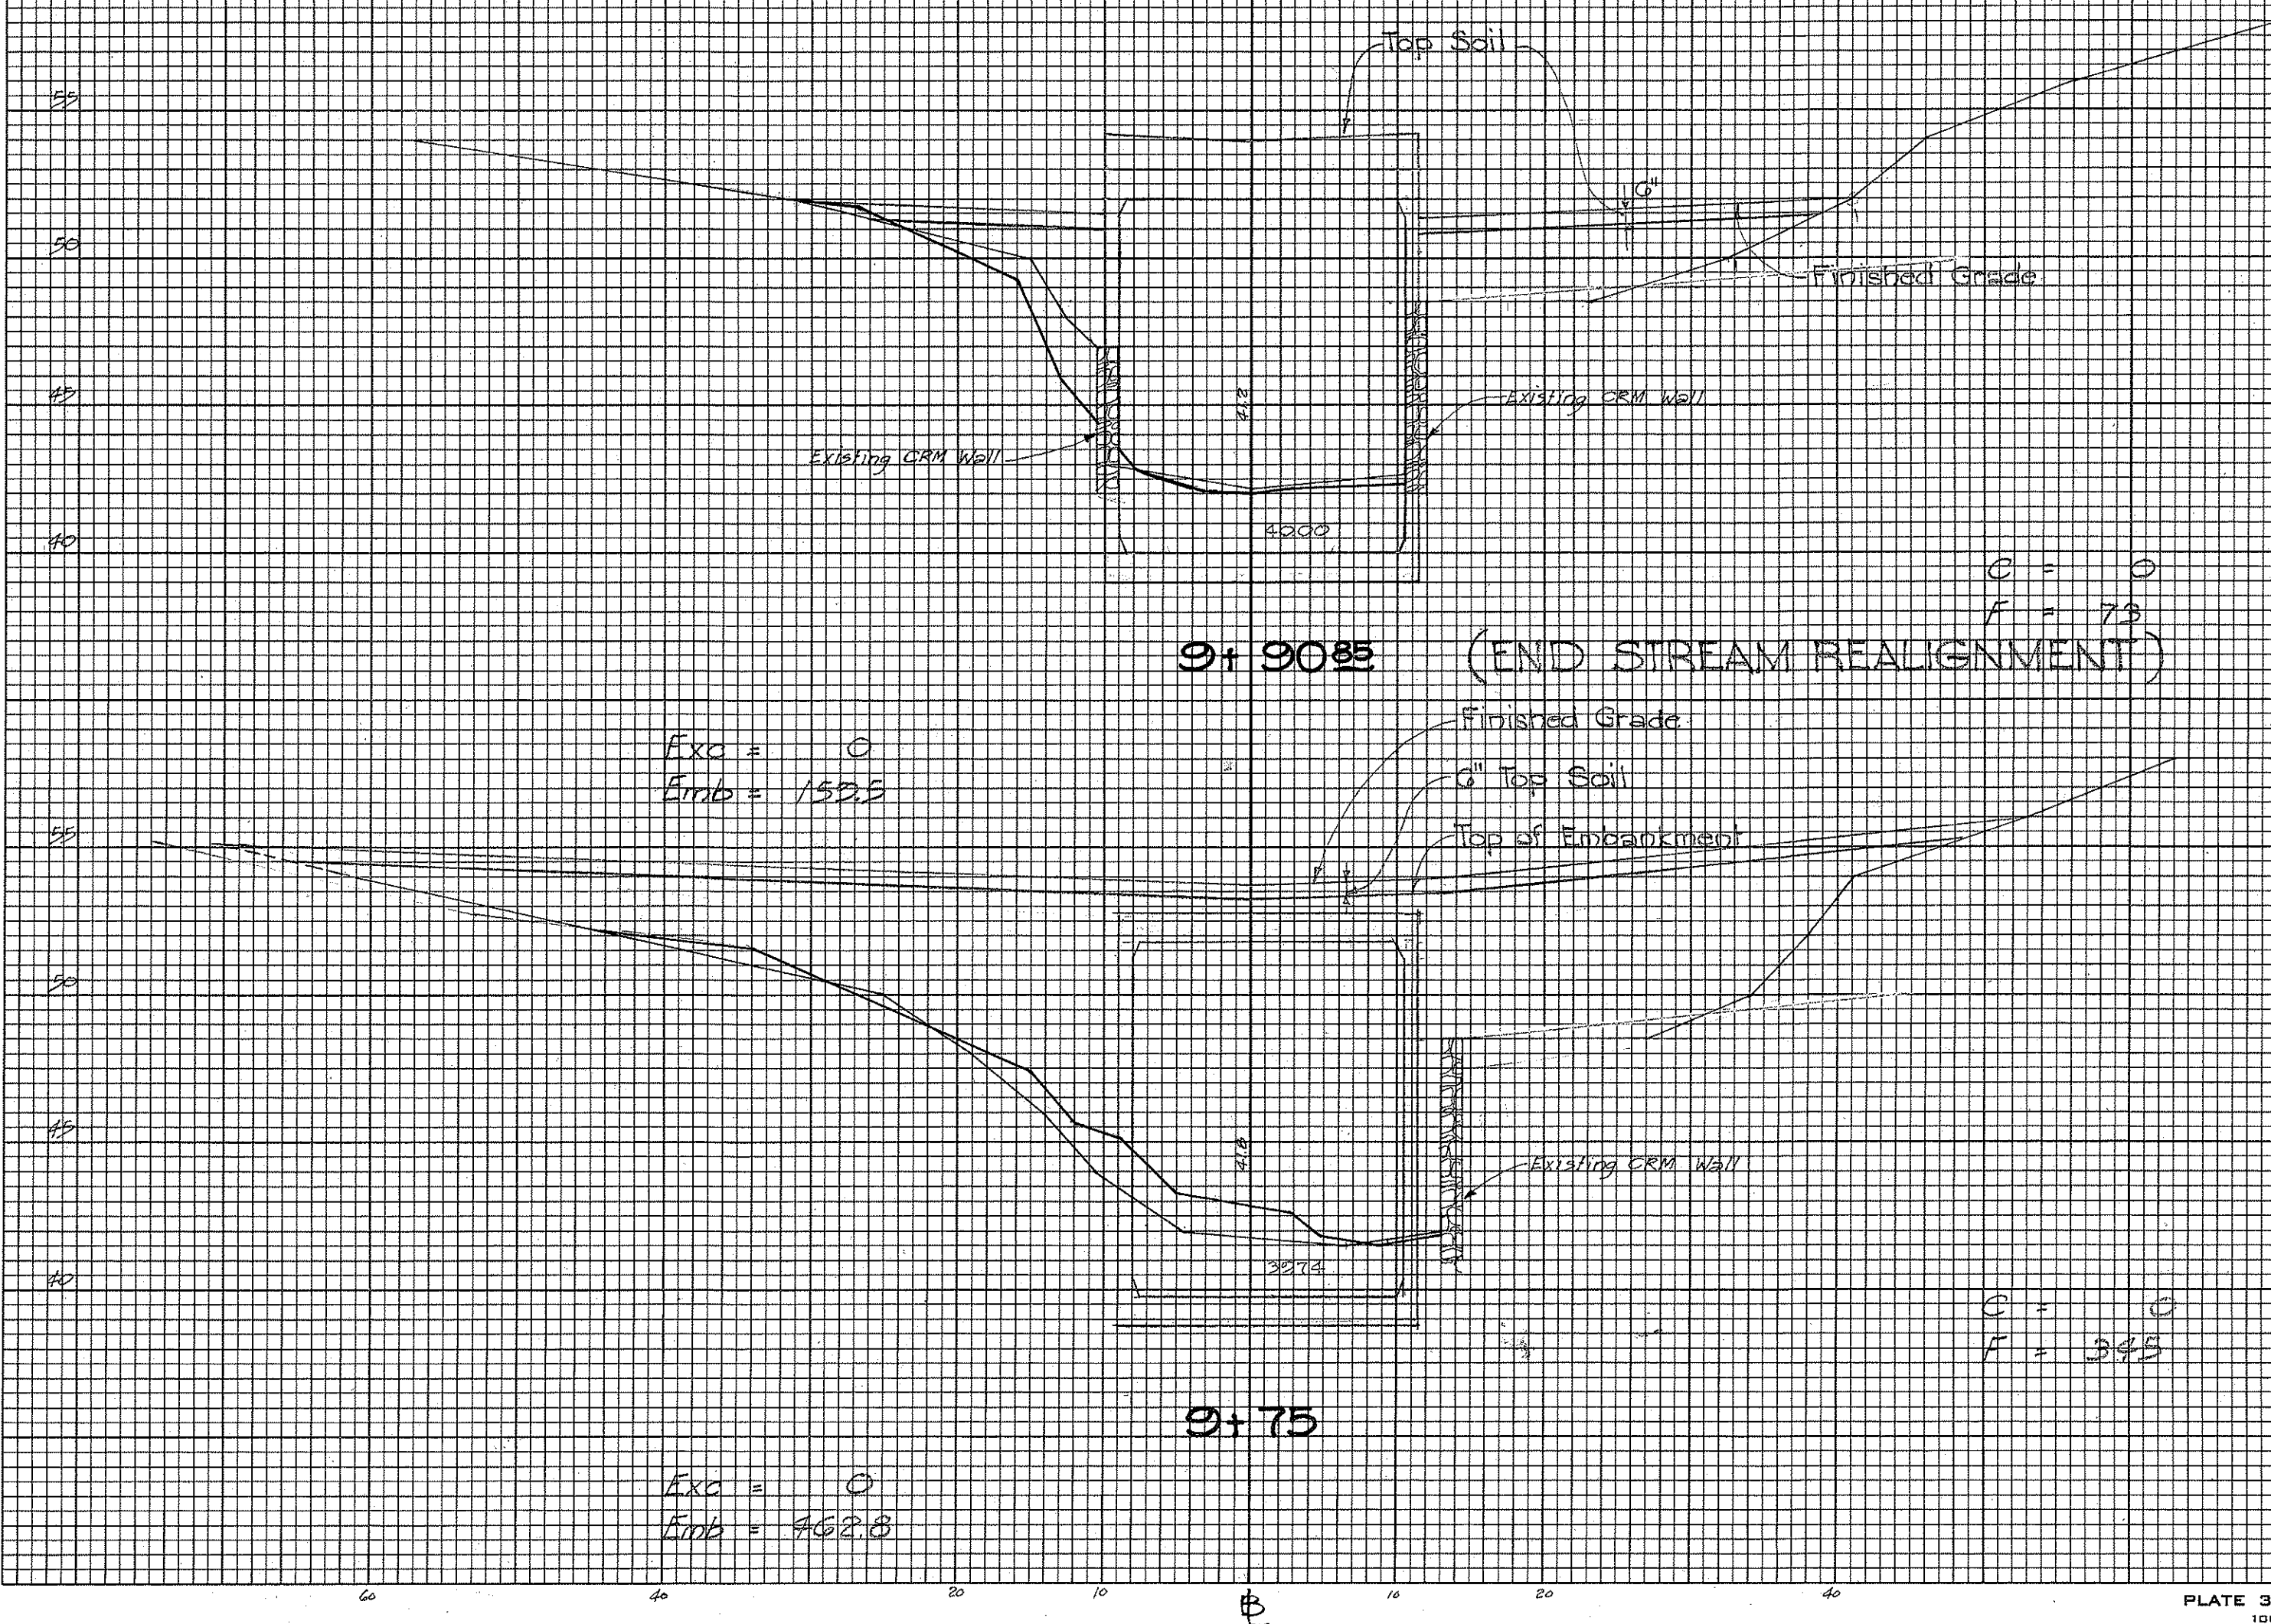


PLATE 3 CROSS SECTION O. P. R. & R. E. STANDARD
100% RAG PAPER—MADE AND PRINTED IN U. S. A.
EUGENE DIETZGEN CO.

5655.14