


PLAN	DATE	BY
SURVEYED		
PLOTTED		
CHECKED		
NO.		

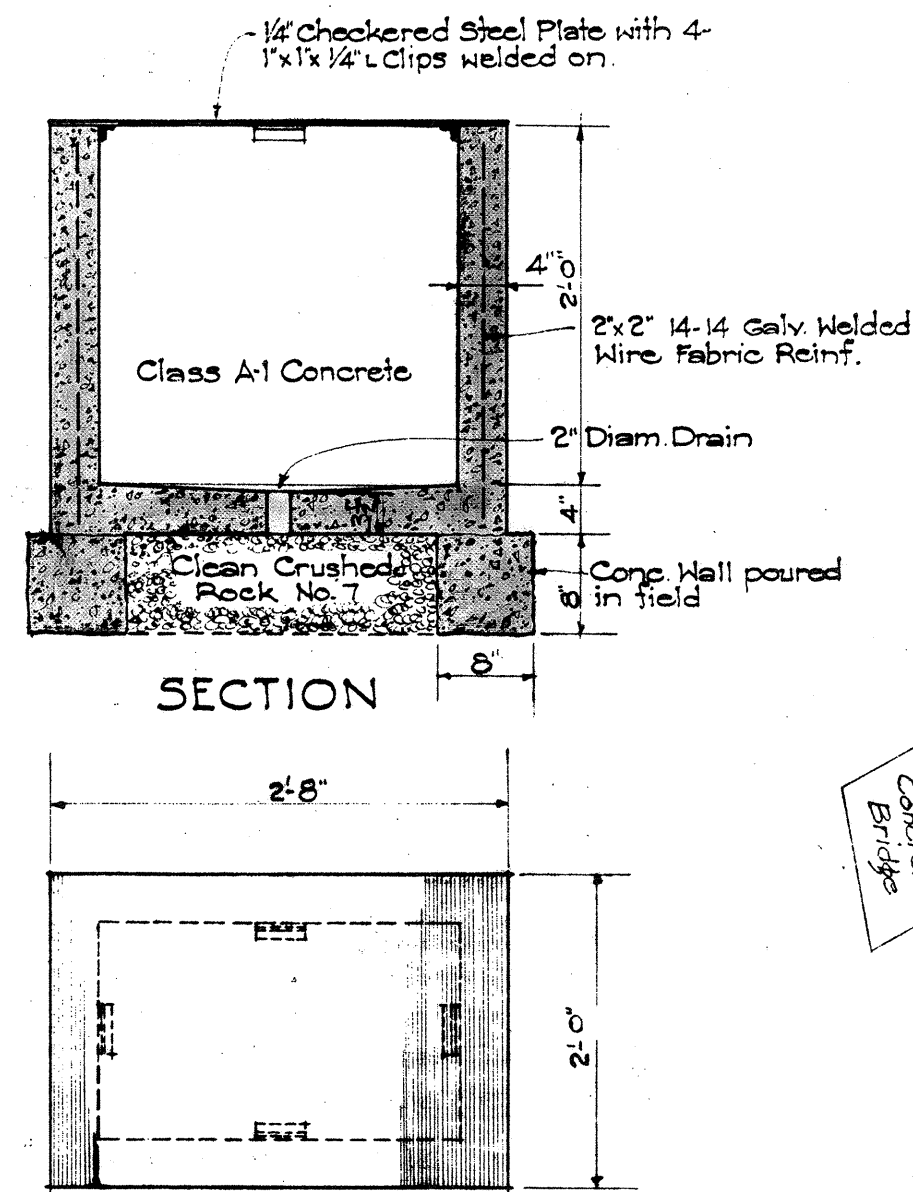


PLAN
DETAIL OF PULL BOX
Not to Scale

NOTE:
Back-fill at structure shall be made simultaneously and evenly on both sides so as to avoid one-sided pressures.
During construction, no equipment heavier than the equivalent of a 5-ton truck shall be imposed on the covered canal section from Sta 0+634.4 - Sta 4+391.2 and Sta 5+564.7 - Sta 5+208.3.
Various Stations designated for Contraction and Expansion Joints are Base Line Stations at the Invert of the Canal.

NOTE:
All Elevations shown are referred to C.C. St. survey Monument (Elev 45.76) at the intersection of Punahou and Bingham Streets.

PROJ. NO F 59 (2)

PROJ. NO F 59 (2)

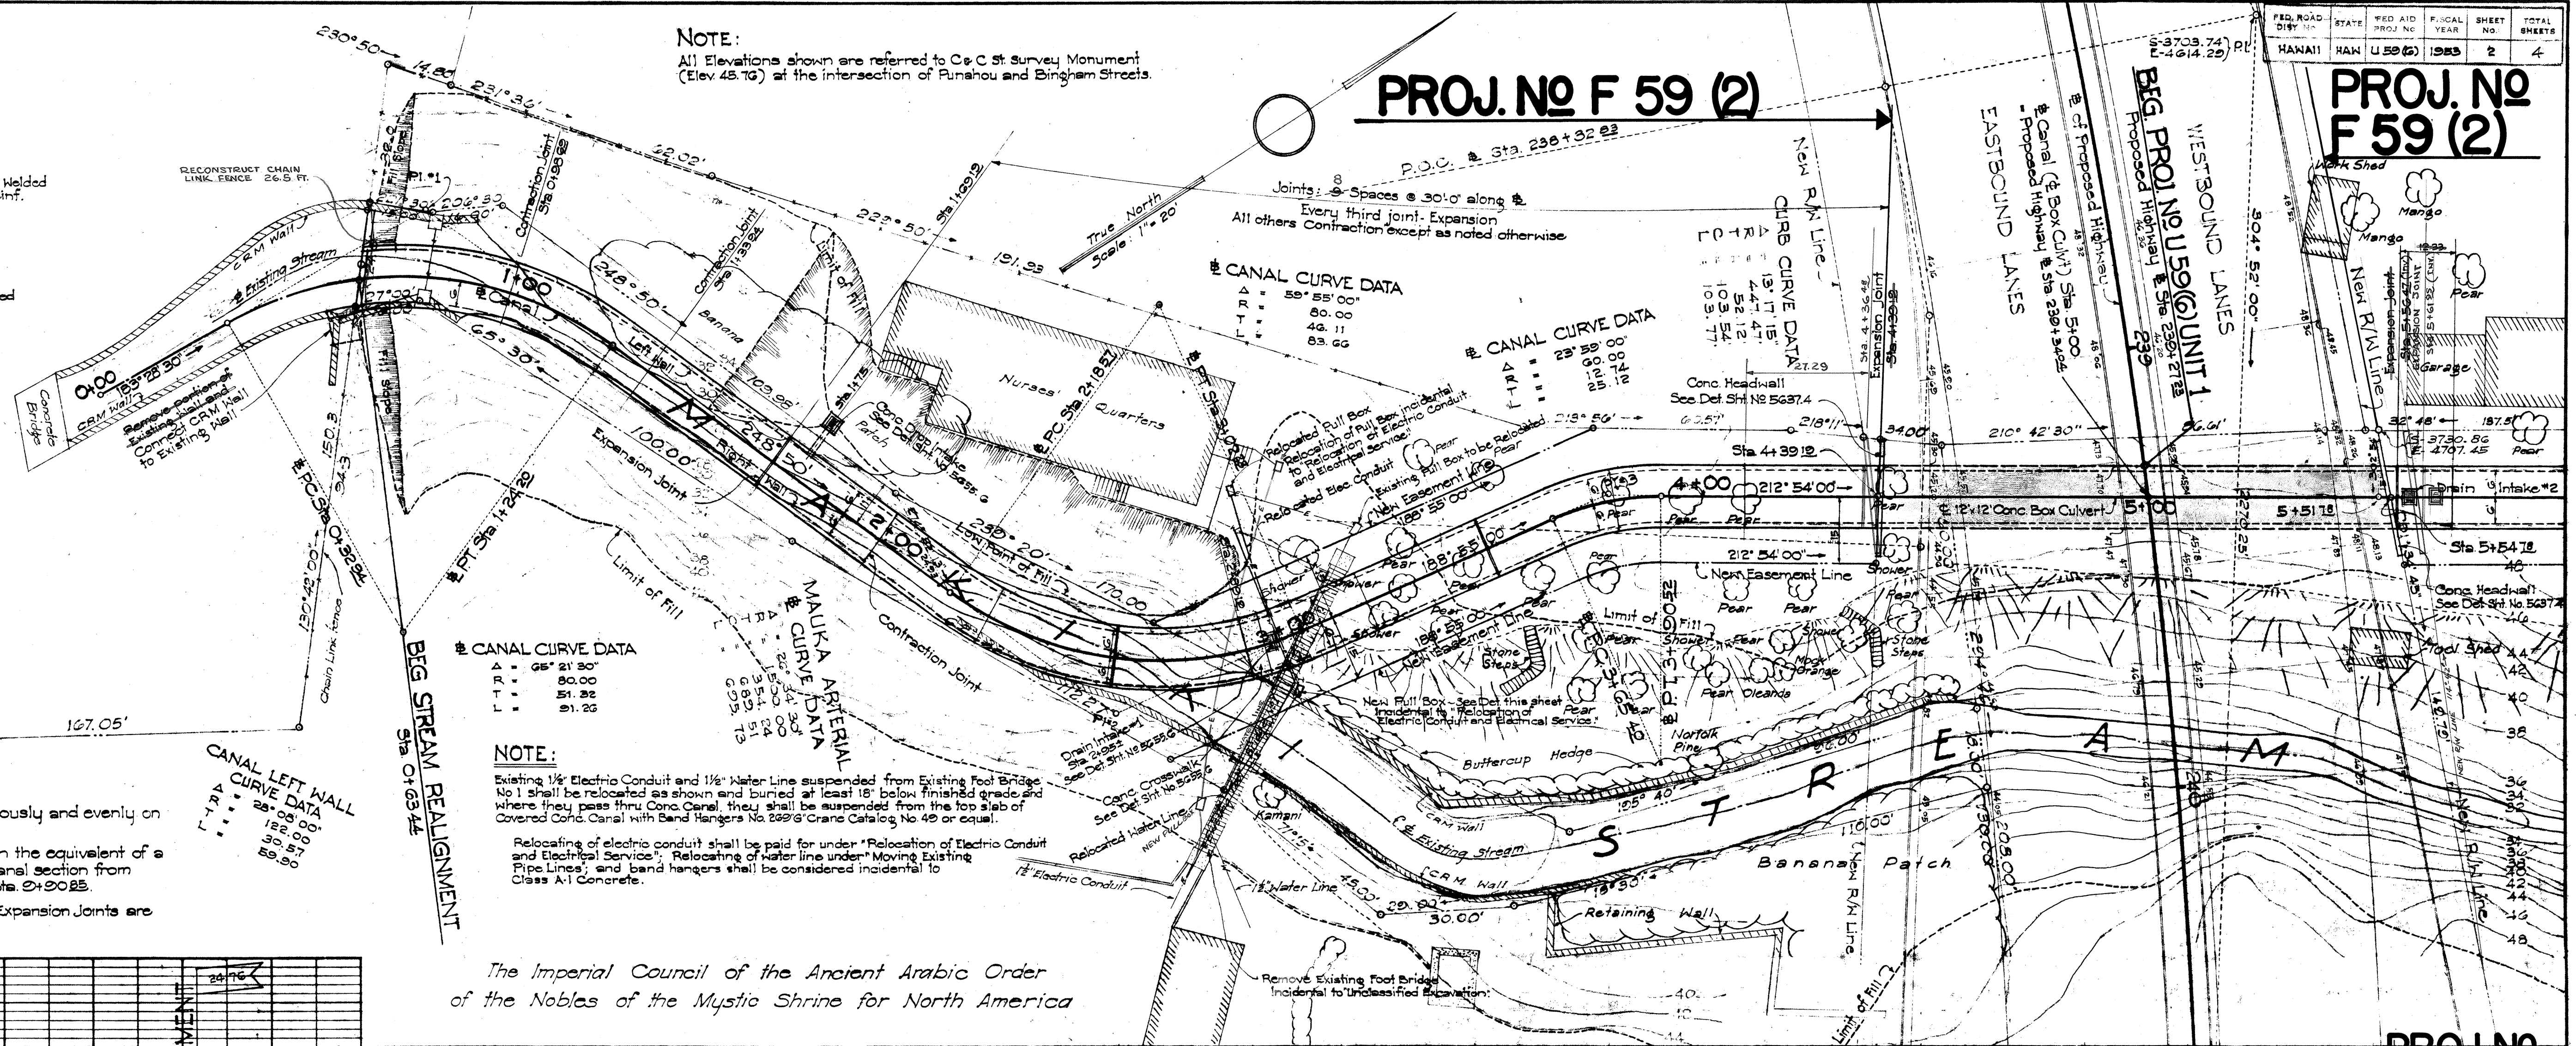

The Imperial Council of the Ancient Arabic Order
of the Nobles of the Mystic Shrine for North America

PROFILE	DATE	BY
SURVEYED		
PLOTTED		
CHECKED		
NO.		

