


FED. ROAD DIST. NO.	STATE	FED. AID PROJ. NO.	FISCAL YEAR	SHEET NO.	TOTAL SHEETS
HAWAII	HAW	U 59(3)	1954	11	25

Unit 2


DATE	BY	NO.
FINAL SURVEY	SURVEYED	PLANNED
NOTE BOOK	AREA'S	AREAS CHECKED

DATE	BY	NO.
ORIGINAL SURVEY	SURVEYED	PLANNED
NOTE BOOK	AREA'S	AREAS CHECKED

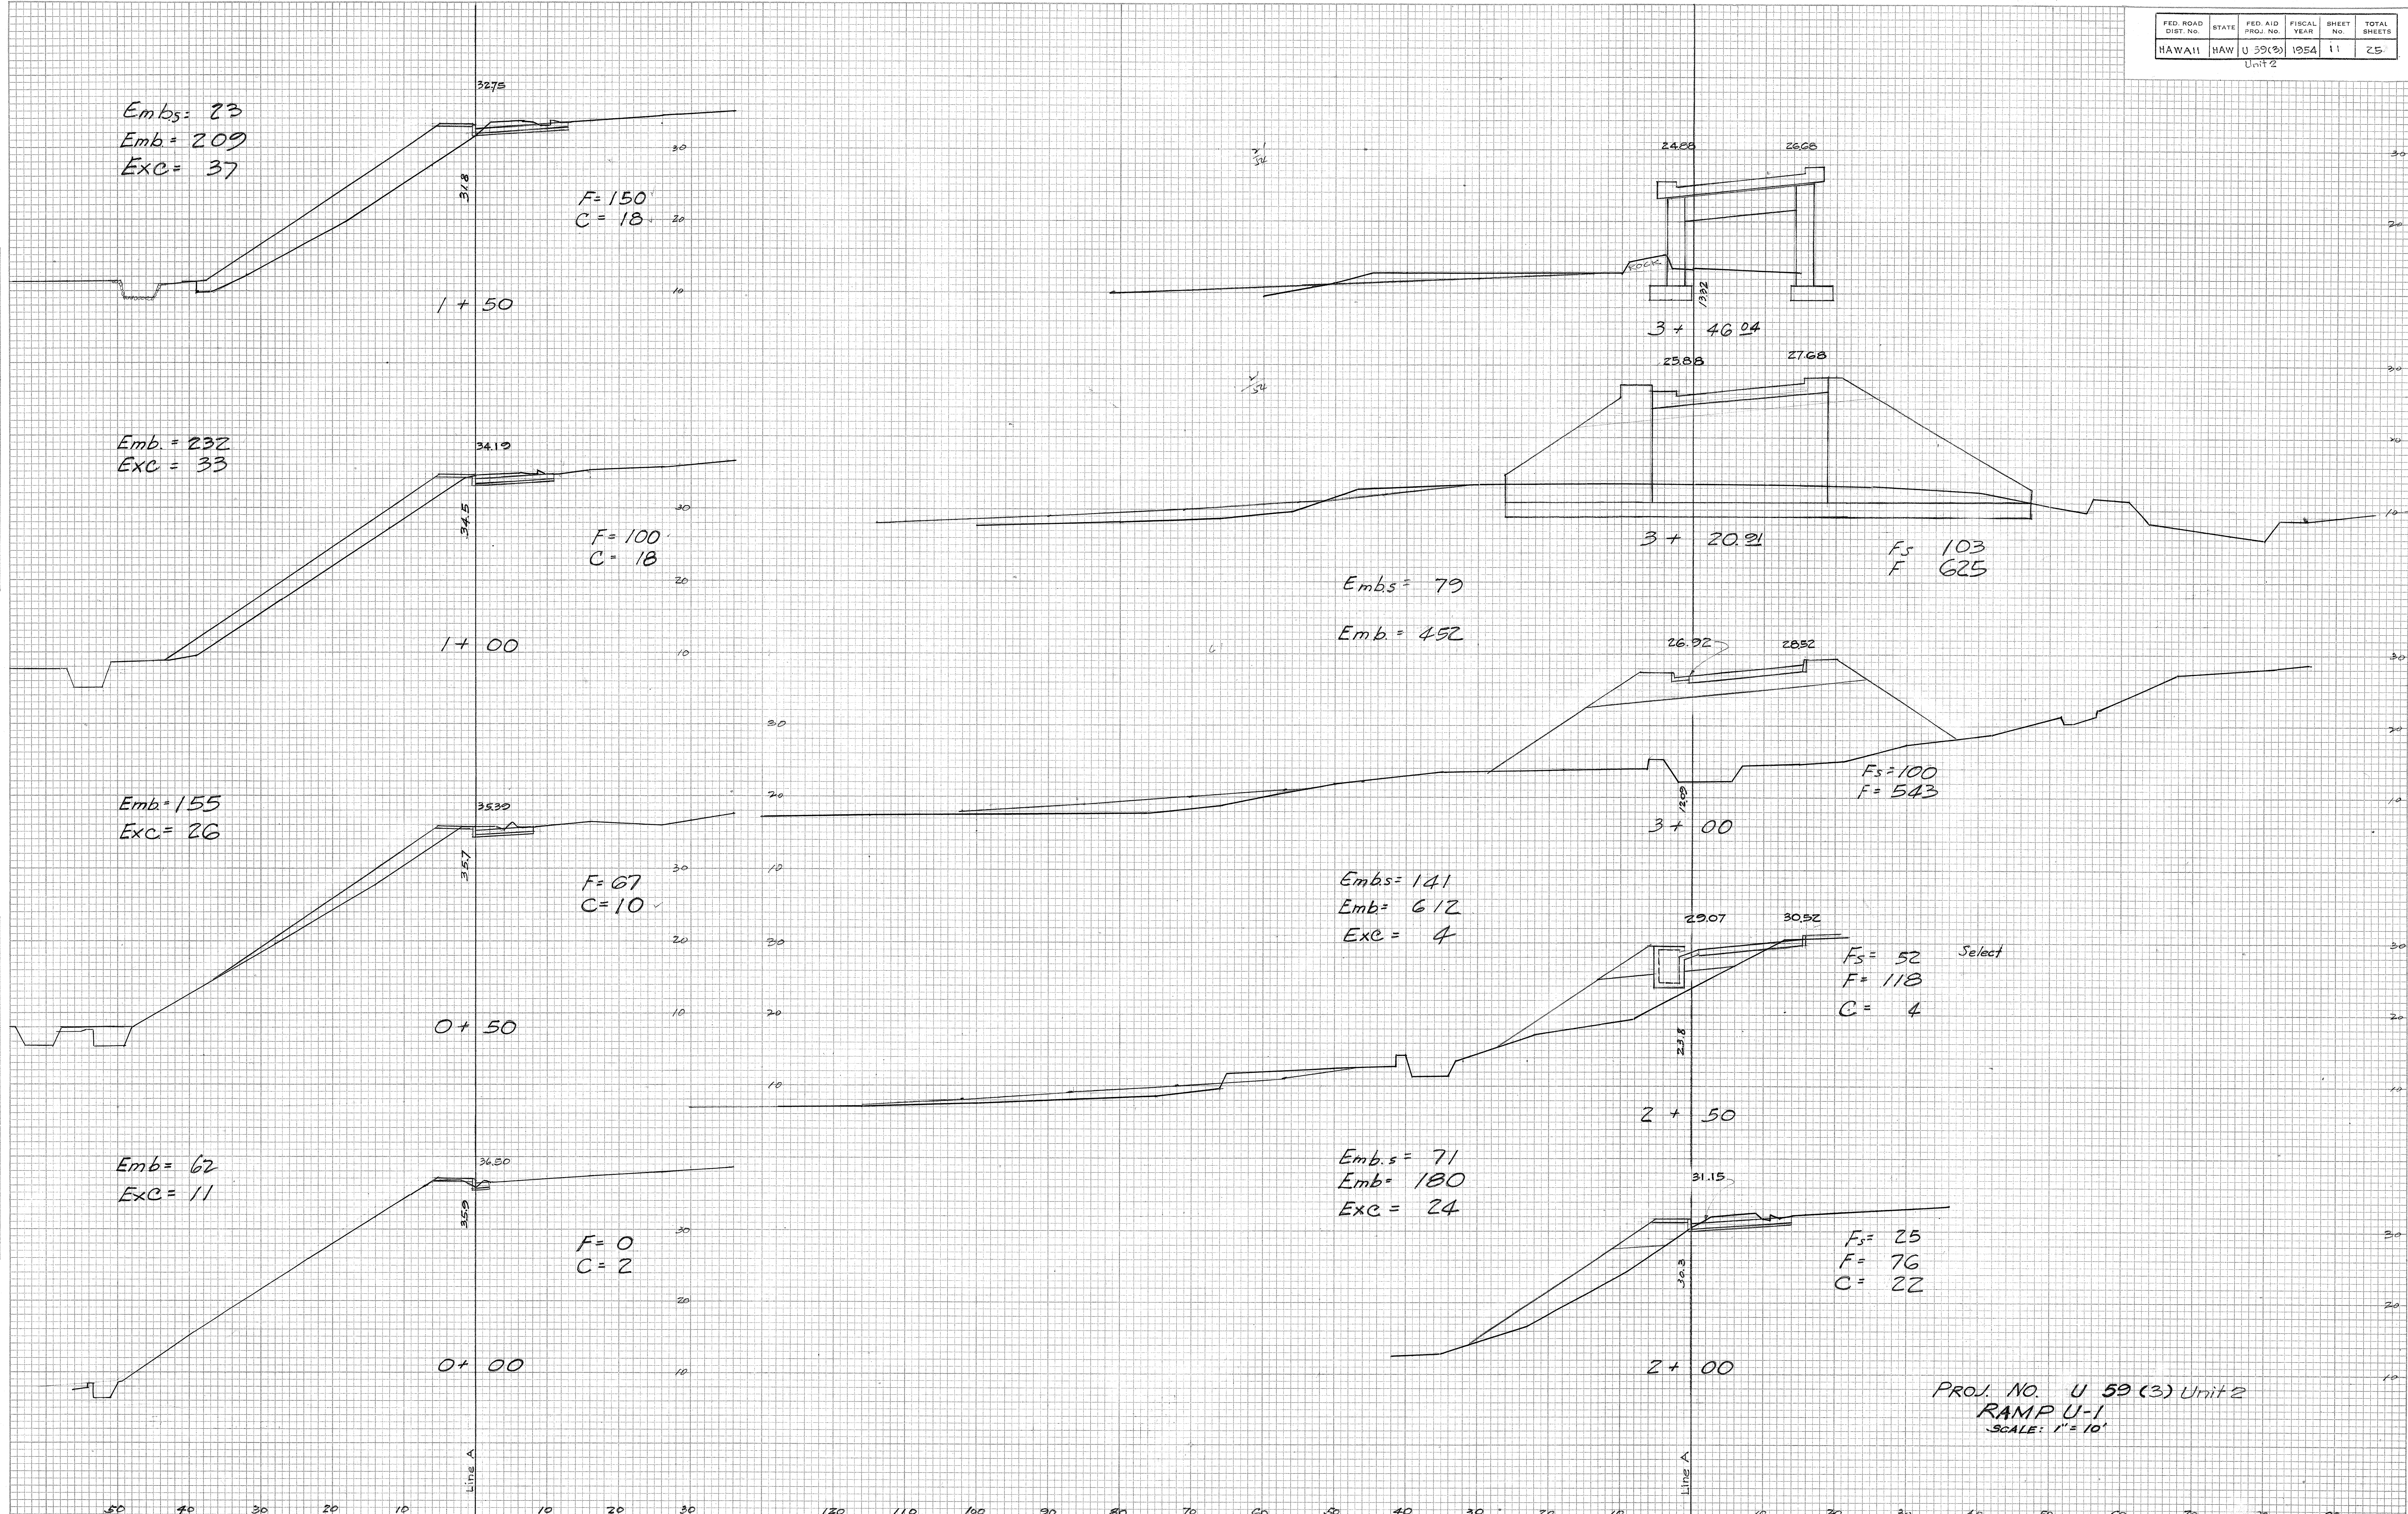

PROJ. NO. U 59(3) Unit 2
RAMP U-1
SCALE: 1" = 10'

ORIGINAL SURVEY	SURVEYED PLOTTED TEMPLATE AREAS	BY	DATE
NOTE BOOK			
NO.	AREAS CHECKED		

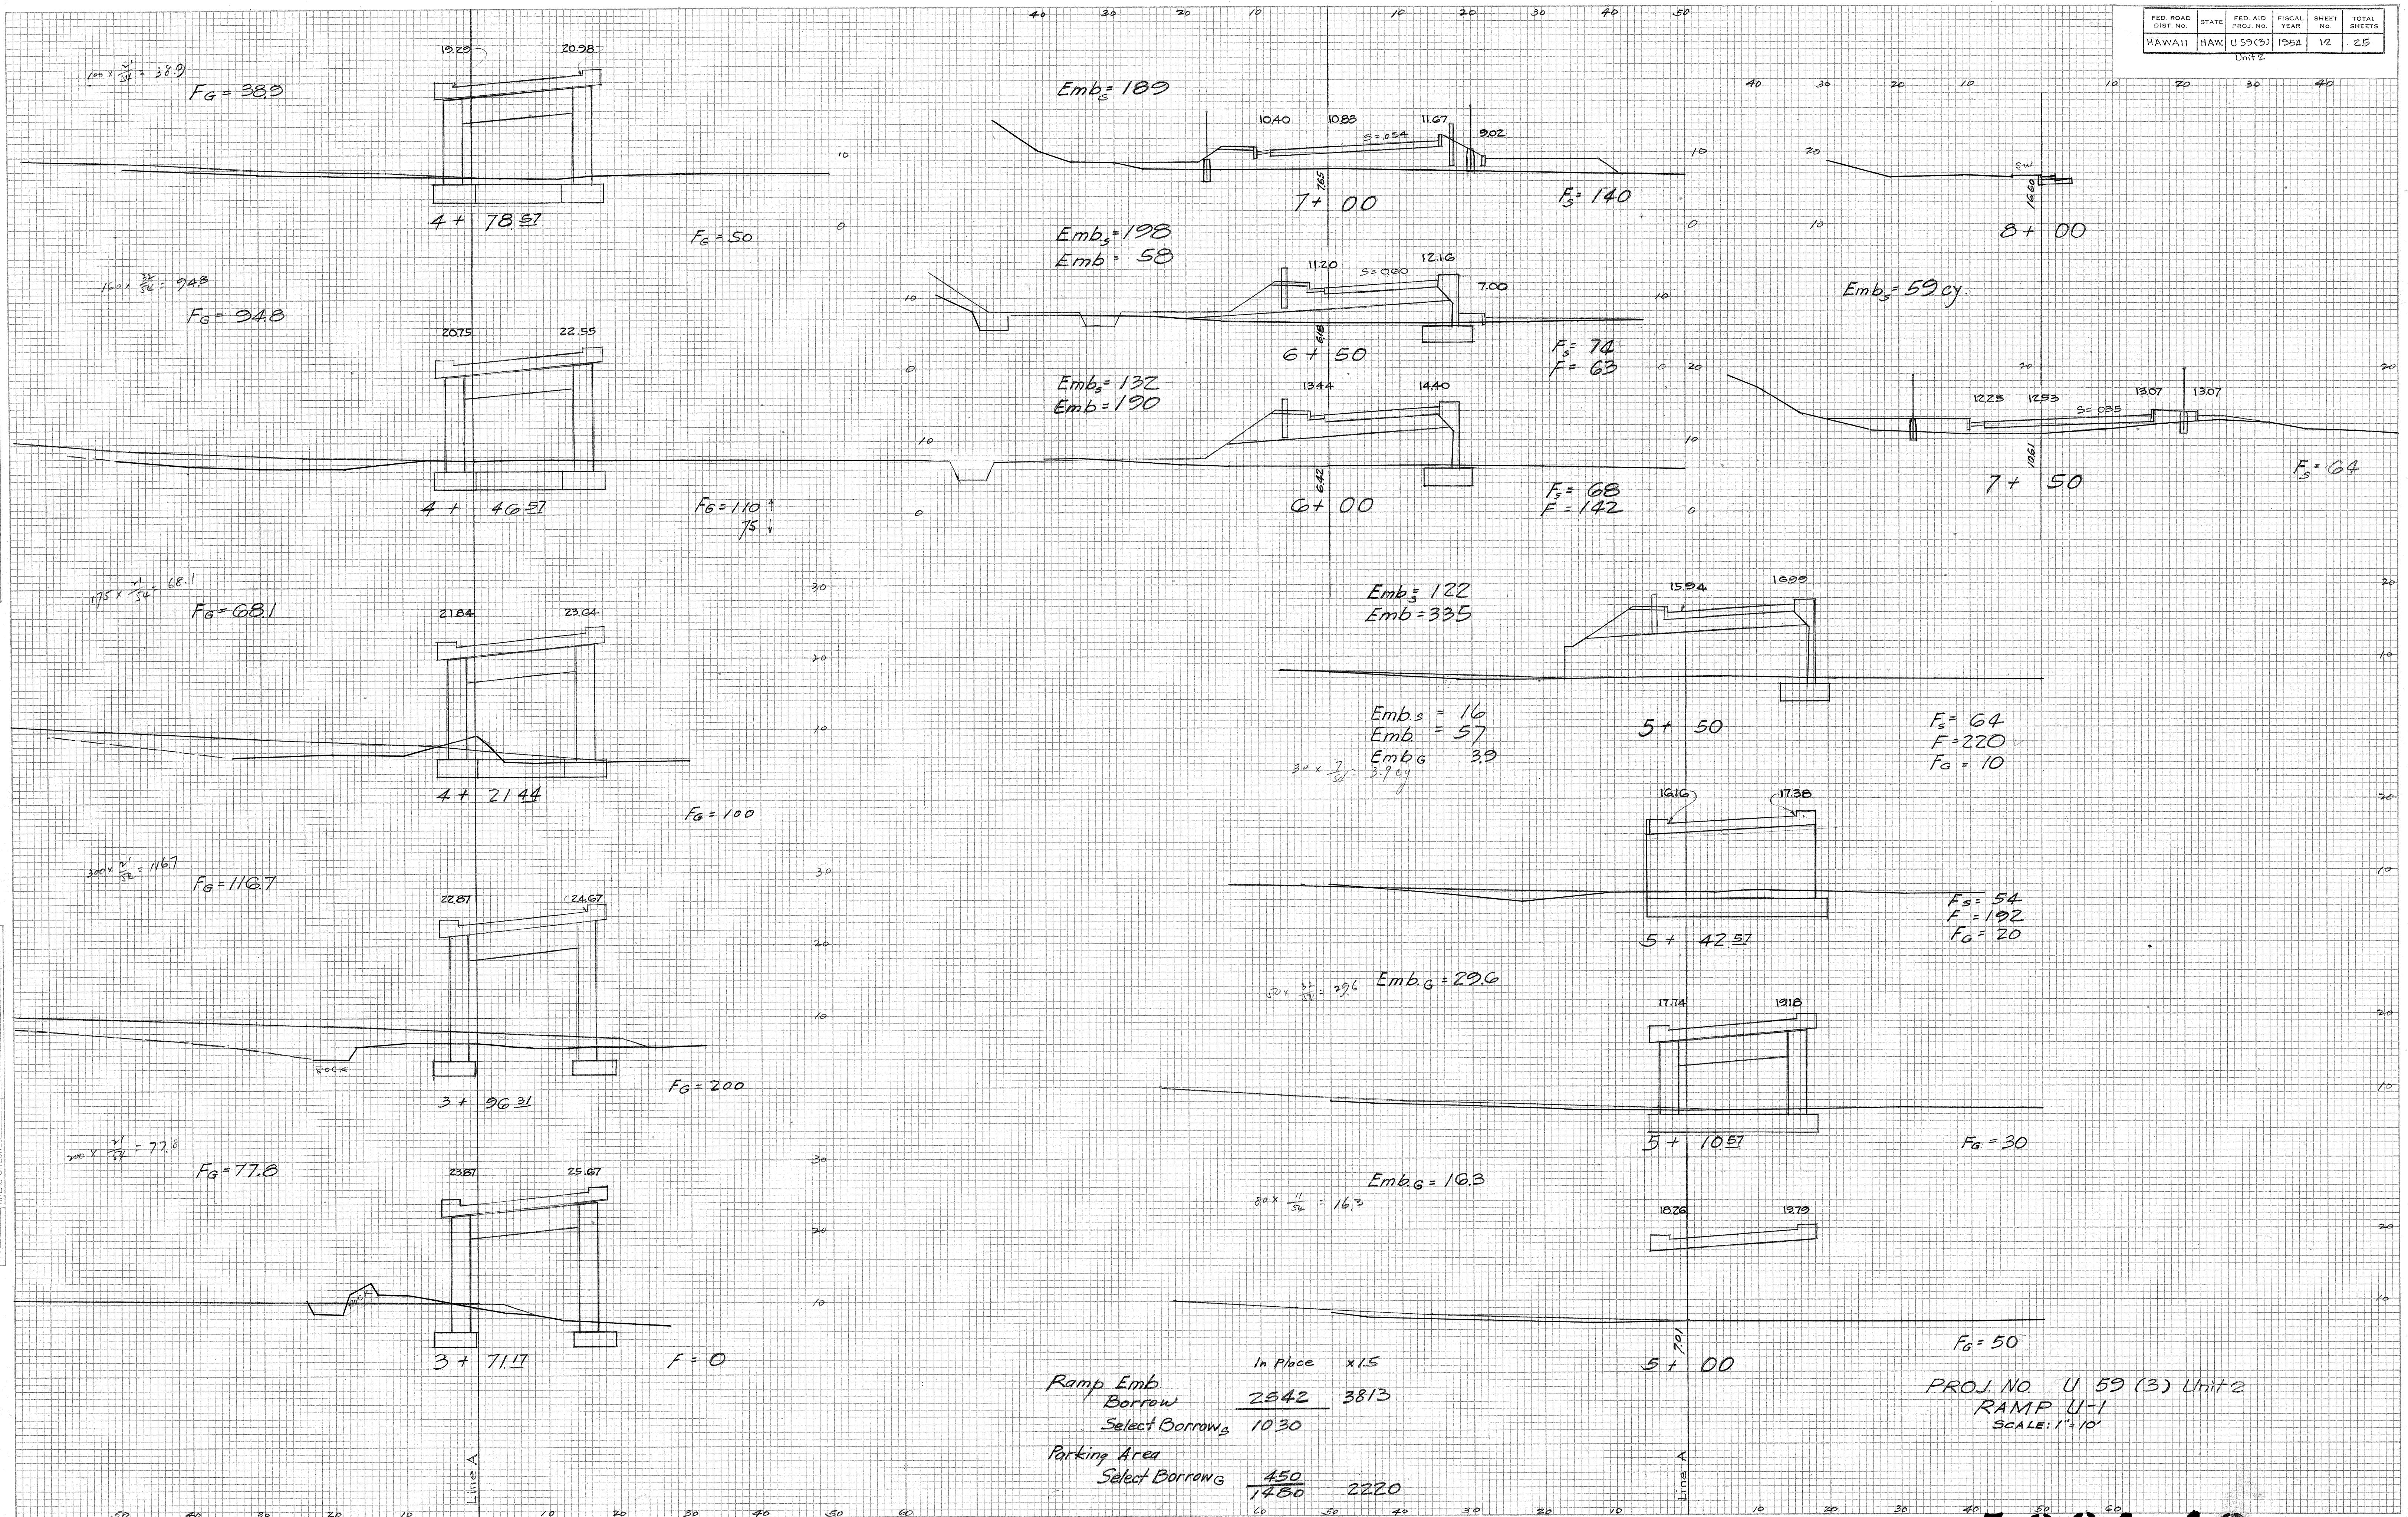

PROJ. NO. U 59 (3) Unit 2
RAMP U-1
SCALE: 1" = 10'

40 50 60
5 6 8 1.1 2