
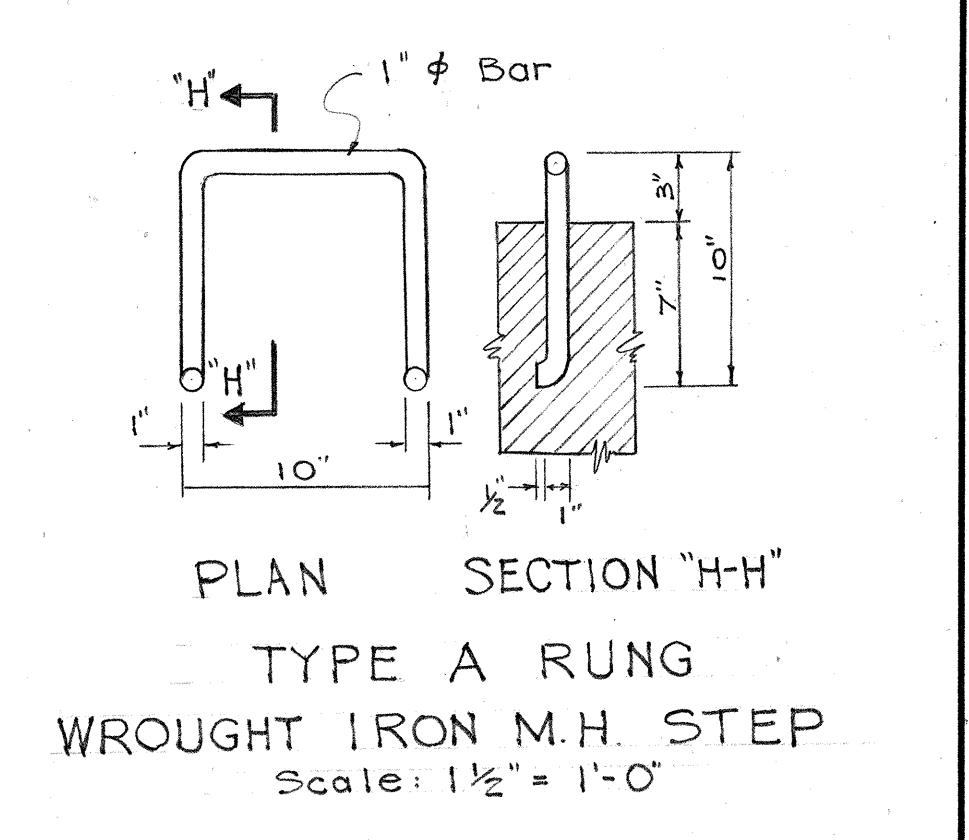
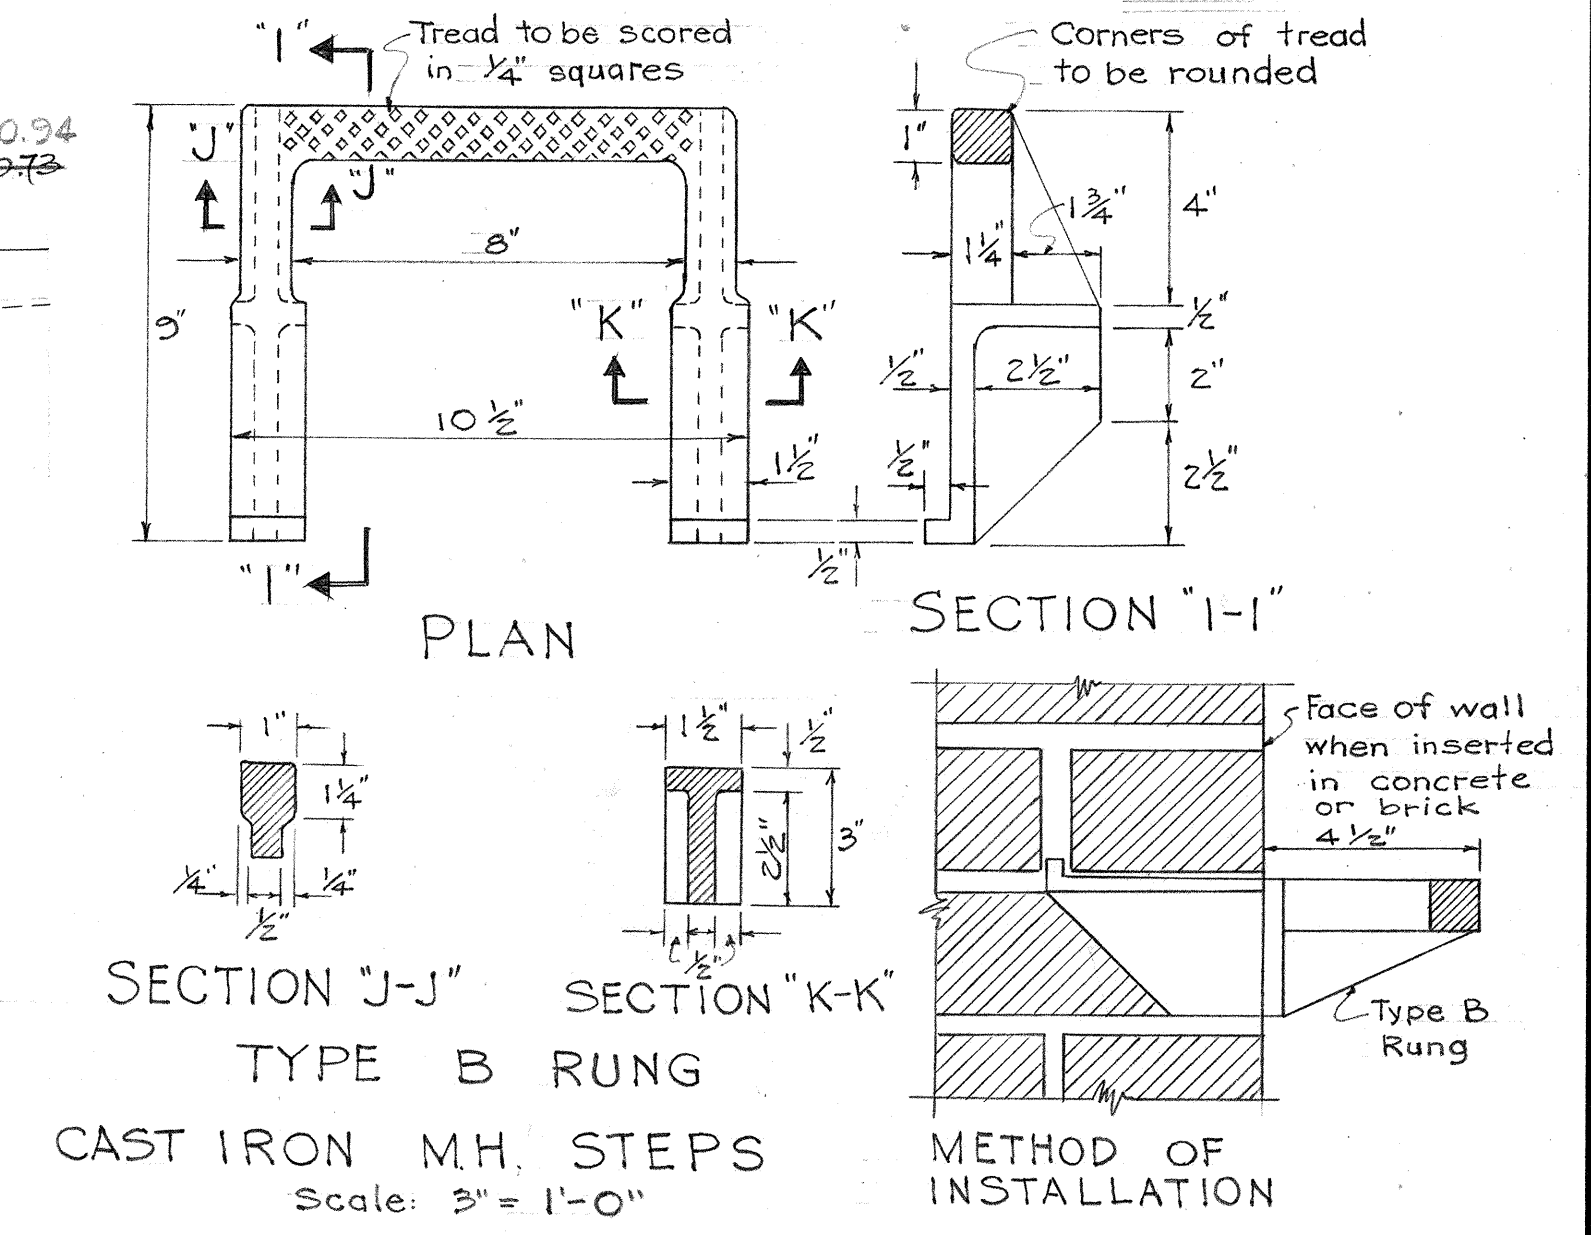


FED. ROAD DIST. NO.	STATE	FED. AID PROJ. NO.	FISCAL YEAR	SHEET NO.	TOTAL SHEETS
HAWAII	HAW	U 59(3)	1954	9	25

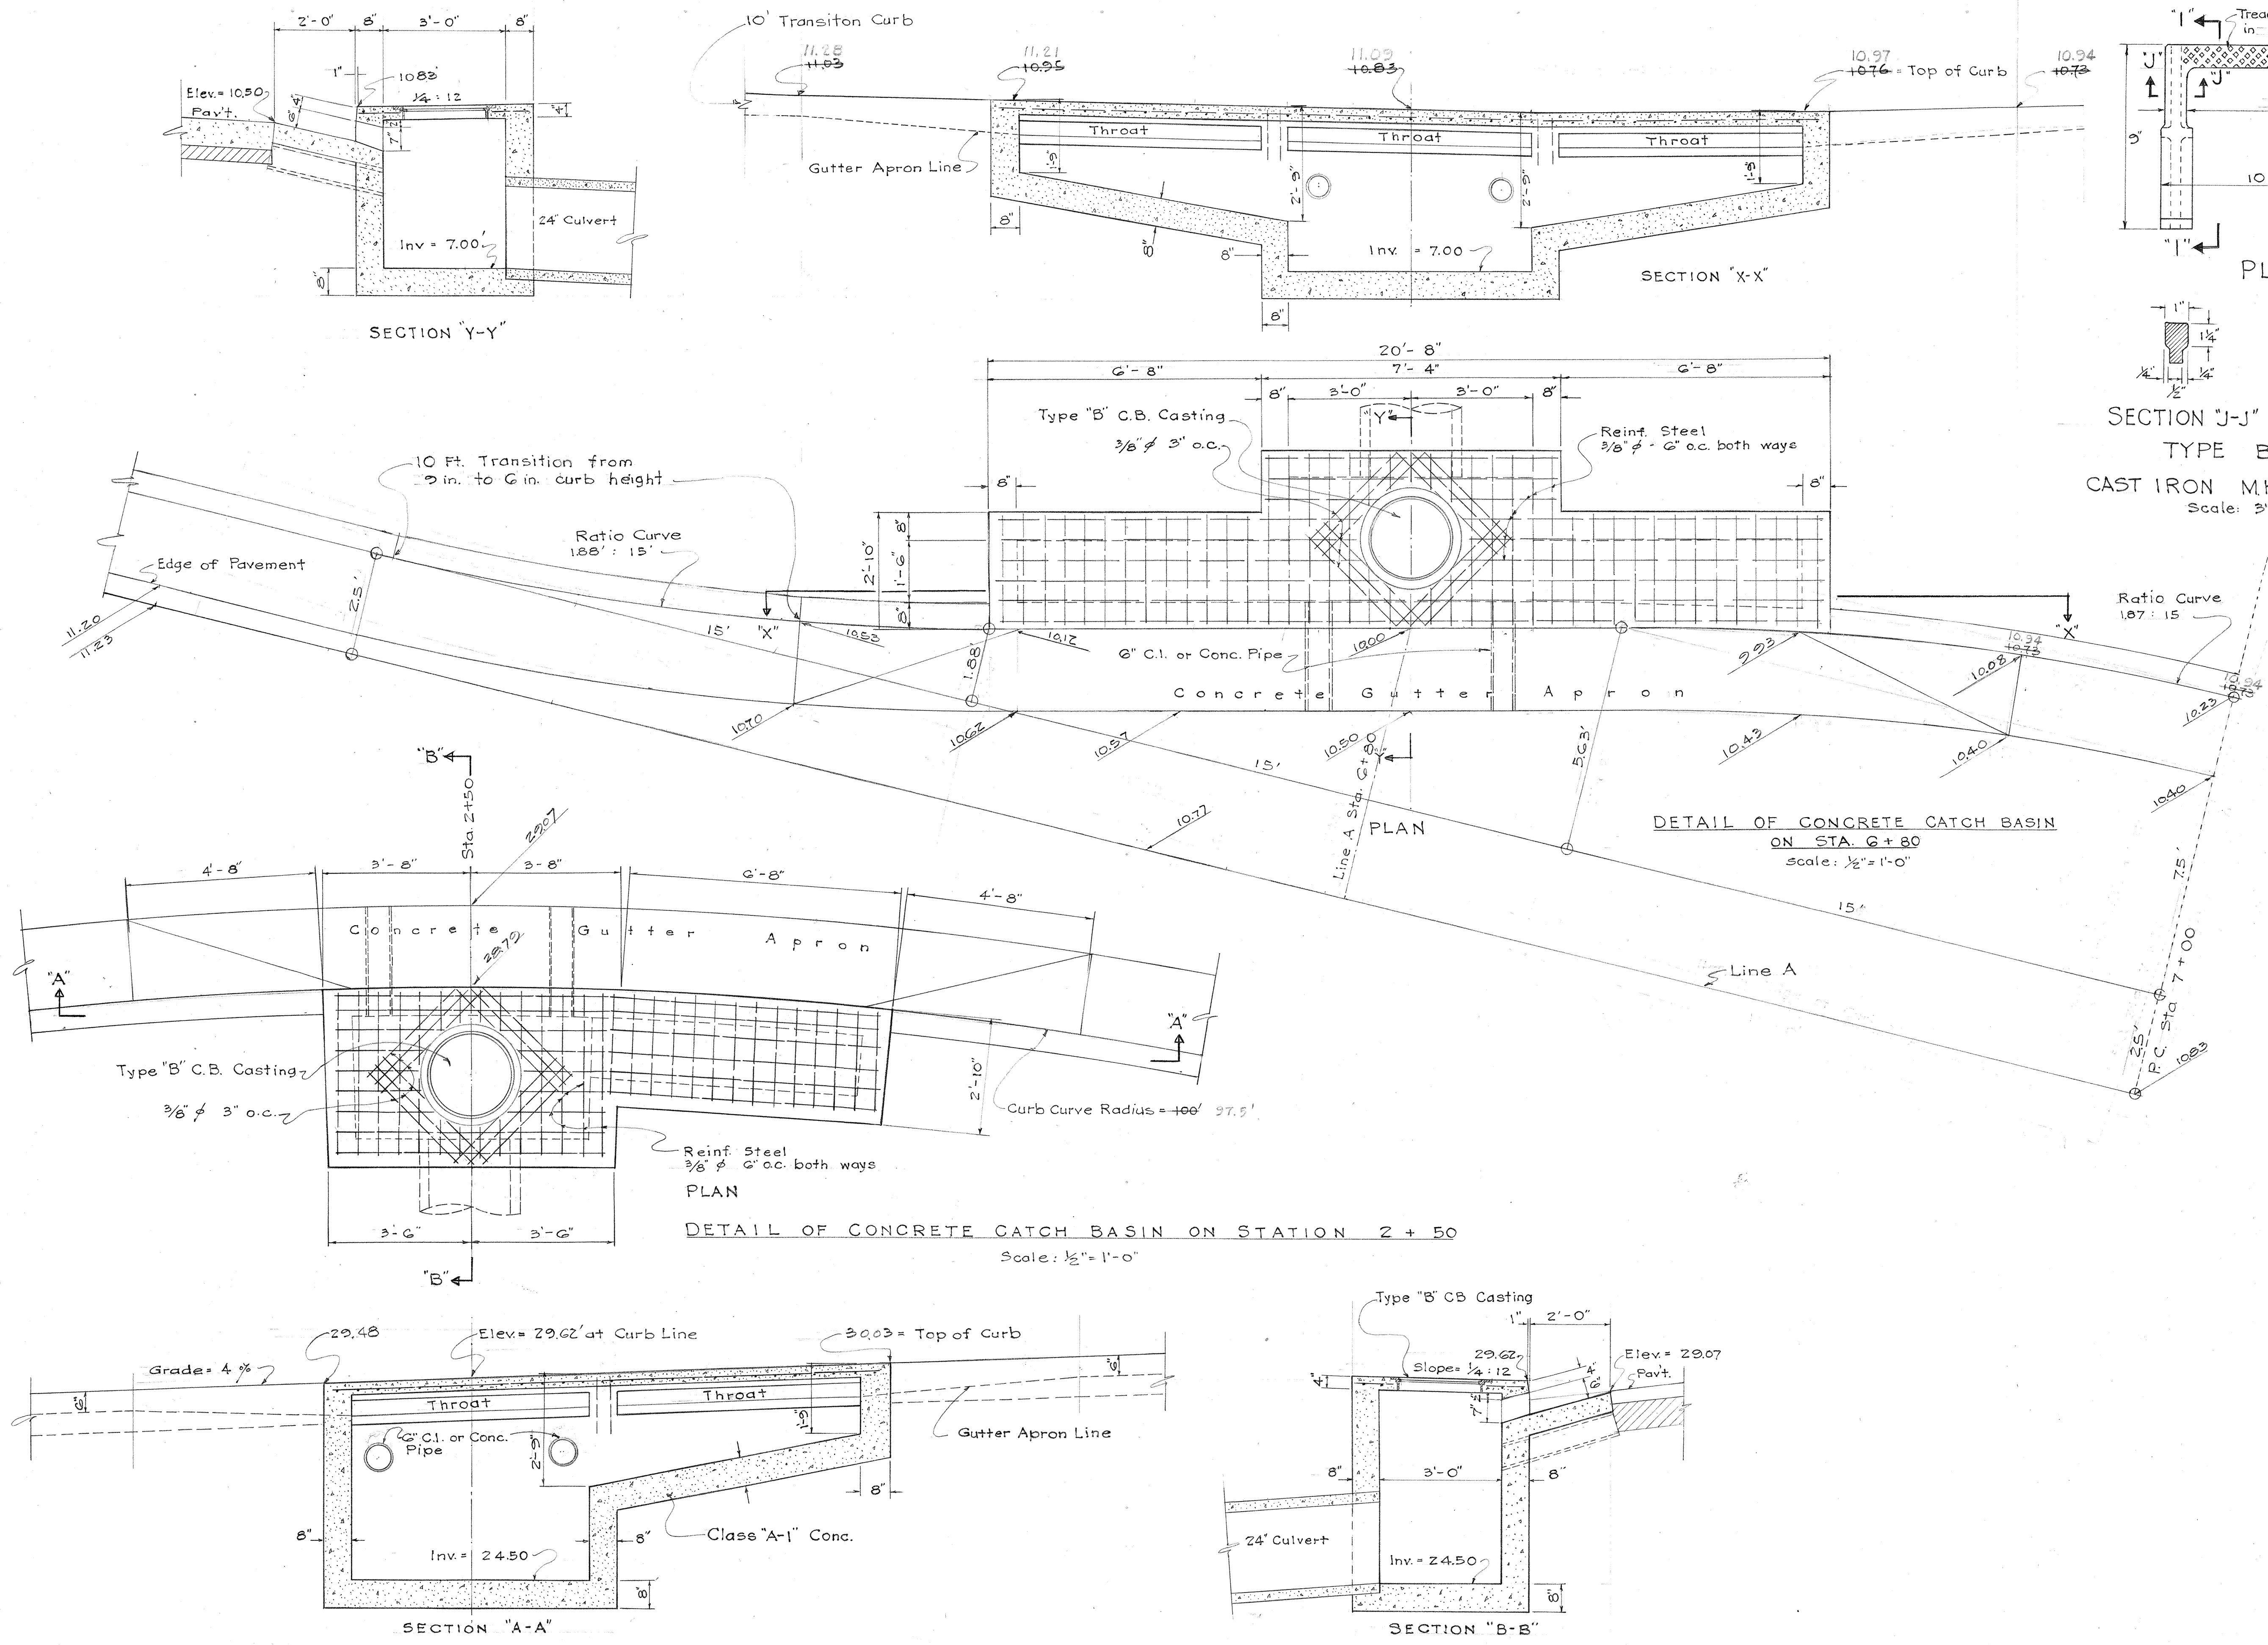

TERRITORIAL HIGHWAY DEPARTMENT
TERRITORY OF HAWAII
 DETAILS OF
 CONCRETE CATCH BASINS
 RAMP U-1
 MAUKA ARTERIAL
 PROJECT NO. U 59 (3) Unit 2
 Scale as noted Sept., 1953

SHEET NO. 9 OF 25 SHEETS

5681.09

DATE	DESIGNED BY	CHECKED BY
PLANNED BY	TRACED BY	QUANTITIES BY
NOTE BOOK	NO.	CHECKED BY