

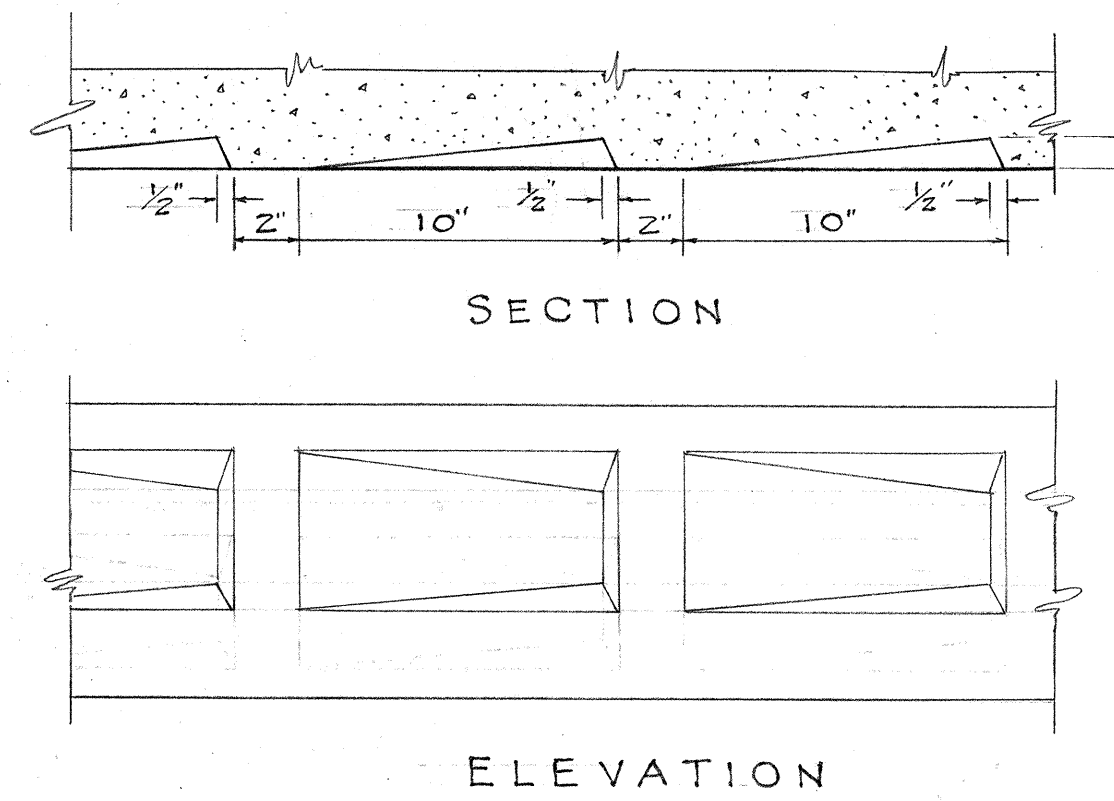
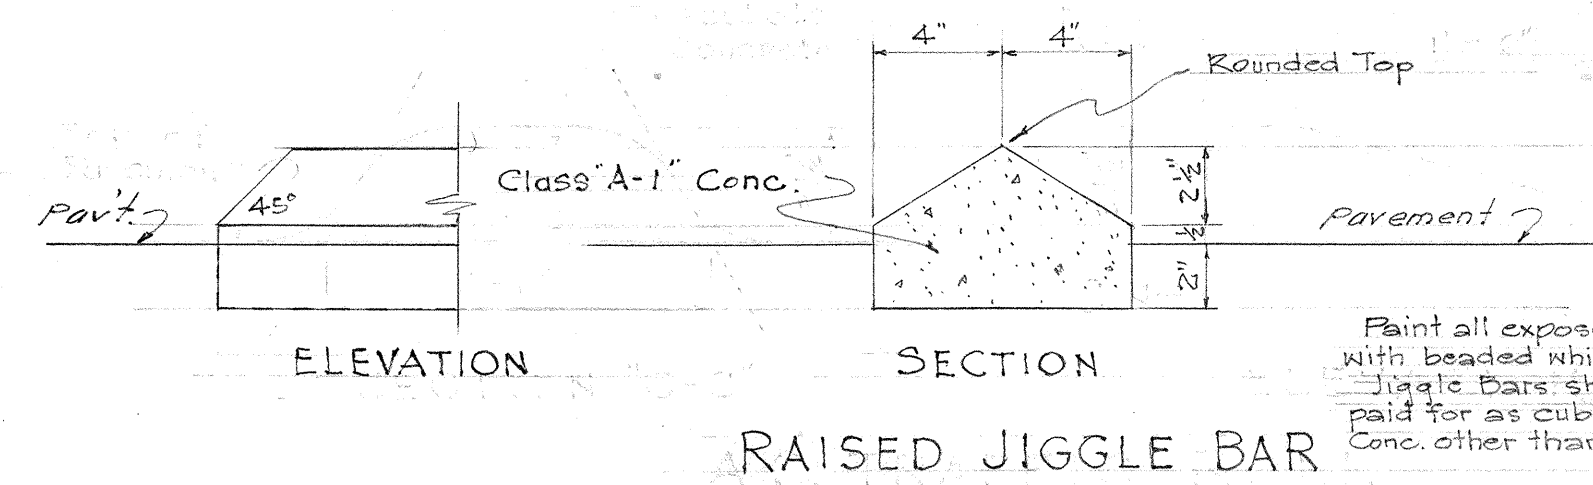
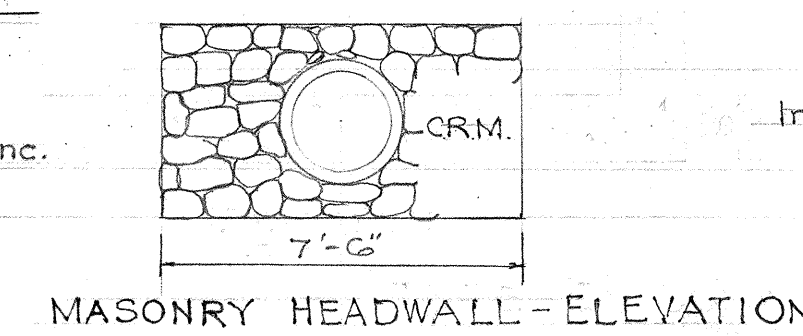
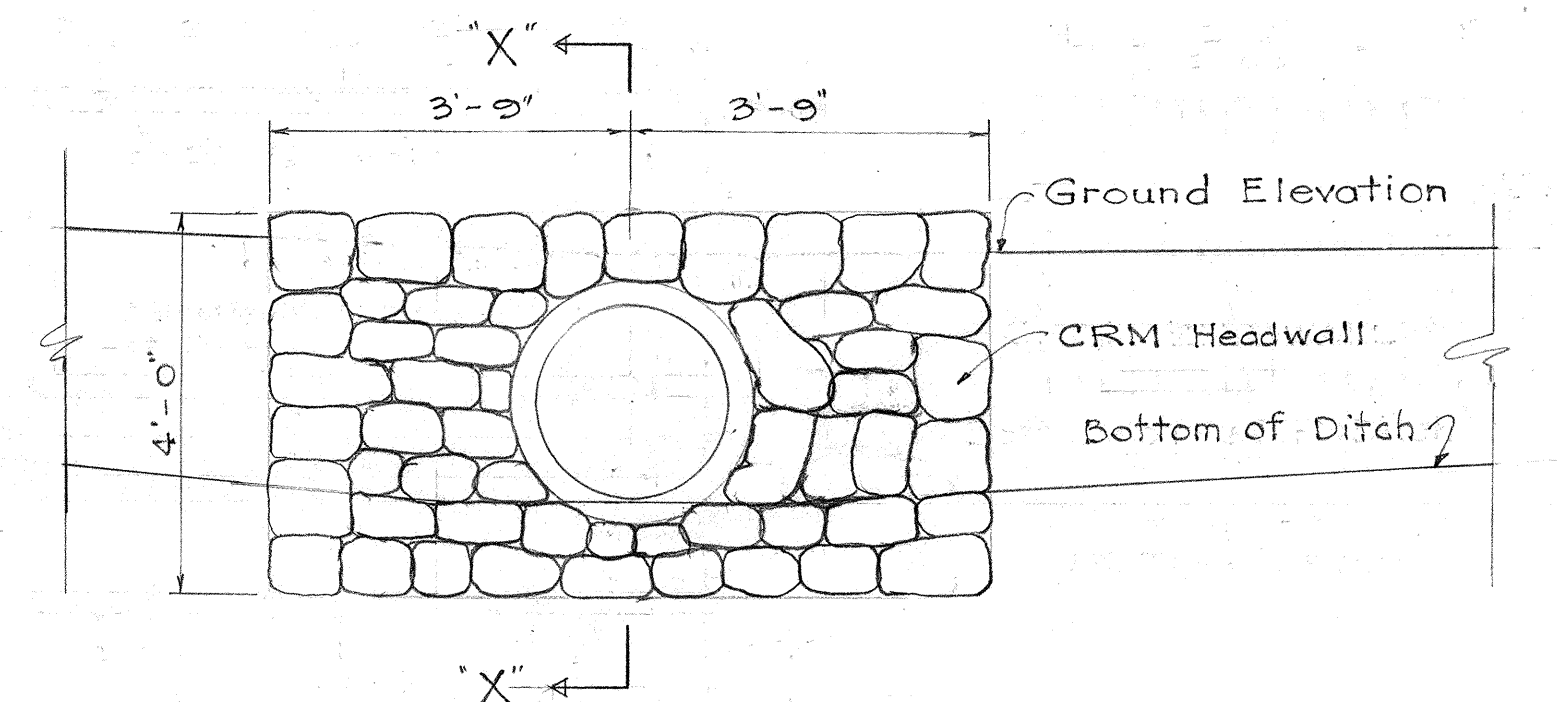
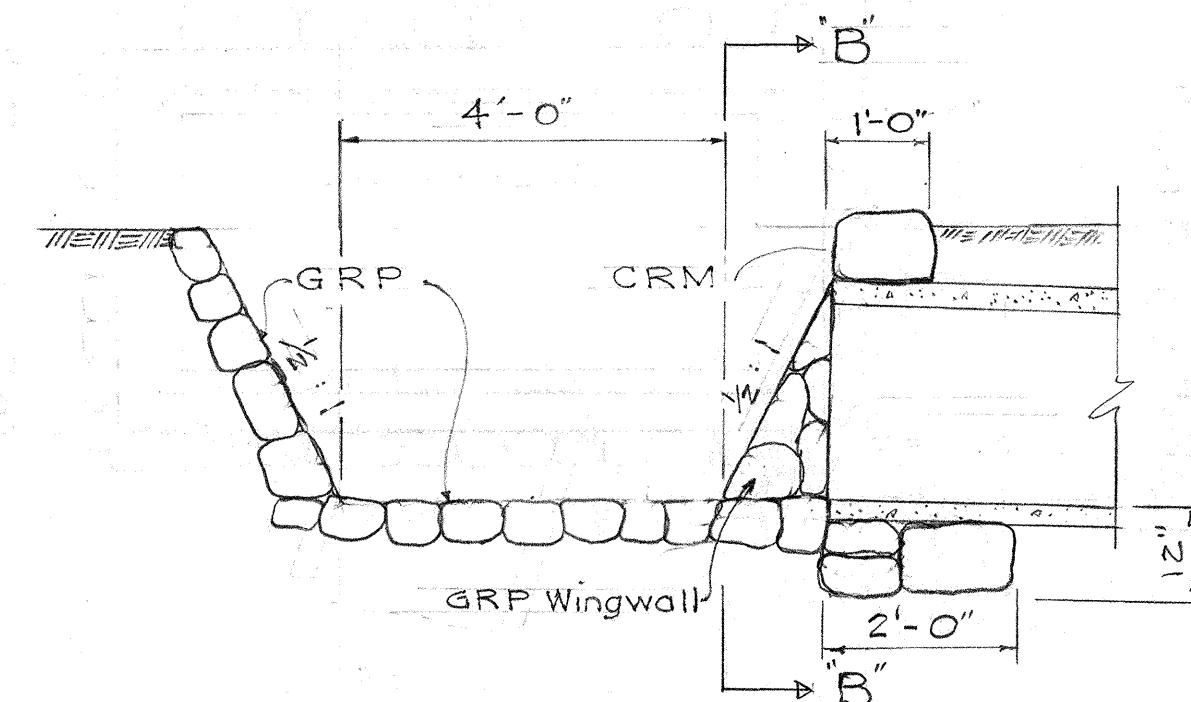
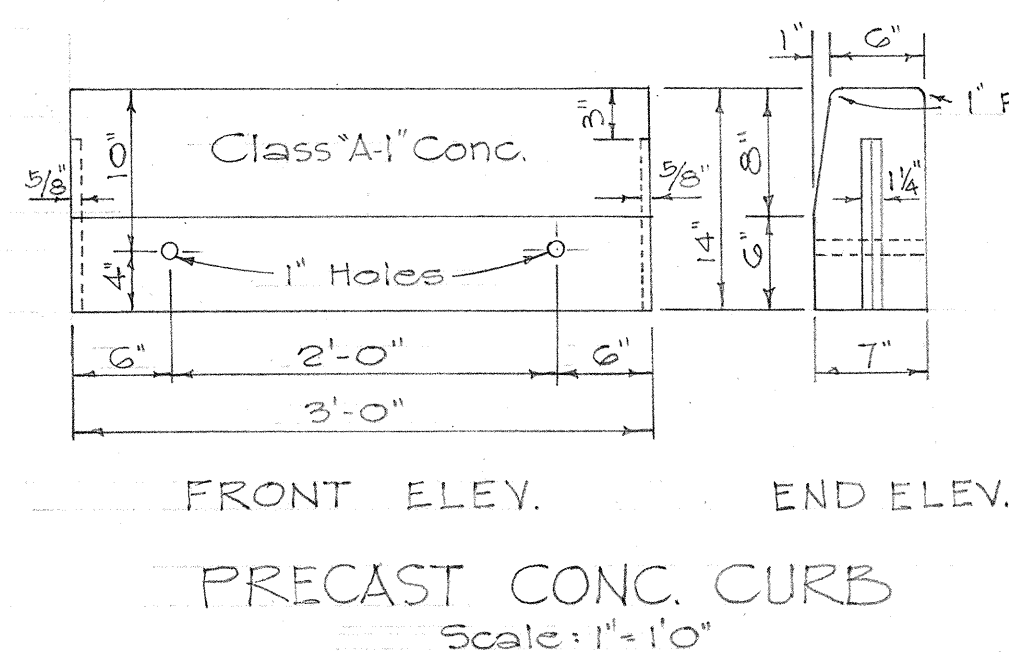
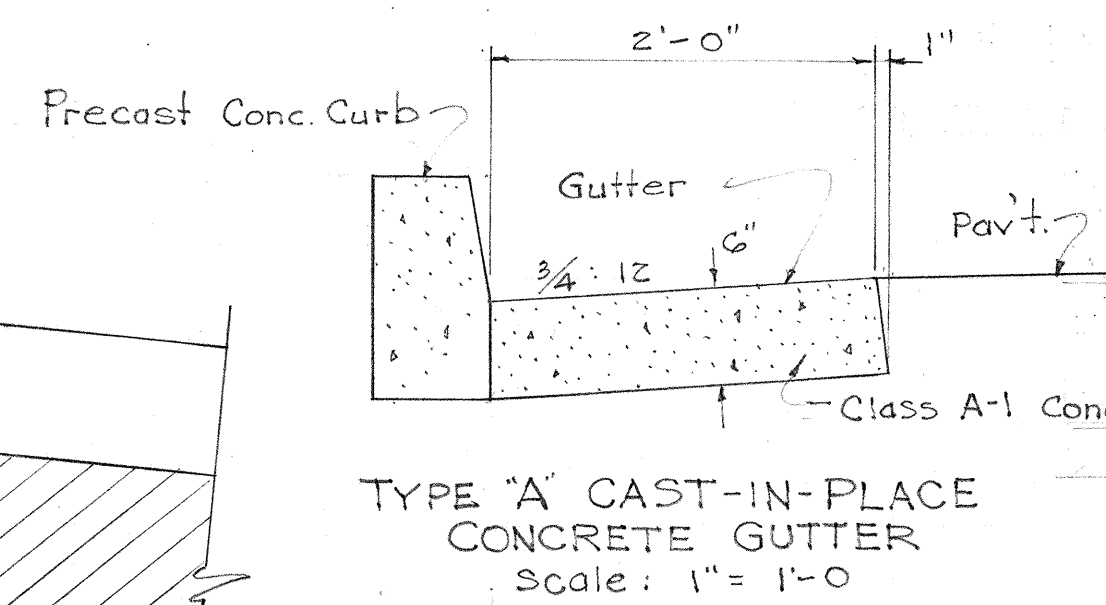
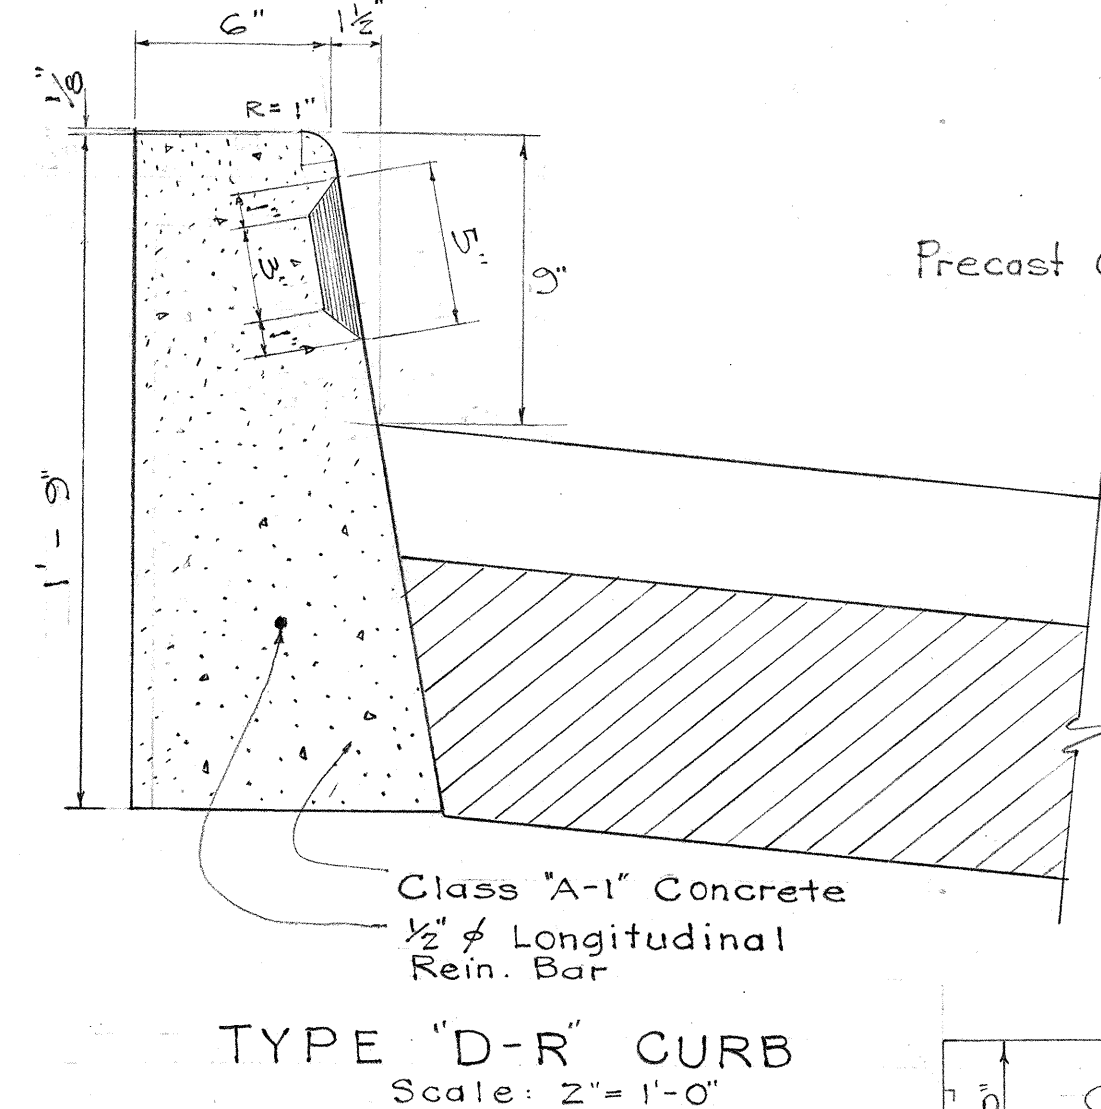
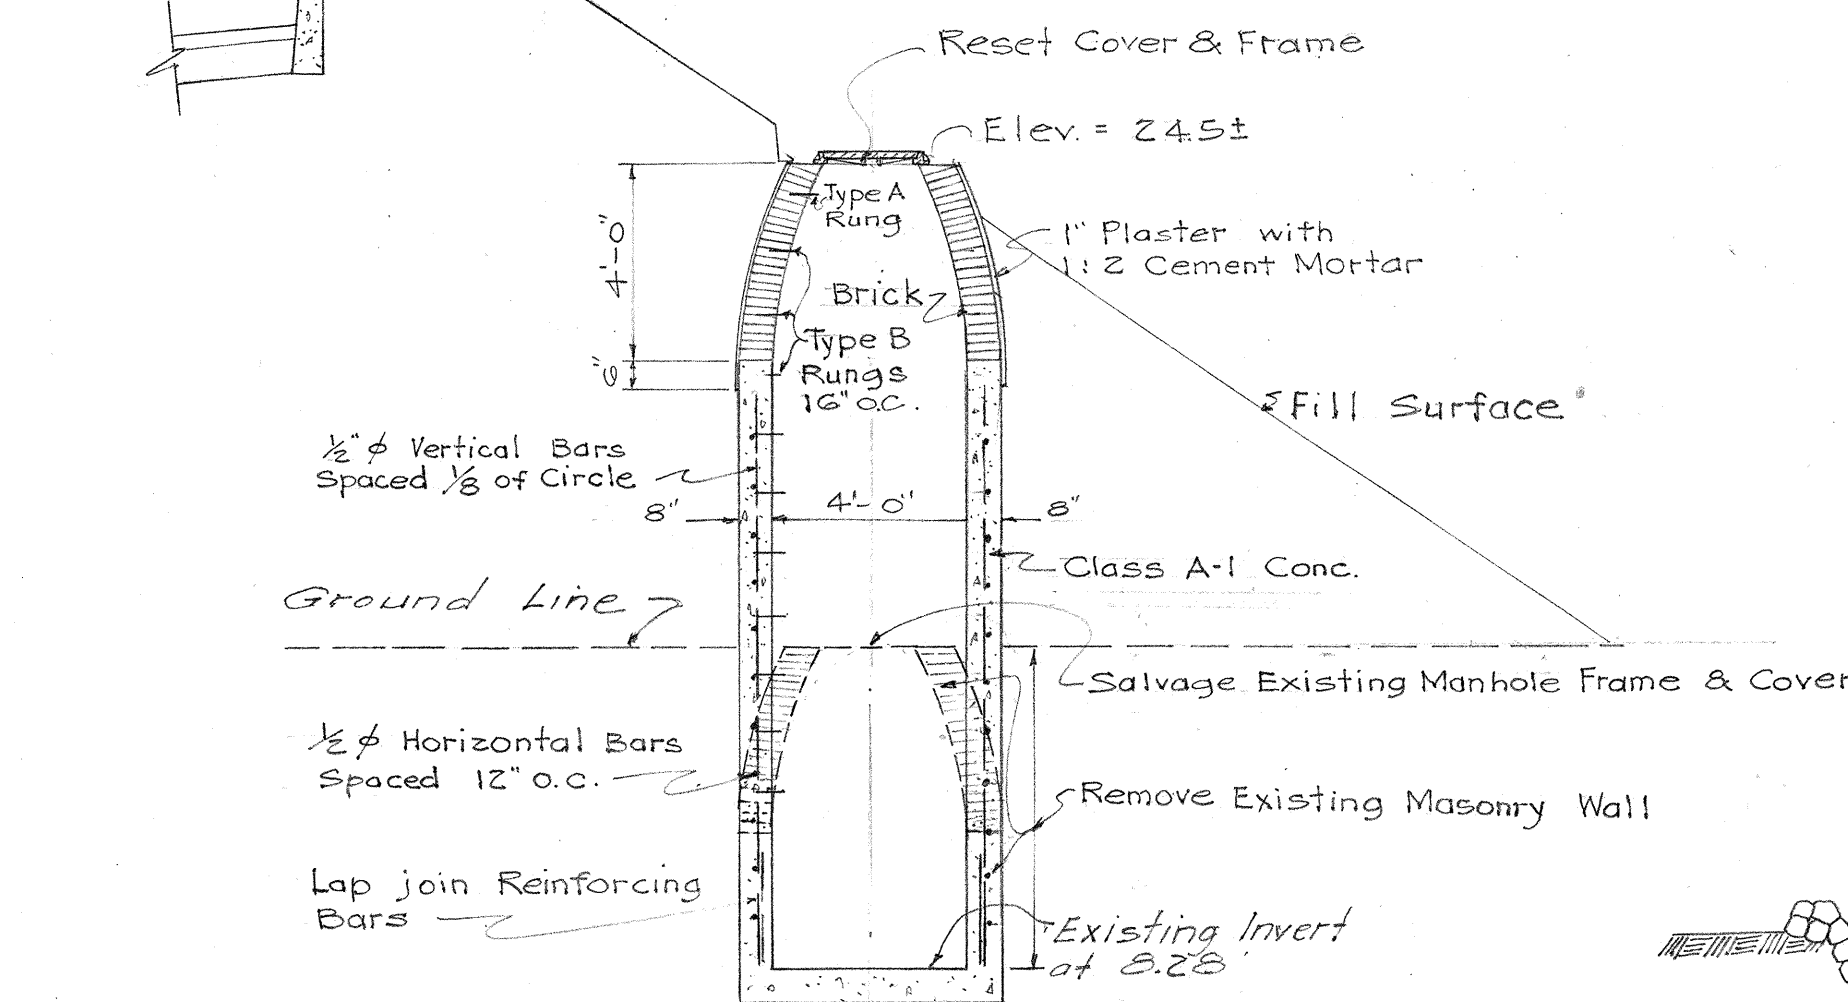
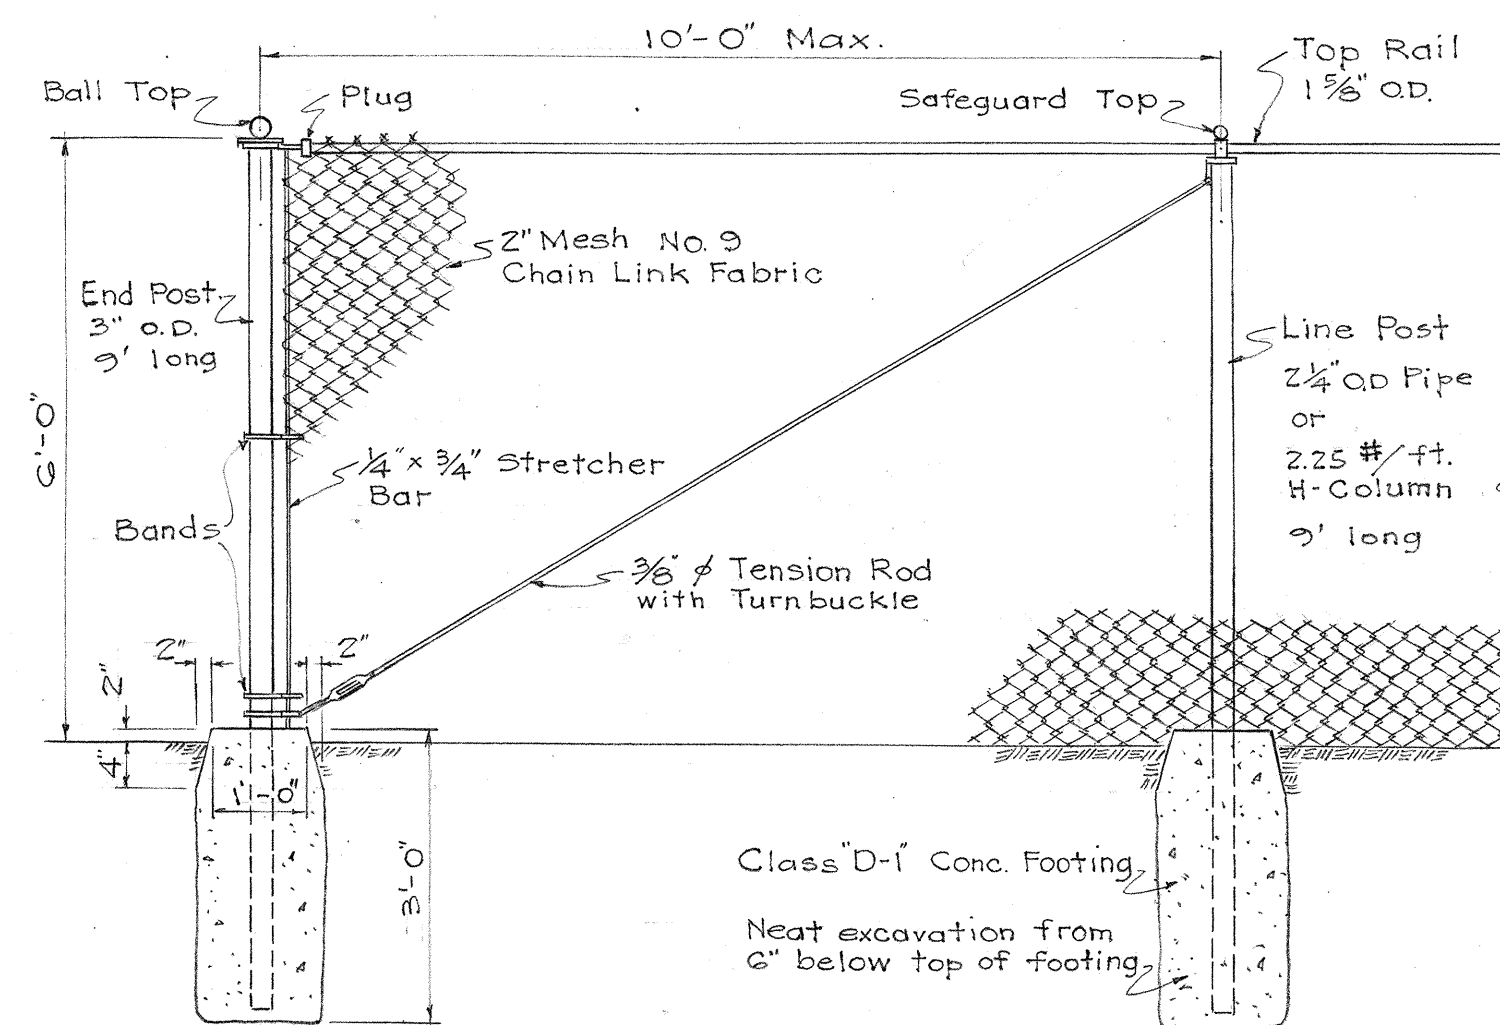
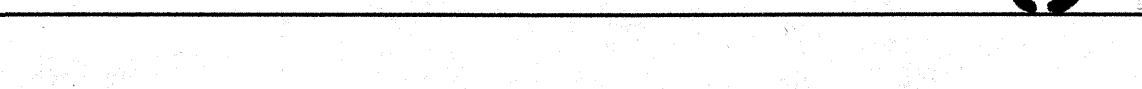
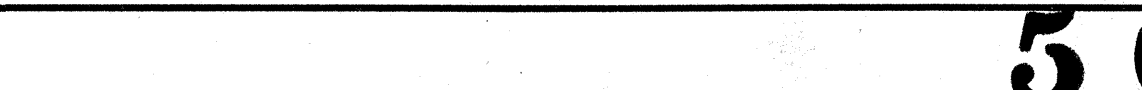
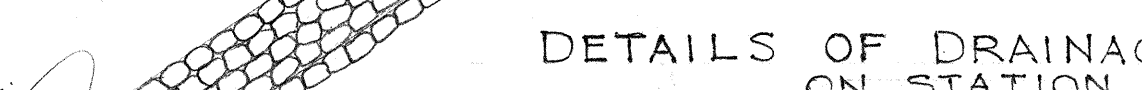
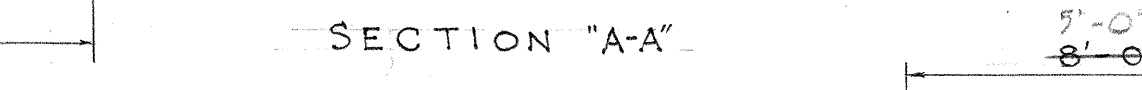
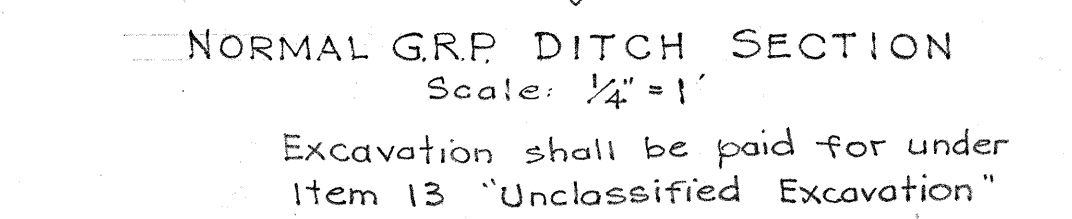
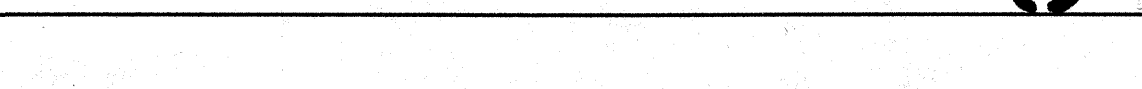
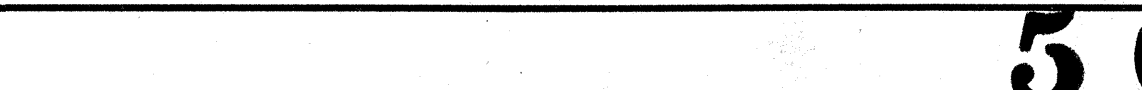
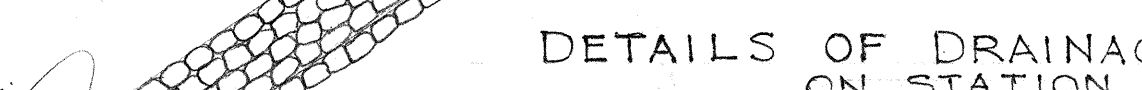
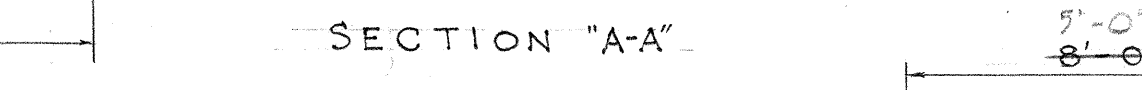
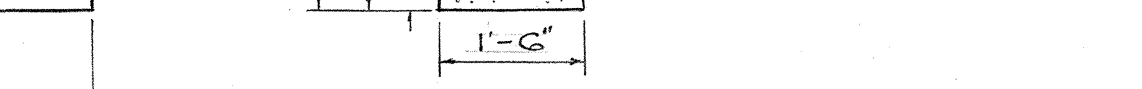
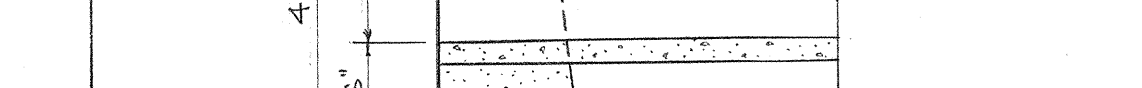


DETAILS OF CAST-IN-PLACE CONC. CURBS AND GUTTER

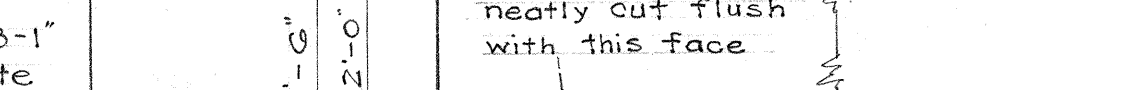

DETAILS OF DRAINAGE CONNECTIONS ON STATION 6+80

Scale: 1/4" = 1'

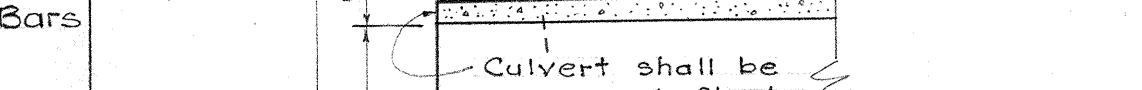

For Detail of Rungs See Sheet No. 5681.09

TERRITORIAL HIGHWAY DEPARTMENT
TERRITORY OF HAWAII
DETAILS OF ROADWAY AND DRAINAGE STRUCTURES
RAMP U-1
MAUKA ARTERIAL
PROJECT NO. U 59 (2) Unit 2

Scale as Noted August, 1953

SHEET NO. OF SHEETS

5681.08

DATE:
DESIGNED BY:
CHECKED BY:
ORIGINAL PLAN:
NOTE BOOK:
No.: