



FED. ROAD DIST. NO.	STATE	FED. AID PROJ. NO.	FISCAL YEAR	SHEET NO.	TOTAL SHEETS
HAWAII	HAW	U 59(2)	1954	3	25

Unit 2

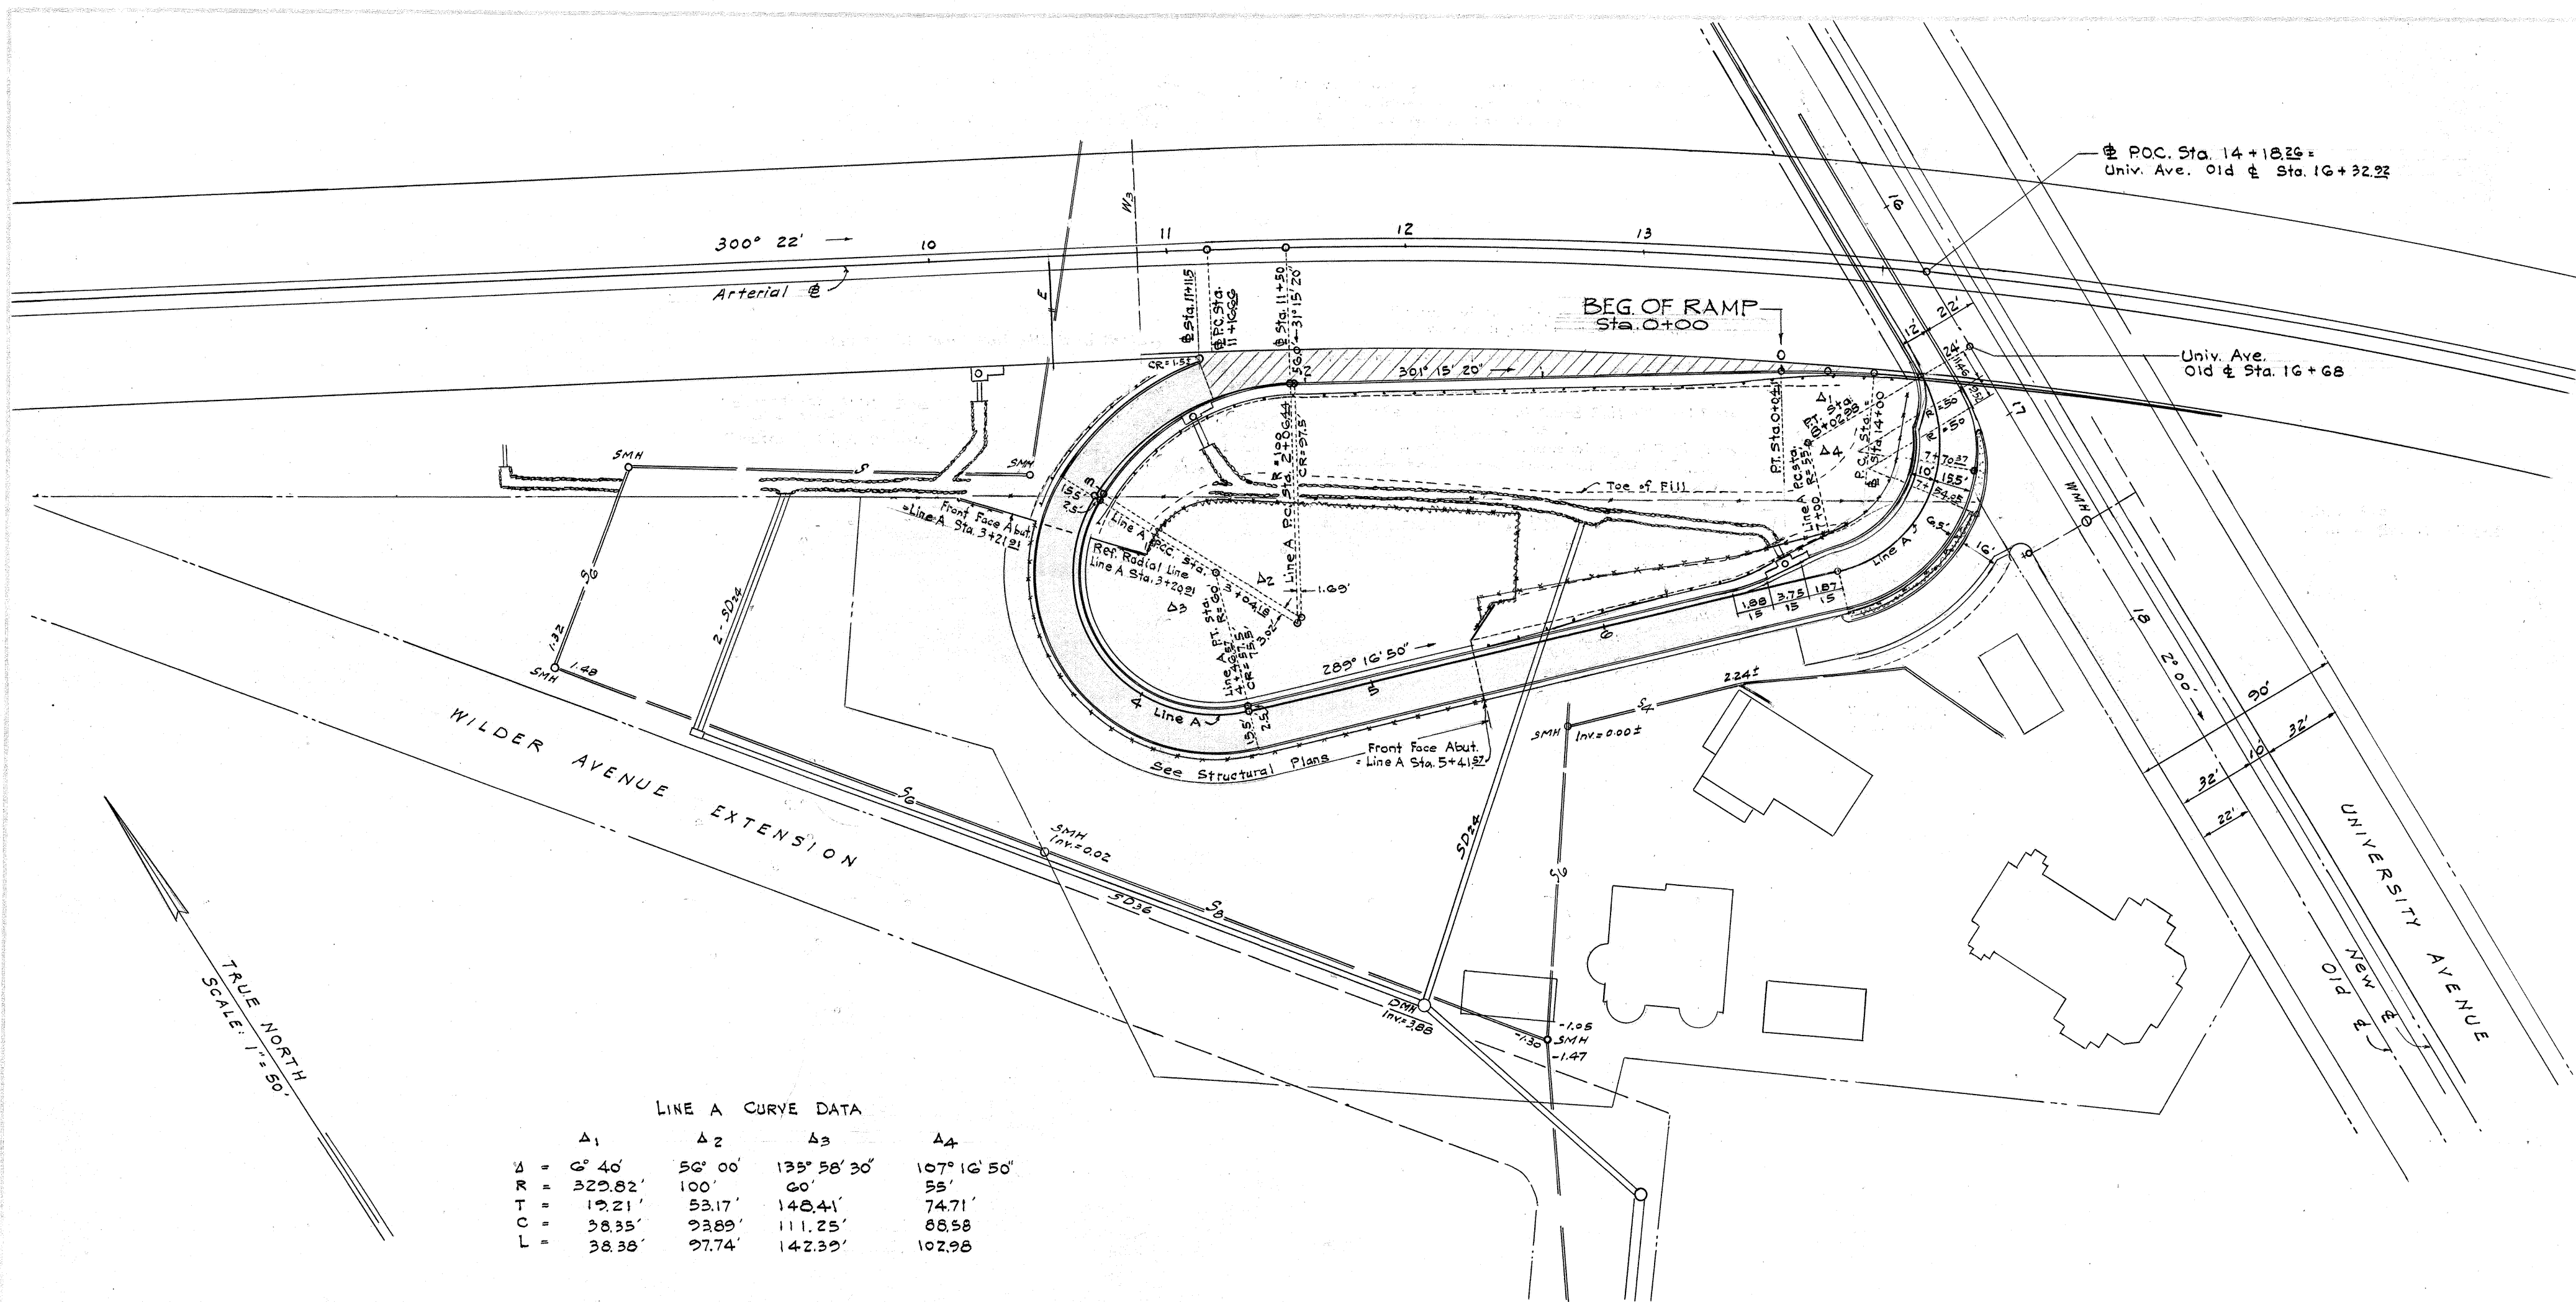



LINE A CURVE DATA

	A1	A2	A3	A4
Δ	2° 40'	56° 00'	135° 56' 30"	107° 16' 50"
R	320.82'	100'	60'	55'
T	10.21'	53.17'	140.41'	74.71'
L	38.35'	23.89'	111.25'	68.58'
L	38.35'	27.74'	142.35'	102.96'

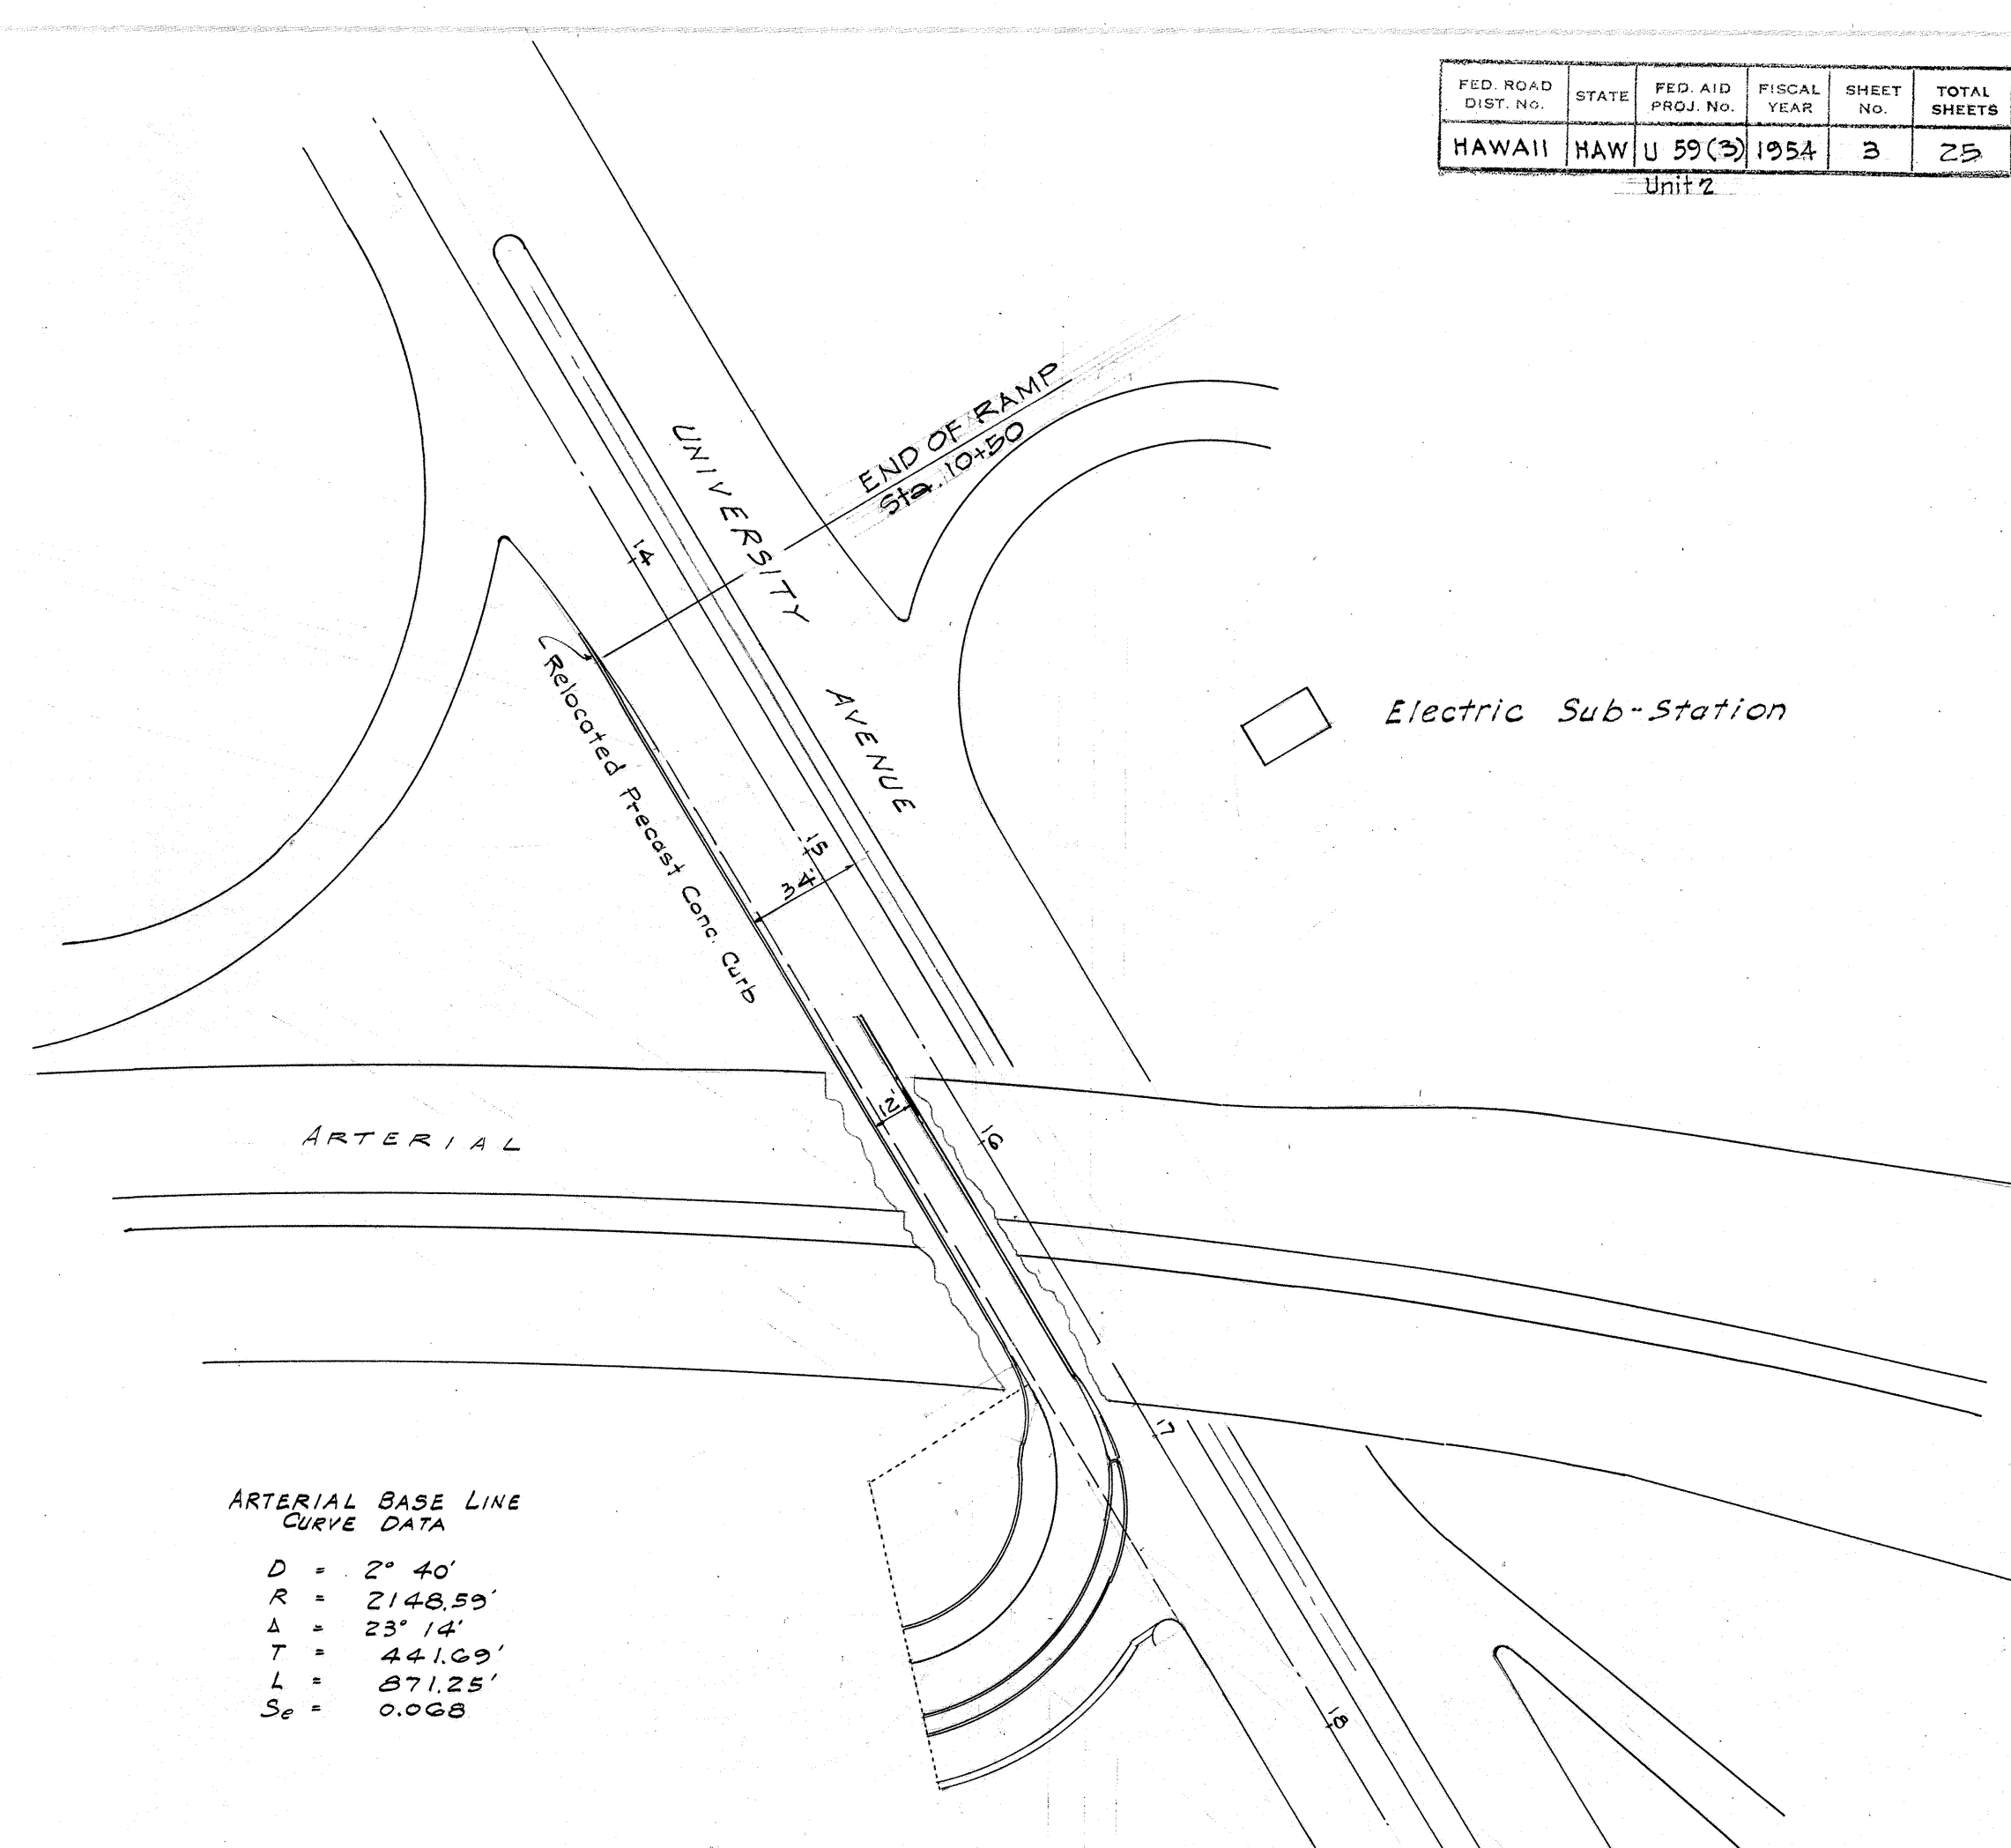

ARTERIAL BASE LINE CURVE DATA

Δ	2° 40'
R	2148.59'
Δ	23° 14'
T	44.169'
L	87.125'
S_e	0.008

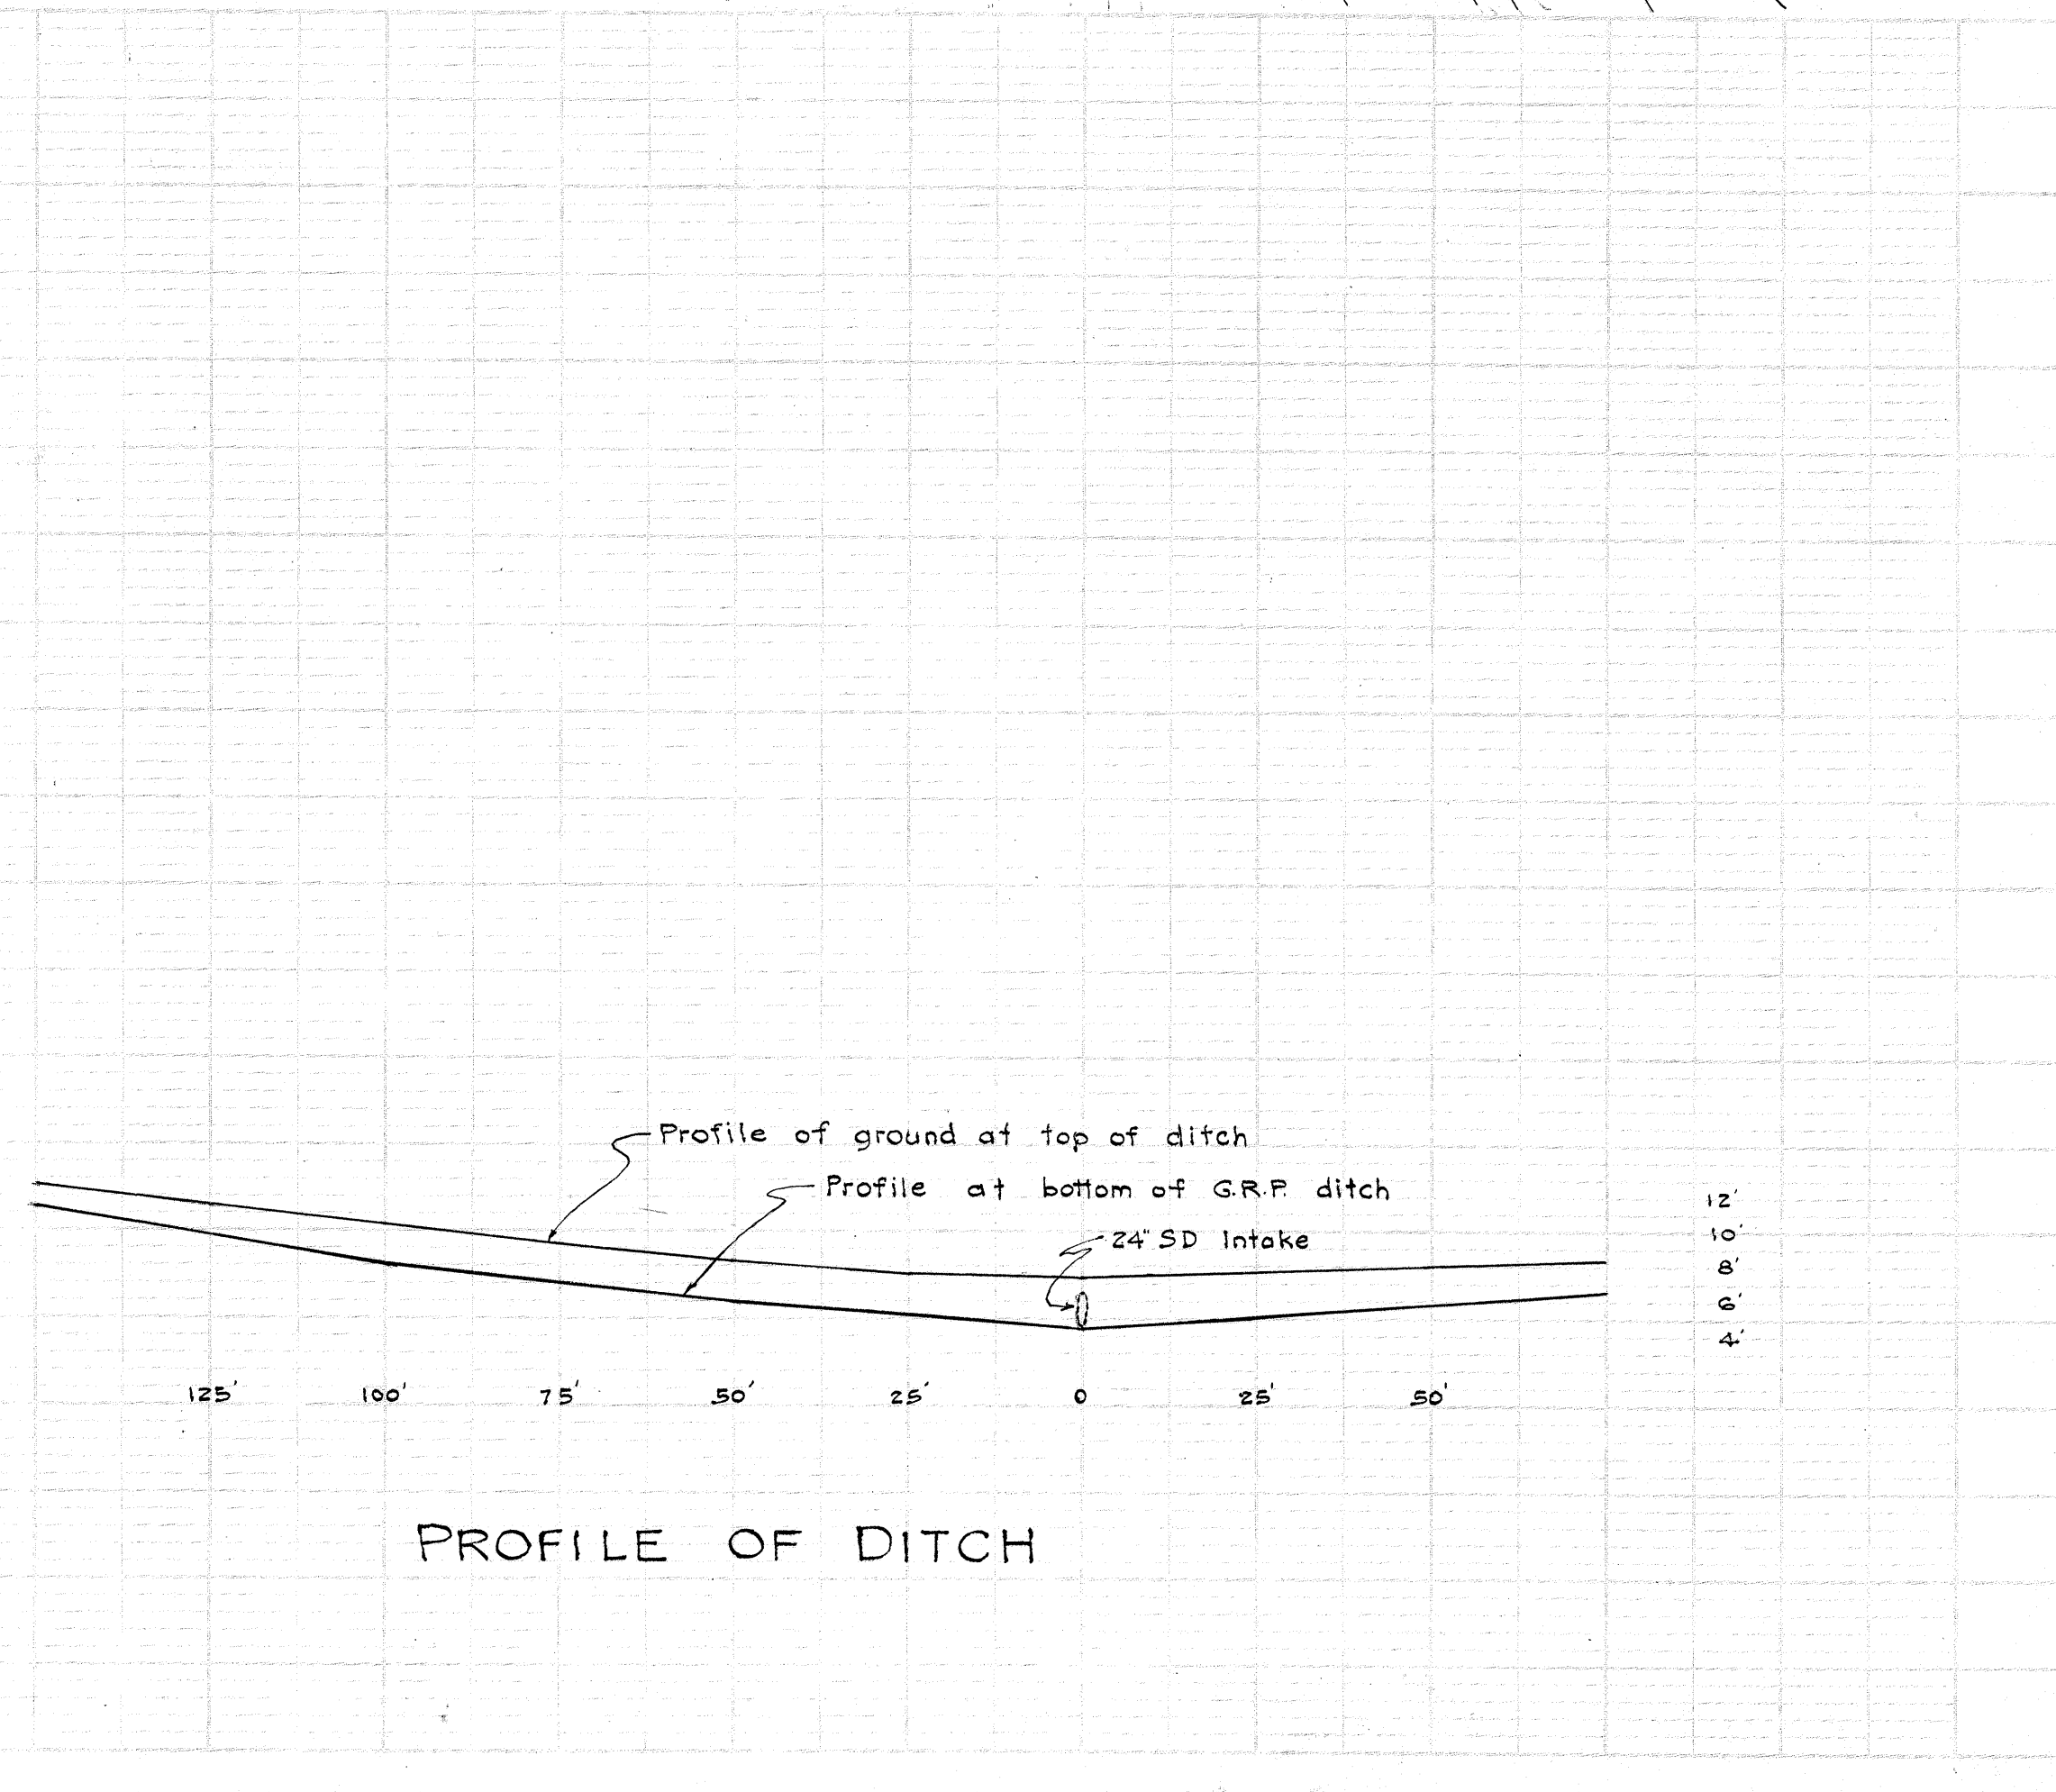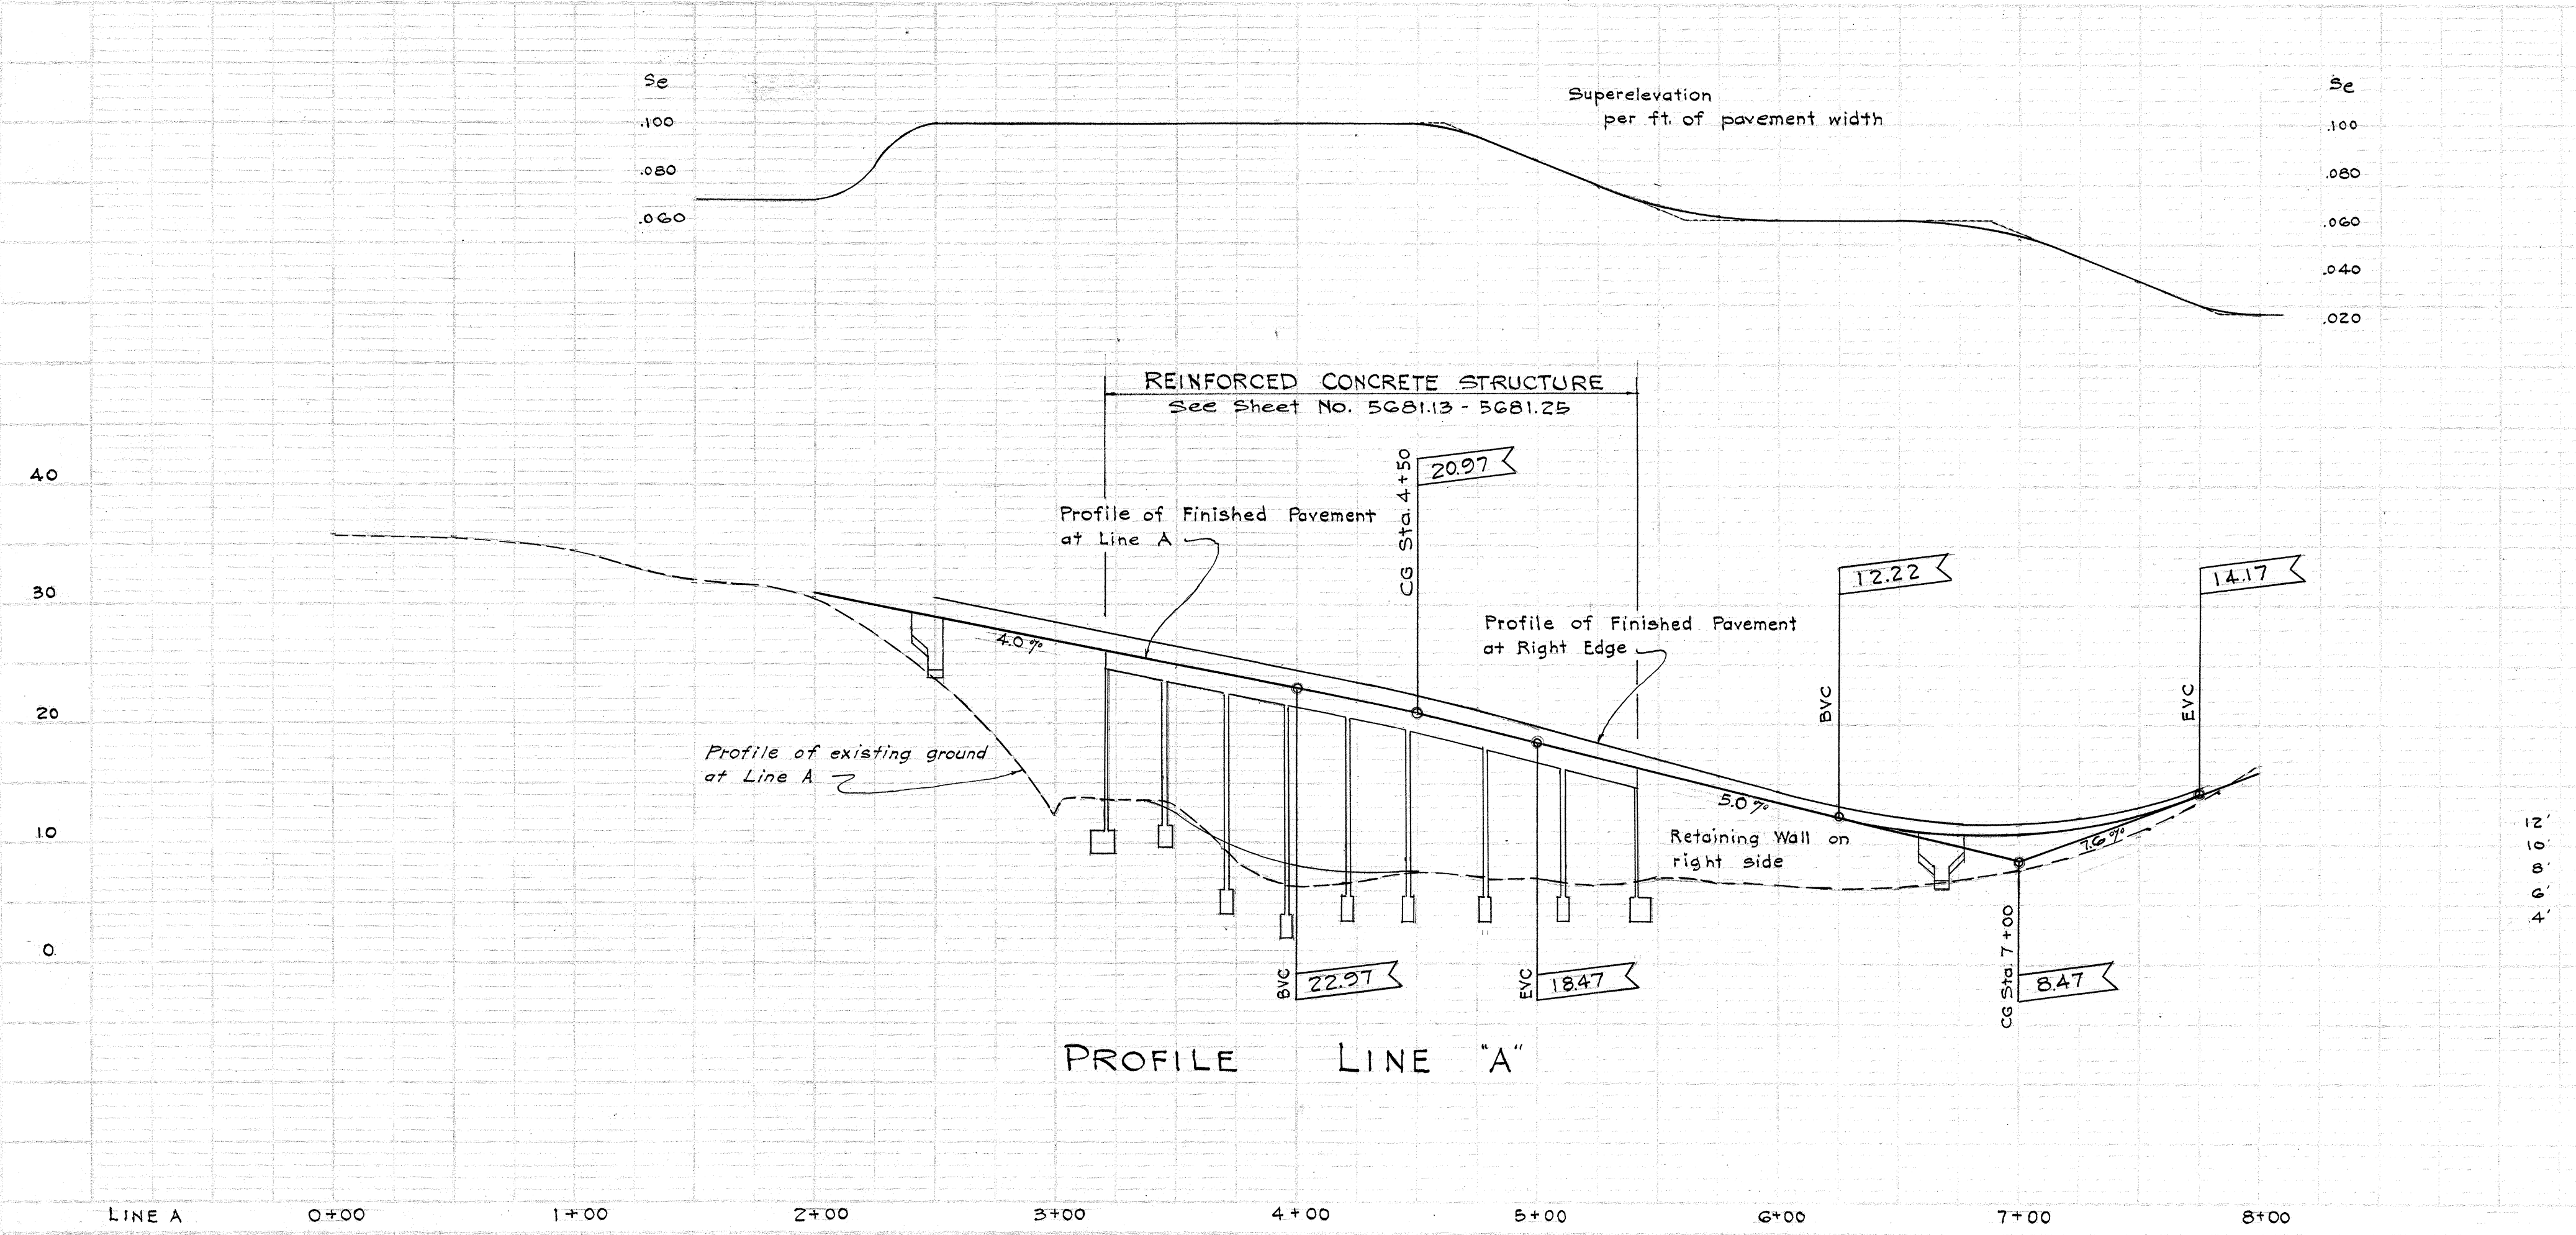

5681.03