



FED. ROAD DIST. NO.	STATE	FED. AID PROJ. NO.	FISCAL YEAR	SHEET NO.	TOTAL SHEETS
HAWAII	HAW.	U 59 (6)	1954	55	104

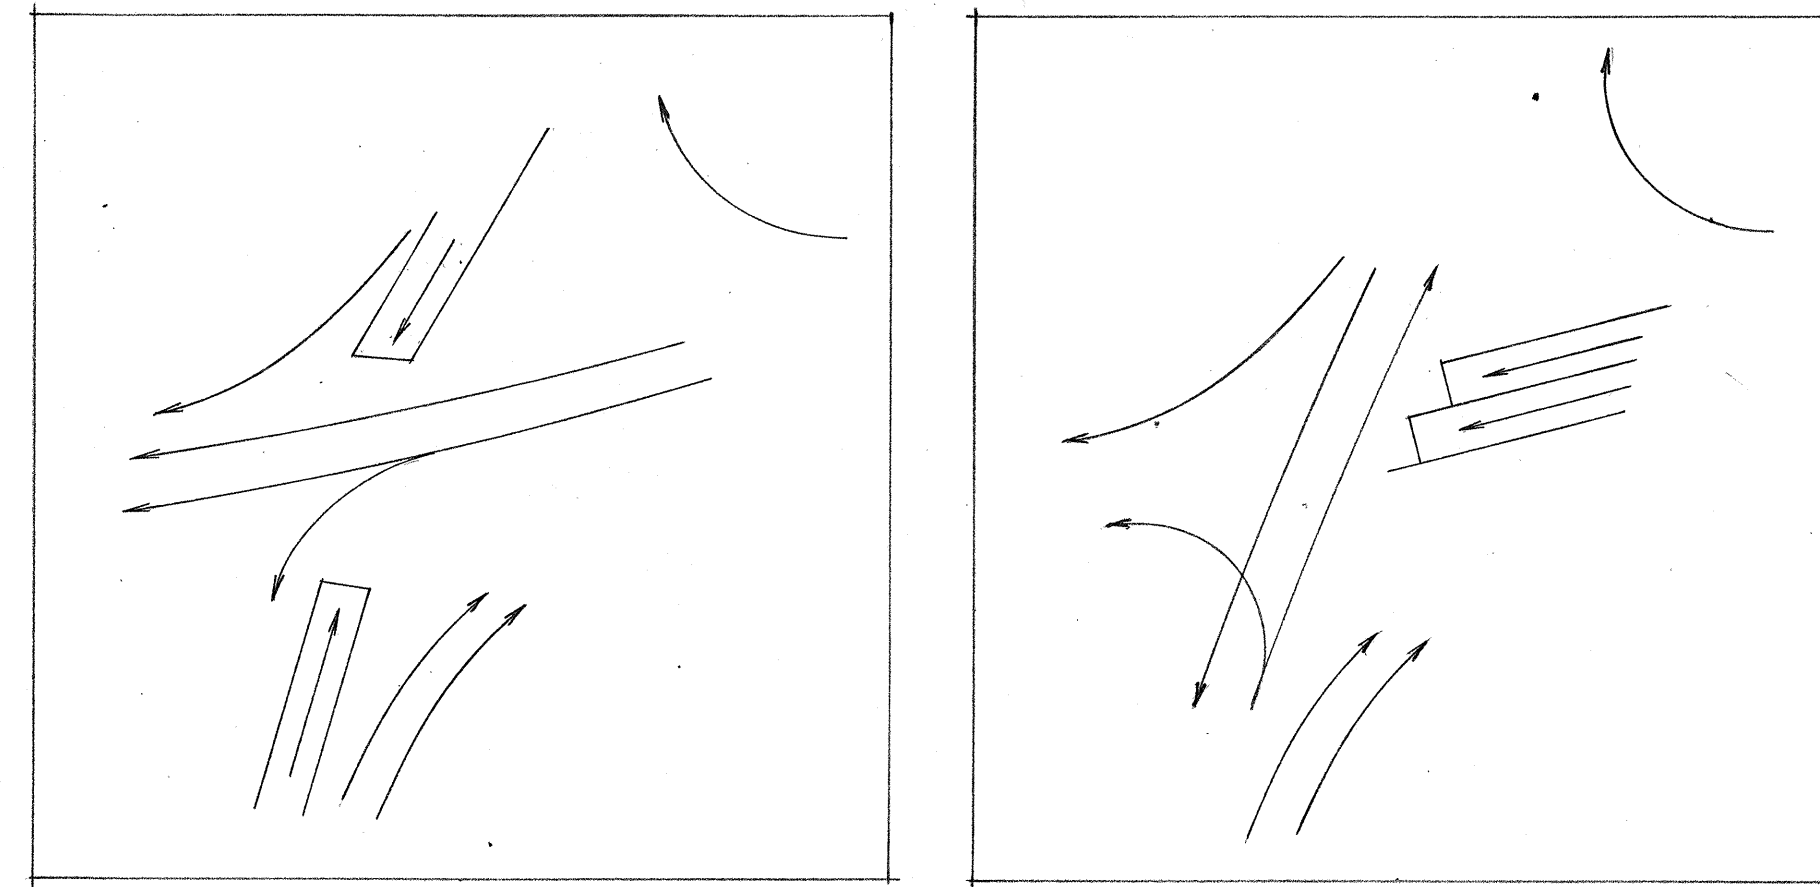


PHASE 1

PHASE 2


NOTE:
Pavement Marking not in Contract.

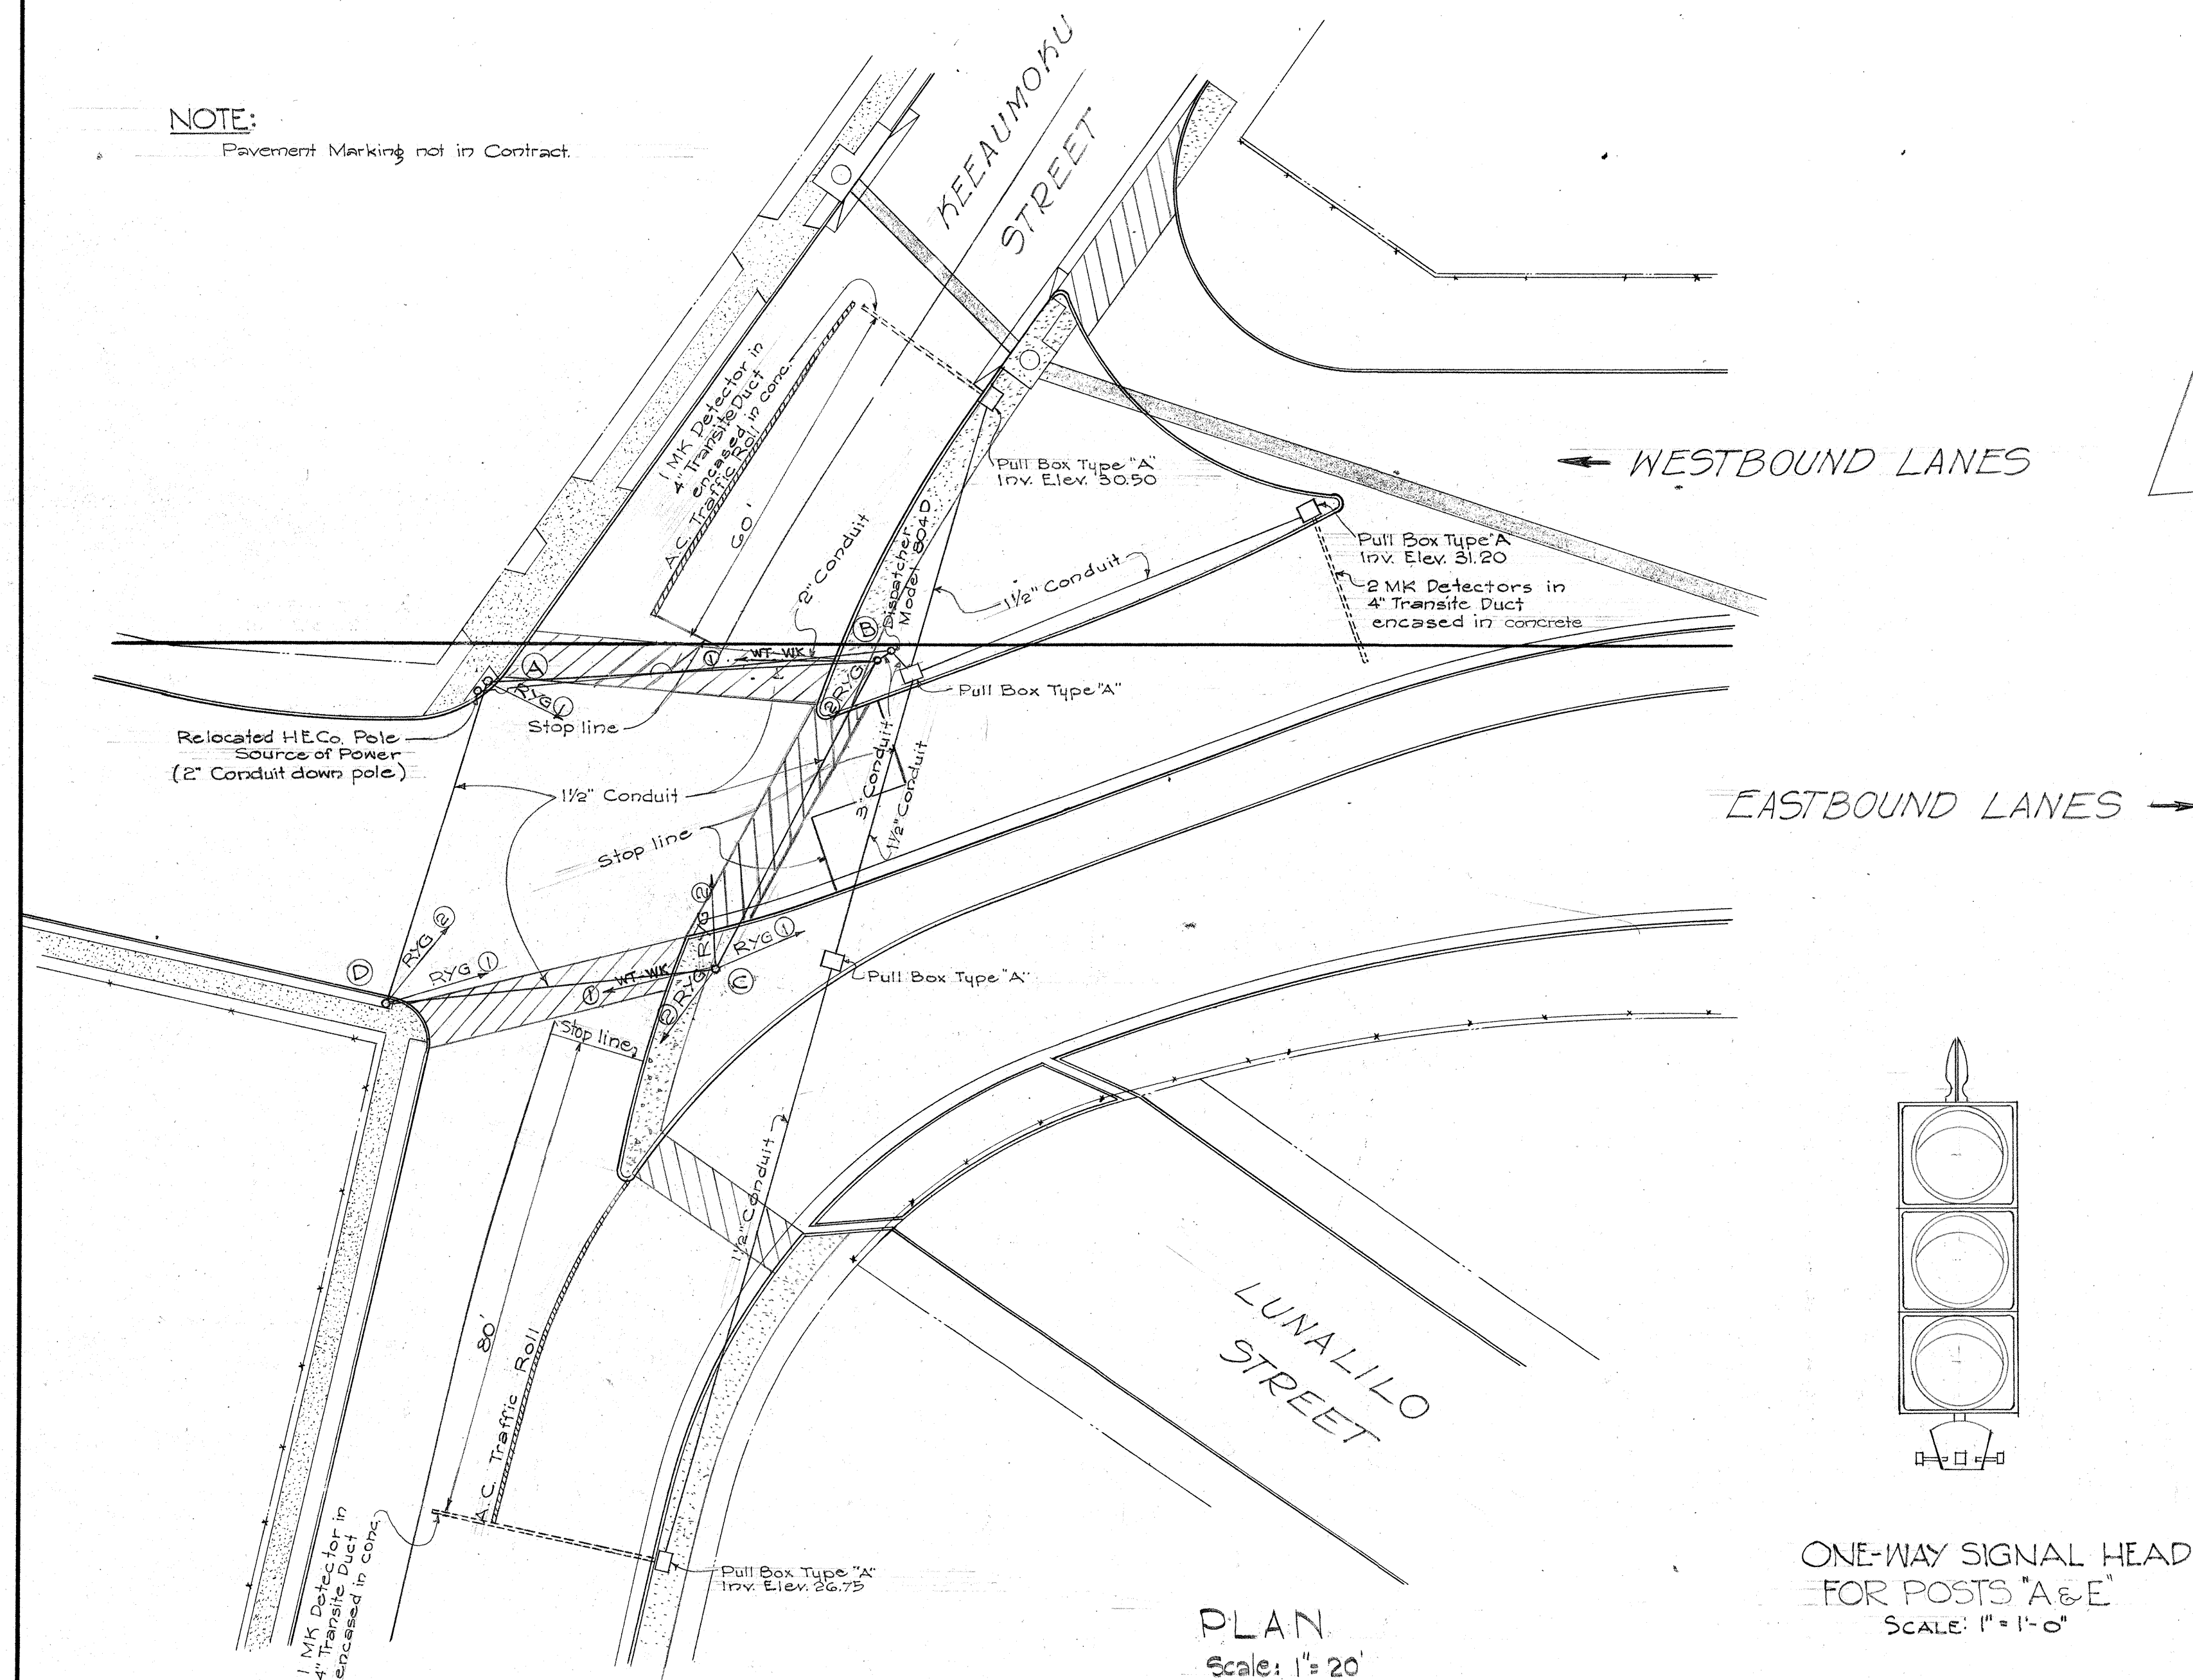


PLAN
Scale: 1" = 20'

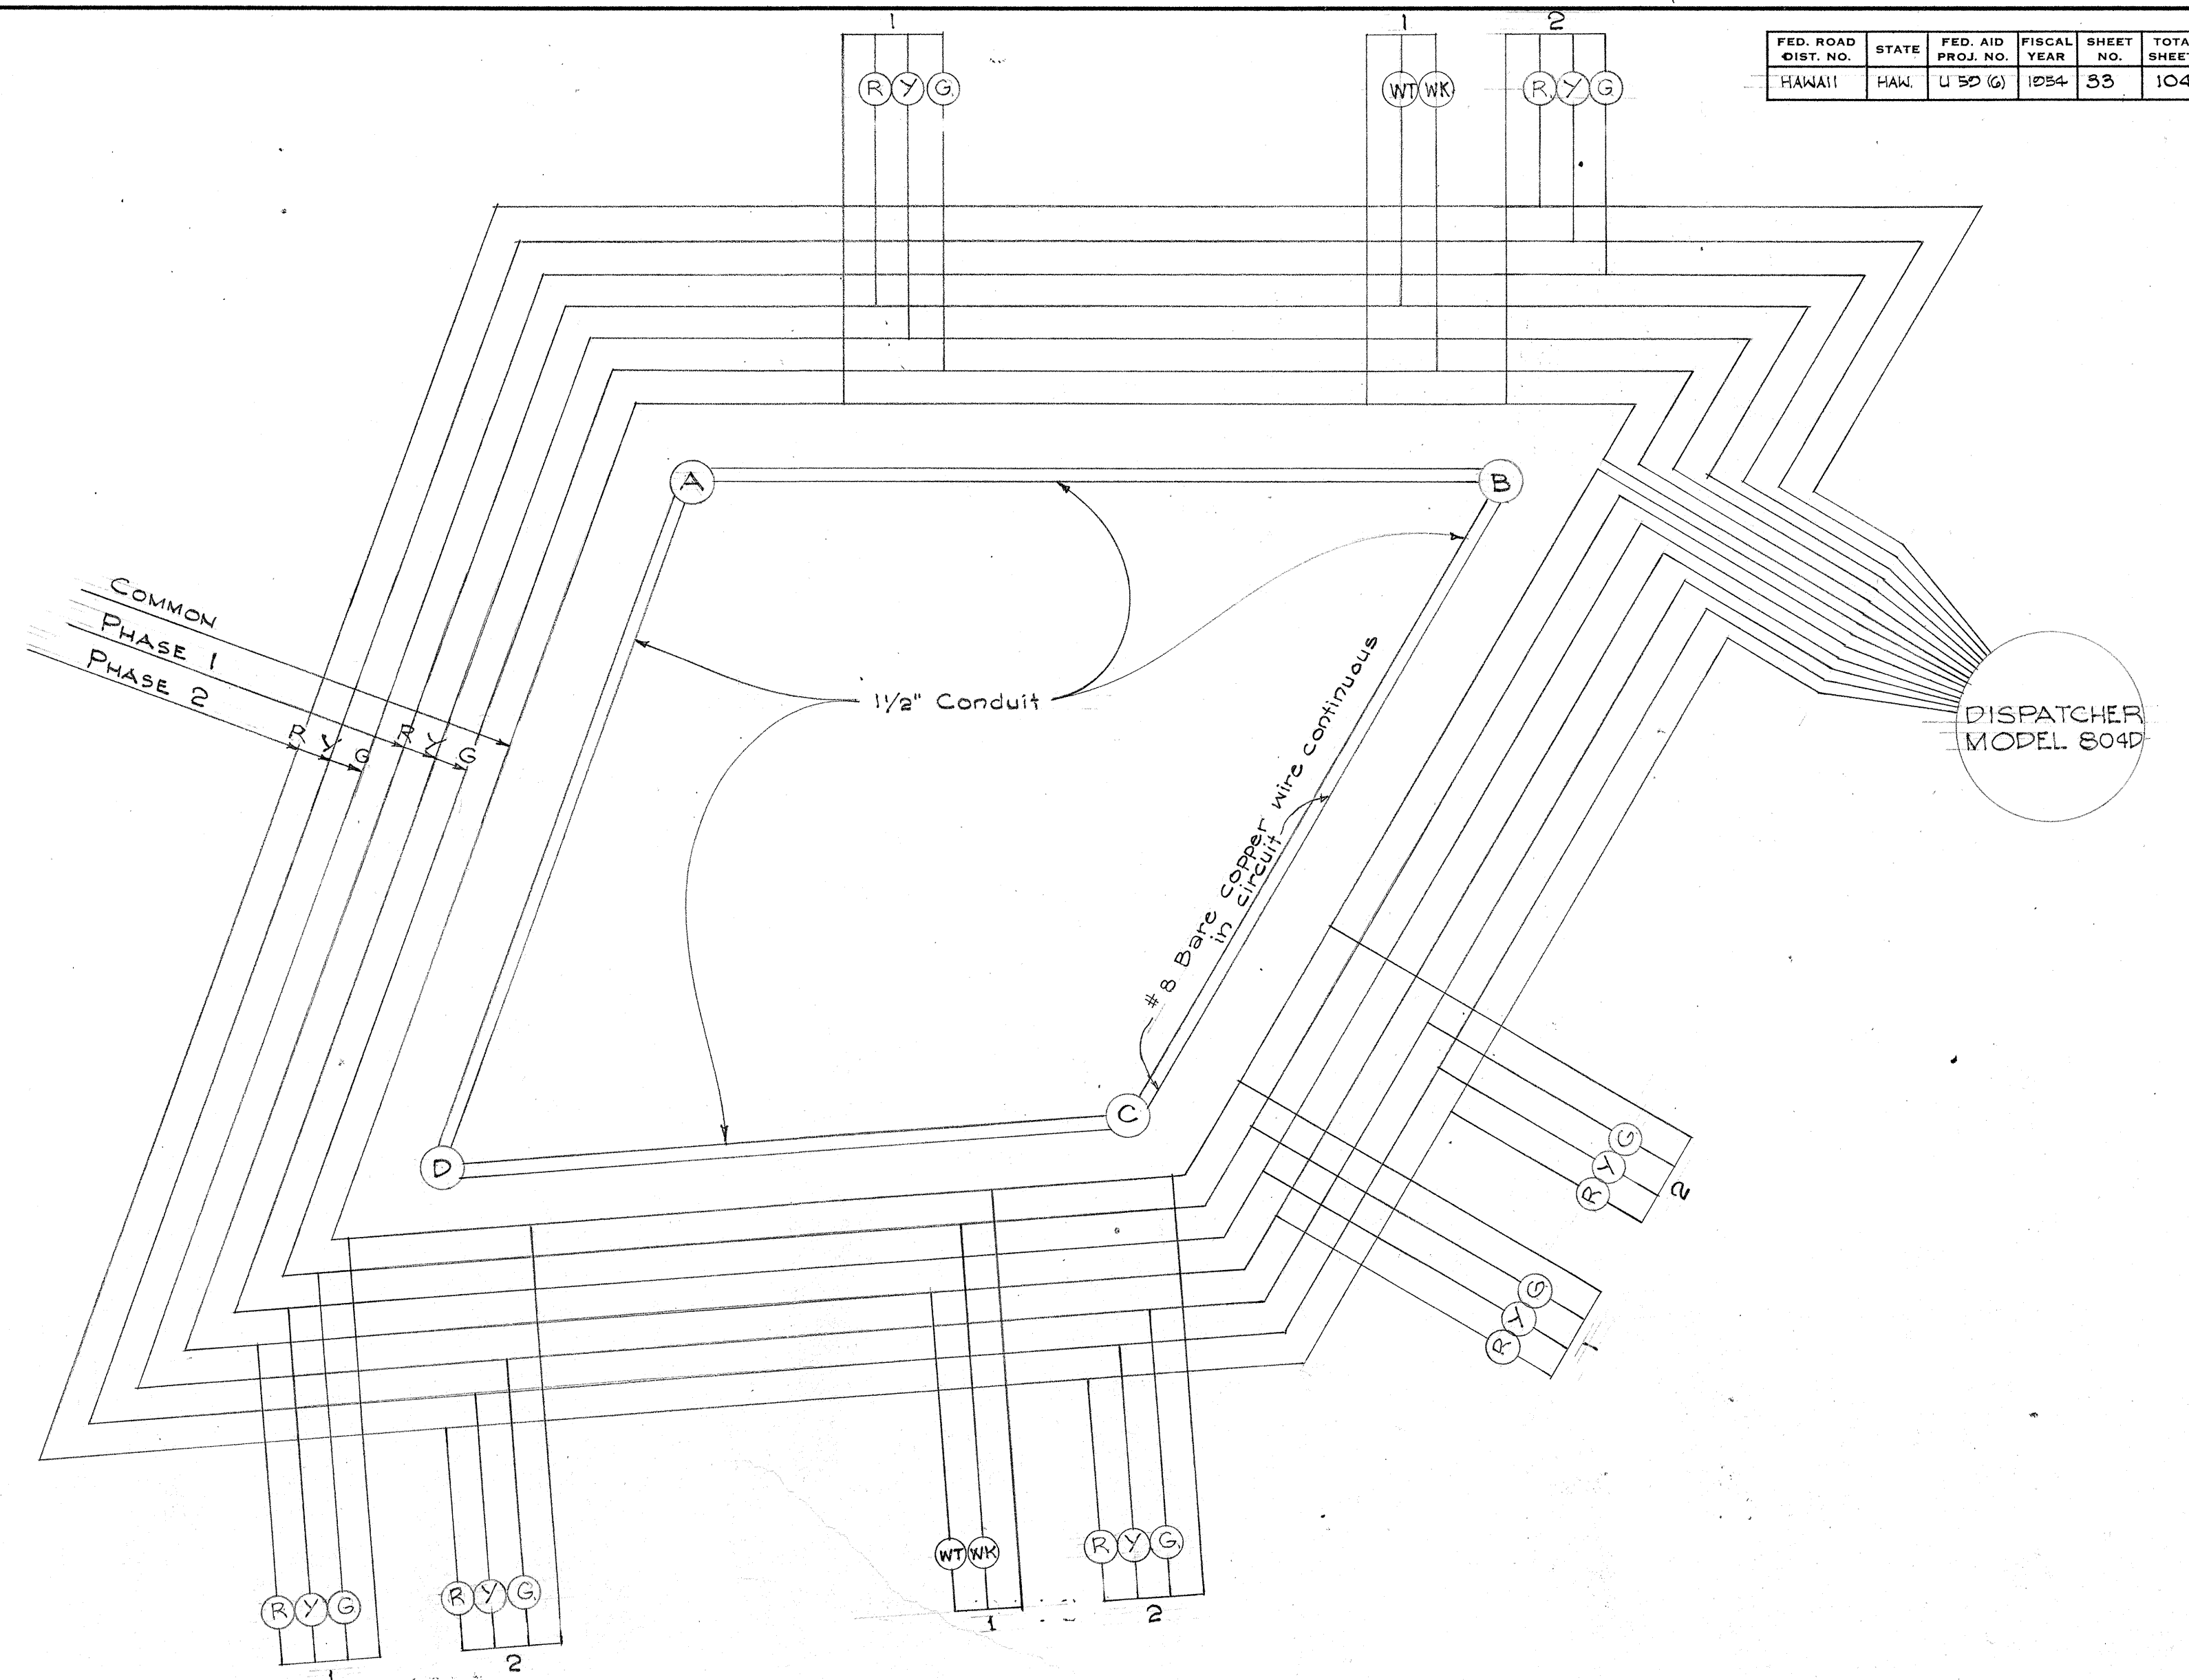


GEOGRAPHICAL CIRCUIT WIRING DIAGRAM
FOR INTERSECTION AT
MAUKA ARTERIAL AND KEEAUMOKU STREET
Not to Scale

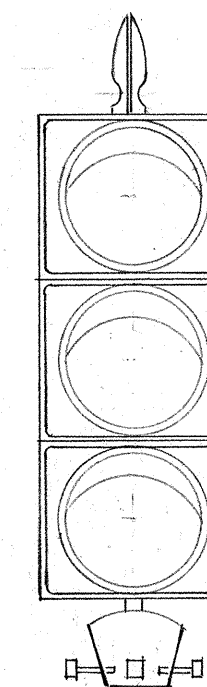


ONE-WAY SIGNAL HEAD
FOR POSTS "A & E"
Scale: 1" = 1'-0"

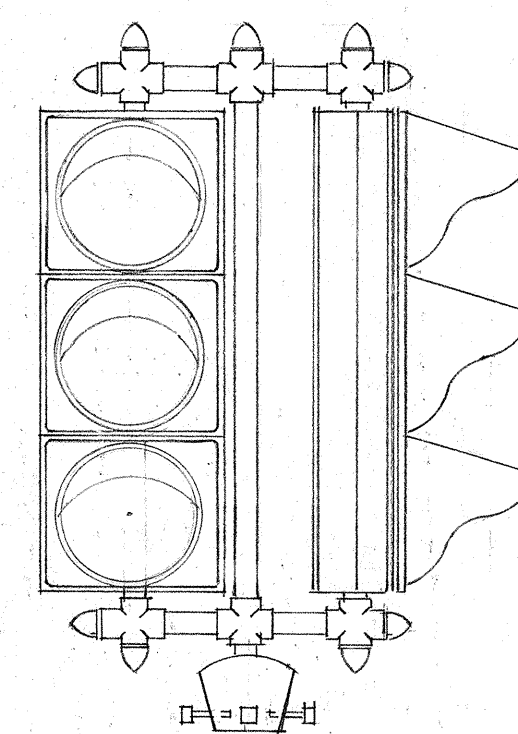

TWO-WAY SIGNAL HEAD
FOR POSTS "D, F & G"
Scale: 1" = 1'-0"

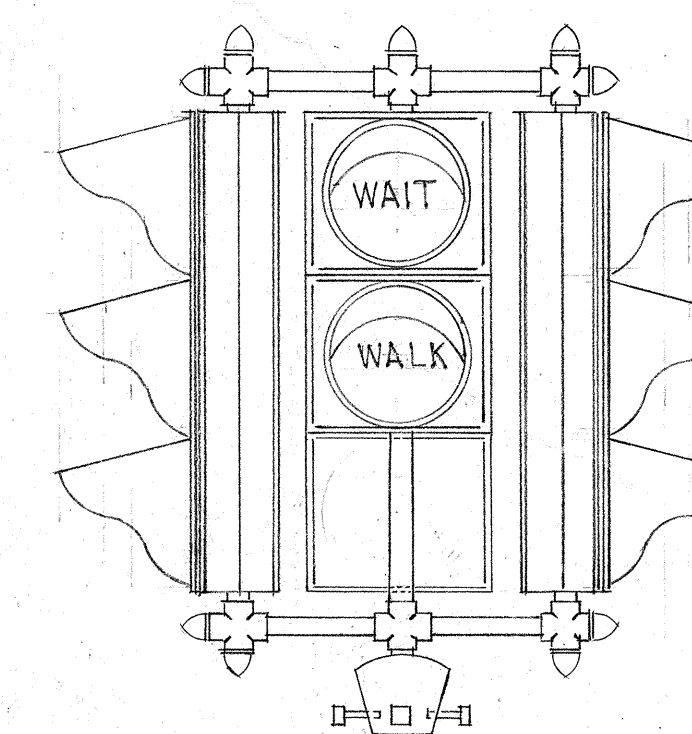

FOUR-WAY SIGNAL HEAD
FOR POST "C"
Scale: 1" = 1'-0"

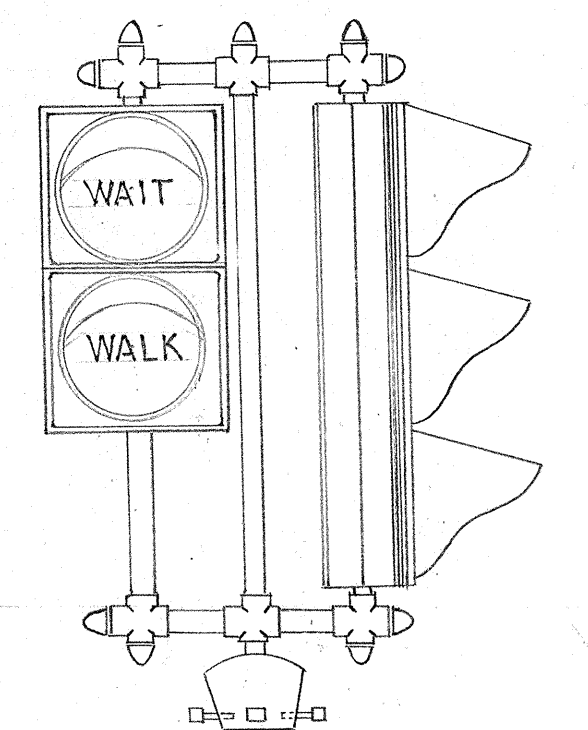


TWO-WAY SIGNAL HEAD
FOR POSTS "B & H"
Scale: 1" = 1'-0"

TERRITORIAL HIGHWAY DEPARTMENT
TERRITORY OF HAWAII
TRAFFIC SIGNAL SYSTEM
MAUKA ARTERIAL at KEEAUMOKU ST.
KEEAUMOKU ST. to ALEXANDER ST.
PROJECT No U 59 (6)
Scale: As Noted UNIT 2 July 1953
SHEET No 1 OF 3 SHEETS

5627.33


FED. ROAD DIST. NO.	STATE	FED. AID PROJ. NO.	FISCAL YEAR	SHEET NO.	TOTAL SHEETS
HAWAII	HAW.	U 59 (6)	1954	33A	104

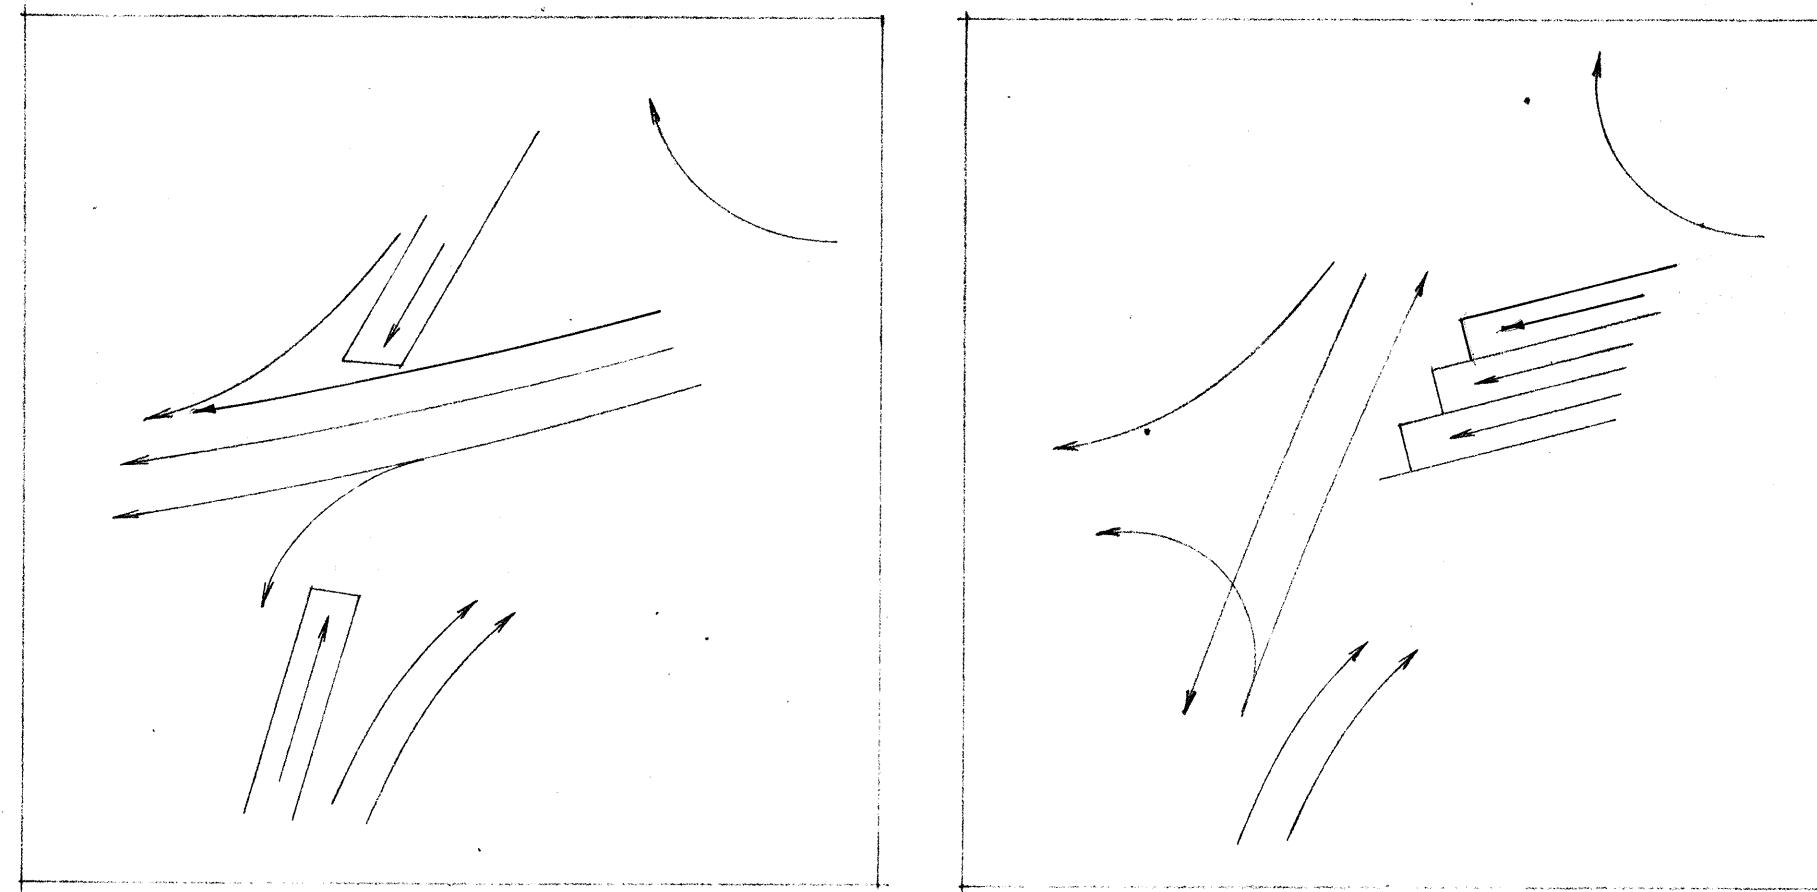


PHASE 1

PHASE 2

NOTE:
Pavement Marking not in Contract.

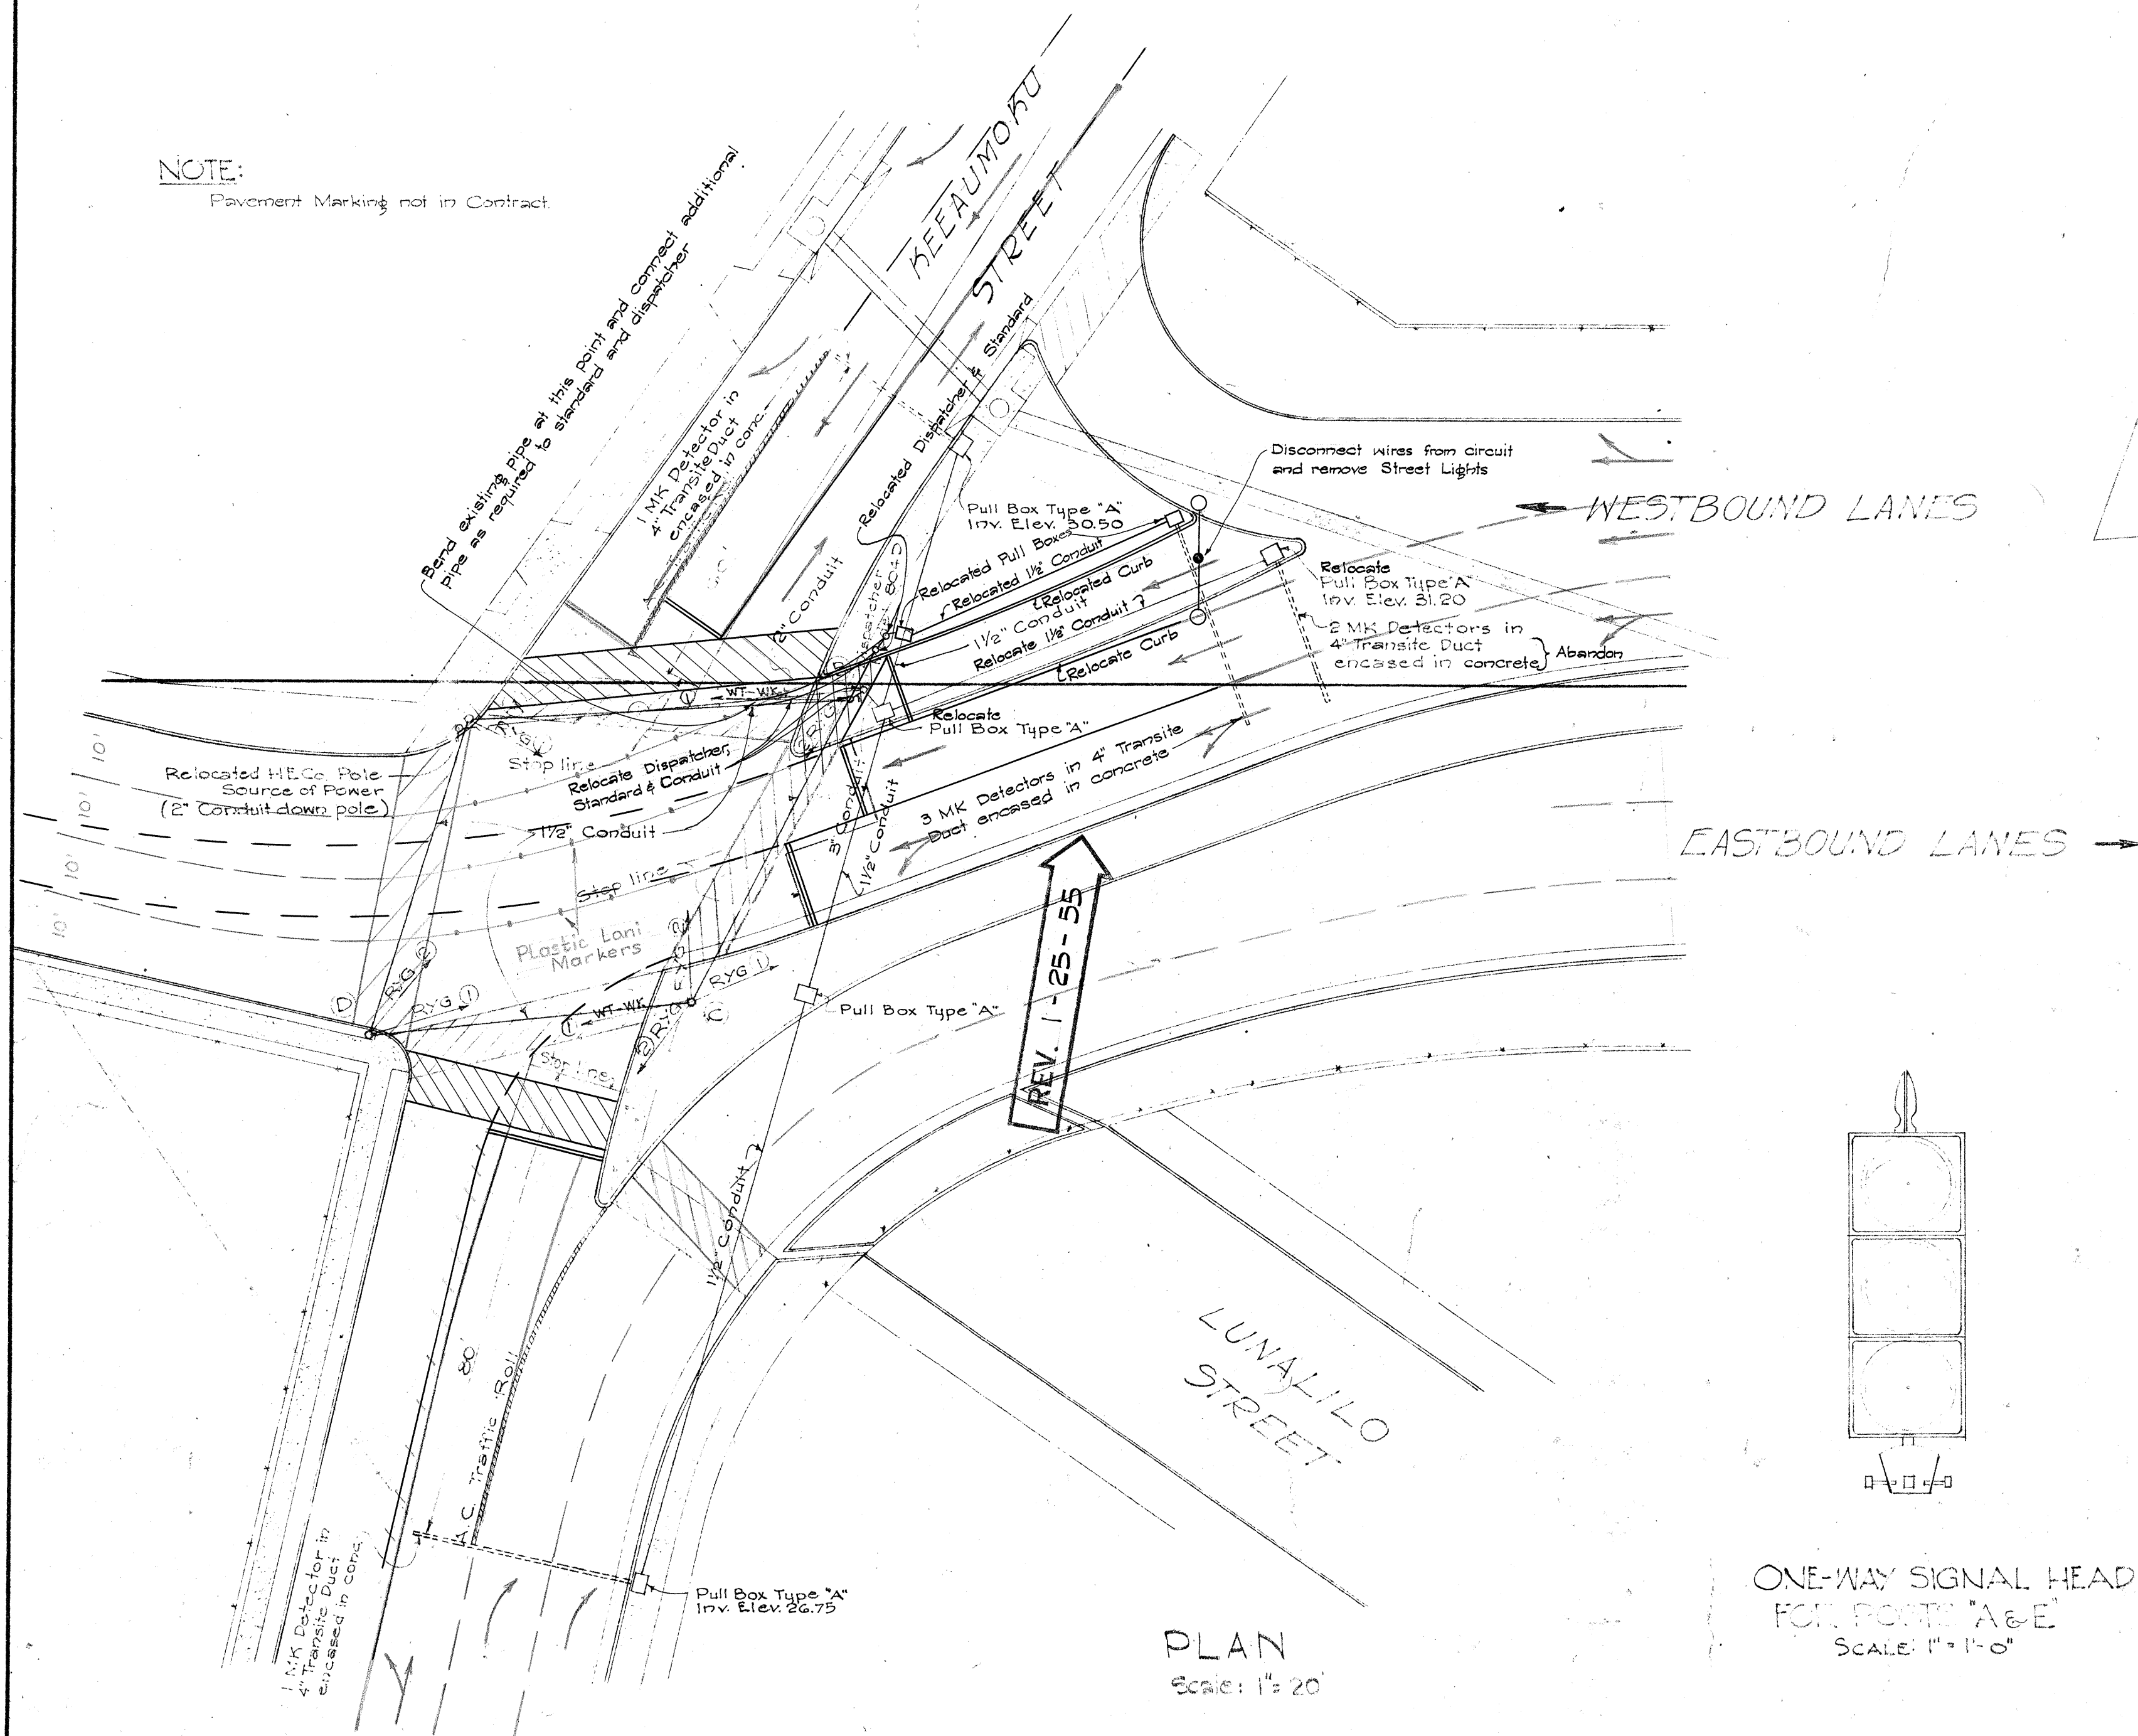

PLAN
Scale: 1" = 20'

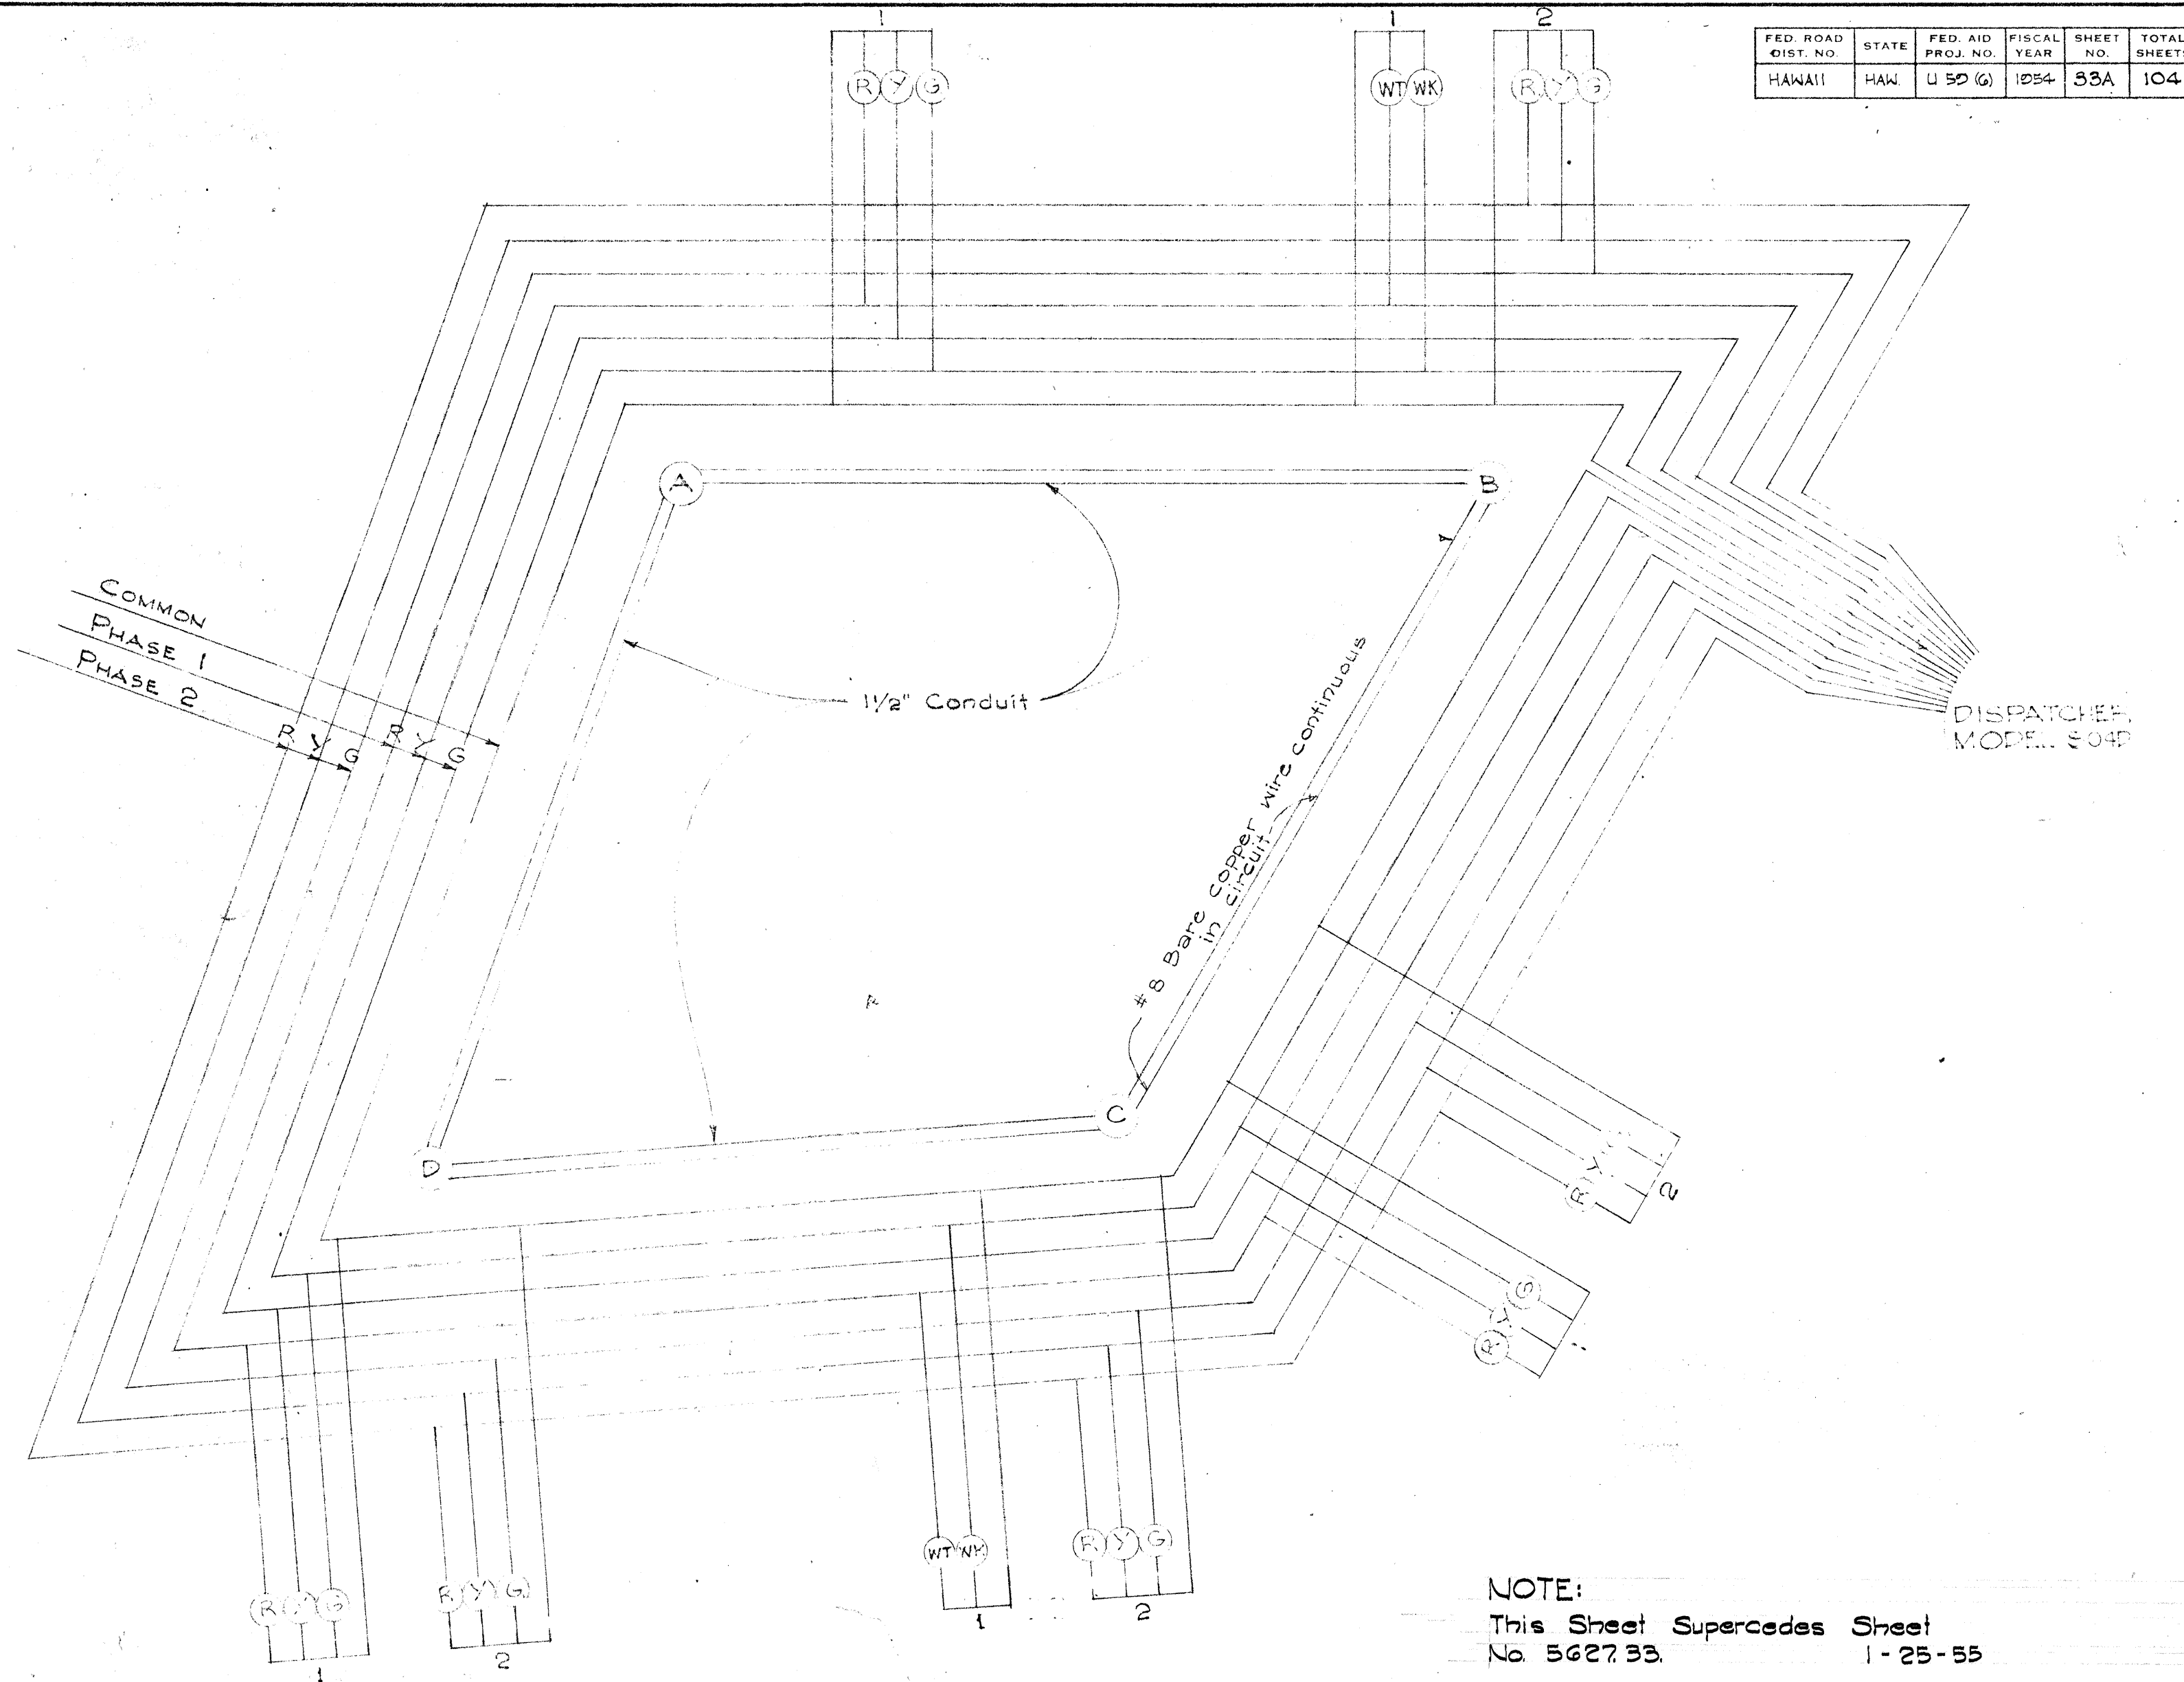


GEOGRAPHICAL CIRCUIT WIRING DIAGRAM
FOR INTERSECTION AT
MAUKA ARTERIAL AND KEEAUMOKU STREET
Not to Scale


NOTE:
This Sheet Supersedes Sheet
No. 5627.33 1-25-55




ONE-WAY SIGNAL HEAD
FOR POSTS "A" & "E"
Scale: 1" = 1'-0"

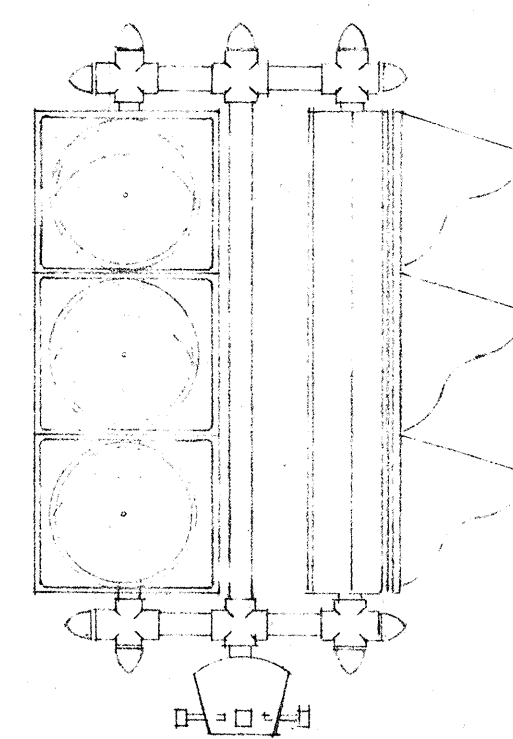

TWO-WAY SIGNAL HEAD
FOR POSTS "D", "F", & "G"
Scale: 1" = 1'-0"

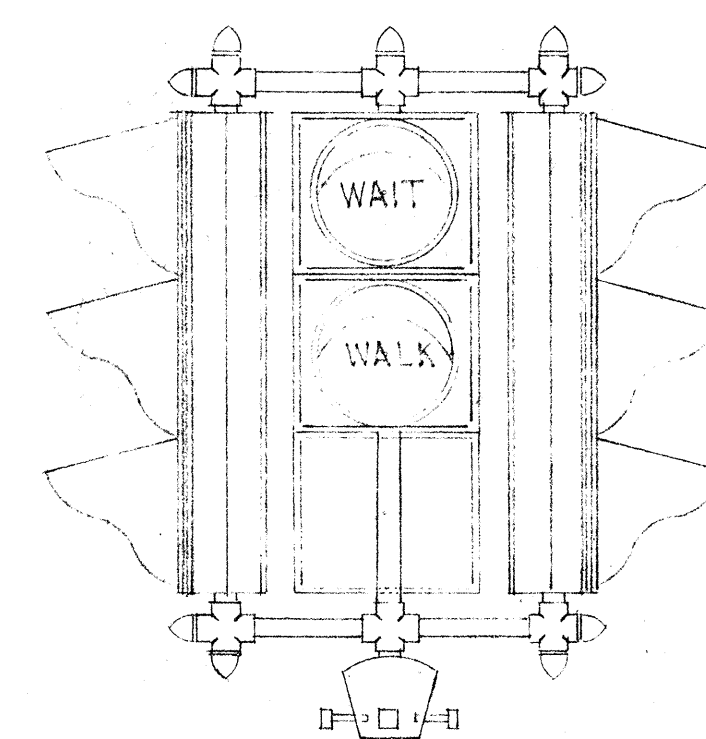

FOUR-WAY SIGNAL HEAD
FOR POST "C"
Scale: 1" = 1'-0"

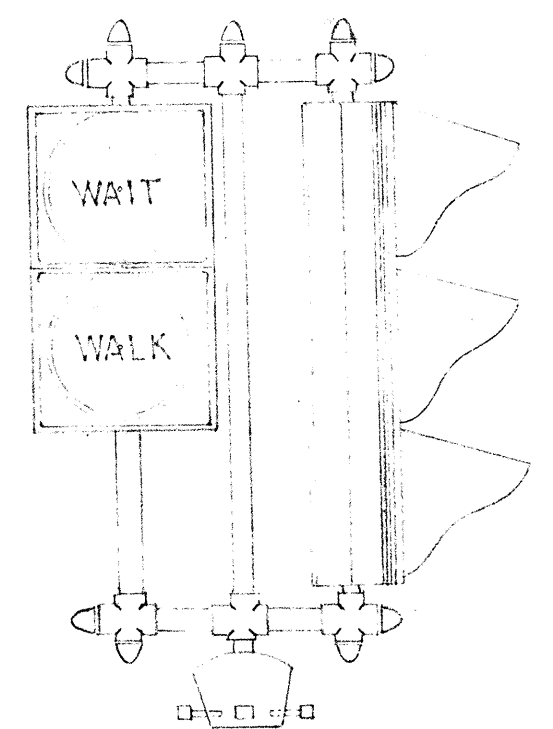


TWO-WAY SIGNAL HEAD
FOR POSTS "B" & "H"
Scale: 1" = 1'-0"

TERRITORIAL HIGHWAY DEPARTMENT
TERRITORY OF HAWAII
TRAFFIC SIGNAL SYSTEM
MAUKA ARTERIAL AT KEEAUMOKU ST.
KEEAUMOKU ST. TO ALEXANDER ST.
PROJECT No. U 59 (6)
Scale: As Shown UNIT 2 July 1953
SHEET No. 1 OF 3 SHEETS

5627.33A

ORIGINAL PLAN	SURVEY PLOTTED BY.....	DATE.....
NOTE BOOK	DESIGNED BY.....	44
	DRAWN BY.....	44
	TRACED BY.....	44
	QUANTITIES BY.....	44
No.....	CHECKED BY.....	44

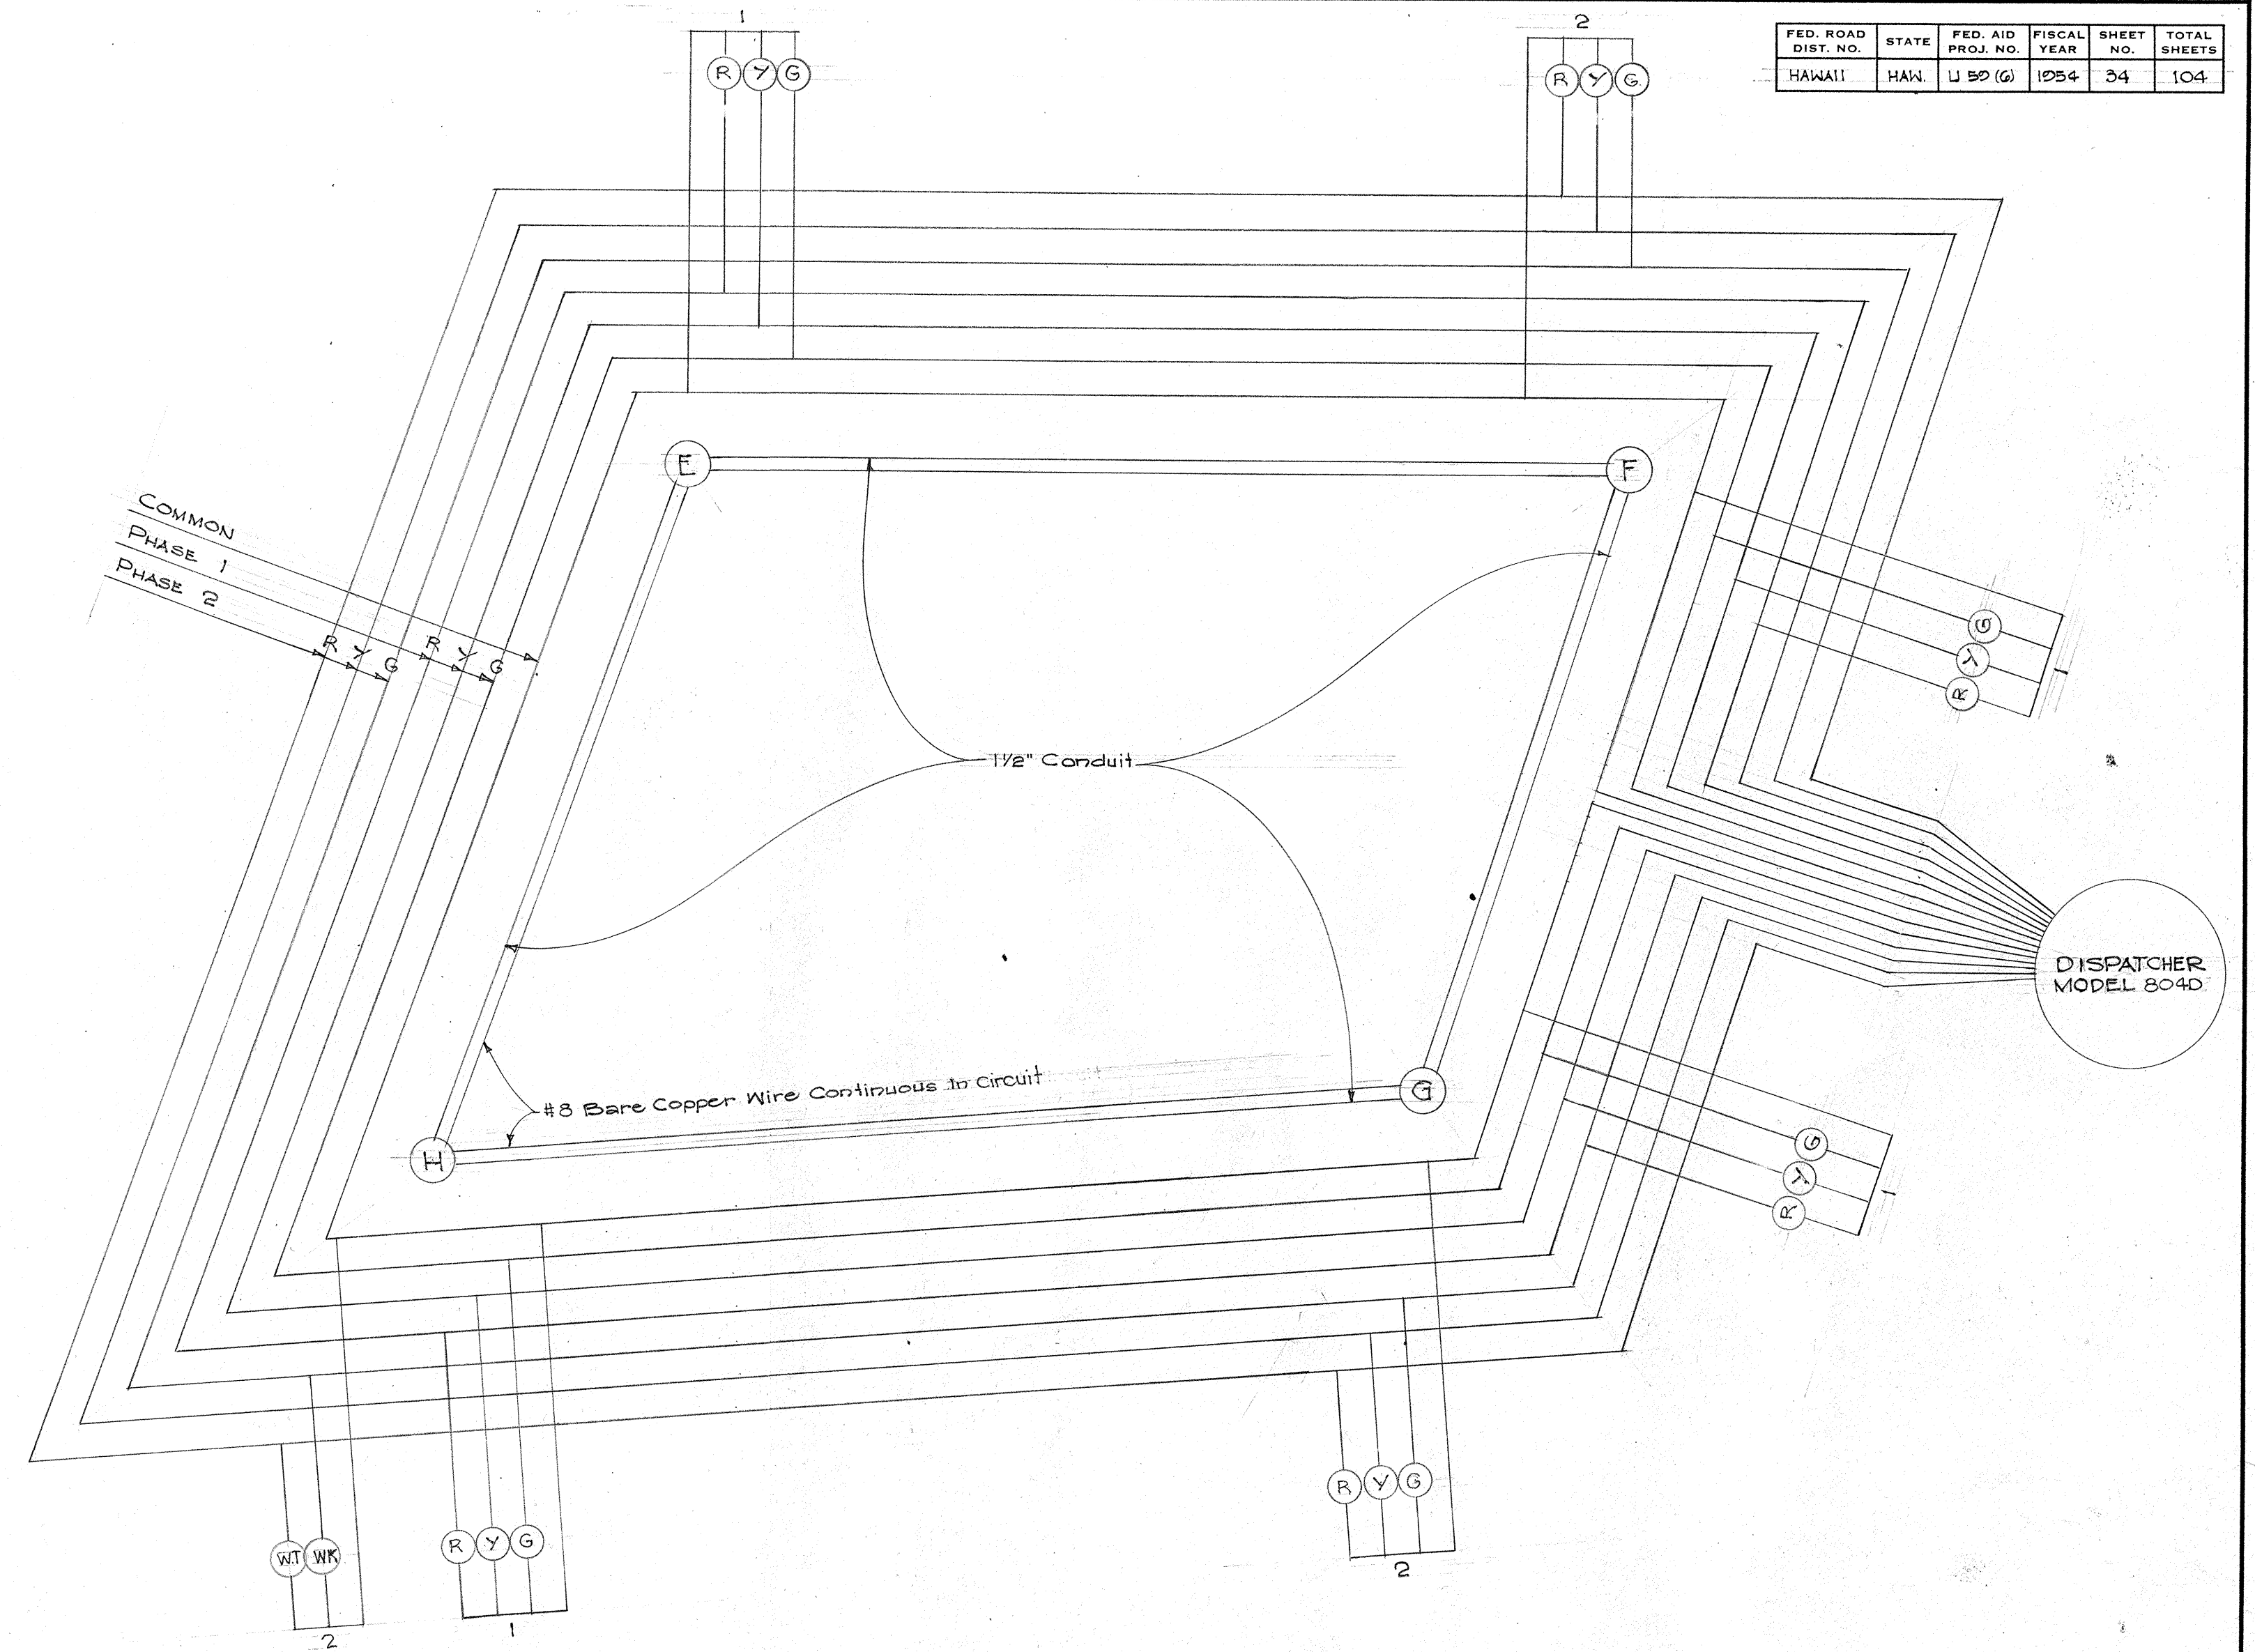

PHASE I

PHASE II







PHASE 2

625 3341

5627.34





5627.34

FED. ROAD DIST. NO.	STATE	FED. AID PROJ. NO.	FISCAL YEAR	SHEET NO.	TOTAL SHEETS
HAWAII	HAW.	U 59 (6)	1954	35	104

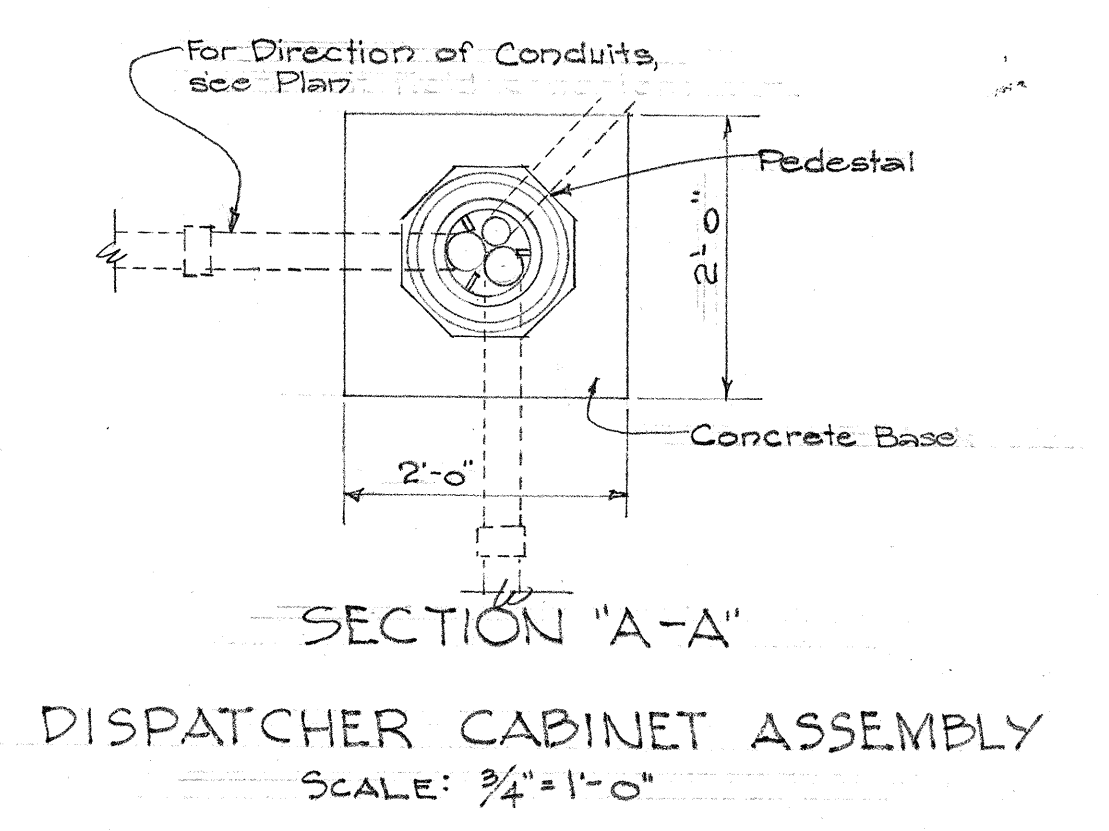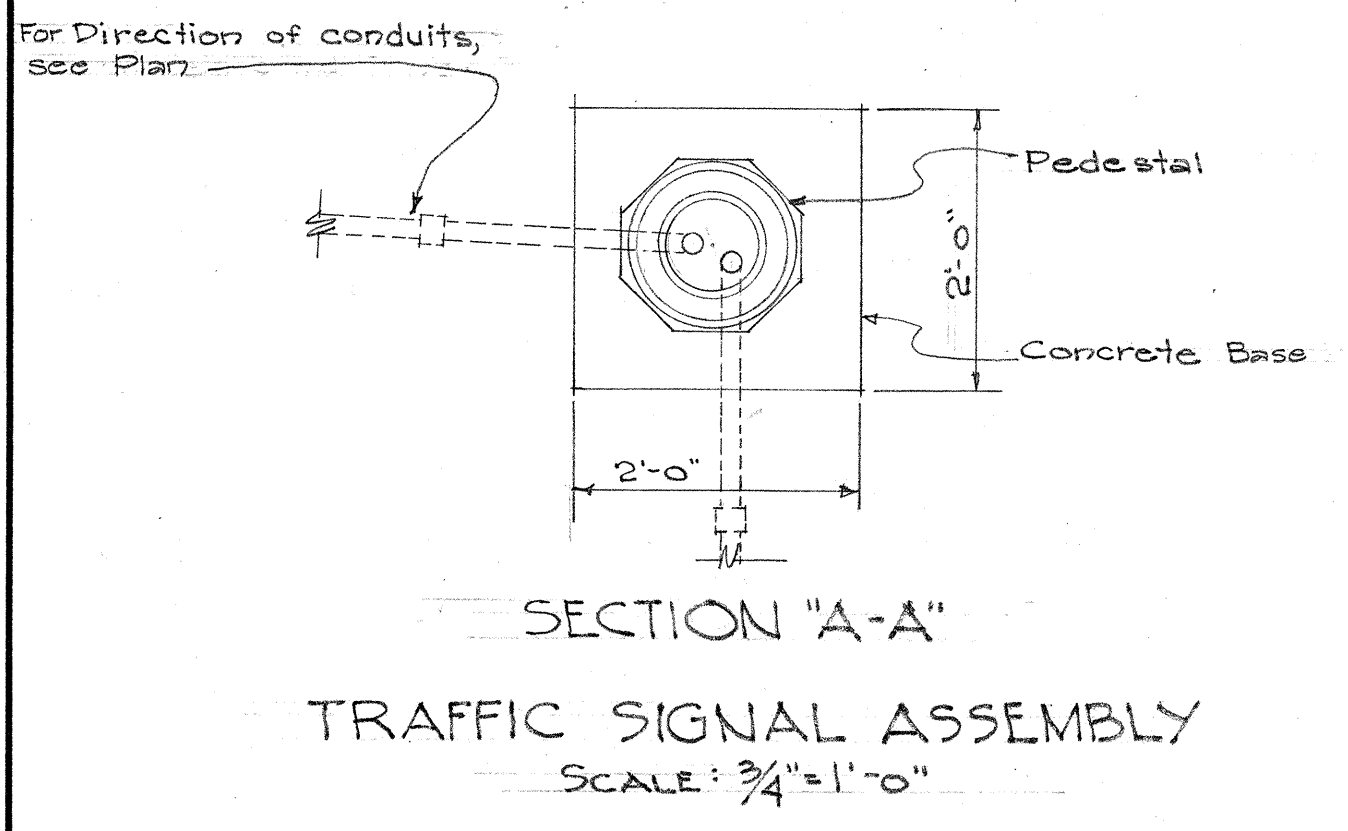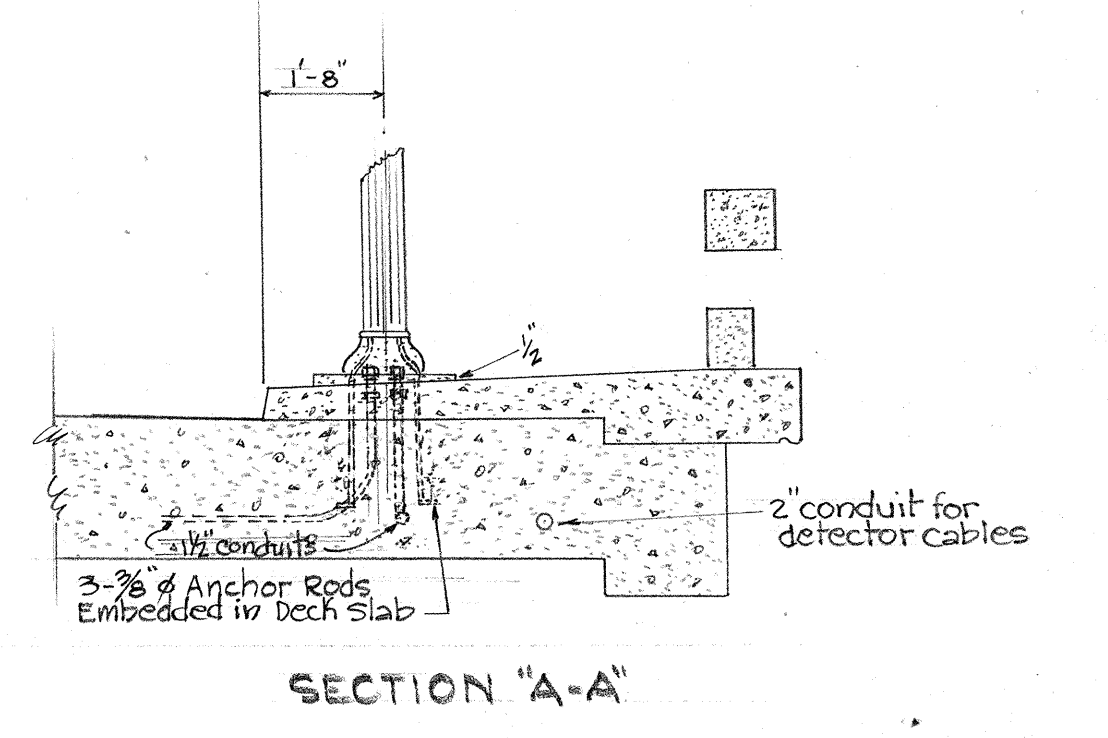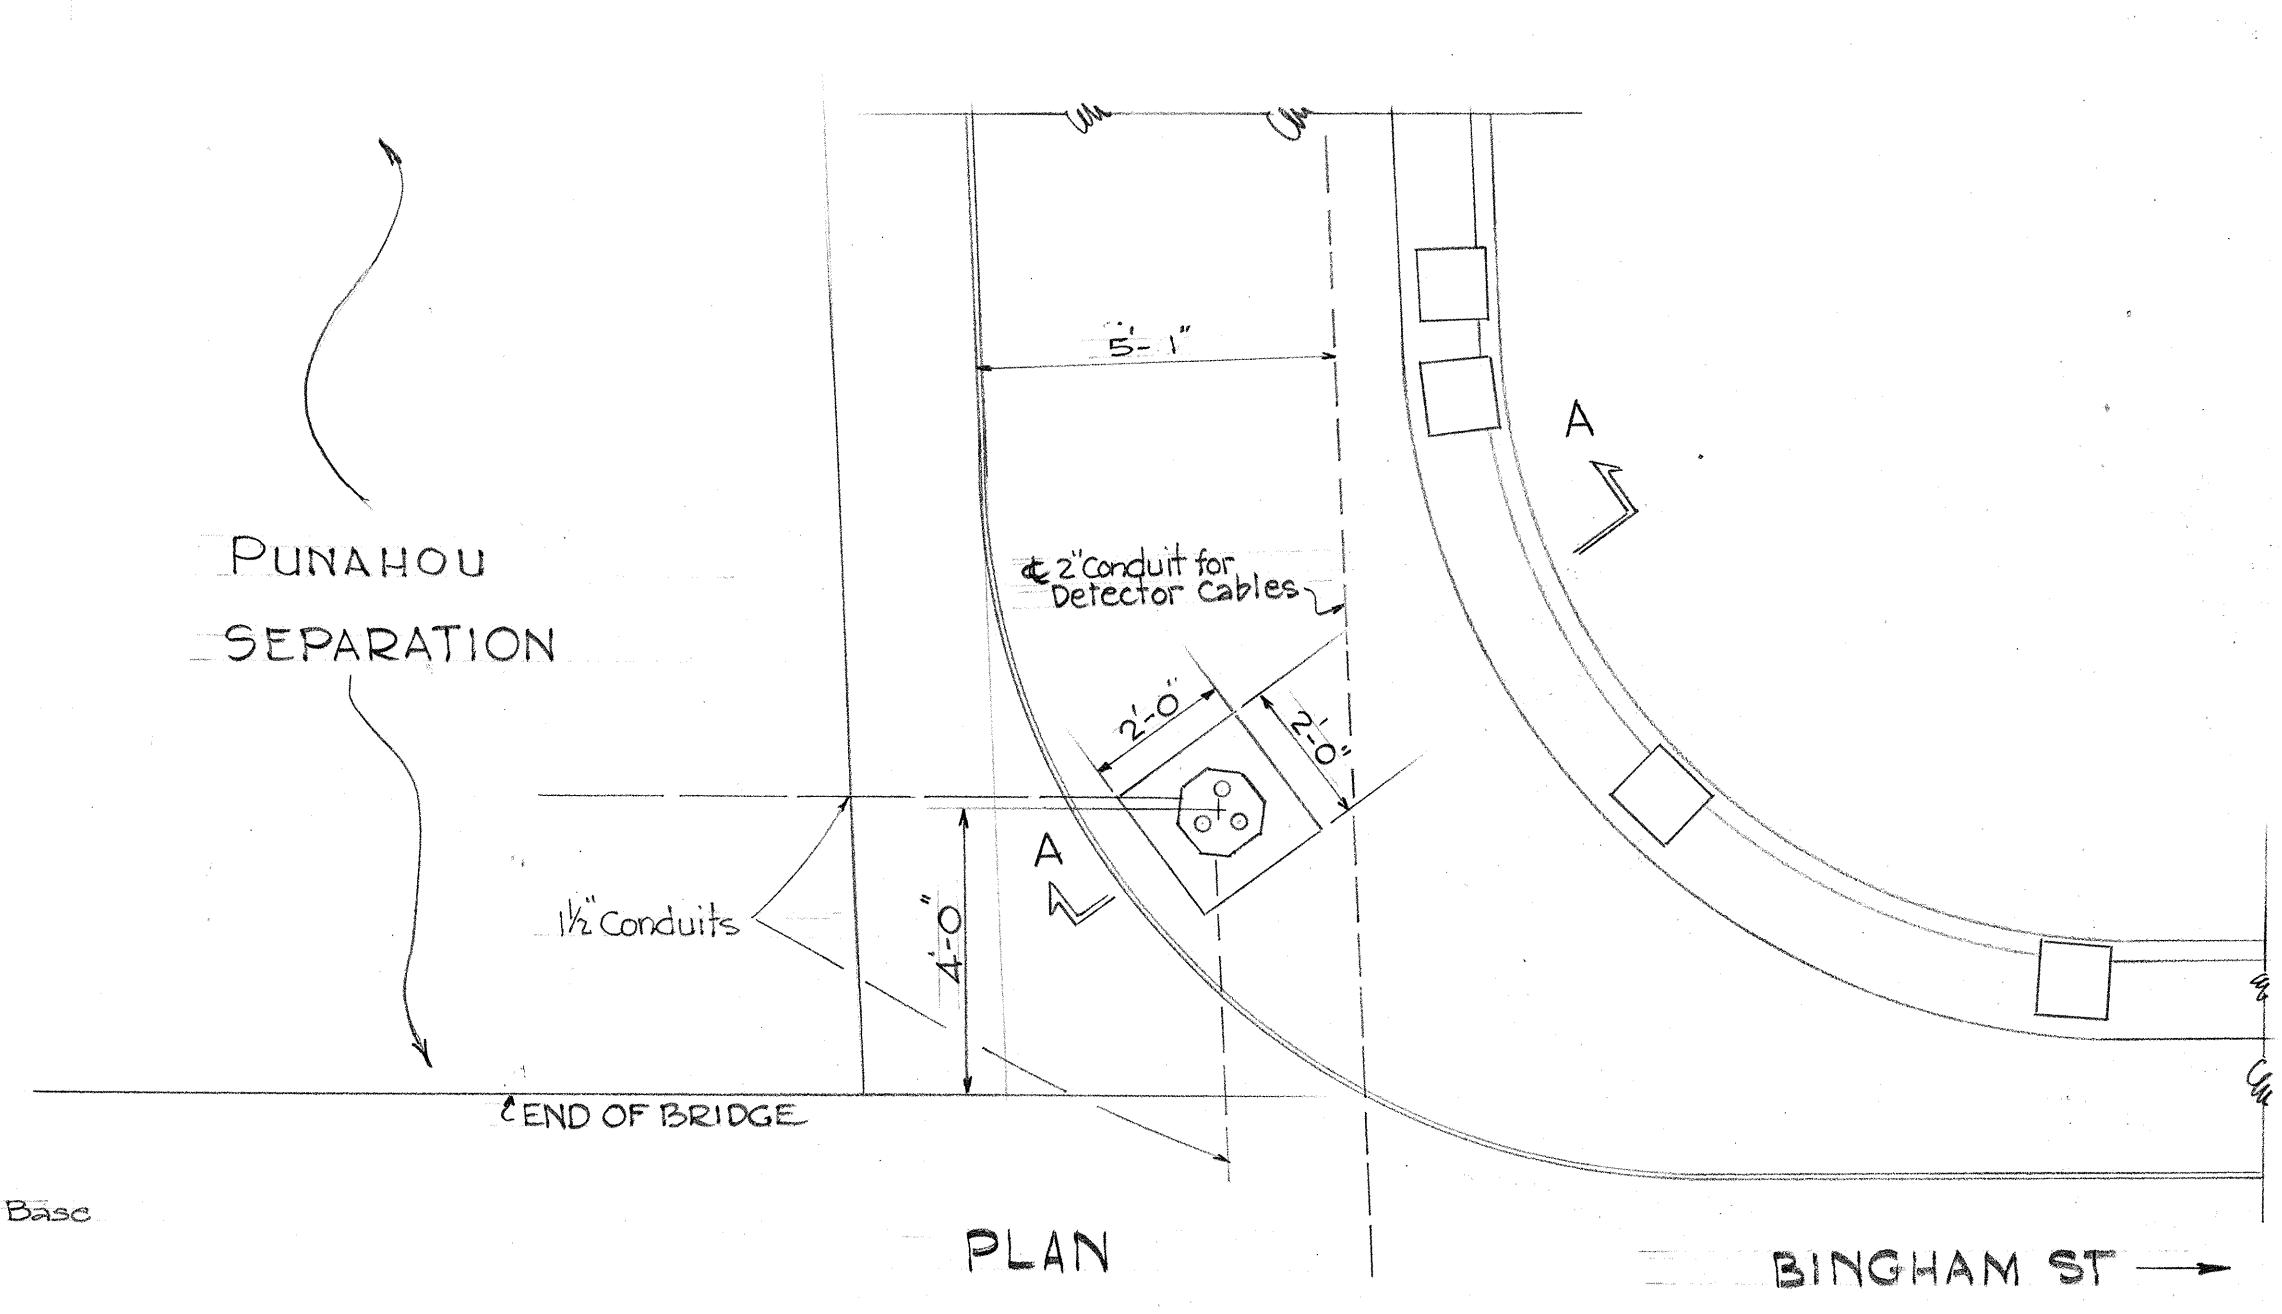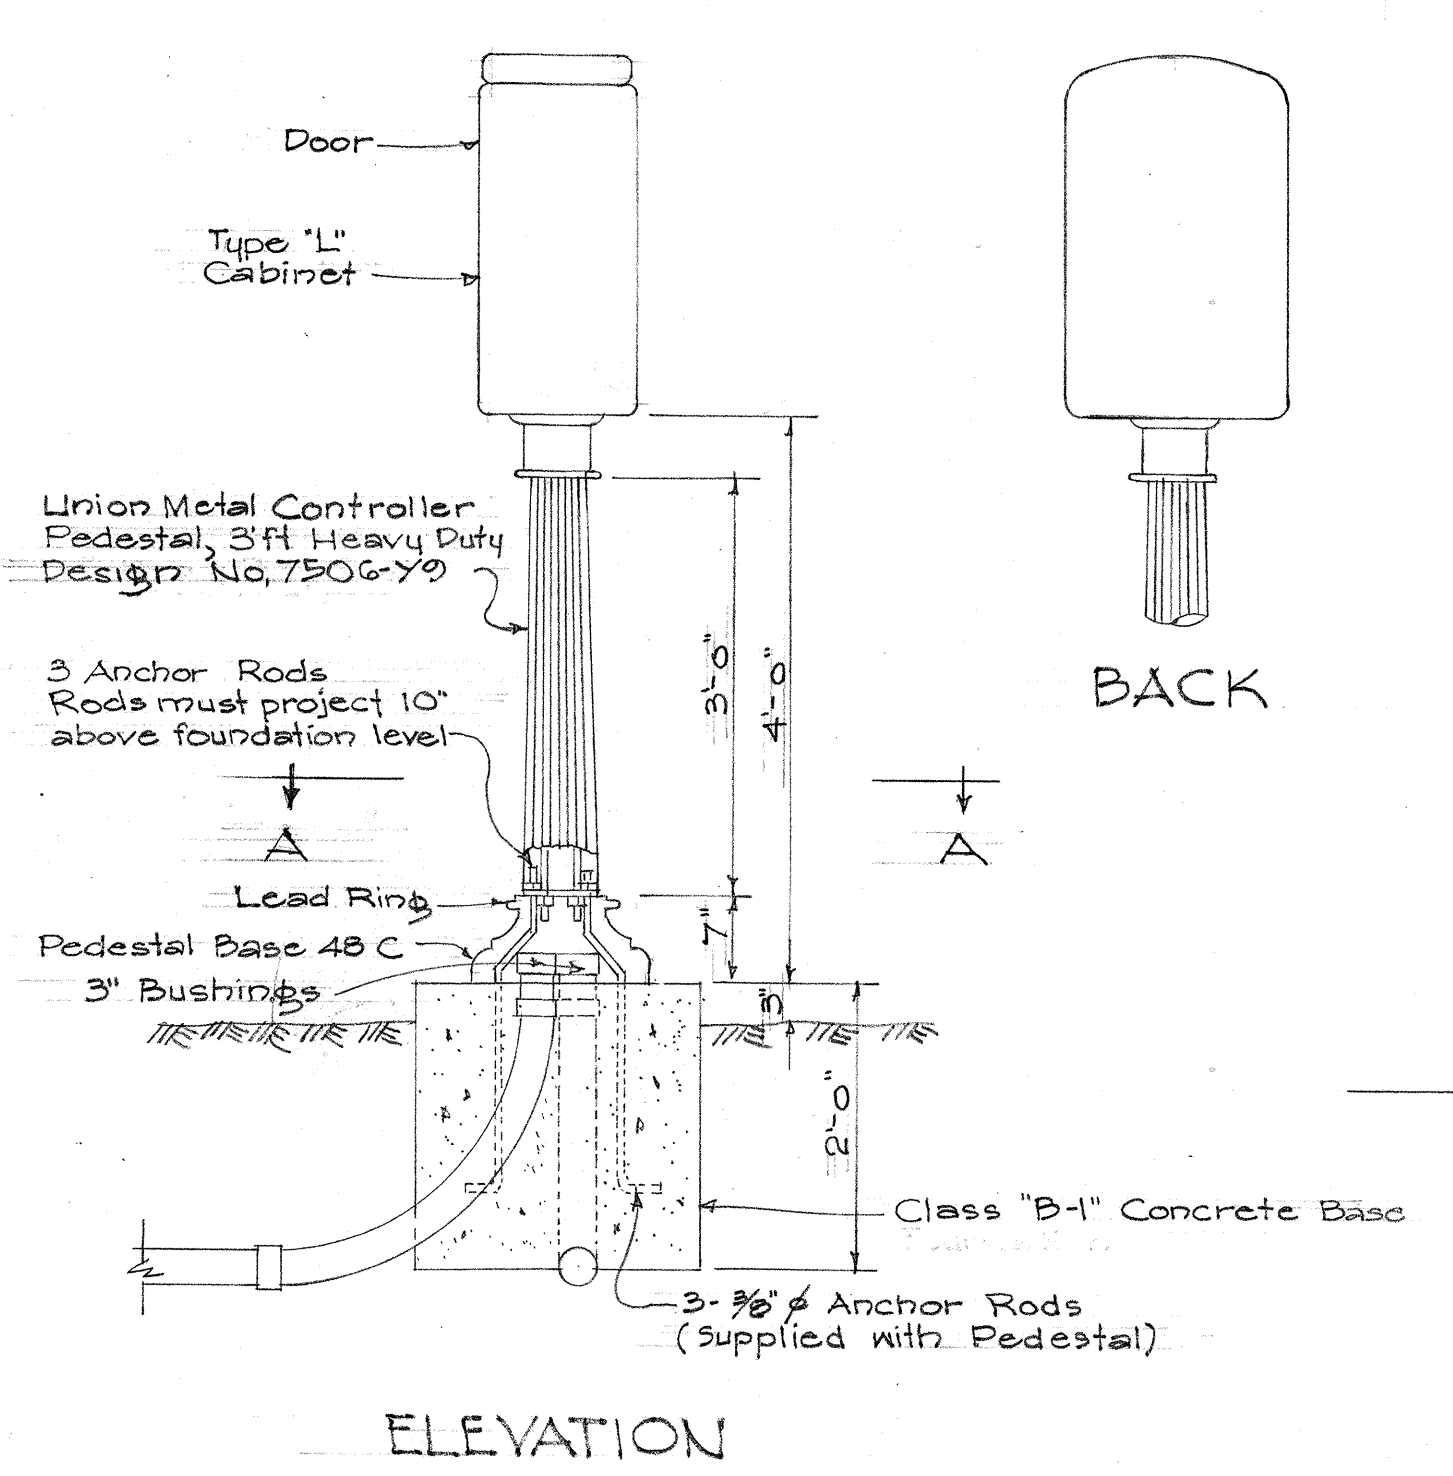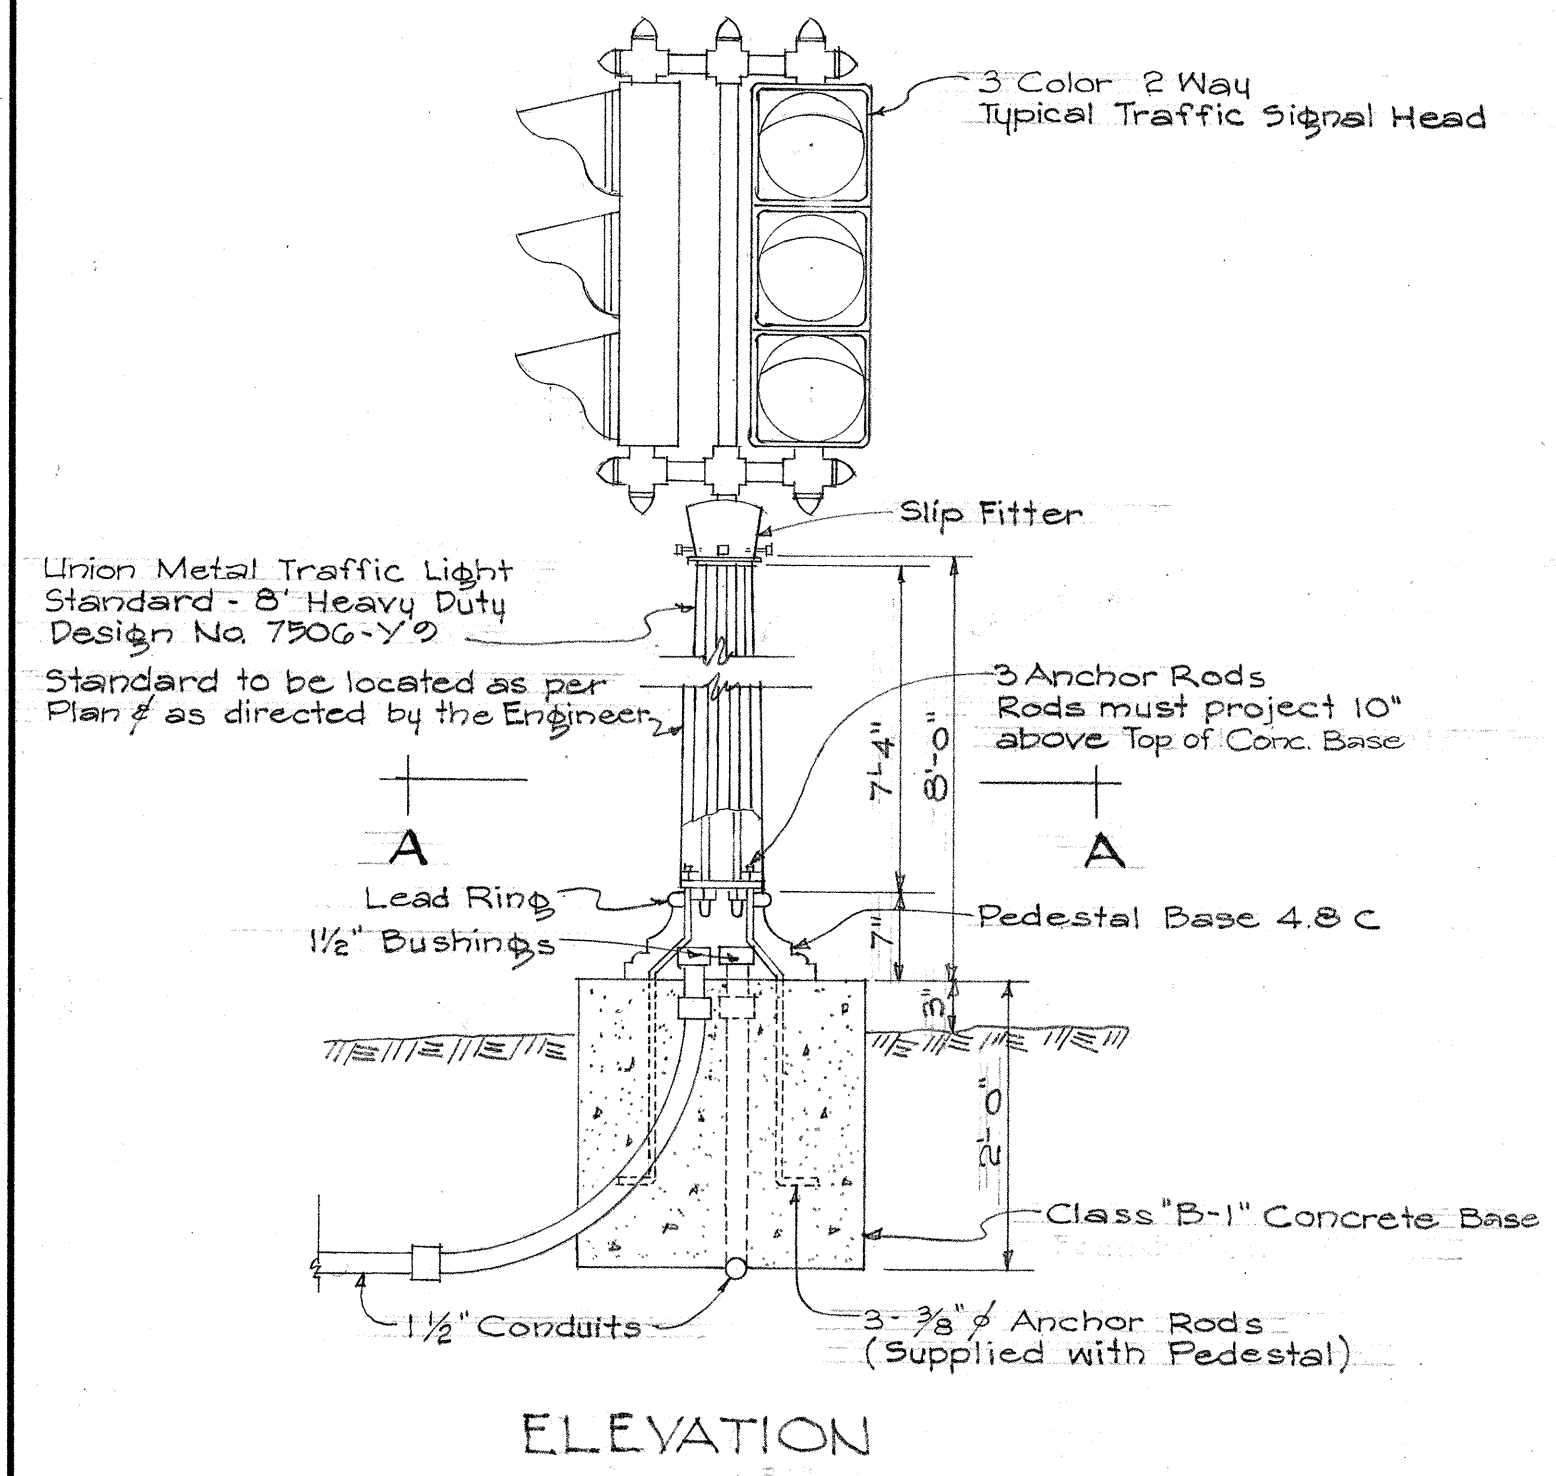

LOCATION DETAIL FOR SIGNAL "F"
Scale 3/8" = 1'-0"

NOTE:
Signal "E" Similar But
Opposite Hand

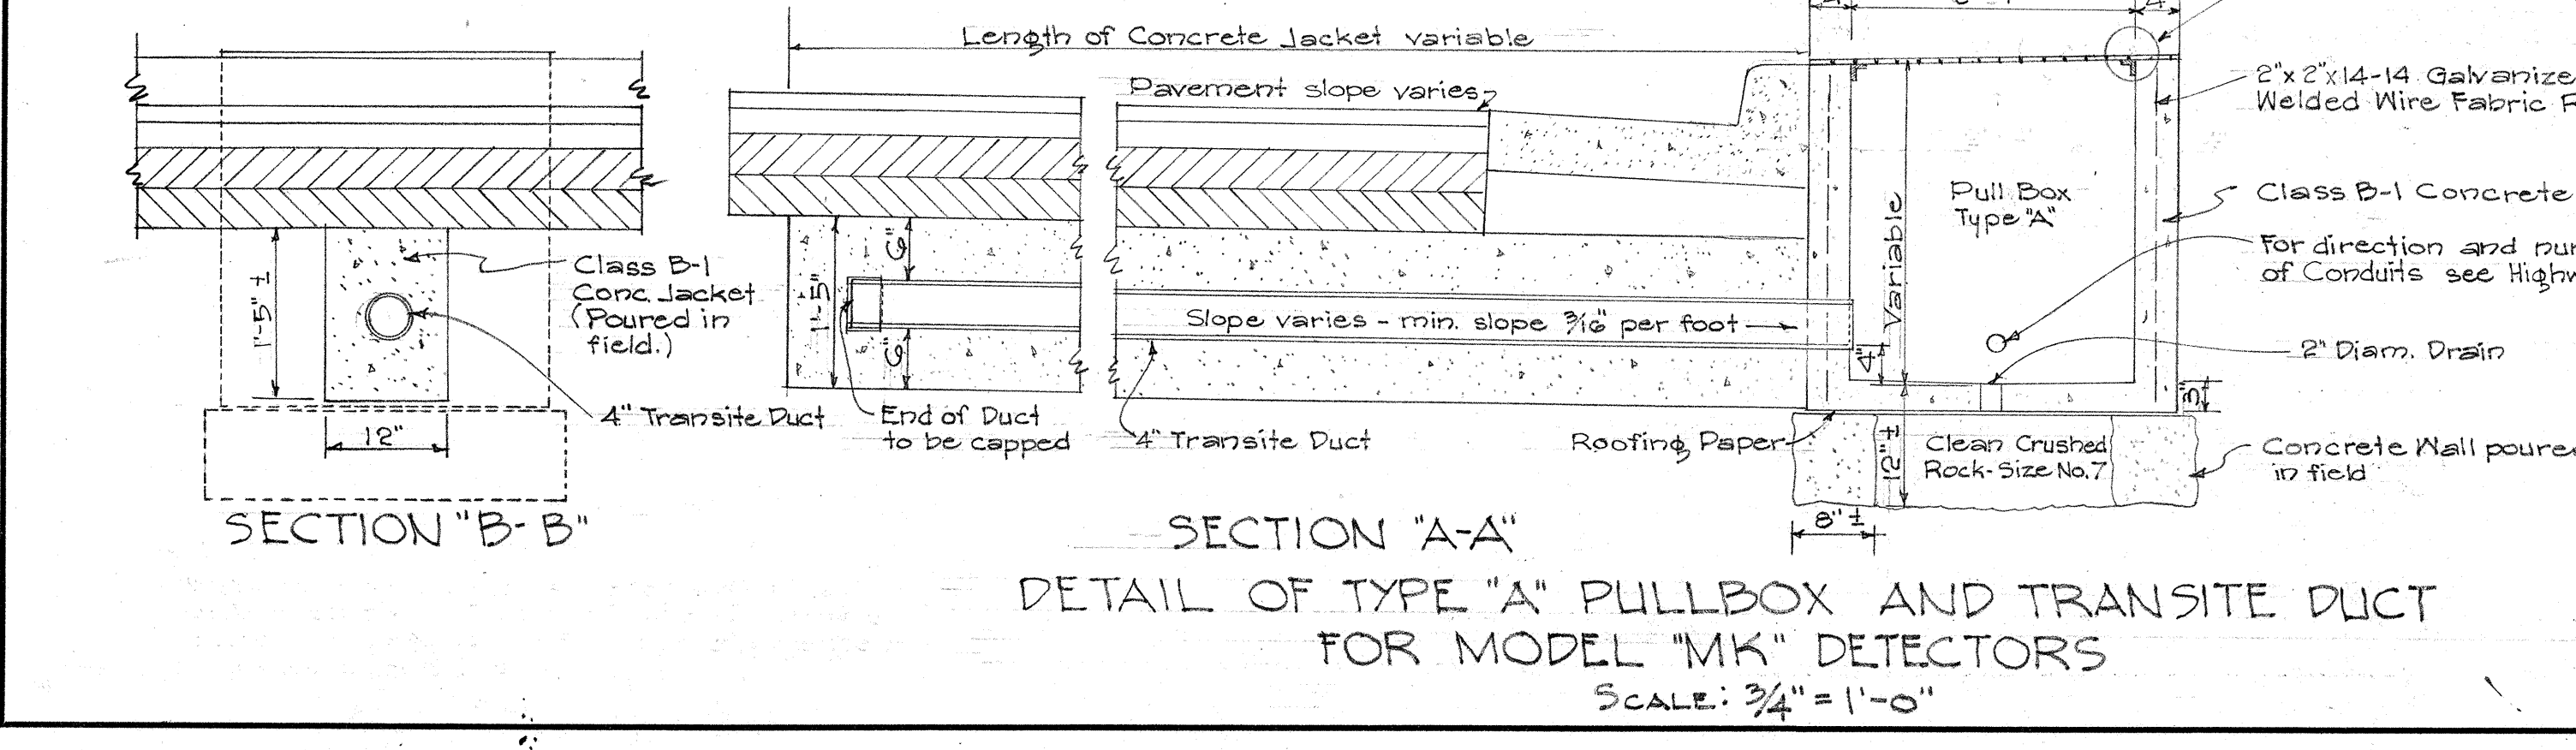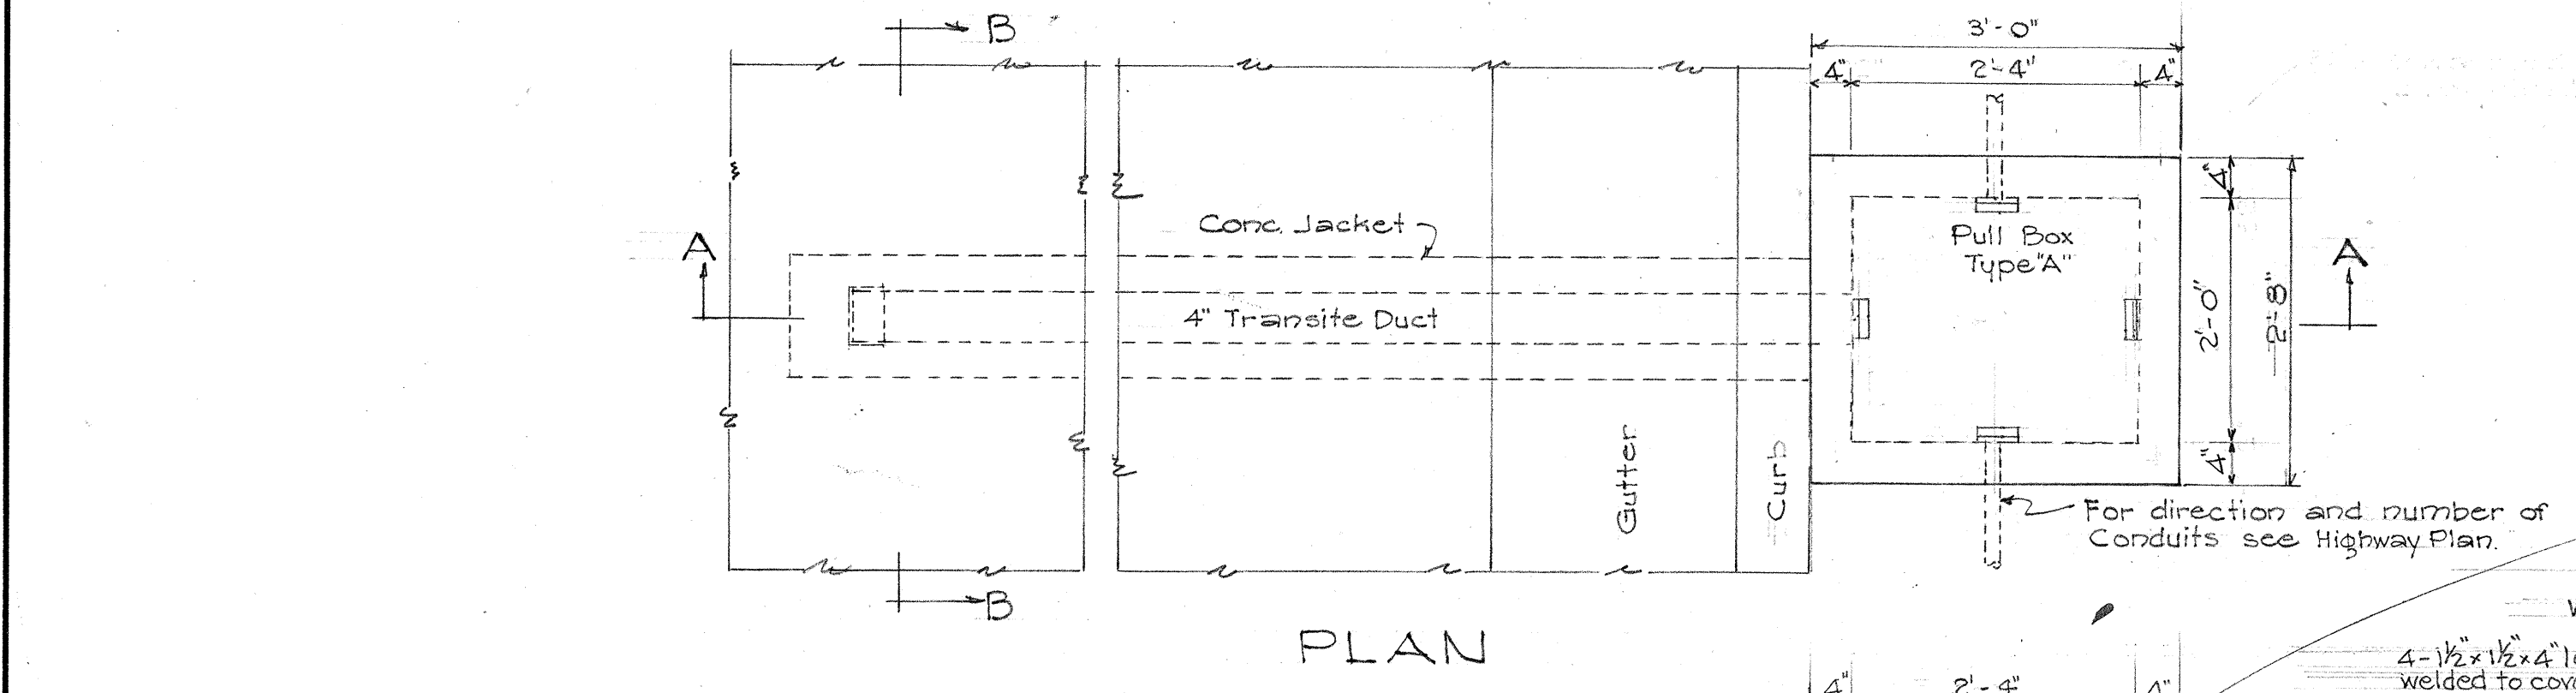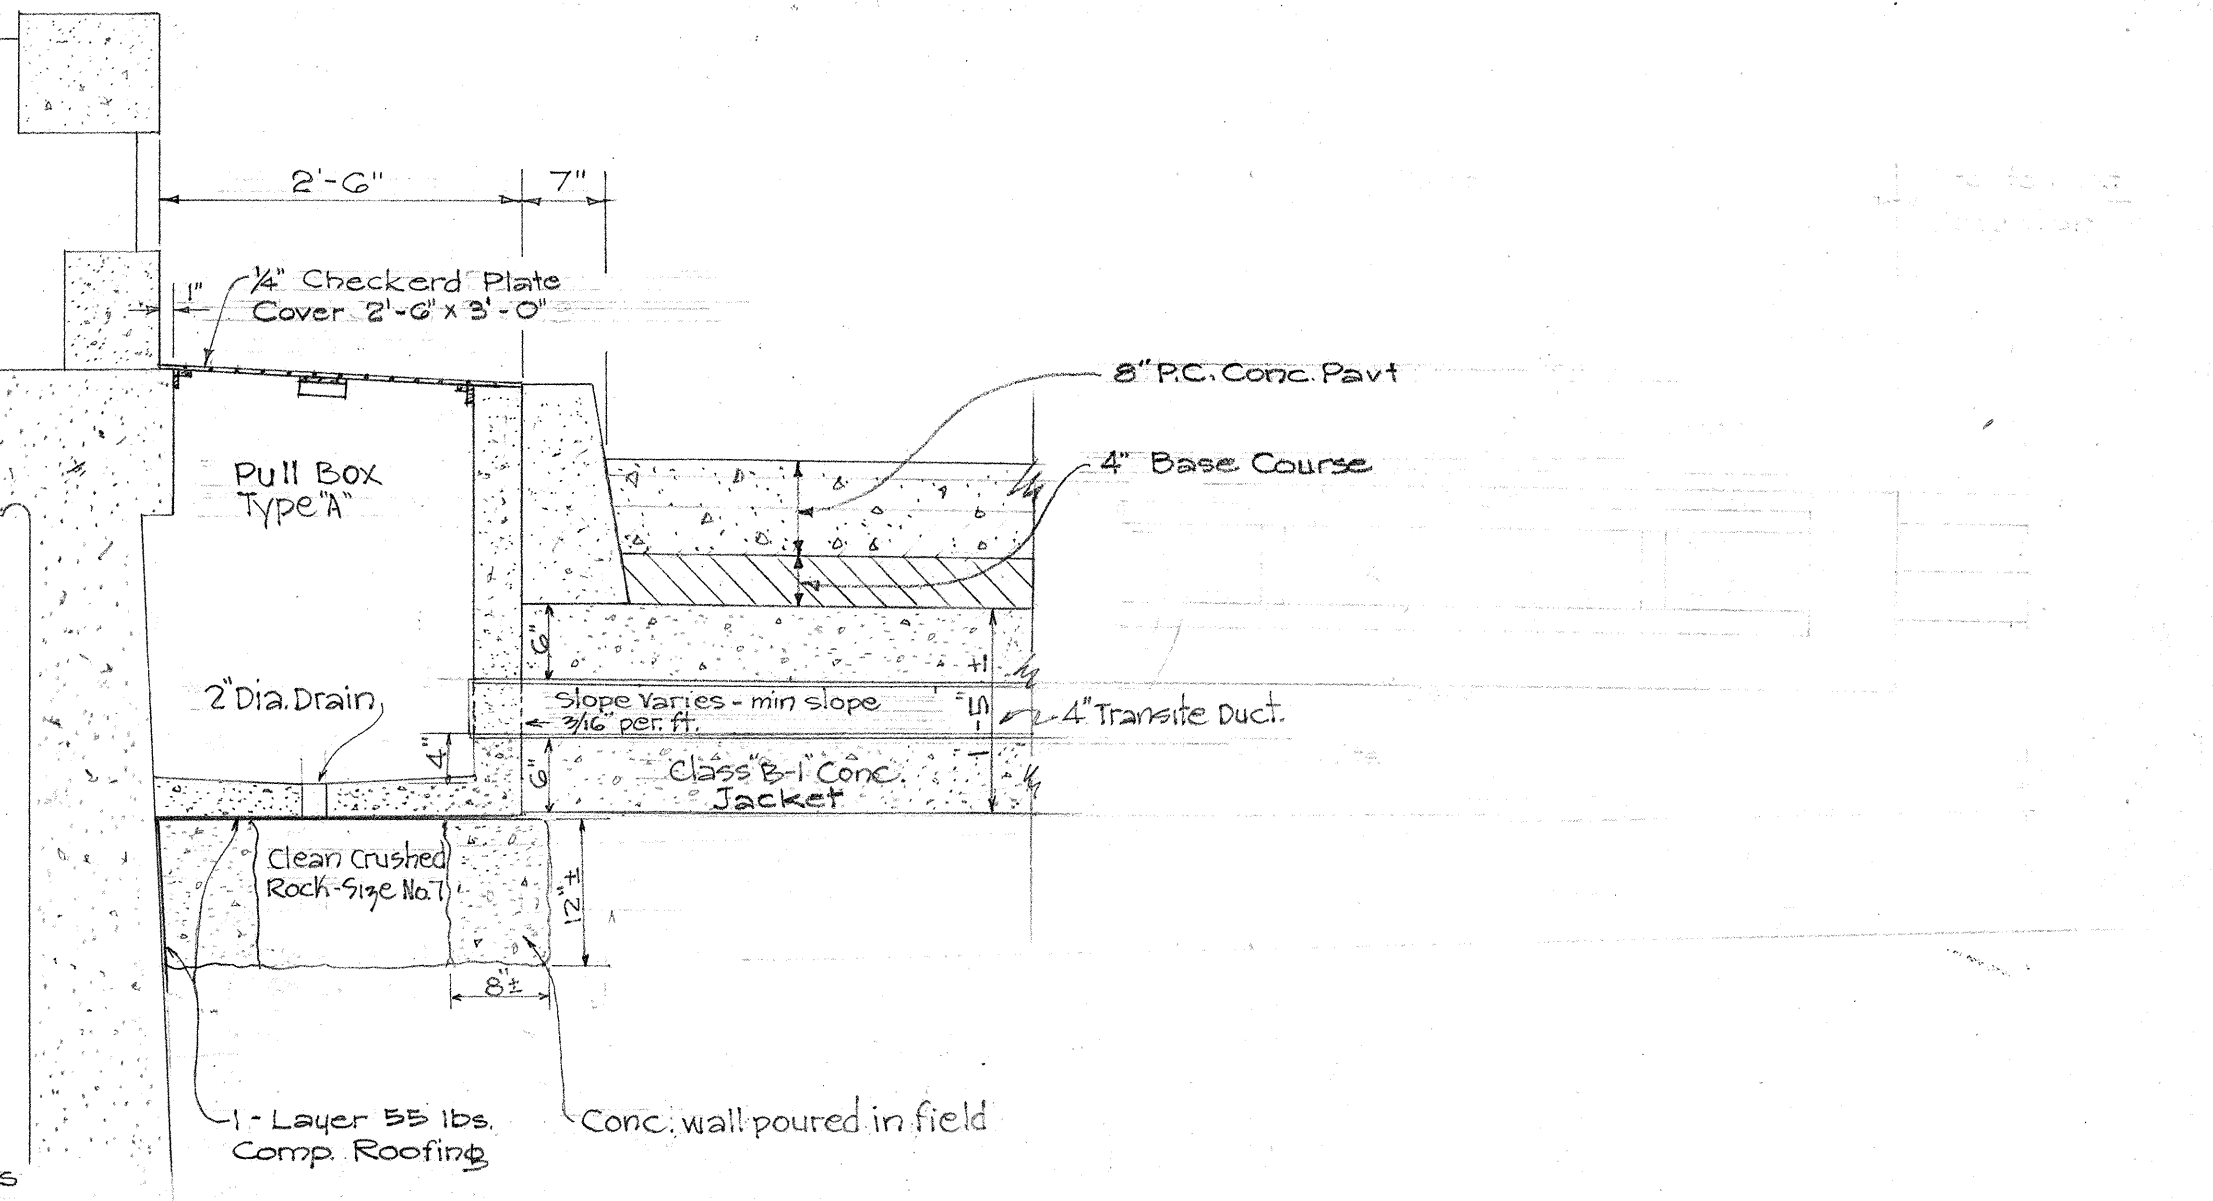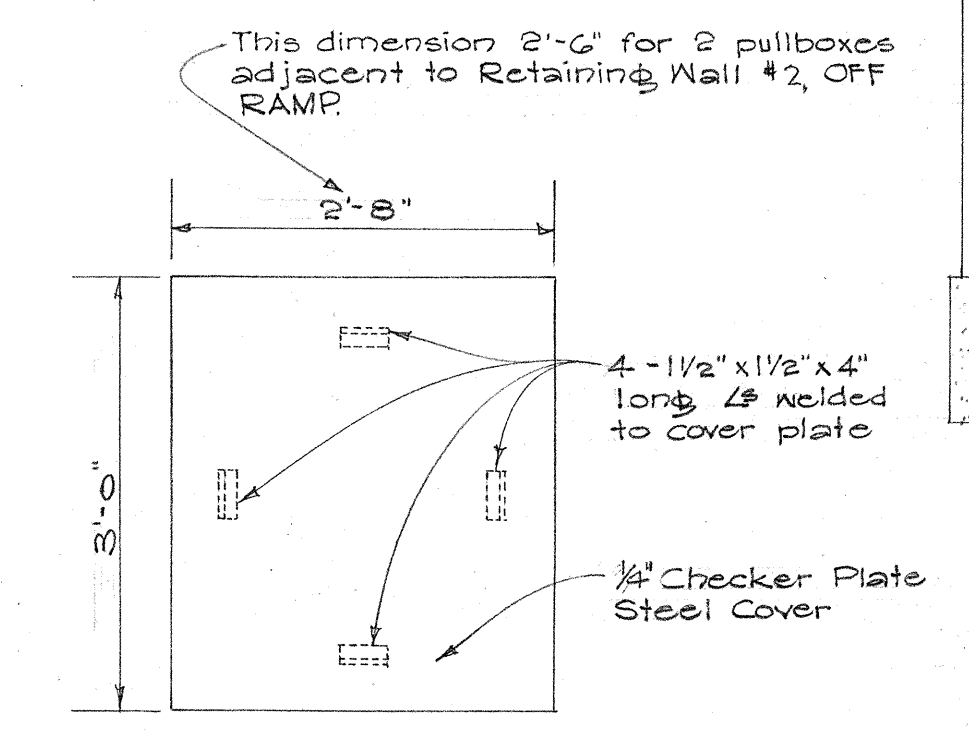

TERRITORIAL HIGHWAY DEPARTMENT
TERRITORY OF HAWAII

TRAFFIC SIGNAL SYSTEM

MAUKA ARTERIAL
KEEAUMOKU ST. TO ALEXANDER ST.

PROJECT No. U 59 (6)
UNIT 2

Scale: As Noted July 1953

SHEET No. 3 OF 3 SHEETS

5627.35