
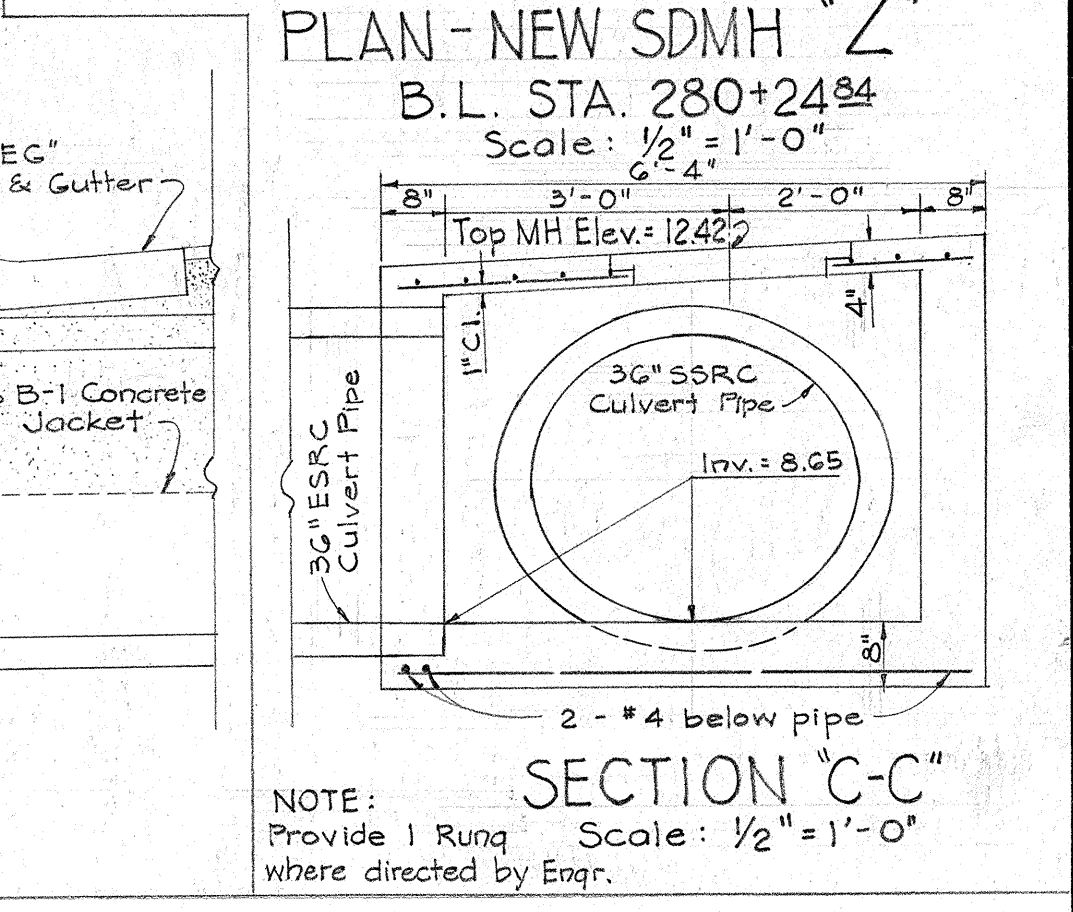
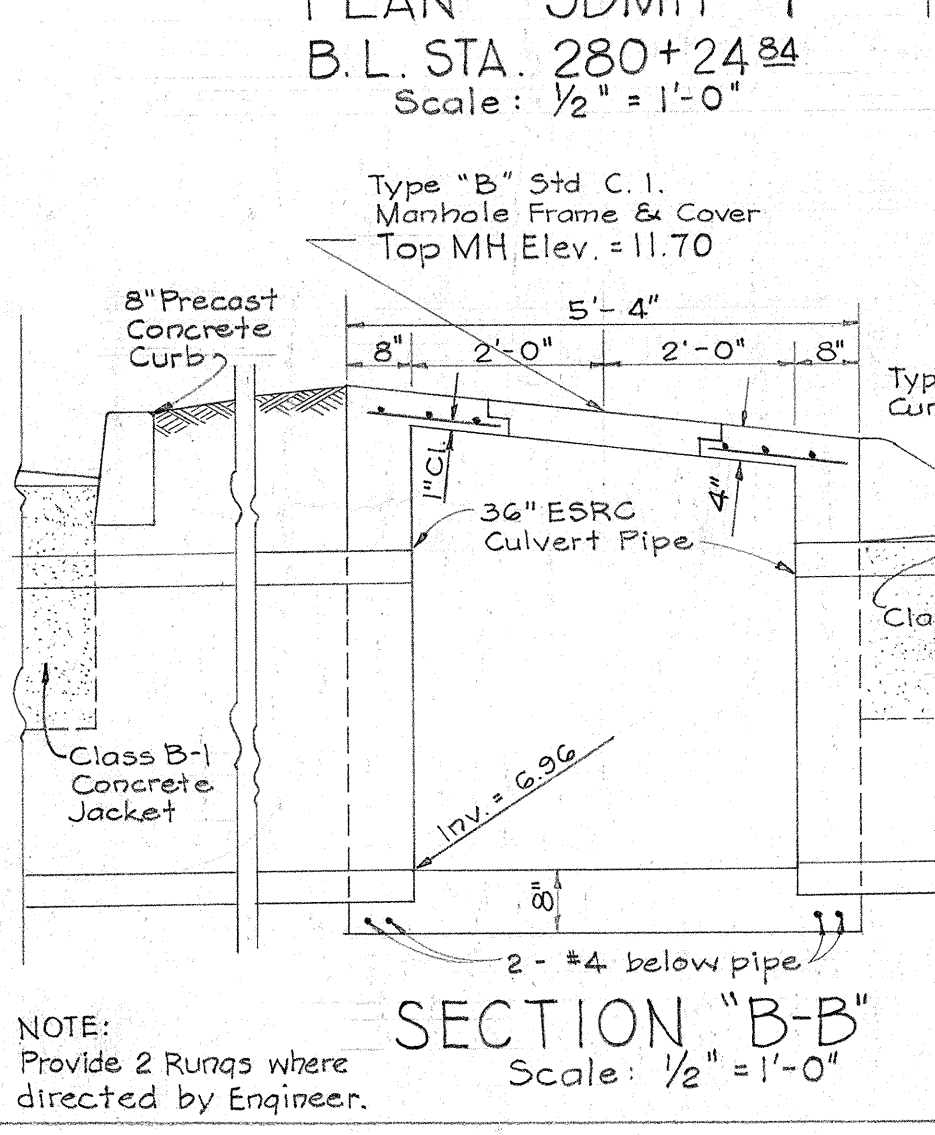
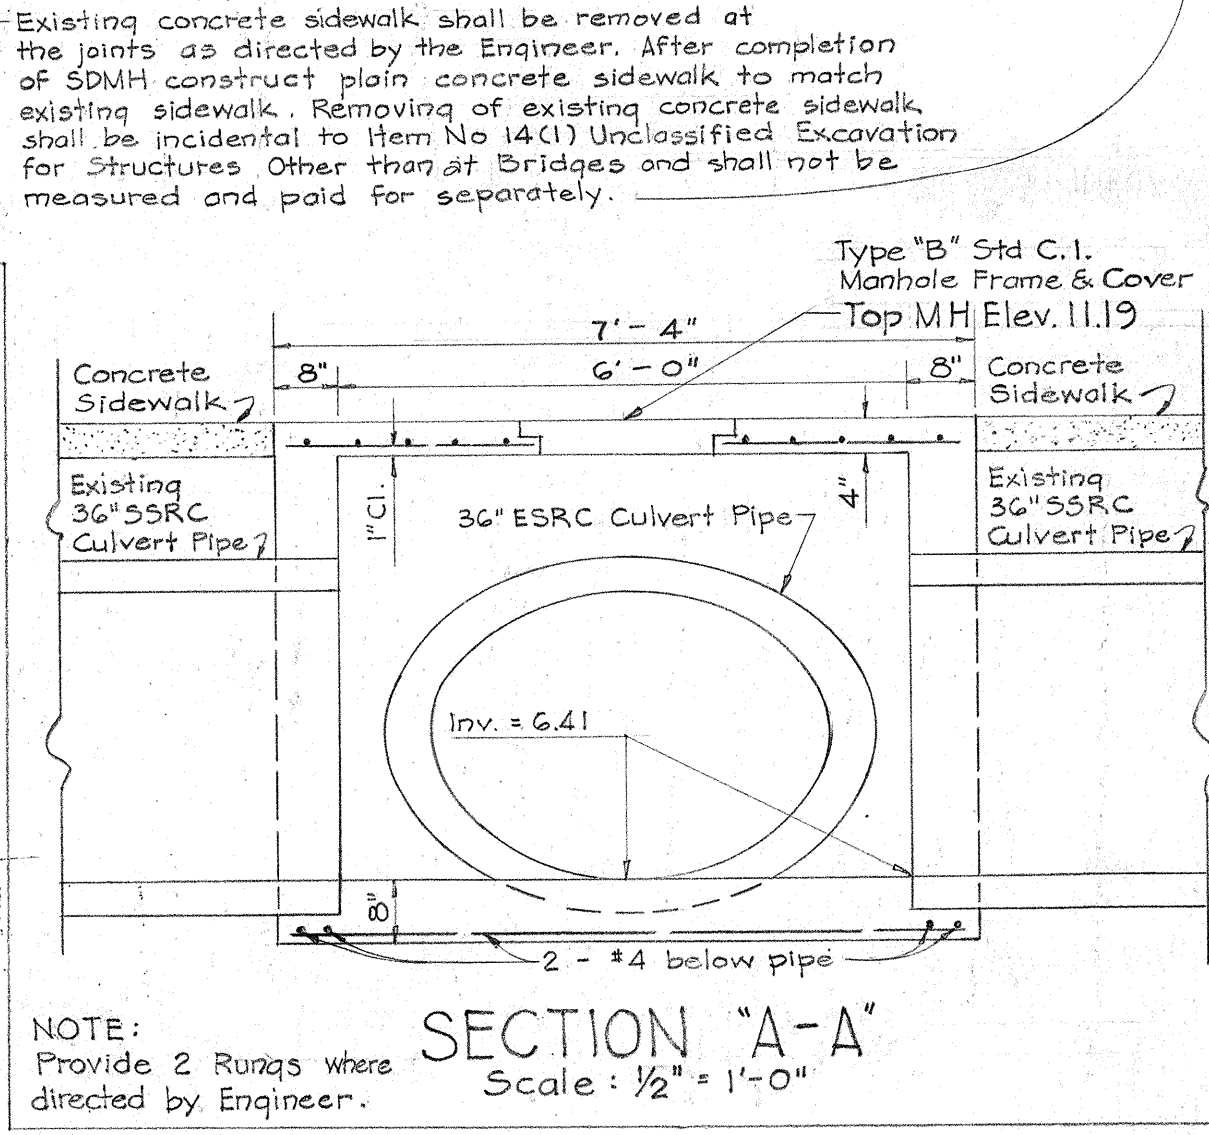
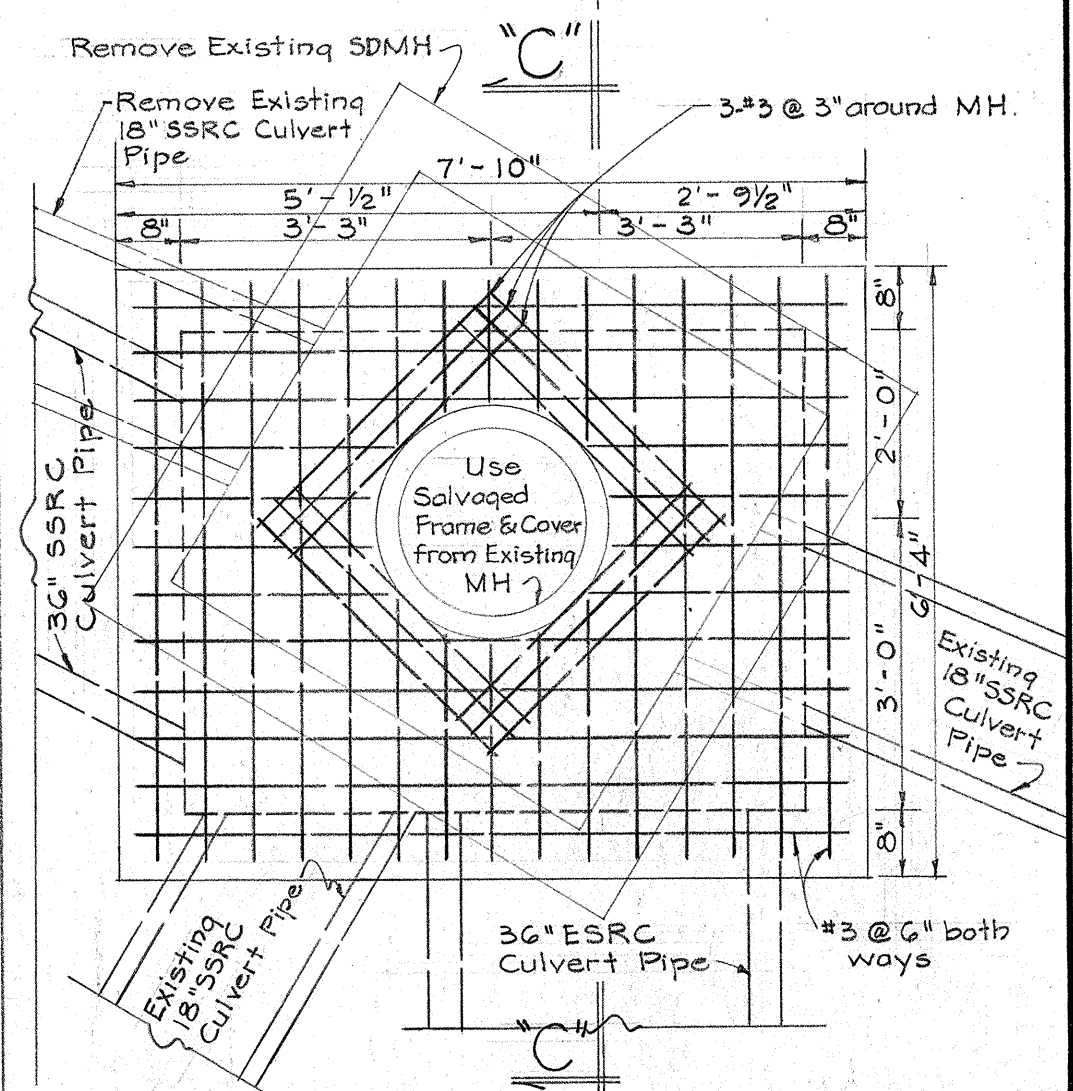
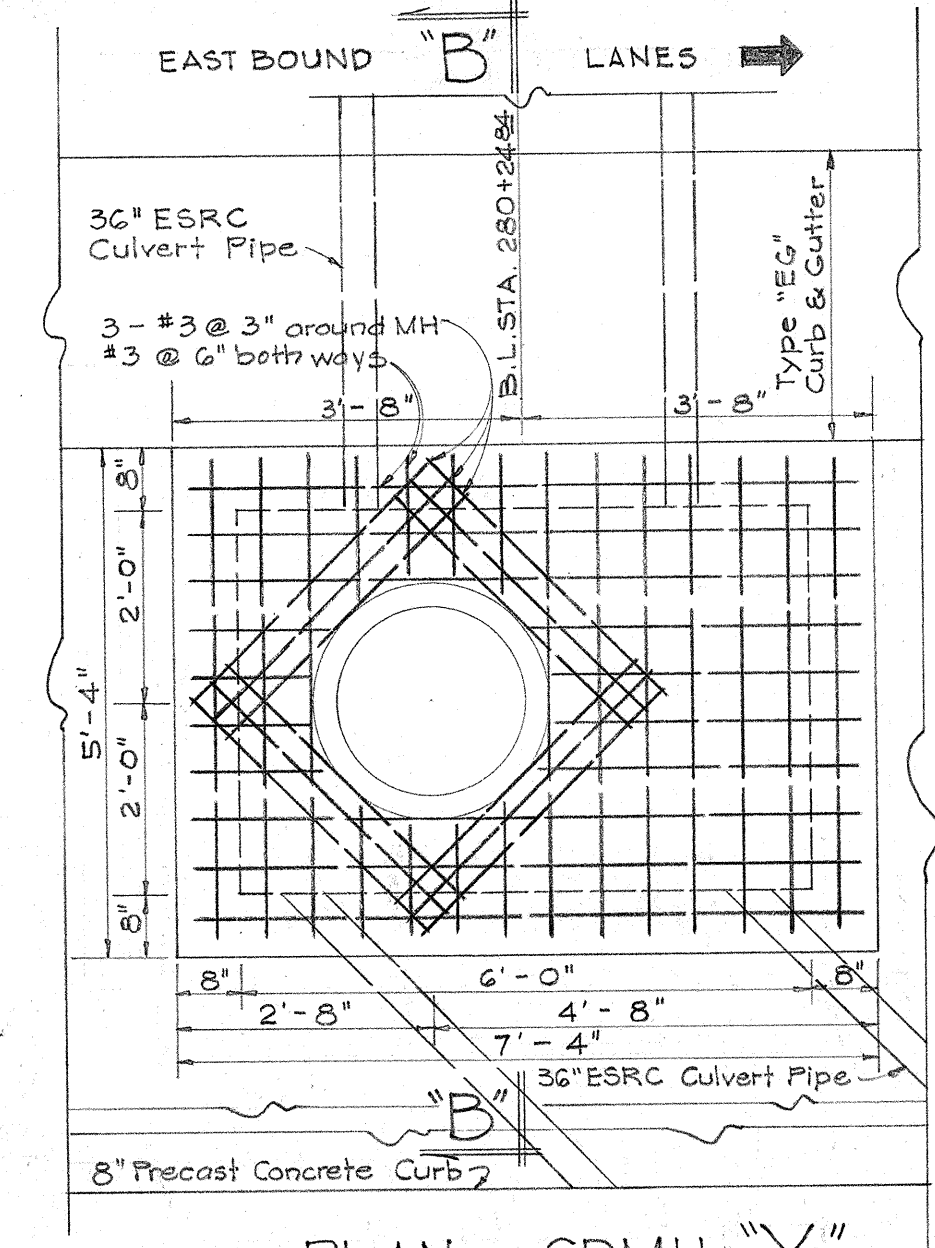
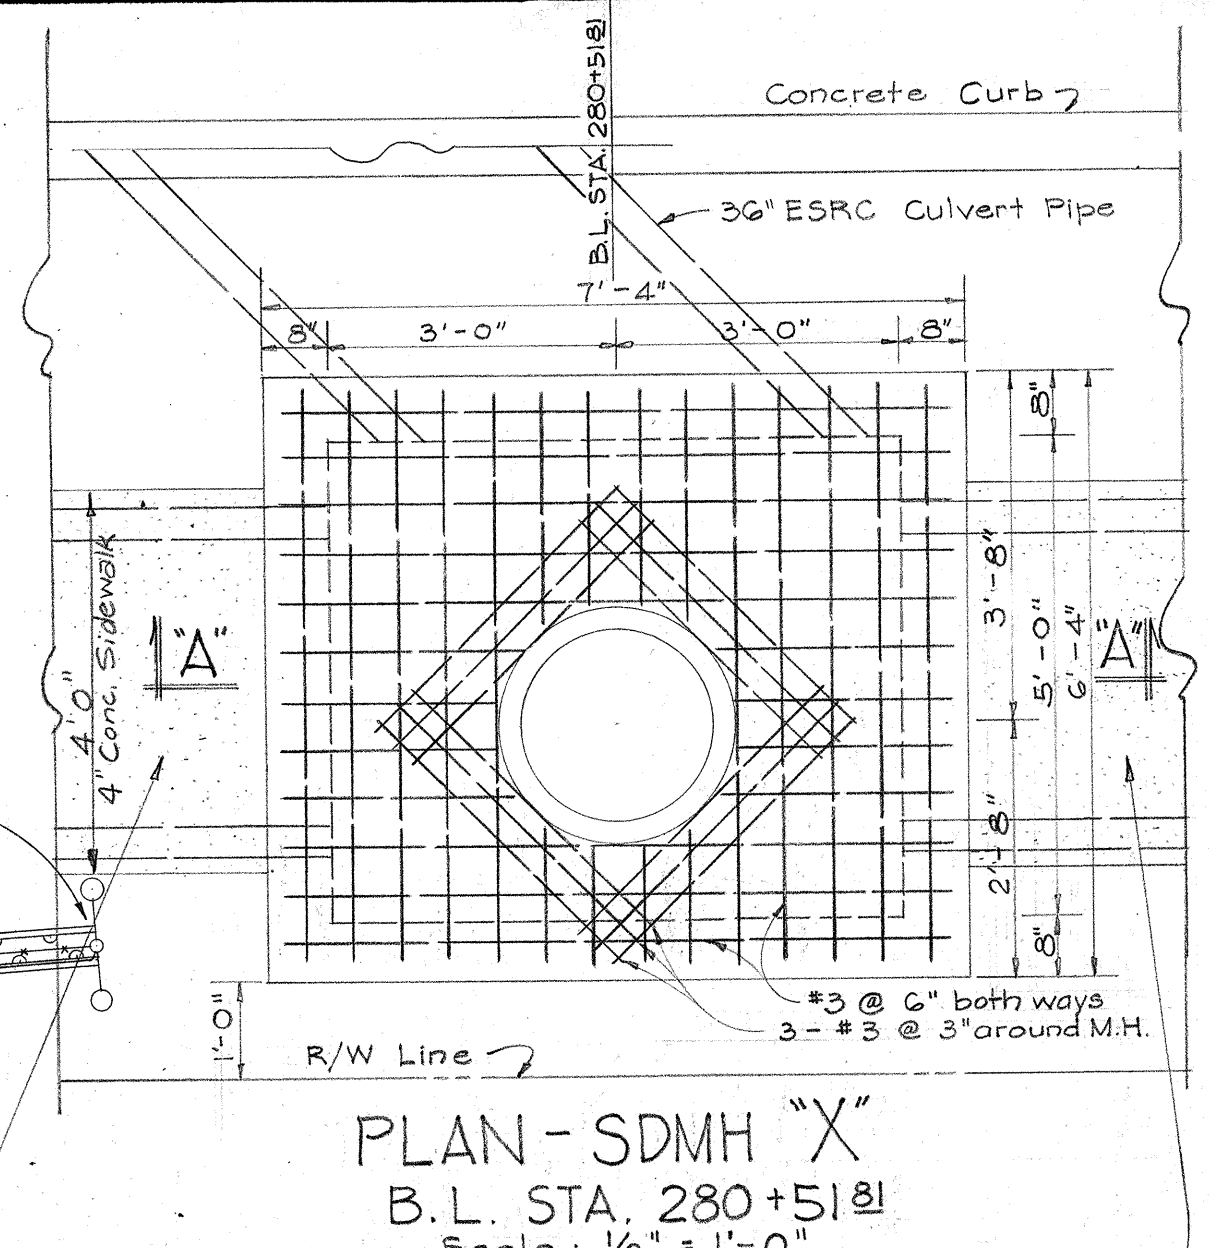


FISCAL YEAR	SHEET NO.	TOTAL SHEETS
1954	2	7



NOTE: Removing of existing SDMH and 18" SSRC Culvert Pipe, and solving existing Cast Iron Frame & Cover shall be incidental to Item No. 14(1) Unclassified Excavation for Structures Other than at Bridges, and shall not be measured and paid for separately.

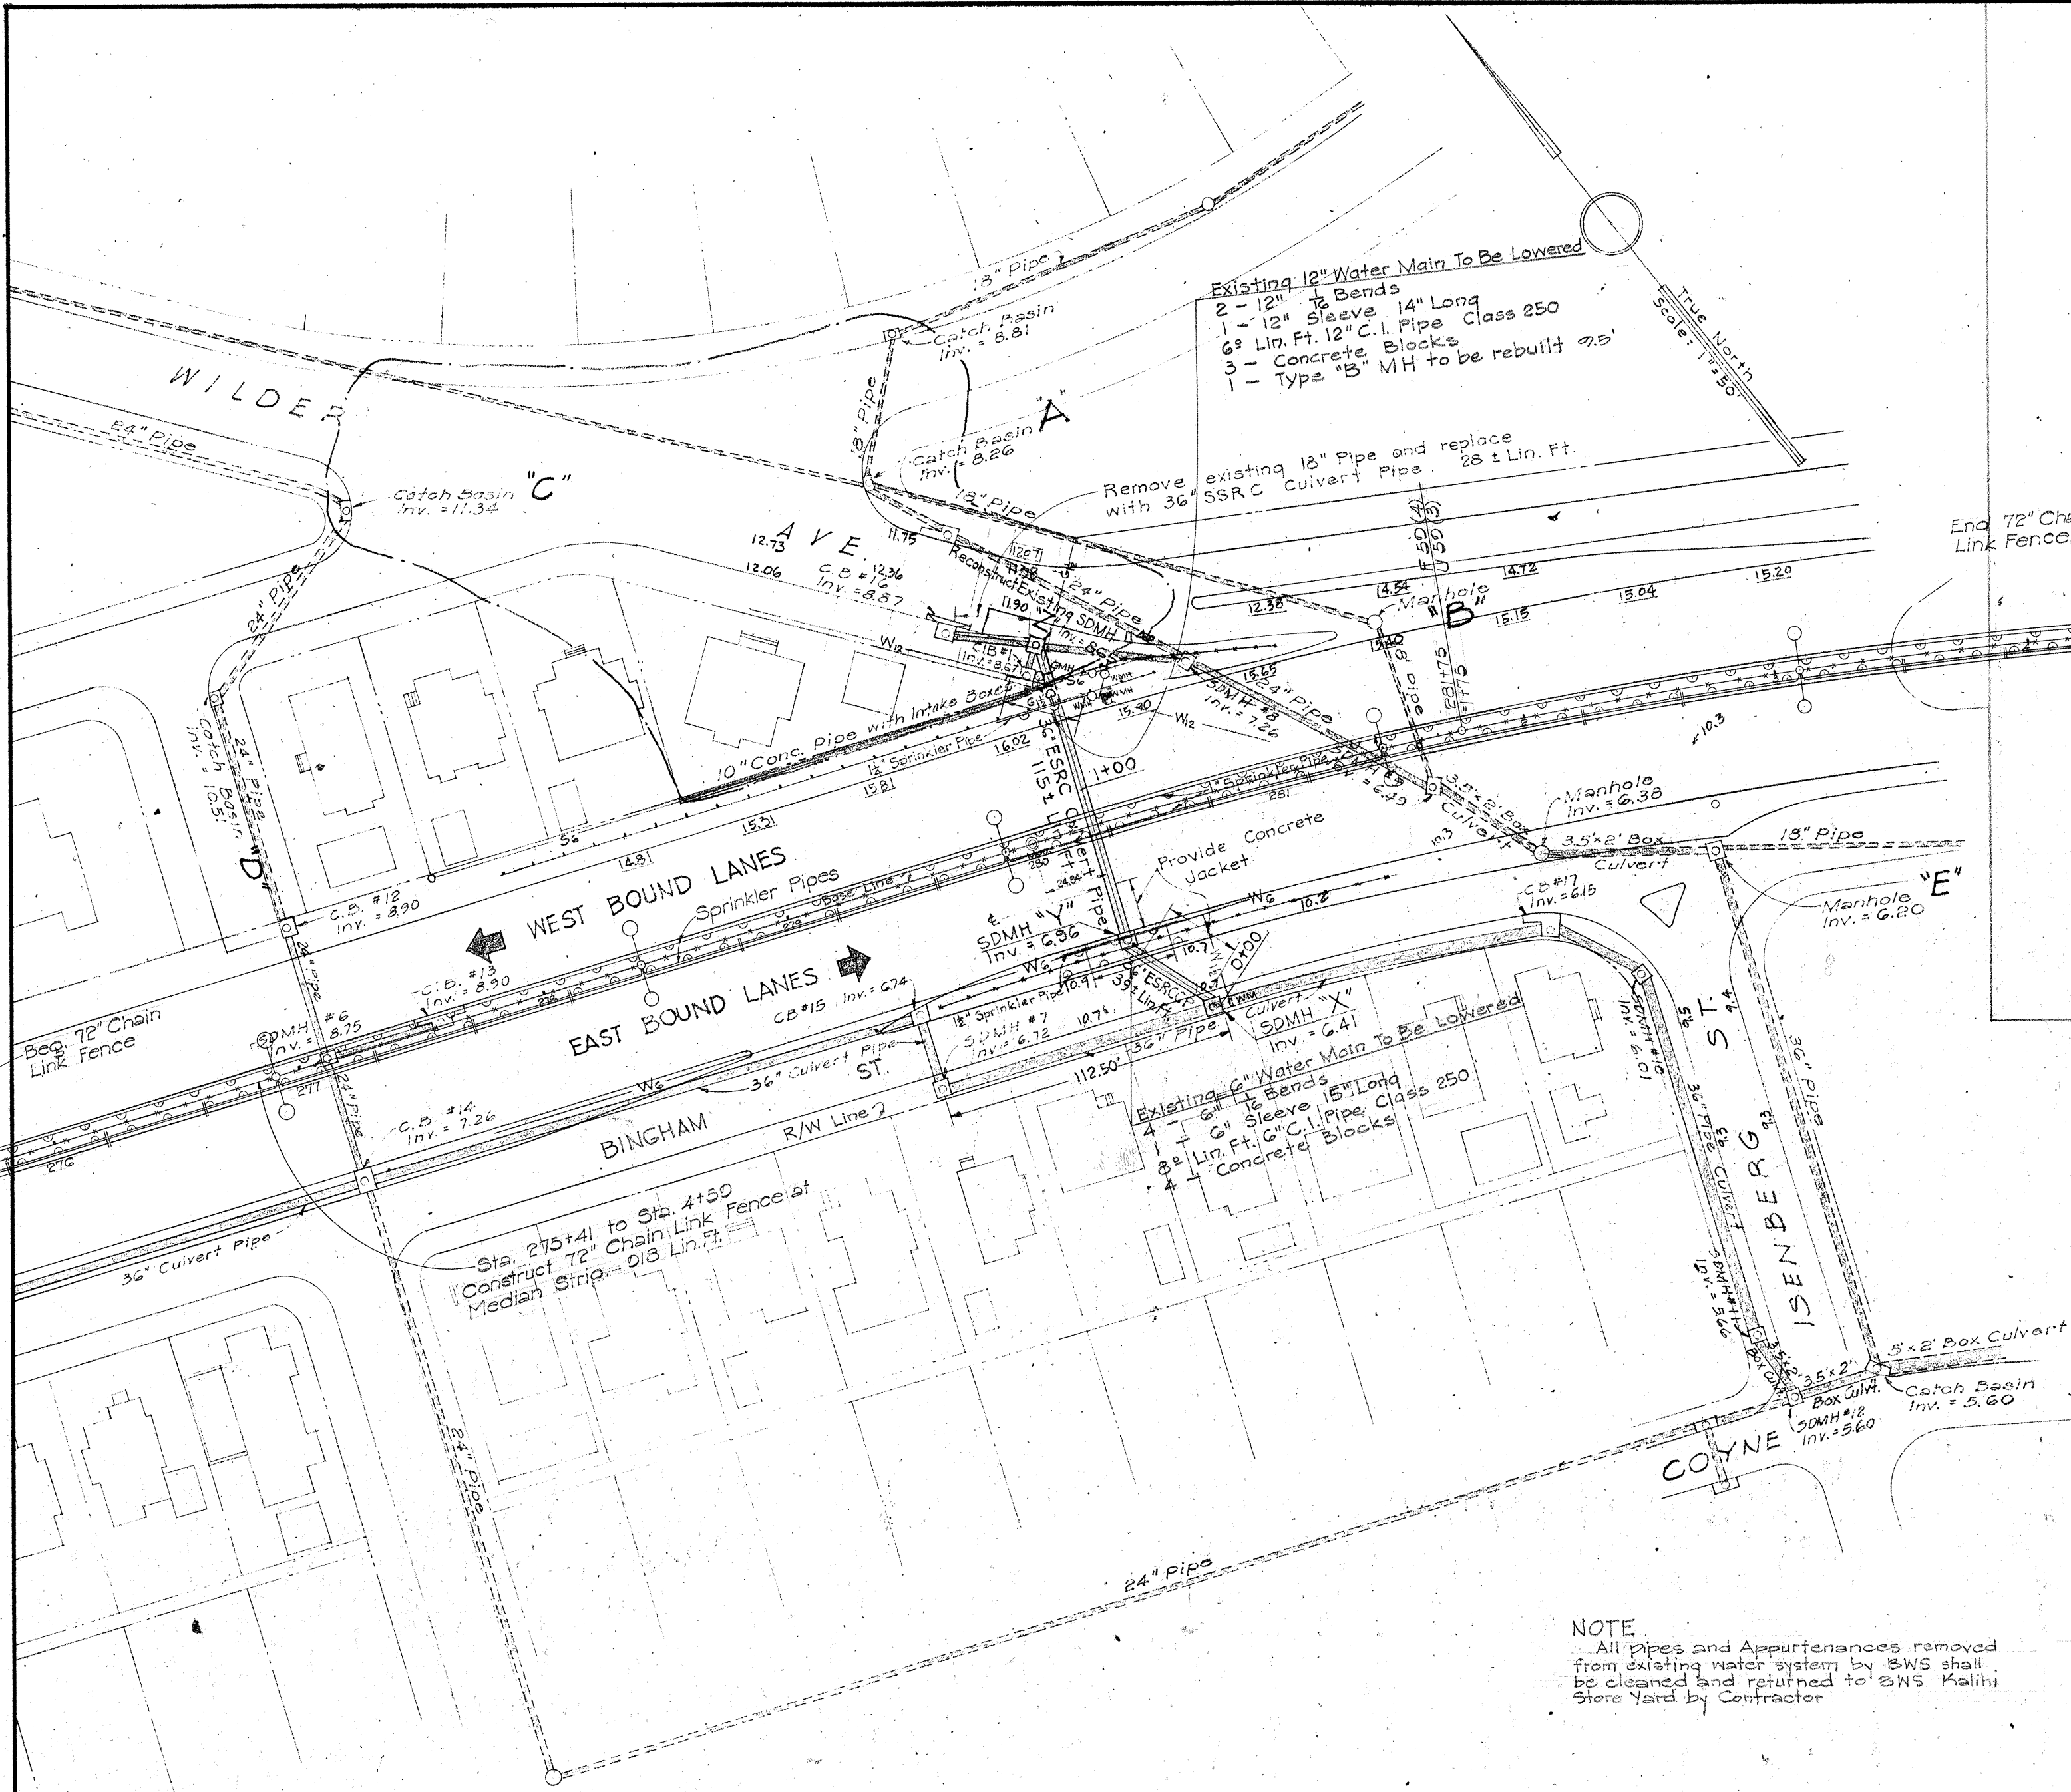

NOTE: All pipes and Appurtenances removed from existing water system by BWS shall be cleaned and returned to BWS Malili Store Yard by Contractor

- LEGEND
- New 36" Drain to be constructed
 - 72" Chain Link Fence
 - Metal Guard Rail with Wood Posts
 - 2 Underground Cables No. 8 AWG buried in trench 18" depth
 - Buckner No. 400H 1/2" Riser Half Circle
 - Double Arm Light Standard - Round Monotube, Union Metal
 - Top of curb elevation before construction of Mauka Arterial
 - 10.00 Mauka Arterial pavement elevation
 - Existing City Drains
 - Drains constructed by Territorial Highway Department
 - City Streets before construction of Mauka Arterial
 - Flood Area

NOTE: See Sheet No. 5696.3 for Details of Concrete Reaction Blocks for 6" and 12" 1/2 Bends.

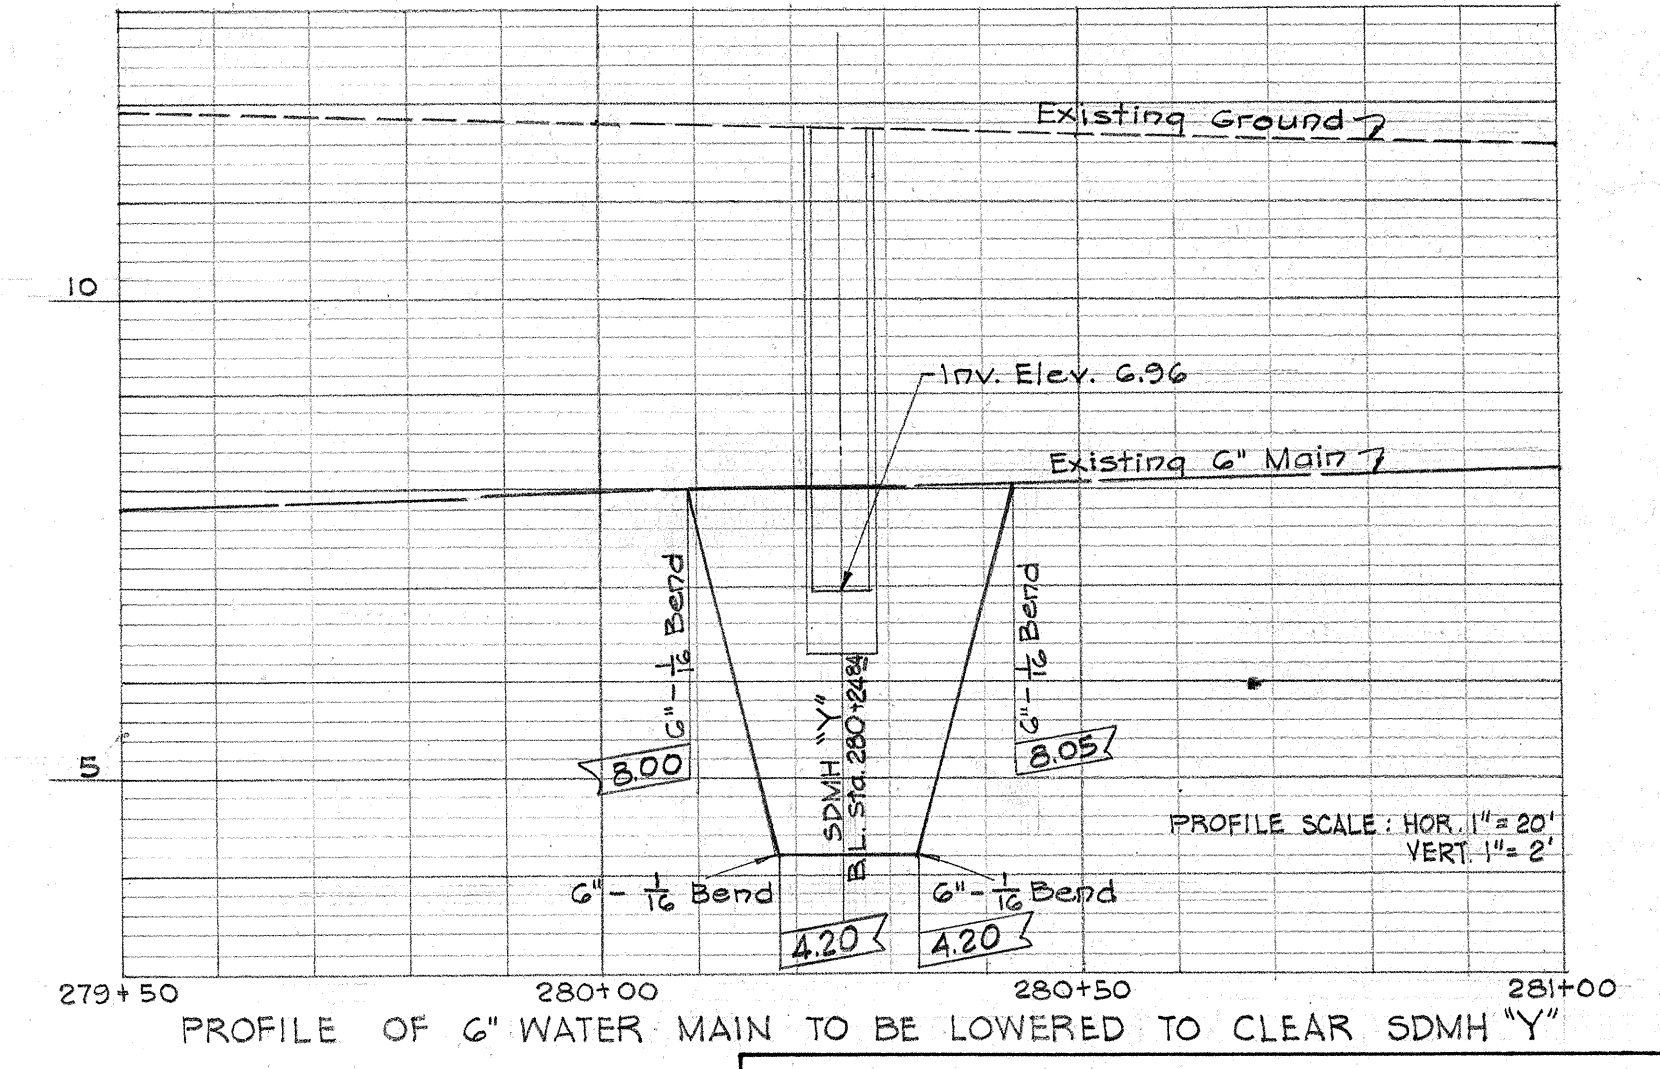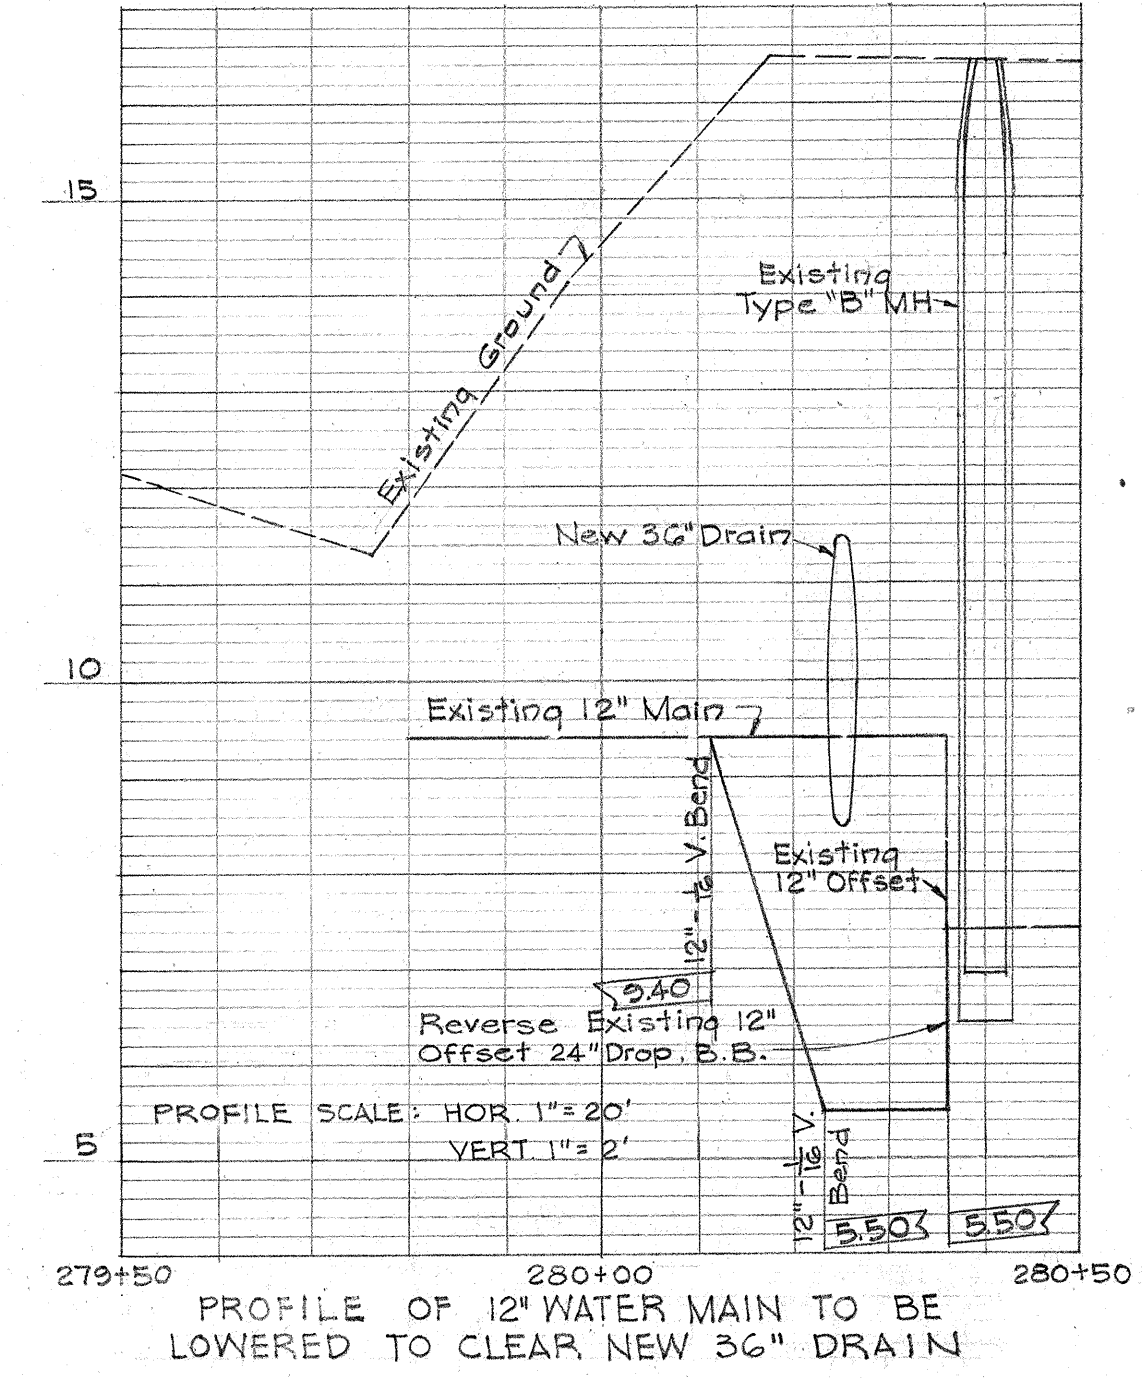

APPROVED: _____
MANAGER AND CHIEF ENGINEER, B.W.S.
DATE: _____

TERRITORIAL HIGHWAY DEPARTMENT
TERRITORY OF HAWAII
NEW 36" DRAIN
MAUKA ARTERIAL AT WILDER AVE.
Scale: As Noted
March 1954

DESIGNED BY	DATE
TRACED BY	
QUANTITIES BY	
CHECKED BY	
ORIGINAL PLAN	
NOTE BOOK No.	