



FED. ROAD DIST. No.	STATE	FED. AID PROJ. No.	FISCAL YEAR	SHEET No.	TOTAL SHEETS
HAWAII	HAW.	U59(8)	1955	23	61

DATE	BY

DATE	BY

DATE	BY


DATE	BY

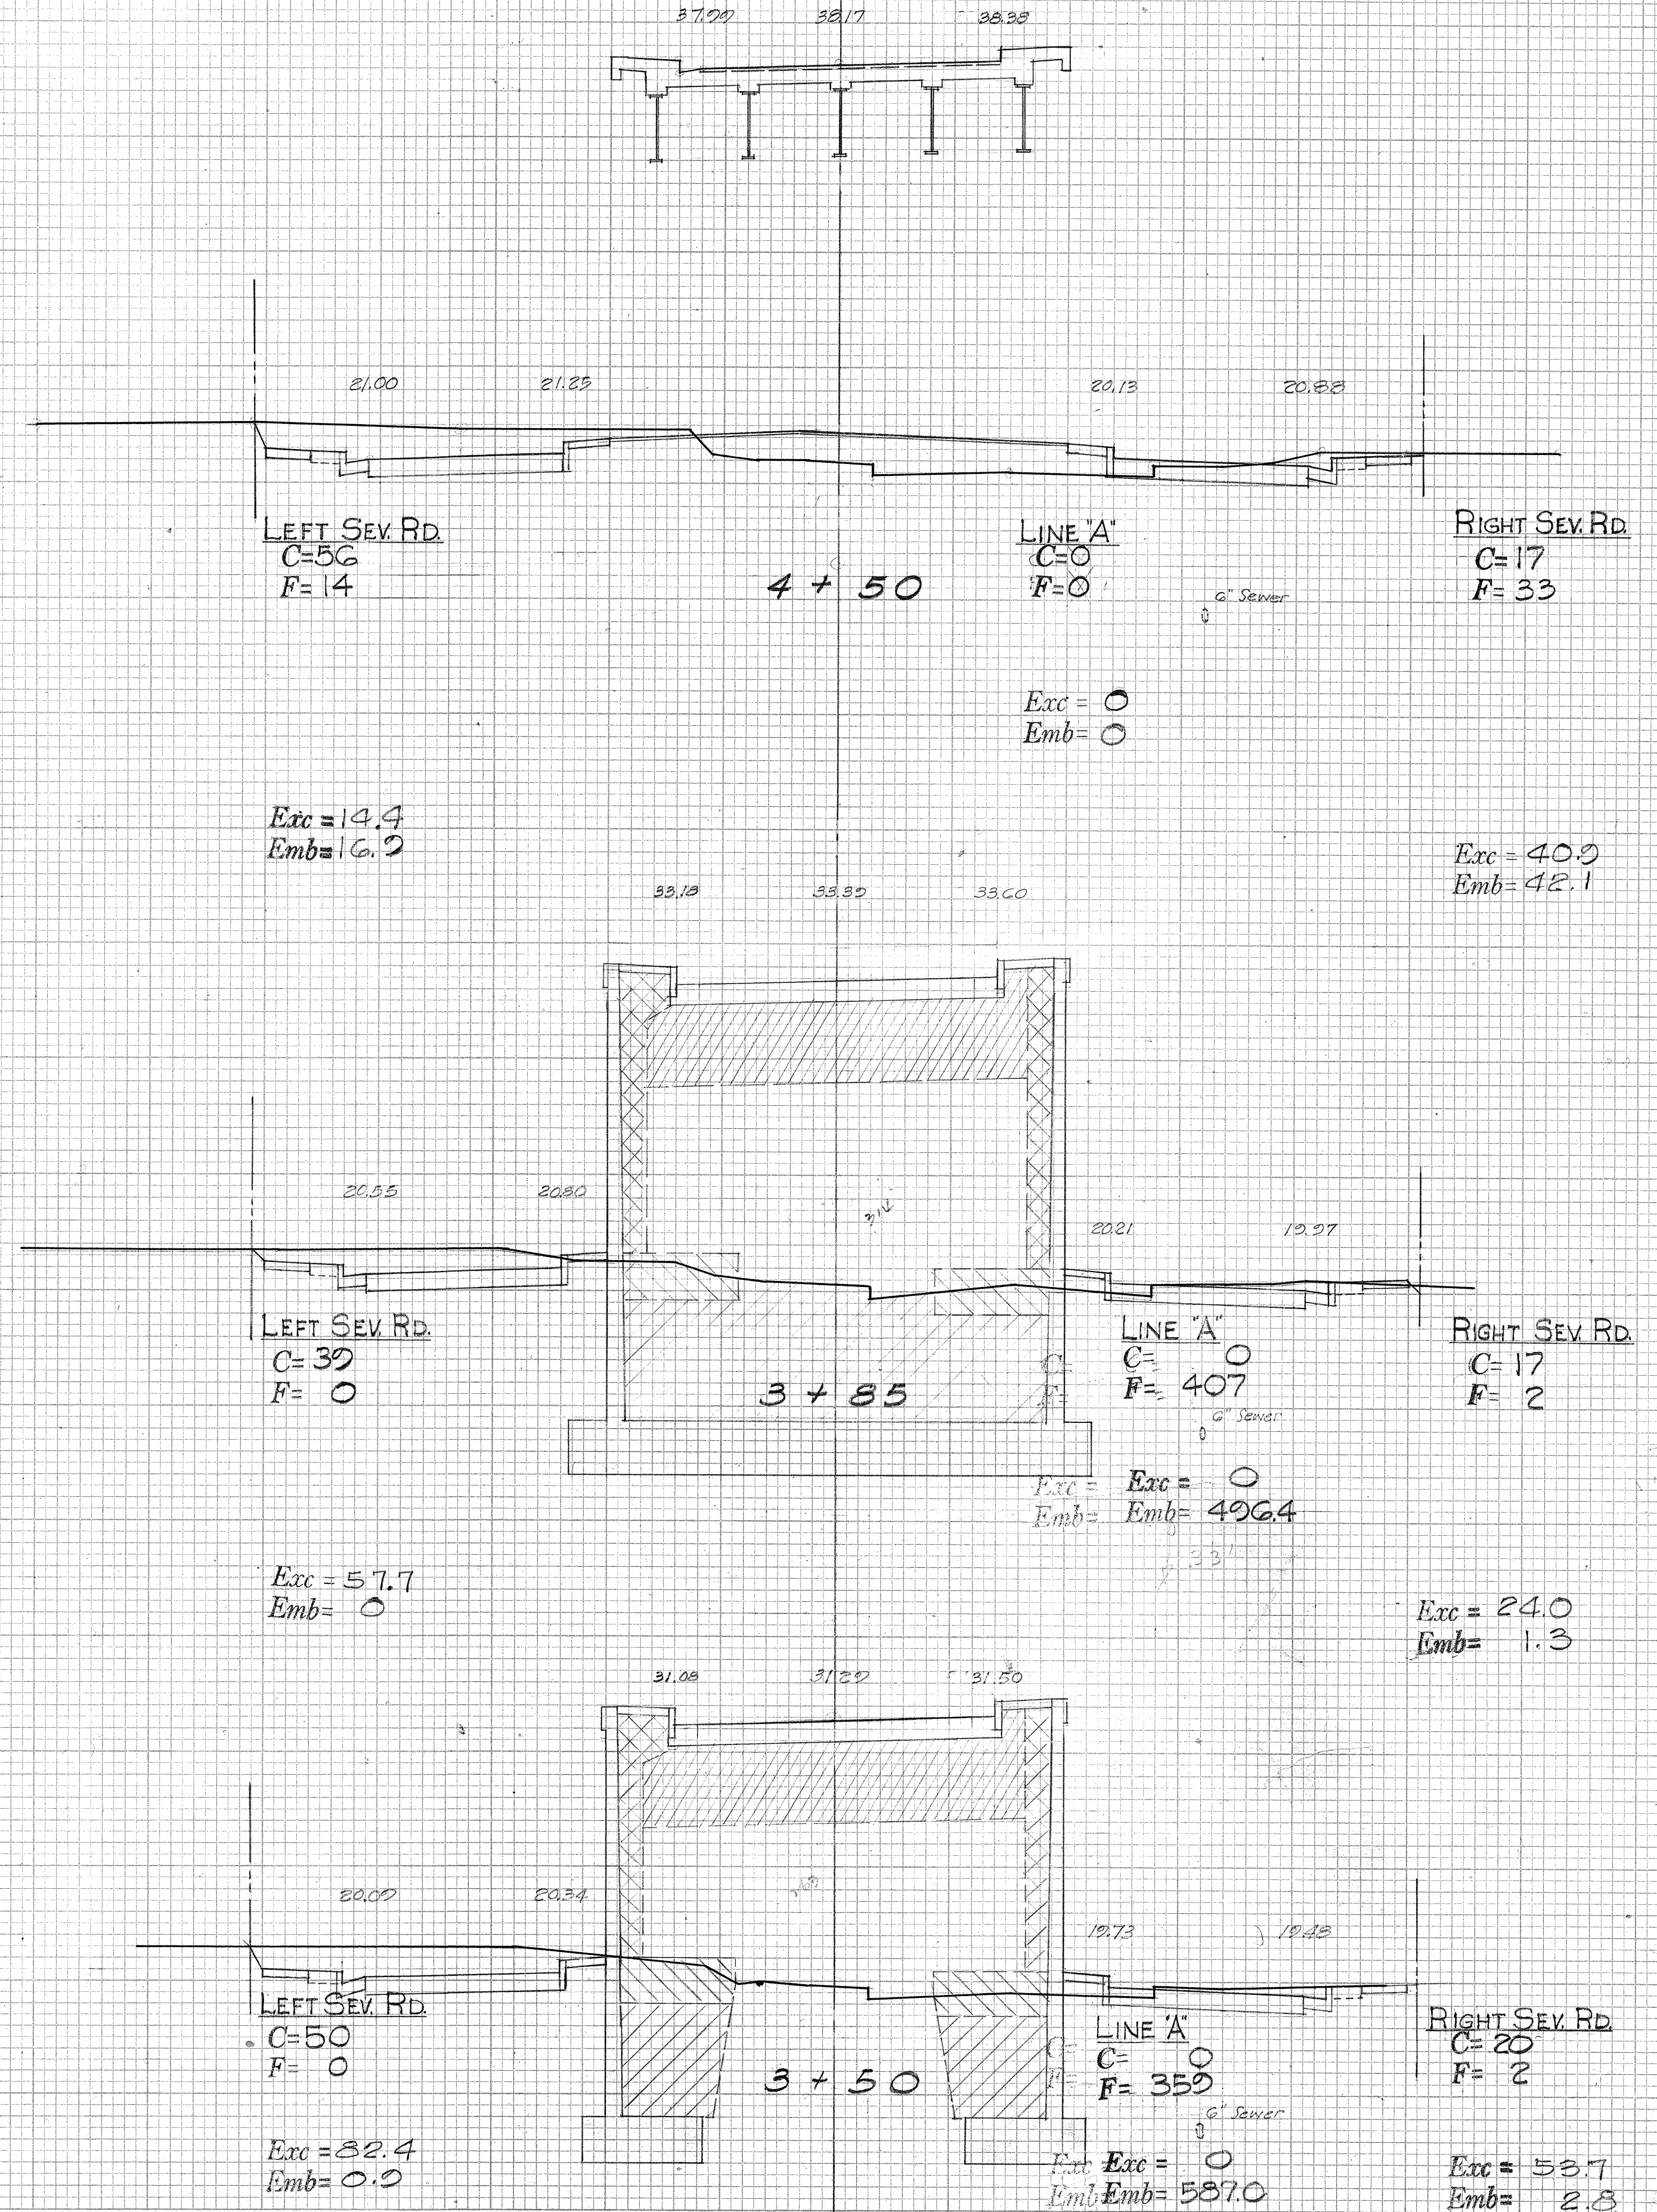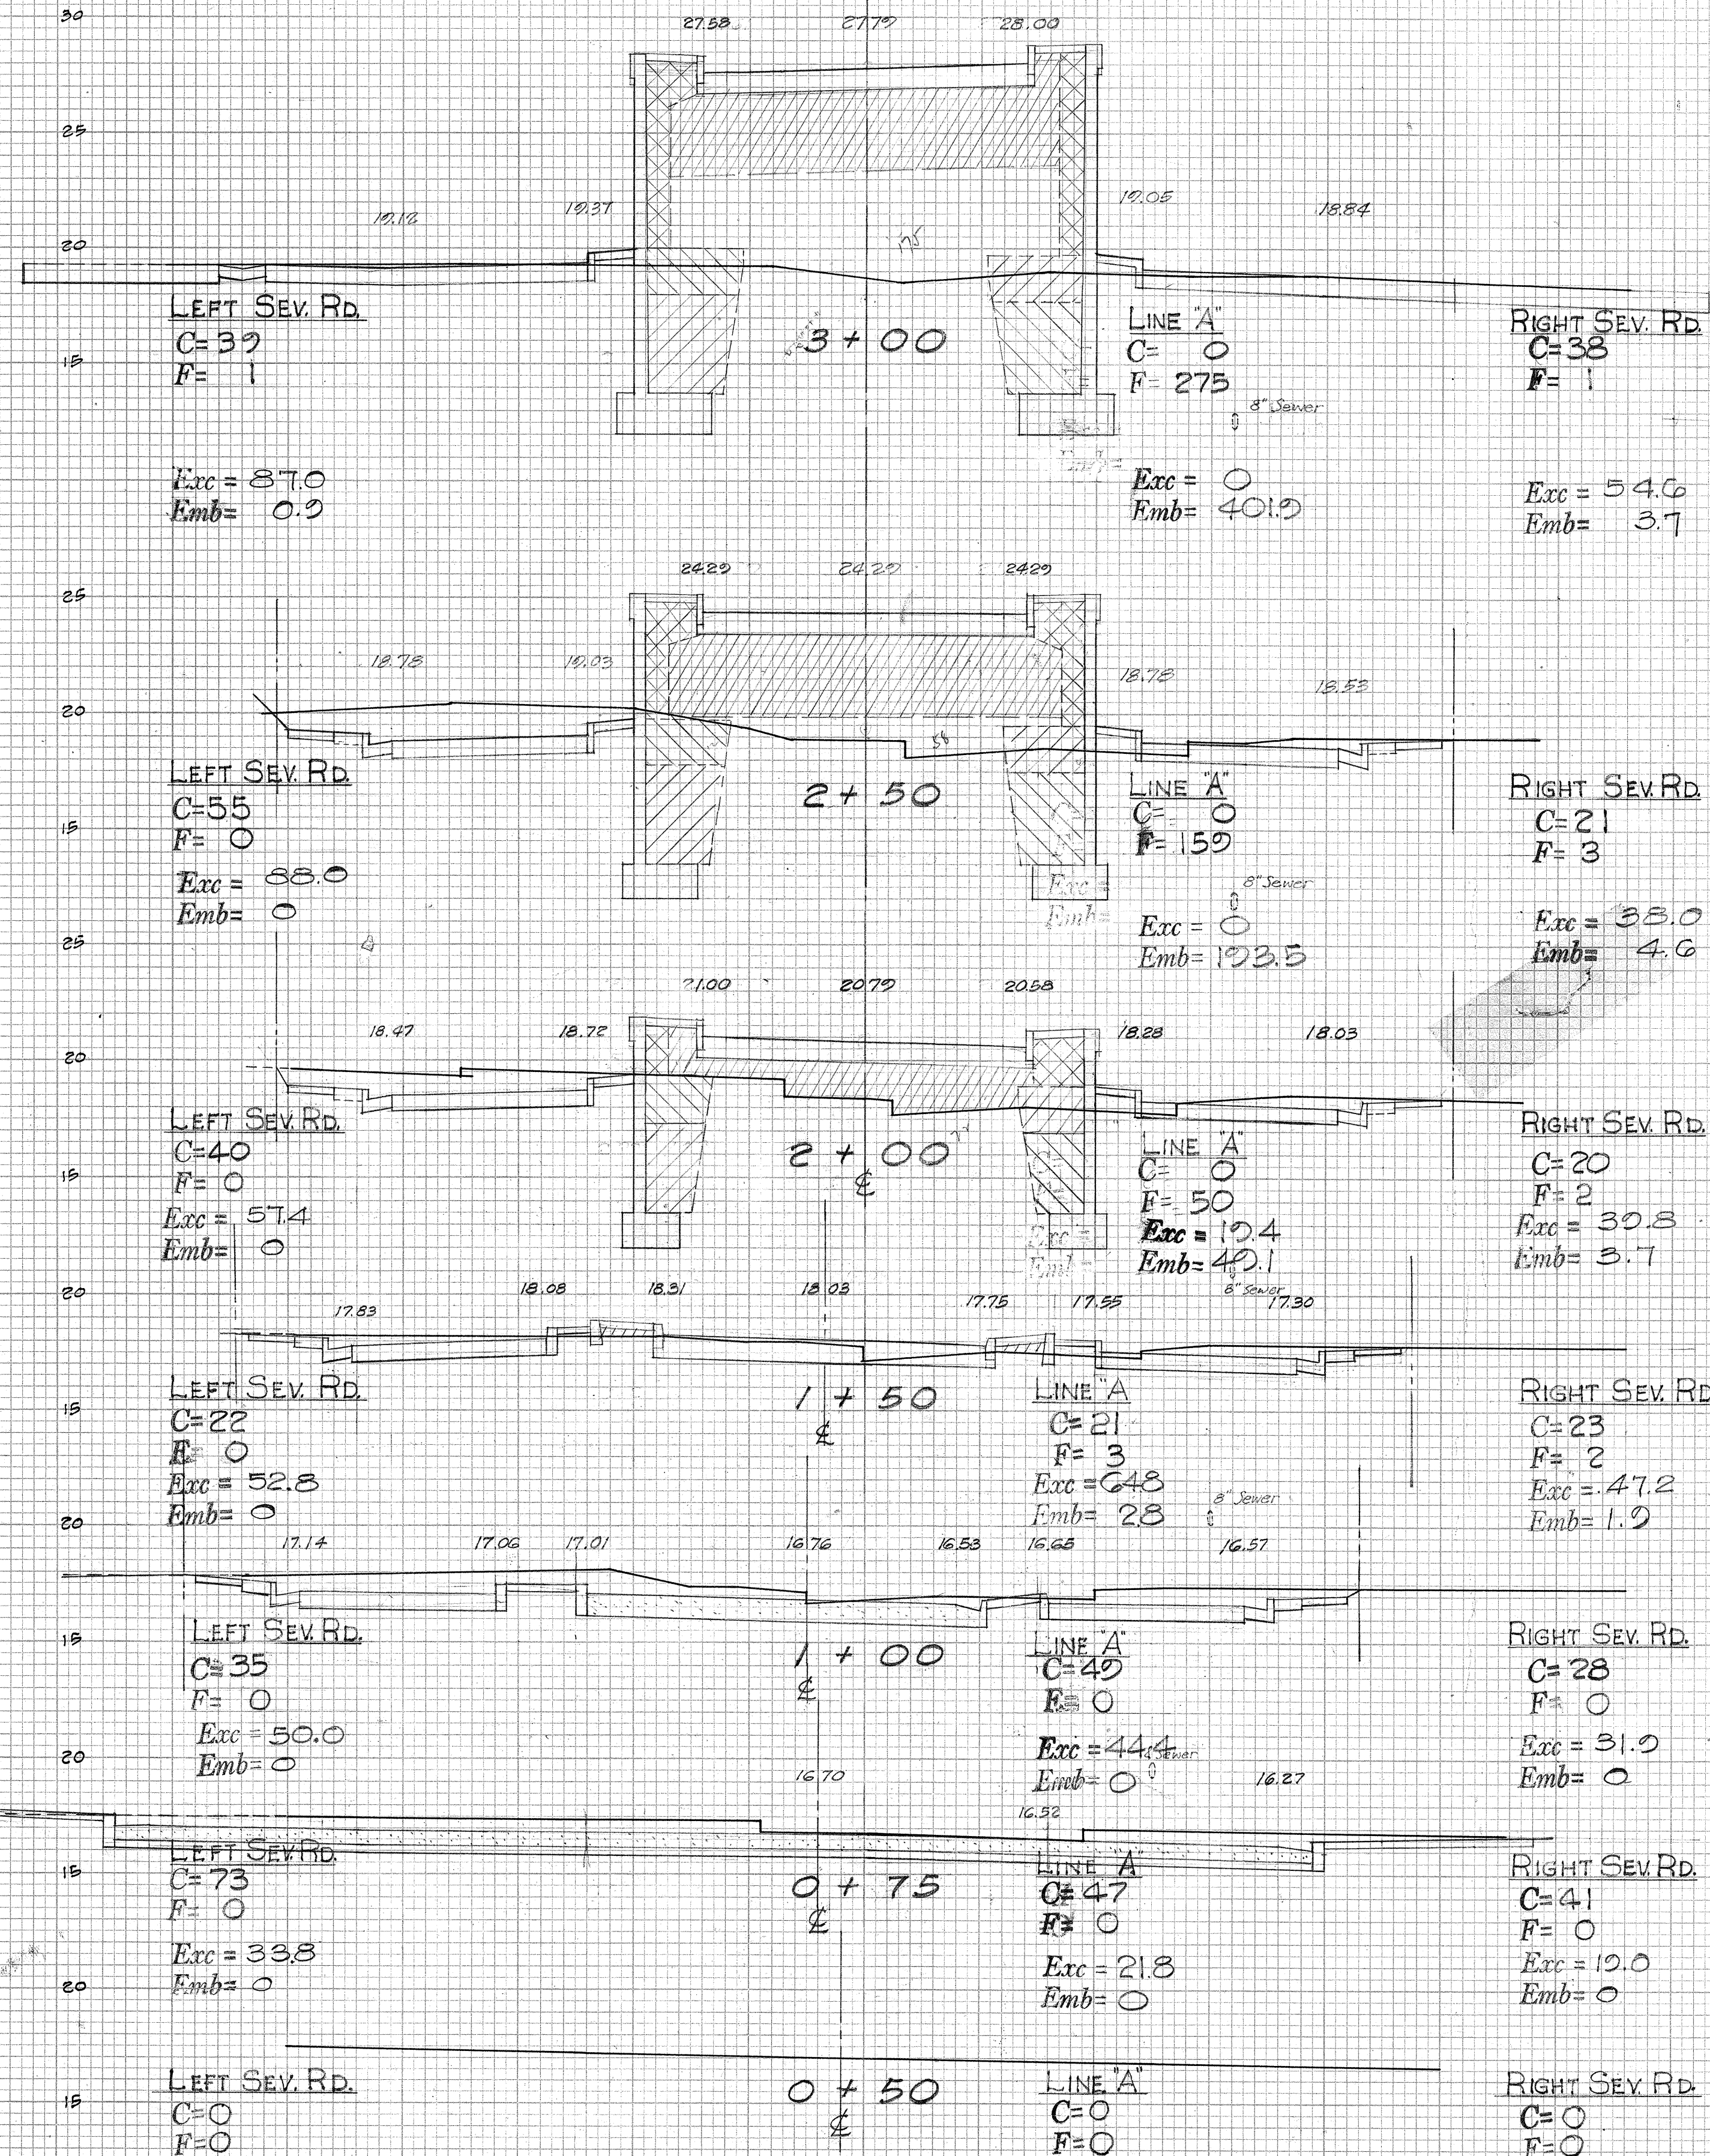

FED. ROAD DIST. NO.	STATE	FED. AID PROJ. NO.	FISCAL YEAR	SHEET NO.	TOTAL SHEETS
HAWAII	HAW.	U 30(8)1055	84	61	61

FINAL SURVEY	DATE
BY	
NO.	

ORIGINAL SURVEY	DATE
BY	
NO.	

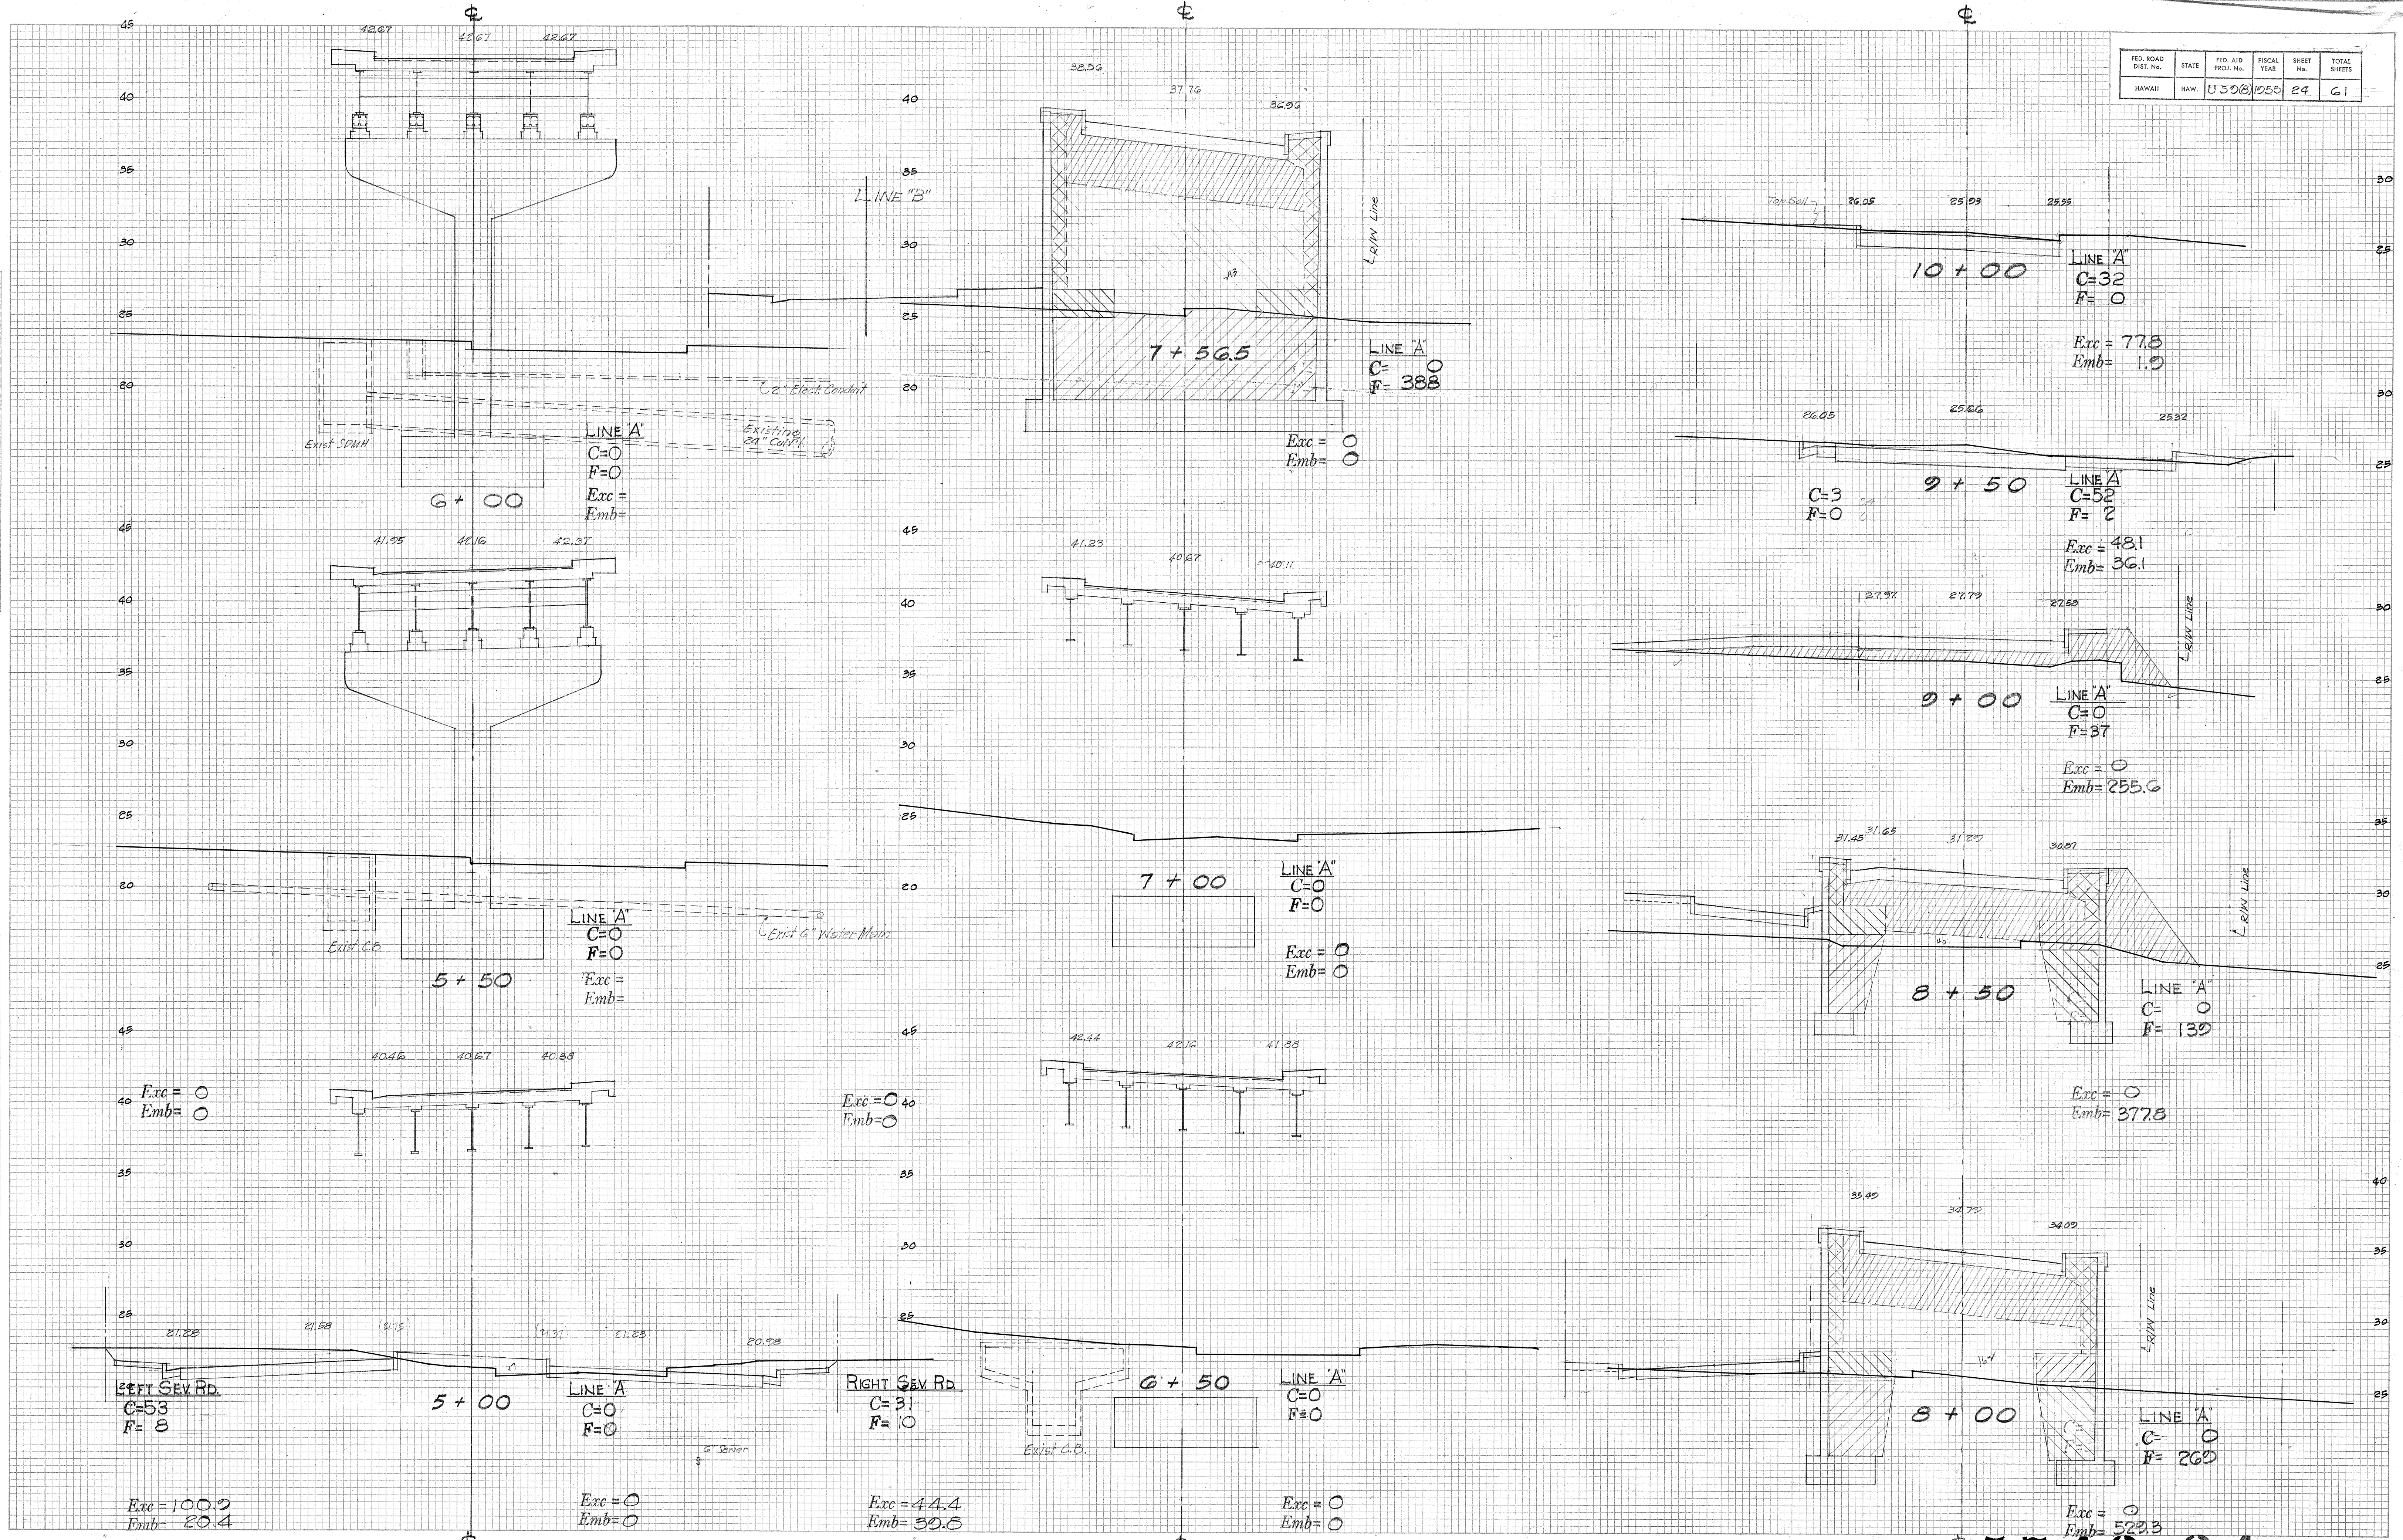

5743.24

FED. ROAD DIST. No.	STATE	FED. AID PROJ. No.	FISCAL YEAR	SHEET No.	TOTAL SHEETS
HAWAII	HAW.	U 59(6)	1955	25	61

DATE	BY	FINAL SURVEY	PLANNED	NO. OF AREAS CHECKED

DATE	BY	ORIGINAL SURVEY	PLANNED	NO. OF AREAS CHECKED

