

GENERAL NOTES

1. All gutters, sidewalks, and driveways within the area of improvement shall be removed as directed by the Engineer. Such removals shall be incidental to the item "Unclassified Excavation". All curbs shall be salvaged.
2. Wherever new and existing curbs and gutters are joined, the connection shall produce a neatly matched joint.
3. All existing manholes shall be adjusted to the new finish grades unless otherwise noted.
4. All traffic signal standards and equipment shall be carefully dismantled and stockpiled as directed by the Engineer unless otherwise noted. The concrete bases shall be removed.
5. 1 1/4" A.C. Mix No. V shall be paved on areas under the Separation structure and on strips between the retaining walls and the service roads. The surface shall be lightly rolled. The subgrade shall be sprayed with non-emergent weed killer. Use "Polybor" Chlorate or equal. Mix 3 gallons of water per 1 pound of the chlorate. Apply at the rate of 0.4 gallon per square yard.
6. All new driveways shall match existing with respect to grades as well as lines.
7. New C.C. Street Survey Monuments and Centerline Monuments shall be installed as directed by the Engineer.
8. New A.C. Traffic Roll shall be incidental to the item "A.C. Pavement Mix V".

FED. ROAD DIST. NO.	STATE	FED. AID PROJ. NO.	FISCAL YEAR	SHEET NO.	TOTAL SHEETS
HAWAII	HAWAII	U 59 (8)	1955	4	61

True North
Scale: 1" = 20'


CONC. RETAINING WALLS

See Sht. No. 42 to 44 for Structure Plans

SEPARATION STRUCTURE

See Sht. No. 30 to 49 for Structure Plans

Owner to move this Building after Contractor completes Relocation of Building in lot Tax Key: 2-8-10-58. See Sheet 5743.20

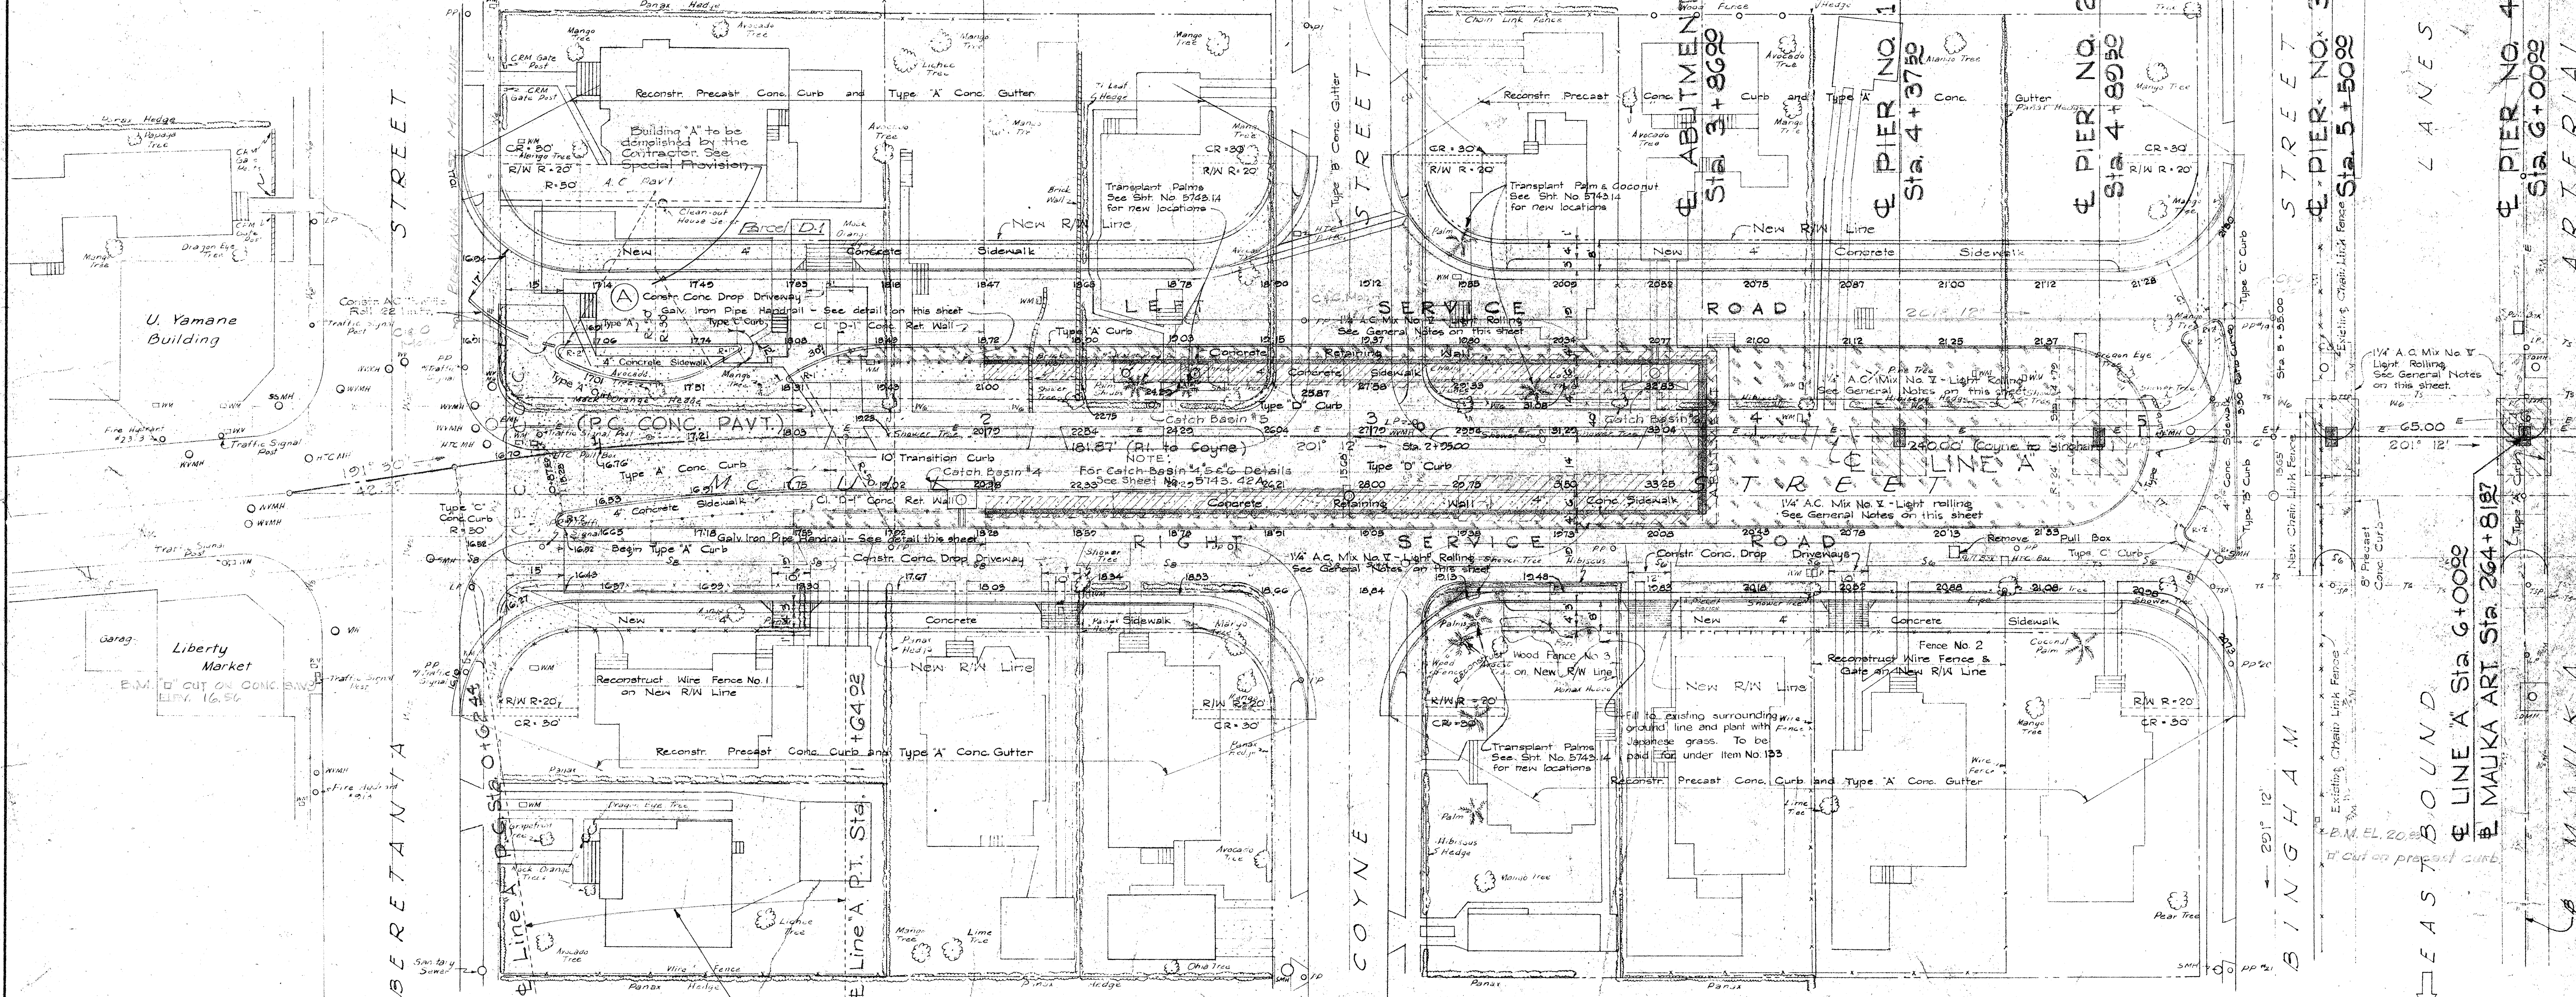

LINE 'A' CURVE DATA


Δ	R	L
9° 42'	600.00'	101.58'

RIGHT CURB CURVE DATA

Δ	R	L
9° 16' 06"	461.58'	37.41'
		74.66'

LONGITUDINAL SECTION THRU RCC PAVT

STA. 0+75 TO 0+20
Scale: 3/8" = 1'-0"

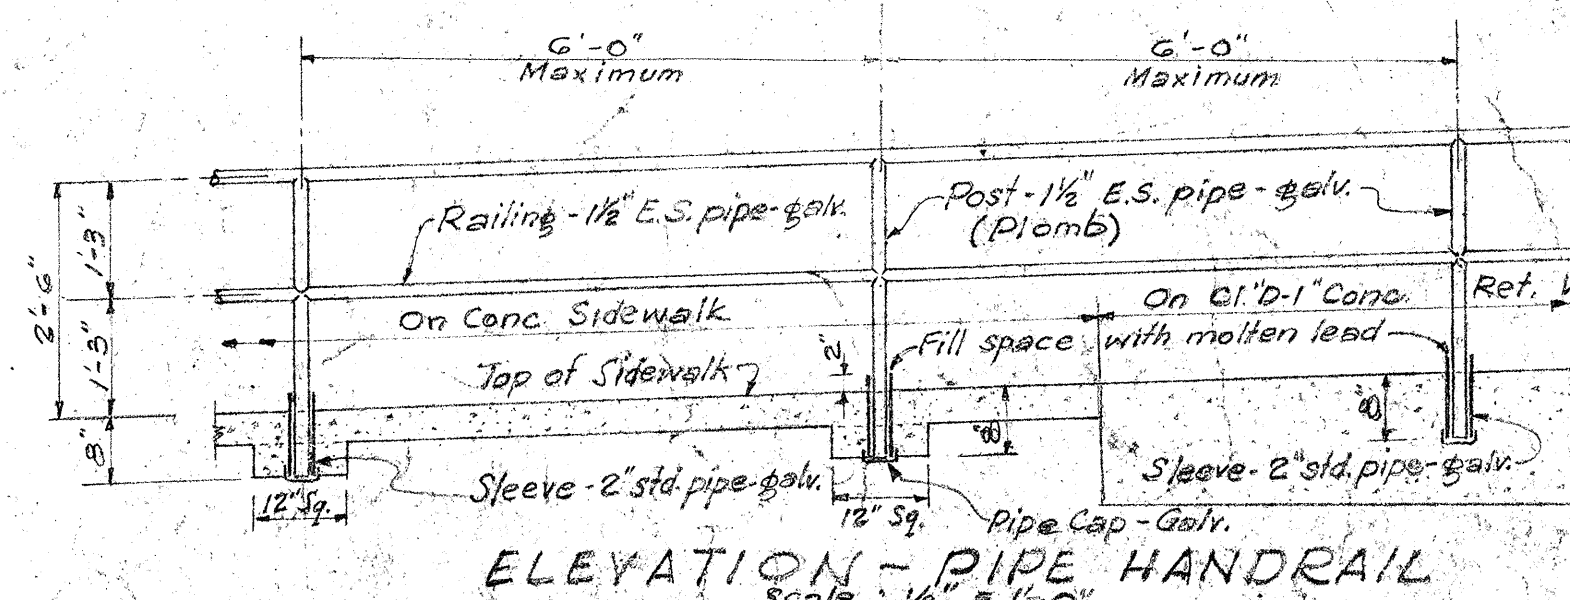

NOTE:
All joints shall be welded. Extra concrete under sidewalk and 2" sleeves shall be incidental to the item of "Pipe Handrail".

TERRITORIAL HIGHWAY DEPARTMENT
TERRITORY OF HAWAII

DETAIL PLAN OF ROADWAY

MAUKA ARTERIAL
McCULLY SEPARATION

PROJECT No. U 59 (8)

Scale: 1" = 20'

SHEET No. 1 OF 2 SHEETS

5743.4

