


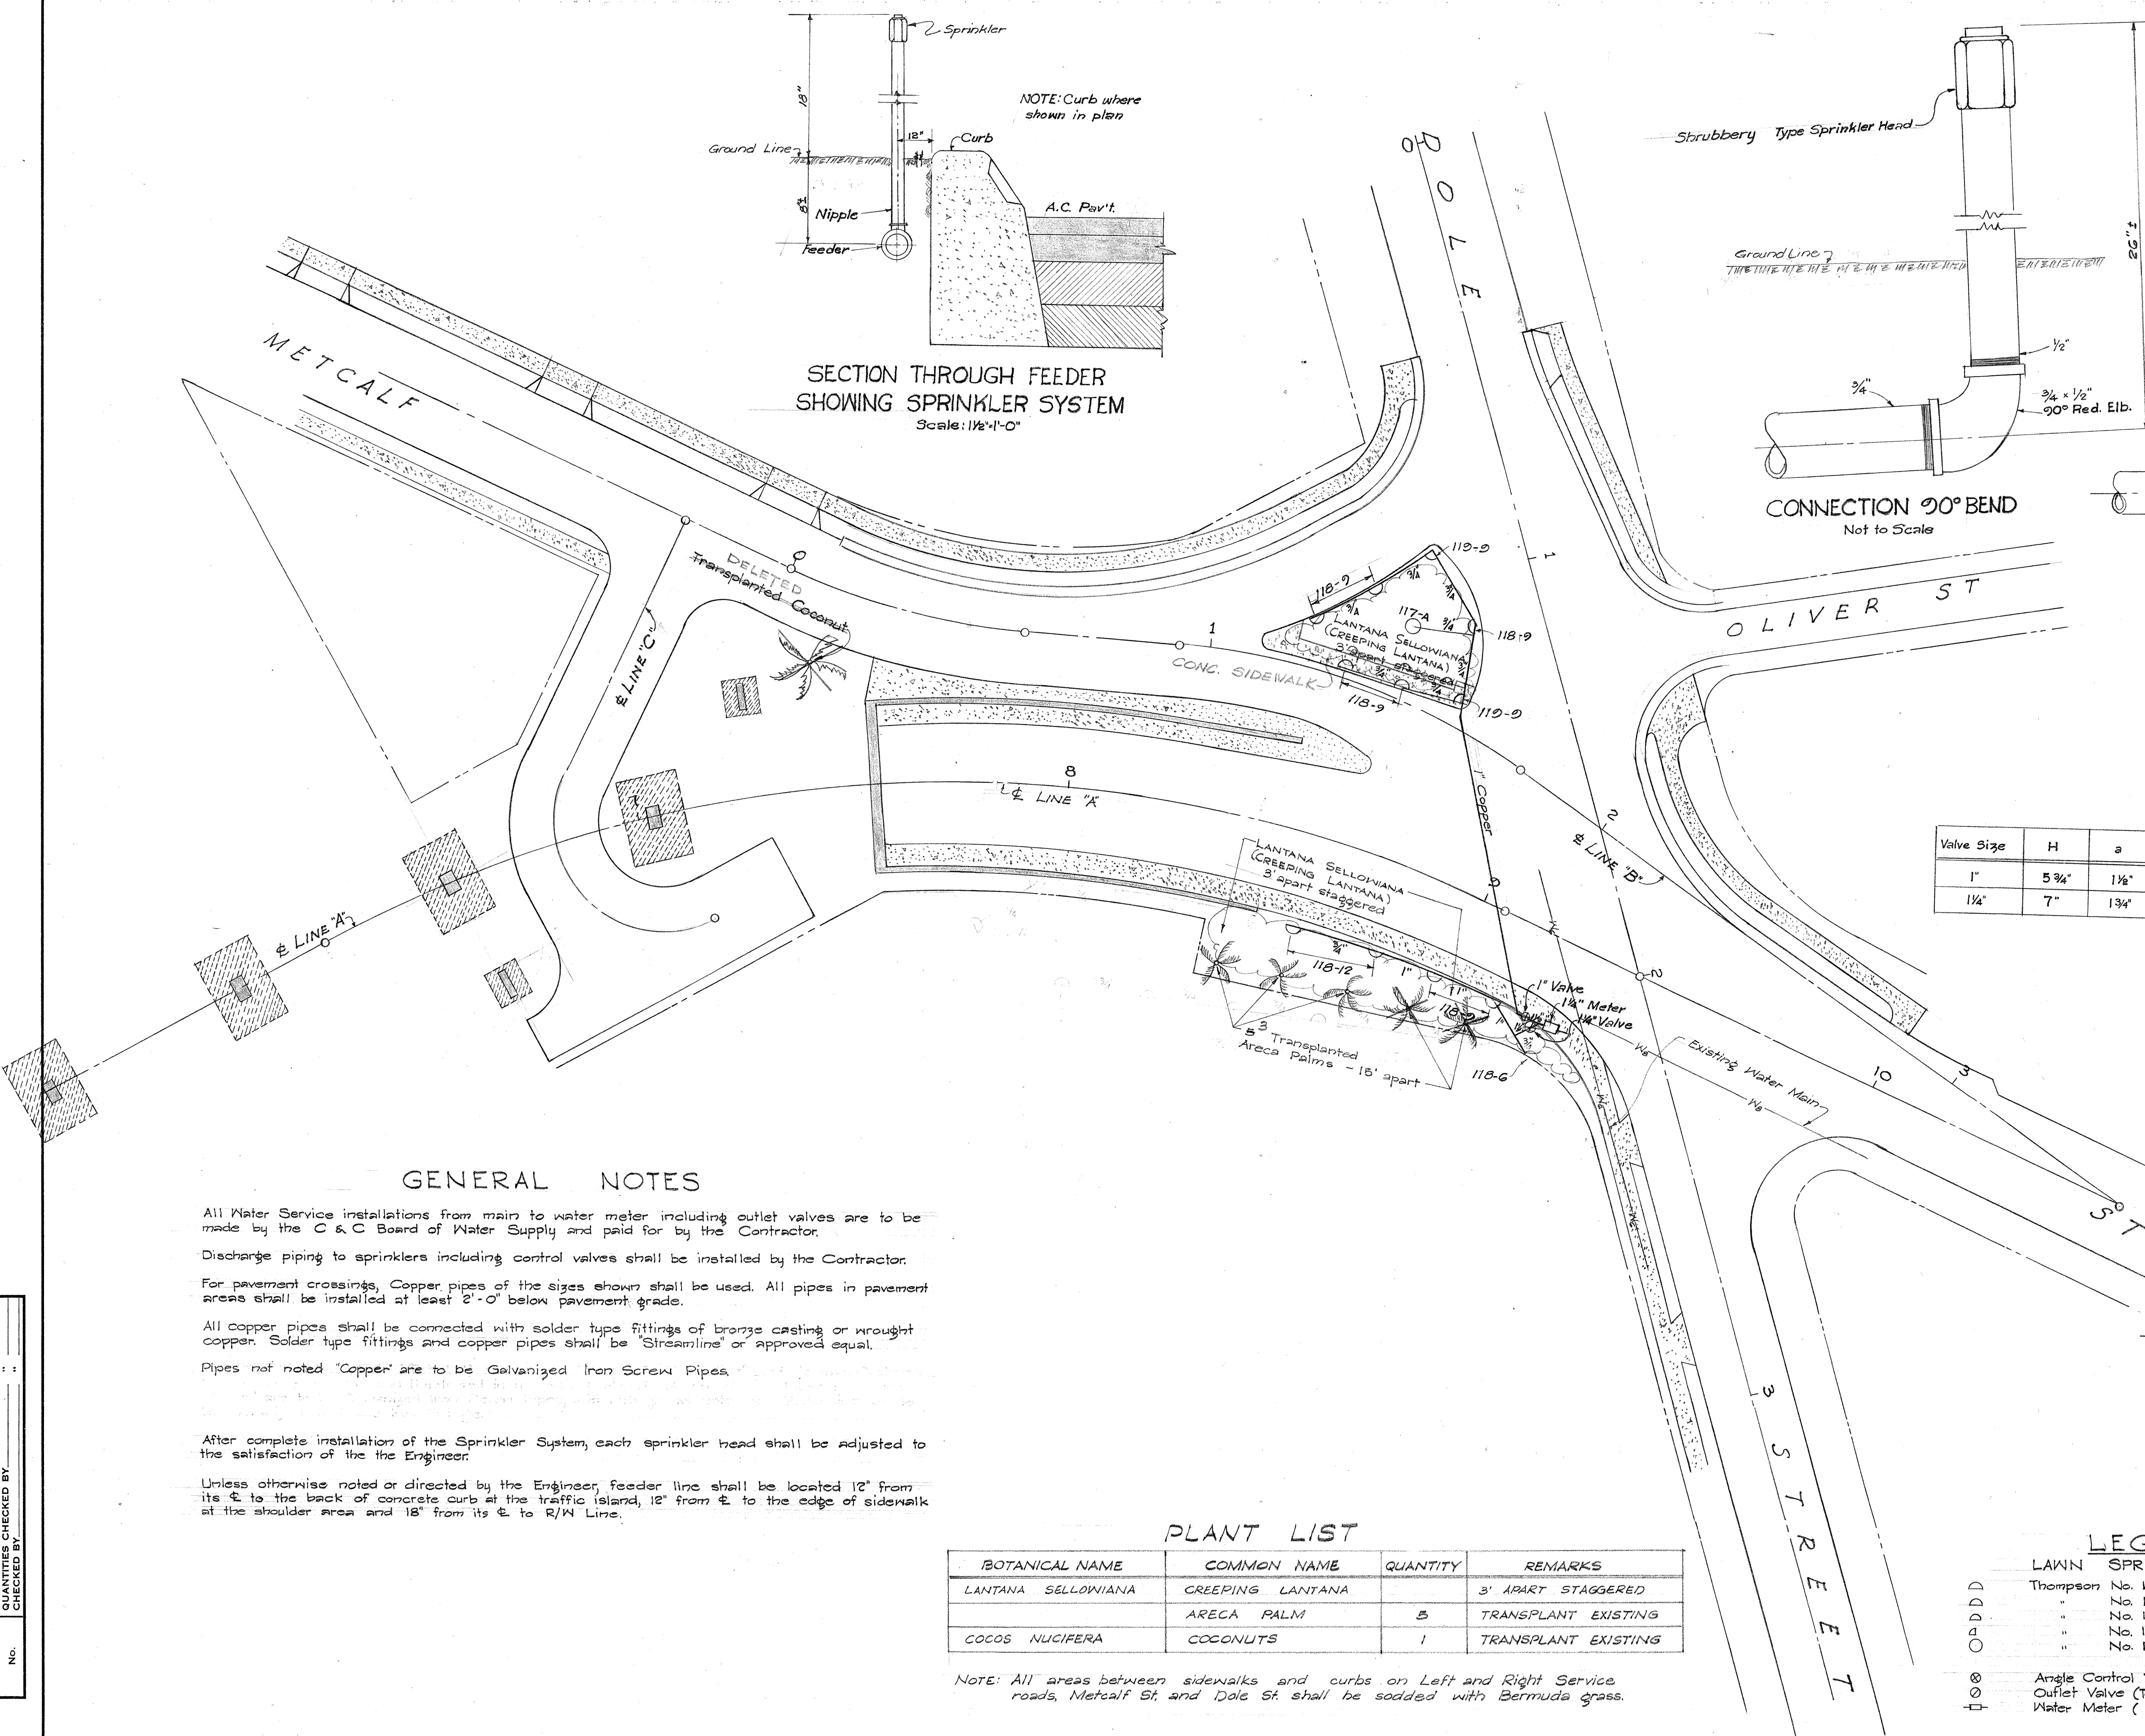

TERRITORIAL HIGHWAY DEPARTMENT
TERRITORY OF HAWAII
LANDSCAPING & SPRINKLER SYSTEM
MAUKA ARTERIAL
McCULLY SEPARATION
PROJECT No. U 59 (8)
Scale: As Shown