


Note: For detailed Plan of Roadway, See
 Sheets No. 5743.4 & No. 5743.5

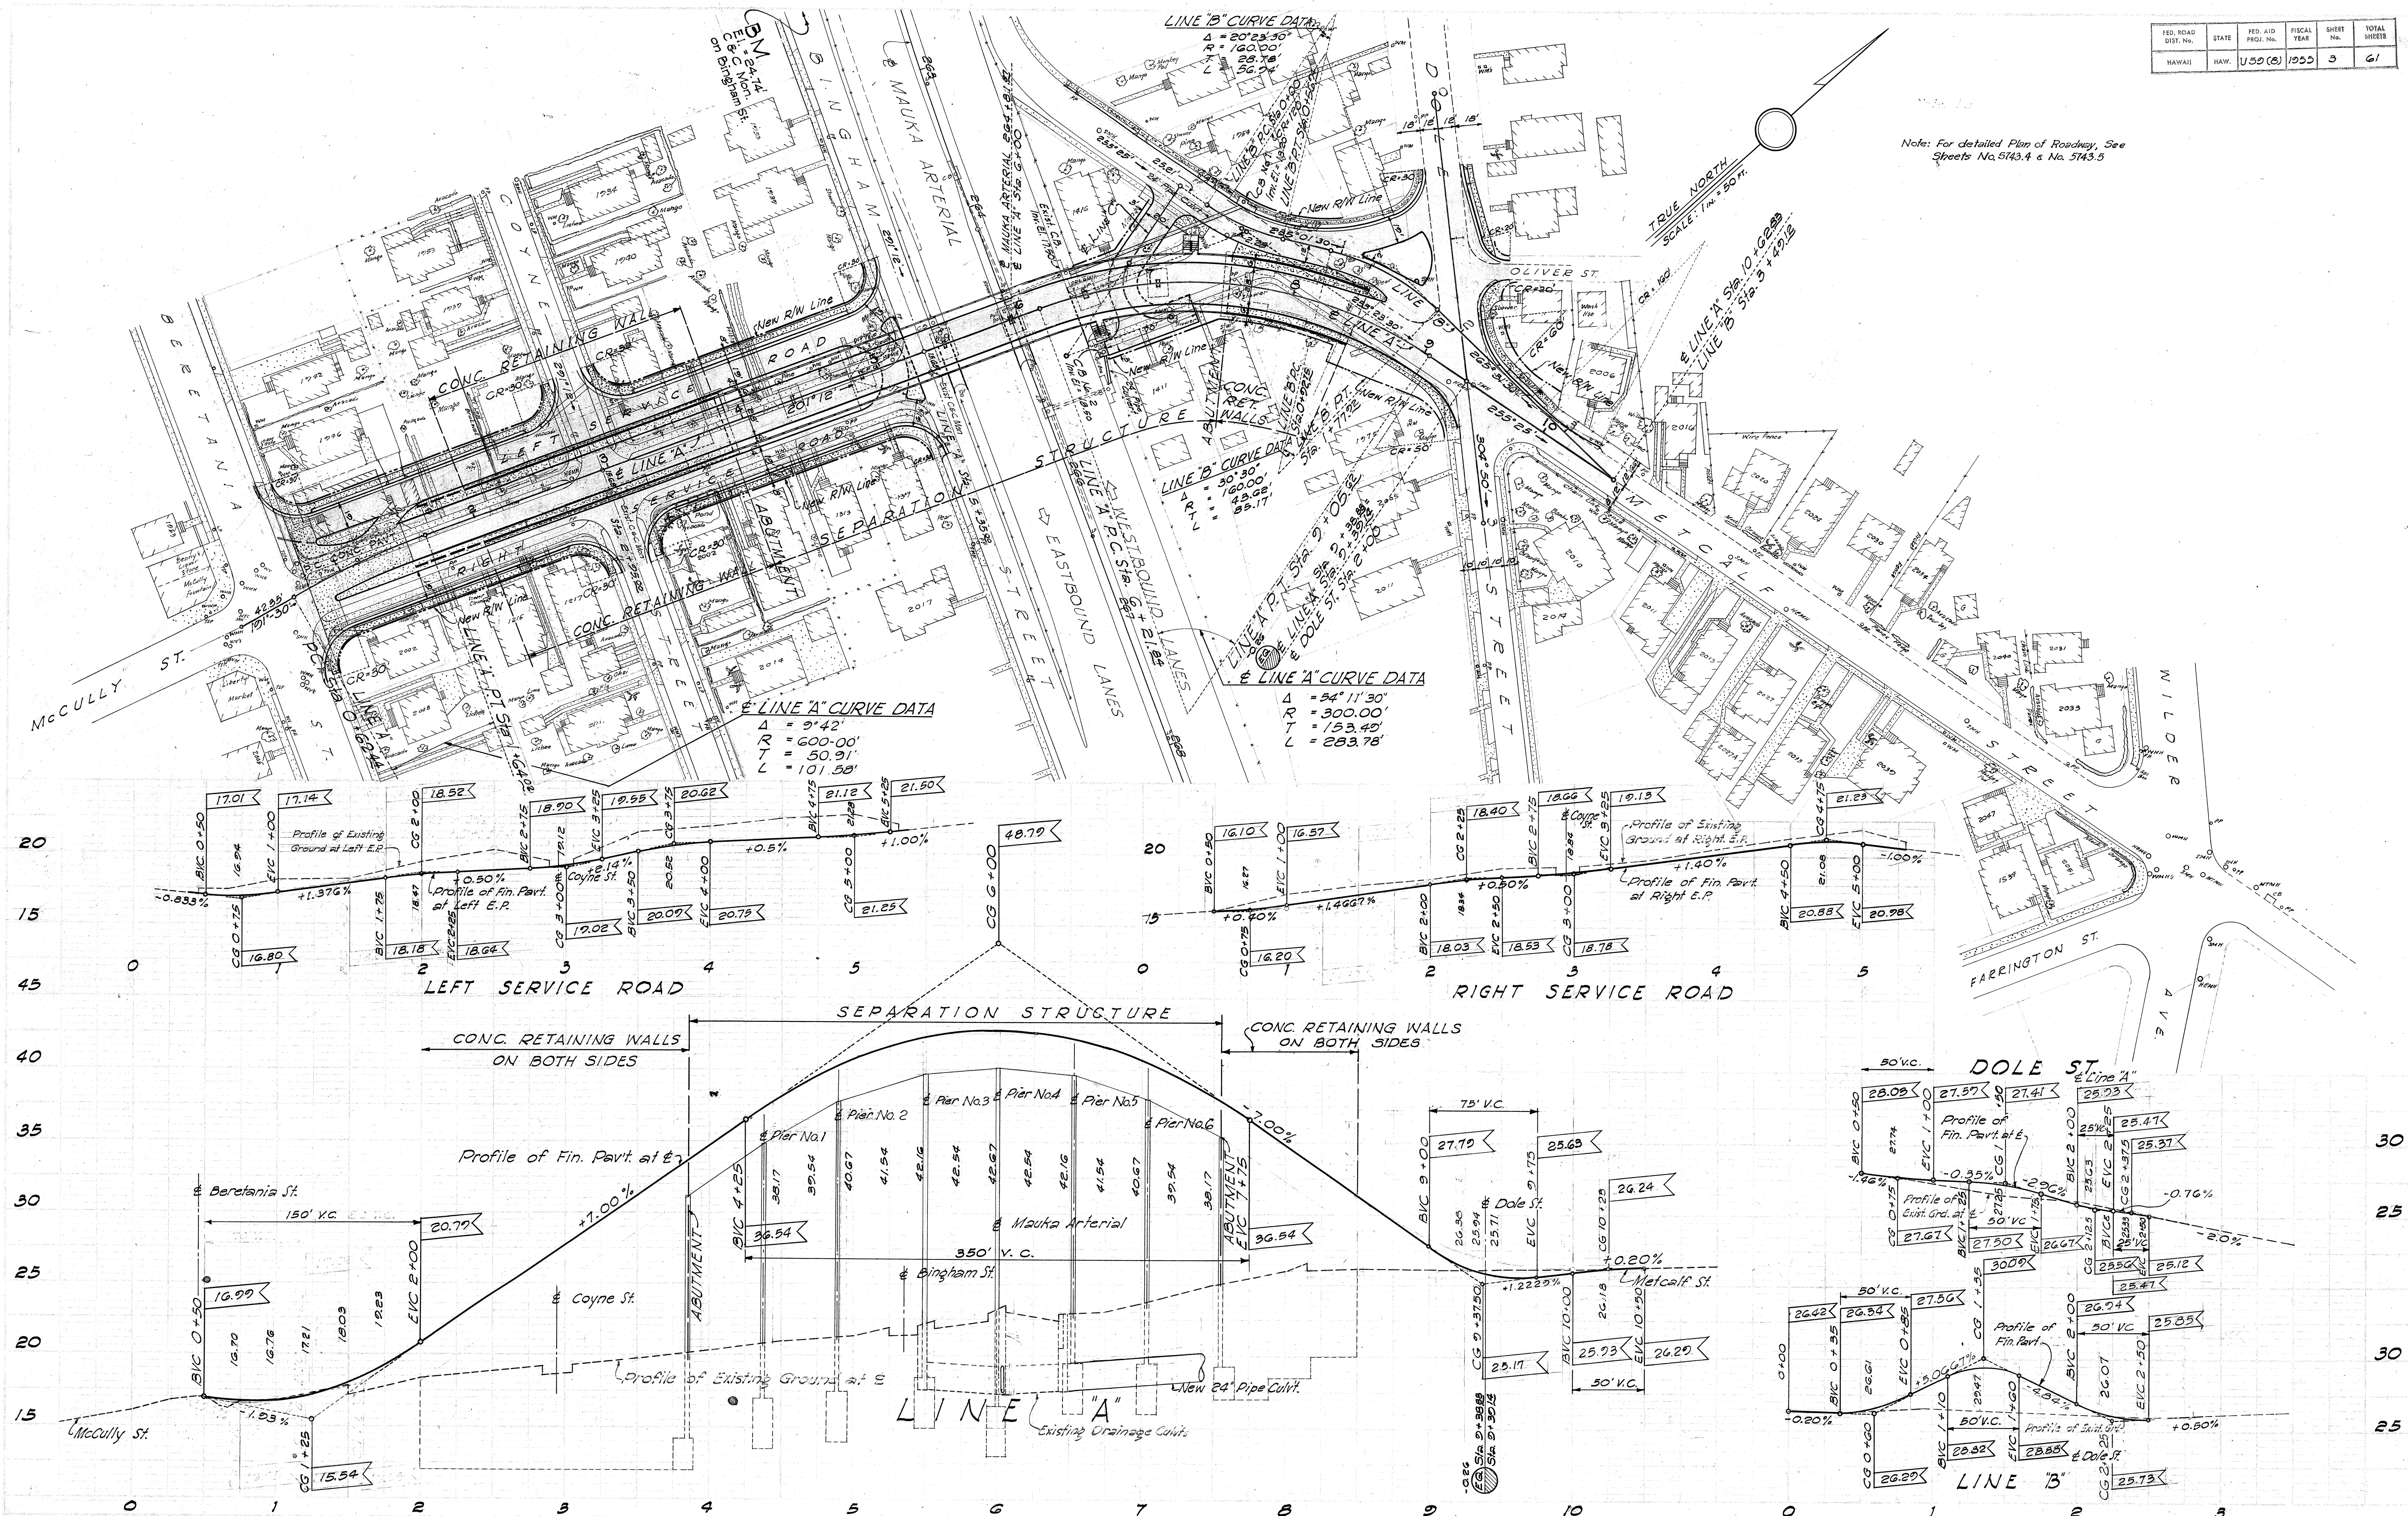

5743.3