


FED. ROAD DIST. No.	STATE	FED. AID PROJ. No.	FISCAL YEAR	SHEET No.	TOTAL SHEETS
HAWAII	HAW.	U 59(8)	1955	6	61

LEGEND


Extend Existing Sewer Lateral
to New P/L. Relocate Cleanout
back of New Prop. Line.

- | | |
|--------------------|-----------------------------|
| — S _e — | Existing Sewer Line |
| — W _o — | Existing Water Line |
| — G _M — | Existing Gas Line |
| — E — | Existing Electric Duct Line |
| — T — | Existing Telephone Cable |
| SMH | Sewer Manhole |
| HEMH | Electric Manhole |
| WMH | Water Manhole |
| WM | Water Meter |
| SDMH | Storm Drain Manhole |
| HTC | Telephone Manhole |

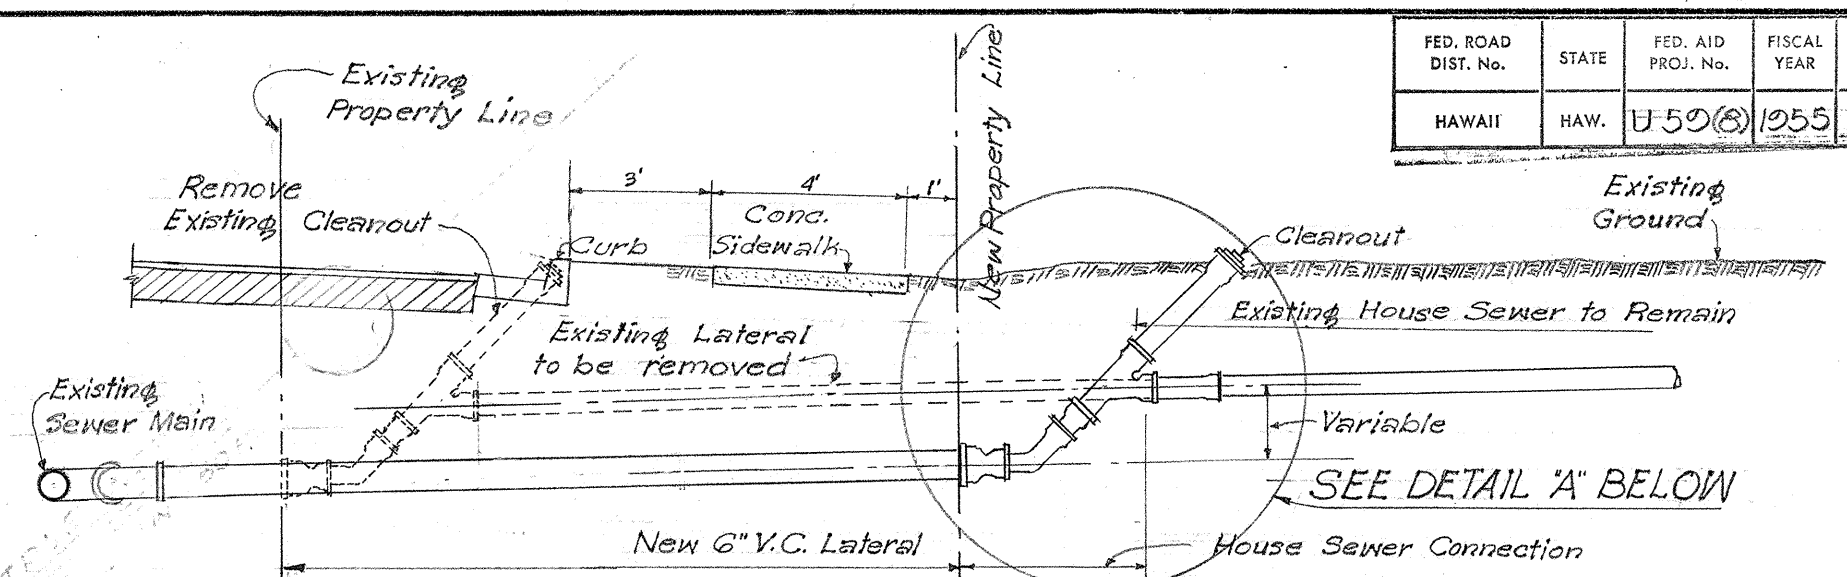



TYPICAL DETAIL OF HOUSE SEWER EXTENSION
& RELOCATION OF CLEANOUT

Scale: 1/4"=1'-0"

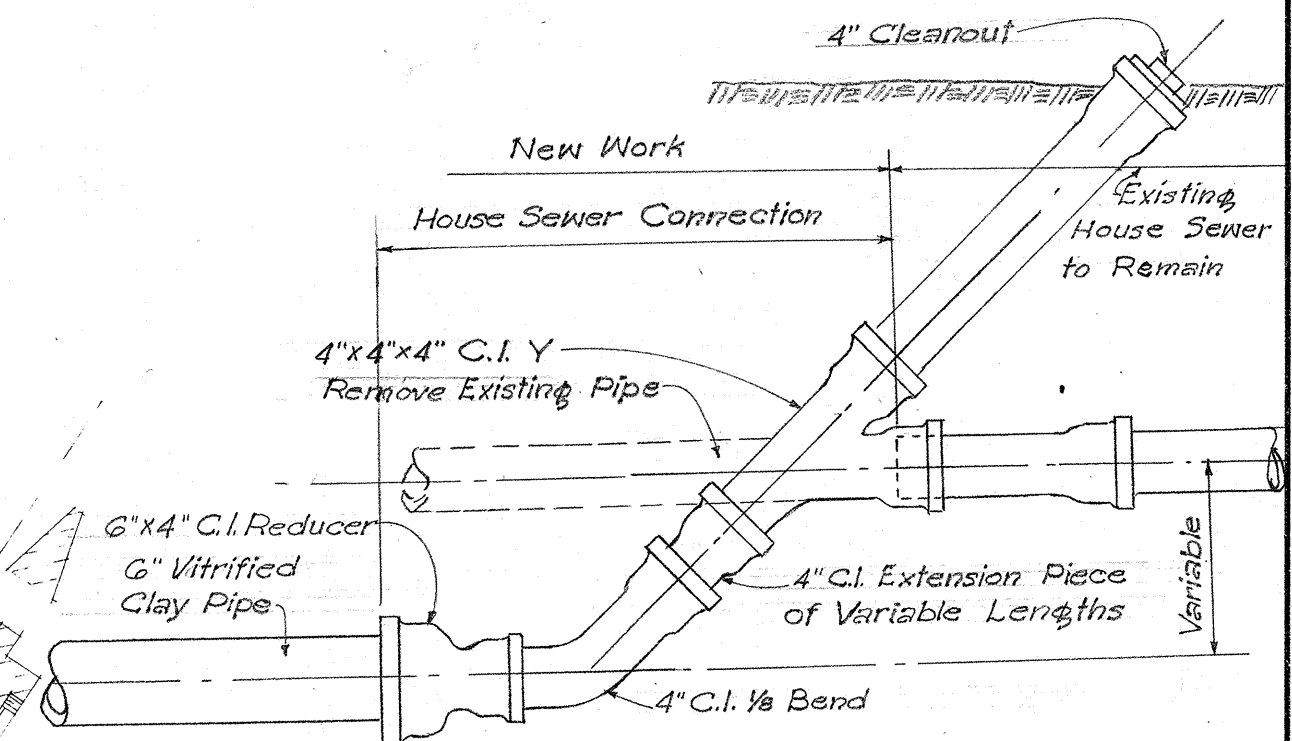

DETAIL "A"

Scale: $\frac{3}{4}'' = 1' - 0$

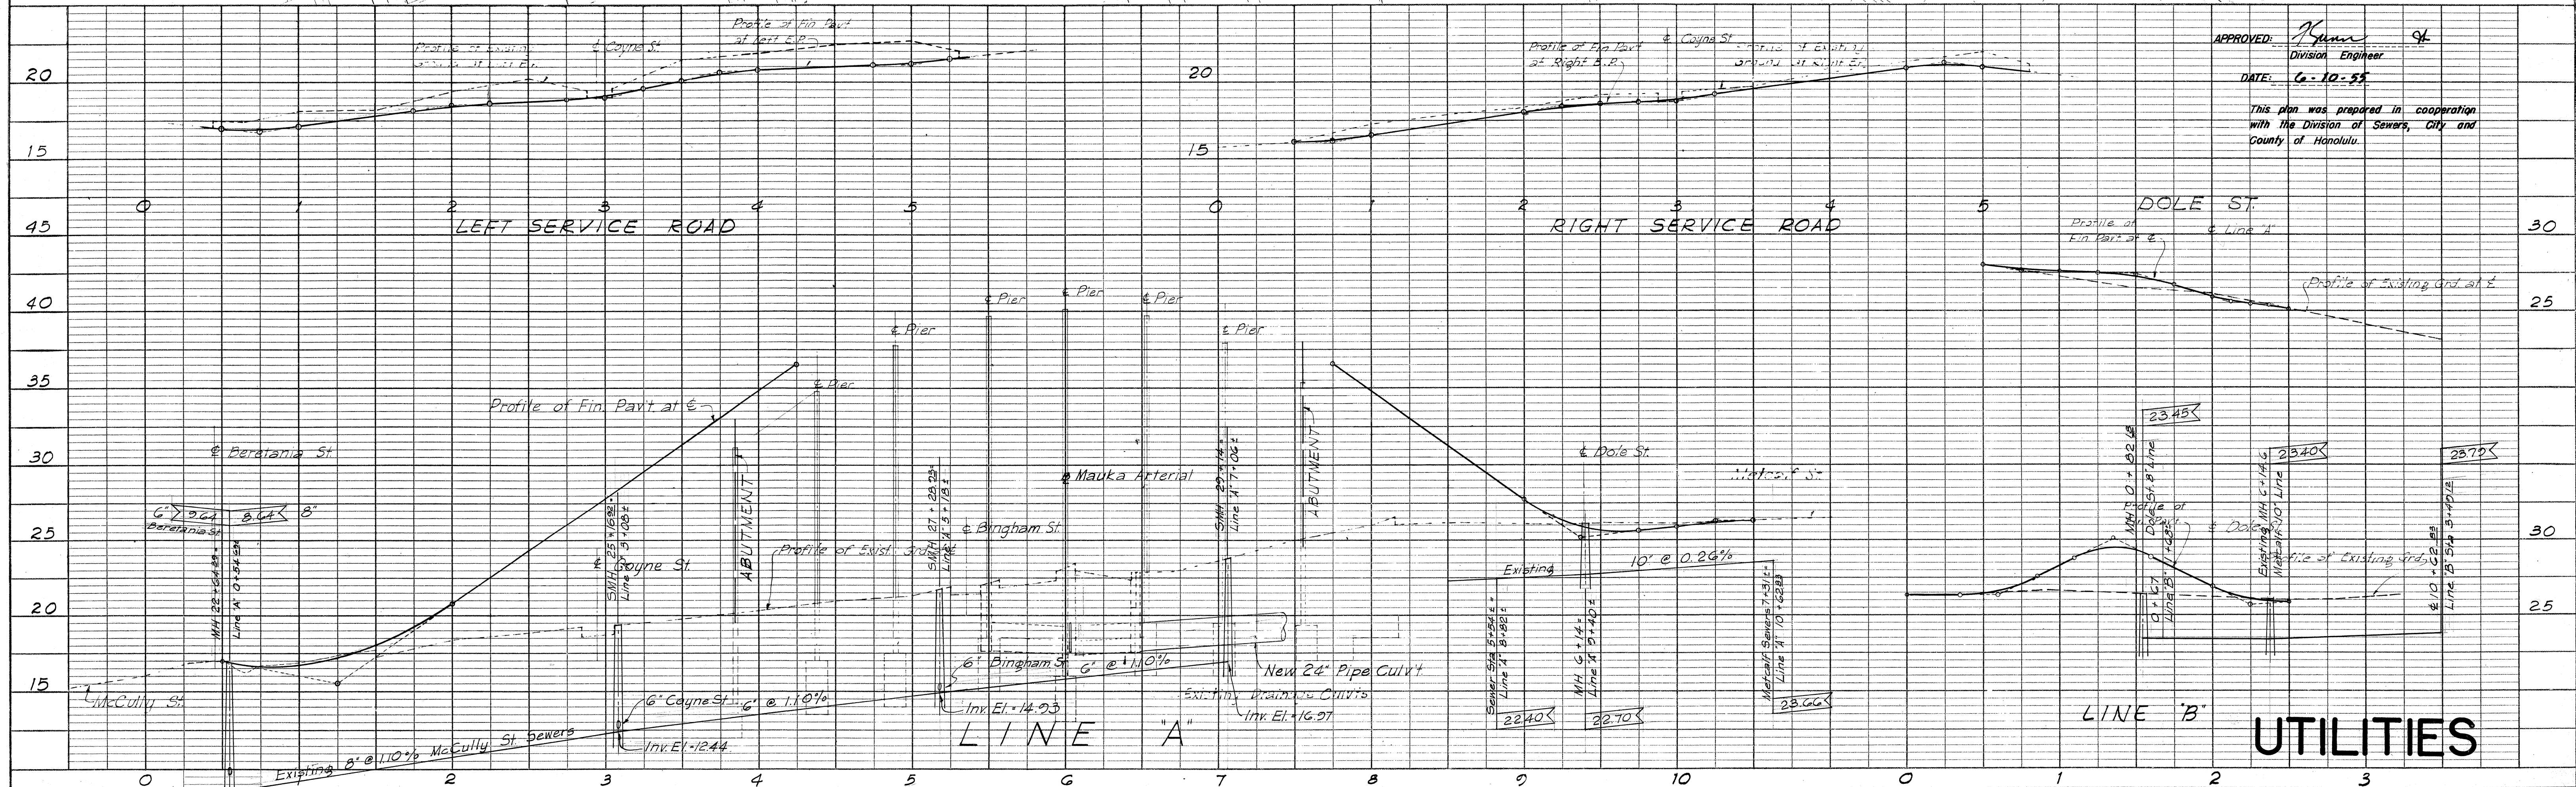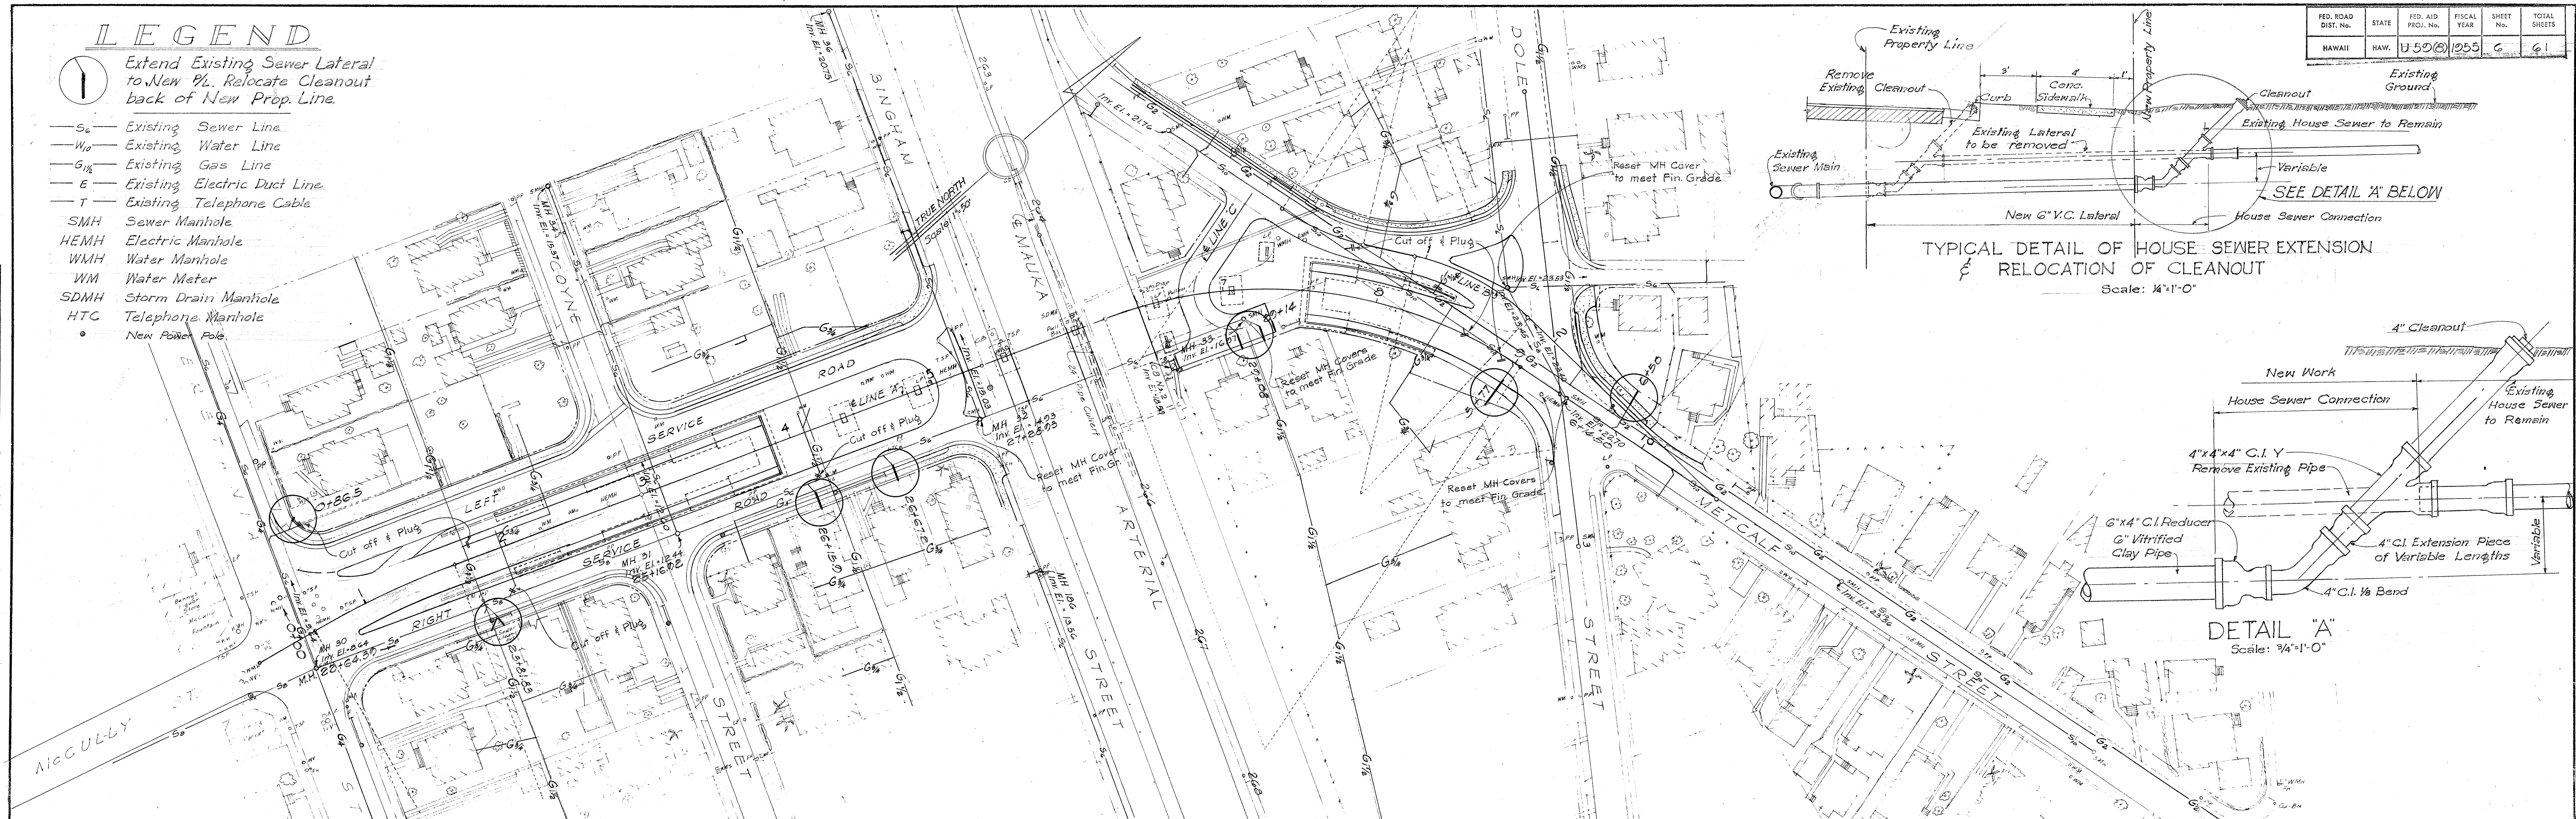

APPROVED:
Division Engineer

DATE: 6-10-55

This plan was prepared in cooperation with the Division of Sewers, City and County of Honolulu.

UTILITIES

$$\overset{2}{5} \overset{3}{7} 4 3 . 6$$