




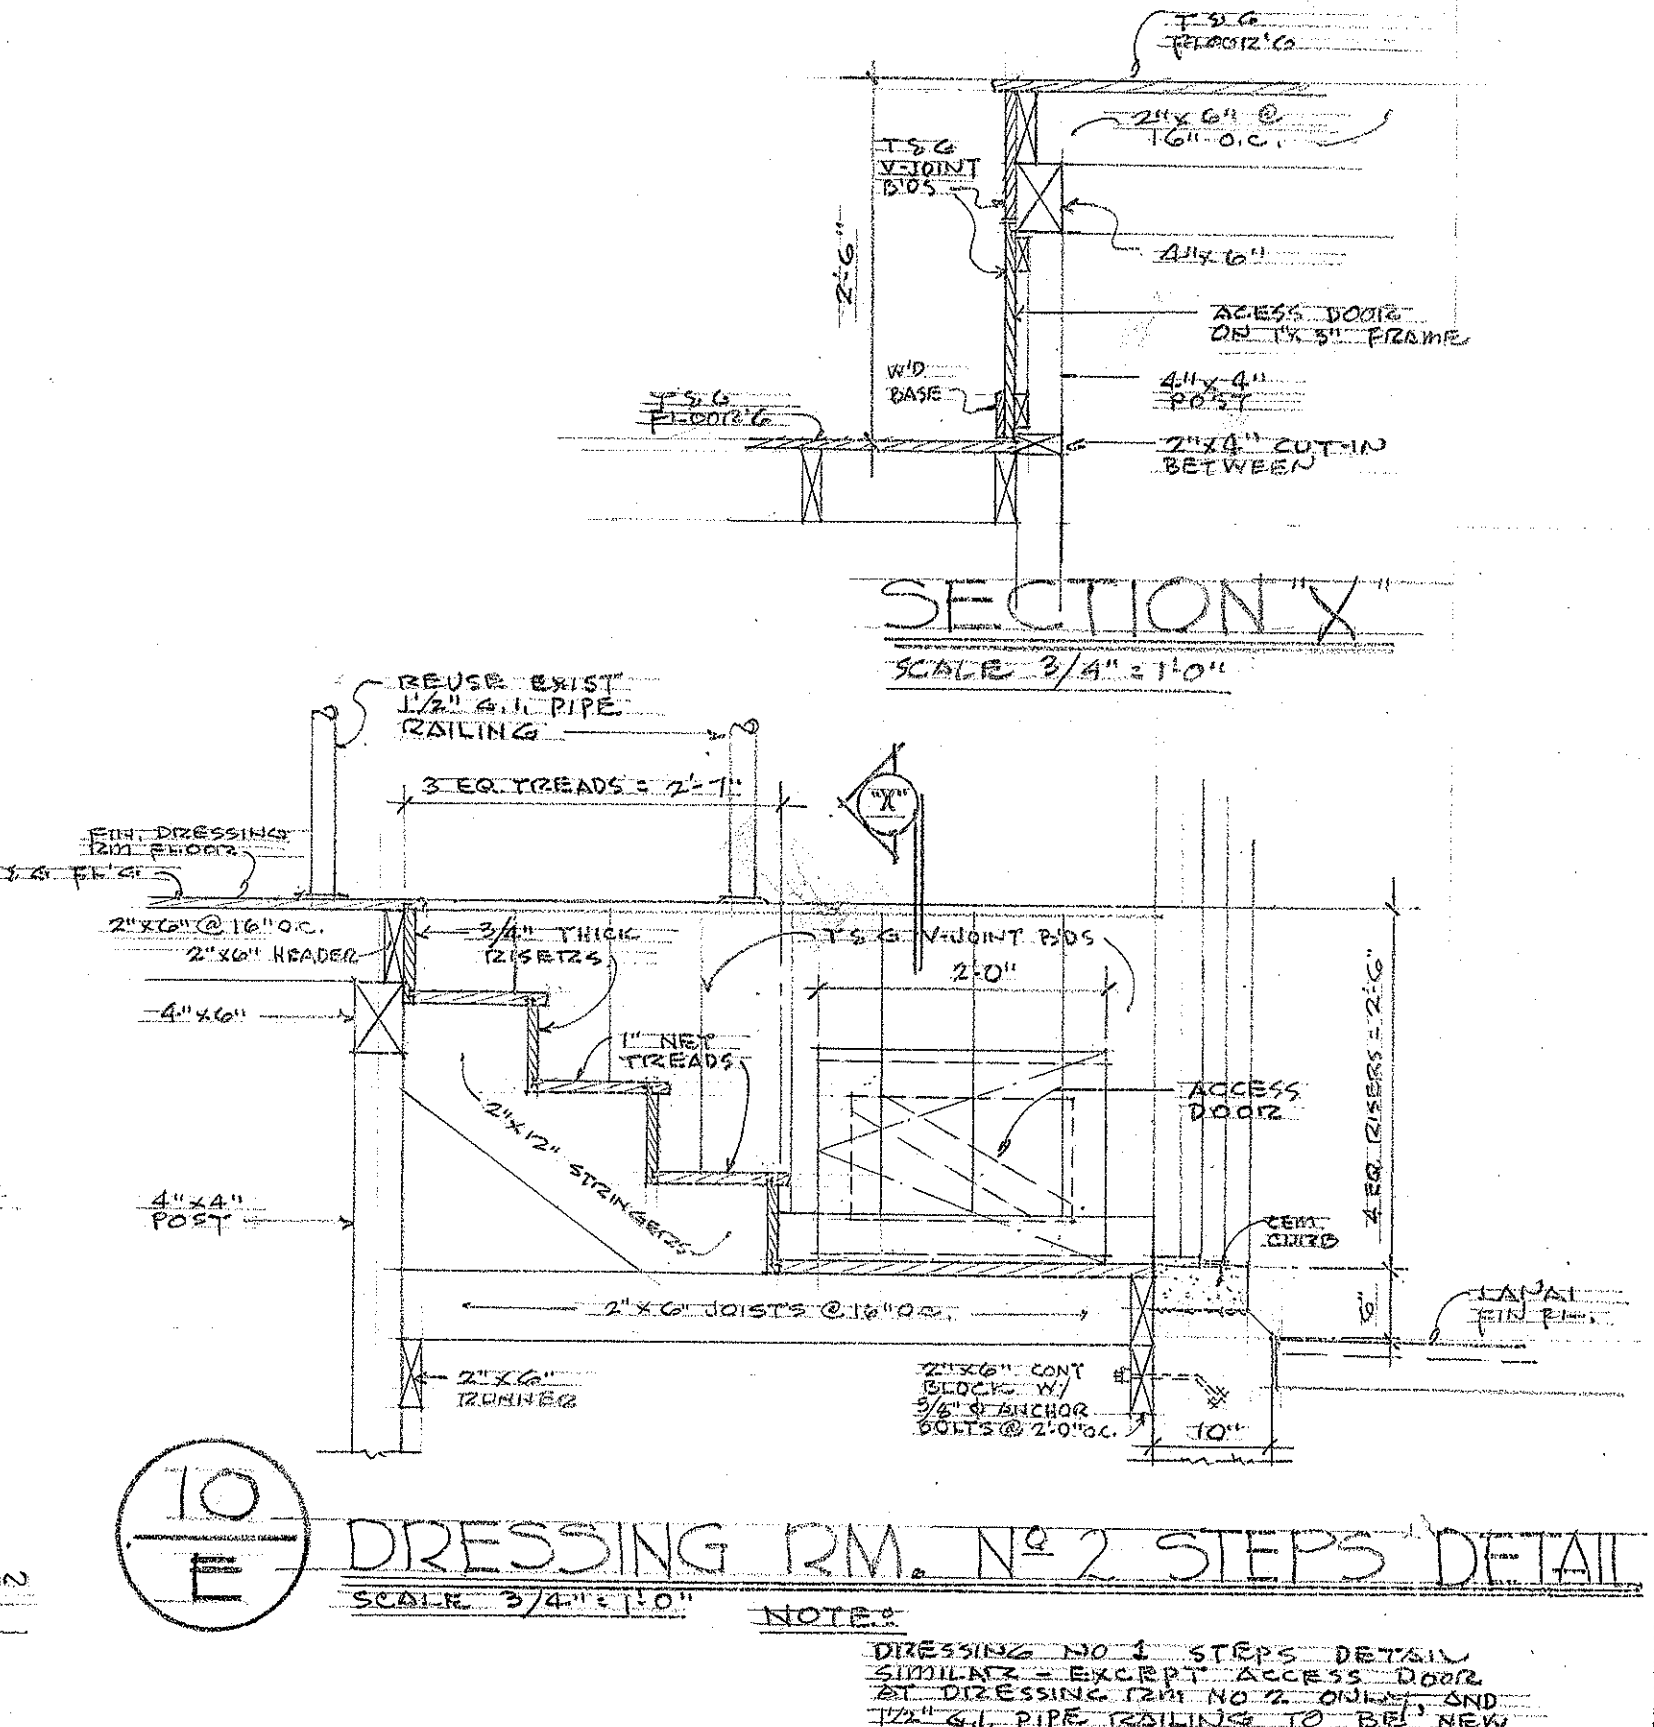


 LONGITUDINAL SECTION THRU NEW ADDITION
 50.0000 1/4" = 1.0"

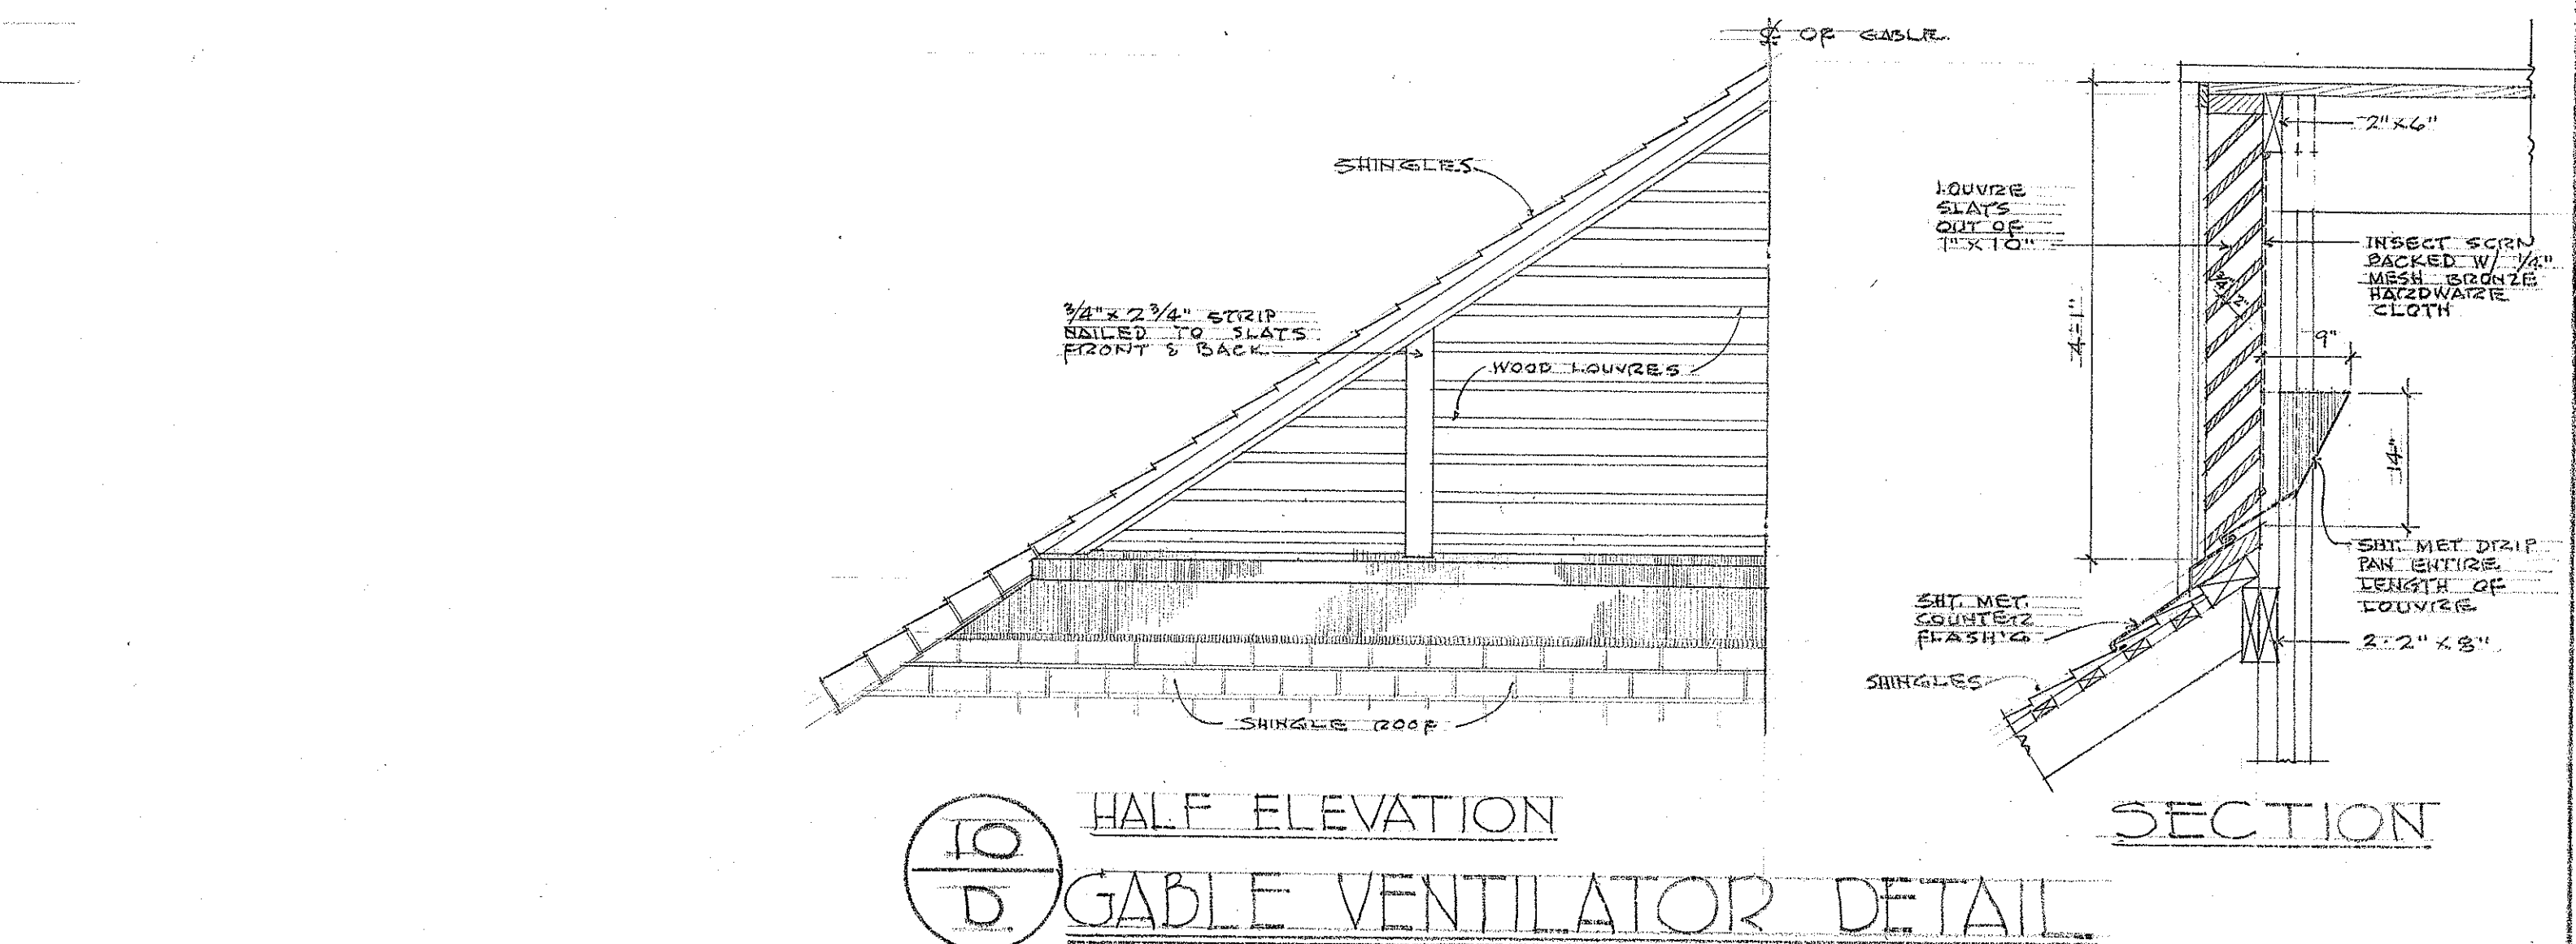

10
D. HALF ELEVATION
GABLE VENTILATOR DETAIL

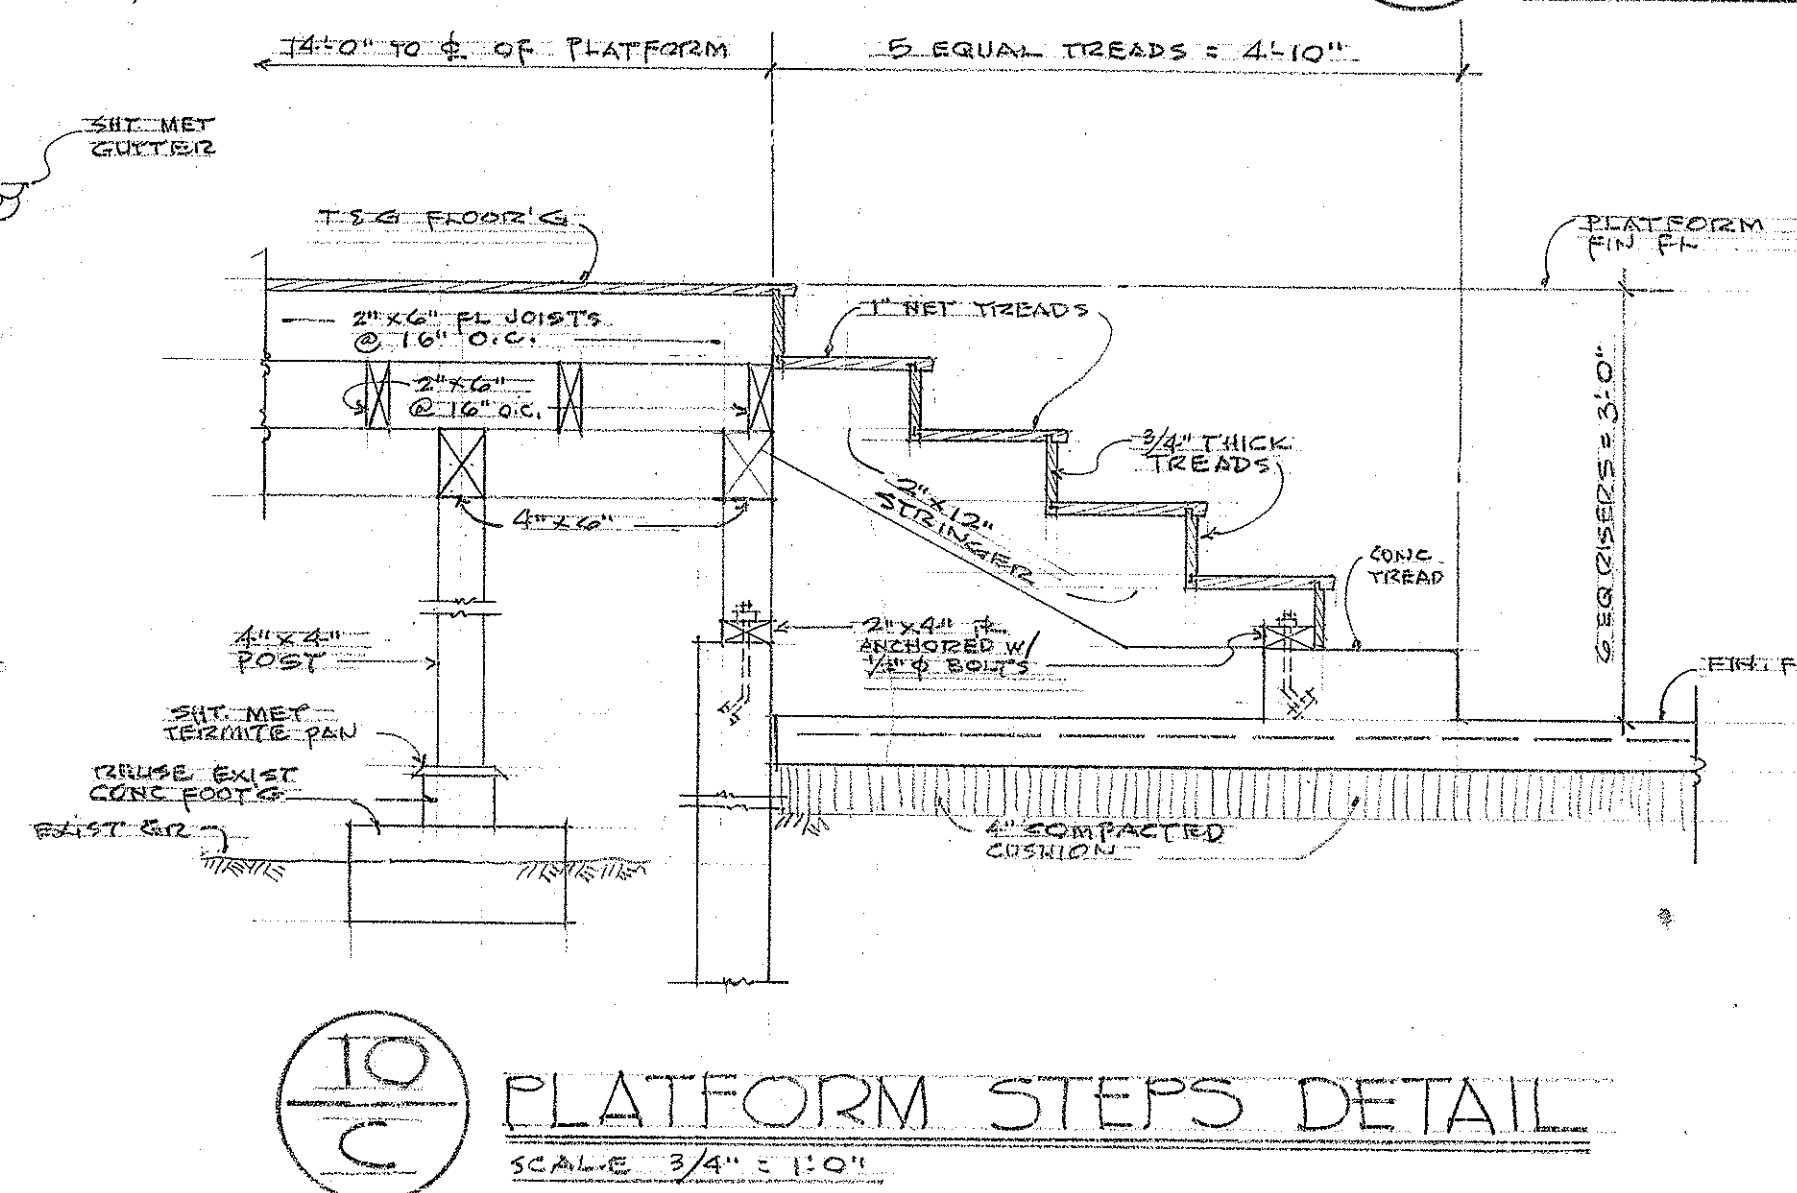

PLATFORM STEPS DETAIL

SCALE 3/4" = 1'-0"

TERRITORIAL HIGHWAY DEPARTMENT
 TERRITORY OF HAWAII
 RELOCATION AND REHABILITATION
 OF
 EXISTING IMPROVEMENTS
 AT
 KAULUWELA SCHOOL
 HONOLULU, OAHU, T.H.
 IN CONNECTION WITH LUNALEILO FREEWAY
 FED. AID PROJ. NO. BE-072-15(3)

DATE: FEB. 14, 1958
 THOMAS T. NISHIDA ARCHITECT
 HAROLD M. TANIMURA ENGINEER
 HONOLULU, OAHU, T.H.

SHEET
 10
 OF 12 SHEETS