


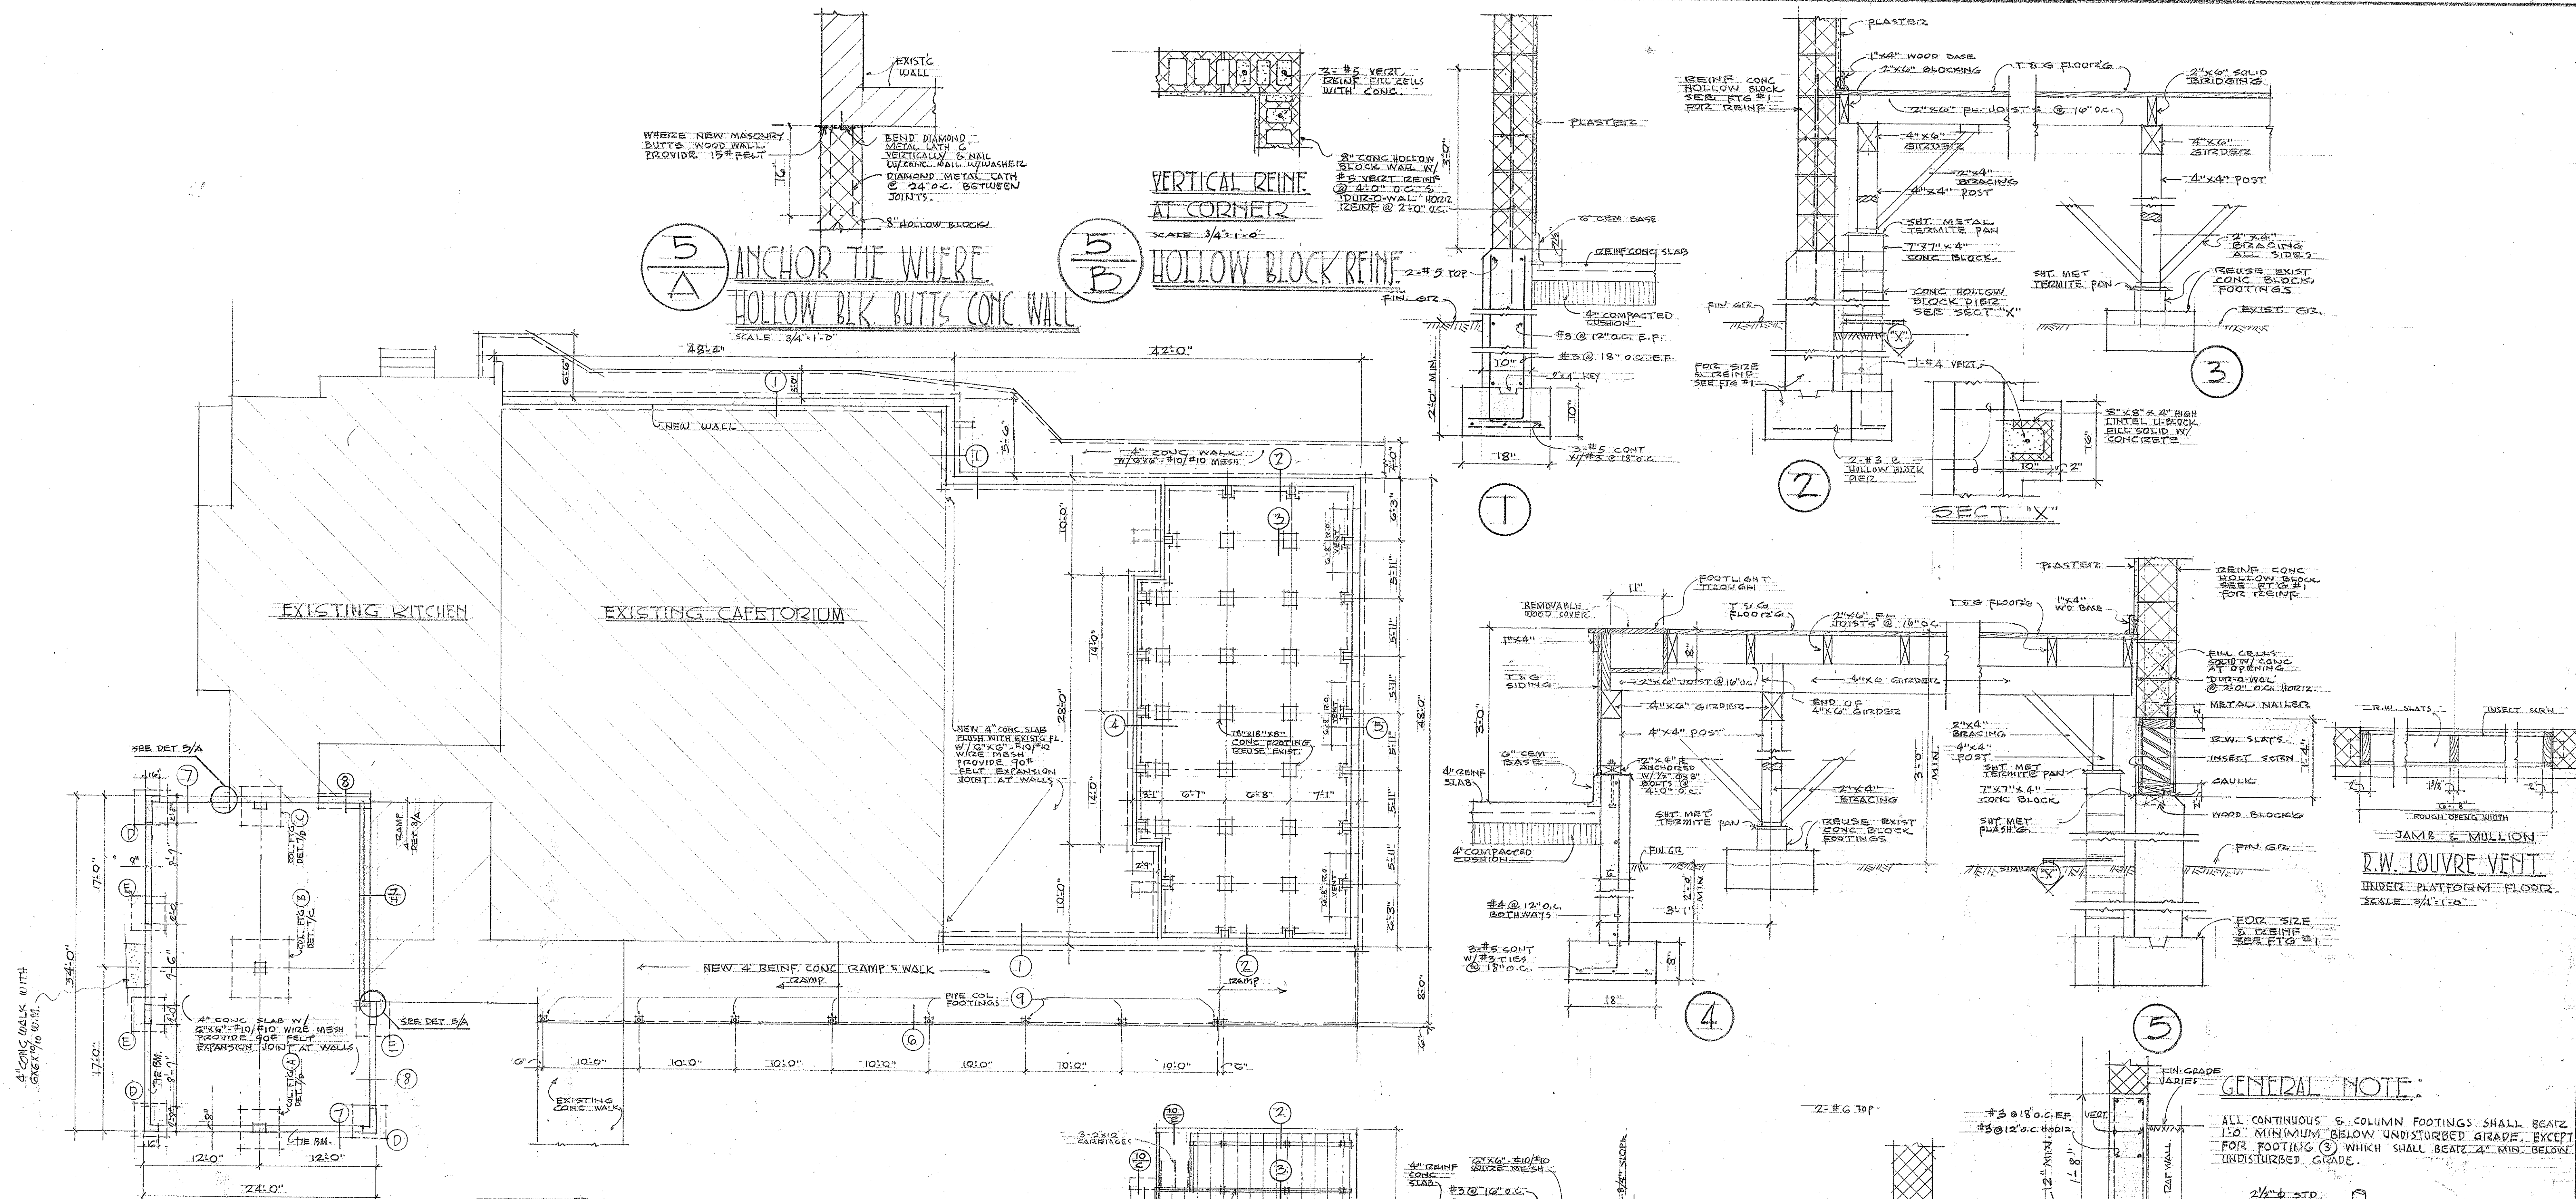

COL (D) REIN. 6-#6 #3 @ 12" O.C.
COL (E) " " " #3 @ 12" O.C.
F.T.S. FOR (D) & (E) TO BE 3'-6" x 3'-6" x 12" w/ 7-#4 E.W.
FOR COL. & F.T.S. A.B.C. SEE DET. 7/D
" " " " B SEE DET. 7/C

TERRITORIAL HIGHWAY DEPARTMENT RELOCATION AND REHABILITATION OF EXISTING IMPROVEMENTS AT KAULUWELA SCHOOL HONOLULU, OAHU, T.H.		
IN CONNECTION WITH LUNALILO FREEWAY FED. AID PROJ. NO. BE-072-1(3)		
DATE FEB 14 1958	THOMAS T. NISHIDA ARCHITECT HAROLD M. TAMMURA ENGINEER HONOLULU, OAHU, T.H.	SHEET 5 OF 13 SHEETS

5985.6